


FED. ROAD DIST. NO.	STATE	PROJ. NO.	FISCAL YEAR	SHEET NO.	TOTAL SHEETS
HAWAII	HAW.	19J-01-03M	2003	7	24

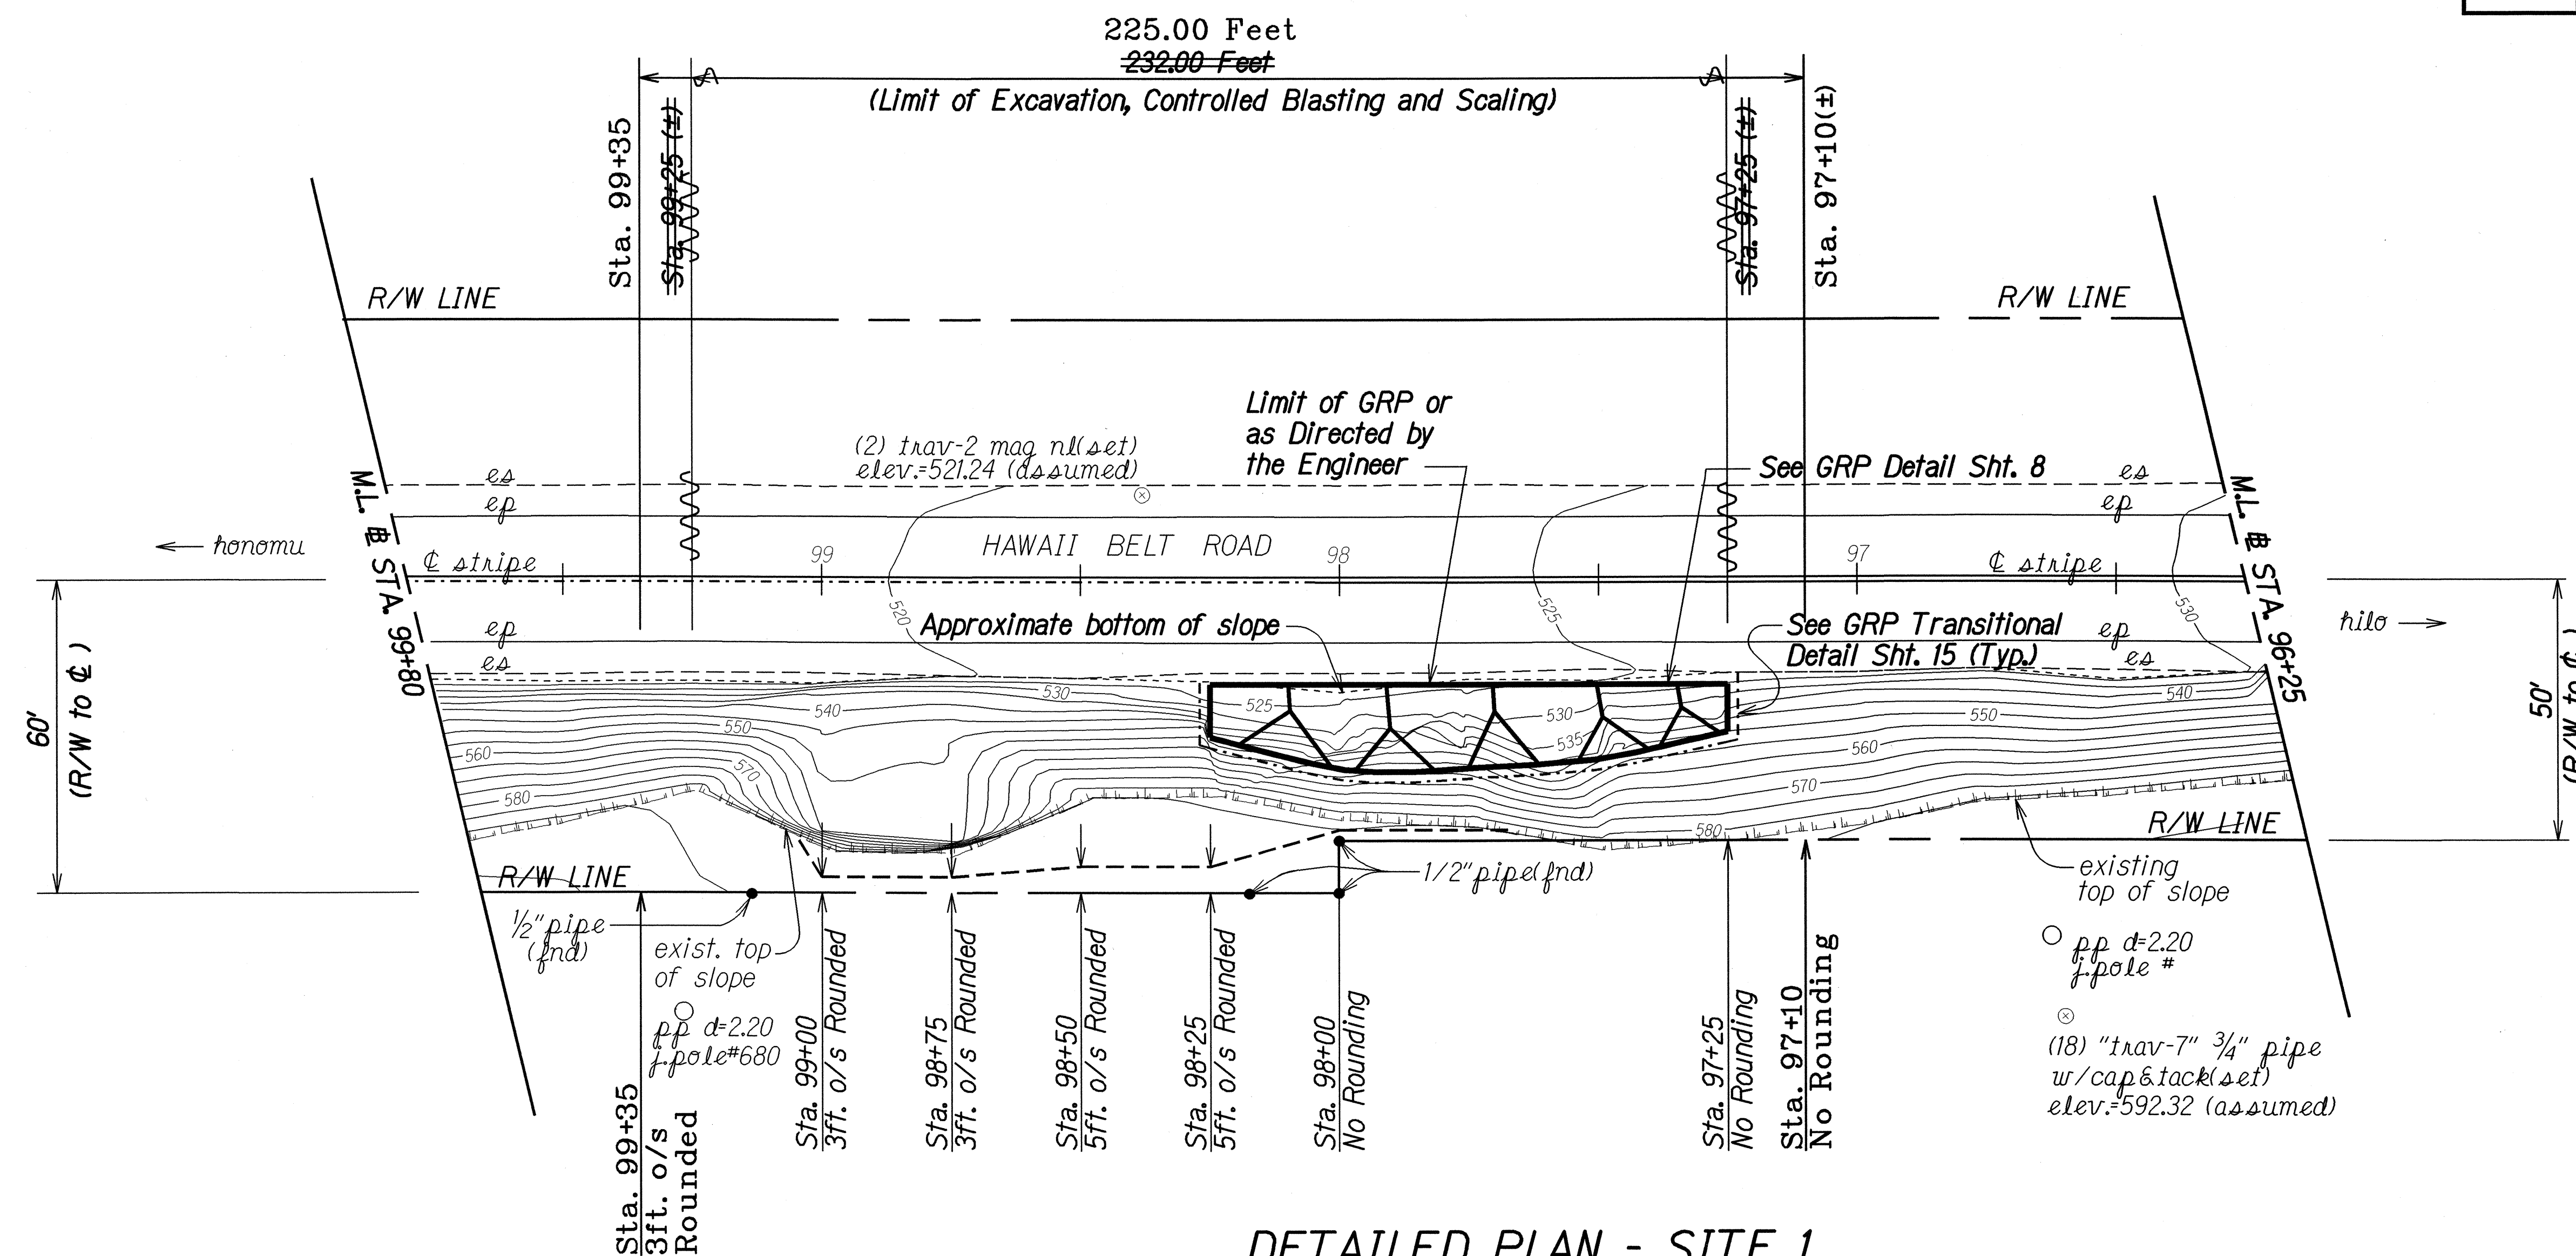


### DETAILED PLAN - SITE 1

Scale: 1"=20'

#### MISCELLANEOUS NOTES:

- Contractor shall protect existing roadway, walls, guardrail etc. with rubber mats, barriers or other acceptable means prior to beginning operations to protect and prevent damage to existing facilities from falling rocks.
- After completion of excavation and acceptance by the Engineer, the Contractor shall provide and install six (6) each of Portable Concrete Barrier (Item No. 606.4160).
- The Contractor shall provide and install one (1) NCHRP Compliant End Treatment (Item No. 606.6000) "N-E-A-T System as manufactured by Energy Absorption Systems, Inc. or approved equal" attached at each end per manufacture instructions.
- The Engineer will pay for the accepted barrier and end treatment at the contract unit price complete in place. The price includes full compensation for material, preparation, installation and furnishing labor, tools, equipment and incidentals to complete the work
- Refer to sheets 9 thru sheets 13 for scope of excavation work.

#### Legend

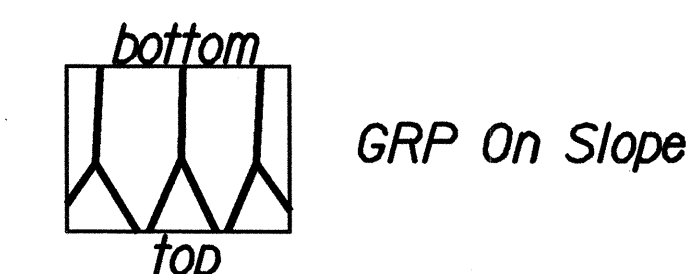

LEGEND FOR AS-BUILT POSTINGS	
	Squiggly line for as-built deletion
	Double line for as-built deletion
Roadway	Text for as-built posting

STATE OF HAWAII  
DEPARTMENT OF TRANSPORTATION  
HIGHWAYS DIVISION

**DETAILED PLAN SITE 1**

**HAWAII BELT ROAD, FLOOD DAMAGE**

**REPAIRS VICINITY OF HONOMU**

**PROJECT NO. 19J-01-03M**

Scale: 1" = 20' Date: April, 2003

SHEET No. 1 OF 1 SHEETS

"AS-BUILT"