

Not To Scale

SITE 2 - STRUCTURAL EXCAVATION/EMBANKMENT EMB. (C.Y.) EXC. (C.Y.) 16 0 70 13 61 98 130+38.70 to 130+46.37 43 6 153 Total 154

2003 | 15 19J-01-03M HAW. Pay Limits for Structural Excavation/Embankment Erosion Control Blanket GRP with Grass Seeds ** "A" "A" Staples


FED. ROAD DIST. NO.

STATE

FISCAL SHEET TOTAL YEAR NO. SHEETS

PROJ. NO.

GRP TRANSITIONAL ON SLOPE PLAN VIEW Not To Scale

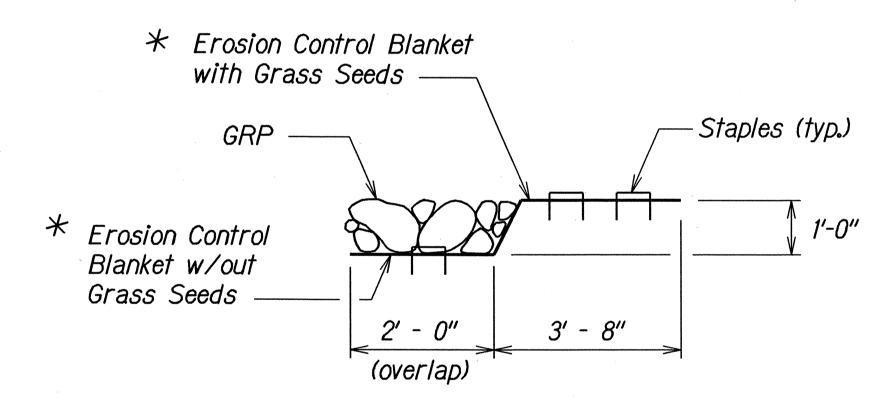


SECTION VIEW "A-A" Not To Scale

* The Engineer will not pay for the Erosion Control Blanket (with and without seeds), Staples and various appurtenances separately. The Engineer shall consider all costs for the material, preparation, installation, and furnishing labor, tools, equipment and incidentals to complete the work as incidental to Item No. 612.0200 Grouted Rubble Paving.

6.67'
5.00'
2.00′
2.00
8" Thick GRP Structural Backfill

DITCH SECTION - STATION 0+05 TO 0+17.53 Not To Scale

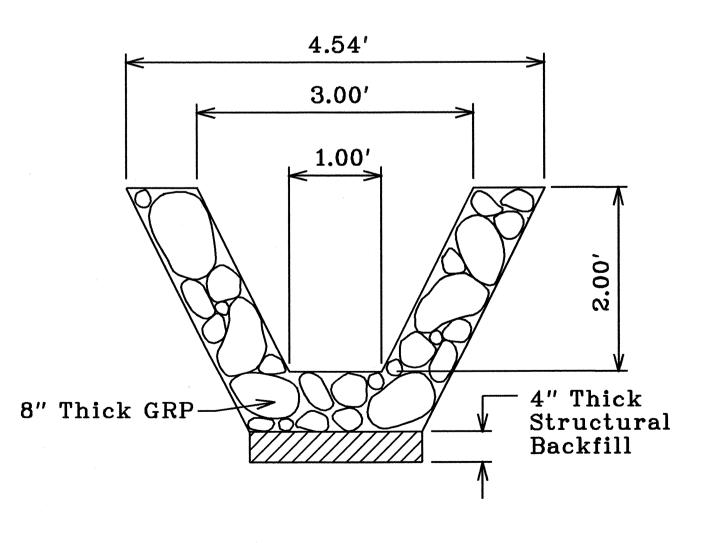

DITCH SECTION - STATION 0+22.2 TO 0+26.87 Not To Scale

LEGEND FOR AS-BUILT POSTINGS Squiggly line for as-built deletion **√√** Double line for as-built deletion 100.00

Text for as-built Roadway posting

DEPARTMENT OF TRANSPORTATION HIGHWAYS DIVISION

DETAILS-SITE 2

HAWAII BELT ROAD, FLOOD DAMAGE REPAIRS VICINITY OF HONOMU PROJECT NO. 19J-01-03M

Scale: As Shown Date: April, 2003 SHEET No. 1 OF 1

SHEETS

"AS-BUILT"

15