
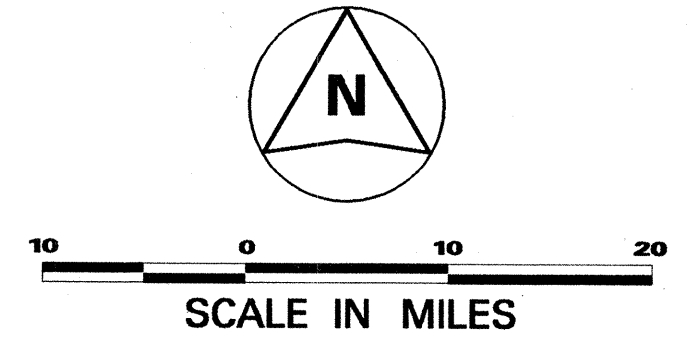
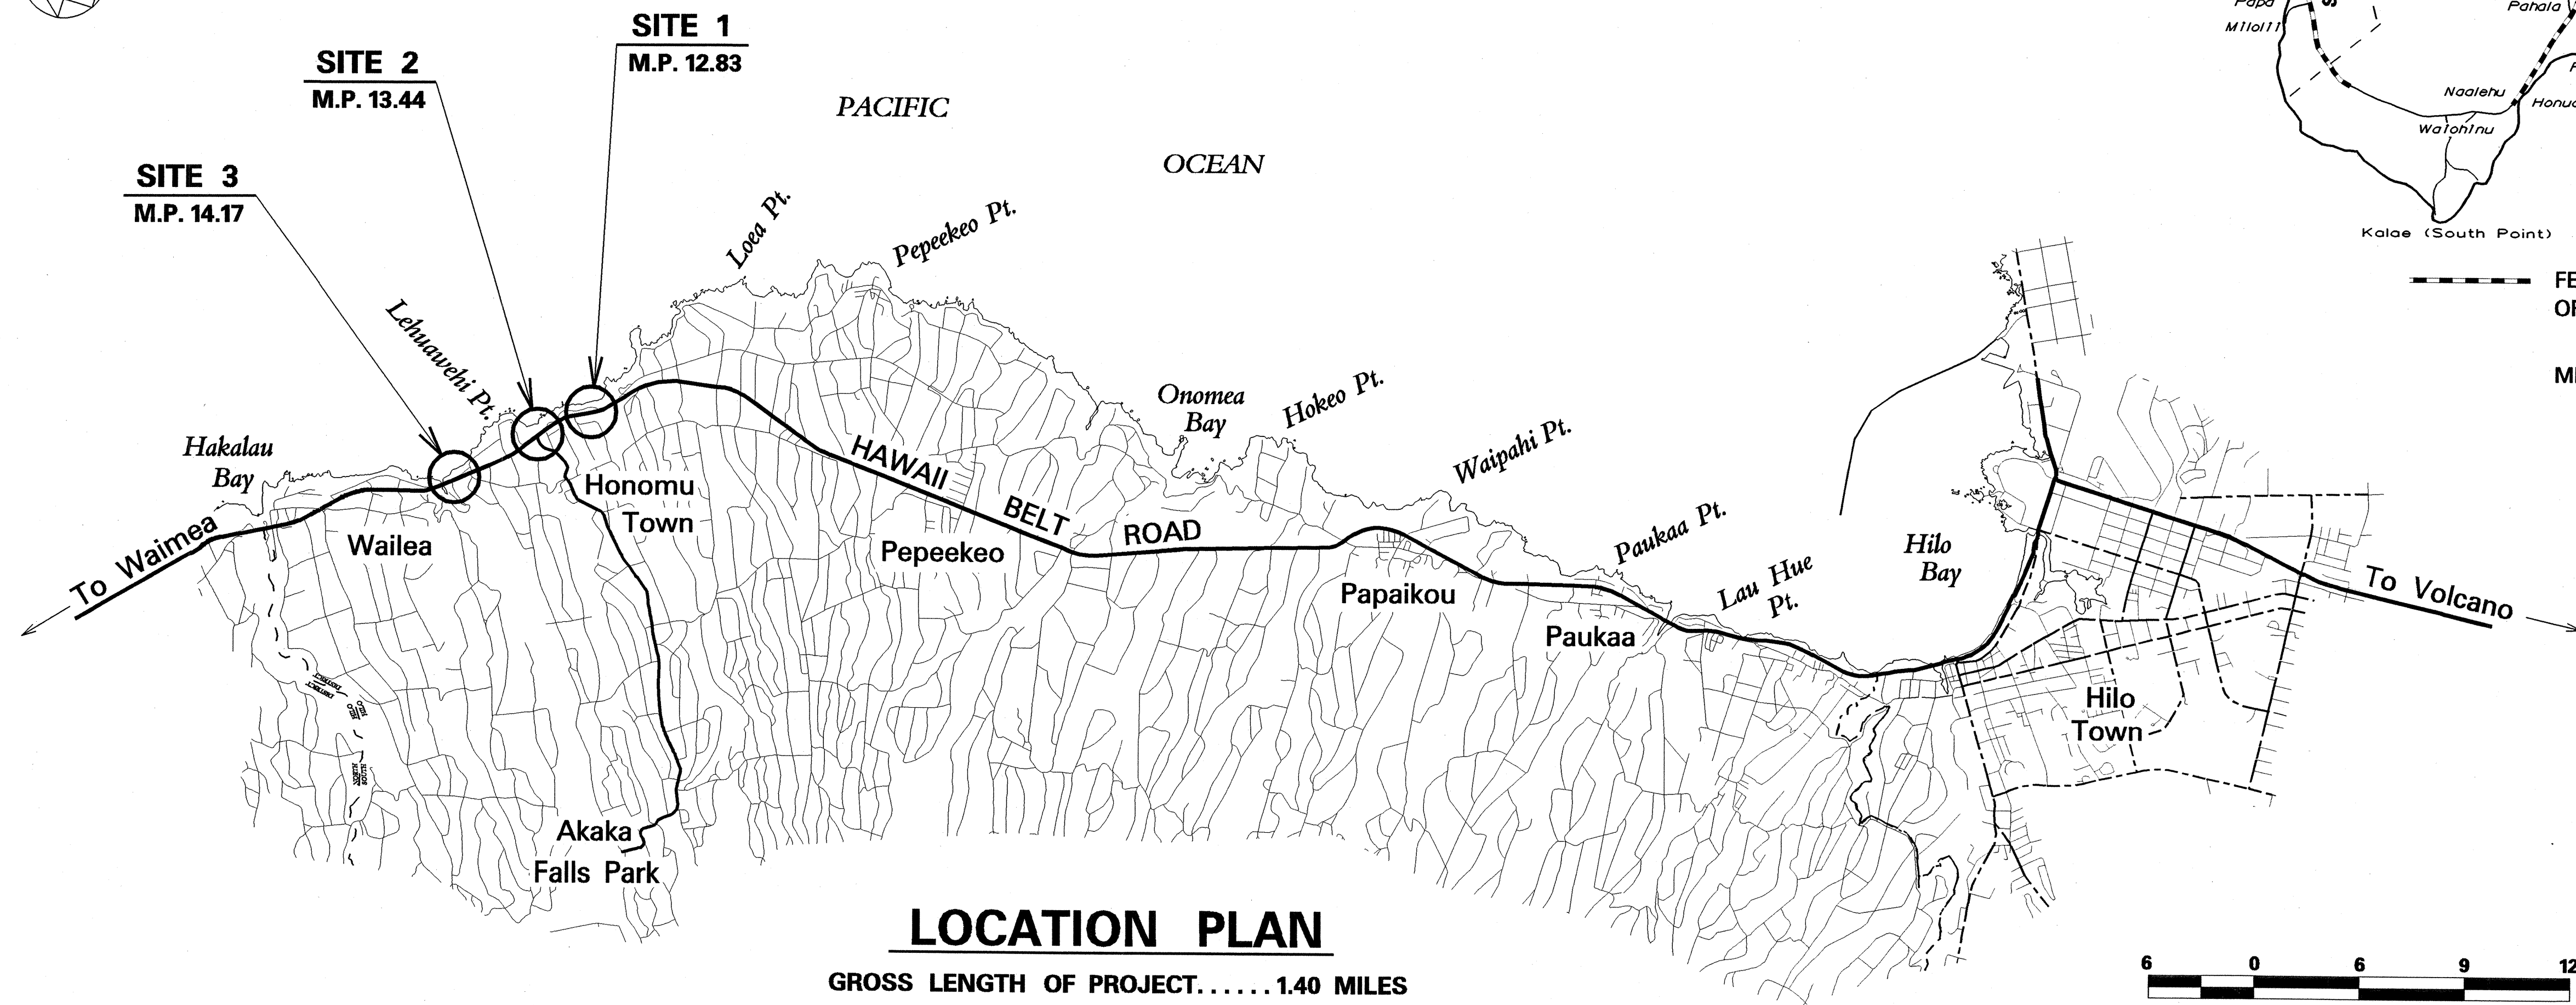
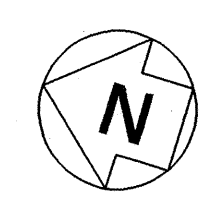
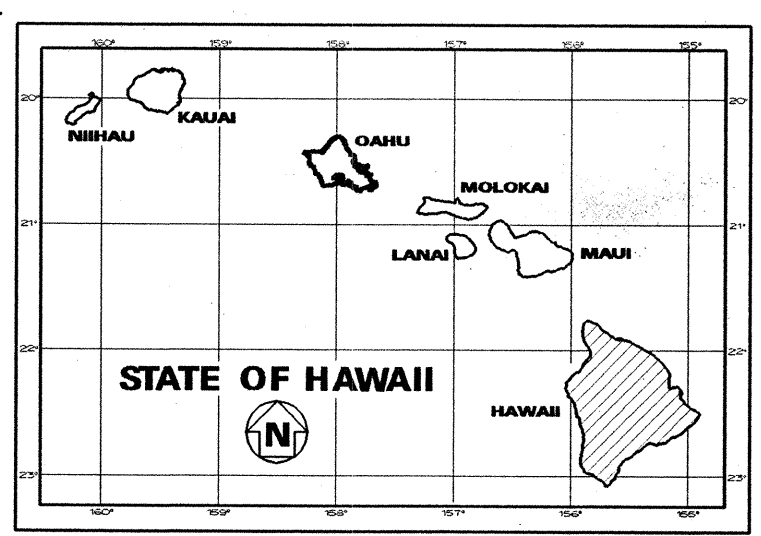


INDEX TO DRAWINGS	
SHEET NO.	DESCRIPTION
1	TITLE SHEET
2	STANDARD PLANS SUMMARY
3	GENERAL NOTES
4-5	WATER POLLUTION AND EROSION CONTROL NOTES
6	SLOPE SCALING NOTES
7	DETAILED PLAN SITE 1
8	DETAILS-SITE 1
9-13	CROSS SECTIONS SITE 1
14 ①	DETAILED PLAN SITE 2
15	DETAILS-SITE 2
16-20	CROSS SECTIONS SITE 2
21	DETAILED PLAN SITE 3
22-23	CROSS SECTIONS SITE 3
24	CONSTRUCTION SIGN PLAN AND SCHEDULE

Sheet No. ① 14 S-1 is a supplemental sheet to this project. Total sheet count after "As-Built" posting is 25 sheets.

STATE OF HAWAII
DEPARTMENT OF TRANSPORTATION
HIGHWAYS DIVISION
HONOLULU, HAWAII
"AS-BUILT"
PLANS FOR
HAWAII BELT ROAD
FLOOD DAMAGE REPAIRS
VICINITY OF HONOMU
PROJECT NO. 19J-01-03M
DISTRICT OF SOUTH HILO
ISLAND OF HAWAII


FED. ROAD DIST. NO.	STATE	PROJ. NO.	FISCAL YEAR	SHEET NO.	TOTAL SHEETS
HAWAII	HAW.	19J-01-03M	2003	1	24

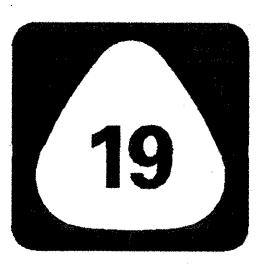

--- FEDERAL AID PROJECTS PREVIOUSLY CONSTRUCTED OR UNDER CONSTRUCTION

MILE POST 12.80 TO MILE POST 14.20

CHANGES MADE DURING CONSTRUCTION HAVE BEEN INCORPORATED ON THESE PLANS EXCEPT CHANGES IN THE ORIGINAL THEORETICAL QUANTITIES. FOR ACTUAL QUANTITIES, REFER TO PROJECT LEADER AND/OR COMPUTER RECORD.
John J. L. Orr 3-31-05
PROJECT ENGINEER DATE

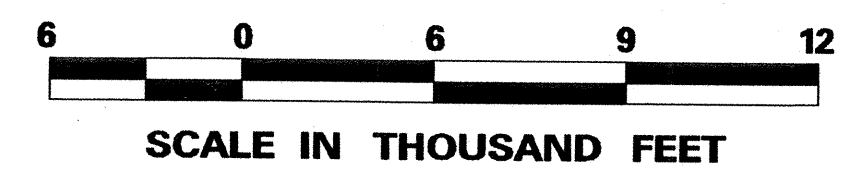

LOCATION PLAN

GROSS LENGTH OF PROJECT.....1.40 MILES
NET LENGTH OF PROJECT.....0.07 MILES

HAWAII DISTRICT DESIGNED BY
ROBERT TAIRA
P. S. & E. BY
933-8866
PHONE
APRIL, 2003
DATE

DEPARTMENT OF TRANSPORTATION STATE OF HAWAII	
APPROVED:	
<u>John M. Fong</u>	3-21-03
DIR. OF TRANSPORTATION	DATE