

<u>LEGEND FOR AS-BUILT POSTING</u>	
	Squiggly line for as-built deletion
	Double line for as-built deletion
Roadway	Text for as-built posting

STATE OF HAWAII
DEPARTMENT OF TRANSPORTATION
HIGHWAYS DIVISION

QUEEN KAAHUMANU HIGHWAY
Resurfacing and Intersection Improvements
Federal-Aid Project No. NH-019-1(35)
Scale: As Noted Date: March 2004

SHEET No. **C-33** OF **68** SHEETS

This work was prepared by me or under my supervision.

Chad M. McDermott
4/30/2011
MITSUBISHI & ASSOCIATES, INC. EYE




NOTE: Contractor to check and verify dimensions at job before proceeding with work.

10' 5' 0 10' 20'

0 SCALE: 1" = 10'

"AS-BUILT"


FED. ROAD DIST. NO.	STATE	FED. AID PROJ. NO.	FISCAL YEAR	SHEET NO.	TOTAL SHEETS
HAWAII	HAWAII	NH-019-1(35)	2004	C.O. 36	70

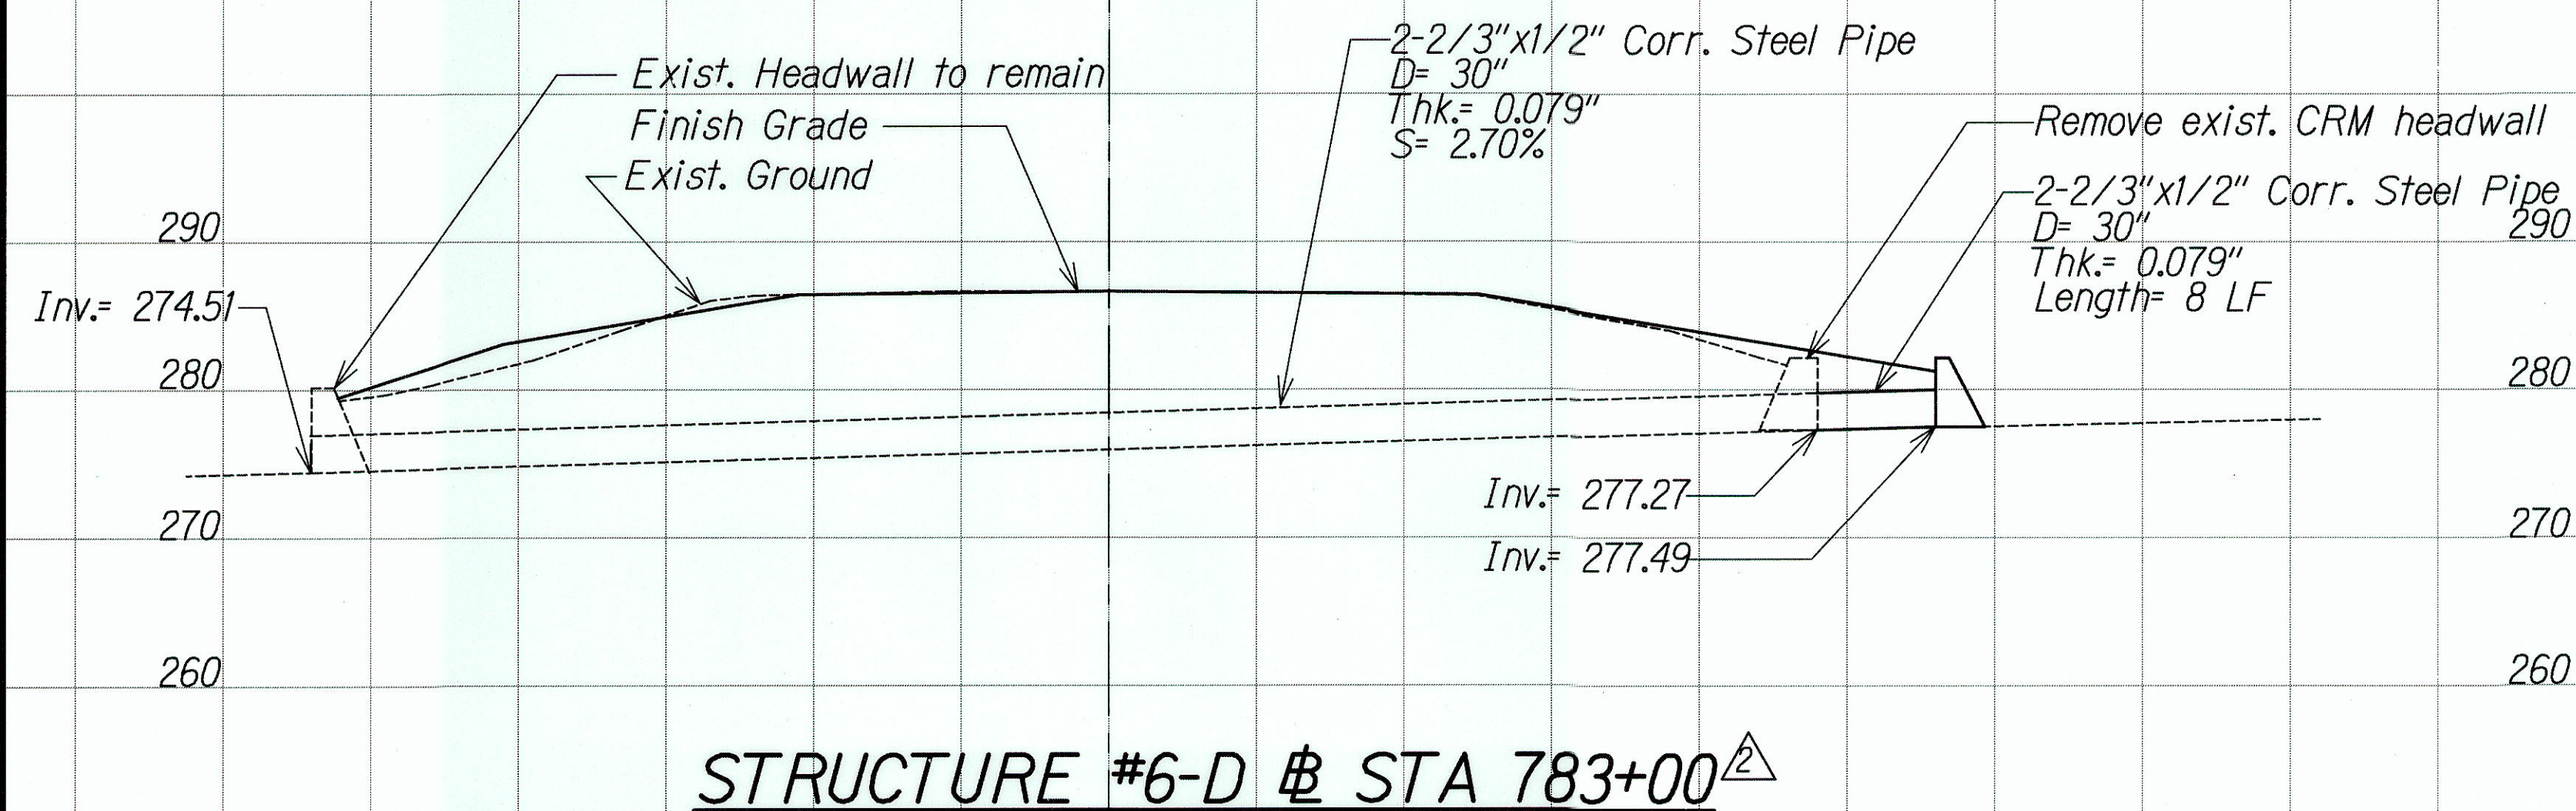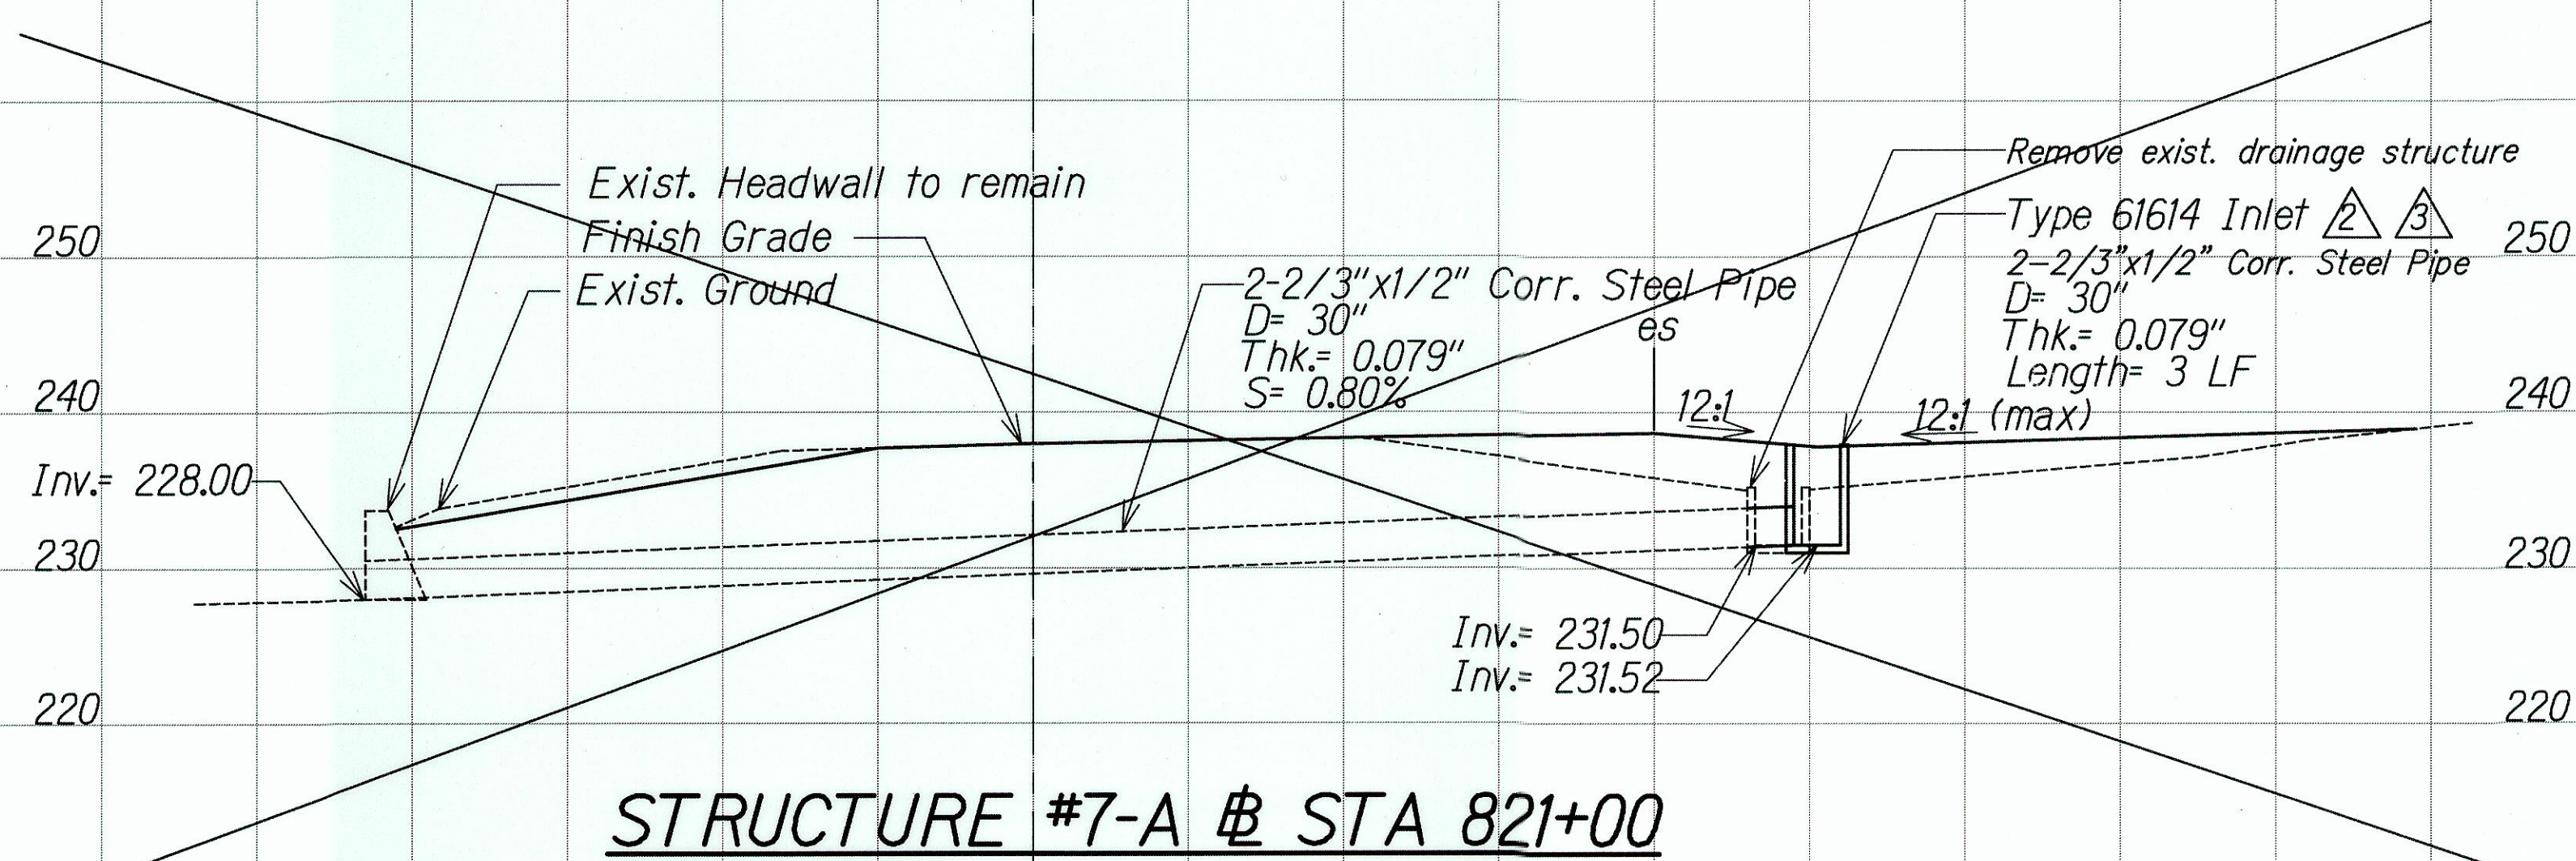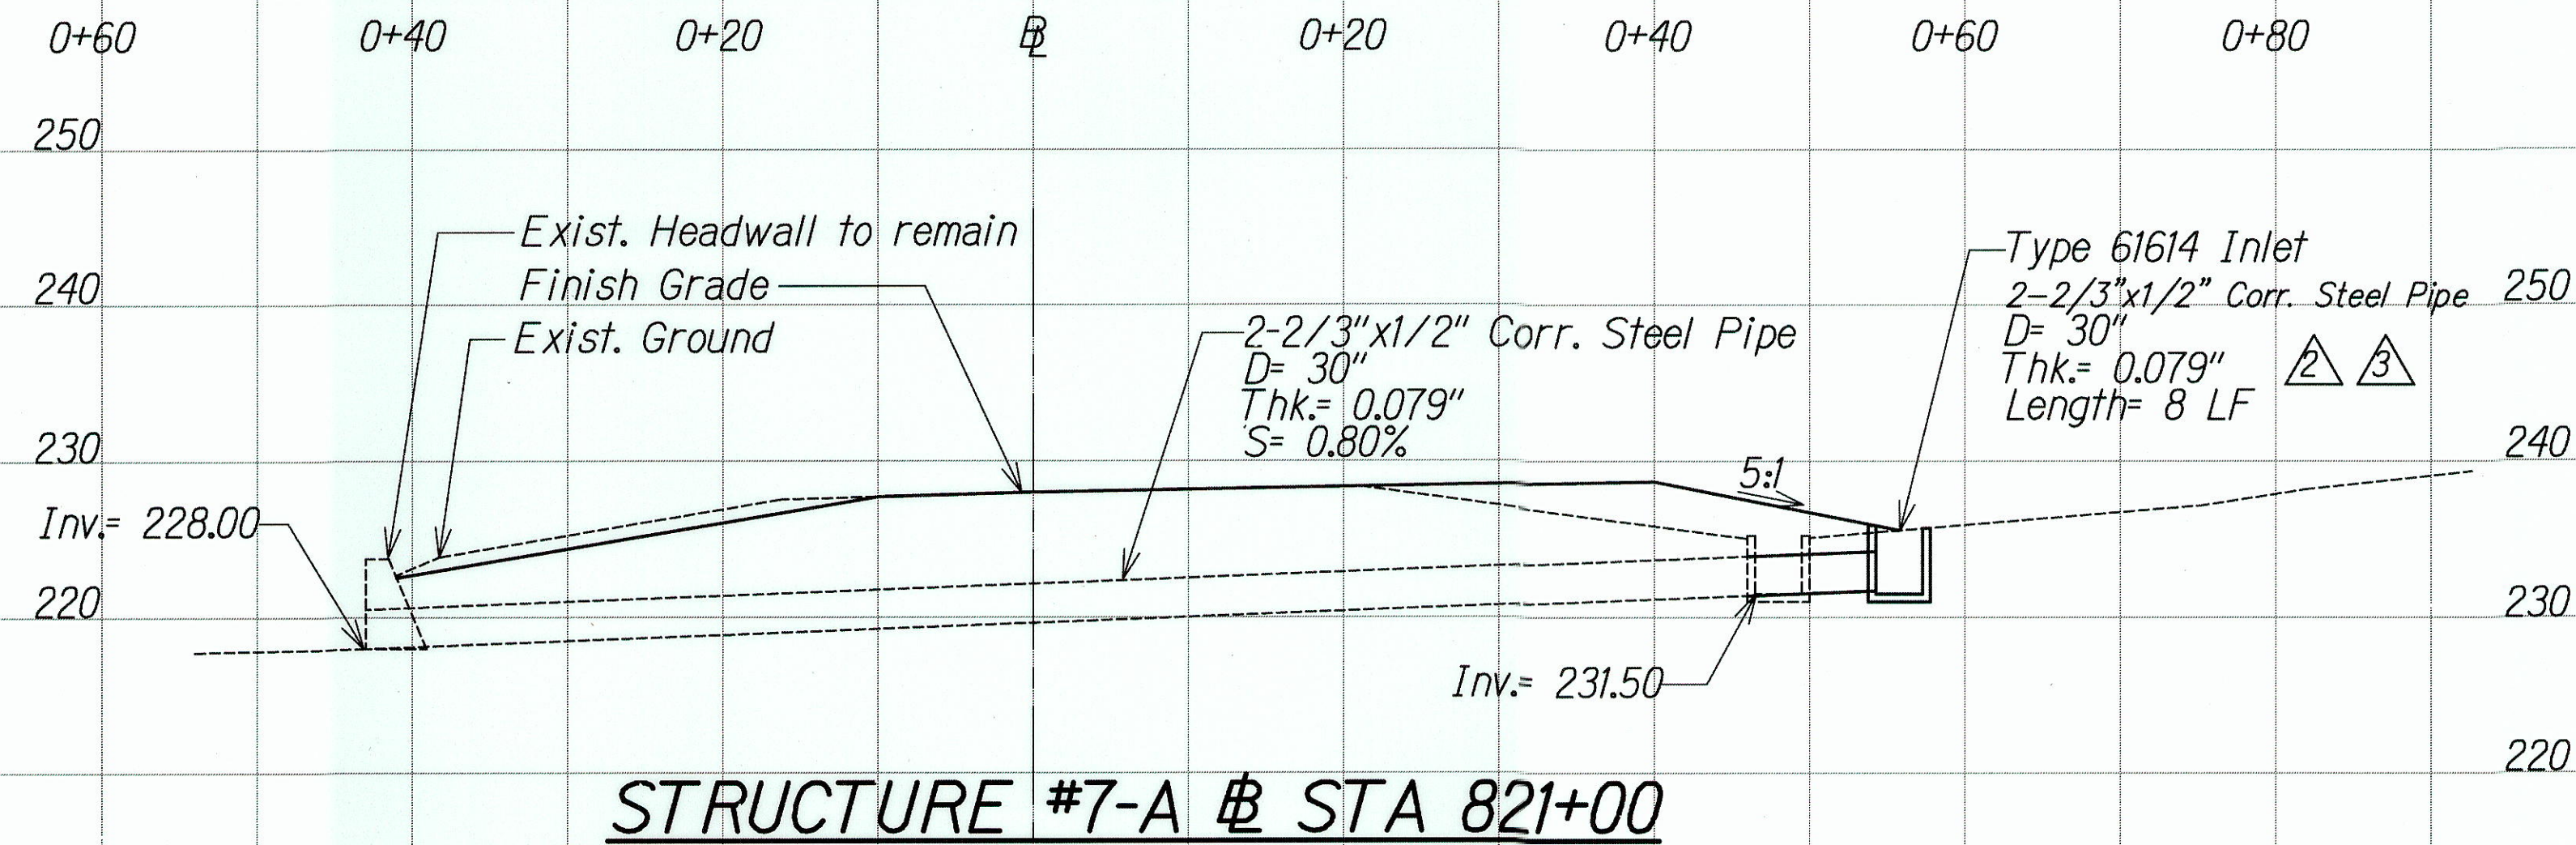

LEGEND FOR AS-BUILT POSTING	
	Squiggly line for as-built deletion
	Double line for as-built deletion
	Text for as-built posting

DATE	REVISION
8/17/06	3 Culvert Inlet Revised (Sta 821+00)
12/30/04	2 Culvert Added & Length Revised


STATE OF HAWAII DEPARTMENT OF TRANSPORTATION HIGHWAYS DIVISION	
CULVERT SECTIONS - 2	
QUEEN KAAHUMANU HIGHWAY Resurfacing and Intersection Improvements Federal-Aid Project No. NH-019-1(35) Scale: As Noted Date: March 2004	
SHEET No. C-34 OF 68 SHEETS	

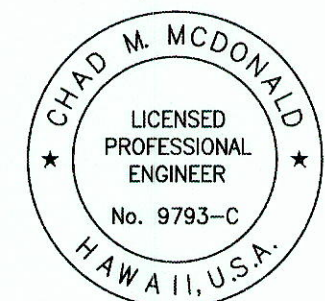

This work was prepared by me or under my supervision

Chad M. McDonald
4/30/2012
MITSUNAGA & ASSOCIATES, INC. EXP. DATE

NOTE: Contractor to check and verify dimensions of job before proceeding with work.

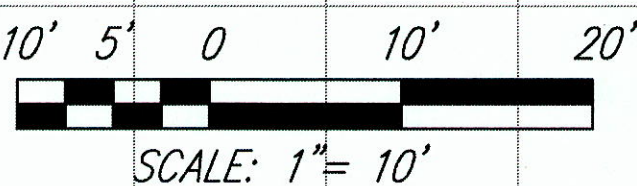

"AS-BUILT"

C.O. 36

ORIGINAL PLAN	DATE
NOTE BOOK	DESIGNED BY
QUANTITIES BY	CHECKED BY
NO.	