

FED. ROAD DIST. NO.	STATE	FED. AID PROJ. NO.	FISCAL YEAR	SHEET NO.	TOTAL SHEETS
HAWAII	HAWAII	NH-019-1(35)	2004	C.O. 30	70

STRIPING AND PAVEMENT MARKING SCHEDULE																							
STATION	TRAFFIC REGIME		THERMOPLASTIC EXTRUSION (lin. ft.)														PAVEMENT MARKERS (EACH)						
	LEFT	RIGHT	4" Double Yellow	4" Yellow Guidelines	4" Yellow C	12" Yellow Diagonal	4" White E.P./lane Stripe	4" White Stripe	8" White Stripe	12" White Diagonal	4" White Guide Lines	12" Stop Bar	Yield Line	SOLID WHITE ARROW				BIKE ROUTE MARKING W/4" WHITE STRIPE	A	C	D	H	J
														Left	Straight	Right	Slant Merge Arrow						
258+00	P	P					15,504													388	194		776
335+52	P	N			534		1,068													28	14	14	56
340+86	P	P					1,112													28	14		52
346+42	N	P			305		610													16	8	8	32
349+47	Kakaha Kai State Park		10,786			1,900	11,166	4,075	320	120	500	24	16	6	8	3	20	5	408	462	25	471	
400+80																							
780+00	Scenic Lookout		10,745			2,681	14,201	2,680	526	30	595	24	2	4	7	4	10	5	240	442	12	540	
835+00			10,900			3,022	11,020		510	40	500		16						250	404	13	643	
TOTALS			10,745	--	839	2,681	14,201	6,755	526	30	505	526	2	4	7	4	10	10	240	442	12	540	
CONTRACT ITEM NUMBER			23 629.10#3			27 629.10#7	22 629.10#2		24 629.10#4	26 629.10#6	20 629.10#0	24 629.10#6	25 629.10#5	31 629.10#0	31 629.10#0	31 629.10#0	31 629.10#0		12 629.20#0	32 629.20#0	42 629.20#0	72 629.20#0	

LEGEND FOR AS-BUILT POSTING
~~~~~ Squiggly line for as-built deletion  
=00.00= Double line for as-built deletion  
Roadway Text for as-built posting

|                   |      |
|-------------------|------|
| SURVEY PLOTTED BY | DATE |
| DESIGNED BY       | 3/04 |
| QUANTITIES BY     | 3/04 |
| CHECKED BY        | 3/04 |



This work was prepared by me or under my supervision

Chad M. McDonald  
4/30/2012  
MITSUNAGA & ASSOCIATES, INC. EXP. DATE

NOTE: Contractor to check and verify dimensions at job before proceeding with work.

|                                                                                                                                                                                                                                                                           |                    |
|---------------------------------------------------------------------------------------------------------------------------------------------------------------------------------------------------------------------------------------------------------------------------|--------------------|
| 12/30/04                                                                                                                                                                                                                                                                  | 2 Schedule Revised |
| DATE                                                                                                                                                                                                                                                                      | REVISION           |
| STATE OF HAWAII<br>DEPARTMENT OF TRANSPORTATION<br>HIGHWAYS DIVISION<br><b>STRIPING AND PAVEMENT MARKING SCHEDULE</b><br>QUEEN KAAHUMANU HIGHWAY<br>Resurfacing and Intersection Improvements<br>Federal-Aid Project No. NH-019-1(35)<br>Scale: As Noted Date: March 2004 |                    |
| SHEET No. C-28 OF 68 SHEETS                                                                                                                                                                                                                                               |                    |



| FED. ROAD DIST. NO. | STATE  | FED. AID PROJ. NO. | FISCAL YEAR | SHEET NO. | TOTAL SHEETS |
|---------------------|--------|--------------------|-------------|-----------|--------------|
| HAWAII              | HAWAII | NH-019-1(35)       | 2004        | 31        | 70           |

SIGN REPLACEMENT, REMOVAL, AND INSTALLATION SCHEDULE

| STATION | LEFT | RIGHT | MILE POST | TYPE                                                                       | SIGN TO REMAIN | REMOVE | INSTALL (10 SQ. FT. OR LESS) |         | INSTALL (GREATER THAN 10 SQ. FT.) |         | DESTINATION SIGN PANEL (S.F.) | RW-4 W/O POST (BI-Dir) | REMARKS        |
|---------|------|-------|-----------|----------------------------------------------------------------------------|----------------|--------|------------------------------|---------|-----------------------------------|---------|-------------------------------|------------------------|----------------|
|         |      |       |           |                                                                            |                |        | W/POST                       | WO/POST | W/POST                            | WO/POST |                               |                        |                |
| 262+86  | ●    |       | 92.46     | "AIRPORT 1/2 MILE"                                                         |                | 1      |                              |         |                                   |         | 17.00                         |                        | Match Existing |
| 287+06  | ●    |       | 92.00     | "AIRPORT 1 MILE"                                                           |                | 1      |                              |         |                                   |         | 16.00                         |                        | Match Existing |
| 339+64  | ●    |       | 91.00     | "ADOPT A HIGHWAY/<br>LITTER CONTROL NEXT 2 MILES/<br>LIT. BUGS HELCO EMP." |                | 2      |                              | 1       | 1                                 |         |                               |                        | Match Existing |
| 339+69  |      | ●     | 91.00     | "ADOPT A HIGHWAY/<br>LITTER CONTROL NEXT 2 MILES/<br>STARBUCKS"            |                | 2      |                              | 1       | 1                                 |         |                               |                        | Match Existing |
| 350+50  | ●    | ●     | 90.80     | R2-1(55) (24"x30")                                                         |                | 1      | 1                            |         |                                   |         |                               |                        |                |
| 352+20  |      | ●     | 90.77     | W2-2 (30"x30")                                                             |                |        | 1                            |         |                                   |         |                               |                        |                |
| 358+41  | ●    |       | 90.65     | R4-1 (24"x30")<br>W14-3 (36"x48"x48")                                      |                | 2      |                              |         |                                   |         |                               |                        |                |
| 358+41  |      | ●     | 90.65     | R4-2 (24"x30")                                                             |                | 1      |                              |         |                                   |         |                               |                        |                |
| 362+00  |      | ●     | 90.58     | "KEKAHA KAI STATE PARK/<br>SHORELINE PUB ACCESS"                           |                | 3      | 1                            |         |                                   |         | 16.67                         |                        | Match Existing |
| 364+03  |      | ●     | 90.54     | W2-2 (30"x30")<br>W13-1(45) (24"x24")                                      |                | 2      |                              |         |                                   |         |                               |                        |                |
| 370+14  | ●    |       | 90.43     | R1-1 (30"x30")                                                             |                | 1      |                              |         |                                   |         |                               |                        |                |
| 371+65  | ●    |       | 90.40     | W11-1 (30"x30")                                                            |                |        | 1                            |         |                                   |         |                               |                        |                |
| 371+80  | ●    |       | 90.40     | R1-1 (30"x30")                                                             |                |        | 1                            |         |                                   |         |                               | 1                      |                |
| 372+50  | ●    |       | 90.39     | R1-2 (36"x36")                                                             |                |        | 1                            |         |                                   |         |                               |                        |                |
| 374+68  | ●    |       | 90.34     | "KEKAHA KAI STATE PARK/<br>SHORELINE PUB ACCESS"<br>M6-1 (21"x15")         |                | 3      |                              |         |                                   |         |                               |                        |                |
| 376+65  | ●    |       | 90.30     | W2-2 (30"x30")<br>W13-1(45) (24"x24")                                      |                | 2      |                              |         |                                   |         |                               |                        |                |
| 380+40  | ●    |       | 90.23     | R4-1 (24"x30")                                                             |                | 1      |                              |         |                                   |         |                               |                        |                |
| 380+40  |      | ●     | 90.23     | R4-2 (24"x30")<br>W14-3 (36"x48"x48")                                      |                | 2      |                              |         |                                   |         |                               |                        |                |
| 380+50  | ●    |       | 90.23     | W11-1 (30"x30")<br>W16-1 (24"x24")                                         |                |        | 1                            | 1       |                                   |         |                               |                        |                |
| 384+00  | ●    |       | 90.15     | "KEKAHA KAI STATE PARK/<br>SHORELINE PUB ACCESS"                           |                |        | 1                            |         |                                   |         | 16.25                         |                        | Match Existing |
| 386+00  | ●    |       | 90.11     | W2-2 (30"x30")                                                             |                |        | 1                            |         |                                   |         |                               |                        |                |

Note:

Reflector Markers (RM-3) shall be provided on all new and existing (to remain) sign posts. The Engineer will consider the cost as included in the price of the various contract items.

LEGEND FOR AS-BUILT POSTING

Squiggly line for as-built deletion  
Double line for as-built deletion  
Roadway Text for as-built posting

|                   |        |
|-------------------|--------|
| SURVEY PLOTTED BY | DATE   |
| PLAN              | 3/2/04 |
| DESIGNED BY       | 3/2/04 |
| QUANTITIES BY     | 3/2/04 |
| CHECKED BY        | 3/2/04 |



This work was prepared by me or under my supervision

Chad M. McDonald  
4/30/2012  
MITSUNAGA & ASSOCIATES, INC. EXP. DATE

NOTE: Contractor to check and verify dimensions at job before proceeding with work.

DATE REVISION

STATE OF HAWAII  
DEPARTMENT OF TRANSPORTATION  
HIGHWAYS DIVISION  
**SIGN REPLACEMENT, REMOVAL  
AND INSTALLATION SCHEDULE - 1**  
QUEEN KAAHUMANU HIGHWAY  
Resurfacing and Intersection Improvements  
Federal-Aid Project No. NH-019-1(35)  
Scale: As Noted Date: March 2004  
SHEET No. C-29 OF 68 SHEETS


"AS-BUILT"



| SIGN REPLACEMENT, REMOVAL, AND INSTALLATION SCHEDULE |      |       |           |                                                                  |                |                            |                              |                           |                                   |         |                                   |                           |                                  |
|------------------------------------------------------|------|-------|-----------|------------------------------------------------------------------|----------------|----------------------------|------------------------------|---------------------------|-----------------------------------|---------|-----------------------------------|---------------------------|----------------------------------|
| STATION                                              | LEFT | RIGHT | MILE POST | TYPE                                                             | SIGN TO REMAIN | REMOVE                     | INSTALL (10 SQ. FT. OR LESS) |                           | INSTALL (GREATER THAN 10 SQ. FT.) |         | DESTINATION SIGN PANEL (S.F.)     | RM-4 W/O POST (Bt-Dlr)    | REMARKS                          |
|                                                      |      |       |           |                                                                  |                |                            | W/POST                       | WO/POST                   | W/POST                            | WO/POST |                                   |                           |                                  |
| 787+00                                               |      | ●     | 82.52     | W2-2 (30"x30")                                                   |                |                            | 1                            |                           |                                   |         |                                   |                           |                                  |
| 787+89                                               |      | ●     | 82.51     | "DRY AREA PREVENT FIRES"                                         | 1              |                            |                              |                           |                                   |         |                                   |                           |                                  |
| 796+05                                               |      | ●     | 82.36     | "DRY AREA PREVENT FIRES"<br>"EMERGENCY PHONE"<br>D9-1B (24"x30") |                | 3                          |                              |                           |                                   |         |                                   |                           |                                  |
| 797+50                                               |      | ●     | 82.33     | "EMERGENCY PHONE"<br>D9-1B (24"x30")                             |                |                            | 1                            | 1                         |                                   |         |                                   |                           |                                  |
| 800+00                                               |      | ●     | 82.28     | "SCENIC POINT"                                                   |                |                            |                              |                           |                                   |         | 19.50                             |                           | Match Existing                   |
| 804+85                                               |      | ●     | 82.19     | "SCENIC POINT"                                                   |                | 1                          |                              |                           |                                   |         |                                   |                           |                                  |
| 808+00                                               |      | ●     | 82.06     | "EMERGENCY PHONE"<br>D9-1A (24"x30")                             |                |                            | 1                            | 1                         |                                   |         |                                   |                           |                                  |
| 808+35                                               |      | ●     | 82.05     | "EMERGENCY PHONE"<br>D9-1A (24"x30")                             |                | 2                          |                              |                           |                                   |         |                                   |                           |                                  |
| 808+60                                               | ●    |       | 82.05     | R1-1 (30"x30")                                                   |                | 1                          |                              |                           |                                   |         |                                   |                           |                                  |
| 809+93                                               | ●    |       | 82.02     | ACCESS AISLE R7-94A (12"x18")<br>R7-201a-E (6"x12")              |                |                            | 1                            | 1                         |                                   |         |                                   |                           | Access Aisle/<br>Tow Signage     |
| 810+02                                               | ●    |       | 82.02     | R7-86E (12"x18")<br>R7-201a-E (6"x12")                           |                |                            | 1                            | 1                         |                                   |         |                                   |                           | ISA Res. Parking/<br>Tow Signage |
| 810+62                                               | ●    |       | 82.01     | R1-1 (30"x30")                                                   |                |                            | 1                            |                           |                                   |         |                                   | 1                         |                                  |
| 810+75                                               | ●    |       | 82.01     | R1-1 (30"x30")                                                   |                | 1                          |                              |                           |                                   |         |                                   |                           |                                  |
| 811+04                                               | ●    |       | 82.00     | R5-2 (24"x24")<br>"NO TRUCKS" (24"x18")                          |                |                            | 1                            | 1                         |                                   |         |                                   |                           |                                  |
| 811+10                                               | ●    |       | 82.00     | R1-2 (36"x36")                                                   |                |                            | 1                            |                           |                                   |         |                                   |                           |                                  |
| 811+45                                               | ●    |       | 81.99     | "EMERGENCY PHONE"<br>D9-1A (24"x30")                             | 1              |                            |                              |                           |                                   |         |                                   |                           |                                  |
| 814+32                                               | ●    |       | 81.94     | D10-5 (12"x36")                                                  | 1              |                            |                              |                           |                                   |         |                                   |                           |                                  |
| 815+45                                               | ●    |       | 81.92     | "SCENIC POINT"                                                   | 1              |                            |                              |                           |                                   |         |                                   |                           |                                  |
| 820+00                                               | ●    |       | 81.83     | W11-1 (30"x30")<br>W16-1 (24"x24")                               |                |                            | 1                            | 1                         |                                   |         |                                   |                           |                                  |
| 823+00                                               | ●    |       | 81.77     | W2-2 (30"x30")                                                   |                |                            | 1                            |                           |                                   |         |                                   |                           |                                  |
| 823+70                                               | ●    |       | 81.76     | "EMERGENCY PHONE"<br>D9-1B (24"x30")                             | 1              |                            |                              |                           |                                   |         |                                   |                           |                                  |
|                                                      |      |       |           |                                                                  |                |                            |                              |                           |                                   |         |                                   |                           |                                  |
| TOTALS                                               |      |       |           |                                                                  | 5              | <del>32</del> <sup>8</sup> | <del>19</del> <sup>10</sup>  | <del>9</del> <sup>6</sup> | <del>2</del> <sup>0</sup>         | --      | <del>65.92</del> <sup>19.50</sup> | <del>2</del> <sup>1</sup> |                                  |
| CONTRACT ITEM NUMBER                                 |      |       |           |                                                                  |                |                            | 621.5100                     | 621.5000                  | 621.5300                          |         | 621.0200                          | 621.4040                  |                                  |

Reflector Markers (RM-3) shall be provided on all new and existing (to remain) sign posts. The Engineer will consider the cost as included in the price of the various contract items.

|                                                                                     |                                            |
|-------------------------------------------------------------------------------------|--------------------------------------------|
|  | <i>Squiggly line for as-built deletion</i> |
|  | <i>Double line for as-built deletion</i>   |
| <b>Roadway</b>                                                                      | <i>Text for as-built posting</i>           |



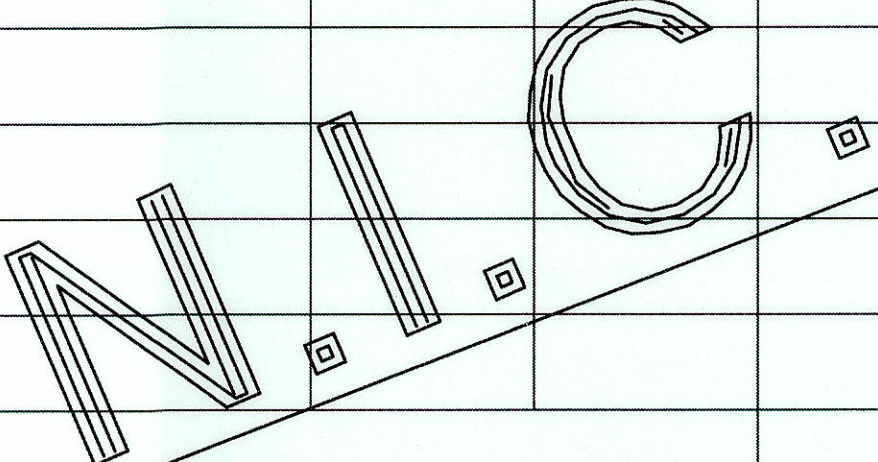
Chia M. McDermott  
4/30/2010  
MITSUNAGA & ASSOCIATES, INC. EXP. D.

NOTE: Contractor to check and verify dimensions at job before proceeding with work.

## "AS-BUILT"



| FED. ROAD DIST. NO. | STATE  | FED. AID PROJ. NO. | FISCAL YEAR | SHEET NO. | TOTAL SHEETS |
|---------------------|--------|--------------------|-------------|-----------|--------------|
| HAWAII              | HAWAII | NH-019-1(35)       | 2004        | C.O. 33   | 70           |

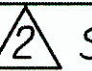
| MILEPOST MARKER SCHEDULE                                                          |      |       |                                                          |                                   |                                  |                     |           |
|-----------------------------------------------------------------------------------|------|-------|----------------------------------------------------------|-----------------------------------|----------------------------------|---------------------|-----------|
| STATION                                                                           | LEFT | RIGHT | MILE POST<br>D10-2 (12"x27")<br>MILE POST NO. (RTE. NO.) | KILOMETER POST<br>D10-2 (12"x36") | INSTALL<br>WITH POST<br>(Bi-Dir) | RM-3<br>W/O<br>POST | REMARKS   |
| 287+07                                                                            | ●    |       | 92 (19)                                                  | 148                               | ●                                |                     |           |
| 339+87                                                                            | ●    |       | 91 (19)                                                  |                                   | ●                                |                     | Not Found |
| 392+57                                                                            | ●    |       | 90 (19)                                                  |                                   | ●                                |                     |           |
|  |      |       |                                                          |                                   |                                  |                     |           |
|                                                                                   |      |       |                                                          |                                   |                                  |                     |           |
| CONTRACT ITEM NO. 621.7610                                                        |      |       | TOTALS                                                   |                                   | 3                                |                     |           |

\* Contractor shall submit shop drawings of the kilometer-post sign to the Engineer for acceptance. Fabrication and installation of these signs shall be considered incidental to various sign items.

| LANE AND SHOULDER WIDTH SCHEDULE |                                   |                                                   |                              |                                   |                                 |
|----------------------------------|-----------------------------------|---------------------------------------------------|------------------------------|-----------------------------------|---------------------------------|
| Station                          | Intersection                      | Full Travel Width (Ft.)<br>(Thru/Auxiliary Lanes) | Average Shoulder Width (Ft.) | Mix IV Approx Area (Sf) Travelway | Mix V Approx Area (Sf) Shoulder |
| <del>258+00</del>                | NA                                | <del>24</del>                                     | <del>9</del>                 | <del>219,528</del>                | <del>164,646</del>              |
| <del>349+47</del>                | <del>Kekaha Kai State Park</del>  | <del>54</del>                                     | <del>9</del>                 | <del>237,355</del>                | <del>92,394</del>               |
| <del>400+80</del>                |                                   |                                                   |                              |                                   |                                 |
| 780+00                           | Scenic Lookout                    | 54                                                | 9                            | 237,377                           | 99,000                          |
| 835+00                           |                                   |                                                   |                              |                                   |                                 |
| <del>0+00</del>                  | <del>Kekaha Kai Access Road</del> | <del>24</del>                                     | <del>6-9</del>               | <del>10,405</del>                 | <del>4,170</del>                |
| <del>3+62.53</del>               |                                   |                                                   |                              |                                   |                                 |
| TOTALS                           |                                   |                                                   |                              | 237,377<br><del>704,665</del>     | 99,000<br><del>360,210</del>    |
| Contract Item Number             |                                   |                                                   |                              | 401.0400                          | 401.0501                        |

LEGEND FOR AS-BUILT POSTING  
~~~~~ Squiggly line for as-built deletion  
===== Double line for as-built deletion
Roadway Text for as-built posting

12/30/04

 Schedule Revised

DATE

REVISION

STATE OF HAWAII
DEPARTMENT OF TRANSPORTATION
HIGHWAYS DIVISION

**MISCELLANEOUS
SCHEDULES - 1**

QUEEN KAAHUMANU HIGHWAY
Resurfacing and Intersection Improvements
Federal-Aid Project No. NH-019-1(35)
Scale: As Noted Date: March 2004

SHEET No. C-31 OF 68 SHEETS



This work was prepared by me or under my supervision

Chad M. McDonald
4/30/2012
MITSUNAGA & ASSOCIATES, INC. EXP. DATE

NOTE: Contractor to check and verify dimensions of job before proceeding with work.

| FED. ROAD DIST. NO. | STATE | FED. AID PROJ. NO. | FISCAL YEAR | SHEET NO. | TOTAL SHEETS |
|---------------------|--------|--------------------|-------------|-----------|--------------|
| HAWAII | HAWAII | NH-019-1(35) | 2004 | 34 | 70 |

| REFLECTOR AND OBJECT MARKER SCHEDULE | | | | | | | | | | | | | | | |
|--------------------------------------|-------------------|------|-------|----------------------|---------------------------|---------------|---------------|---------------|---------------------------|---------------|---------------|---------------------------|------------------|---------------|----------------------------------|
| STATION | | LEFT | RIGHT | RM-2, Bi-dir (White) | | | RM-3 (Yellow) | | RM-3 (Bi-dir)
(Yellow) | | RM-4 (Bi-dir) | | TYPE II (Bi-dir) | | REMARKS |
| FROM | TO | | | STEEL
POST | FLEX
POST | W/OUT
POST | FLEX
POST | W/OUT
POST | FLEX
POST | W/OUT
POST | STEEL
POST | W/OUT
POST | FLEX
POST | W/OUT
POST | |
| | | | | | | | | | | | | | | | |
| 371+80 | 371+80 | ● | | | | | | | | | | 1 | | | Kekaha Kai State Park |
| 809+00 | 810+62 | ● | | | 9 | | | | | | | 1 | | | Scenic Lookout |
| | | | | | | | | | | | | | | | |
| | | | | | | | | | | | | | | | |
| | | | | | | | | | | | | | | | |
| TOTALS | | | | | 9 | -- | -- | -- | -- | -- | -- | 1
2 | -- | -- | |
| CONTRACT ITEM NUMBER | | | | | 60
621.4138 | | | | | | | 60
621.4040 | | | |

| CENTERLINE AND REFERENCE SURVEY MONUMENT SCHEDULE | | | | | |
|---|---------------|---|---|---|-----------------------|
| STATION | MONUMENT TYPE | CONSTRUCT NEW CENTERLINE AND REFERENCE MON. (ITEM NO. 613.0100)
0200 | RECONSTRUCT CENTERLINE AND REFERENCE MON. (ITEM NO. 613.0120) | STANDARD STREET SURVEY MONUMENT 0200
(ITEM NO. 614.0100) | REMARKS |
| 258+00 | POT | | | 1 | New |
| 271+00 | POT | | | 1 | New |
| 293+00 | POT | | | 1 | New |
| 311+65.51 | P.C. | | | 1 | New |
| 328+00 | POC | | | 1 | New |
| 344+00 | POC | | | 1 | New |
| 360+00 | POC | | | 1 | New |
| 372+00 | MON. | 1 | | | Kekaha Kai |
| 382+00 | POC | | | 1 | New |
| 796+00 | POT | --- | --- | 1 | New |
| 801+55.07 | P.C. | --- | --- | 1 | New |
| 810+00 | POC | --- | --- | 1 | New |
| 810+81.32 | MON. | 1 | --- | --- | Scenic Lookout |
| 820+00 | POC | --- | --- | 1 | New |
| 832+00 | POC | --- | --- | 1 | New |
| TOTALS | | 2 1 | --- | 12 5 | |

- NOTES:
1. THE CONTRACTOR SHALL INSTALL MONUMENTS PER SCHEDULE.
 2. THE ENGINEER WILL PROVIDE THE LOCATION OF THE SURVEY MONUMENT PRIOR TO INSTALLATION.

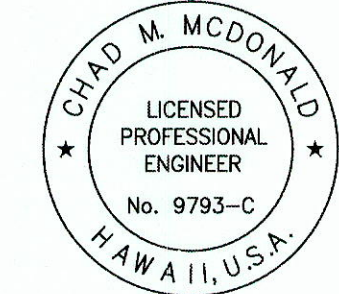
LEGEND FOR AS-BUILT POSTING

Squiggly line for as-built deletion

Double line for as-built deletion

Roadway Text for as-built posting

| | |
|-------------------|-----------|
| ORIGINAL PLAN | DATE |
| SURVEY PLOTTED BY | 4/30/2012 |
| DESIGNED BY | |
| QUANTITIES BY | |
| CHECKED BY | |



This work was prepared by me or under my supervision

Chad M. McDonald
MITSUNAGA & ASSOCIATES, INC. 4/30/2012
NOTE: Contractor to check and verify dimensions of job before proceeding with work.

| DATE | REVISION |
|---|----------|
| | |
| STATE OF HAWAII
DEPARTMENT OF TRANSPORTATION
HIGHWAYS DIVISION
MISCELLANEOUS SCHEDULES - 2
QUEEN KAAHUMANU HIGHWAY
Resurfacing and Intersection Improvements
Federal-Aid Project No. NH-019-1(35)
Scale: As Noted Date: March 2004
SHEET No. C-32 OF 68 SHEETS | |

"AS-BUILT"