


FED. ROAD DIST. NO.	STATE	FED. AID PROJ. NO.	FISCAL YEAR	SHEET NO.	TOTAL SHEETS
HAWAII	HAWAII	NH-019-1(35)	2004	C.O. 23	70

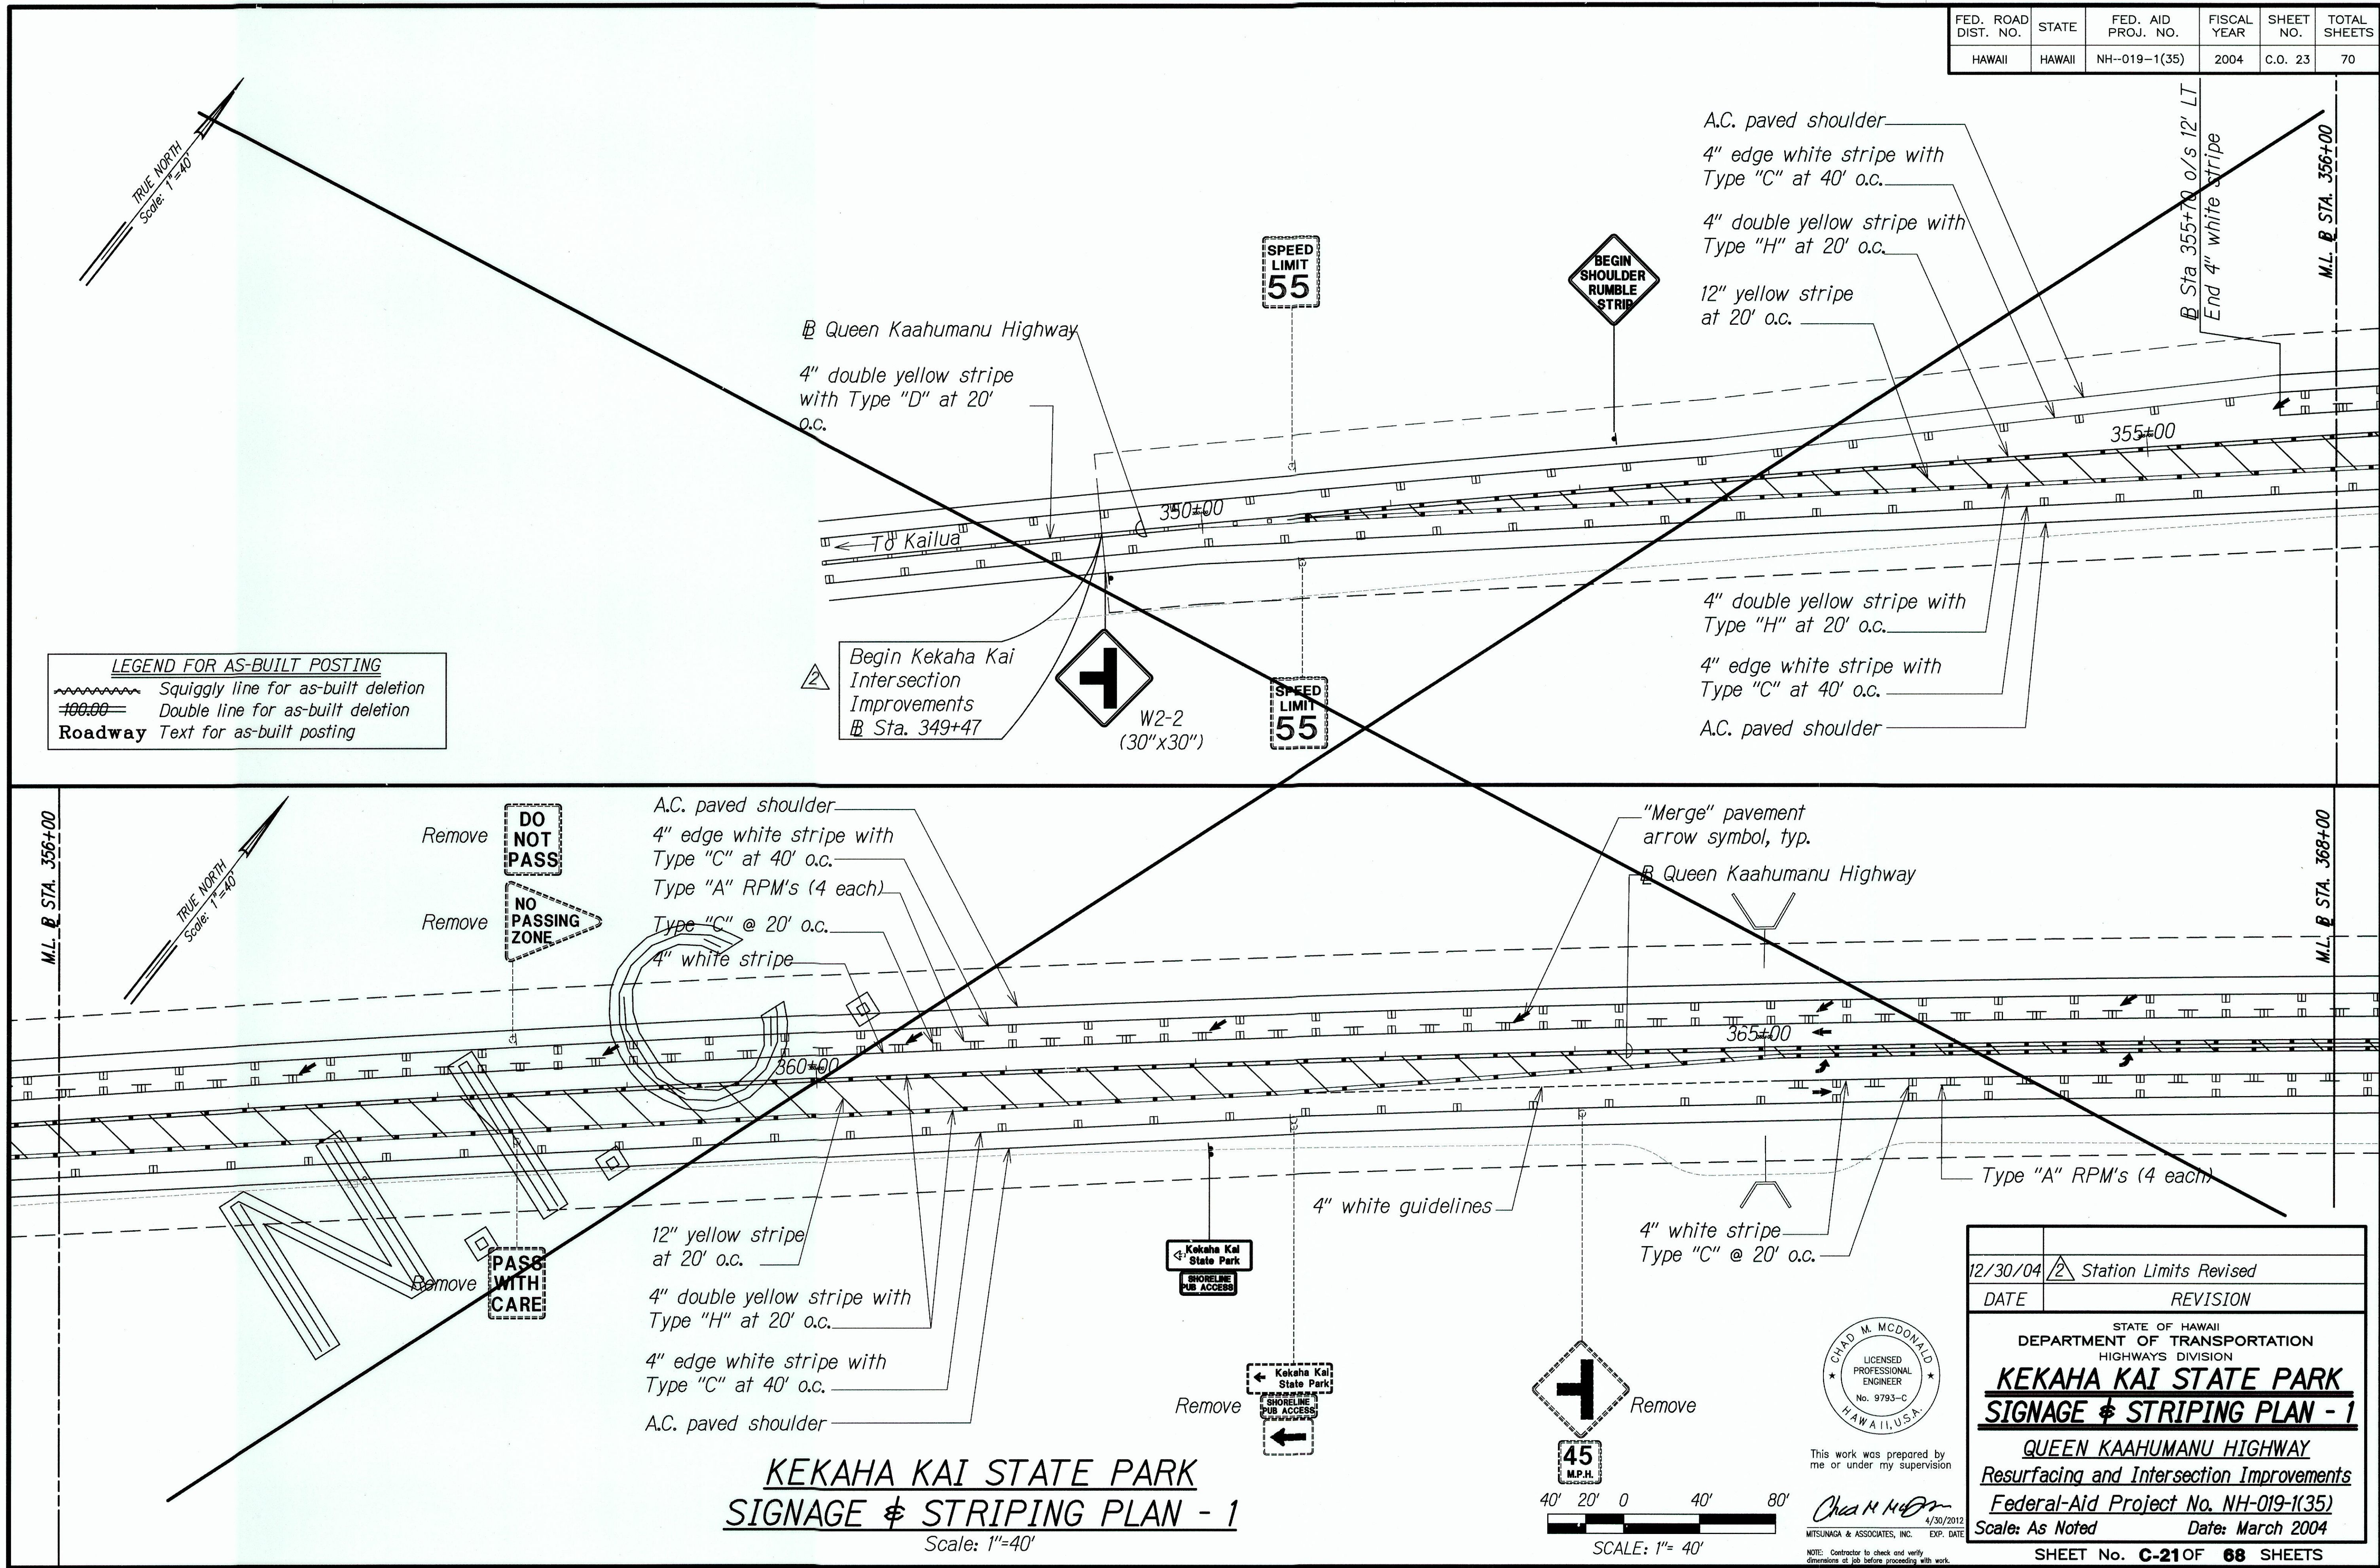

LEGEND FOR AS-BUILT POSTING


~~~~~ Squiggly line for as-built deletion

==== Double line for as-built deletion

Roadway Text for as-built posting

|                   |      |
|-------------------|------|
| SURVEY PLOTTED BY | DATE |
| DESIGNED BY       | 2/04 |
| NOTED BY          | 2/04 |
| CHECKED BY        | 2/04 |
| ORIGINAL PLAN     |      |
| NOTE BOOK         |      |
| QUANTITIES BY     |      |
| CHECKED BY        |      |
| No.               |      |

**KEKAHA KAI STATE PARK**  
**SIGNAGE & STRIPING PLAN - 1**  
 Scale: 1"=40'

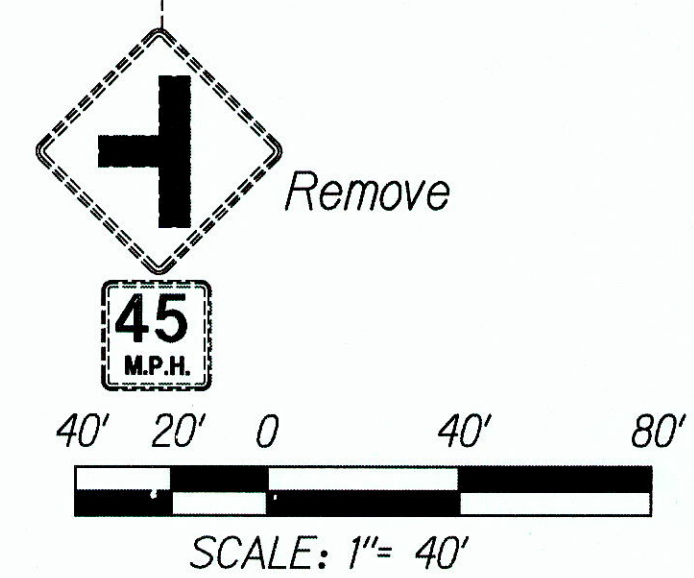

This work was prepared by me or under my supervision

*Chad M. McDonald*

4/30/2012

MITSUNAGA & ASSOCIATES, INC. EXP. DATE

NOTE: Contractor to check and verify dimensions of job before proceeding with work.

|          |                        |
|----------|------------------------|
| 12/30/04 | Station Limits Revised |
| DATE     | REVISION               |

STATE OF HAWAII  
 DEPARTMENT OF TRANSPORTATION  
 HIGHWAYS DIVISION

**KEKAHA KAI STATE PARK**  
**SIGNAGE & STRIPING PLAN - 1**

**QUEEN KAAHUMANU HIGHWAY**  
 Resurfacing and Intersection Improvements

Federal-Aid Project No. NH-019-1(35)  
 Scale: As Noted Date: March 2004

SHEET No. **C-21** OF **68** SHEETS

"AS-BUILT"

C.O. 23

C.O. 24

Scale: 1"=40'

This work was prepared by  
me or under my supervision

This work was prepared by  
me or under my supervision

*Chad M. McBratney*  
4/30/2011  
MITCHELL & ASSOCIATES, INC. EVD

NOTE: Contractor to check and verify dimensions at job before proceeding with work.

|          |                          |
|----------|--------------------------|
| 12/30/04 | ② Station Limits Revised |
| DATE     | REVISION                 |

STATE OF HAWAII  
DEPARTMENT OF TRANSPORTATION  
HIGHWAYS DIVISION

**KEKAHA KAI STATE PARK**  
**SIGNAGE & STRIPING PLAN - 2**

**QUEEN KAAHUMANU HIGHWAY**  
**Resurfacing and Intersection Improvements**  
**Federal-Aid Project No. NH-019-1(35)**

Scale: As Noted Date: March 2004

SHEET No. **C-220F** 68 SHEETS

| FED. ROAD DIST. NO. | STATE  | FED. AID PROJ. NO. | FISCAL YEAR | SHEET NO.  | TOTAL SHEETS |
|---------------------|--------|--------------------|-------------|------------|--------------|
| HAWAII              | HAWAII | NH-019-1(35)       | 2004        | C.O. 24S-1 | 70           |

M.L. & STA. 392+00

MILE  
9  
0  
19

Remove and replace

TRUE NORTH  
Scale: 1"=40'


A.C. paved shoulder

4" edge white stripe with Type "C" at 40' o.c.

4" double yellow stripe with Type "H" at 20' o.c.

12" yellow stripe at 20' o.c.

W2-2  
(30"x30")

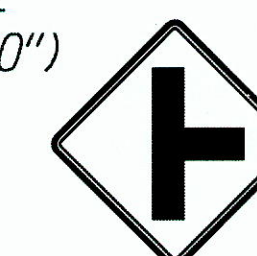

End Kekaha Kai Intersection Improvements @ Sta. 400+80



To Kawaihae

@ Queen Kaahumanu Highway

4" double yellow stripe with Type "H" at 20' o.c.

4" edge white stripe with Type "C" at 40' o.c.

A.C. paved shoulder

**LEGEND FOR AS-BUILT POSTING**

~~~~~ Squiggly line for as-built deletion  
~~=====~~ Double line for as-built deletion
Roadway Text for as-built posting

N I C

**KEKAHA KAI STATE PARK
SIGNAGE & STRIPING PLAN - 3**
Scale: 1"=40'

40' 20' 0 40' 80'
SCALE: 1"= 40'



This work was prepared by me or under my supervision

Chad M. McDonald
4/30/2012
MITSUNAGA & ASSOCIATES, INC. EXP. DATE

NOTE: Contractor to check and verify dimensions at job before proceeding with work.



| | |
|---|------------------------------------|
| 12/30/04 | Station Limits Revised/ Sht. added |
| DATE | REVISION |
| STATE OF HAWAII
DEPARTMENT OF TRANSPORTATION
HIGHWAYS DIVISION
KEKAHA KAI STATE PARK
SIGNAGE & STRIPING PLAN - 3
QUEEN KAAHUMANU HIGHWAY
Resurfacing and Intersection Improvements
Federal-Aid Project No. NH-019-1(35)
Scale: As Noted Date: March 2004
SHEET No. C-22 OF 68 SHEETS | |

"AS-BUILT"

C.O. 24S-1


| | |
|---------------|------------------|
| ORIGINAL PLAN | DATE |
| NOTE BOOK | 3/04 |
| DESIGNED BY | CHAD M. McDONALD |
| CHECKED BY | CHAD M. McDONALD |
| DATE | 3/04 |

| FED. ROAD DIST. NO. | STATE | FED. AID PROJ. NO. | FISCAL YEAR | SHEET NO. | TOTAL SHEETS |
|---------------------|-------|--------------------|-------------|-----------|--------------|
| HAWAII | HAW. | NH-019-1(35) | 2004 | C.O. 25 | 70 |

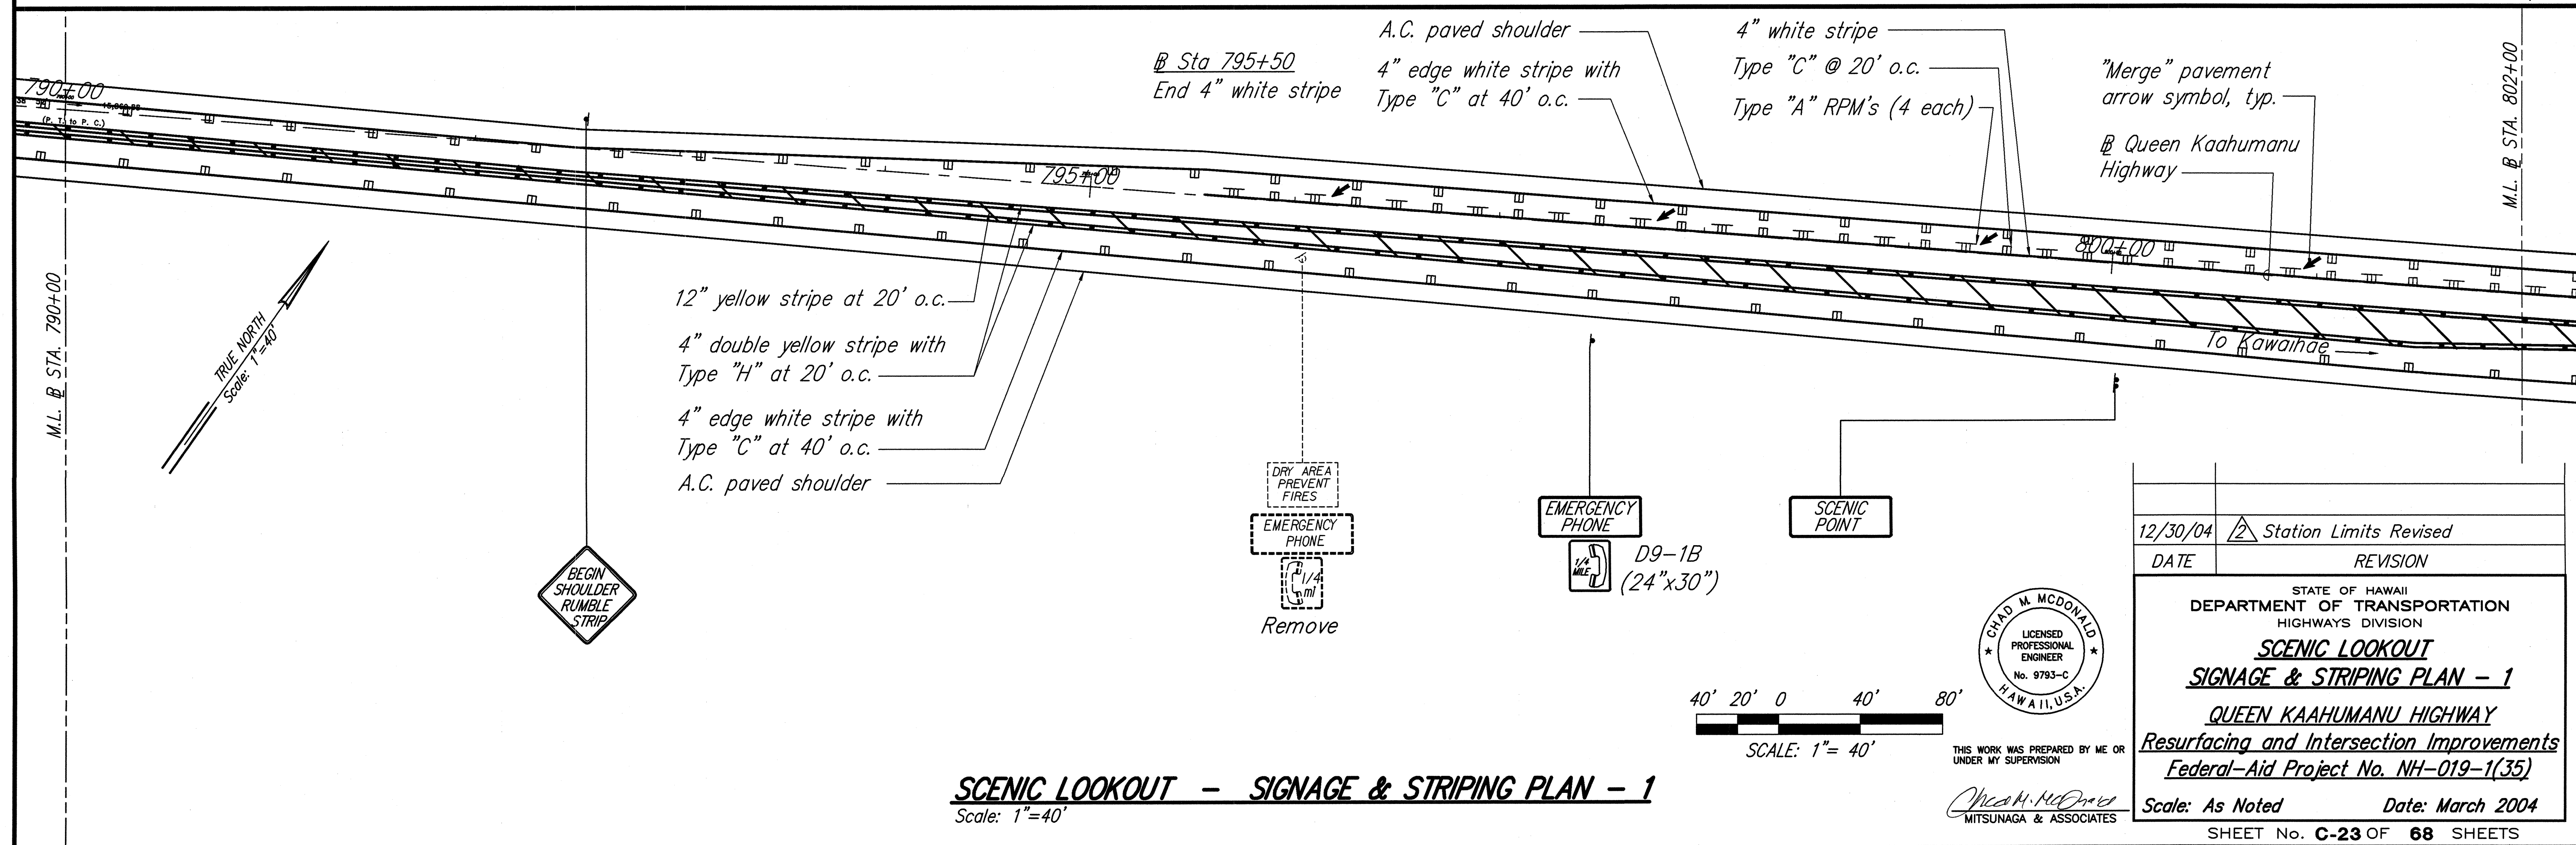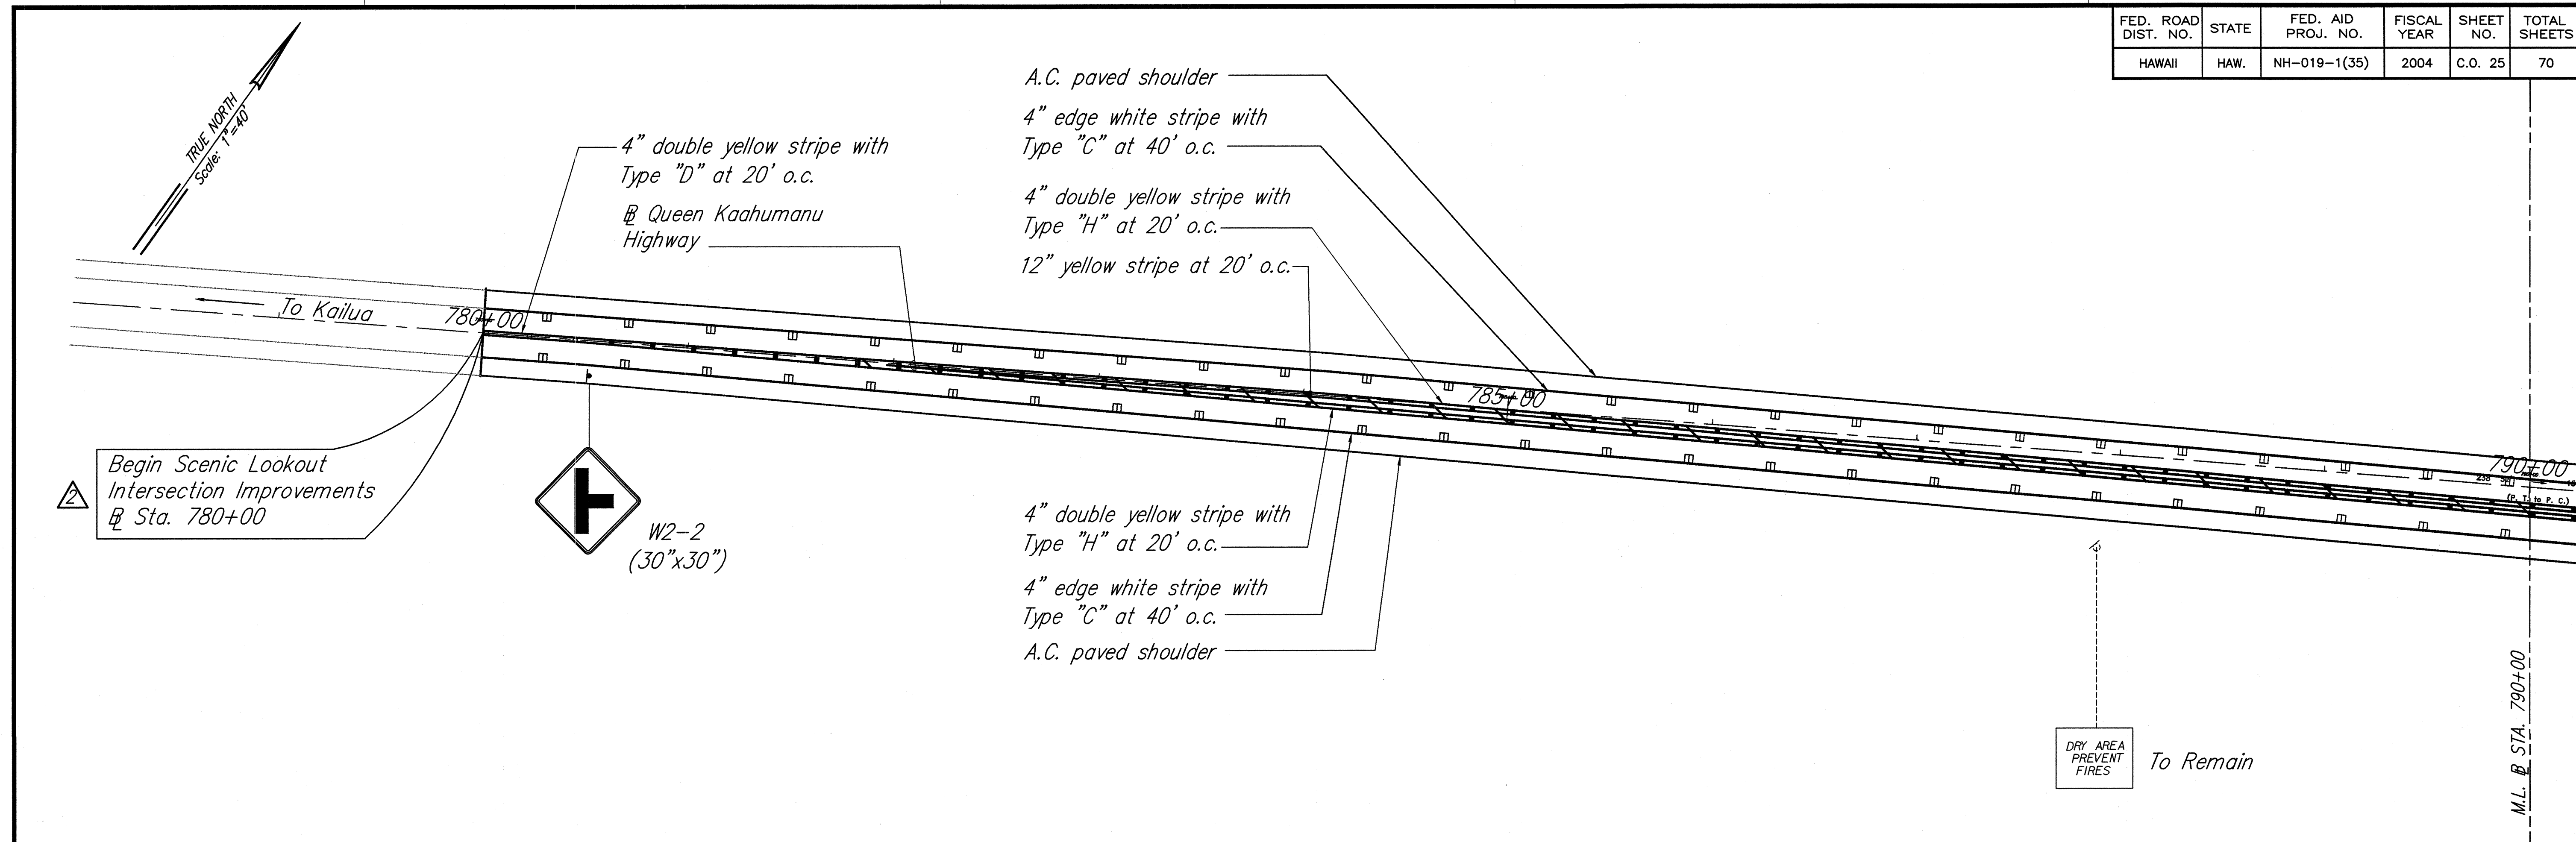

| | |
|-------------------|------|
| SURVEY PLOTTED BY | DATE |
| DRAWN BY | 3/04 |
| TRACED BY | 3/04 |
| QUANTITIES BY | 3/04 |
| CHECKED BY | 3/04 |
| ORIGINAL PLAN | |
| NOTE BOOK | |
| No. | |



SCENIC LOOKOUT - SIGNAGE & STRIPING PLAN - 1 Scale: 1"=40'

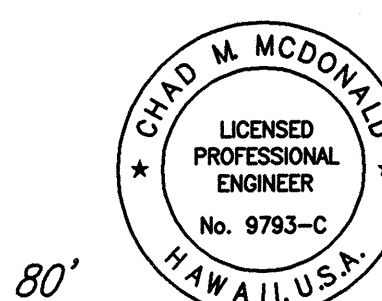

THIS WORK WAS PREPARED BY ME OR UNDER MY SUPERVISION
CHAD M. McDONALD
MITSUNAGA & ASSOCIATES



| | |
|---|--------------------------|
| 12/30/04 | 2 Station Limits Revised |
| DATE | REVISION |
| STATE OF HAWAII
DEPARTMENT OF TRANSPORTATION
HIGHWAYS DIVISION
SCENIC LOOKOUT
SIGNAGE & STRIPING PLAN - 1
QUEEN KAAHUMANU HIGHWAY
Resurfacing and Intersection Improvements
Federal-Aid Project No. NH-019-1(35)
Scale: As Noted Date: March 2004
SHEET No. C-23 OF 68 SHEETS | |

| FED. ROAD DIST. NO. | STATE | FED. AID PROJ. NO. | FISCAL YEAR | SHEET NO. | TOTAL SHEETS |
|---------------------|-------|--------------------|-------------|-----------|--------------|
| HAWAII | HAW. | NH-019-1(35) | 2004 | C.O. 26 | 70 |

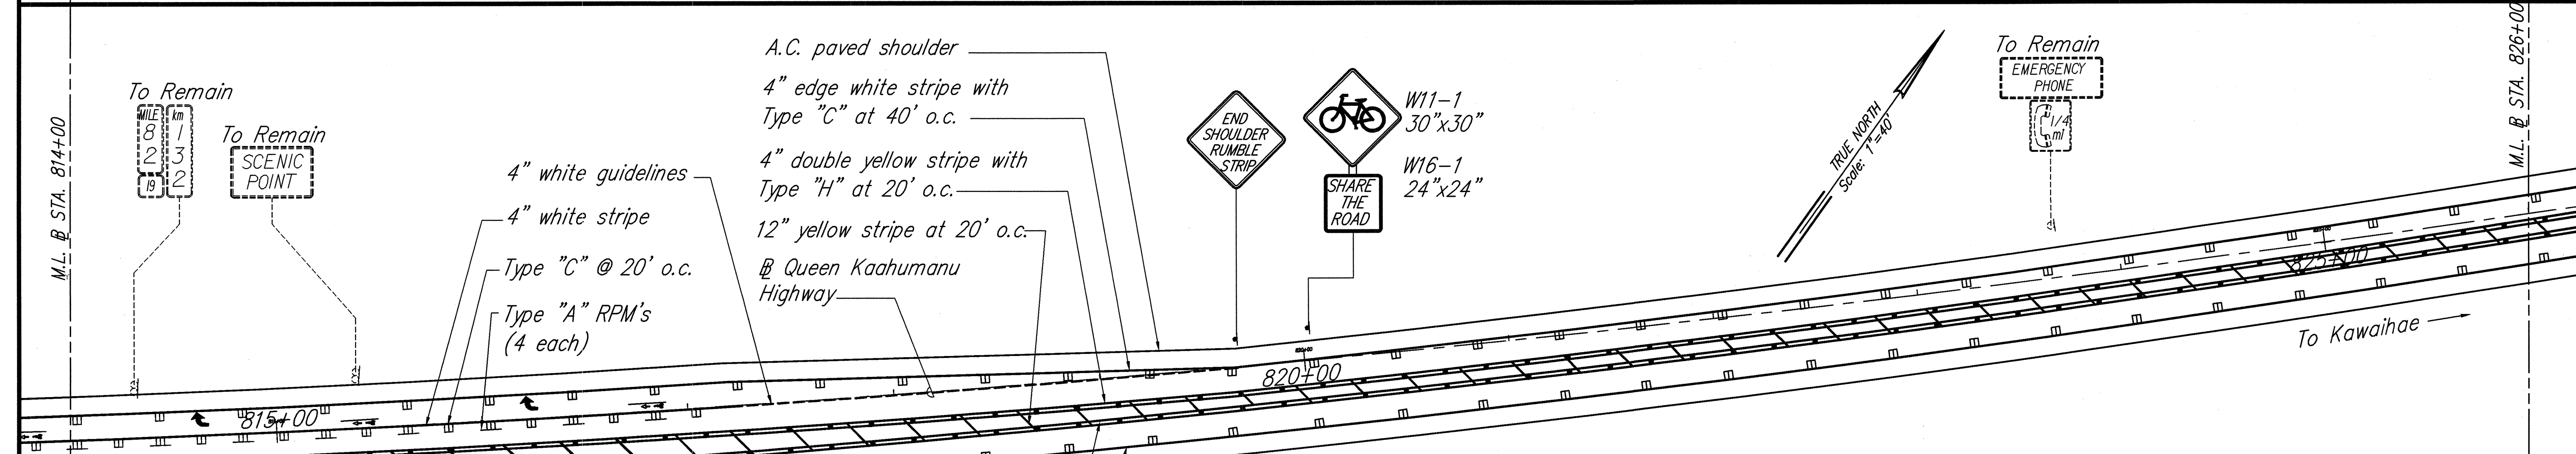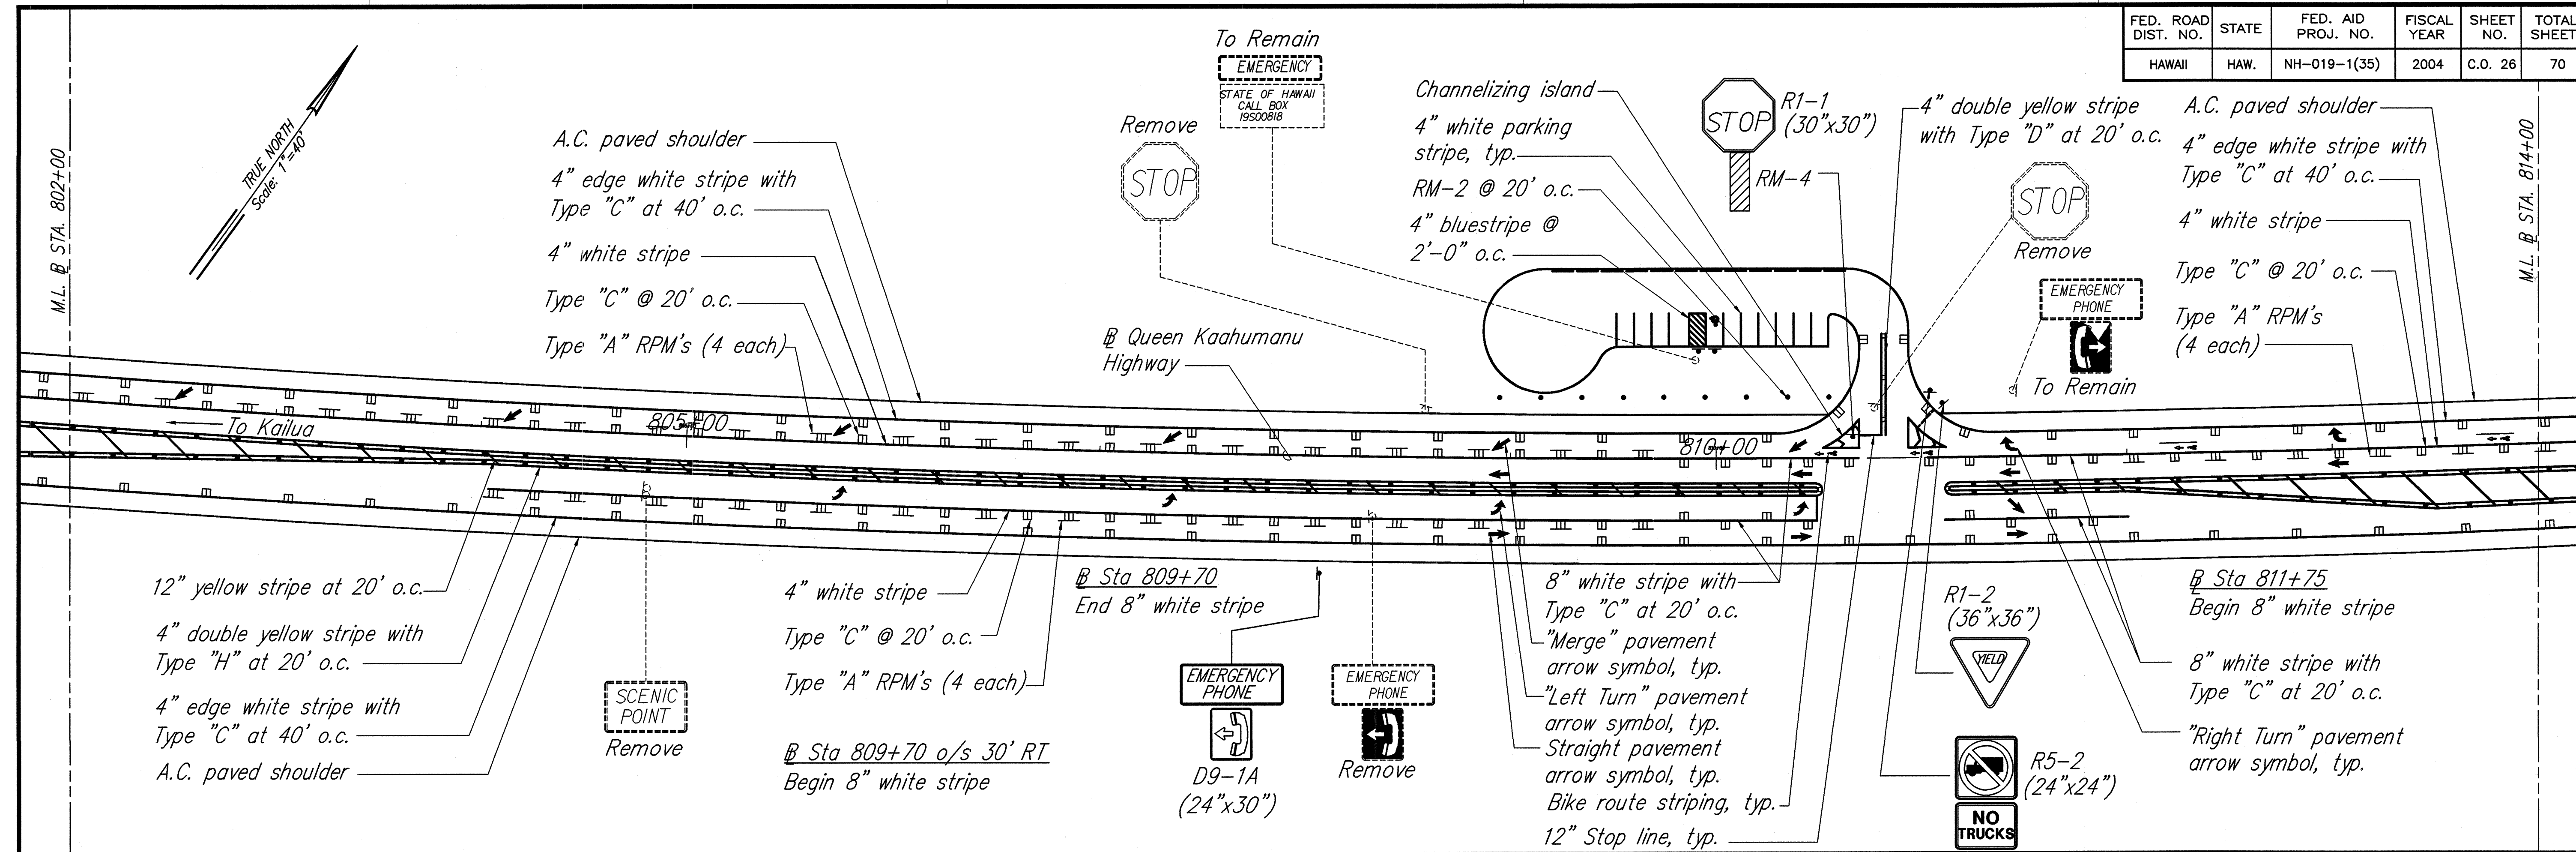

| | |
|-------------------|------|
| SURVEY PLOTTED BY | DATE |
| DRAWN BY | 3/04 |
| DESIGNED BY | 3/04 |
| QUANTITIES BY | 3/04 |
| CHECKED BY | 3/04 |
| ORIGINAL PLAN | |
| NOTE BOOK | |
| No. | |


SCENIC LOOKOUT - SIGNAGE & STRIPING PLAN - 2
Scale: 1"=40'

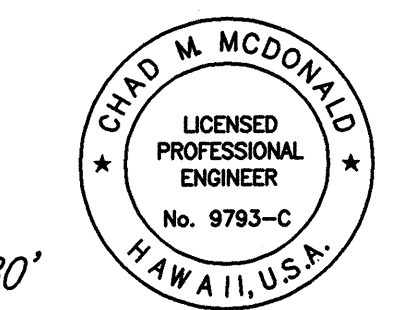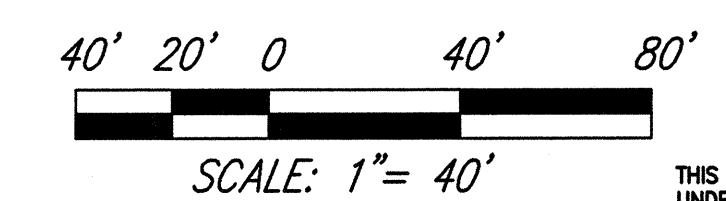

THIS WORK WAS PREPARED BY ME OR UNDER MY SUPERVISION
Chad M. McDonald
MITSUNAGA & ASSOCIATES



| | |
|---|--------------------------|
| 12/30/04 | 2 Station Limits Revised |
| DATE | REVISION |
| STATE OF HAWAII
DEPARTMENT OF TRANSPORTATION
HIGHWAYS DIVISION
SCENIC LOOKOUT
SIGNAGE & STRIPING PLAN - 2
QUEEN KAAHUMANU HIGHWAY
Resurfacing and Intersection Improvements
Federal-Aid Project No. NH-019-1(35)
Scale: As Noted Date: March 2004
SHEET No. C-24 OF 68 SHEETS | |

| FED. ROAD DIST. NO. | STATE | FED. AID PROJ. NO. | FISCAL YEAR | SHEET NO. | TOTAL SHEETS |
|---------------------|-------|--------------------|-------------|------------|--------------|
| HAWAII | HAW. | NH-019-1(35) | 2004 | C.O. 26S-1 | 70 |

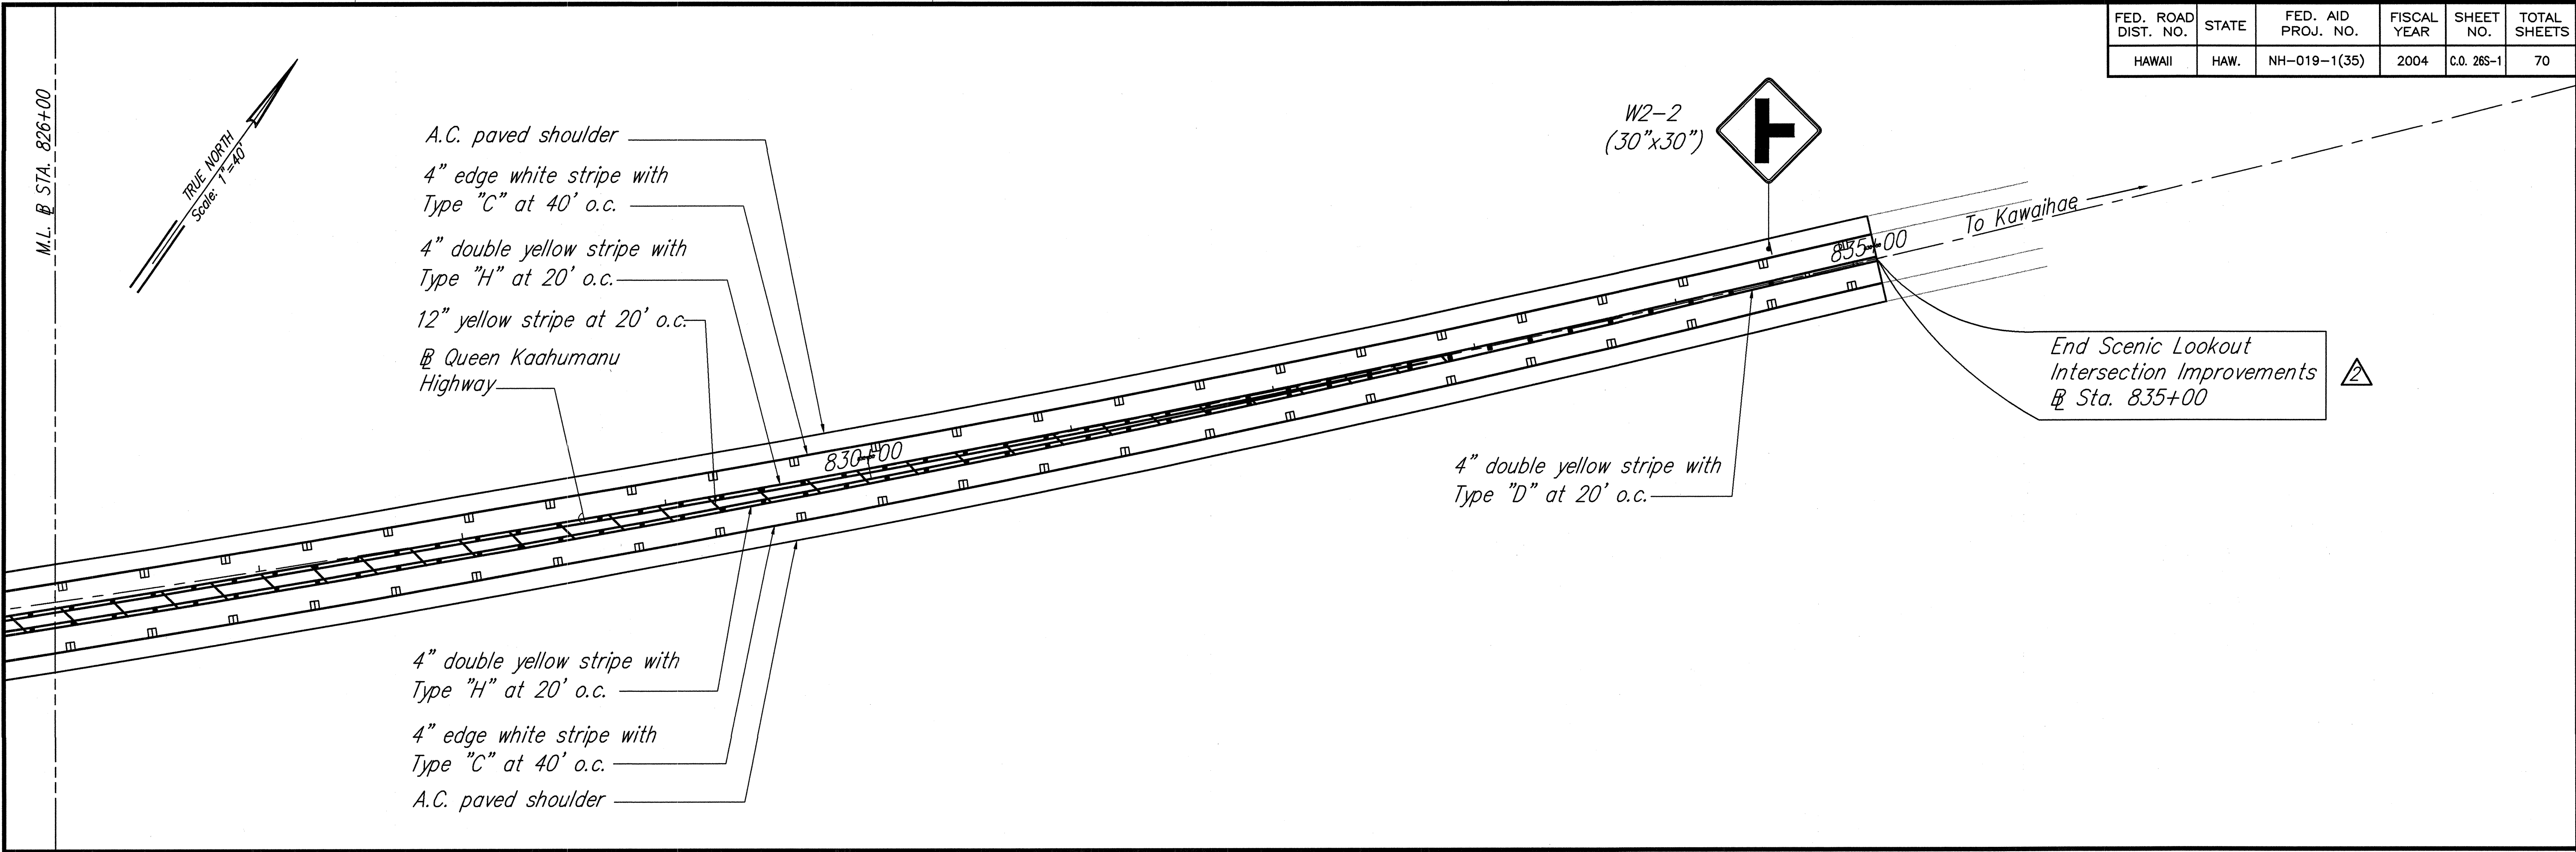

| | |
|-------------------|------|
| SURVEY PLOTTED BY | DATE |
| DRAWN BY | DATE |
| DESIGNED BY | DATE |
| QUANTITIES BY | DATE |
| CHECKED BY | DATE |
| ORIGINAL PLAN | |
| NOTE BOOK | |
| No. | |

SCENIC LOOKOUT - SIGNAGE & STRIPING PLAN - 3
Scale: 1"=40'

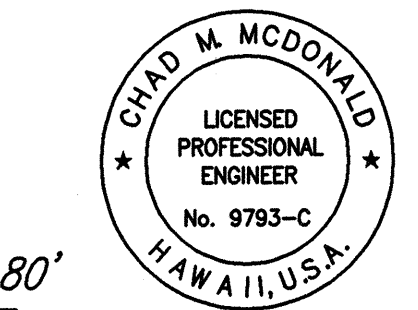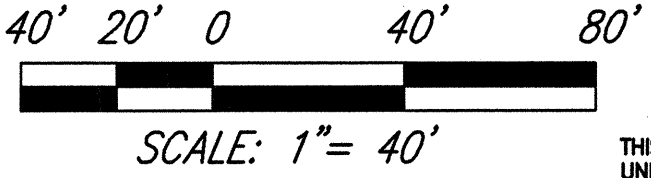

THIS WORK WAS PREPARED BY ME OR UNDER MY SUPERVISION

Chad W. McDonald
MITSUNAGA & ASSOCIATES

| | | |
|--|---|------------------------------------|
| 12/30/04 | 2 | Station Limits Revised/ Sht. added |
| DATE | | REVISION |
| STATE OF HAWAII
DEPARTMENT OF TRANSPORTATION
HIGHWAYS DIVISION
SCENIC LOOKOUT
SIGNAGE & STRIPING PLAN - 3
QUEEN KAAHUMANU HIGHWAY
Resurfacing and Intersection Improvements
Federal-Aid Project No. NH-019-1(35)
Scale: As Noted Date: March 2004
SHEET No. C-24 OF 68 SHEETS | | |