


FED. ROAD DIST. NO.	STATE	PROJ. NO.	FISCAL YEAR	SHEET NO.	TOTAL SHEETS
HAWAII	HAW.	19J-01-02	2004	36	40

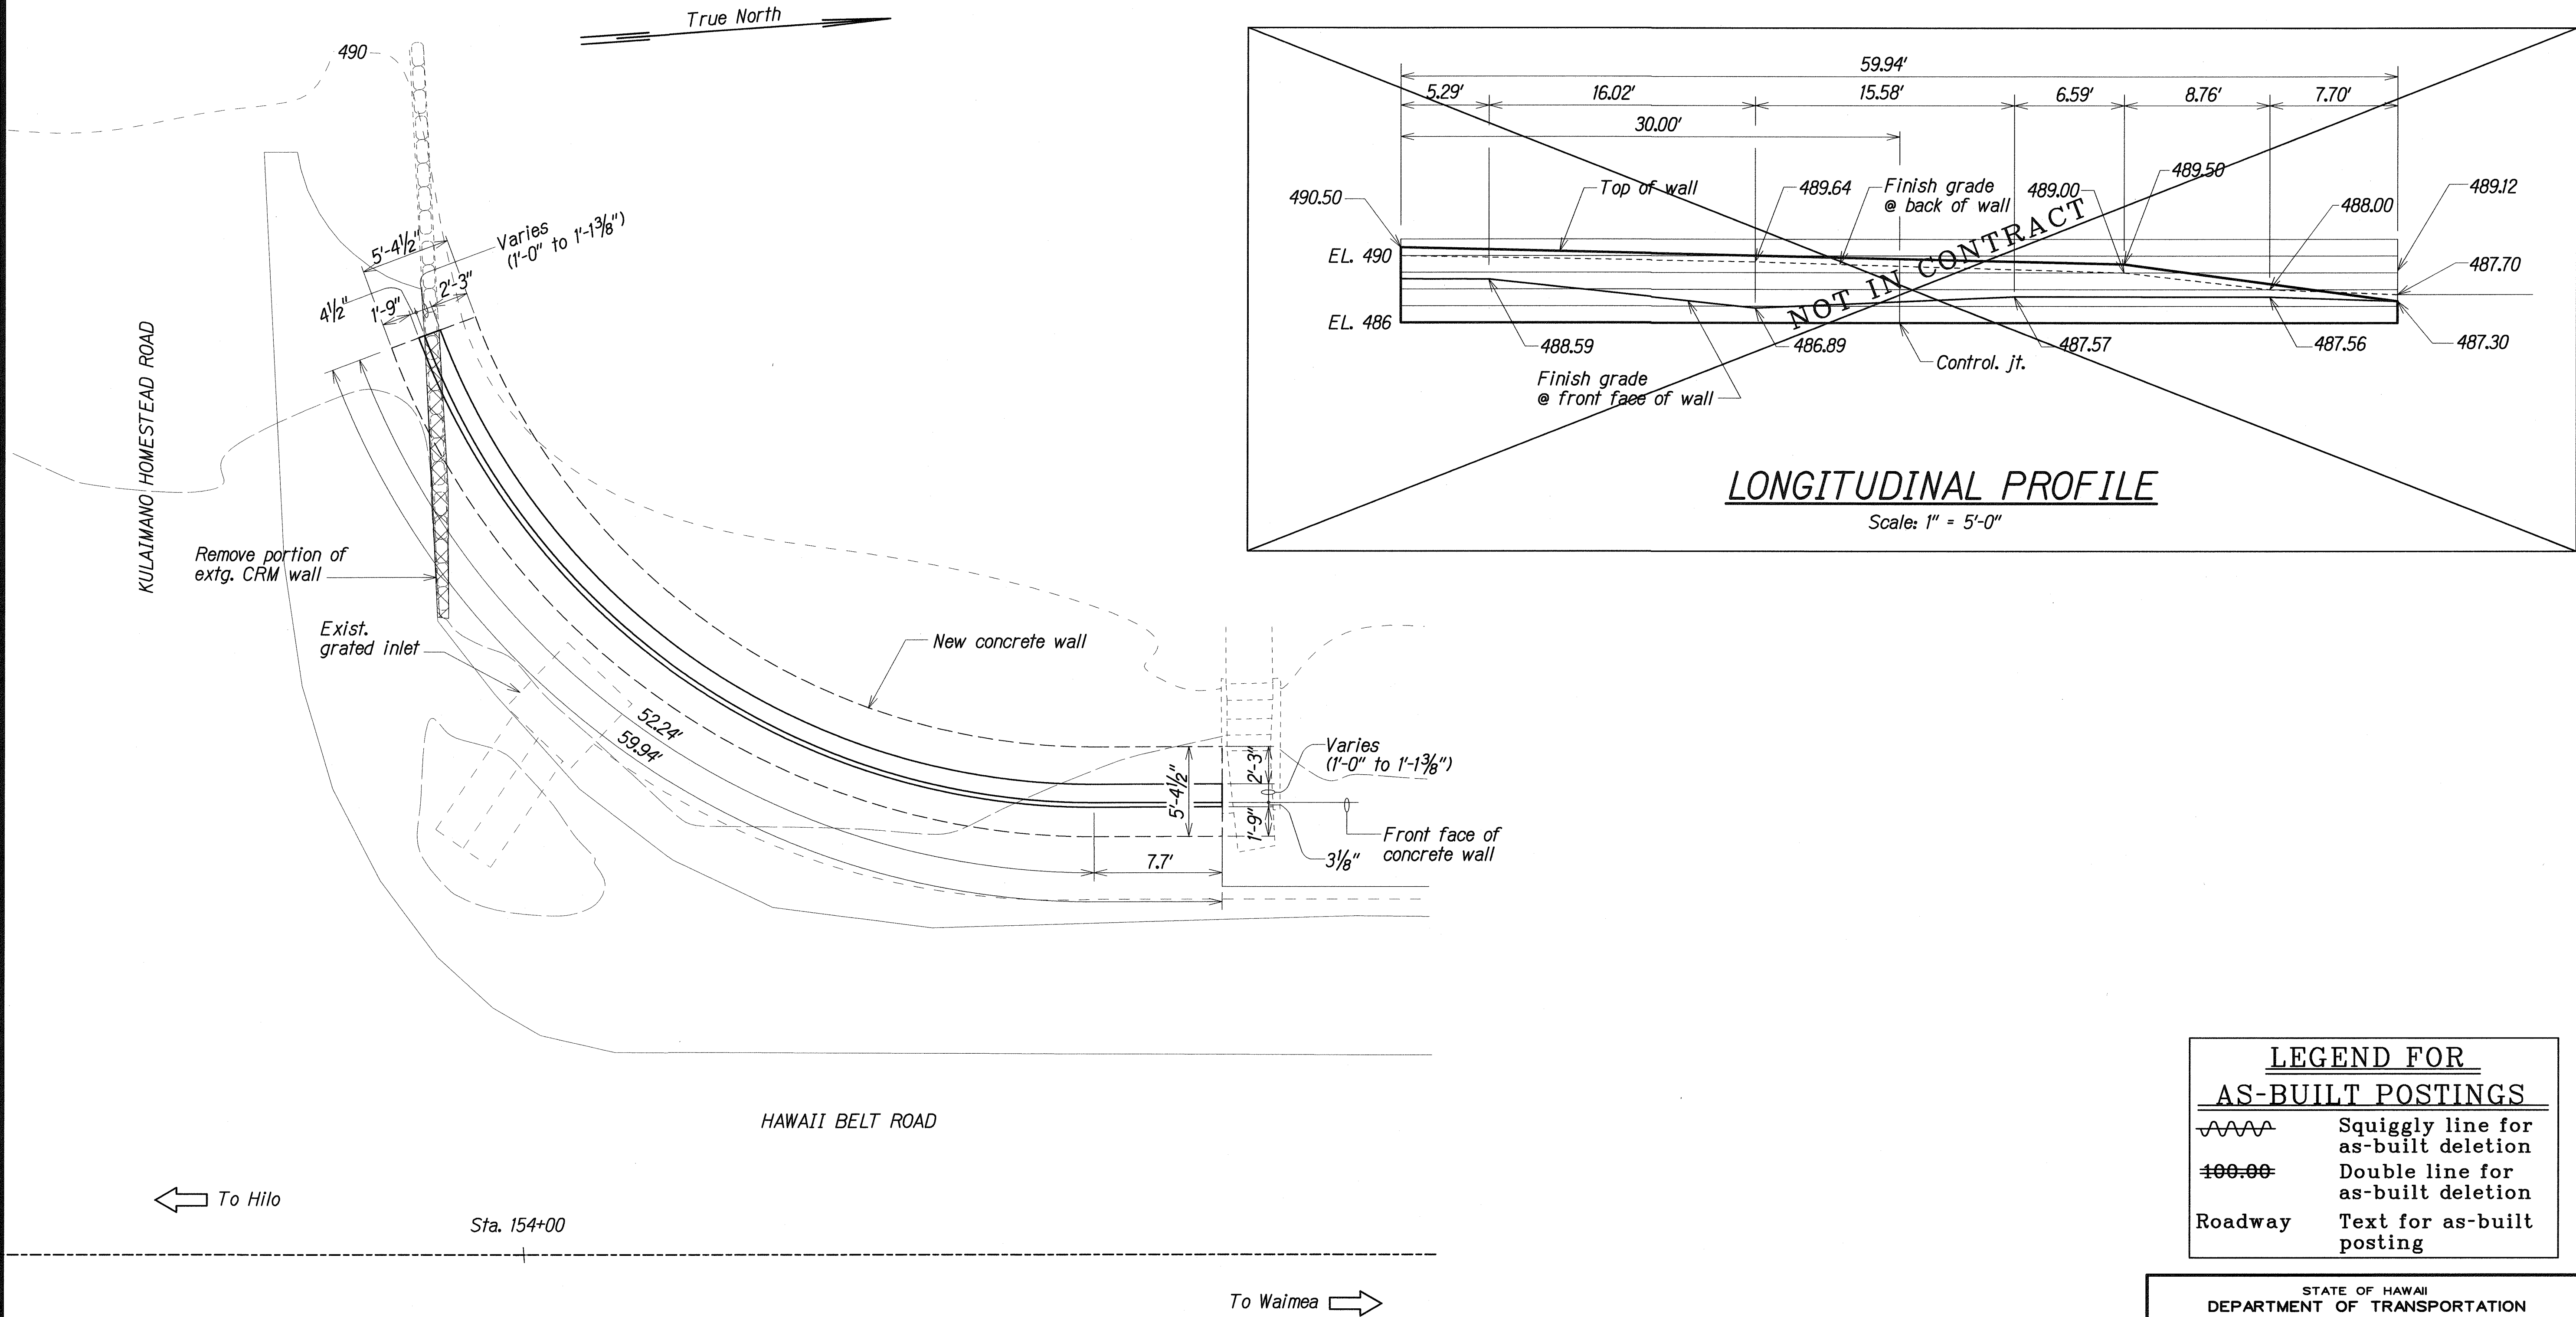

SURVEY PLOTTED BY	DATE
MMN	Oct 2003
DRAWN BY	
DESIGNED BY	
CHECKED BY	
NOTE BOOK	
NO. XXXXXX	

LEGEND FOR AS-BUILT POSTINGS	
	Squiggly line for as-built deletion
	Double line for as-built deletion
Roadway	Text for as-built posting

STATE OF HAWAII  
DEPARTMENT OF TRANSPORTATION  
HIGHWAYS DIVISION  
**CONCRETE WALL**  
**PLAN AND ELEVATION**  
TRAFFIC OPERATIONAL IMPROVEMENTS  
Hawaii Belt Road  
At Kulaimano Road  
Project No. 19J-01-02

Scale: As Noted  
Date: Oct, 2003