


19J-01-02

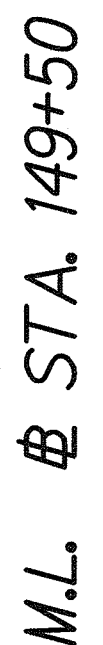


Scale: 1"=20'

SHEET No. *H2* OF *10* SHEETS

|                  |                         |               |
|------------------|-------------------------|---------------|
| ORIGINAL PLAN    | SURVEY PLOTTED BY _____ | DATE _____    |
|                  | DRAWN BY <i>LEC</i>     | <i>B.5.03</i> |
|                  | TRACED BY _____         | _____         |
| NOTE BOOK        | DESIGNED BY <i>CM</i>   | _____         |
| <i>amochawal</i> | QUANTITIES BY _____     | _____         |
| <i>amochawal</i> | CHECKED BY _____        | _____         |
| <i>amochawal</i> | NO. <i>500100208</i>    | _____         |


| FED. ROAD DIST. NO. | STATE | PROJ. NO. | FISCAL YEAR | SHEET NO. | TOTAL SHEETS |
|---------------------|-------|-----------|-------------|-----------|--------------|
| HAWAII              | HAW.  | 19J-01-02 | 2004        | 17        | 40           |

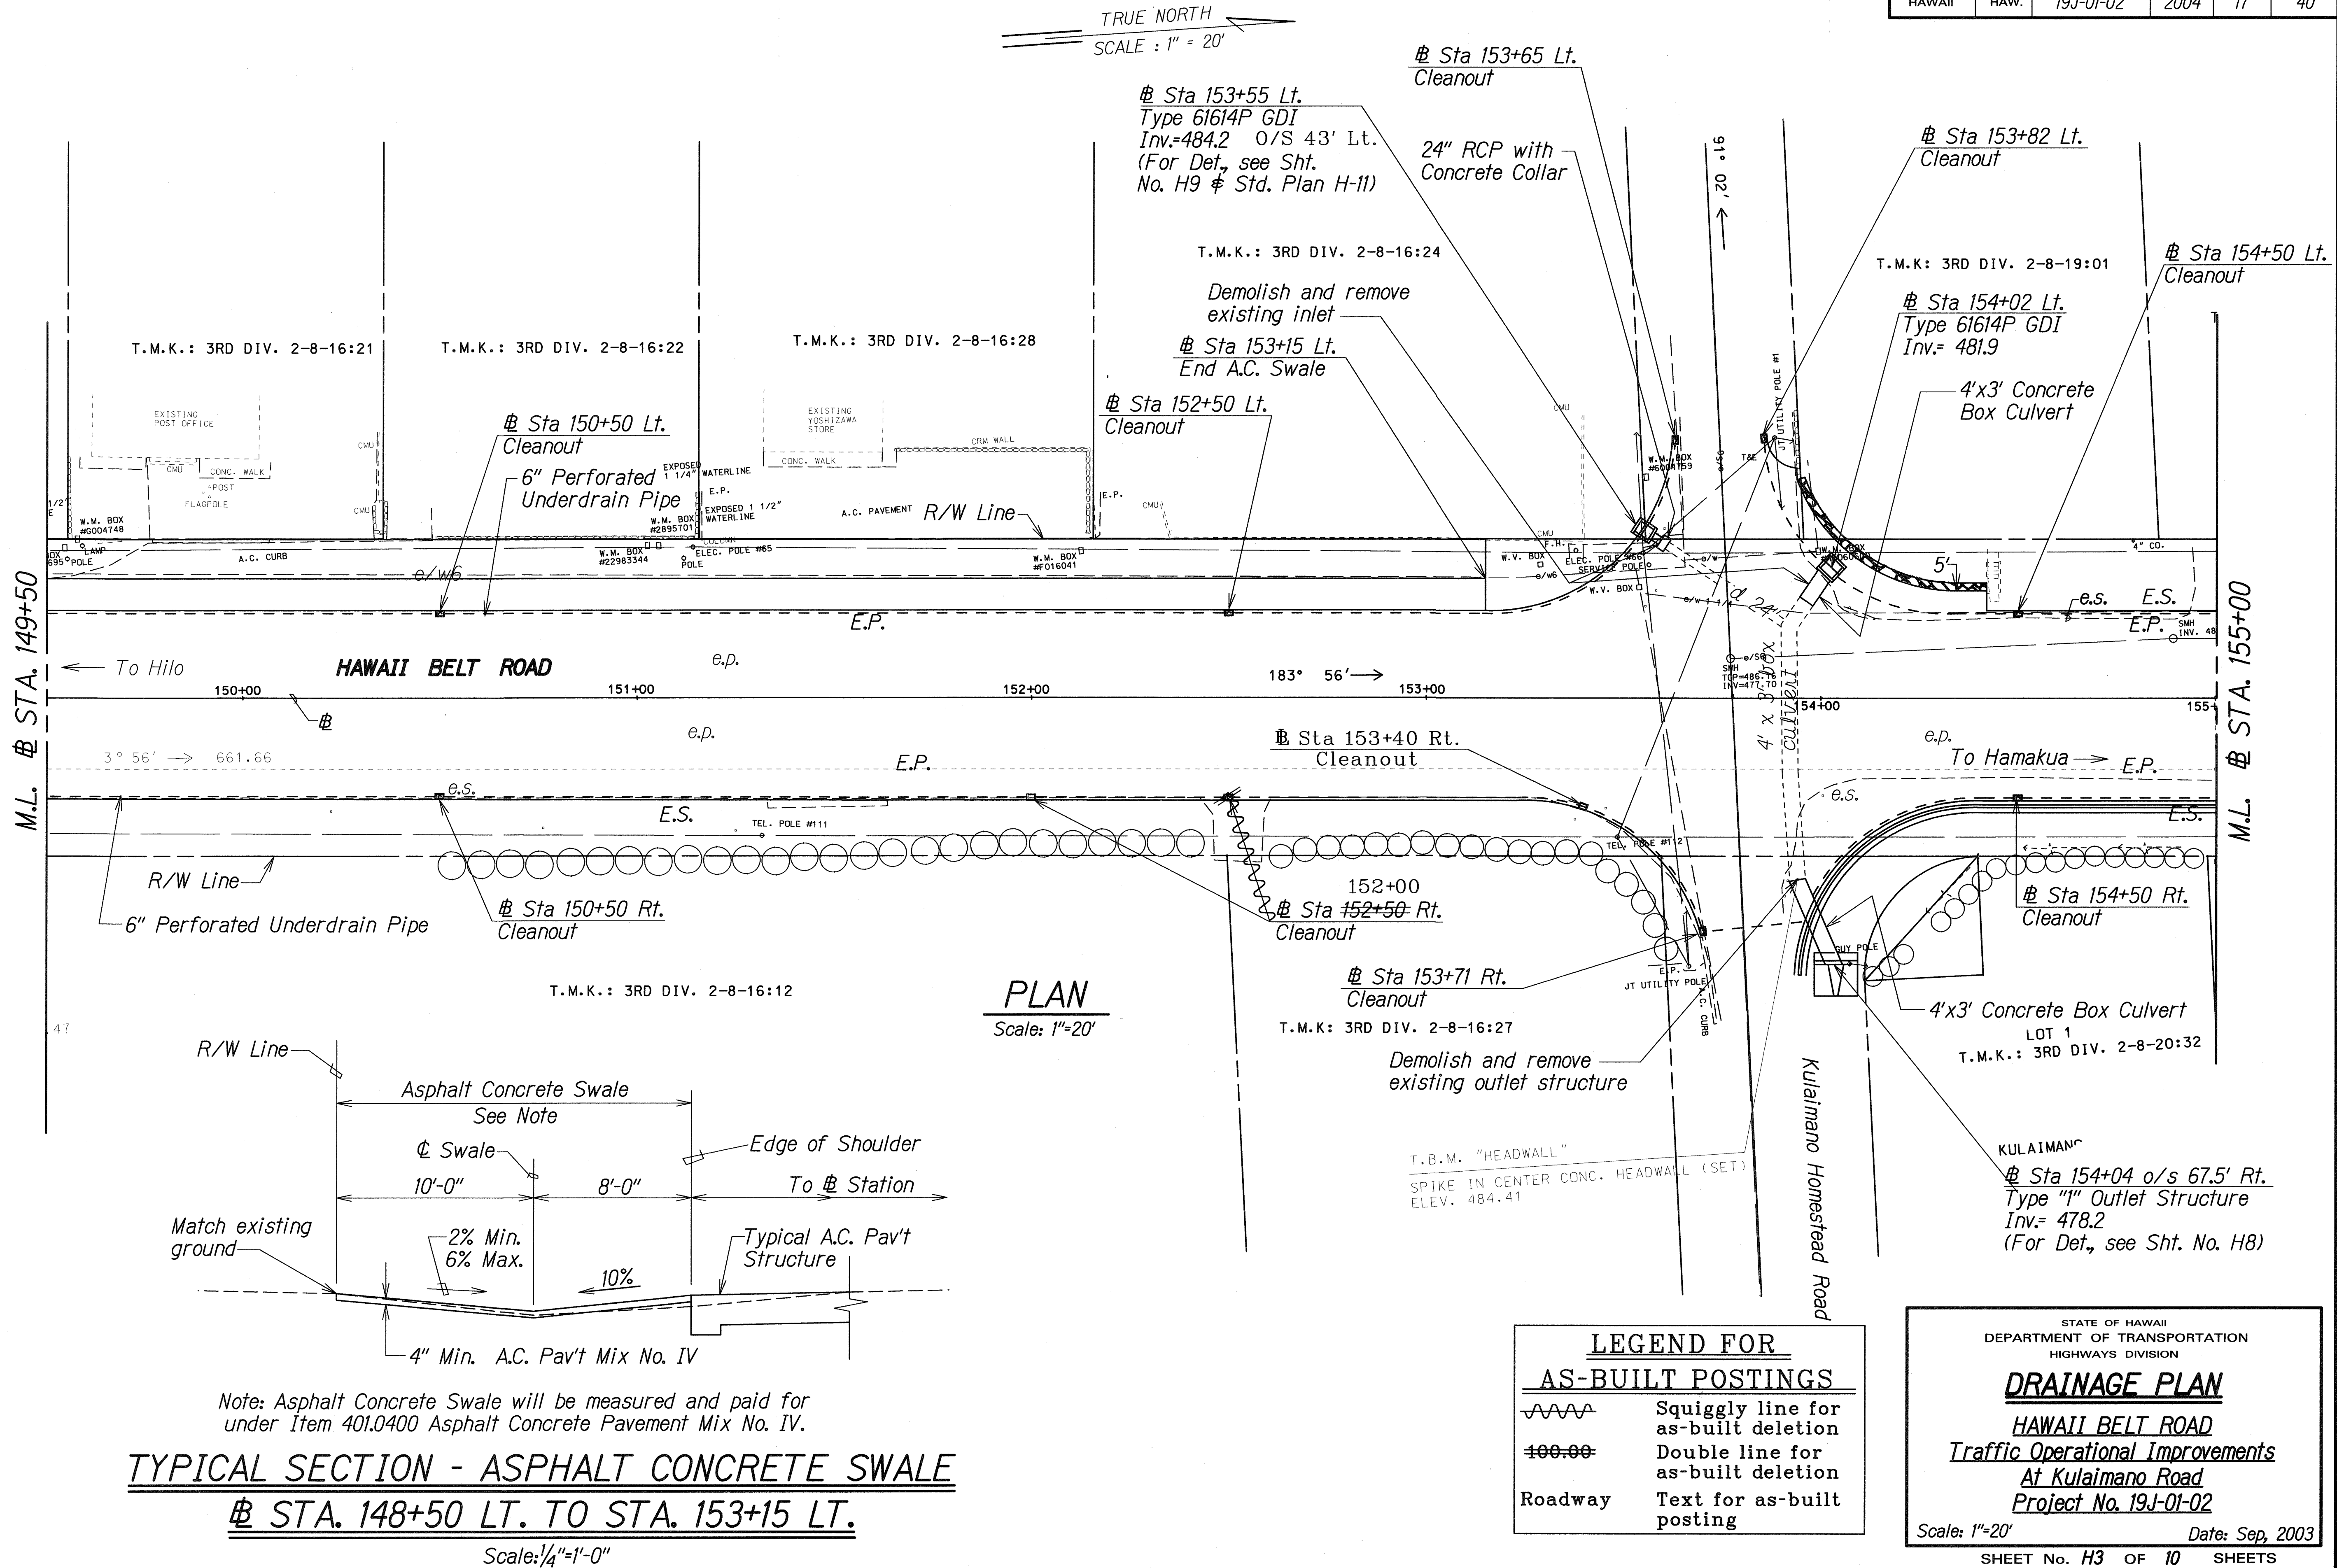

|                   |      |         |
|-------------------|------|---------|
| ORIGINAL PLAN     | DATE | 8/25/03 |
| SURVEY PLOTTED BY | DATE | 8/25/03 |
| DRAWN BY          | DATE | 8/25/03 |
| TRACED BY         | DATE | 8/25/03 |
| DESIGNED BY       | DATE | 8/25/03 |
| CHECKED BY        | DATE | 8/25/03 |

"AS-BUILT"

| FED. ROAD DIST. NO. | STATE | PROJ. NO. | FISCAL YEAR | SHEET NO. | TOTAL SHEETS |
|---------------------|-------|-----------|-------------|-----------|--------------|
| HAWAII              | HAW.  | 19J-01-02 | 2004        | 18        | 40           |

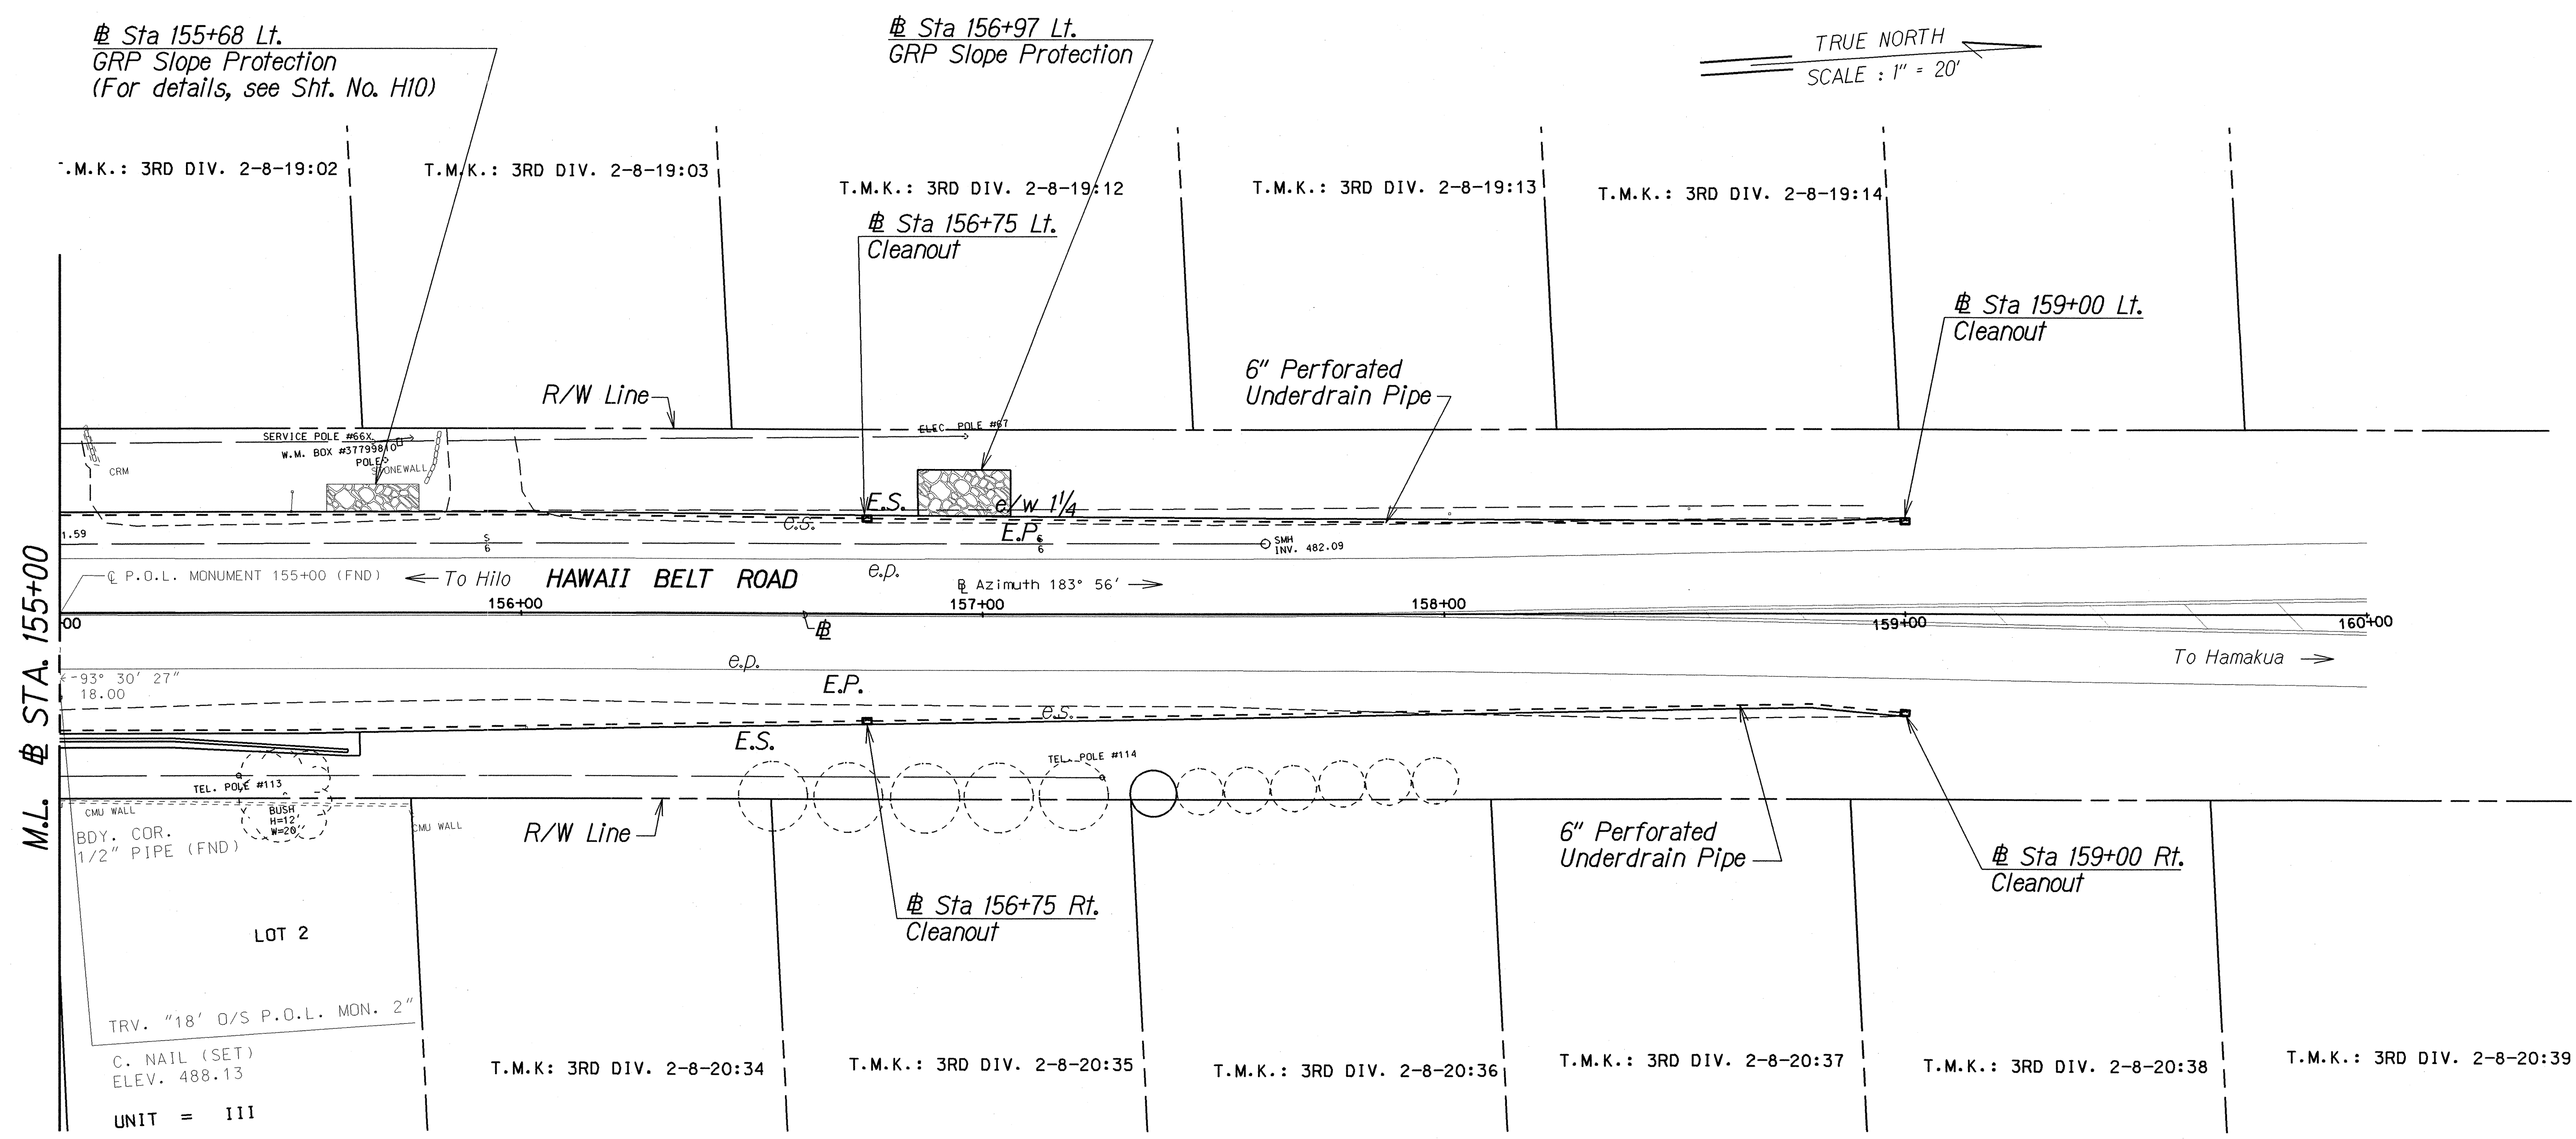

PLAN  
Scale: 1"=20'

|                |                   |        |
|----------------|-------------------|--------|
| ORIGINAL PLAN  | SURVEY PLOTTED BY | DATE   |
| PLAN           | DRAWN BY          | 8/5/03 |
| NOTE BOOK      | DESIGNED BY       |        |
| CHIEF ENGINEER | CHECKED BY        |        |

STATE OF HAWAII  
DEPARTMENT OF TRANSPORTATION  
HIGHWAYS DIVISION

### DRAINAGE PLAN

HAWAII BELT ROAD  
Traffic Operational Improvements  
At Kulaimano Road  
Project No. 19J-01-02

Scale: 1"=20'  
Date: Sep, 2003

SHEET No. H4 OF 10 SHEETS