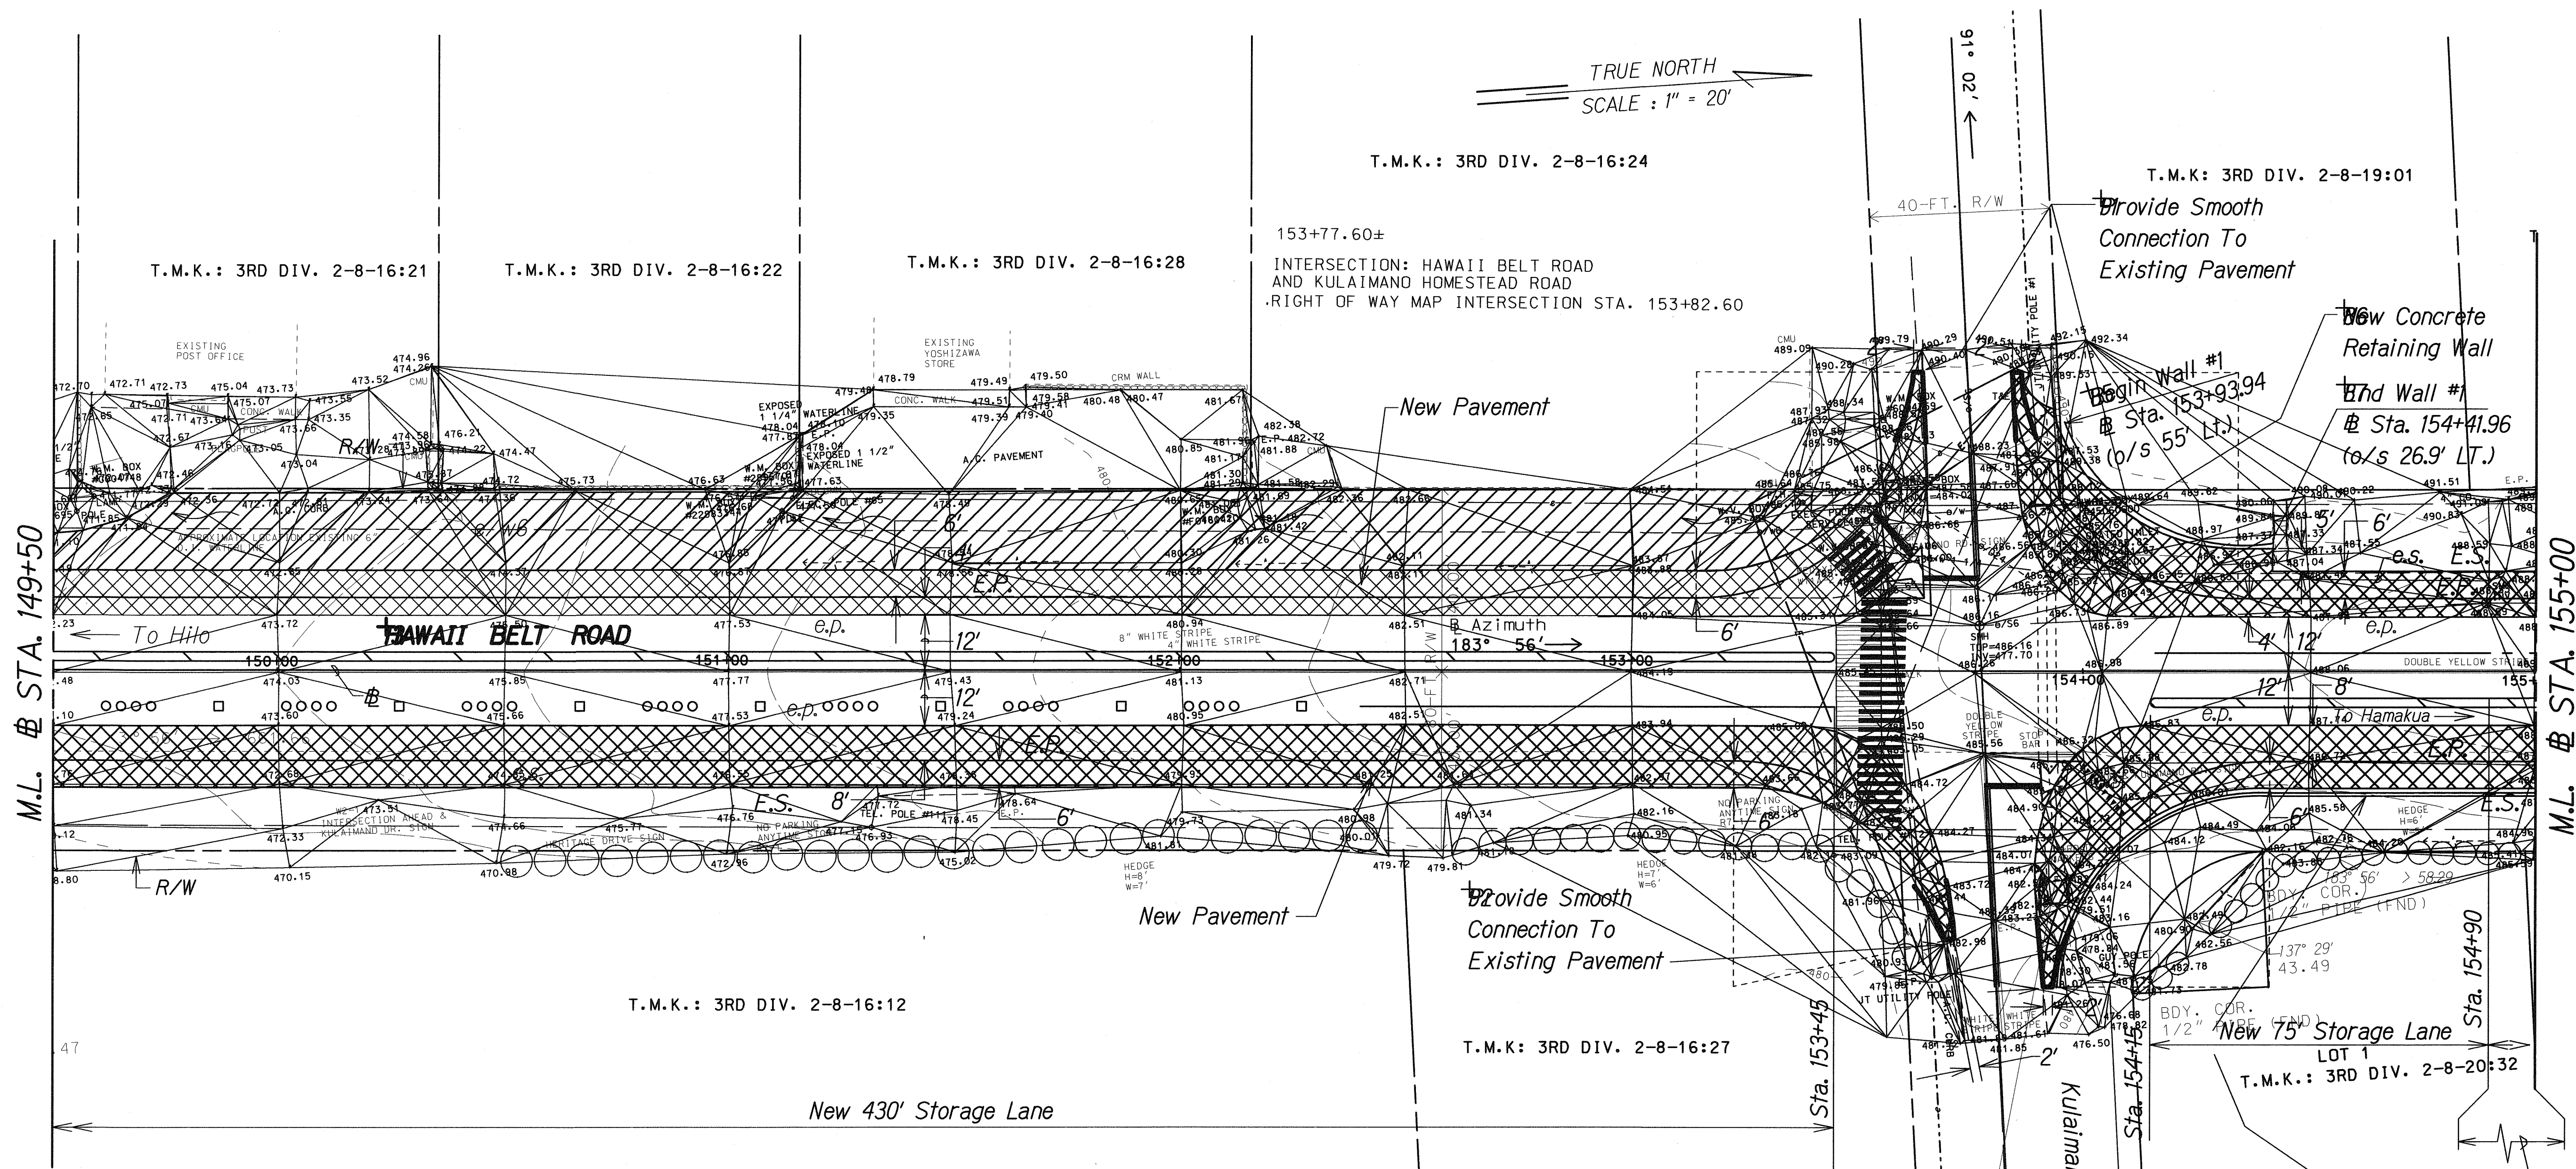


FED. ROAD DIST. NO.	STATE	PROJ. NO.	FISCAL YEAR	SHEET NO.	TOTAL SHEETS
HAWAII	HAW.	19J-01-02	2004	12	40



Legend:

- Reconstruct Pavement
- Overlay Existing A.C. Pavement

PLAN

Scale: 1"=20'



LEGEND FOR AS-BUILT POSTINGS	
	Squiggly line for as-built deletion
	Double line for as-built deletion
Roadway	Text for as-built posting

STATE OF HAWAII
DEPARTMENT OF TRANSPORTATION
HIGHWAYS DIVISION

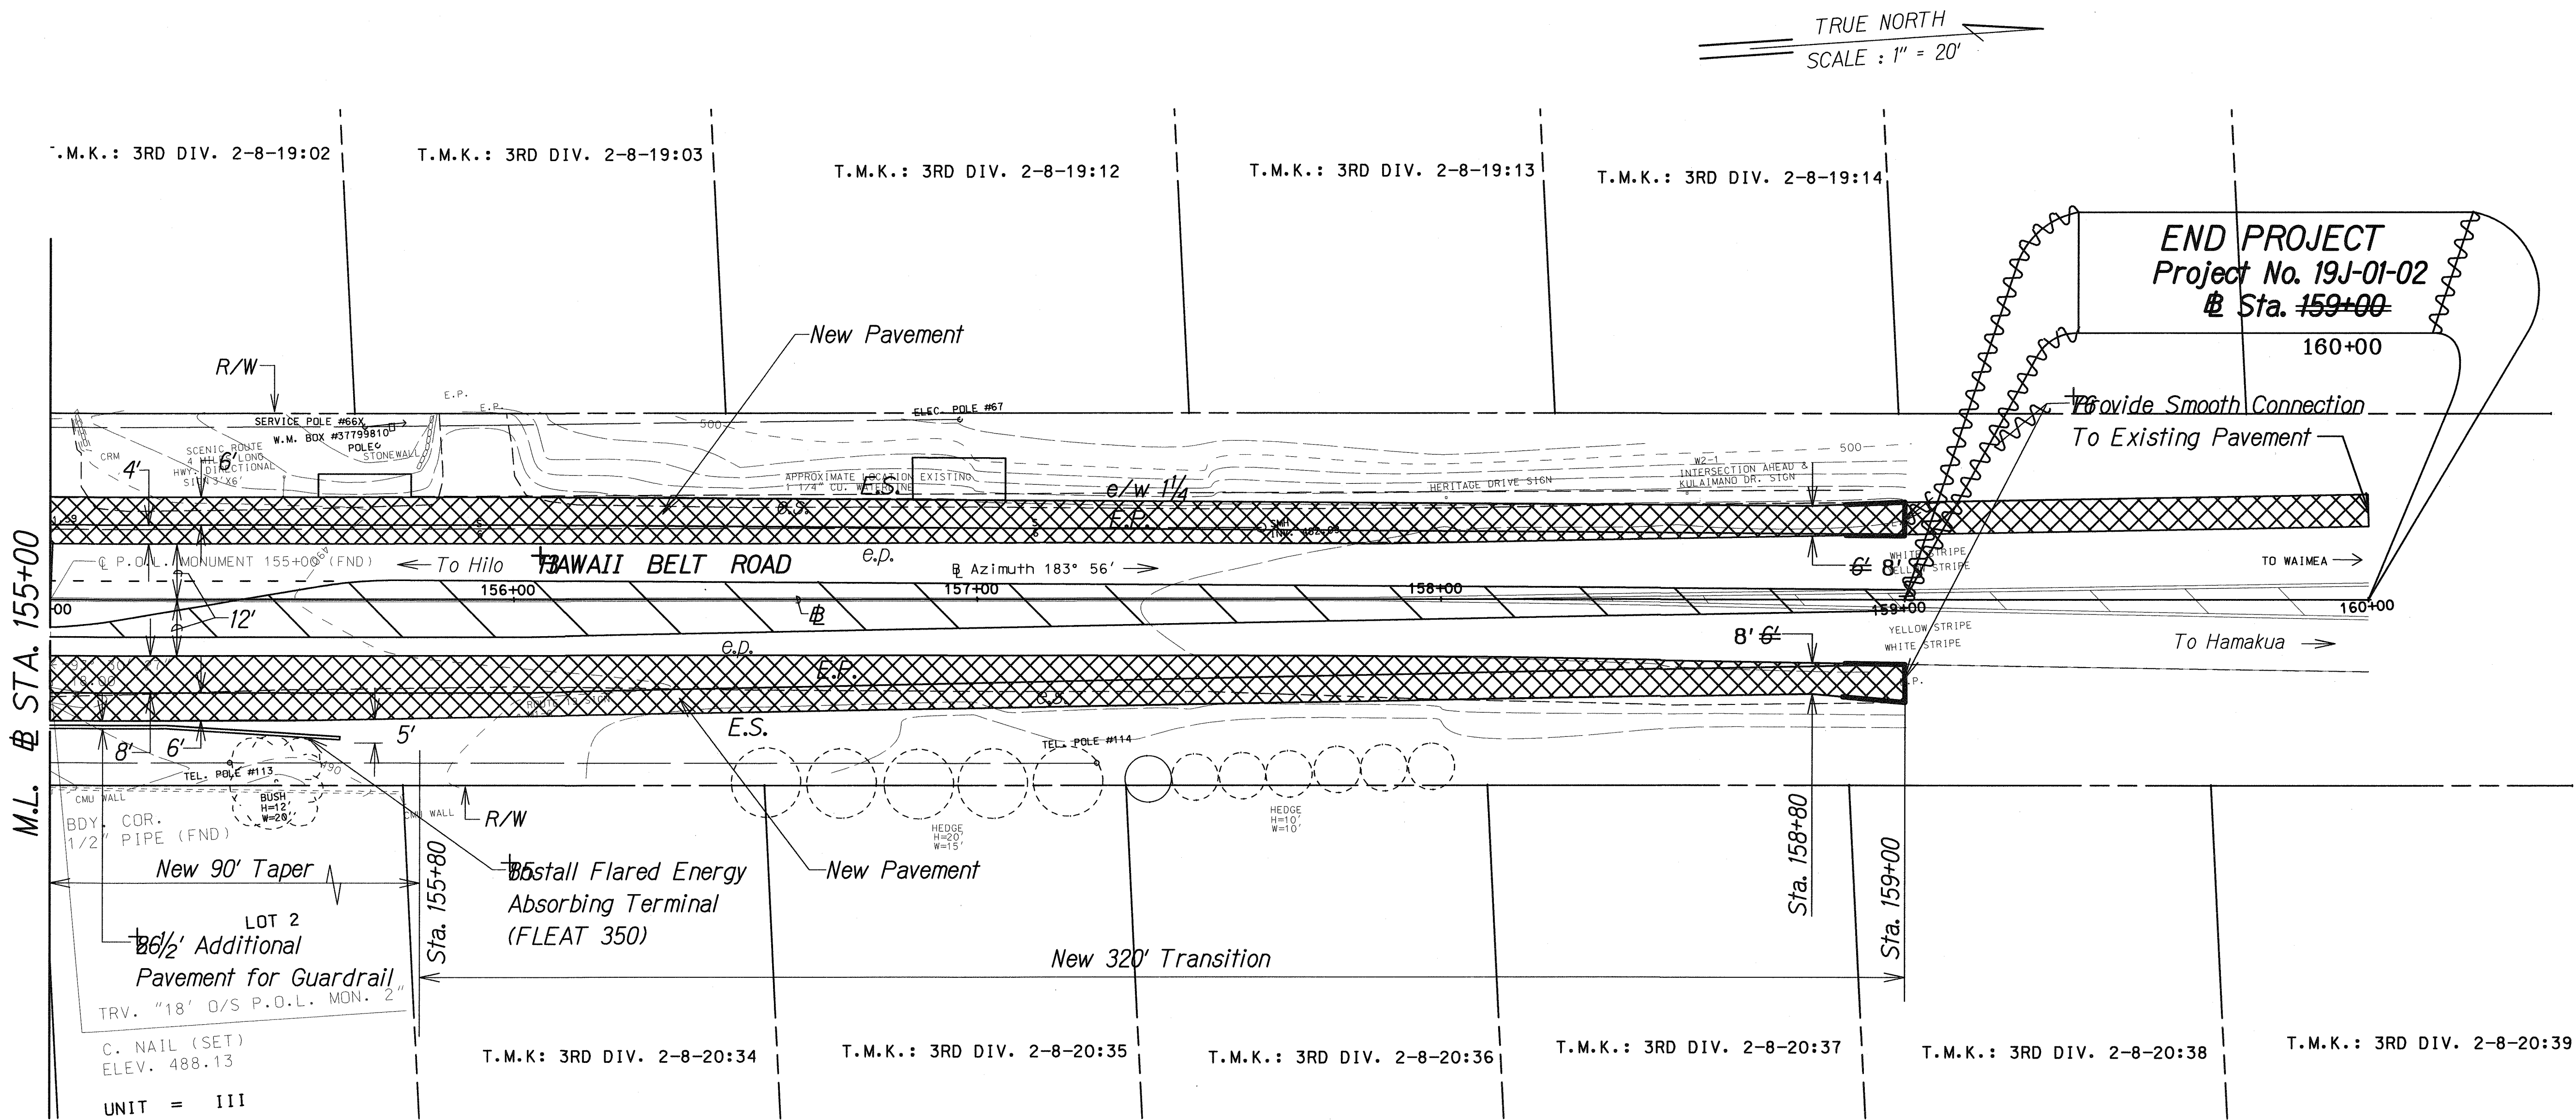
ROADWAY PLAN
Hawaii Belt Road
Traffic Operational Improvements
At Kulaimano Road
Project No. 19J-01-02

Scale: 1"=20' Date: Feb. 2003

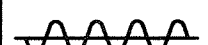
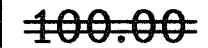
SHEET No. 2 OF 3 SHEETS

"AS-BUILT"

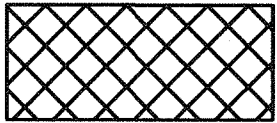
FED. ROAD DIST. NO.	STATE	PROJ. NO.	FISCAL YEAR	SHEET NO.	TOTAL SHEETS
HAWAII	HAW.	19J-01-02	2004	ADD.13	40



SURVEY PLOTTED BY	DATE
DRAWN BY	
DESIGNED BY	
CHECKED BY	
NOTED BY	
DATE	

LEGEND FOR AS-BUILT POSTINGS	
	Squiggly line for as-built deletion
	Double line for as-built deletion
Roadway	Text for as-built posting

PLAN
Scale: 1"=20'

Legend:
 Reconstruct Pavement



5/11/04	Increased Reconstruction Area
DATE	REVISION
STATE OF HAWAII DEPARTMENT OF TRANSPORTATION HIGHWAYS DIVISION ROADWAY PLAN <i>Hawaii Belt Road</i> <i>Traffic Operational Improvements</i> <i>At Kulaimano Road</i> <i>Project No. 19J-01-02</i> Scale: 1"=20' Date: Feb. 2003 SHEET No. 3 OF 3 SHEETS	

"AS-BUILT"

ADD.13