



FED. ROAD DIST. NO.	STATE	PROJ. NO.	FISCAL YEAR	SHEET NO.	TOTAL SHEETS
HAWAII	HAW.	19J-01-02	2004	10	40

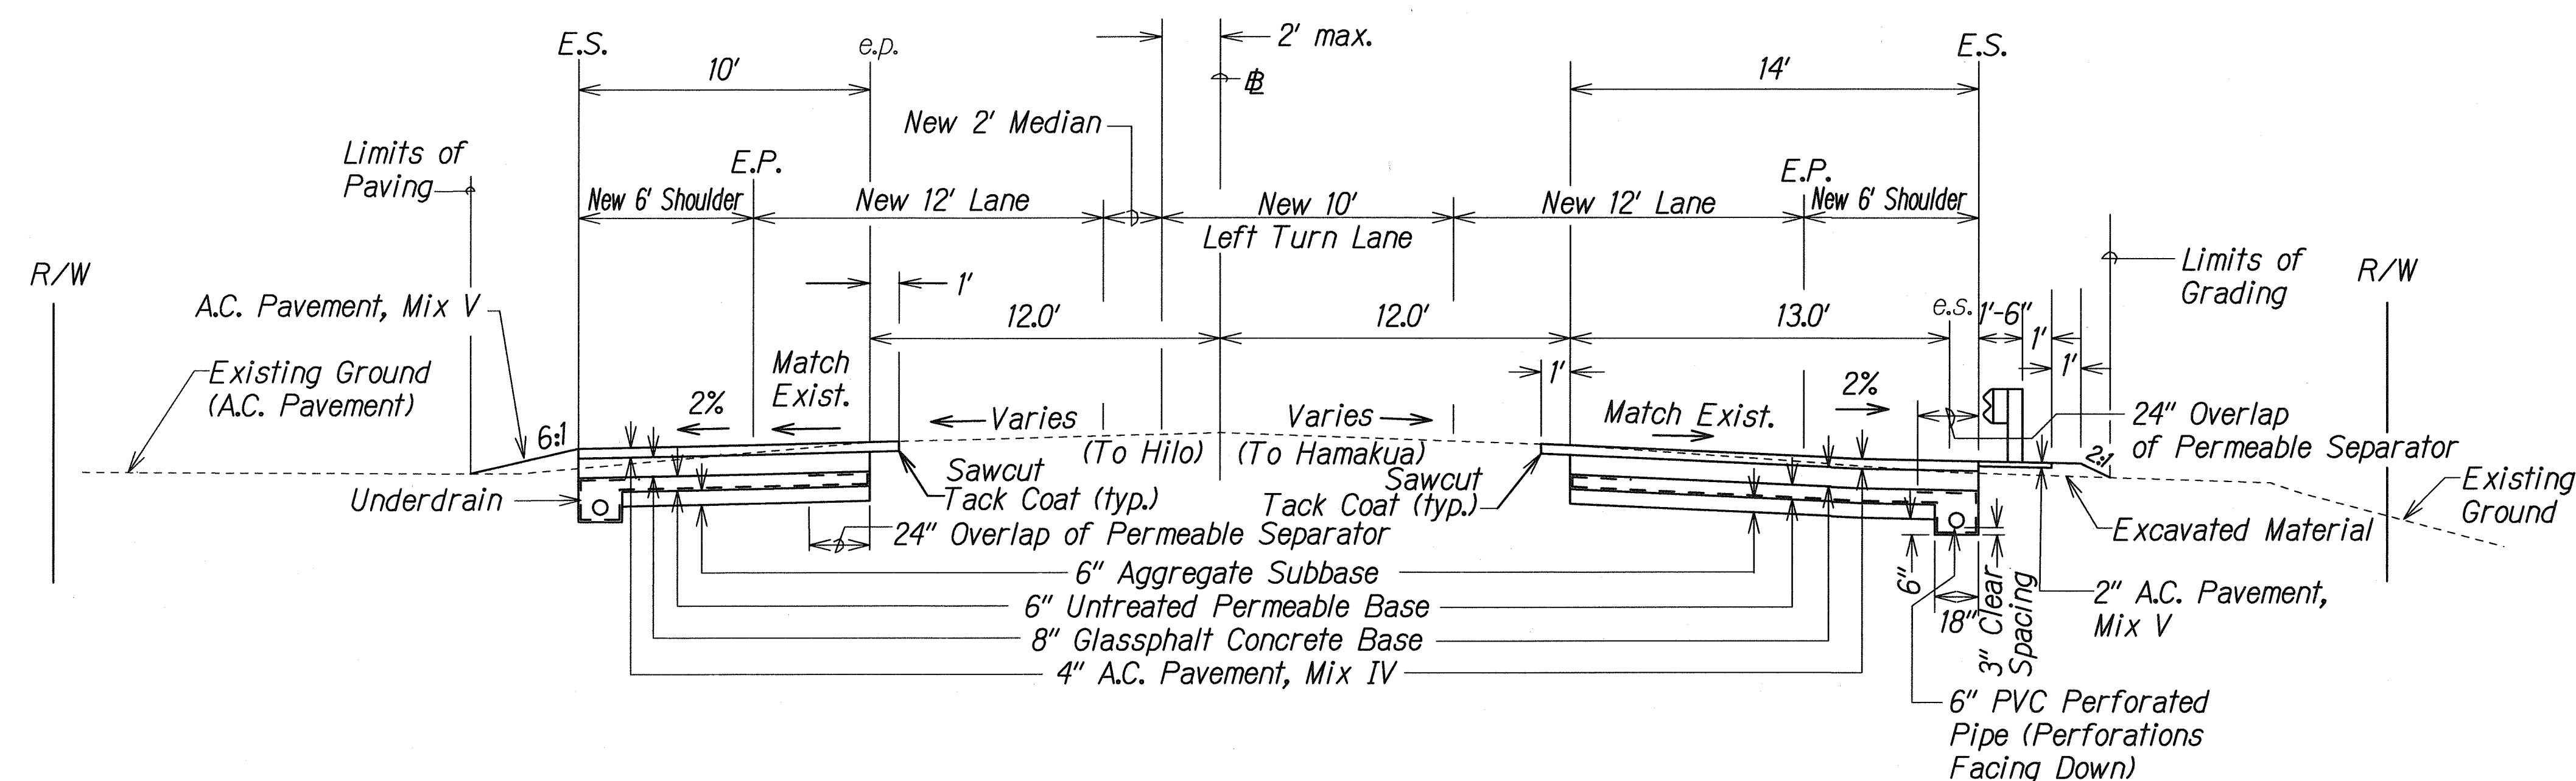

TYPICAL SECTION - HAWAII BELT ROAD

Sta. 144+40 to Sta. 153+77

Scale: 1/4"=1'-0"

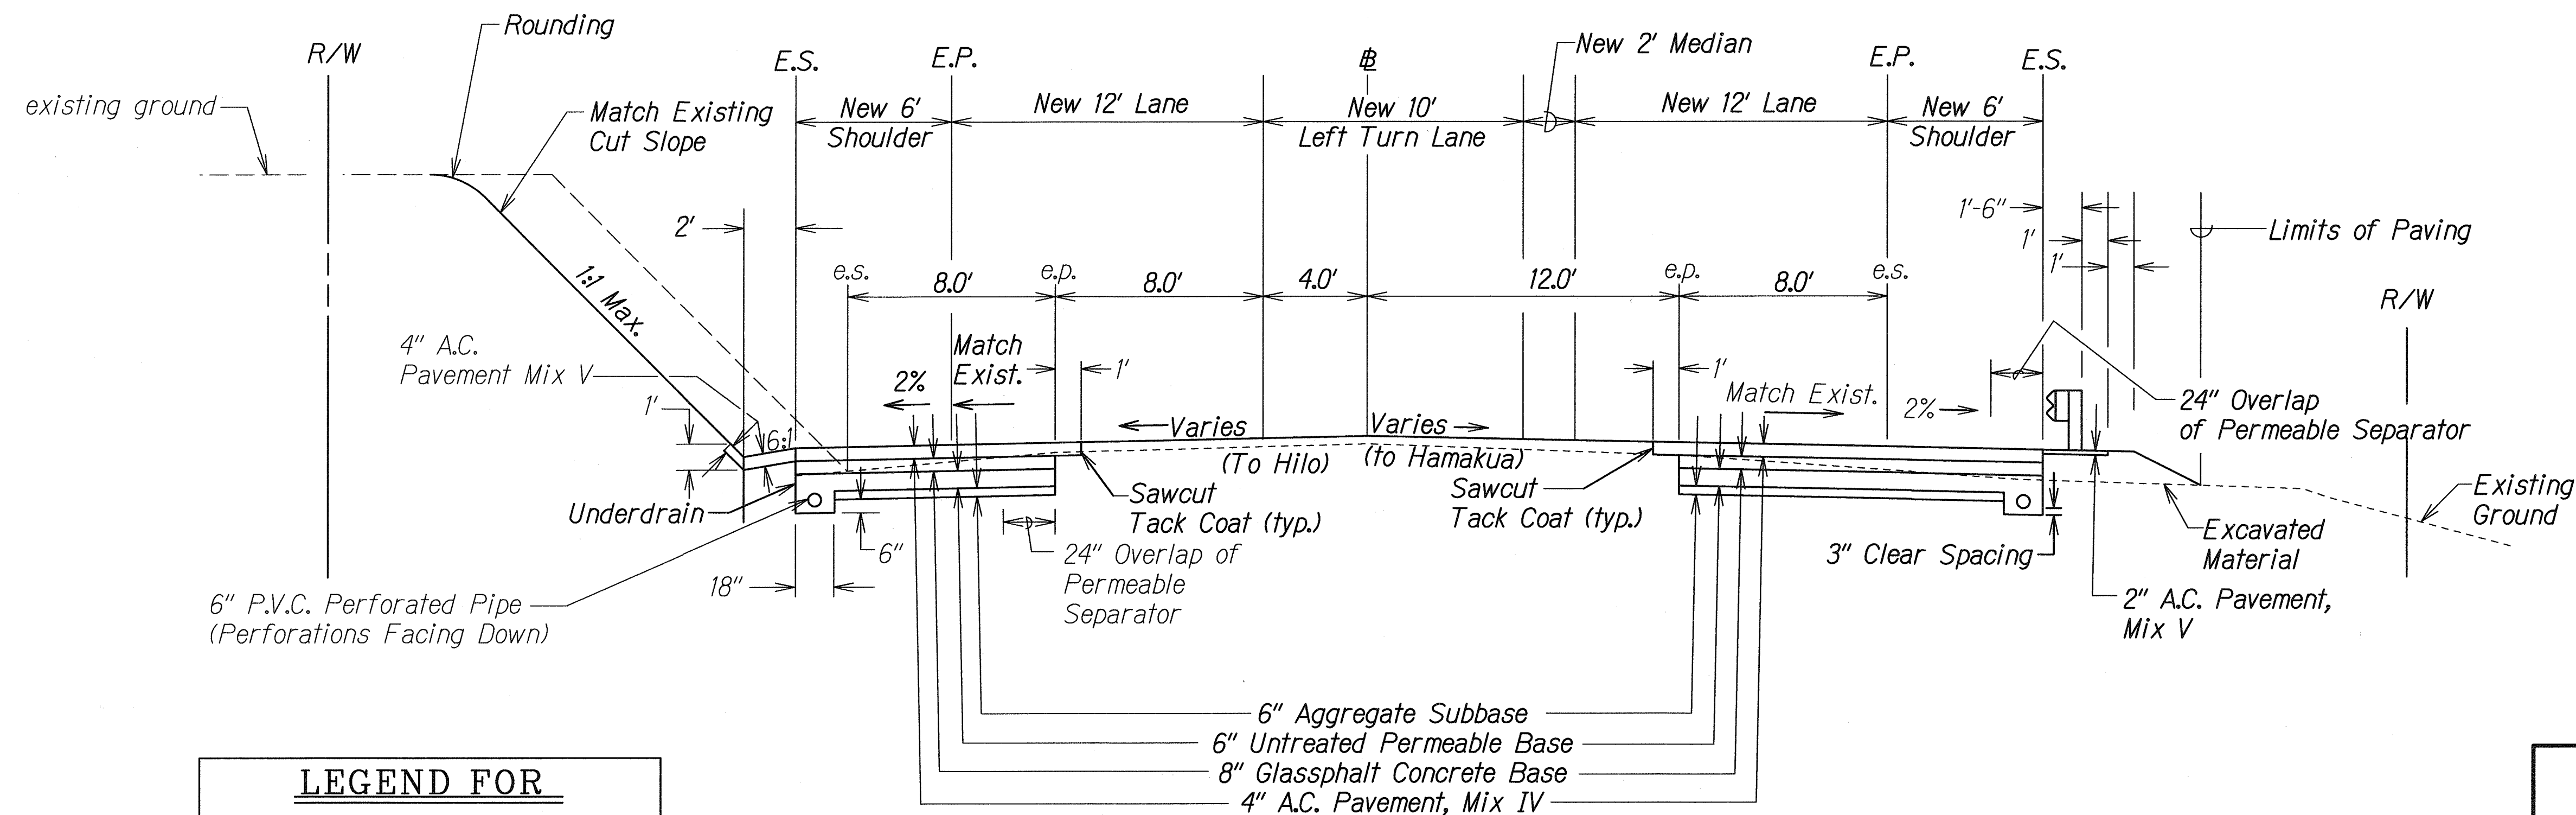

TYPICAL SECTION - HAWAII BELT ROAD

Sta. 153+77 to Sta. 159+00

Scale: 1/4"=1'-0"

Sta. 153+77 Rt. to Sta. 159+00 Lt.
Sta. 153+77 Lt. to Sta. 160+00 Lt.

LEGEND FOR AS-BUILT POSTINGS	
	Squiggly line for as-built deletion
	Double line for as-built deletion
Roadway	Text for as-built posting

STATE OF HAWAII DEPARTMENT OF TRANSPORTATION HIGHWAYS DIVISION
TYPICAL SECTION
Hawaii Belt Road Traffic Operational Improvements At Kulaimano Road Project No. 19J-01-02
Scale: 1/4"=1'-0" Date: Feb. 2003
SHEET NO. 1 OF 1 SHEETS

"AS-BUILT"