


DIST.	STATE	PROJ. NO.	SECTION	SHEET NO.	TOTAL SHEETS
HAWAII	HAW.	G-3262-01-61	1000	2	4

DATE	BY	REVISIONS
		1. SURVEYED
		2. PLANNED
		3. NOTED
		4. AREAS
		5. DIVERSED

DATE	BY	REVISIONS
		1. SURVEYED
		2. PLANNED
		3. NOTED
		4. AREAS
		5. DIVERSED

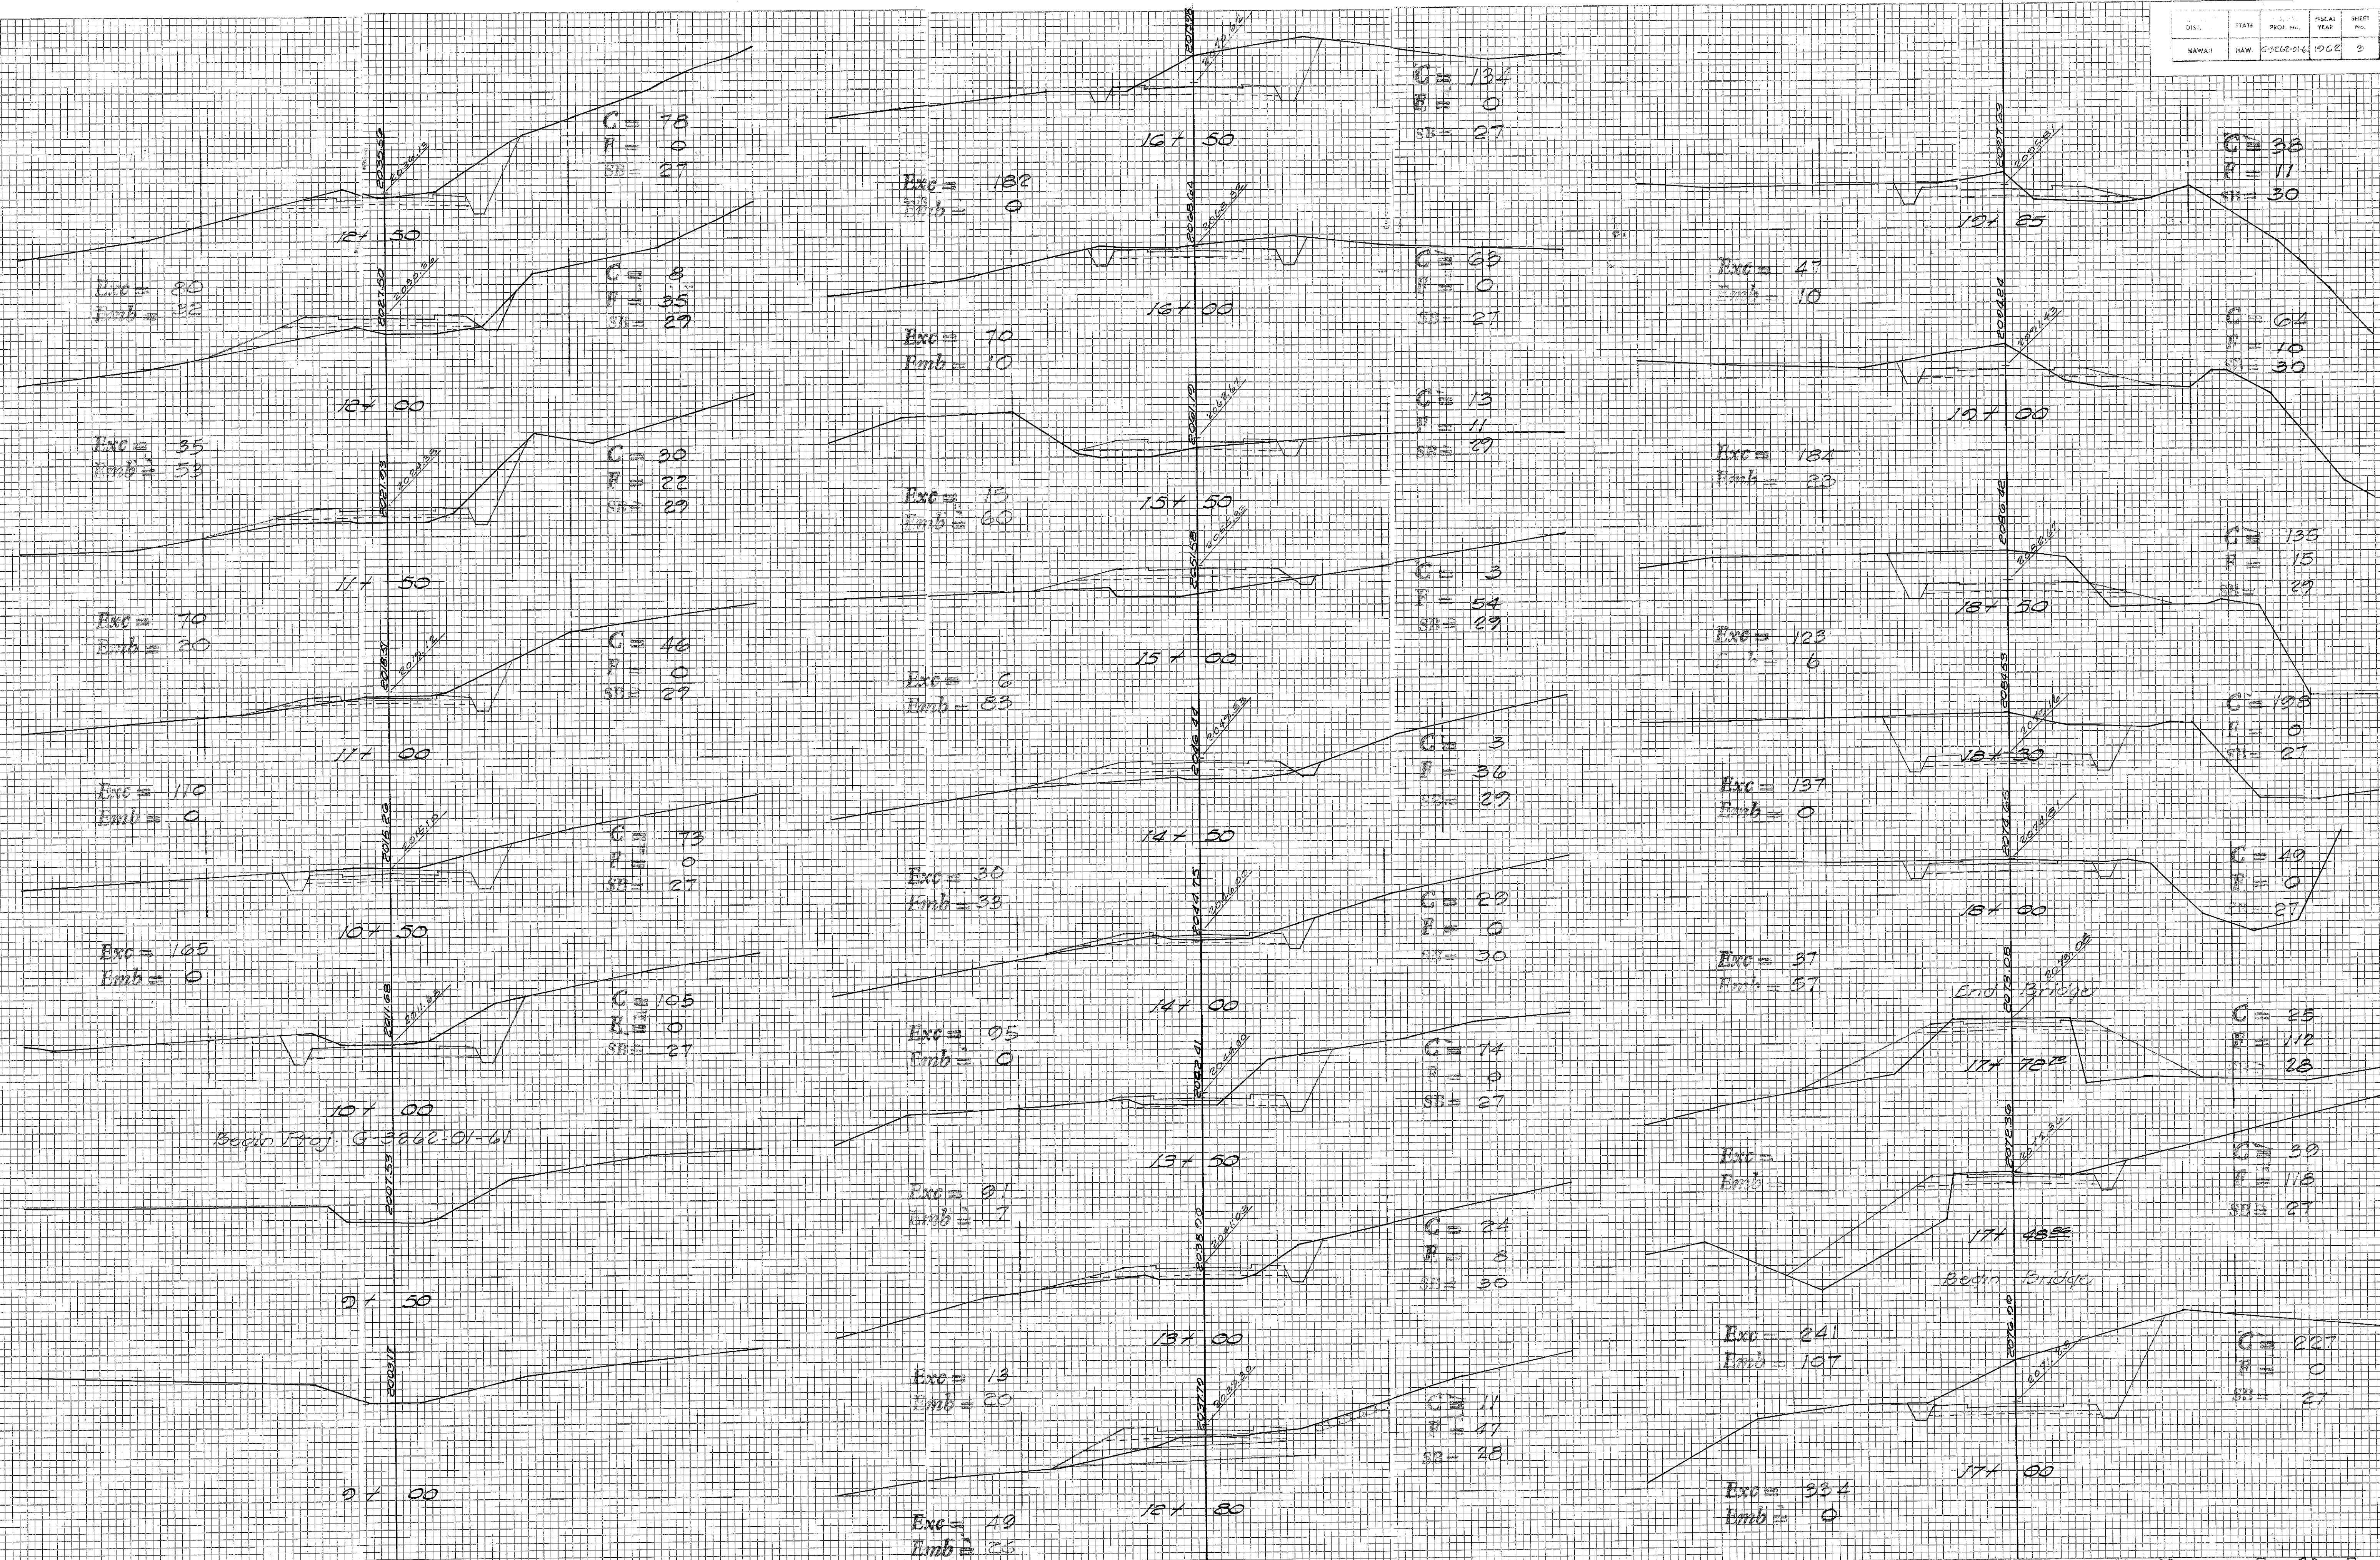

DATE	BY
SURVEYED	
NOTE BOOK	
TEMPLATE	
AREAS	
AREAS CHECKED	

DATE	BY
ORIGINAL SURVEY	
NOTE BOOK	
TEMPLATE	
AREAS	
AREAS CHECKED	

