

INDEX TO DRAWINGS	
SHEET	DESCRIPTION
1	TITLE SHEET
2	TYPICAL SECTION
3	Borrow Pit
4-12	Plan & Profile
13-15	Standard Details
16-26	Cross Sections

TERRITORY OF HAWAII

TERRITORIAL HIGHWAY DEPARTMENT

HONOLULU T.H.

PLANS OF





OLAA - PAHOA ROAD

FEDERAL AID SECONDARY PROJECT NO. S 231 (I)

DISTRICT OF PUNA



ISLAND OF HAWAII

CONVENTIONAL SIGNS USED

Centerline	_____
Boundary Lines	_____ or, _____
Fences (Noted)	_____ or, _____
Existing Roadway	_____
Box Culvert	
Circular Culvert	
Tree (Large)	 or, 
Telephone Pole	○ TP
Electric Pole	⊗ EP
Centerline Monument	⊙

SCALES

PLAN		1 IN. = 100 FT.
PROFILE	HOR.	1 IN. = 100 FT.
	VERT.	1 IN. = 10 FT.
GROSS SECTION	HOR.	1 IN. = 10 FT.
	VERT.	1 IN. = 10 FT.

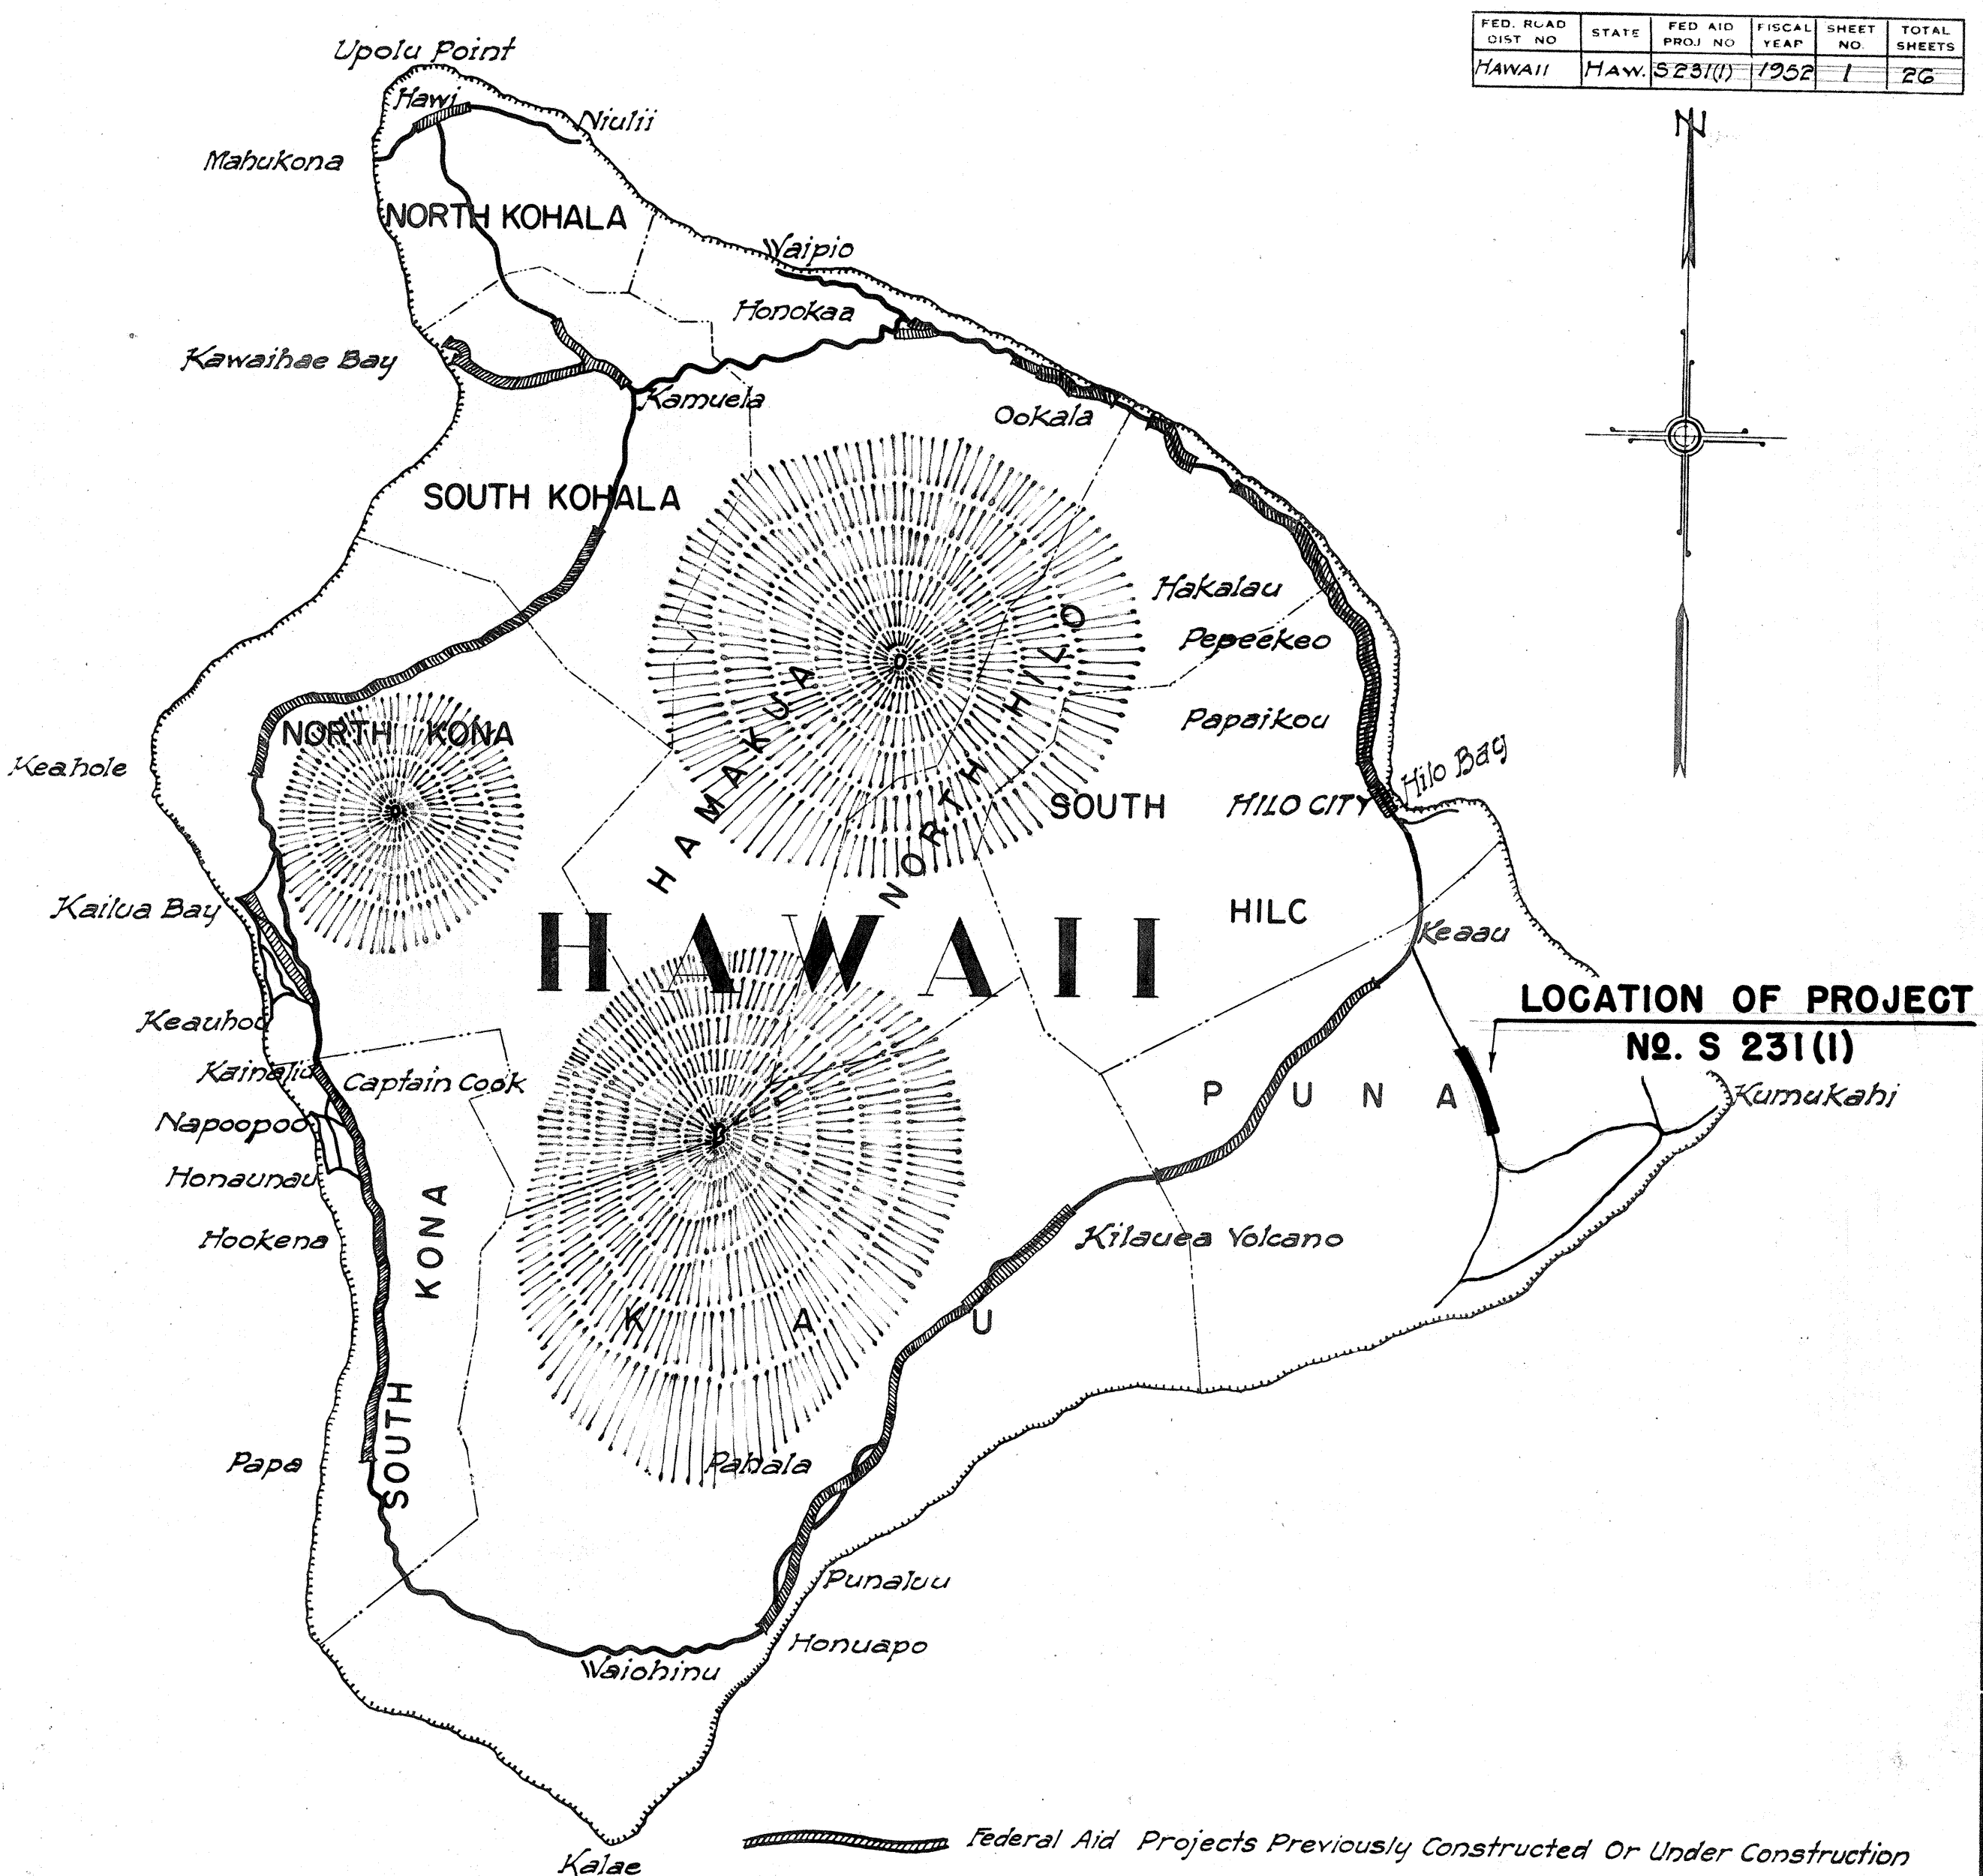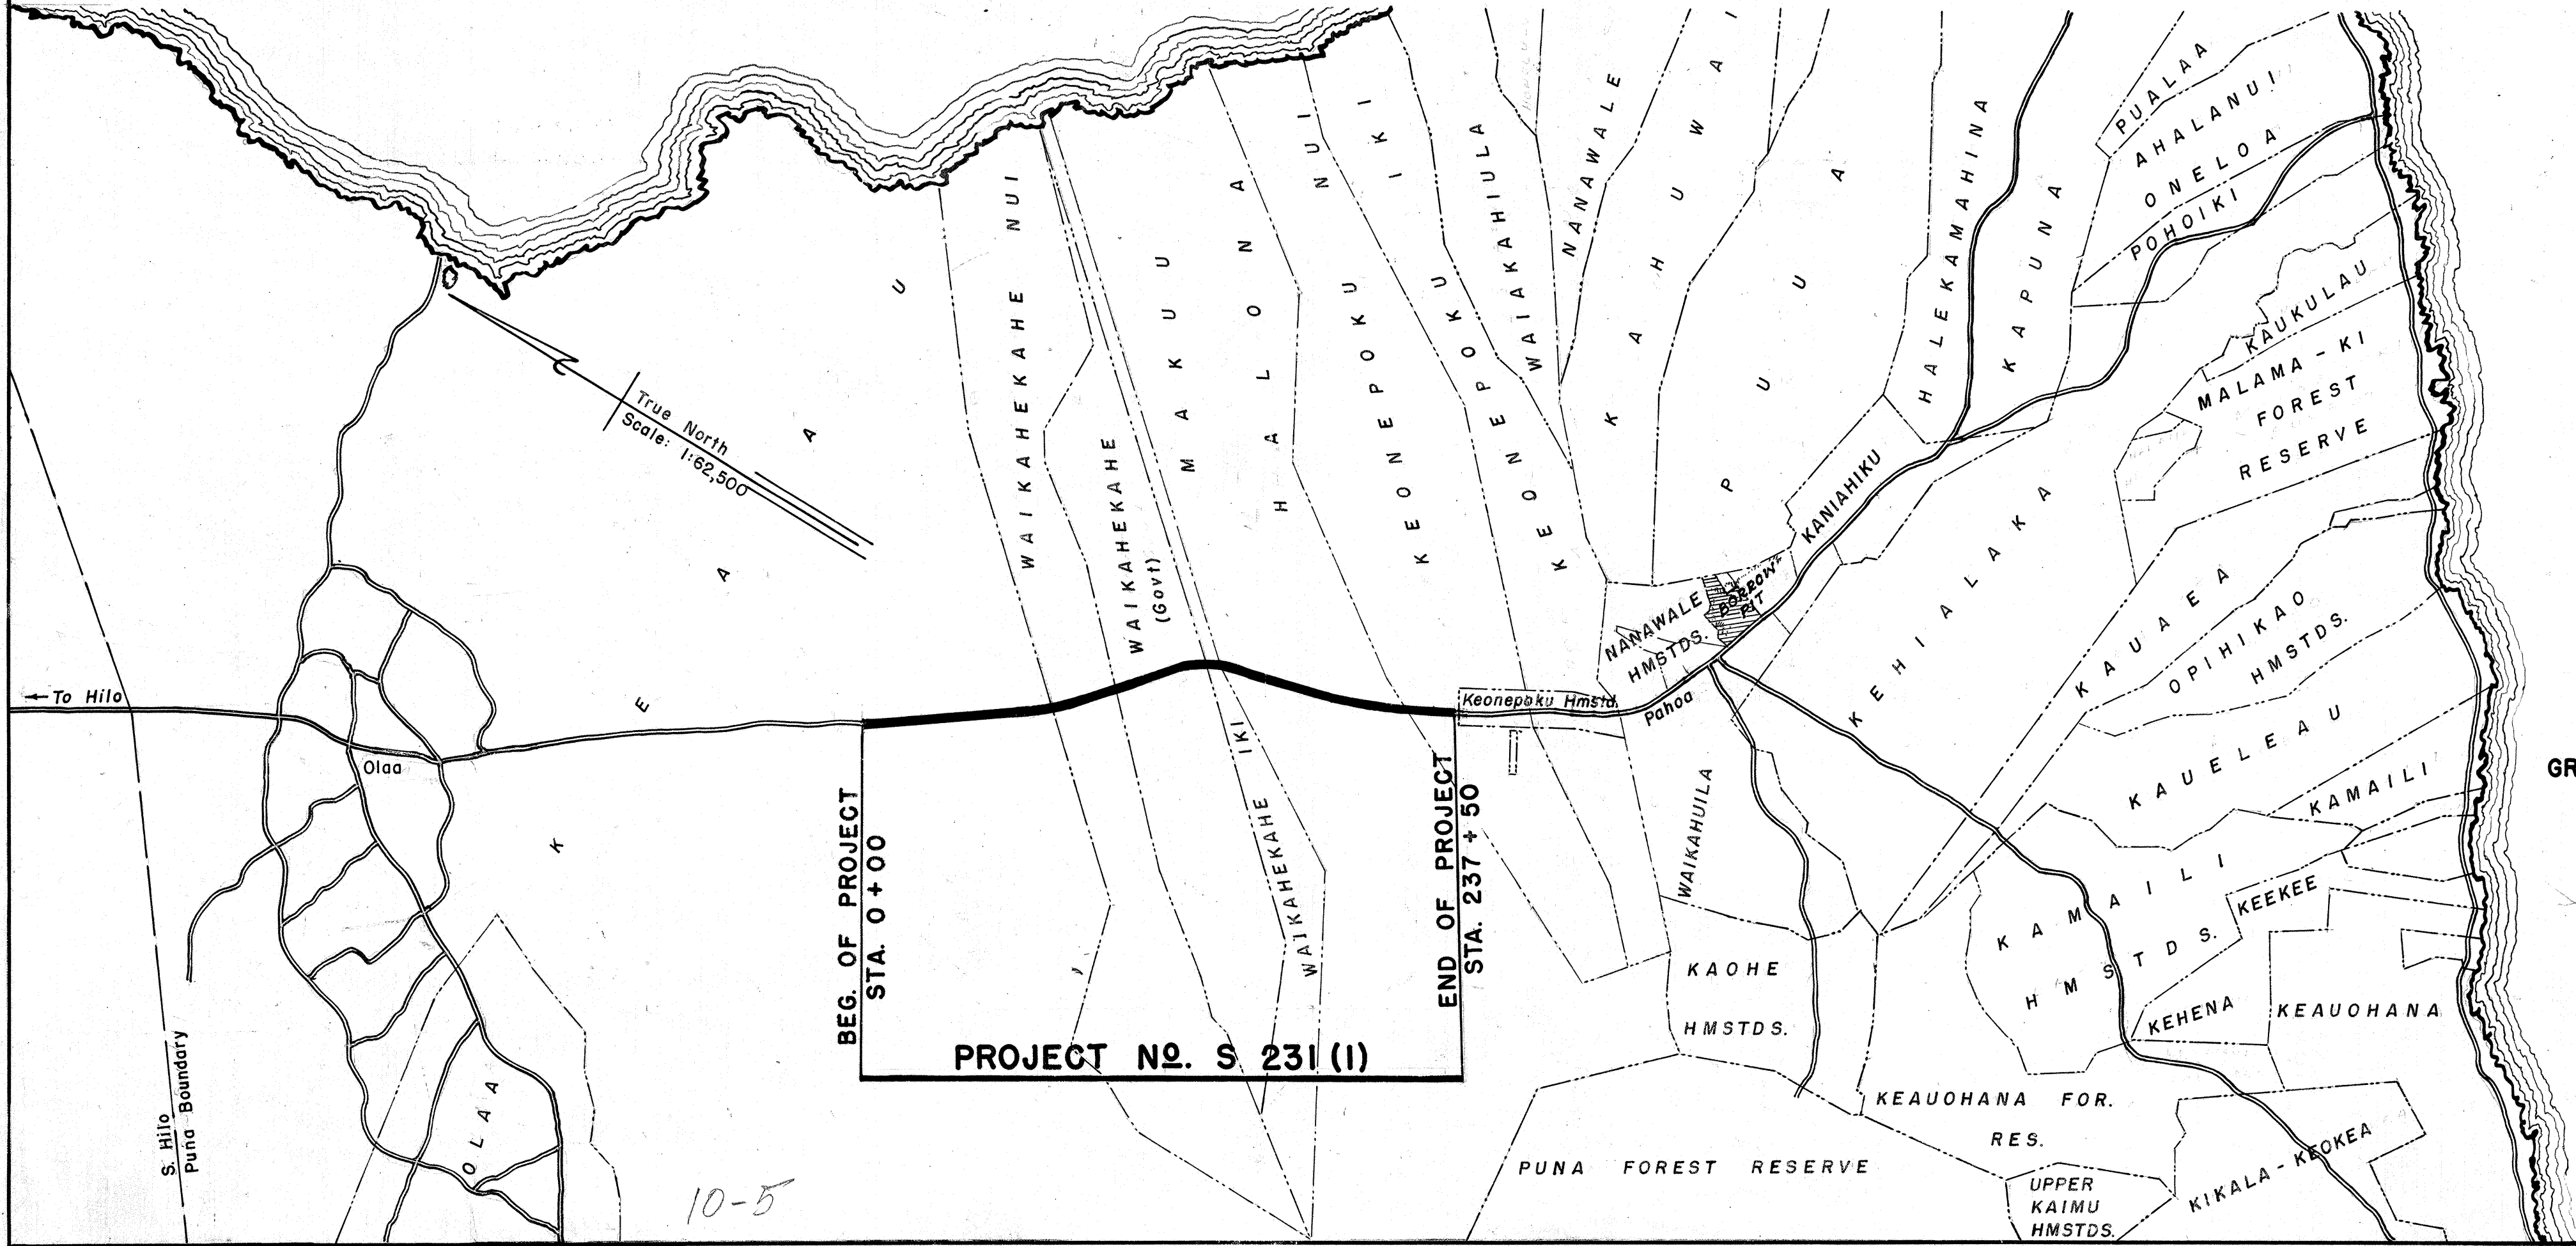

NOTE

ALL CHANGES MADE DURING CONSTRUCTION  
HAVE BEEN NOTED IN RED ON THESE  
SHEETS AND CHECKED BY

GENERAL LOCATION PLAN  
SCALE: 1" = 62,500  
GROSS & NET LENGTH OF PROJECT 4.498 MILES

*John W. Smith*  
PROJECT ENGINEER  
May 14, 1954  
DATE

DEPARTMENT OF COMMERCE BUREAU OF PUBLIC ROADS	
RECOMMENDED FOR APPROVAL:	
<div></div>	<div></div>
DISTRICT ENGINEER	DATE
<div></div>	<div></div>
DIVISION ENGINEER	DATE

APPROVED: *[Signature]* DATE 2-4-52  
TERRITORIAL HIGHWAY ENGINEER