



ORIGINAL		SJ	DATE
SURVEY	SURVEYED	H.T.	4/59
	PLOTTED	I.F.	6/23/58
	TEMPLATE	H.N.	7/1/58
NOTE BOOK	AREAS	S.H.K.	7/58

FED ROAD DIST. No.	STATE	FED AID PROJ. No.	FISCAL YEAR	SHEET No.	TOTAL SHEETS
PA-100	PA.	EA-3(1)	1955	6	9

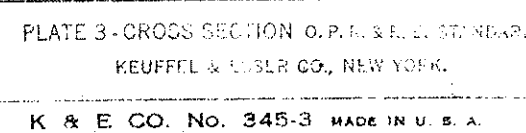

5786. (6)

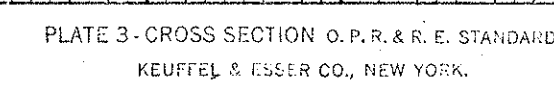


FINAL SURVEY	DATE	
	BY	
	PROJECTED PLUTIMATE	
	NOTE BOOK NO.	

ORIGINAL SURVEY	DATE	
	BY	
	PROJECTED PLUTIMATE	
	NOTE BOOK NO.	

FED. ROAD DIST. NO.	STATE	FED. AID PROJ. NO.	FISCAL YEAR	SHEET NO.	TOTAL SHEETS
HAWAII	HAW	ER 3(1)	1955	8	9



Note: Flatter cut slopes in this vicinity
to provide better drainage.

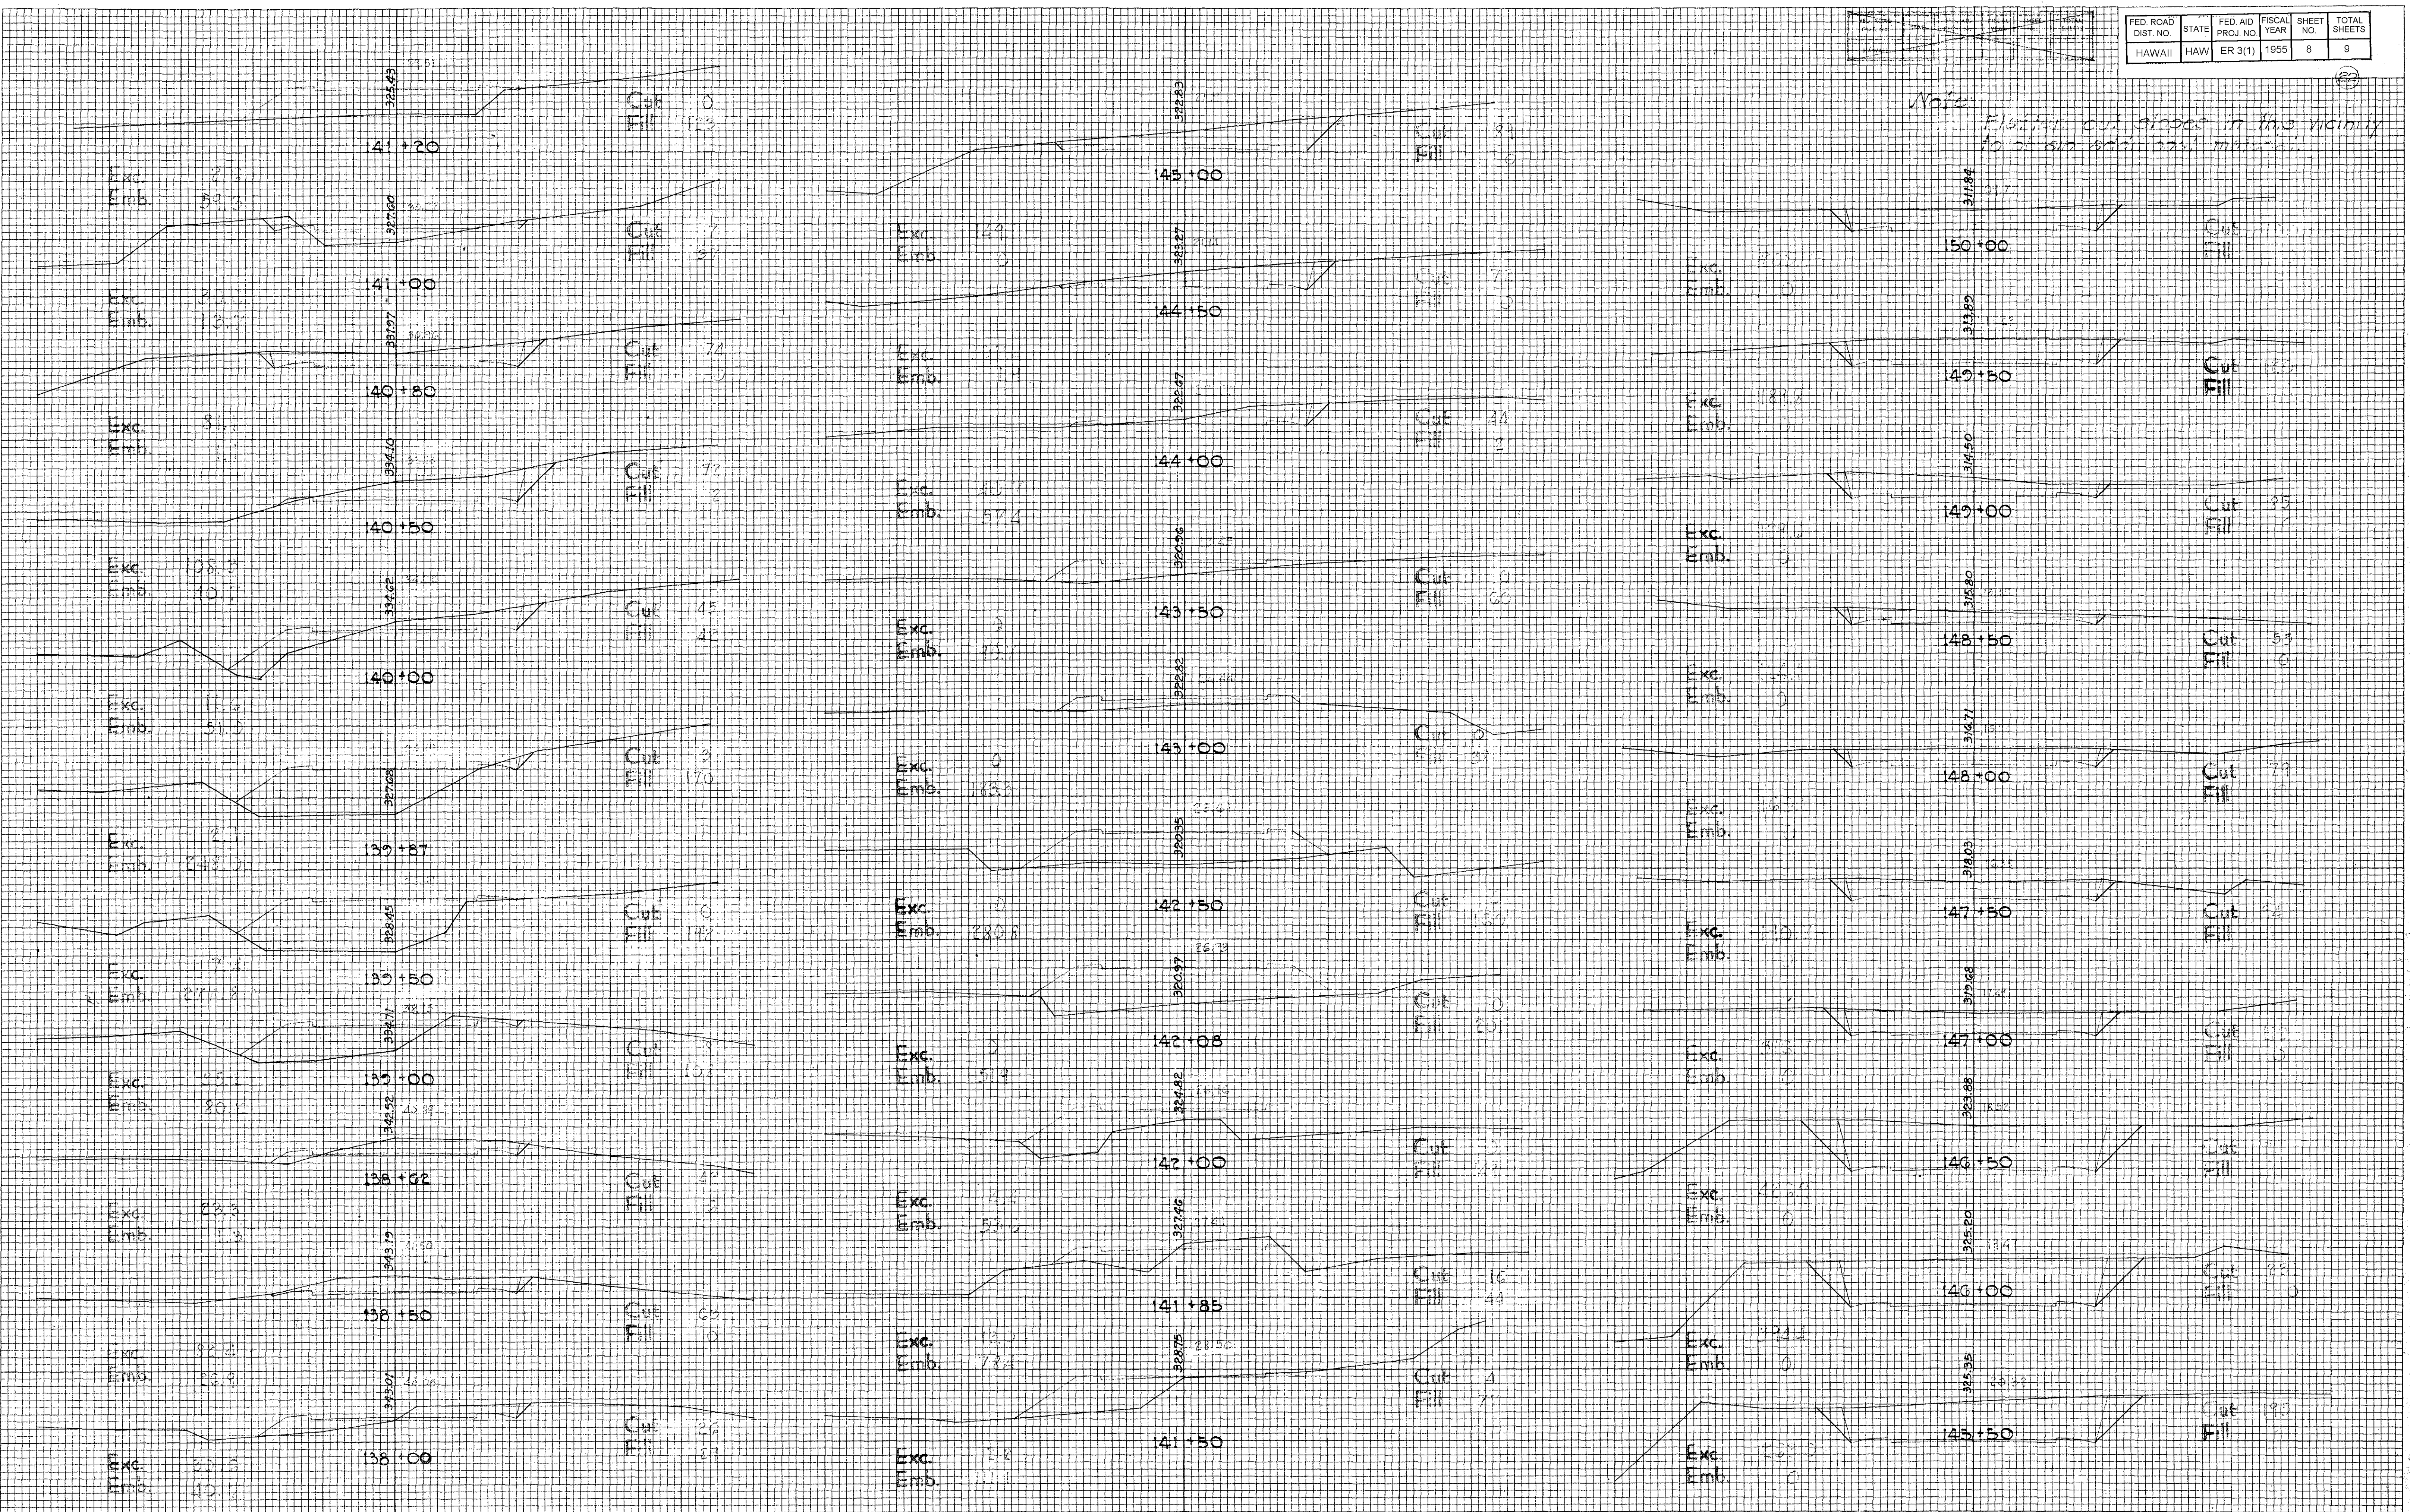

ORIGINAL	SURVEYED	BY	DATE
SURVEY	PLOTTED	T. T.	6/25
NOTE BOOK	TEMPLATE	T. Y.	6/25
NO.	AREAS	N.	7/25
	CHECKED	J. J.	7/25

PLATE 3 CROSS SECTION O. P. R. & R. E. STANDARD
100% RAG PAPER—MADE AND PRINTED IN U. S. A.
EUGENE DIETZGEN CO.

5786.9