

INDEX TO DRAWINGS	
SHEET	DESCRIPTION
1	TITLE SHEET
2	TYPICAL SECTION
3-4	PLAN & PROFILE
5	STANDARD DETAILS
6-9	CROSS-SECTIONS

TERRITORY OF HAWAII

TERRITORIAL HIGHWAY DEPARTMENT

HONOLULU T.H.

PLANS OF

KAPOHO - PAHOA ROAD

EMERGENCY RELIEF PROJECT NO. ER-3(I)

DISTRICT OF PUNA

ISLAND OF HAWAII

PLAN

PROFILE

CROSS SECTION



1 INCH = 100 FT.

HOR. 1 INCH = 100 FT.

VER. 1 INCH = 10 FT.

HOR. 1 INCH = 10 FT.

VER. 1 INCH = 10 FT.

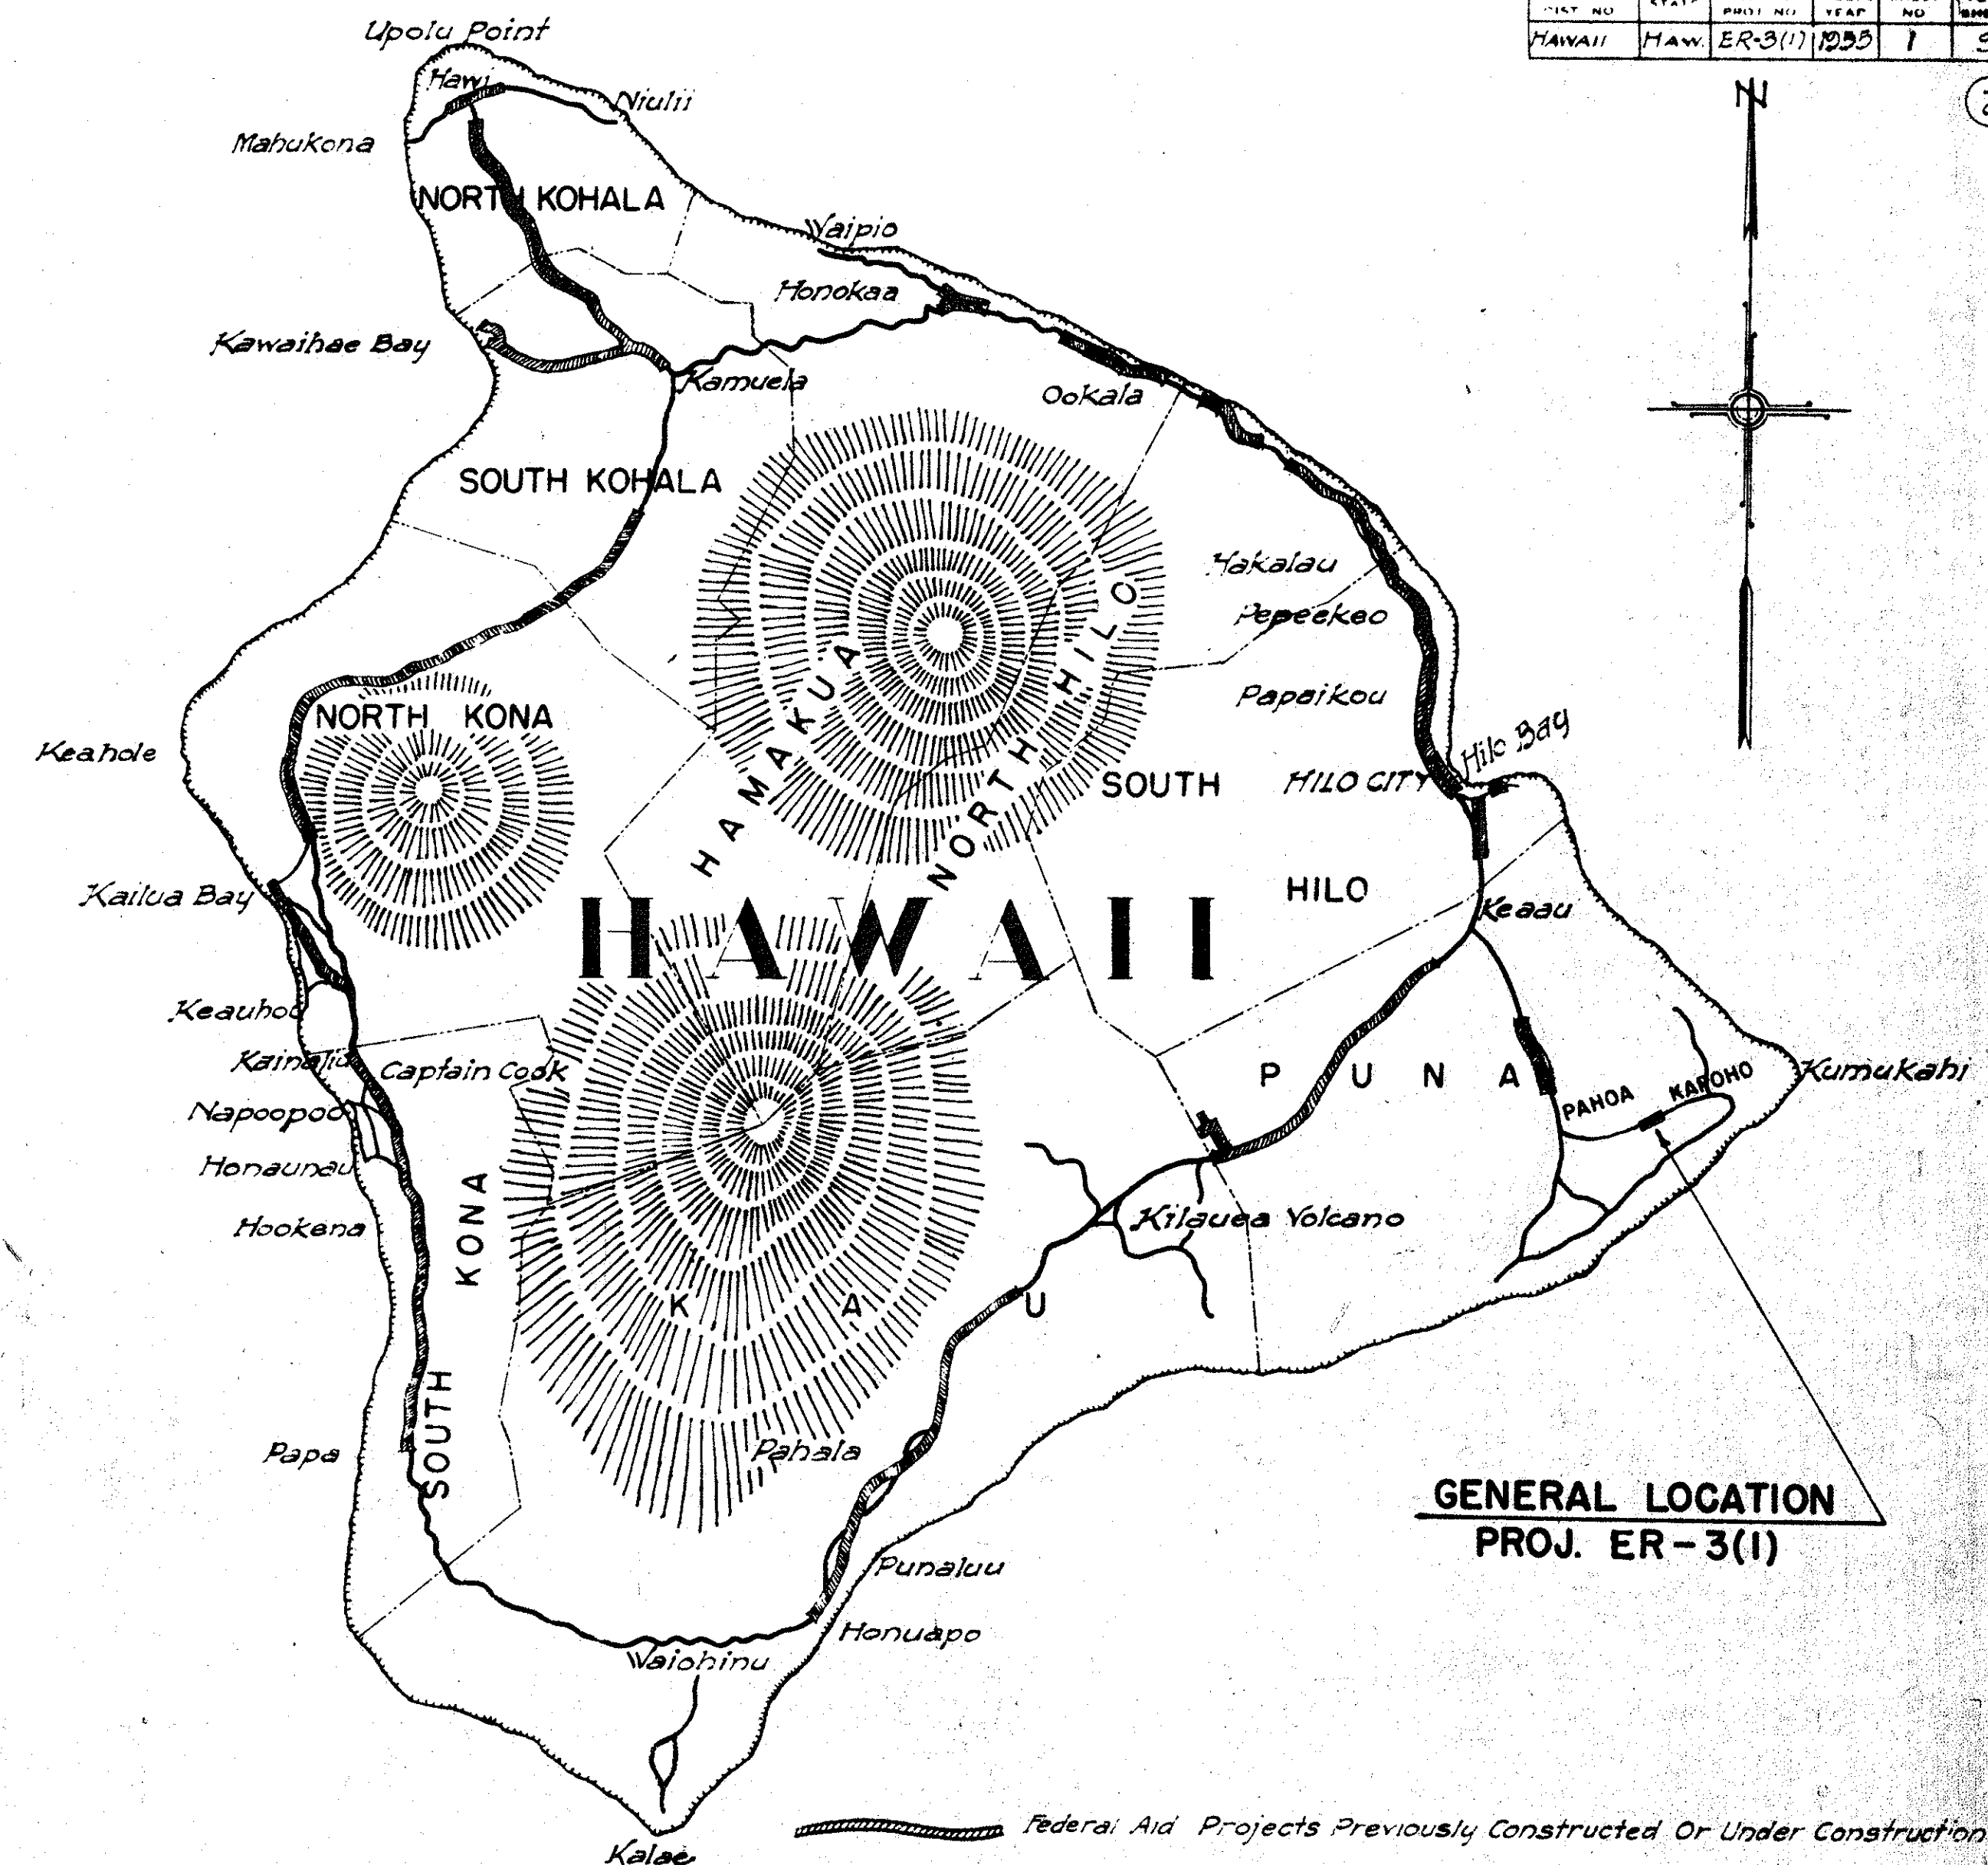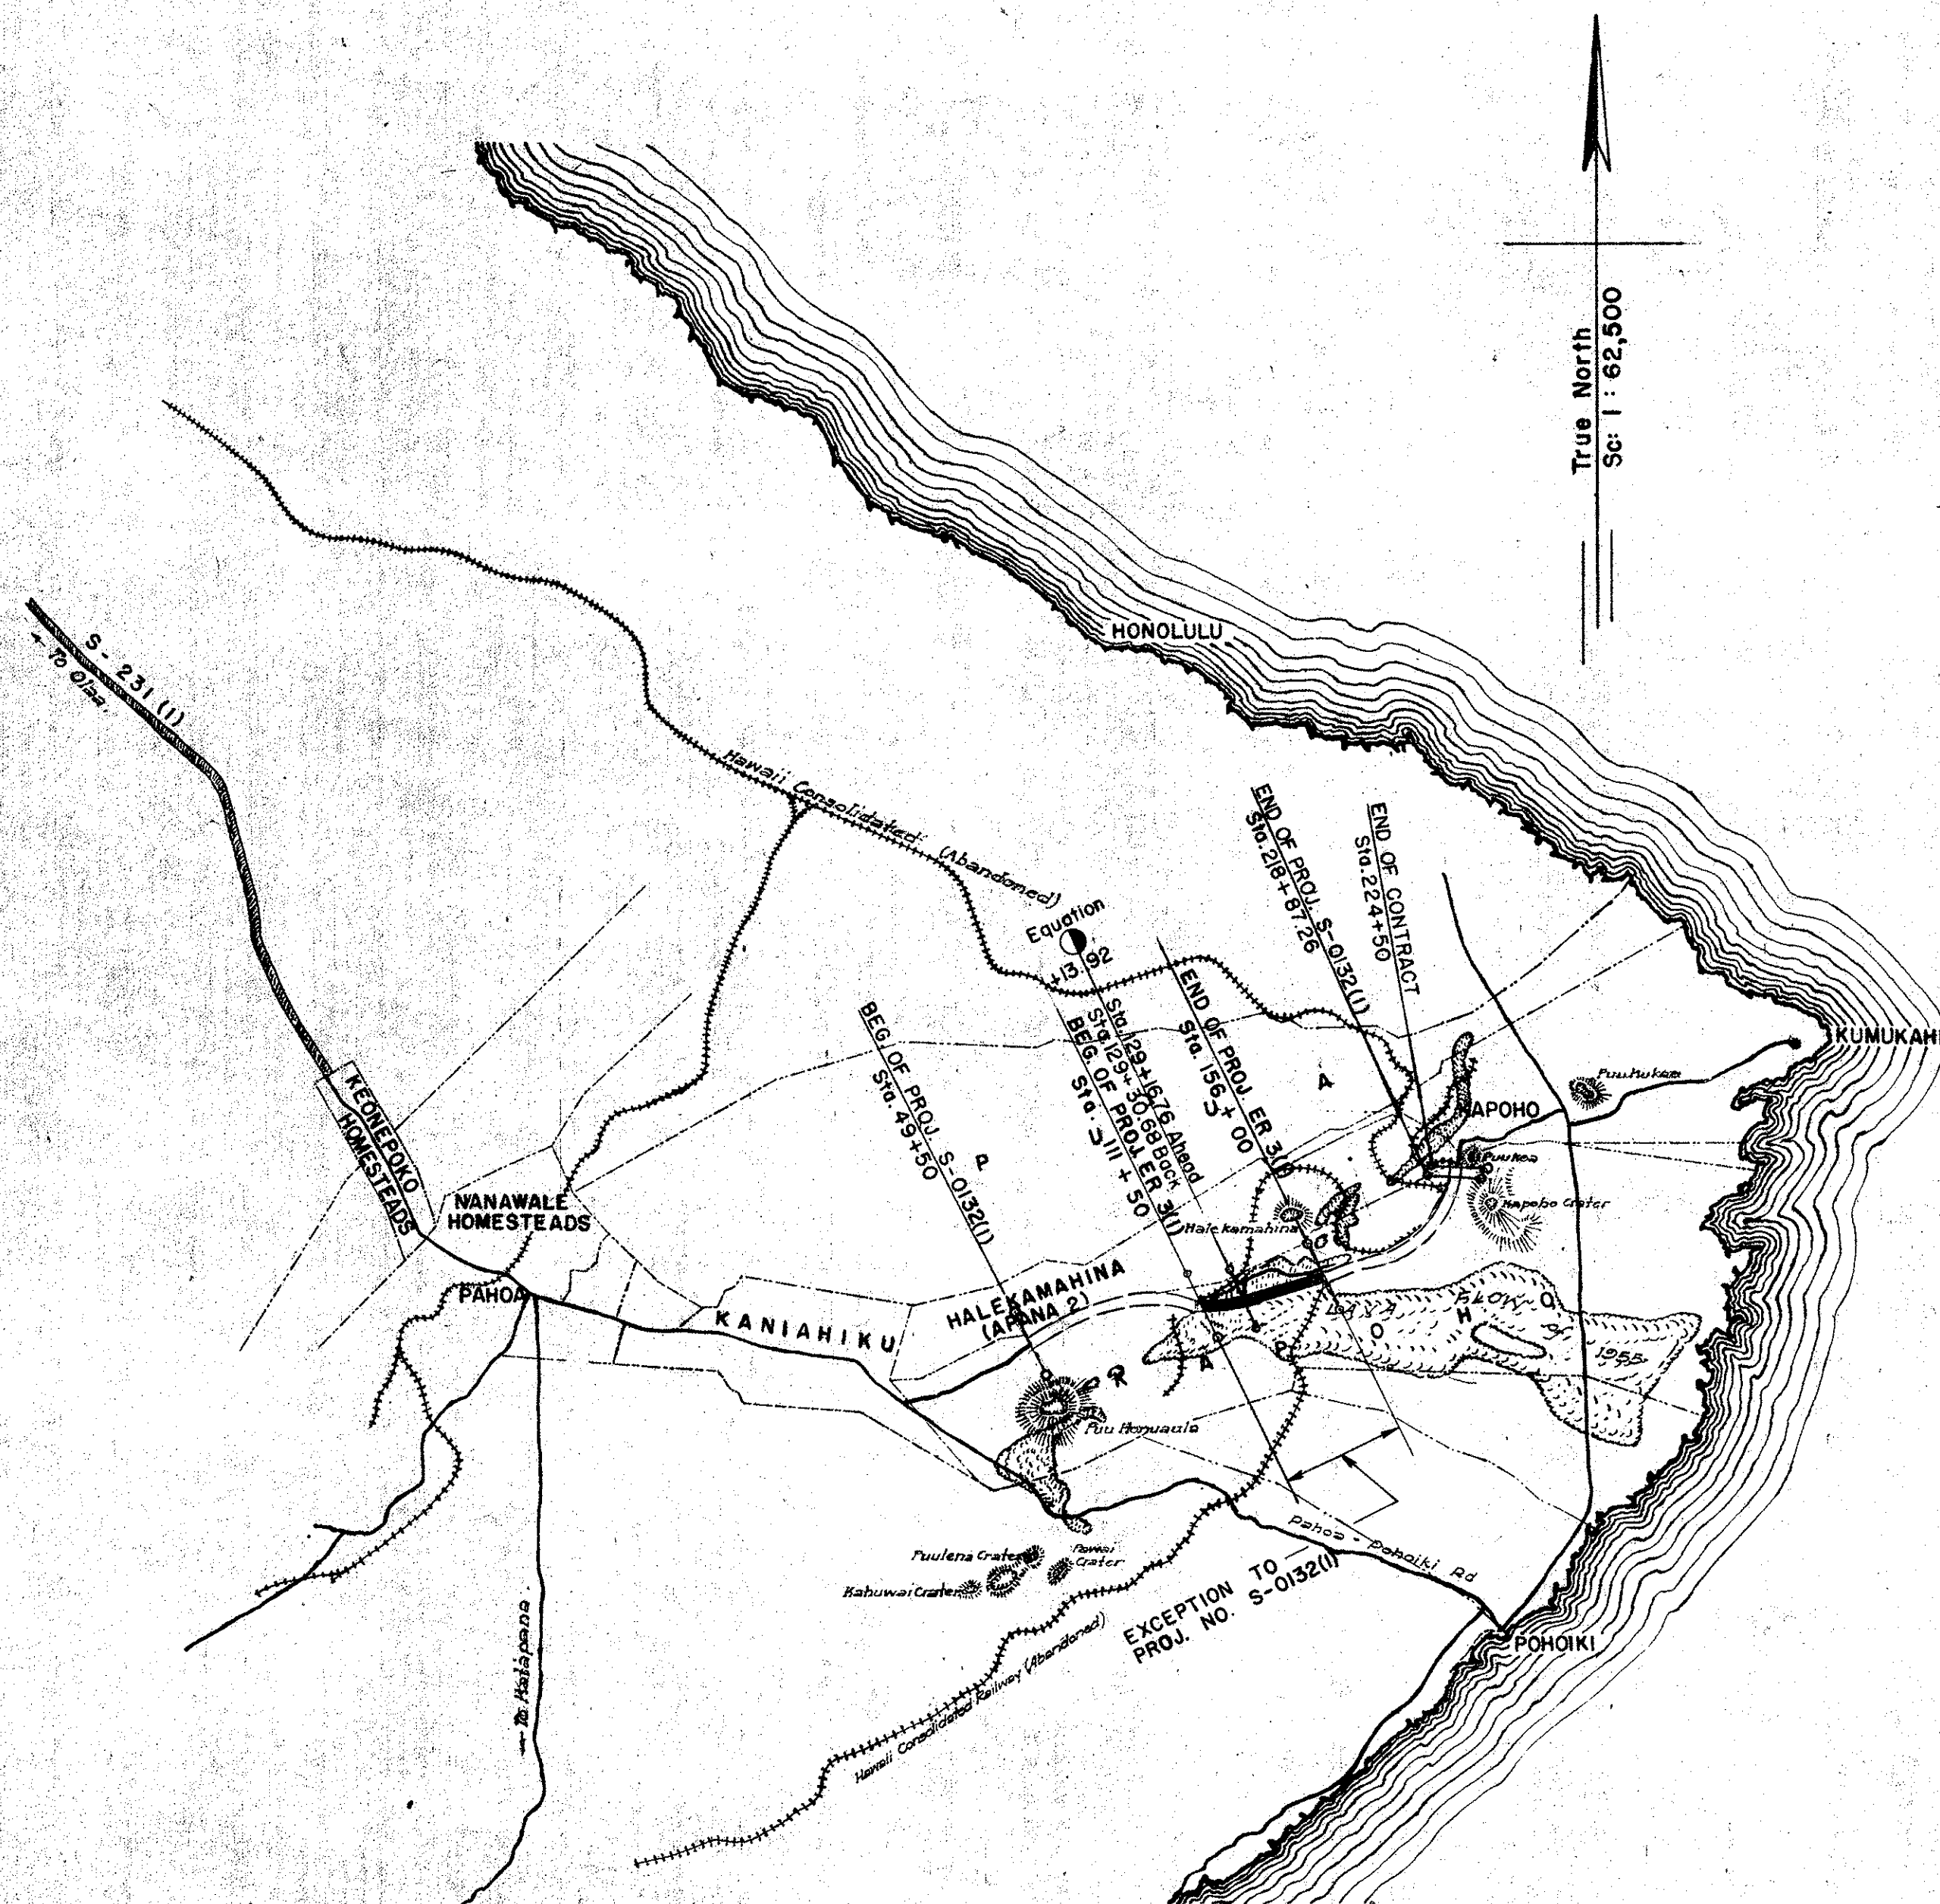

GENERAL LOCATION

PROJ. ER-3(I)

NOTE:-

All changes made during construction have been noted in red on these sheets and checked by:-

Theodore A. Wray

Project Engineer

October 8, 1956

Date

GROSS & NET LENGTH OF PROJECT

0.845 MILE

APPROVED: DATE 9-29-55

Theodore A. Wray

TERRITORIAL HIGHWAY ENGINEER

DEPARTMENT OF COMMERCE

BUREAU OF PUBLIC ROADS

APPROVED:

DISTRICT ENGINEER

DATE