


FINAL SURVEY	DATE	BY
	NOTED	BY
	NOTE BOOK	NO.
	NO.	NO.

ORIGINAL SURVEY	DATE	BY
	NOTED	BY
	NOTE BOOK	NO.
	NO.	NO.


Note: Solid line indicates original ground line taken prior to volcanic eruption of Feb., 1955.
Dash line indicates ground line after the volcanic eruption of Feb., 1955.

NO.	DATE	BY	NO.	DATE	BY
1	1955	1	1	1955	1
2	1955	2	2	1955	2
3	1955	3	3	1955	3
4	1955	4	4	1955	4
5	1955	5	5	1955	5
6	1955	6	6	1955	6
7	1955	7	7	1955	7
8	1955	8	8	1955	8
9	1955	9	9	1955	9
10	1955	10	10	1955	10
11	1955	11	11	1955	11
12	1955	12	12	1955	12
13	1955	13	13	1955	13
14	1955	14	14	1955	14
15	1955	15	15	1955	15
16	1955	16	16	1955	16
17	1955	17	17	1955	17
18	1955	18	18	1955	18
19	1955	19	19	1955	19
20	1955	20	20	1955	20
21	1955	21	21	1955	21
22	1955	22	22	1955	22
23	1955	23	23	1955	23
24	1955	24	24	1955	24
25	1955	25	25	1955	25

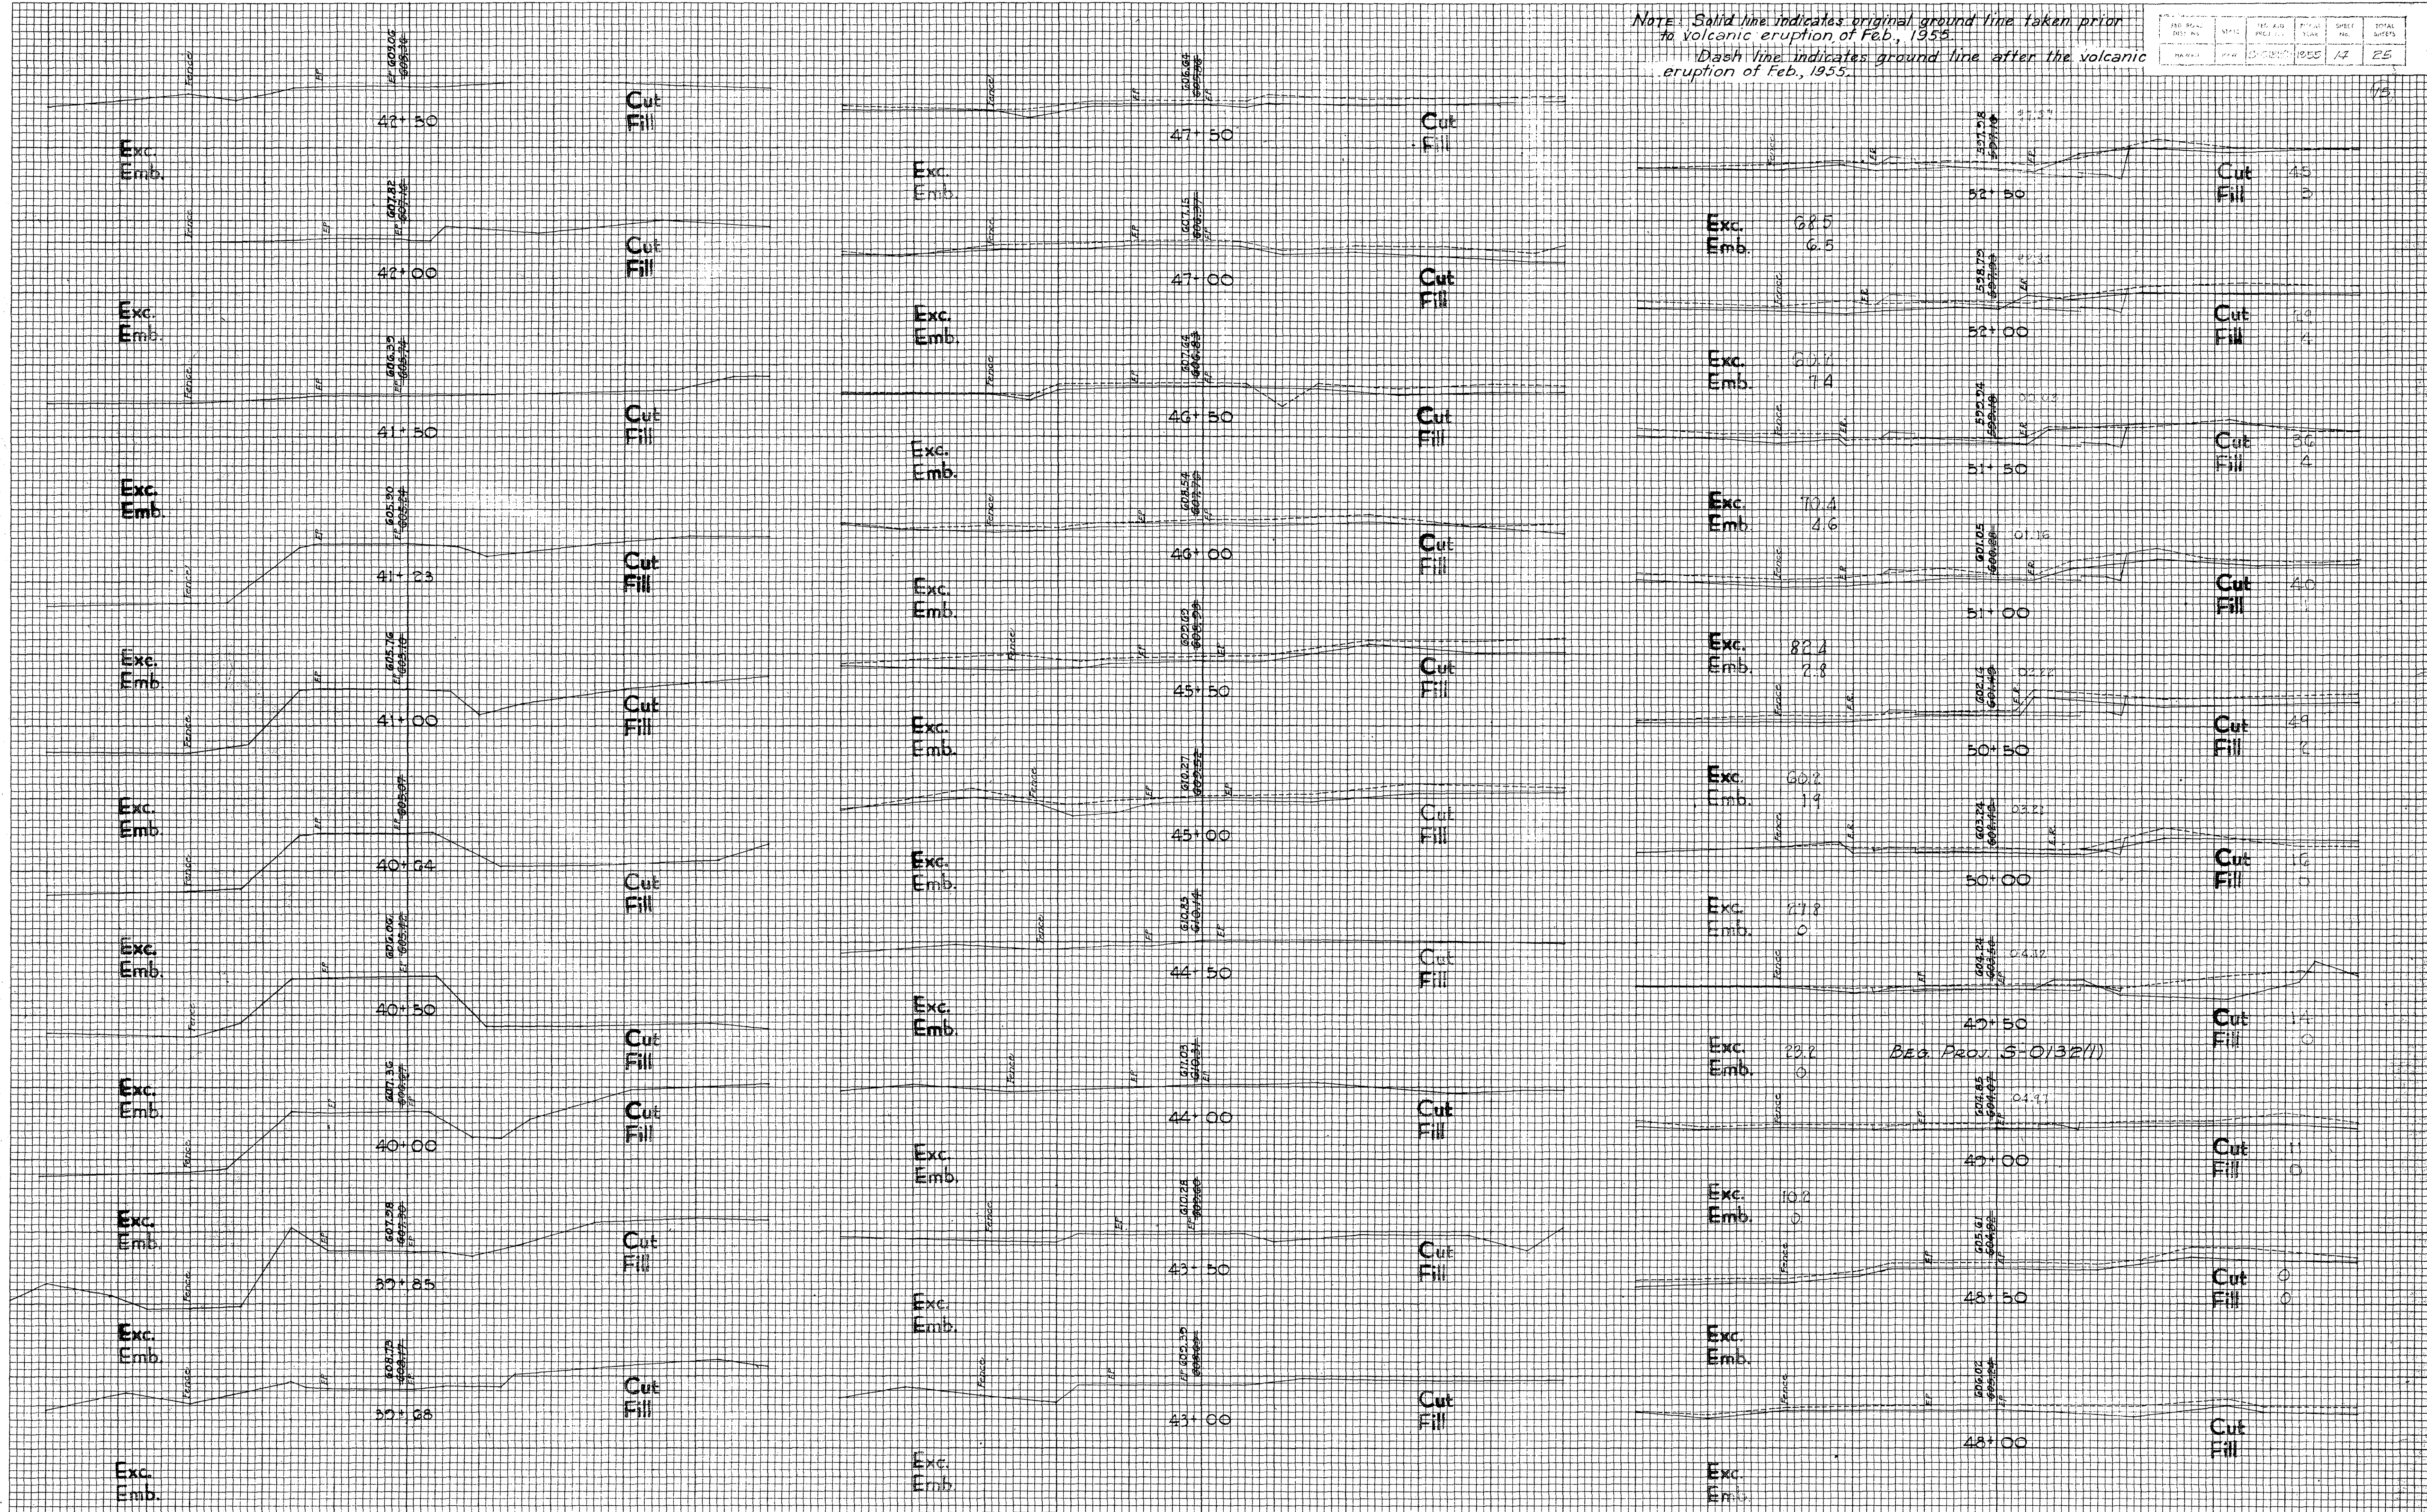

FINAL SURVEY	DATE	
	BY	
	SURVEYED	
	PLOTTED	
NOTE BOOK	NO.	
	AREAS CHECKED	

ORIGINAL SURVEY	DATE	
	BY	
	SURVEYED	
	PLOTTED	
NOTE BOOK	NO.	
	AREAS CHECKED	

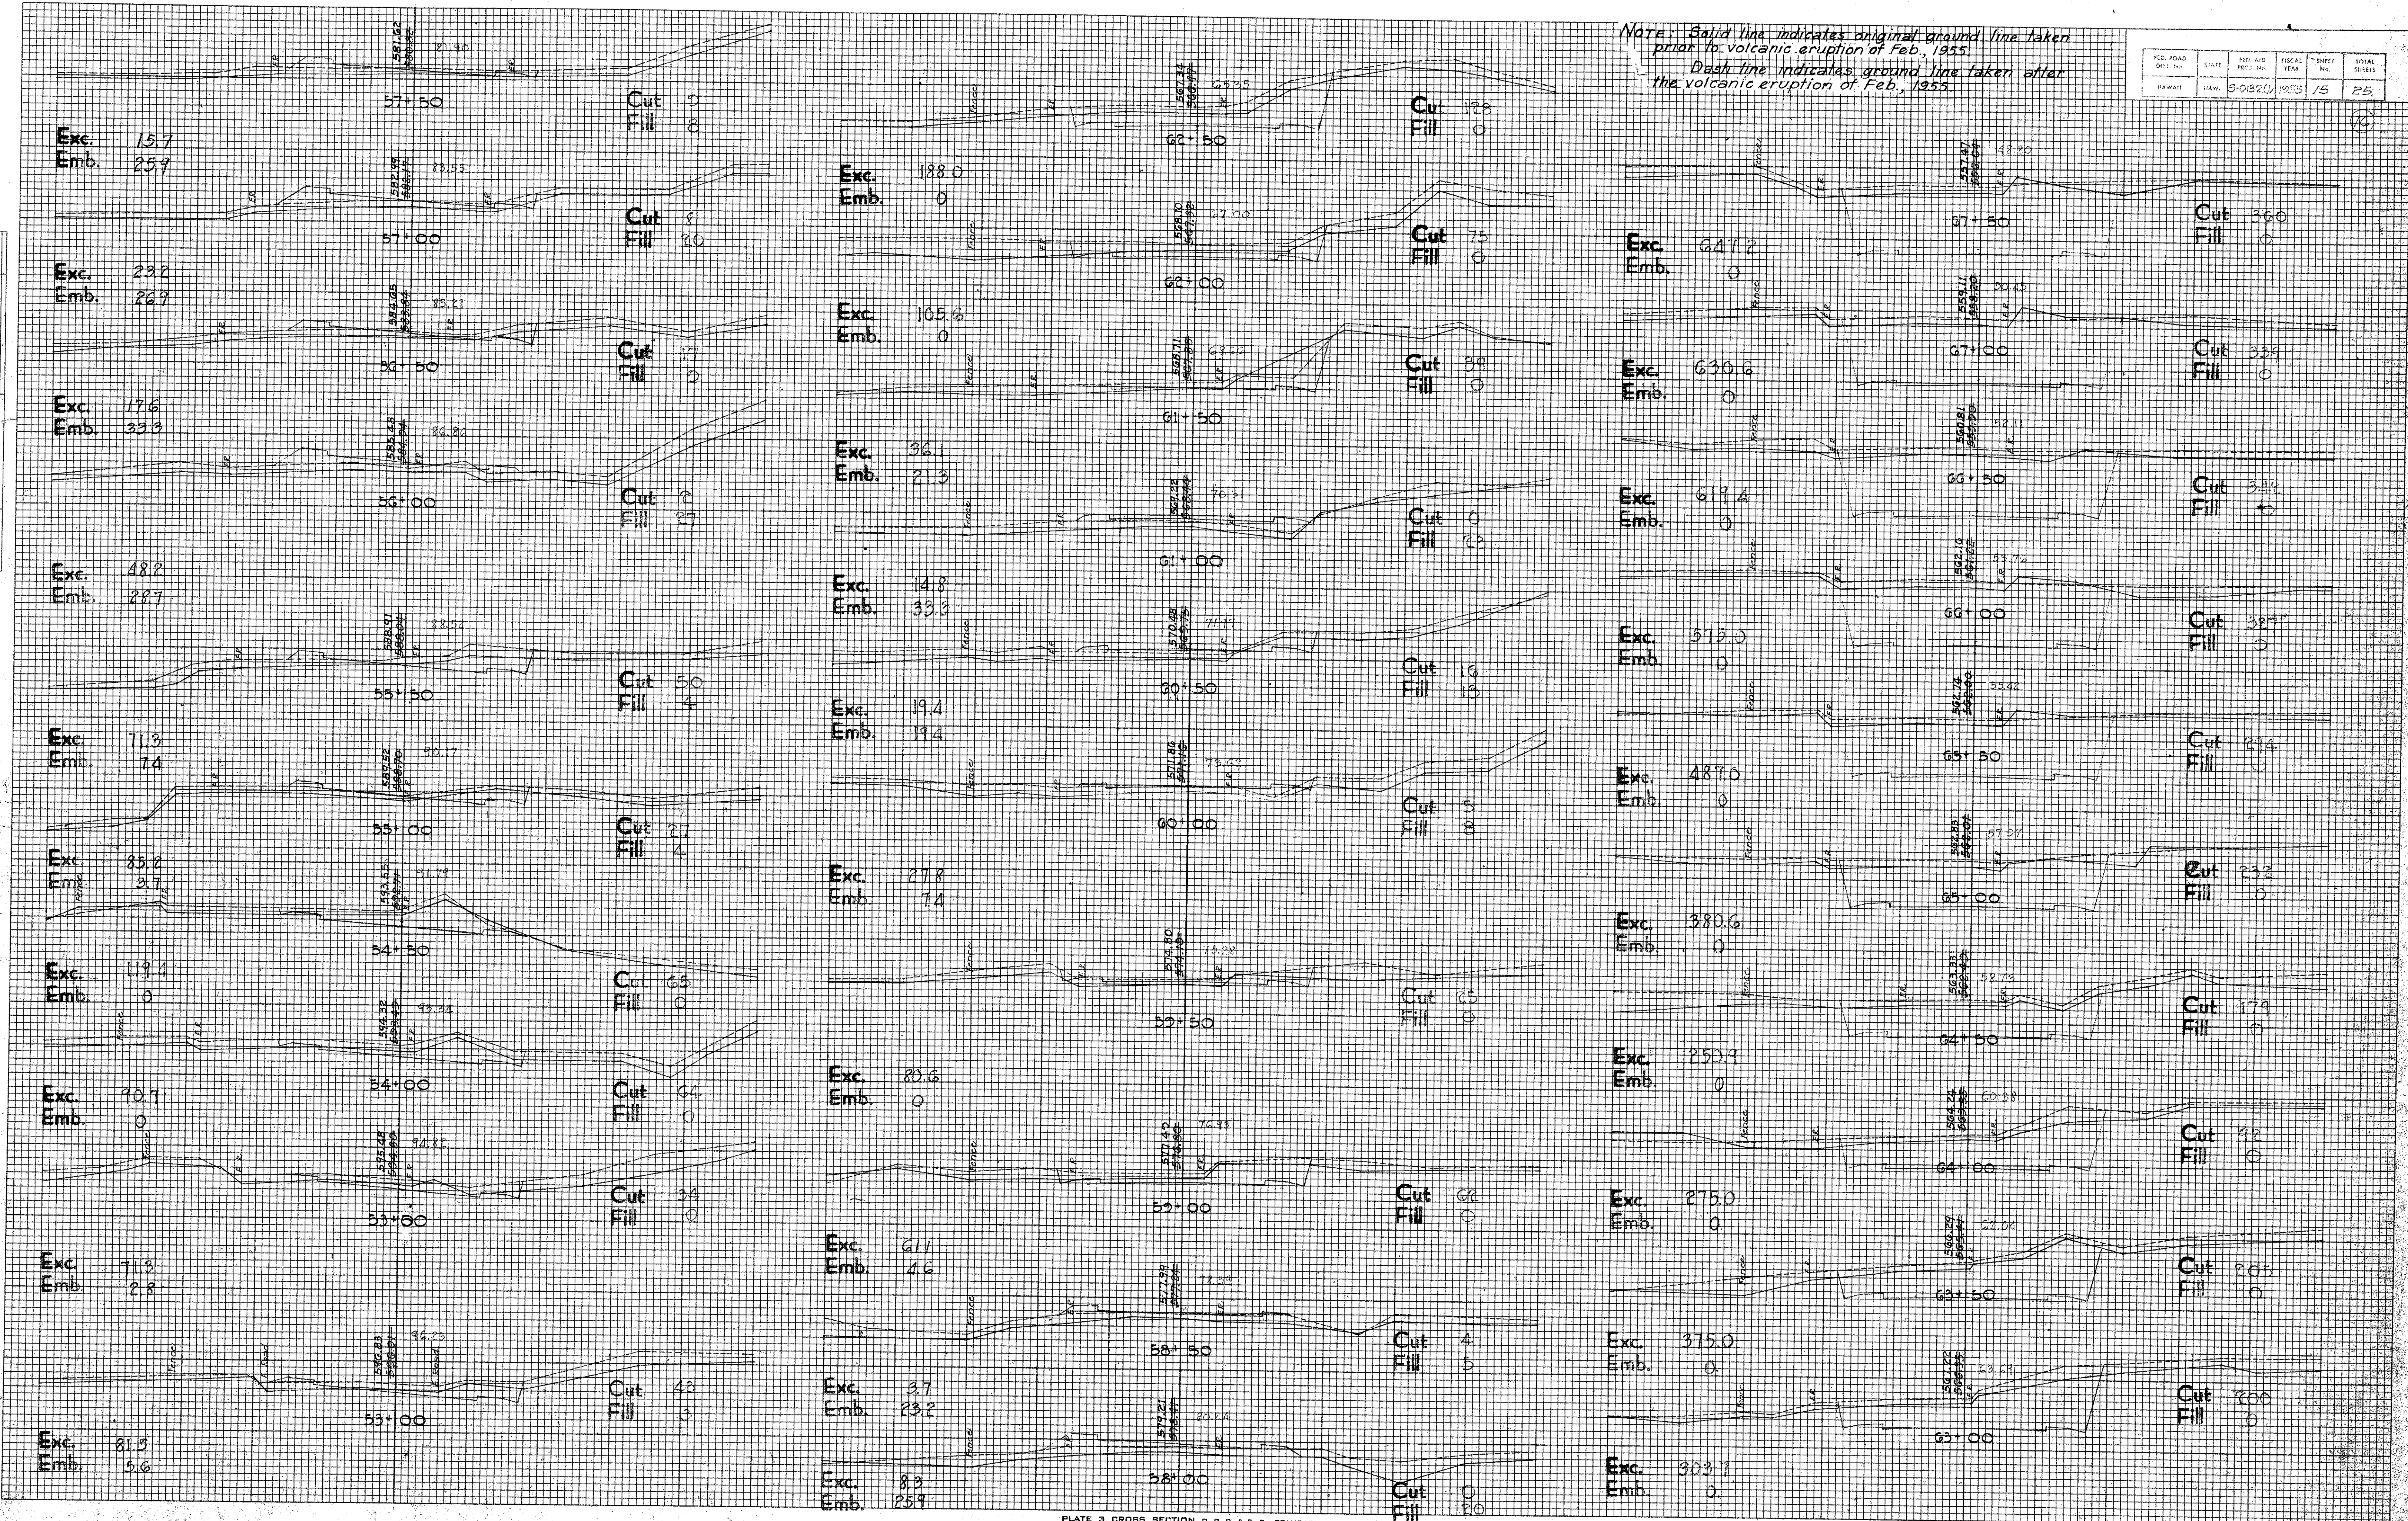

Note: Solid line indicates original ground line taken prior to volcanic eruption of Feb., 1955.
Dash line indicates ground line taken after the volcanic eruption of Feb., 1955.


FEED ROAD DIST. NO.	STATE	REP. AID PROJ. NO.	FISCAL YEAR	SHEET NO.	TOTAL SHEETS
HAWAII	HAU.	8-0182(V)	1955	15	25

DATE	BY	REVIEWED	DATE
NO.	NO.	NO.	NO.

DATE	BY	REVIEWED	DATE
6/55			
7/57			


Note: Solid line indicates original ground line taken prior to volcanic eruption of Feb., 1955.
 Dash line indicates ground line taken after the volcanic eruption of Feb., 1955.

REG. ROAD	STATE	FED. AID	FISCAL	SHEET	TOTAL
HA-101	HA-101	50/32(1)	1955	16	25

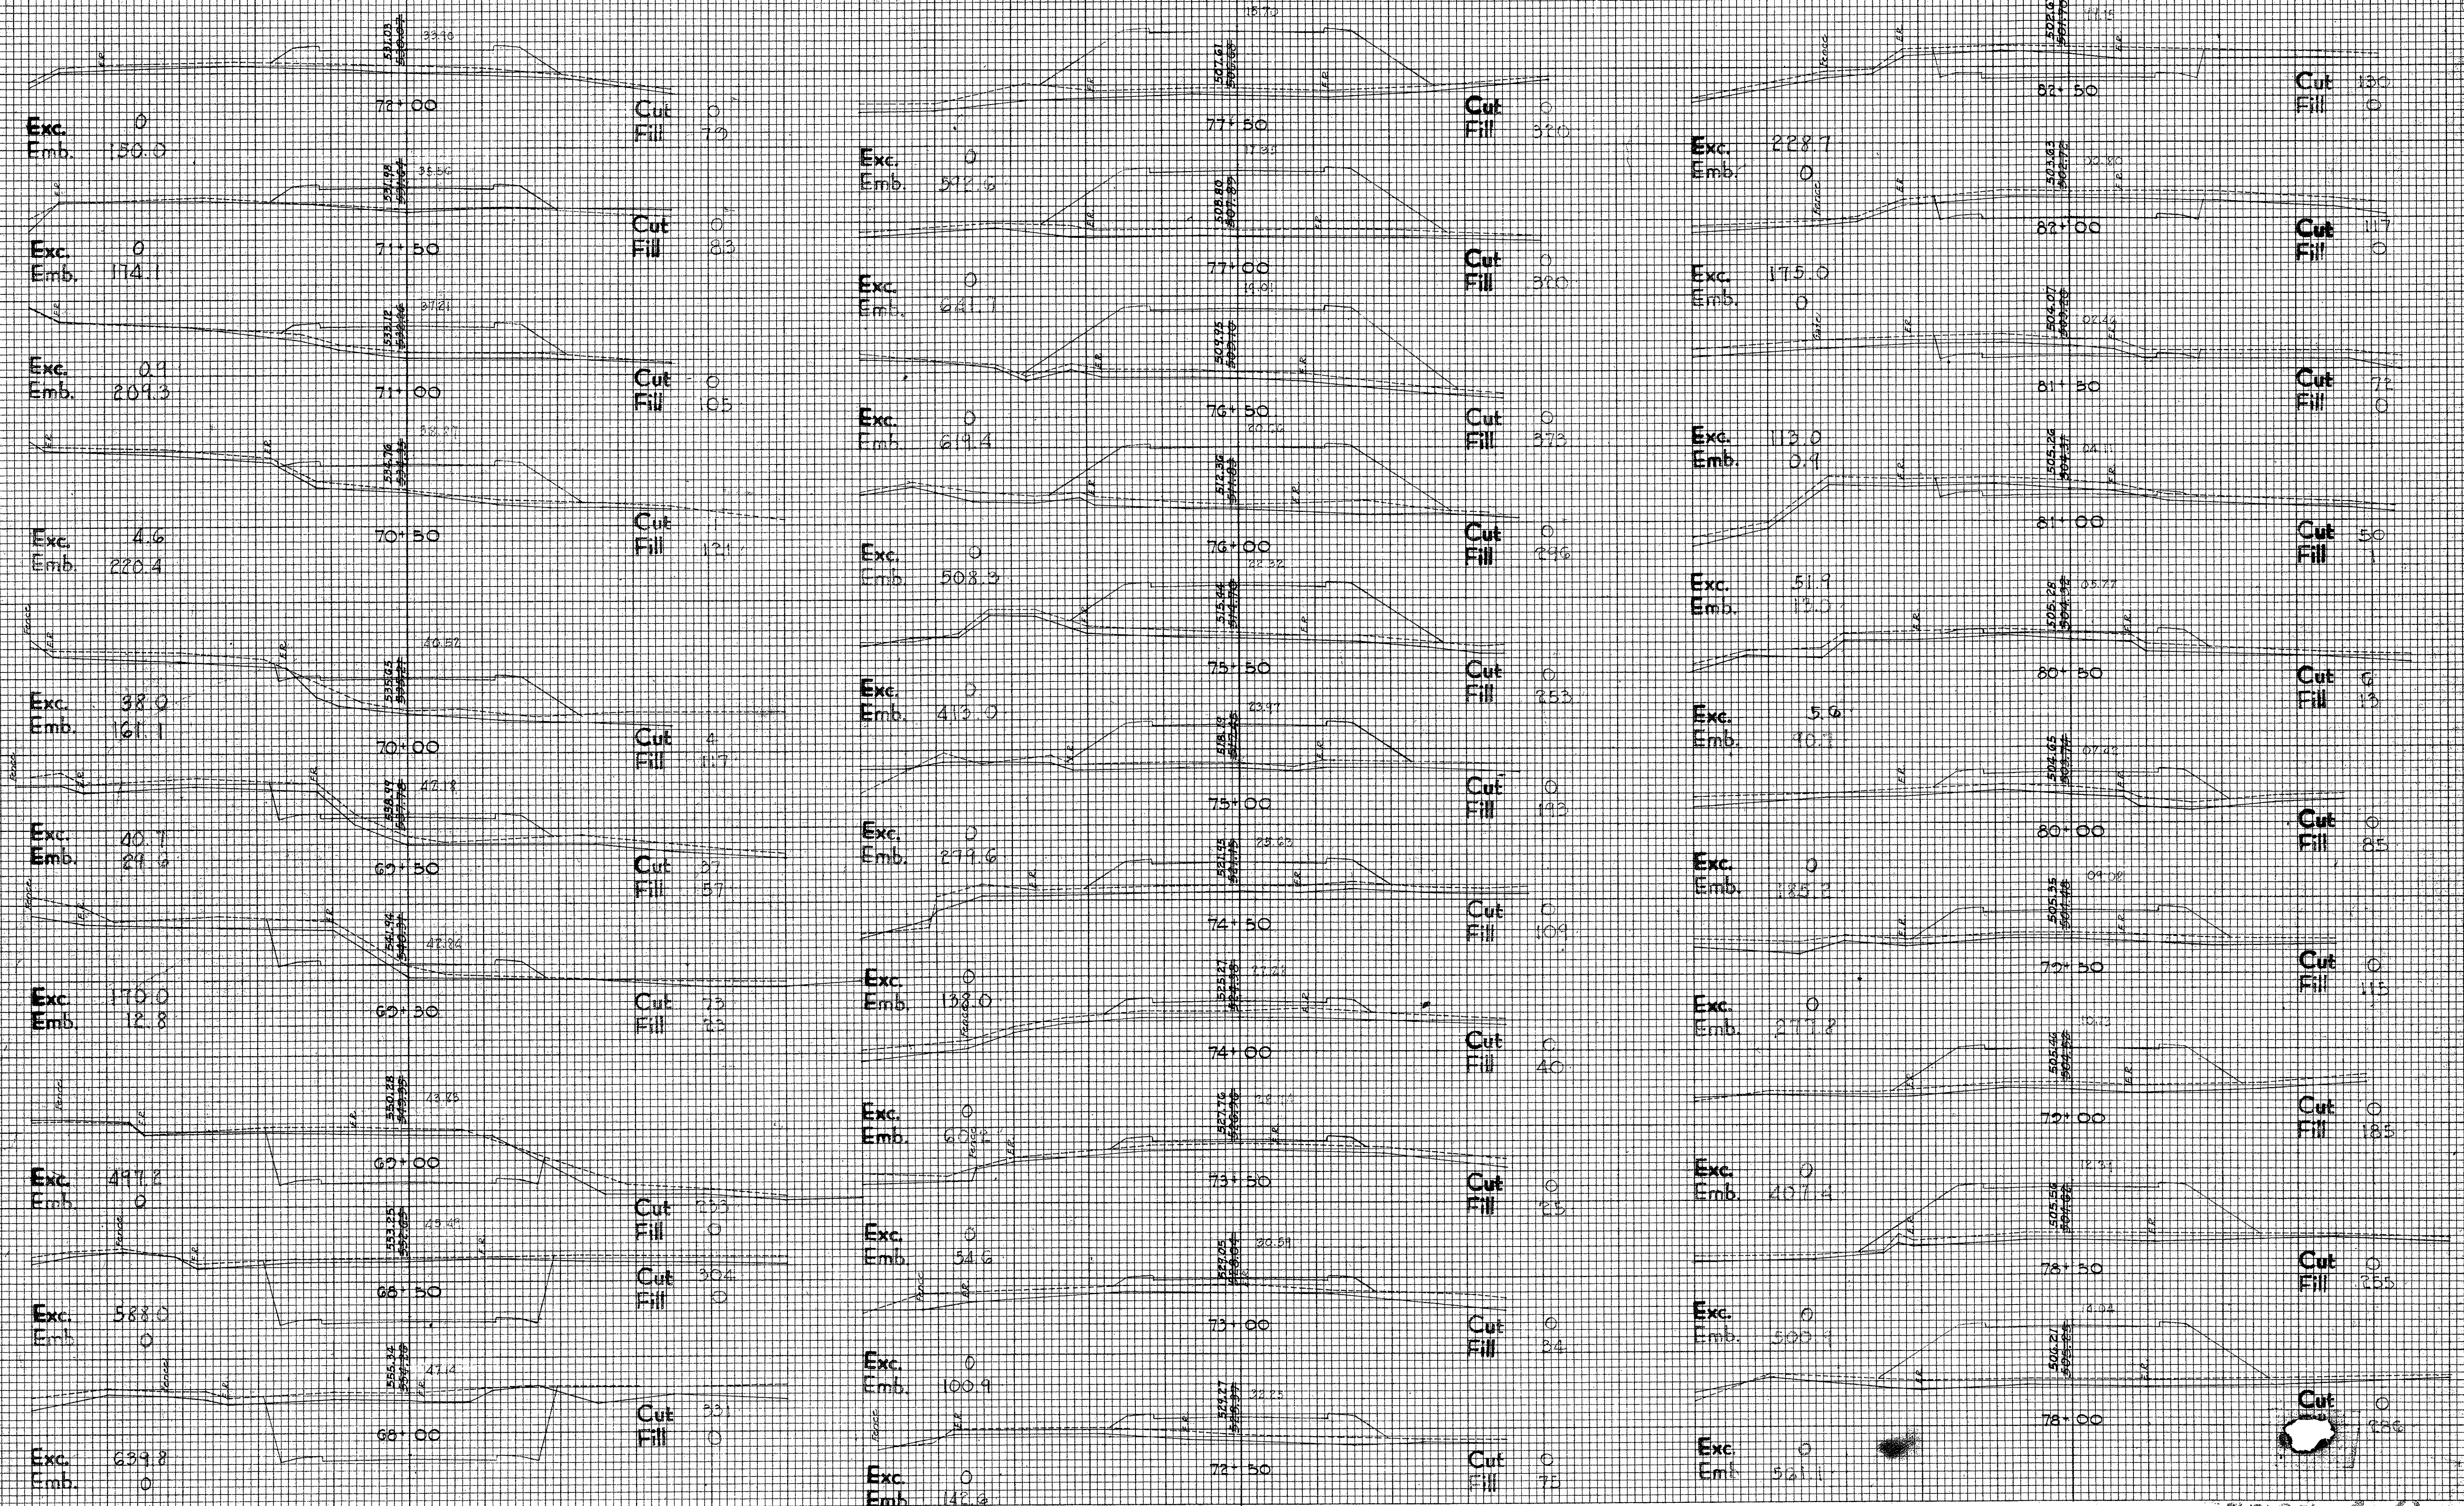

ORIGINAL SURVEY	SURVED	BY	DATE
NOTED	PLOTTED	H. T.	5/25/53
NOTE BOOK	TEMPLATE	T. E.	6/55
	AREAS	H. N.	7/55
NO.	AREAS CHECKED	W. N.	7/55
		"	"

REG. BOARD S. JC. No.	STATE	REG. AND POST. No.	ISCAL YEAR	SHEET No.	TOTAL SHEETS
MASSACHUSETTS	MASS.	5-01820	1955	17	25

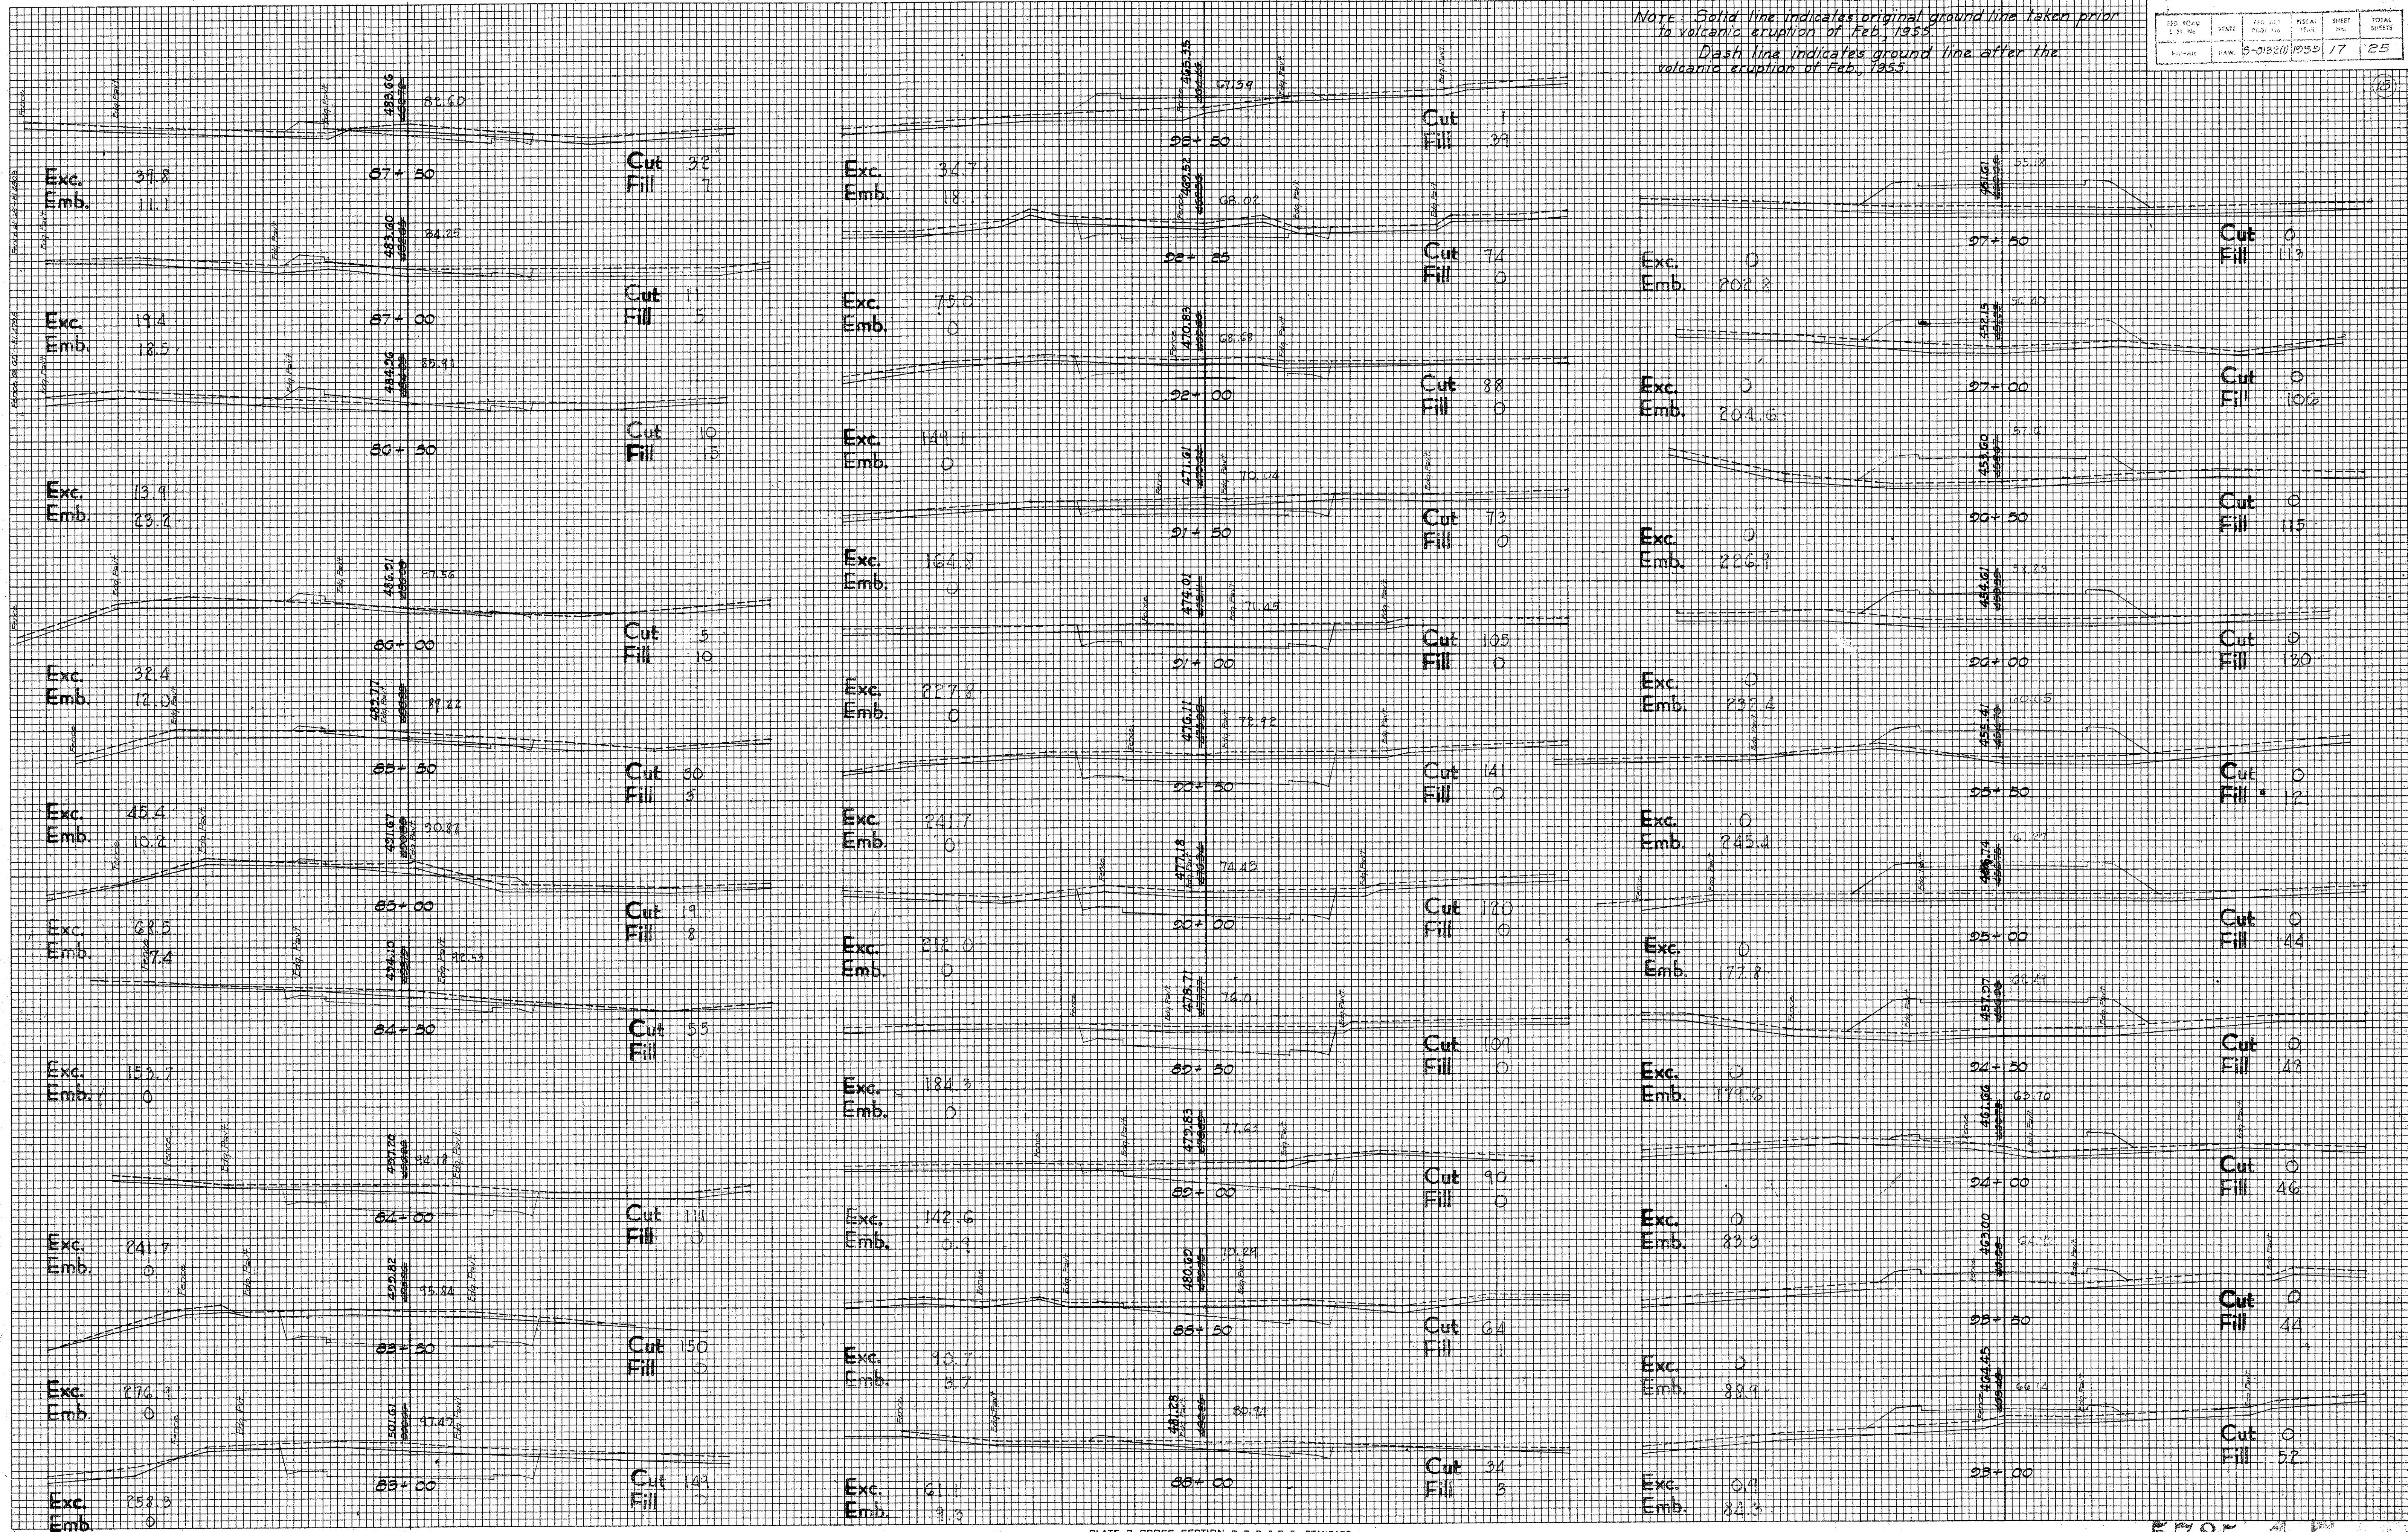


5785.1

FINAL SURVEY	DATE	
	BY	
	SURVEYED PLOTTED	
	NOTE BOOK TEMPLATE AREAS CHECKED	

ORIGINAL SURVEY	DATE	6/25
	BY	H. I. E.
	SURVEYED PLOTTED	
	NOTE BOOK TEMPLATE AREAS CHECKED	


Note: Solid line indicates original ground line taken prior to volcanic eruption of Feb., 1955.
Dash line indicates ground line taken after the volcanic eruption of Feb., 1955.

FILE NO.	STATE	FILE NO.	LOCAL	SHEET	TOTAL
100860	PA	100860	18	25	

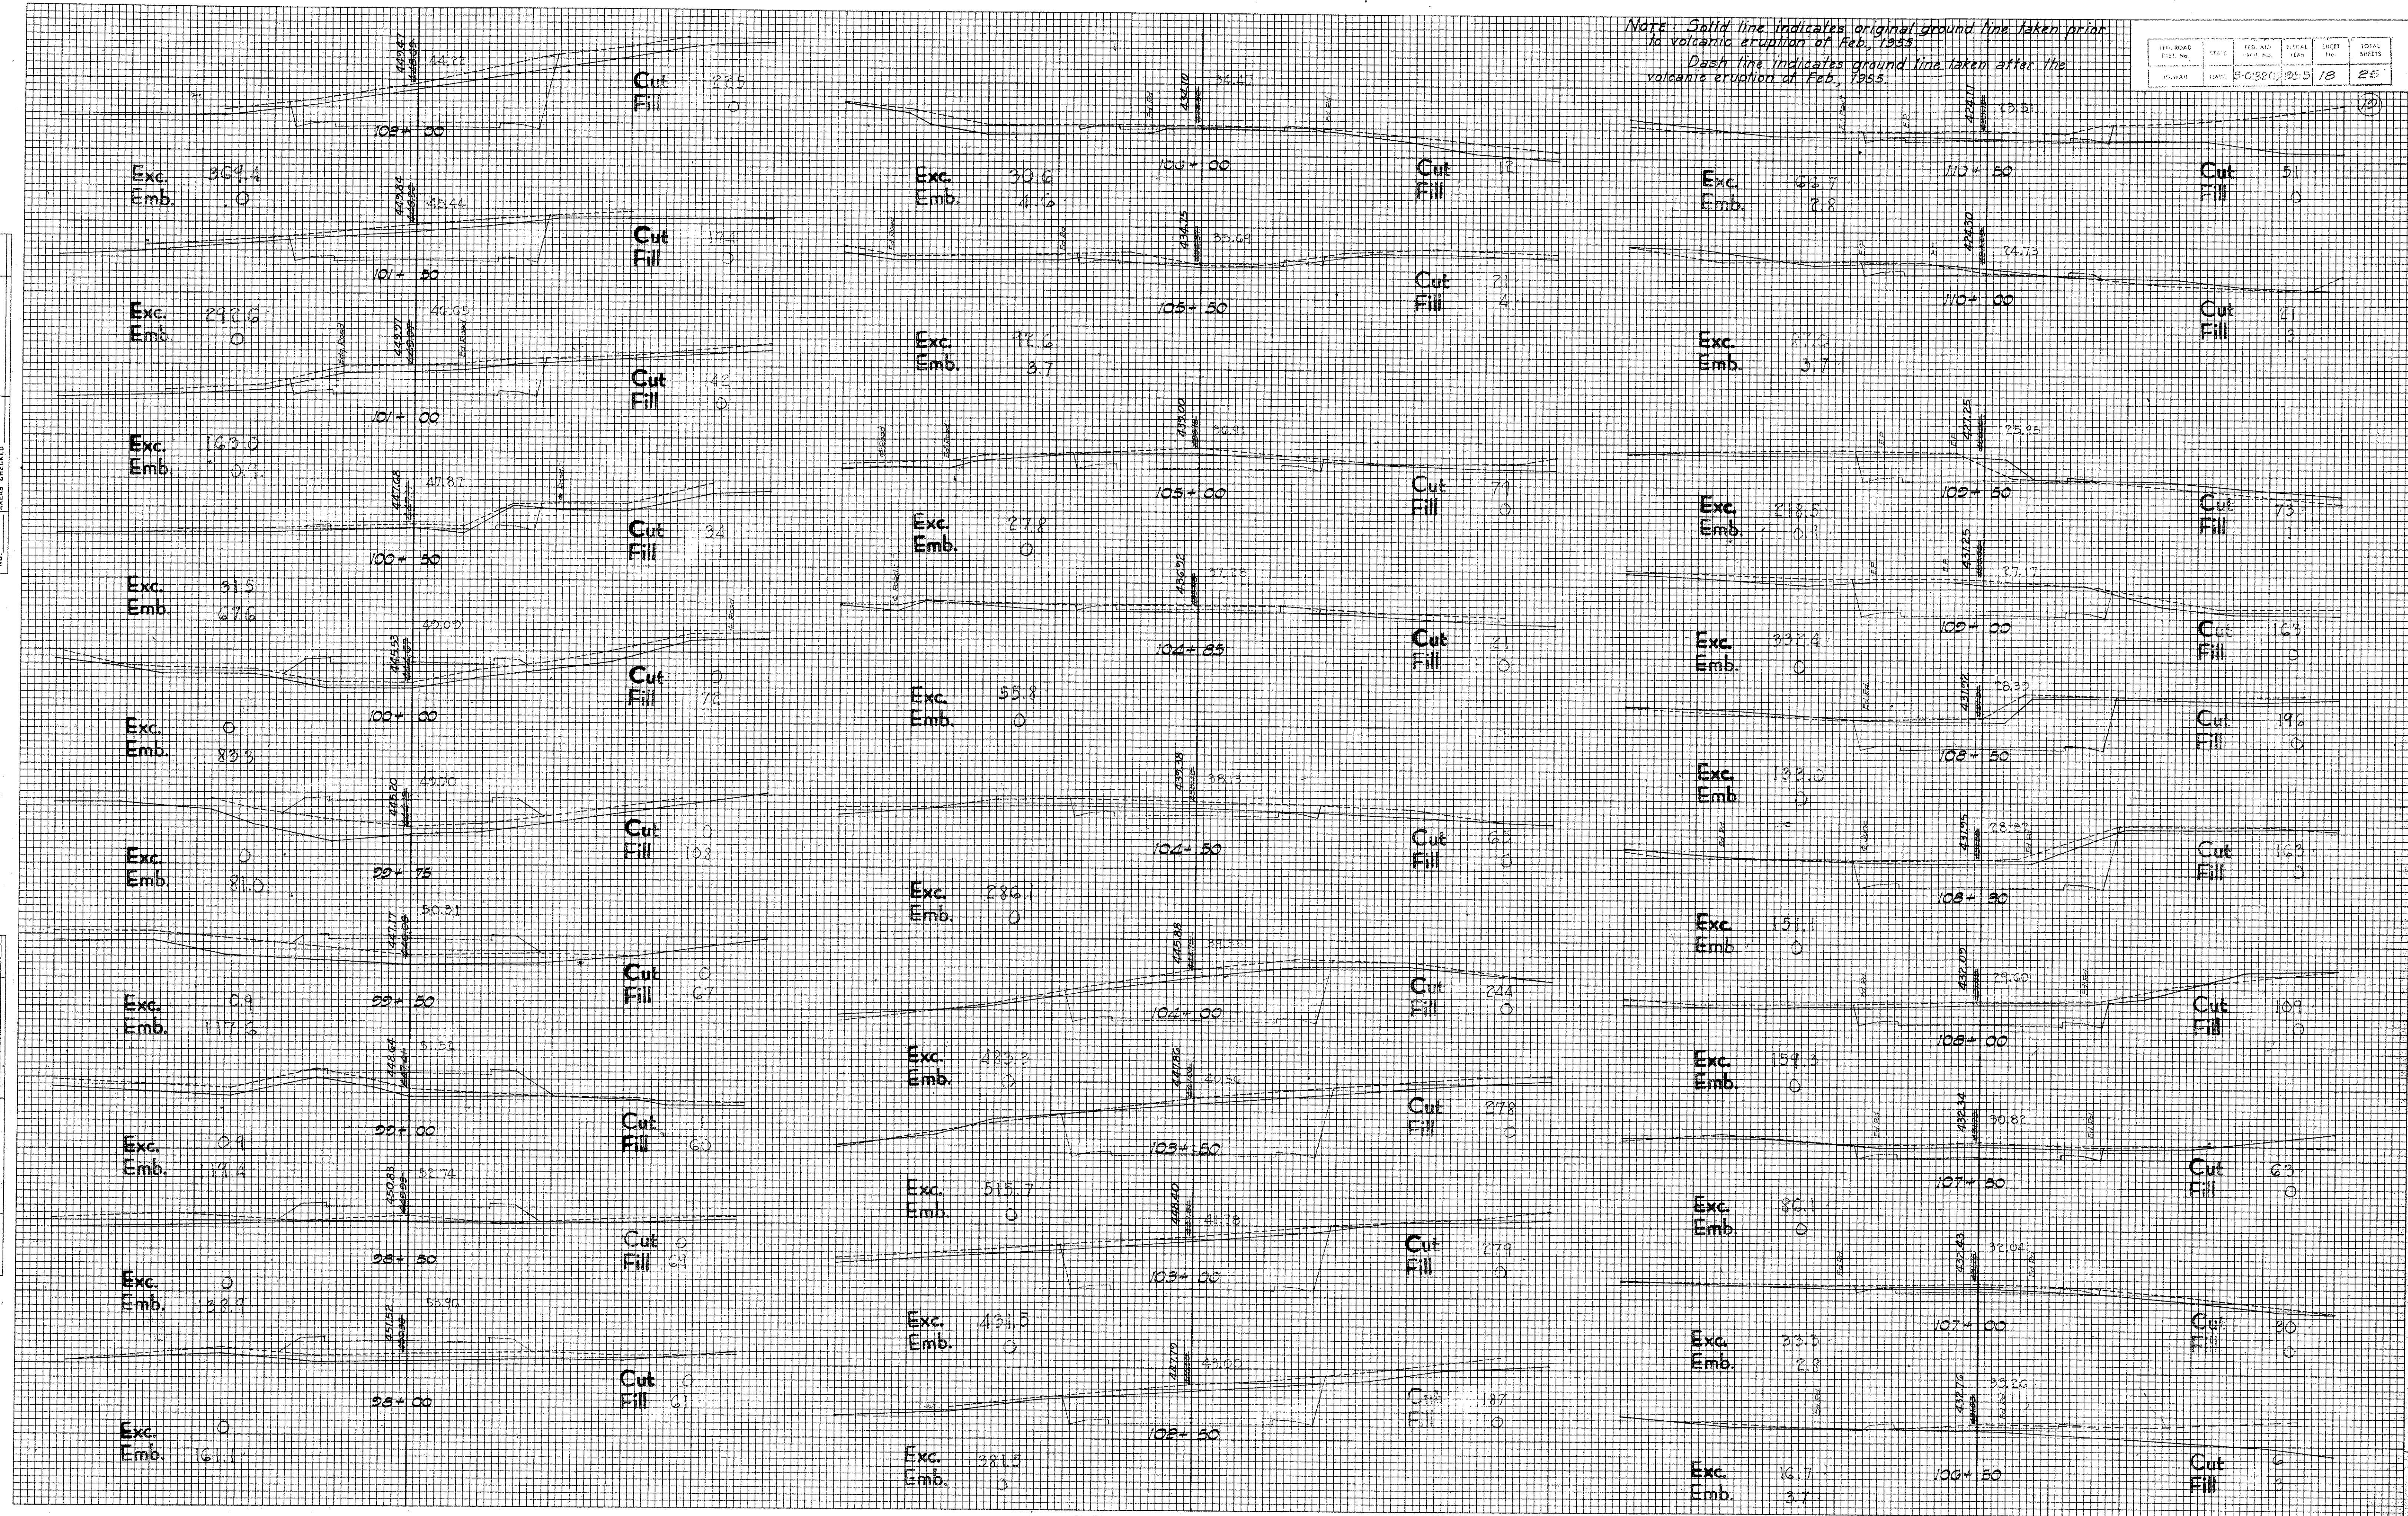

ORIGINAL		SJ	DATE
SURVEY	SURVEYED	H.T.	4/59
	PLOTTED	I.F.	6/23/58
	TEMPLATE	H.N.	7/11/58
	AREAS	S.H.K.	7/58

FED ROAD DIST. No.	STATE	FED AID PROJ. No.	FISCAL YEAR	SHEET No.	TOTAL SHEETS
PA-100	PA.	EA-3(1)	1955	6	9

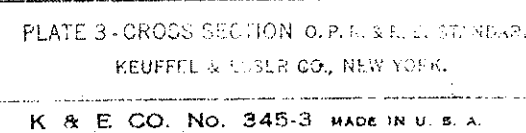


5786. (6)

FINAL SURVEY	DATE	
	BY	
	SURVEYED	
	PLOTTED	
	NOTE BOOK	
	AREAS CHECKED	
	NO.	

ORIGINAL SURVEY	DATE	6/55
	BY	J. V. ...
	SURVEYED	6/55
	PLOTTED	7/55
	NOTE BOOK	
	AREAS CHECKED	
	NO.	

FED. ROAD DIST. NO.	STATE	FED. AID PROJ. NO.	FISCAL YEAR	SHEET NO.	TOTAL SHEETS
HAWAII	HAW	ER 3(1)	1955	9	9

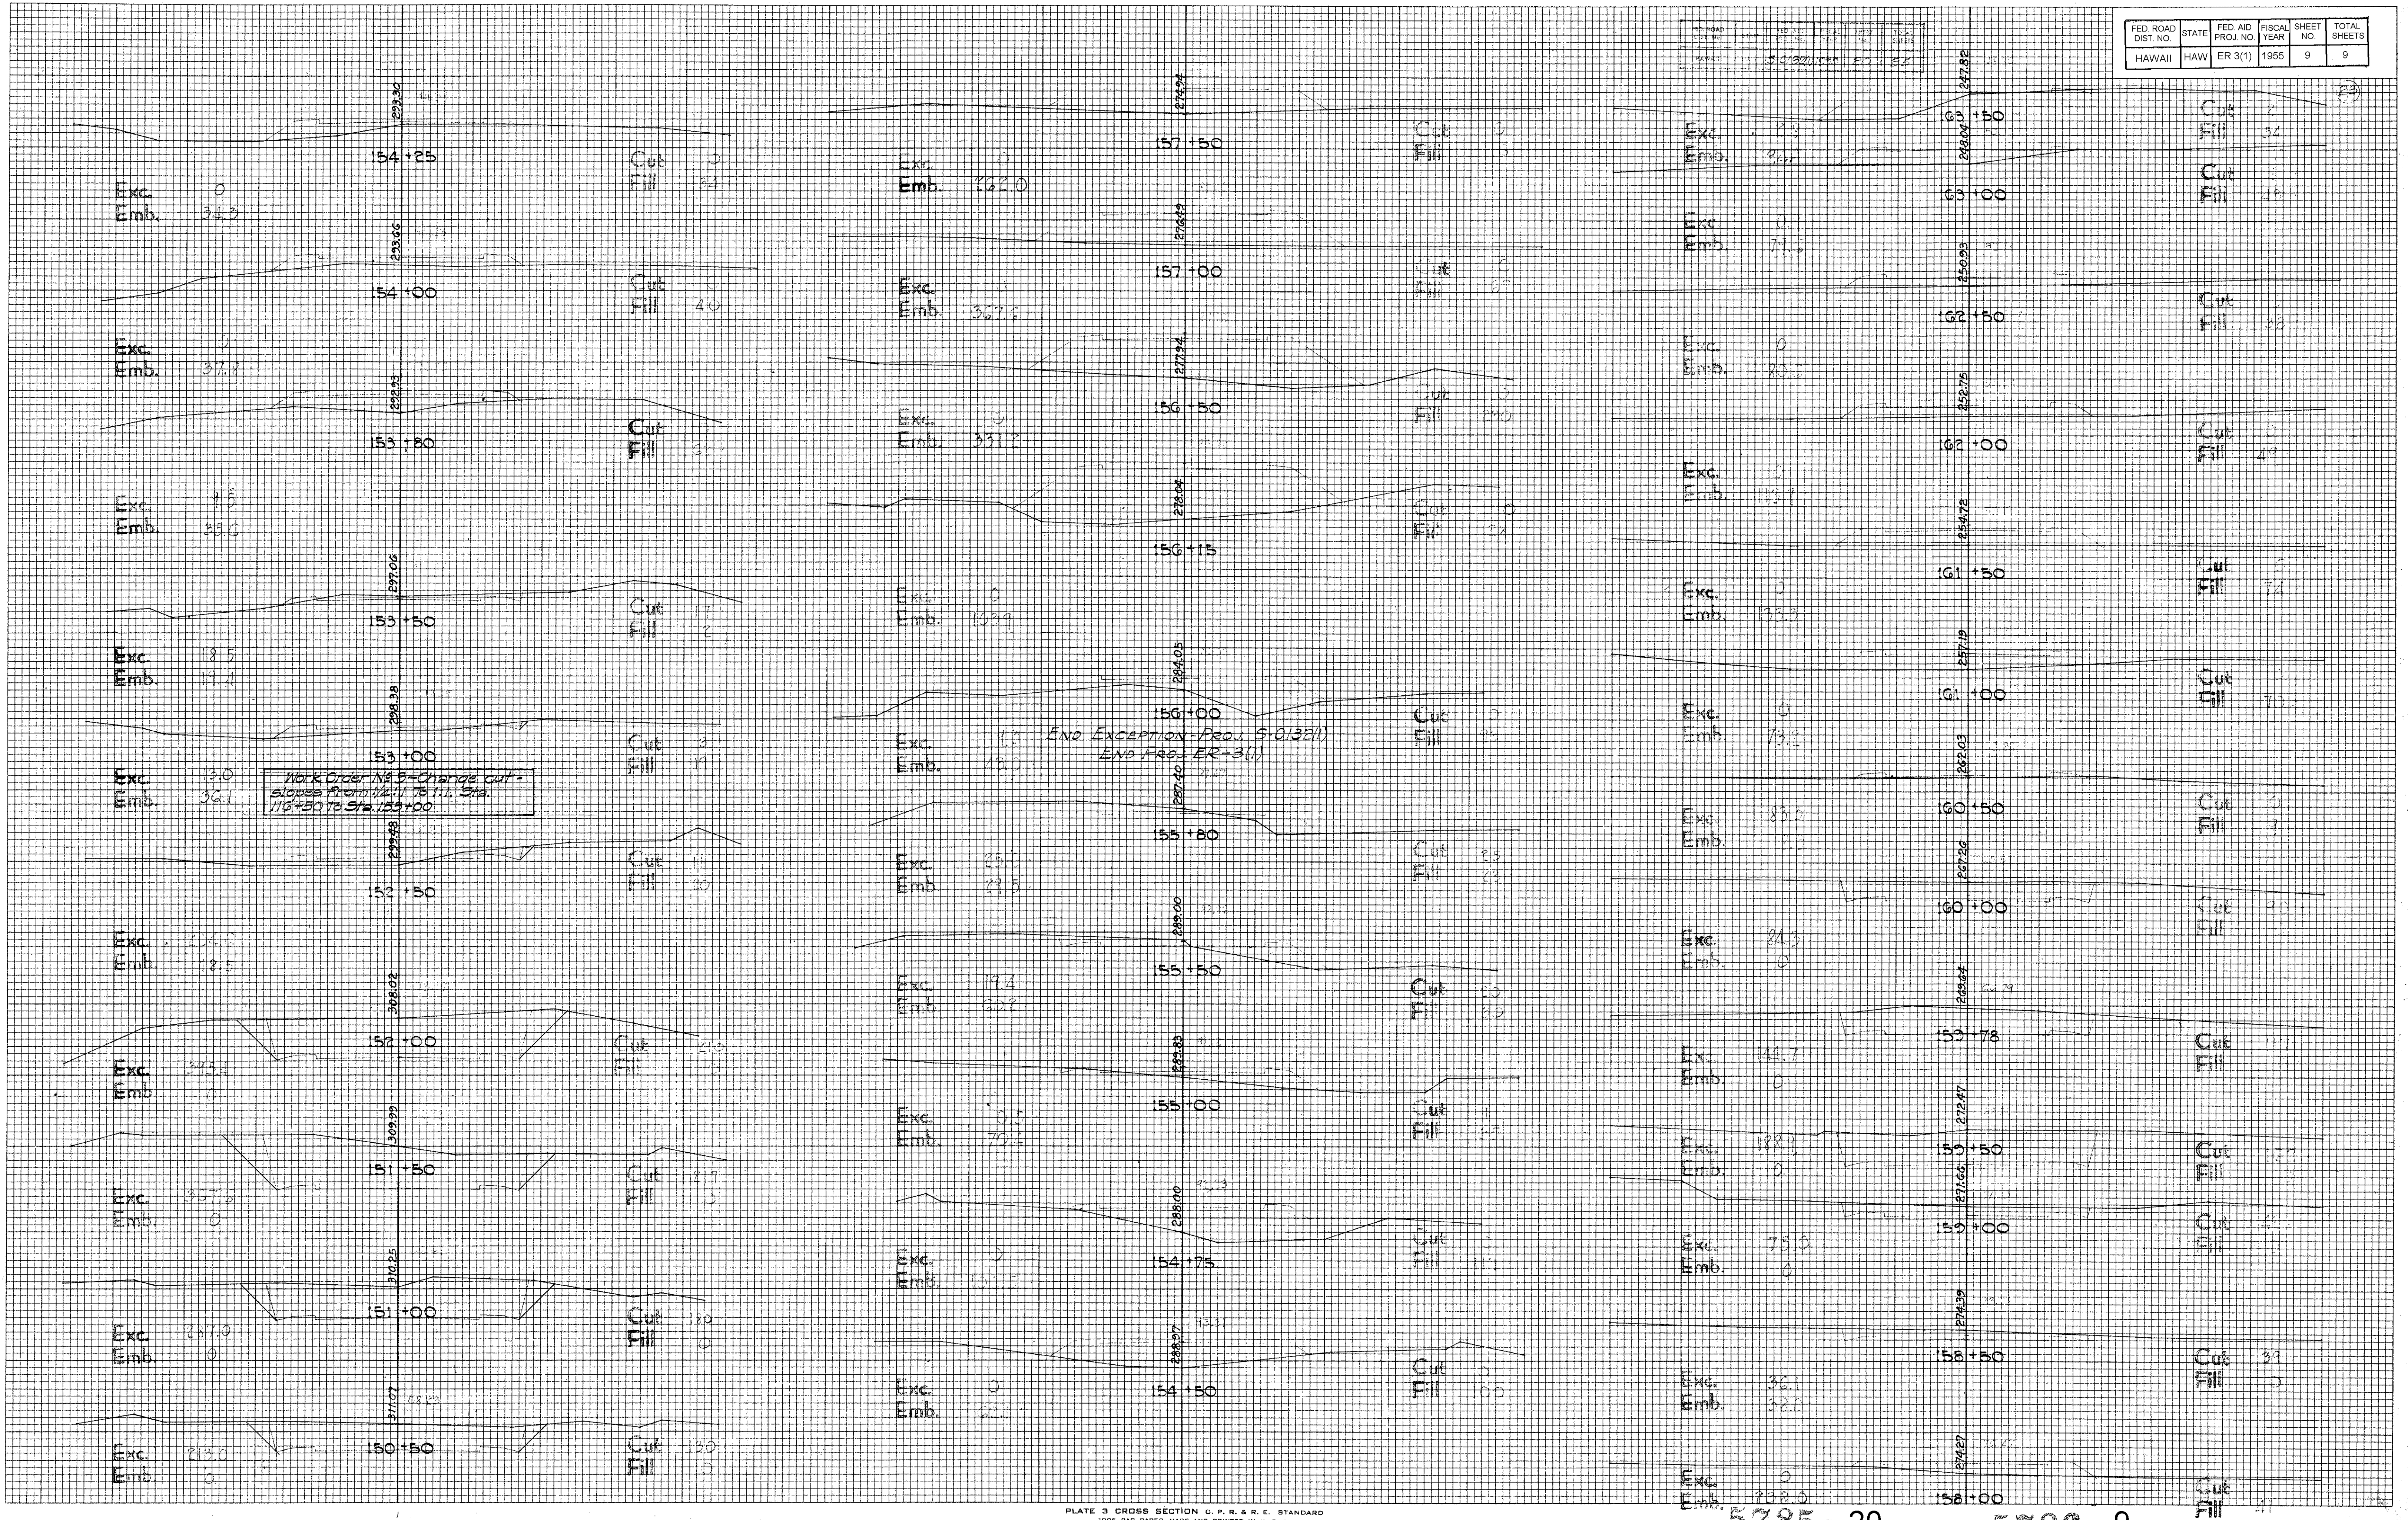

5785 • 20


5786 • 9

FINAL SURVEY	SURVEYED	DATE
	PLOTTED	BY
	TEMPLATE	
	NOTE BOOK	
	AREAS CHECKED	NO.

ORIGINAL SURVEY	SURVEYED	DATE
	PLOTTED	BY
	TEMPLATE	
	NOTE BOOK	
	AREAS CHECKED	NO.

Note: Solid line indicates original ground line taken prior to volcanic eruption of Feb, 1935.
Dash line indicates ground line taken after the volcanic eruption of Feb, 1935.

FILE NO.	STATE	FED. AID	FISCAL YEAR	SHEET NO.	TOTAL SHEETS
101320	HAW.	101320	1935	21	25

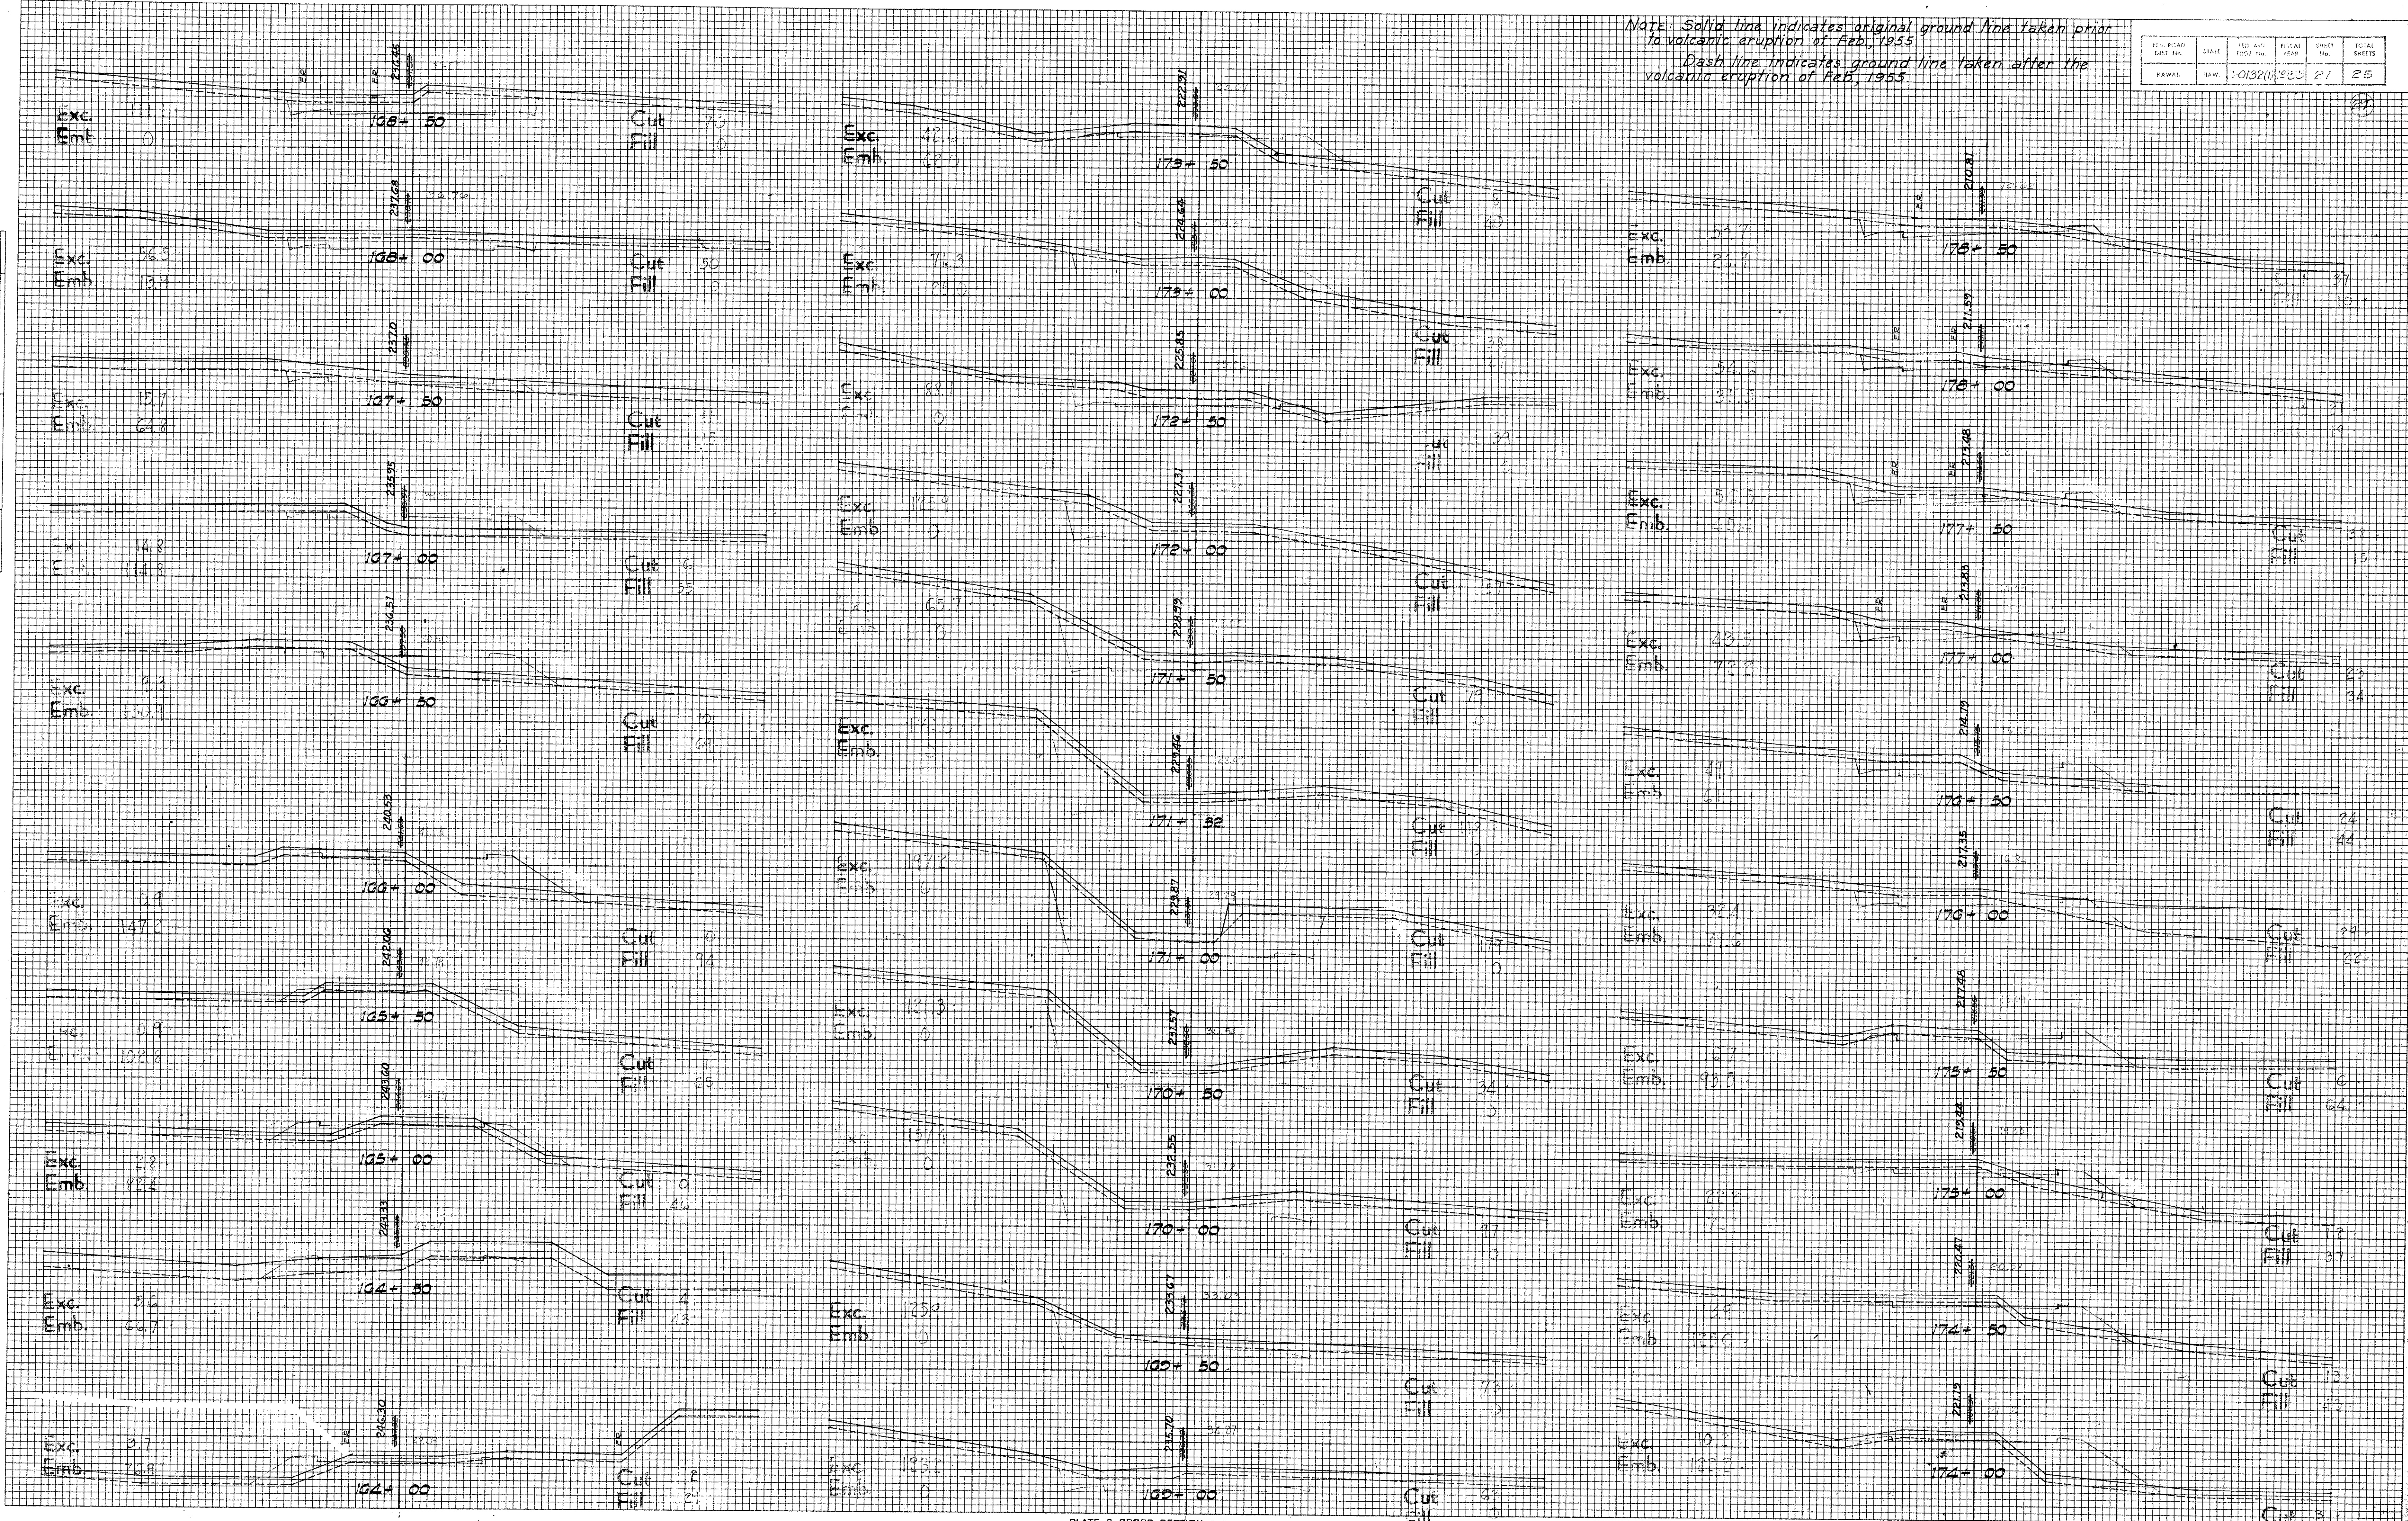


FINAL SURVEY	DATE	BY
NOTE BOOK	SURVEYED	PLOTTED
	DATE	DATE
NO.	AREAS CHECKED	AREAS CHECKED

ORIGINAL SURVEY	DATE	BY
	5/55	H. J.
NOTE BOOK	SURVEYED	PLOTTED
	DATE	DATE
NO.	AREAS CHECKED	AREAS CHECKED

Note: Solid line indicates original ground line taken prior to volcanic eruption of Feb. 1955.
Dash line indicates ground line taken after the volcanic eruption of Feb. 1955.

PROJECT	STATE	SECTION	LOCAL	SHEET	TOTAL
101320	1005	22	25		

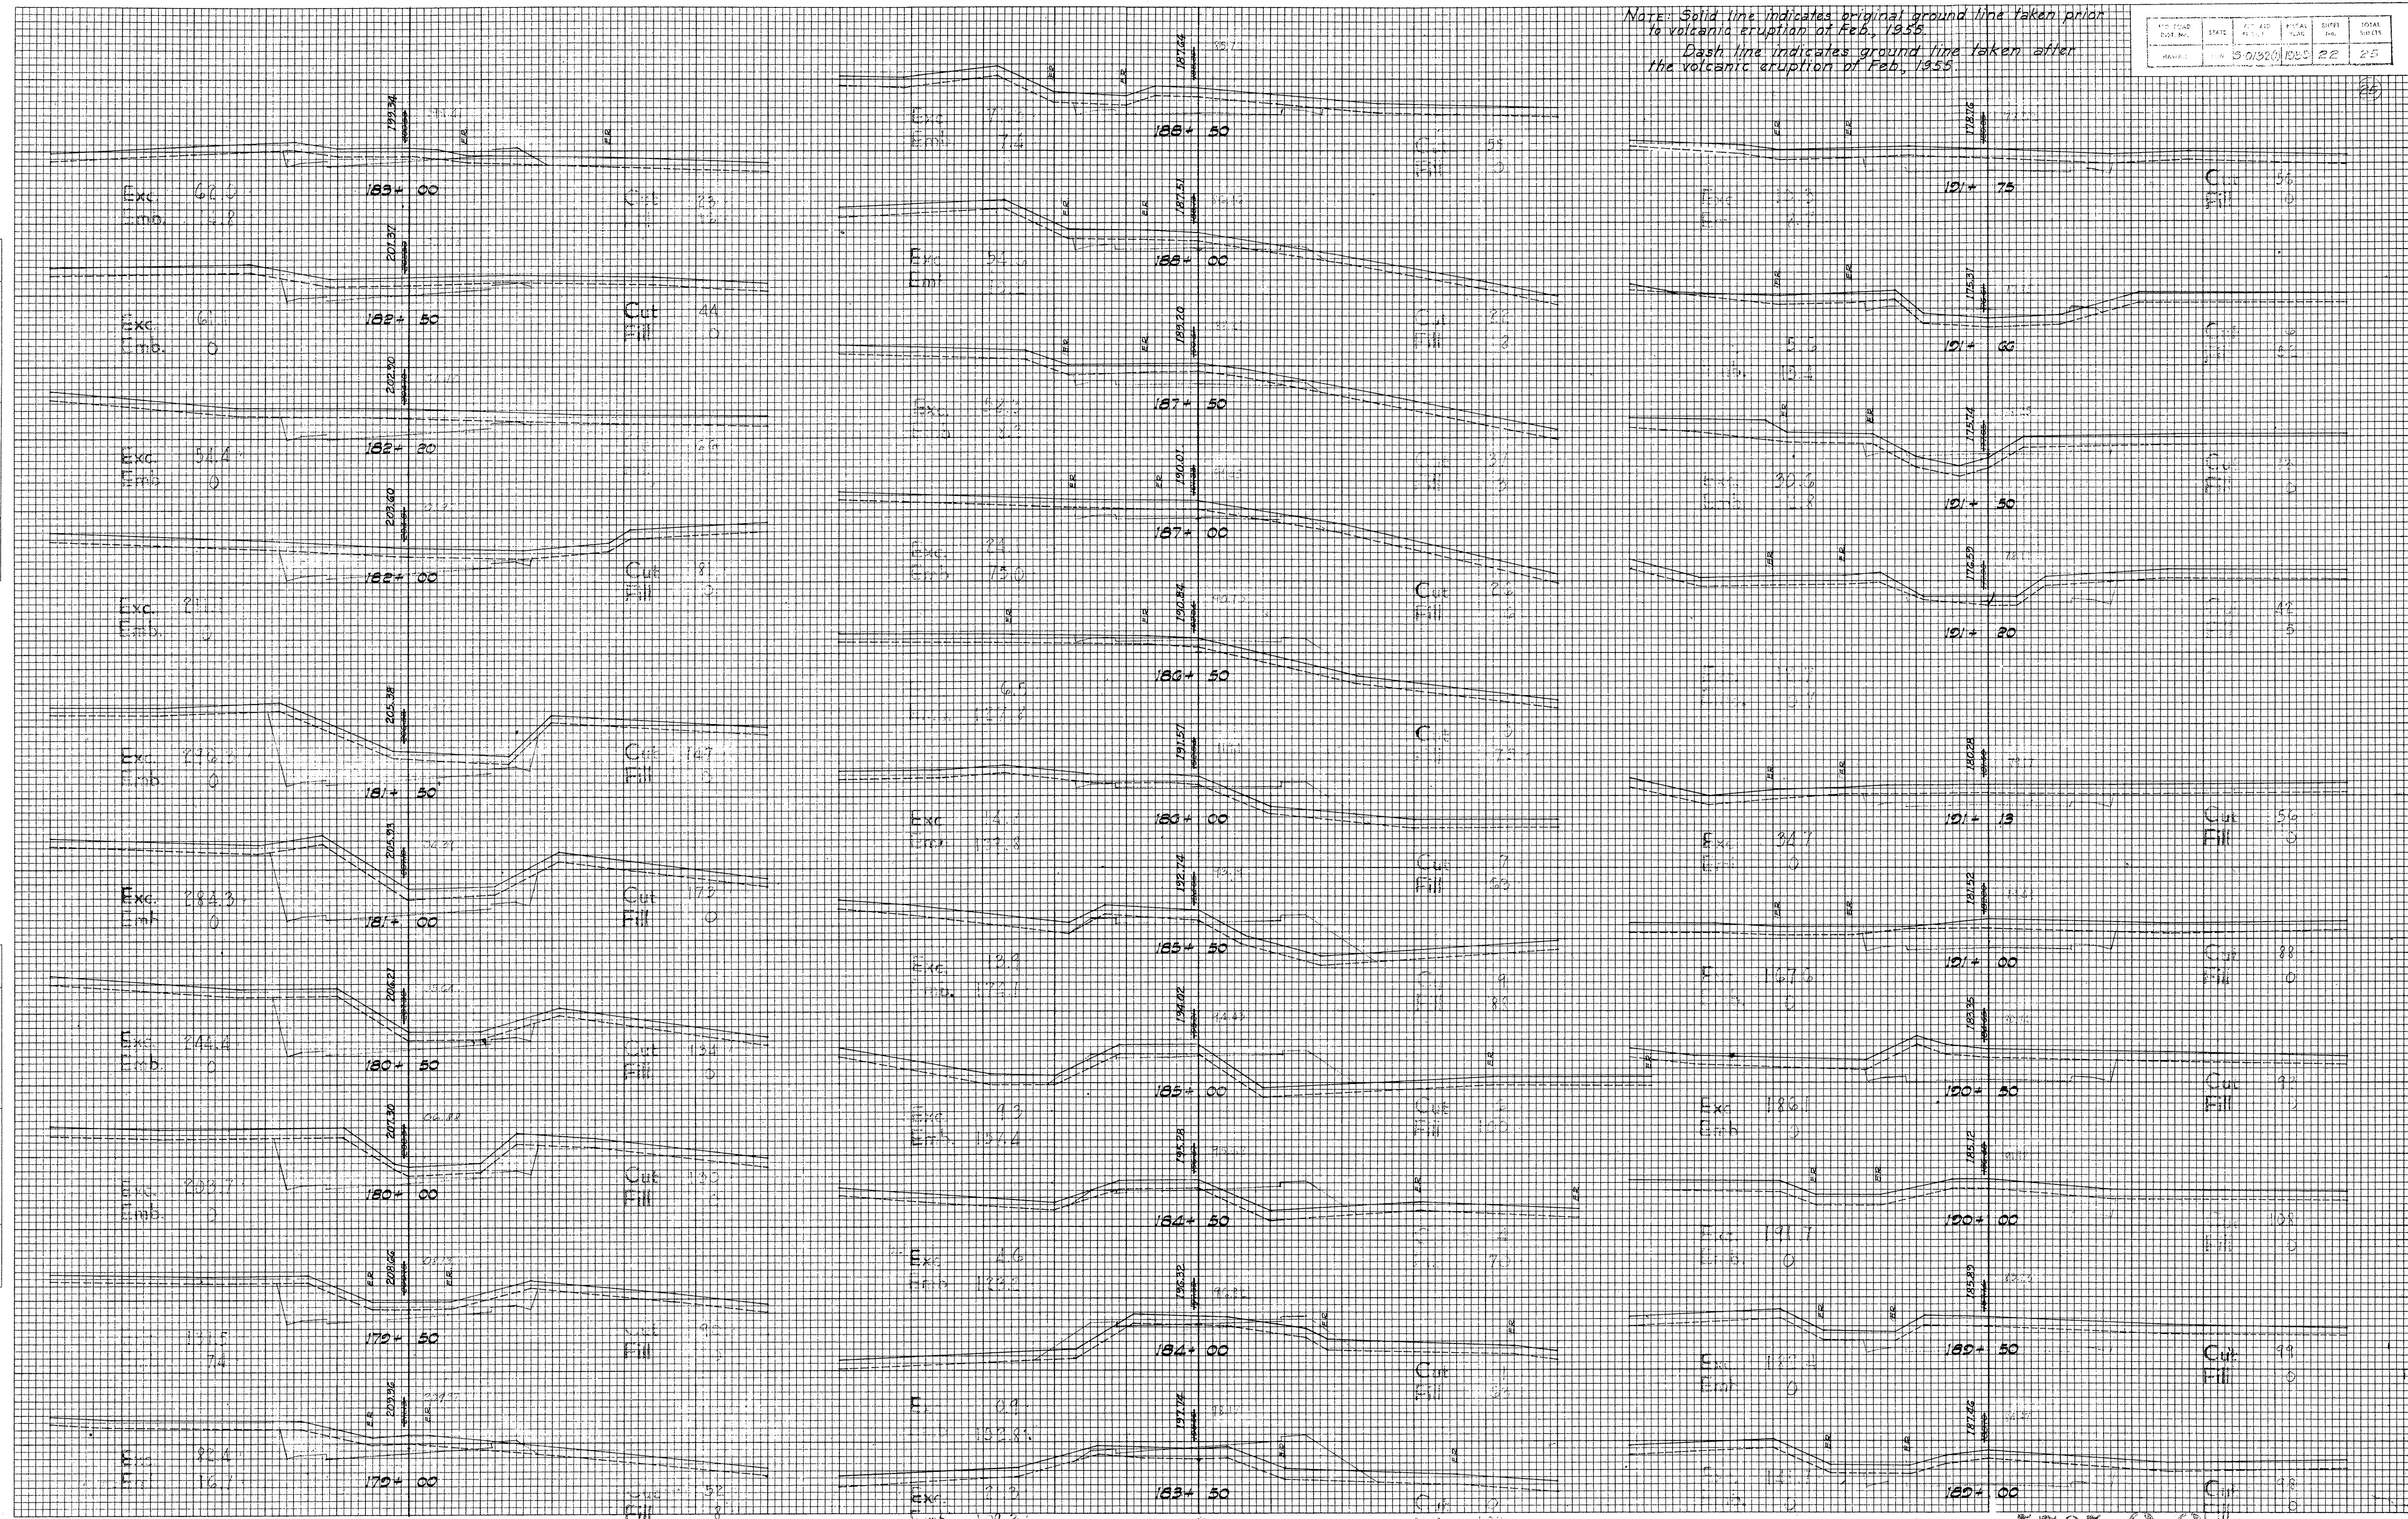


5785.2

FINAL SURVEY	DATE	
	BY	
	SURVEYED	
	PLOTTED	
	NOTE BOOK	
	AREAS CHECKED	
	NO.	

ORIGINAL SURVEY	DATE	6/5/55
	BY	J. L. K.
	SURVEYED	
	PLOTTED	
	NOTE BOOK	
	AREAS CHECKED	
	NO.	

Note: Solid line indicates original ground line taken prior to volcanic eruption of Feb. 1955.
Dash line indicates ground line taken after the volcanic eruption of Feb. 1955.

FEED POINT DIST. NO.	STATE	FEED AID PAGE NO.	FISCAL YEAR	SHEET NO.	TOTAL SHEETS
HAWAII	11	5018	1955	23	25

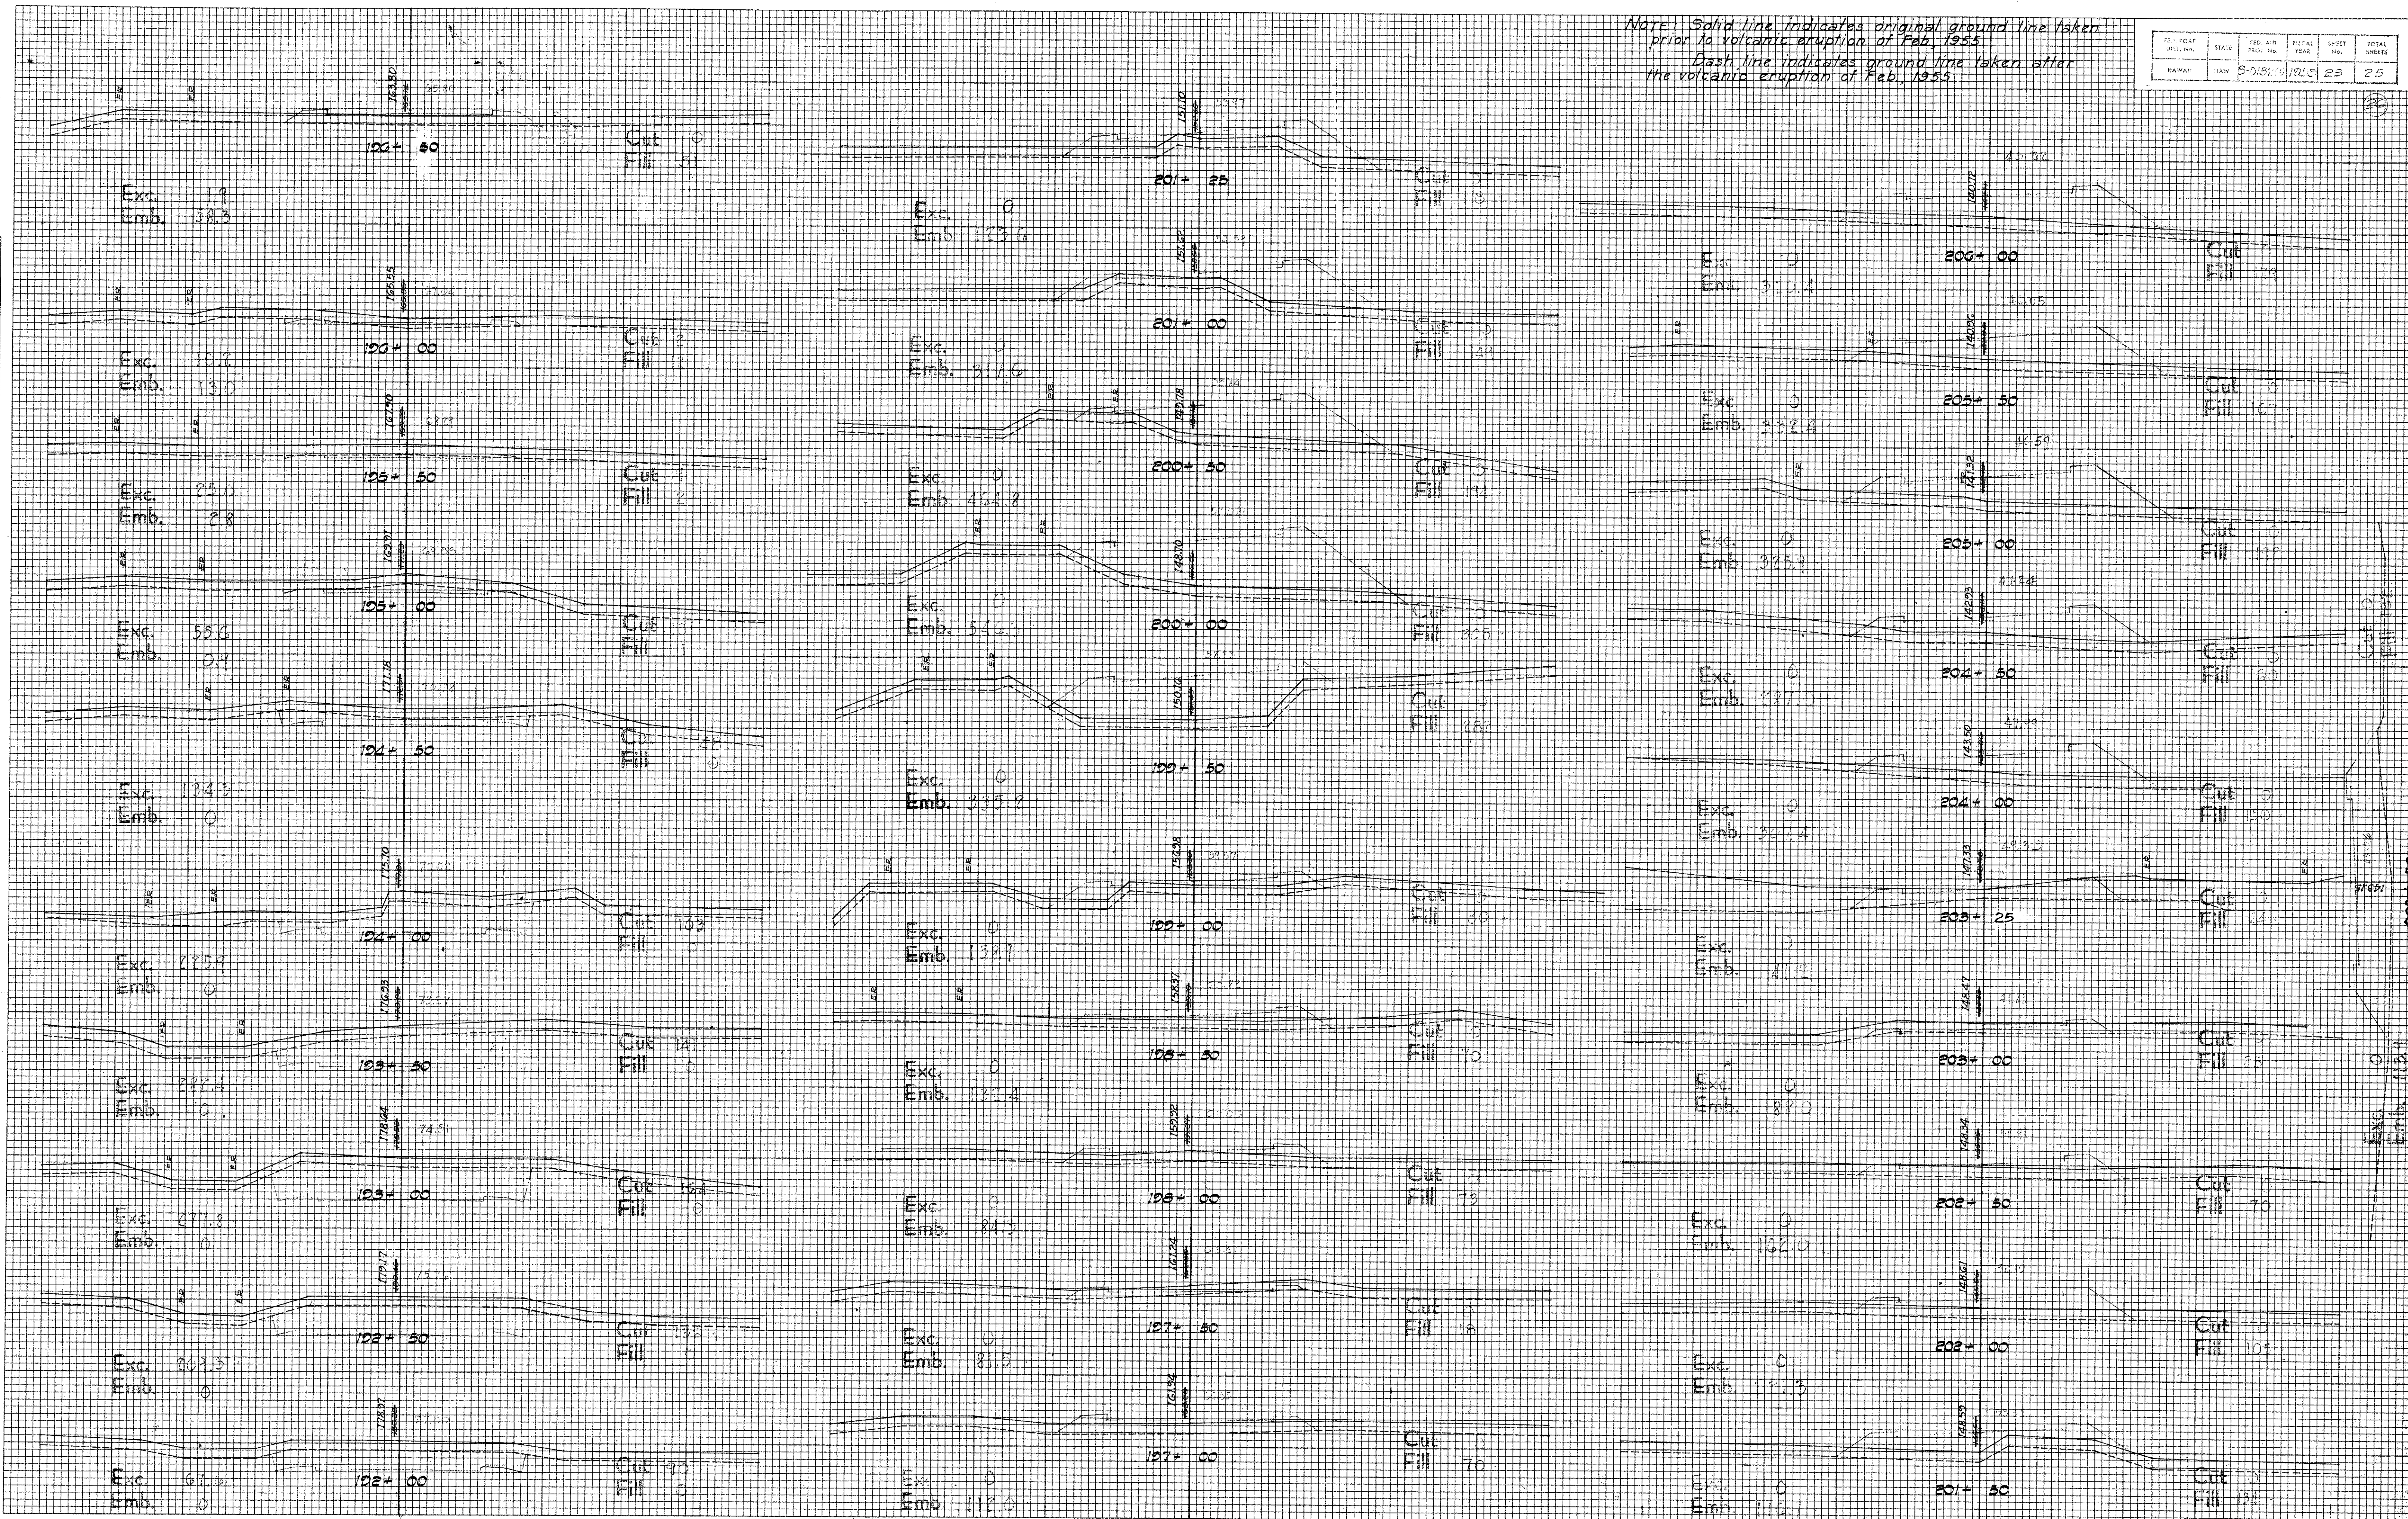


FINAL SURVEY	DATE	BY
	SURVEYED	BY
	PLOTTED	BY
	NOTE BOOK	NO.

ORIGINAL SURVEY	DATE	BY
	SURVEYED	BY
	PLOTTED	BY
	NOTE BOOK	NO.

Note: Solid line indicates original ground line taken prior to volcanic eruption of Feb., 1955.
 Dash line indicates ground line taken after the volcanic eruption of Feb., 1955.

DATE	BY	NO.	TOTAL SHEETS
5-20-55	W.C. 27	25	

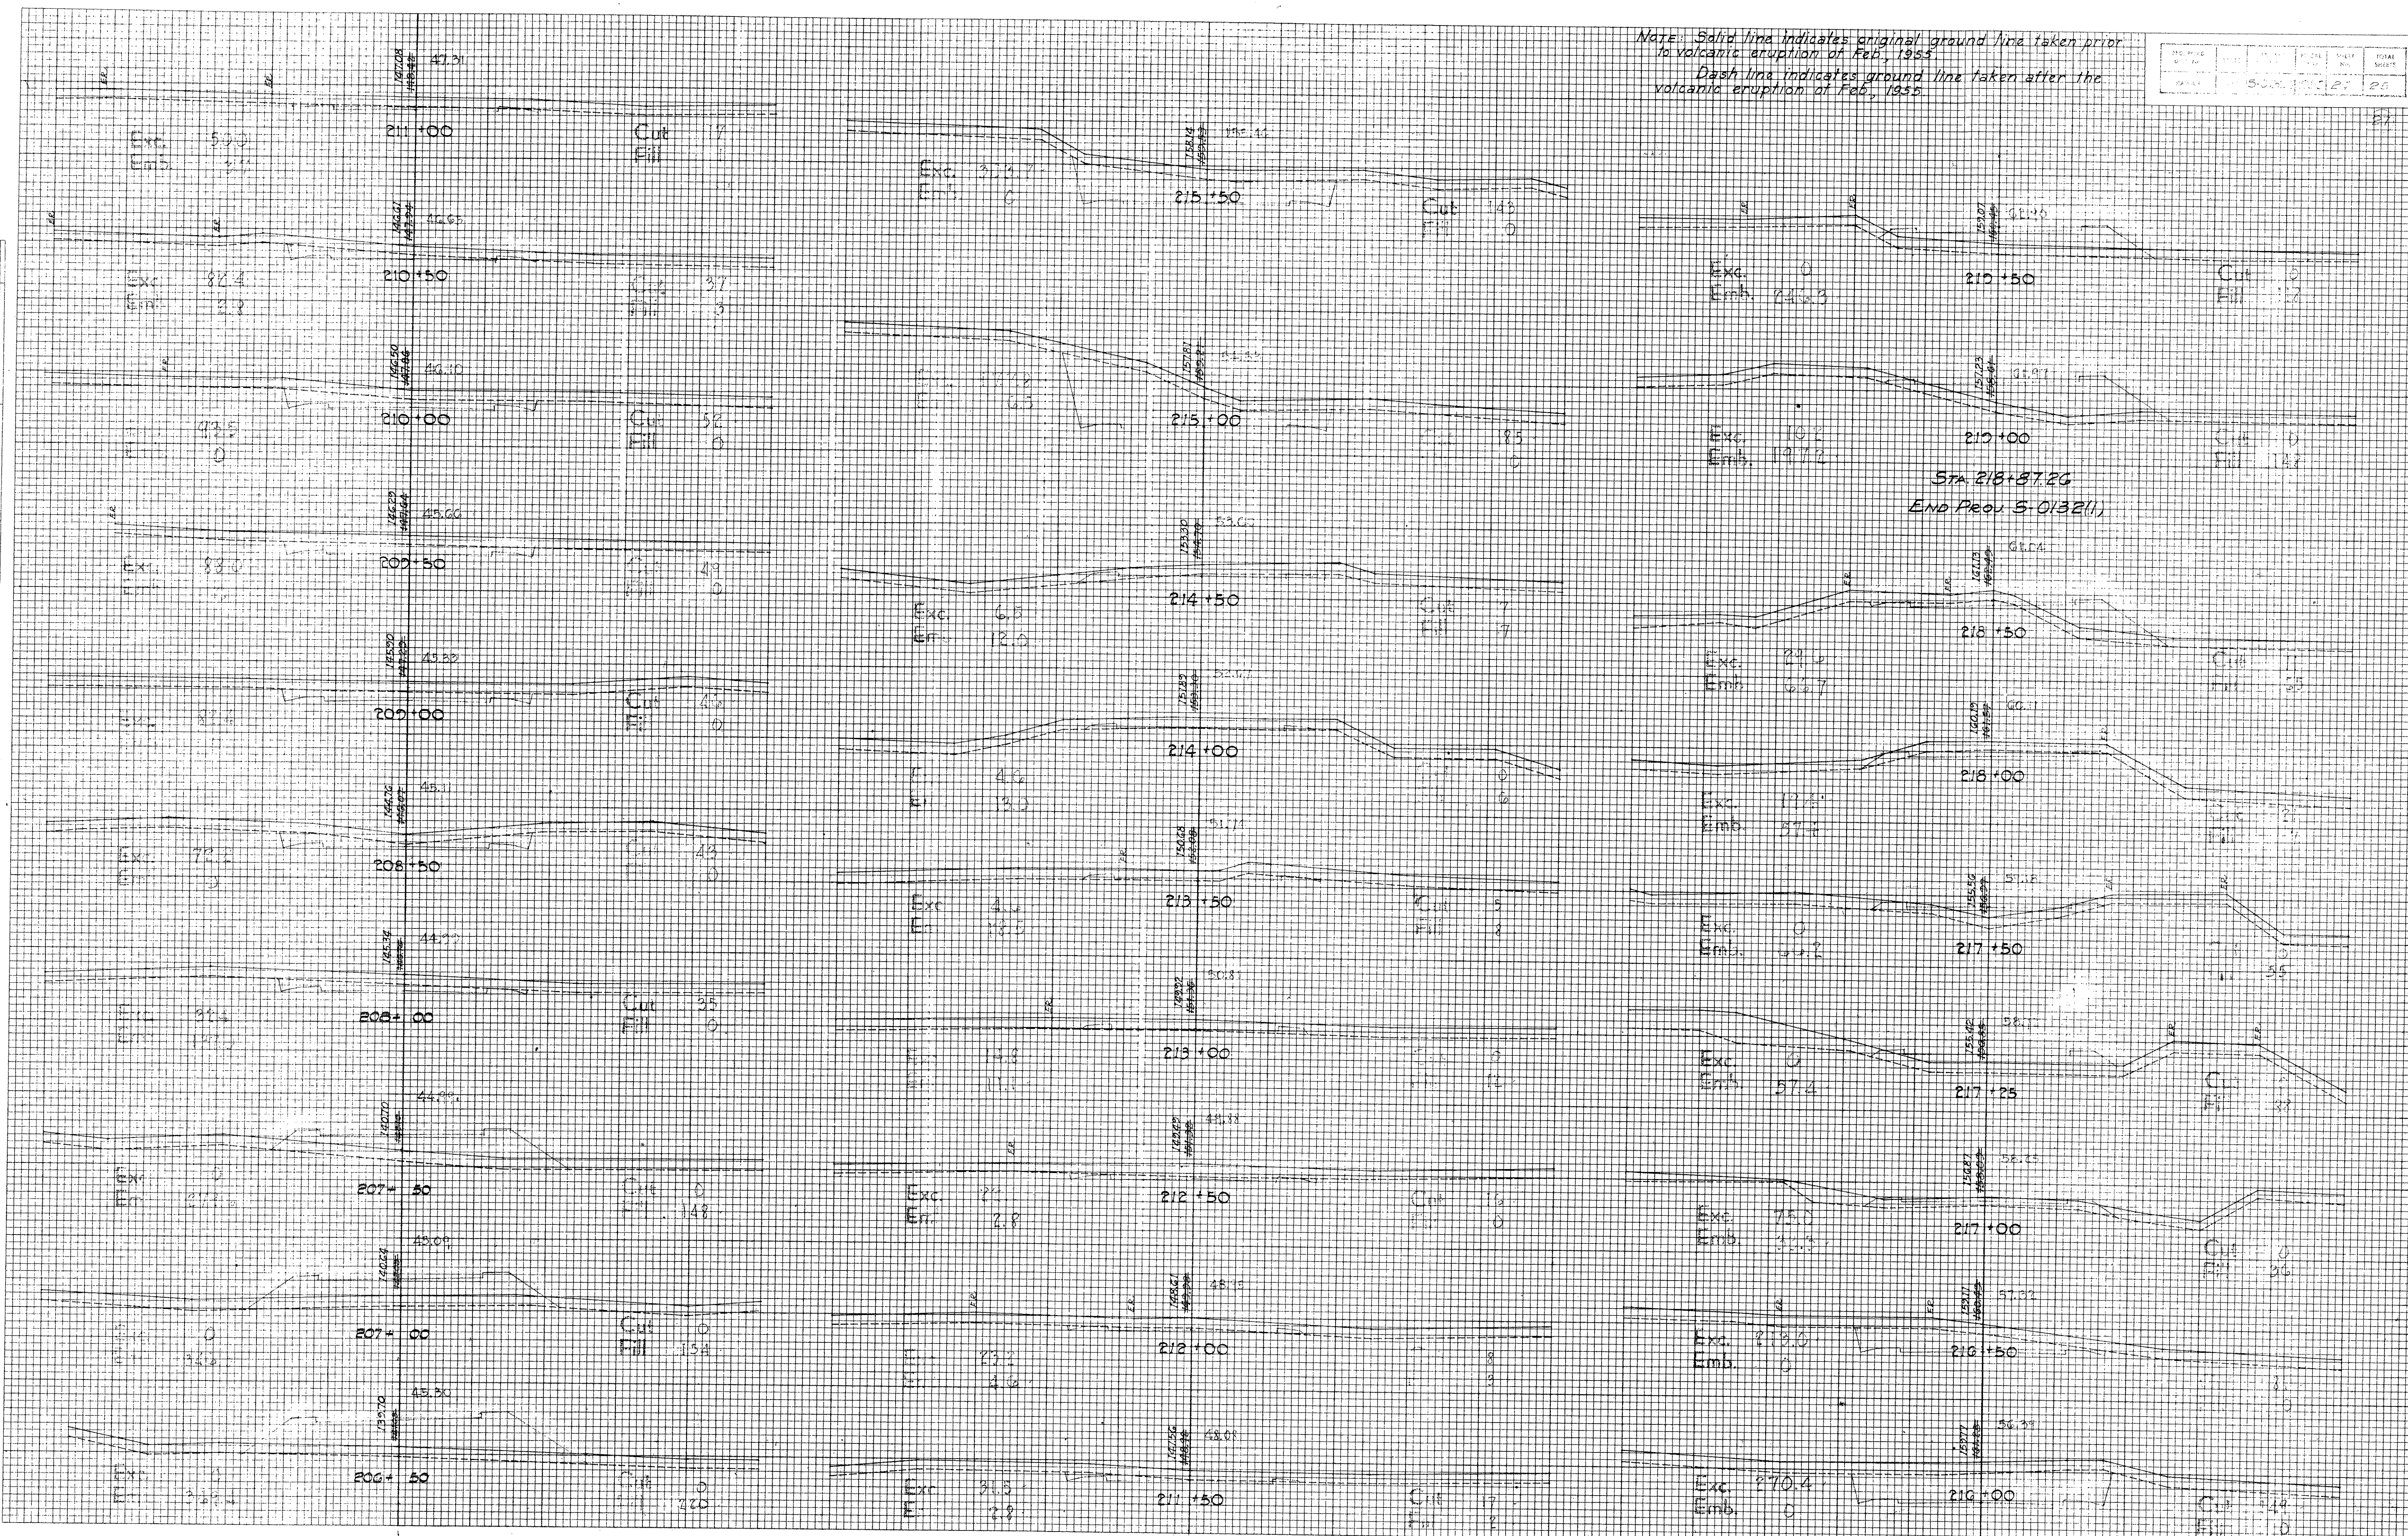

FINAL SURVEY	SURVEYED	DATE
	PLOTTED	BY
	NOTE BOOK	
	AREAS CHECKED	

ORIGINAL SURVEY	SURVEYED	DATE
	PLOTTED	BY
	NOTE BOOK	
	AREAS CHECKED	

Note: Solid line indicates original ground line taken prior to volcanic eruption of Feb. 1953.
Dash line indicates ground line taken after the volcanic eruption of Feb. 1953.

NO. OF PAGES	NO. OF SHEETS	DATE	TOTAL
20	20	20	20

