

INDEX TO DRAWINGS	
SHEET	DESCRIPTION
1	TITLE SHEET
2	TYPICAL SECTION
3-9	PLAN & PROFILE
10-13	STANDARD DETAILS
14-25	CROSS-SECTIONS

TERRITORY OF HAWAII

TERRITORIAL HIGHWAY DEPARTMENT

HONOLULU T.H.

PLANS OF

KAPOHO - PAHOA ROAD

FEDERAL AID SECONDARY PROJECT NO. S-0132(1)

DISTRICT OF PUNA

ISLAND OF HAWAII

SCALES


PLAN ----- 1 INCH = 100 FT.

PROFILE ----- HOR. 1 INCH = 100 FT.

VER. 1 INCH = 10 FT.


CROSS SECTION ----- HOR. 1 INCH = 10 FT.

VER. 1 INCH = 10 FT.

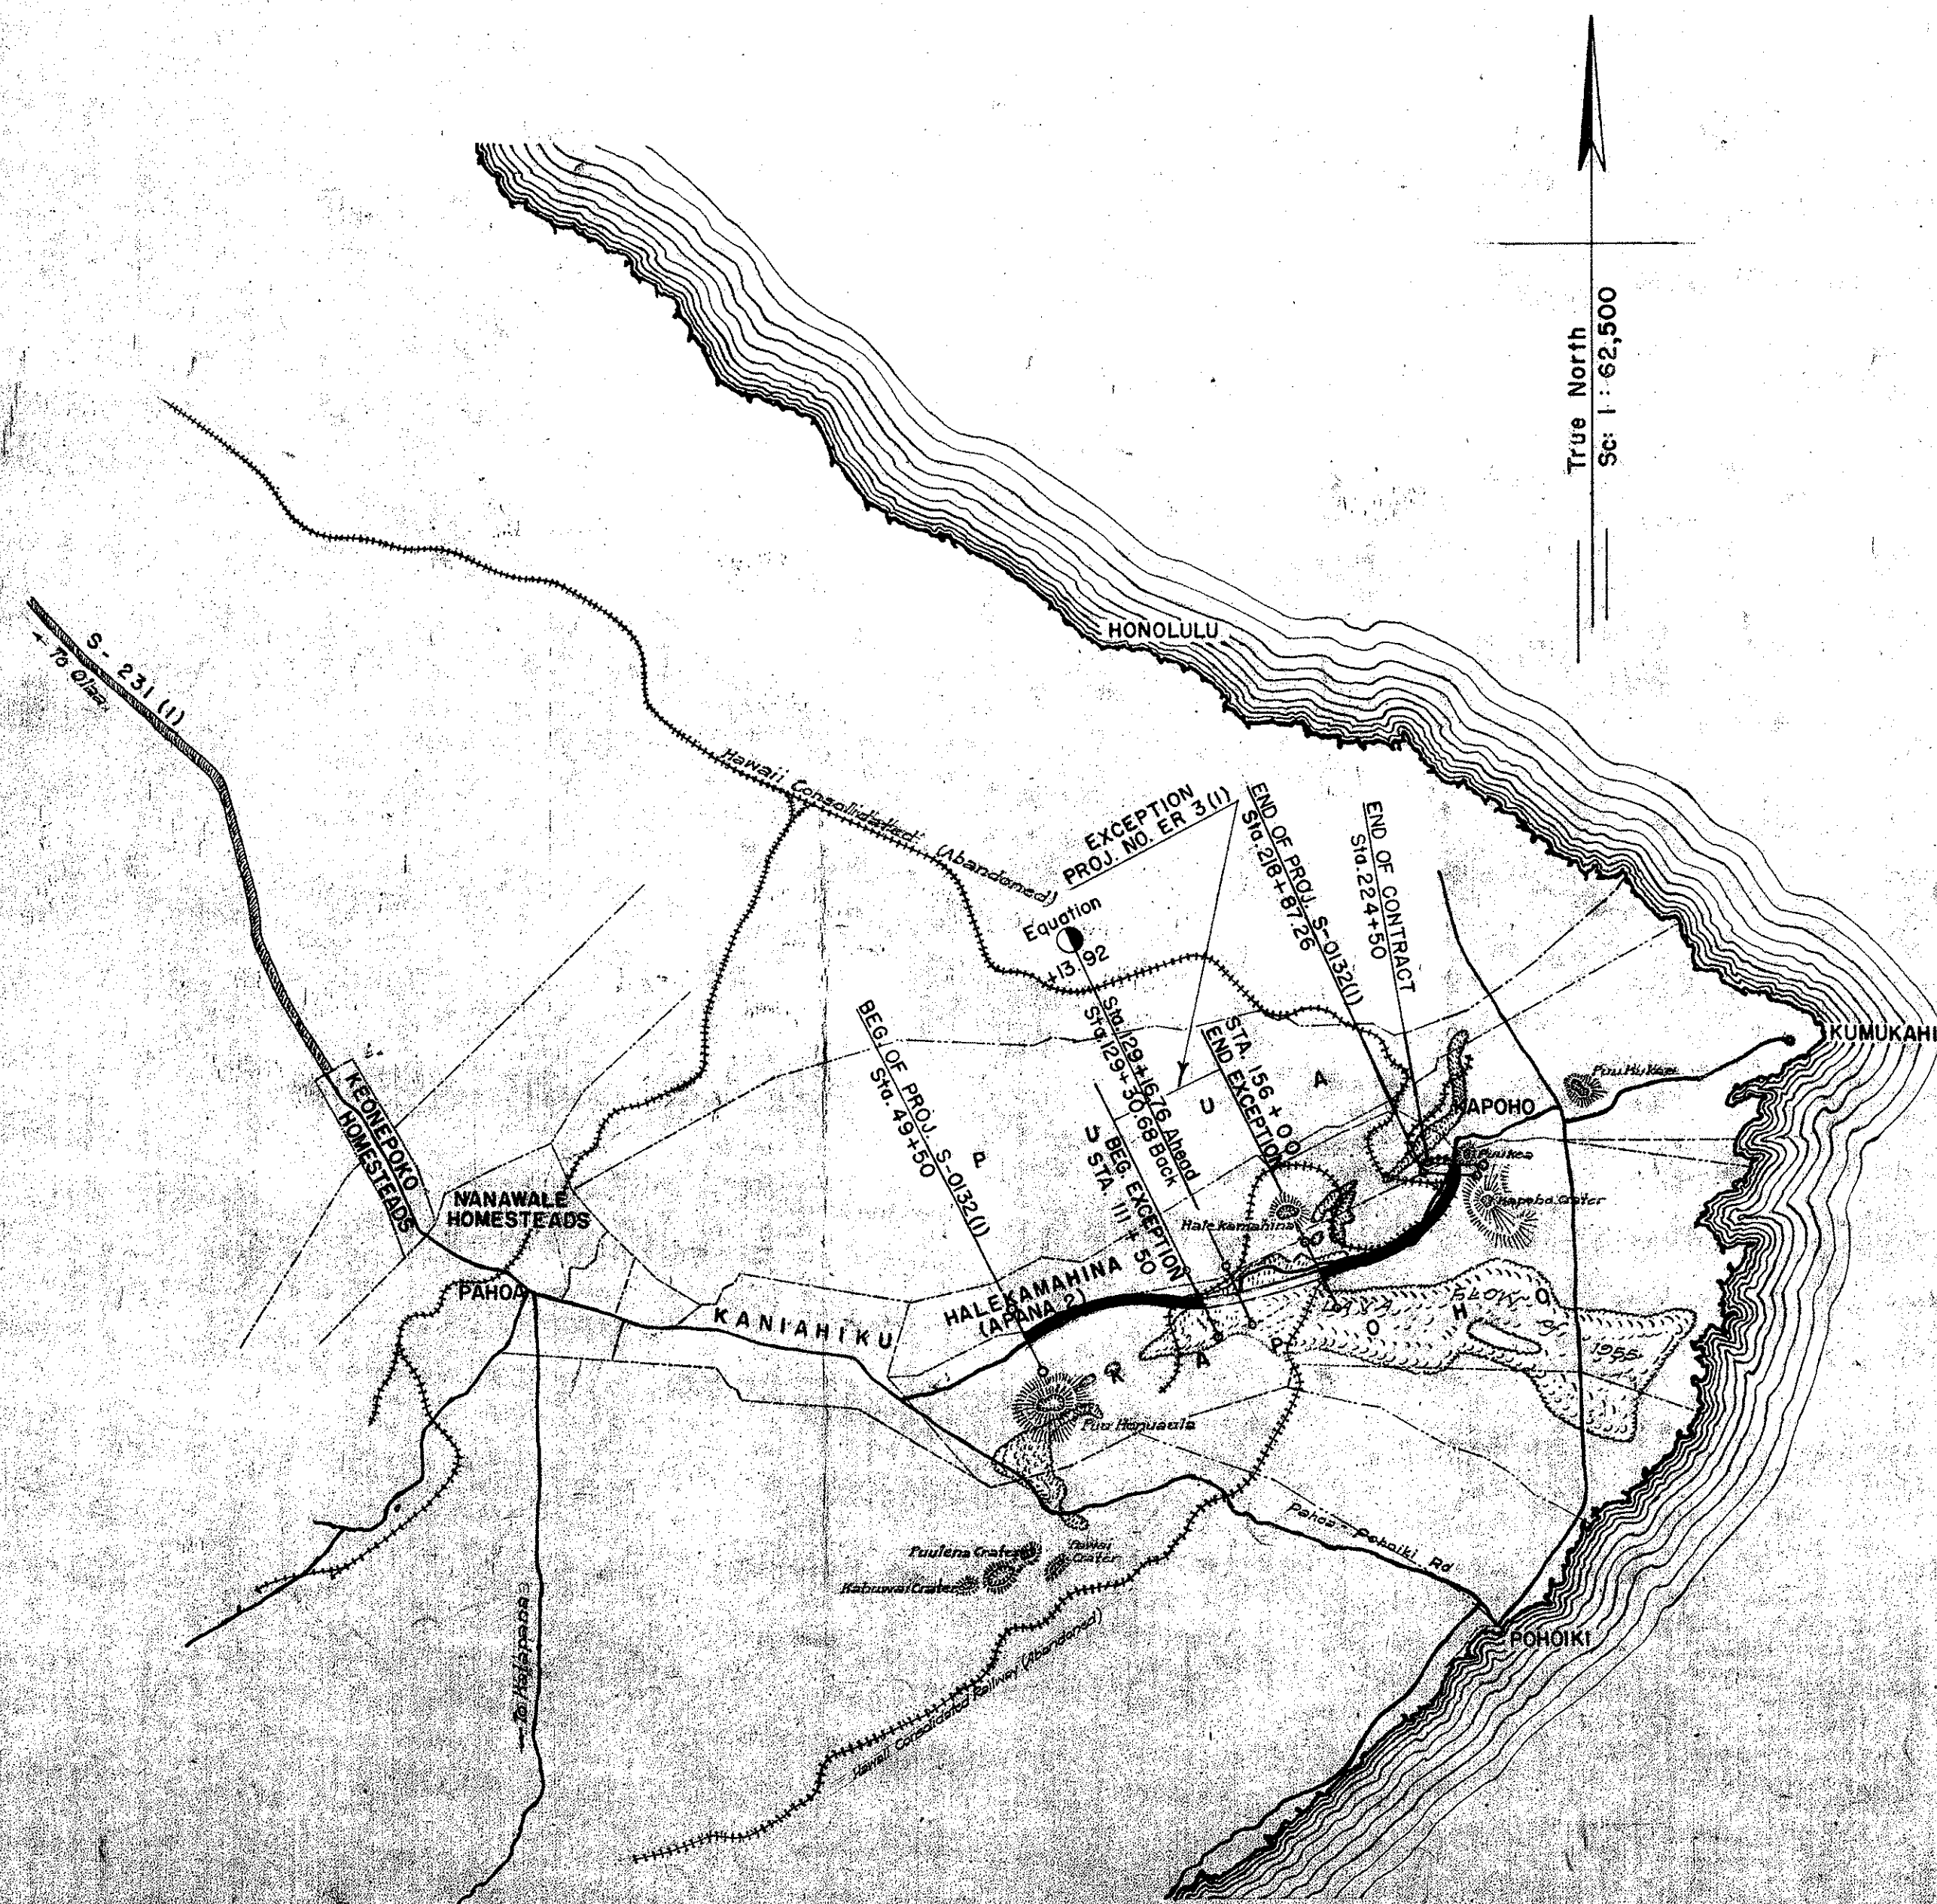

GROSS & NET LENGTH OF PROJECT

2.365 MILES

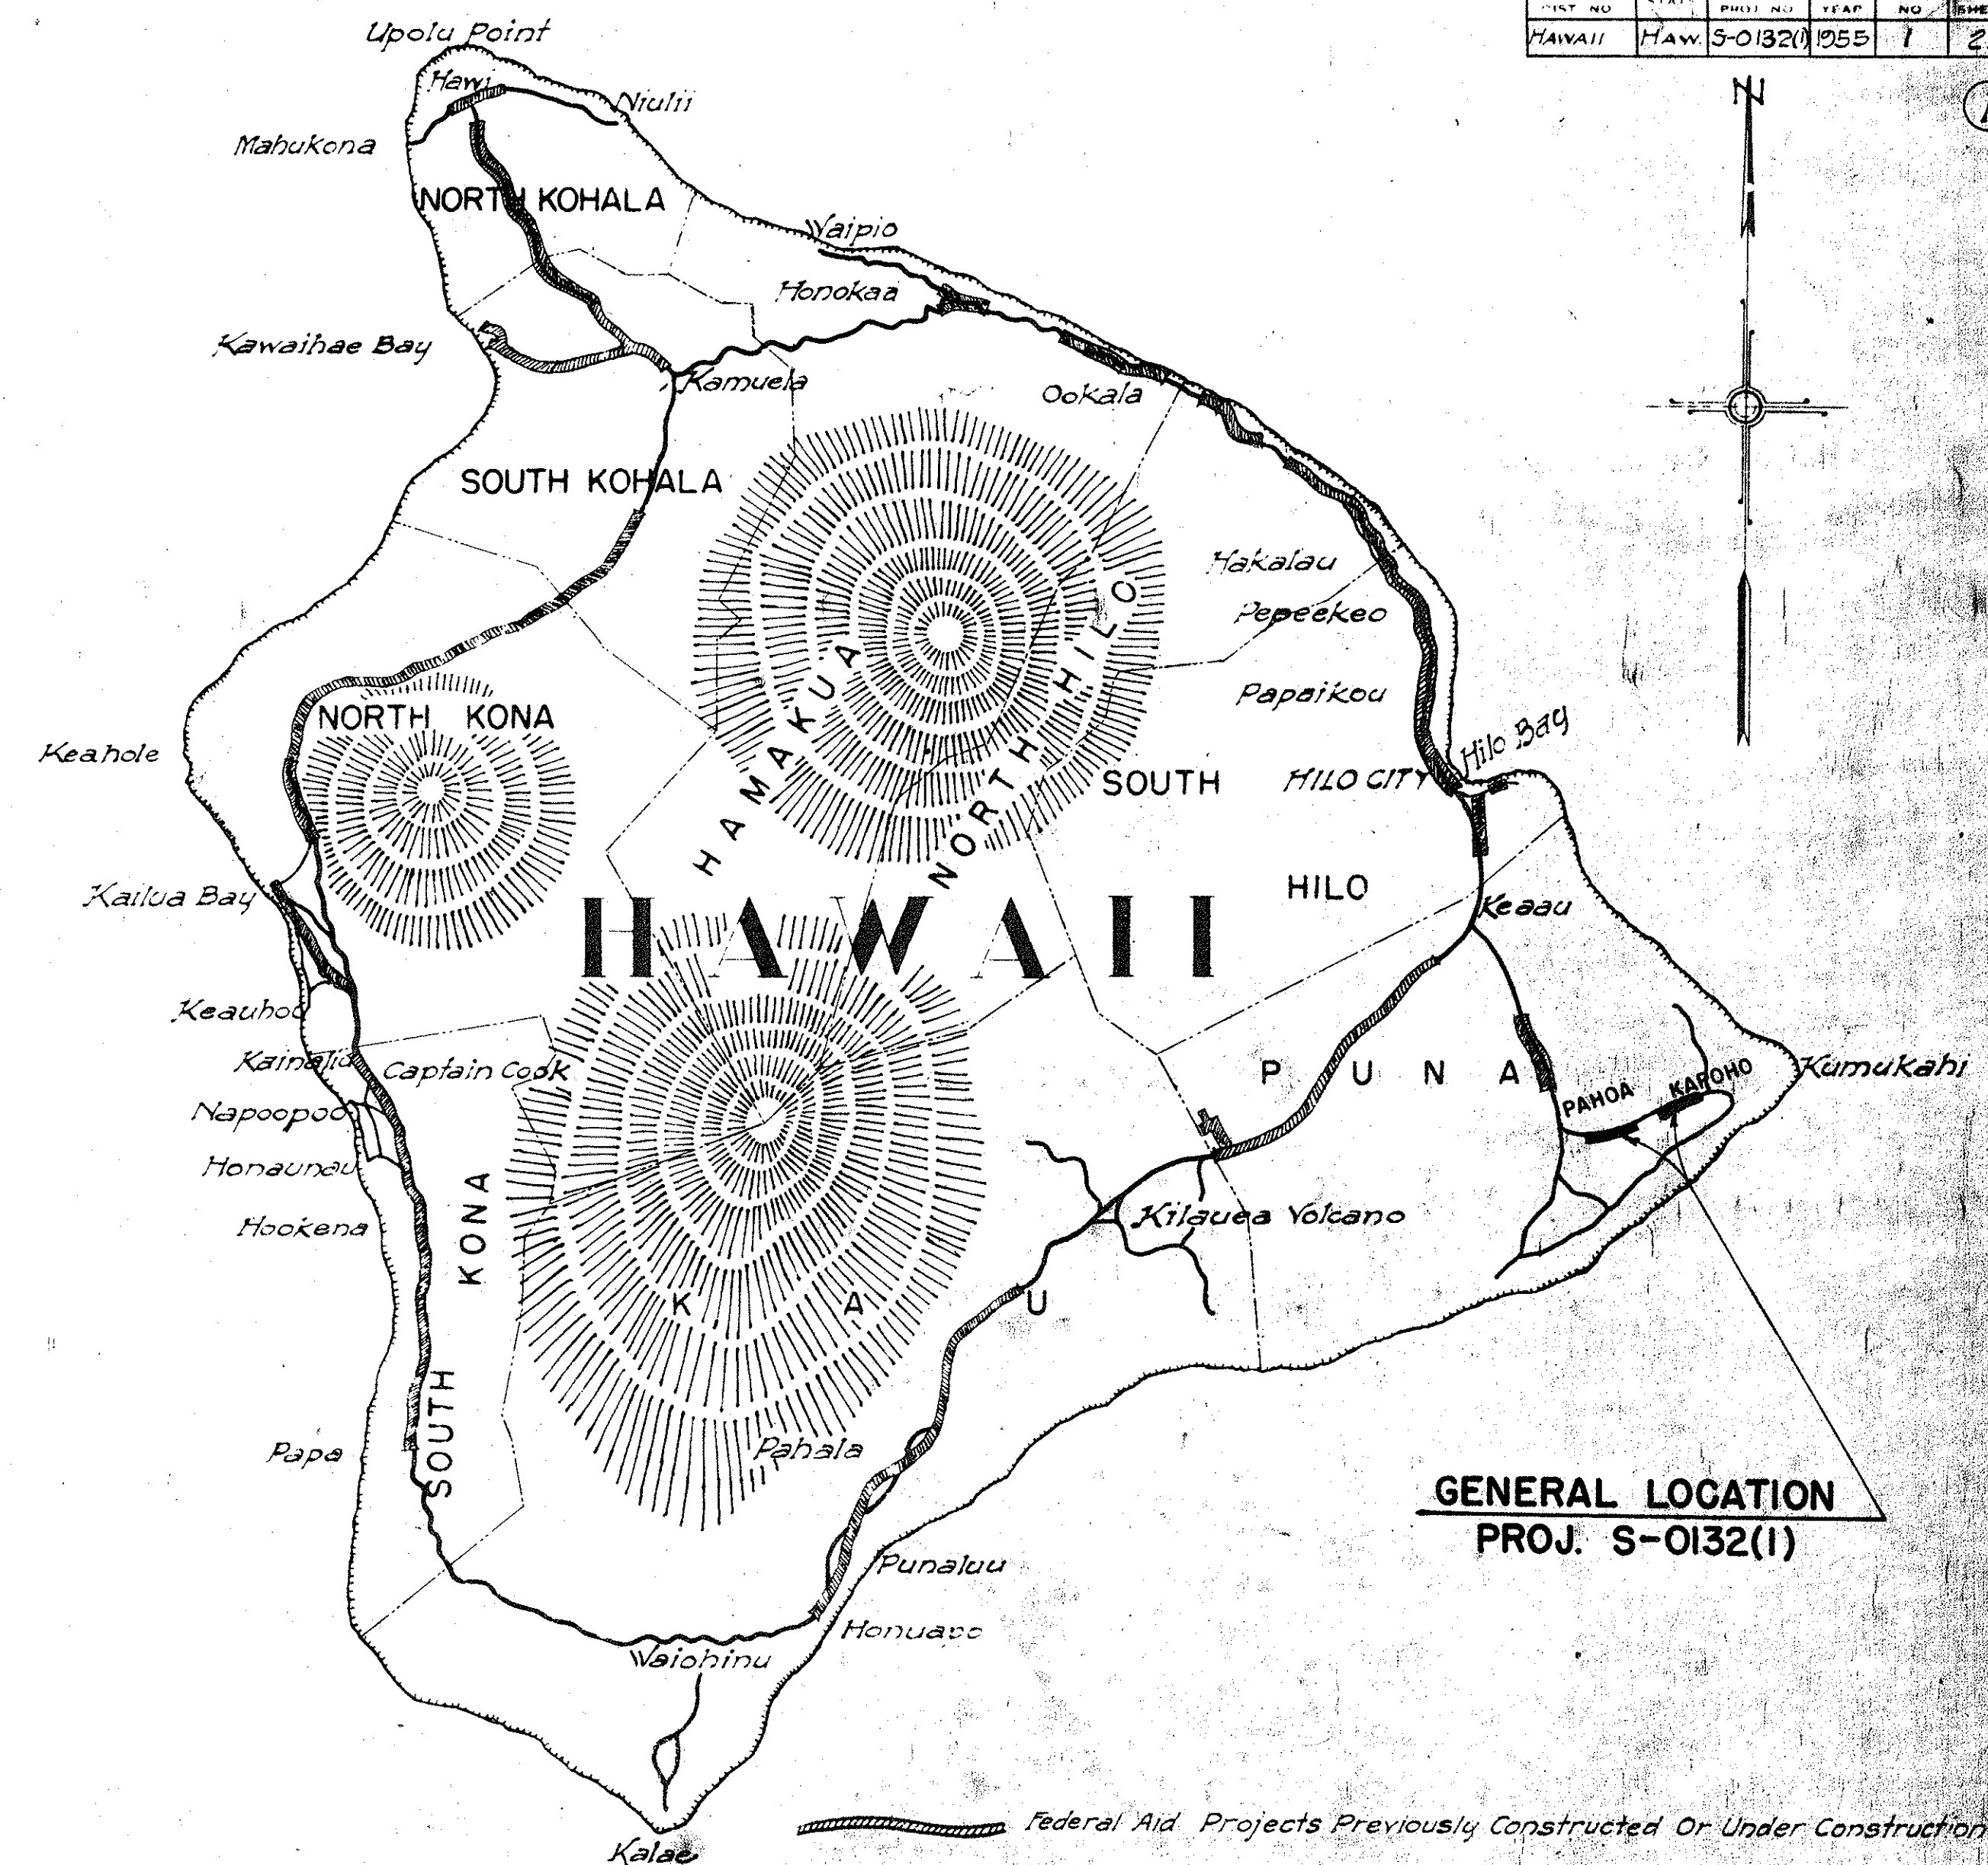

NOTE:—

All changes made during construction

have been noted in red on these sheets

and checked by

Theodore B. Wong

Project Engineer

October 8, 1956

Date

APPROVED: _____

DATE 9-29-56

Theodore B. Wong

TERRITORIAL HIGHWAY ENGINEER

DEPARTMENT OF COMMERCE

BUREAU OF PUBLIC ROADS

APPROVED: _____

DISTRICT ENGINEER

DATE _____