

| INDEX TO DRAWINGS |                 |
|-------------------|-----------------|
| SHEET             | DESCRIPTION     |
| 1                 | TITLE SHEET     |
| 2                 | TYPICAL SECTION |
| 3-5               | PLAN & PROFILE  |
| 6-17              | CROSS SECTIONS  |
|                   |                 |
|                   |                 |
TERRITORY OF HAWAII

TERRITORIAL HIGHWAY DEPARTMENT

HONOLULU T.H.

PLANS OF

PAHOA—KALAPANA ROAD



EMERGENCY RELIEF PROJECT NO. ER—4(I)

DISTRICT OF PUNA

ISLAND OF HAWAII

SCALES

|               |             |         |
|---------------|-------------|---------|
| PLAN          | 1 INCH      | 200 FT. |
| PROFILE       | HOR. 1 INCH | 200 FT. |
|               | VER. 1 INCH | 20 FT.  |
| CROSS SECTION | HOR. 1 INCH | 10 FT.  |
|               | VER. 1 INCH | 10 FT.  |

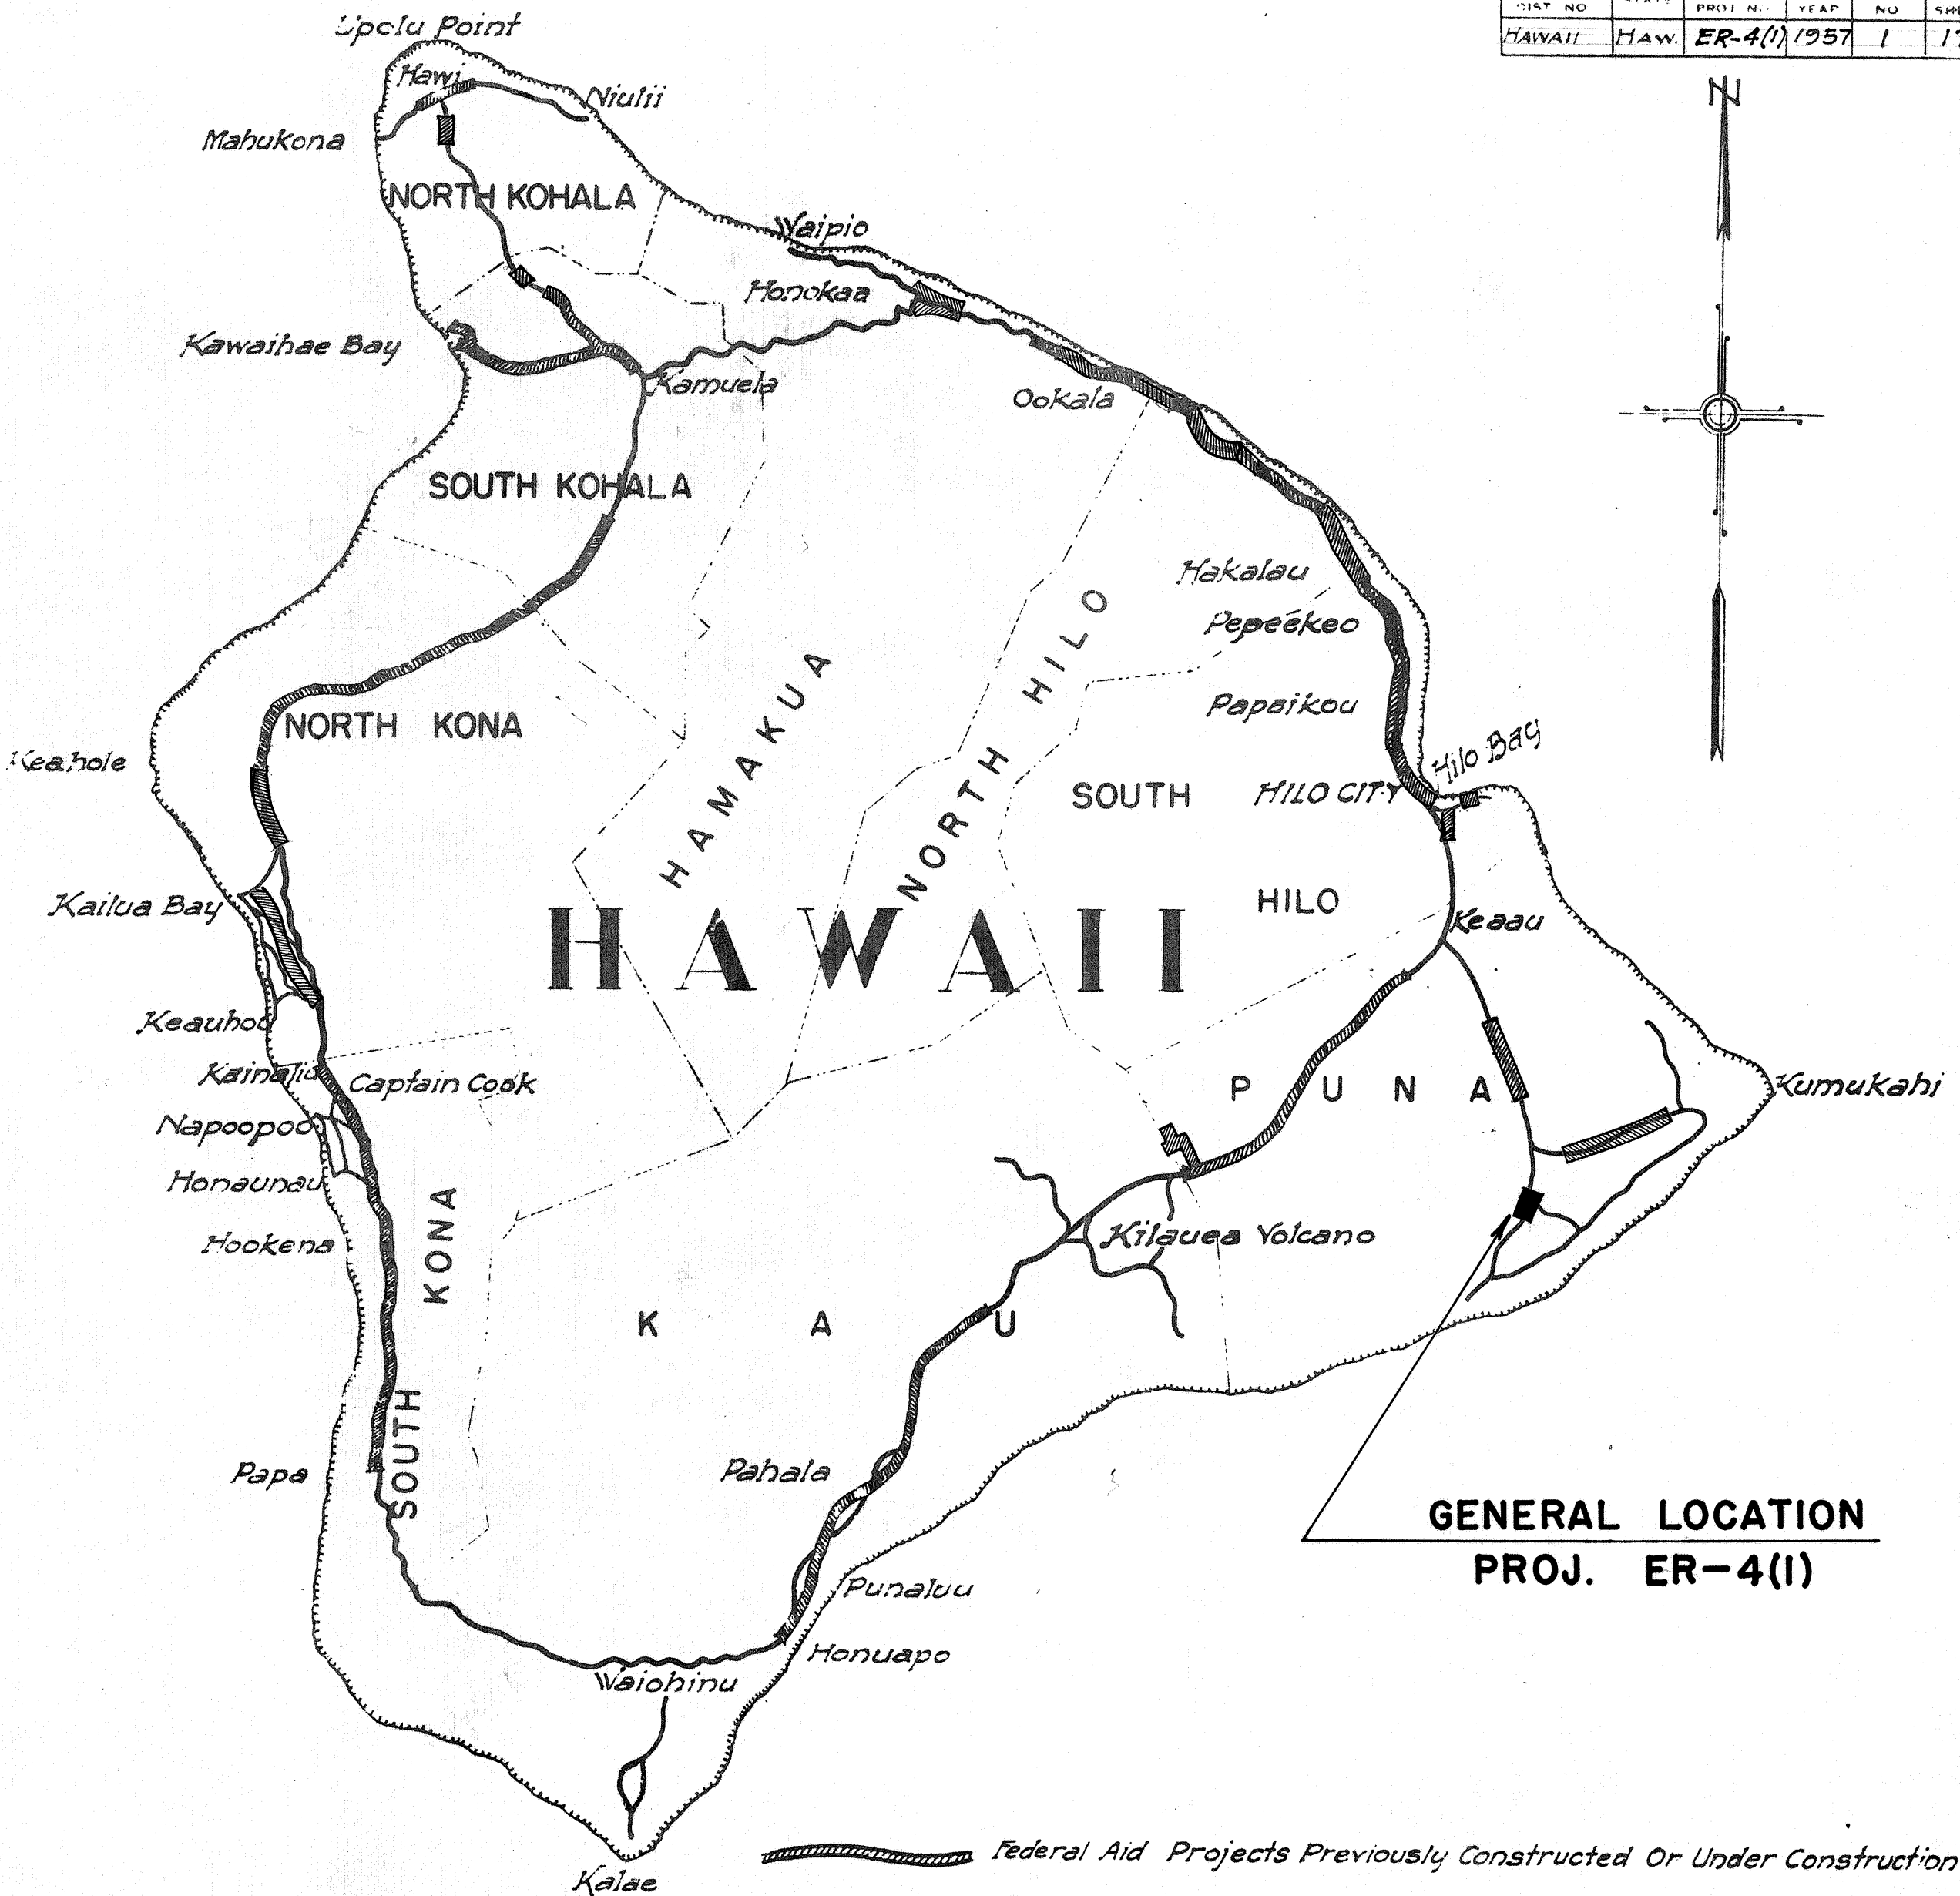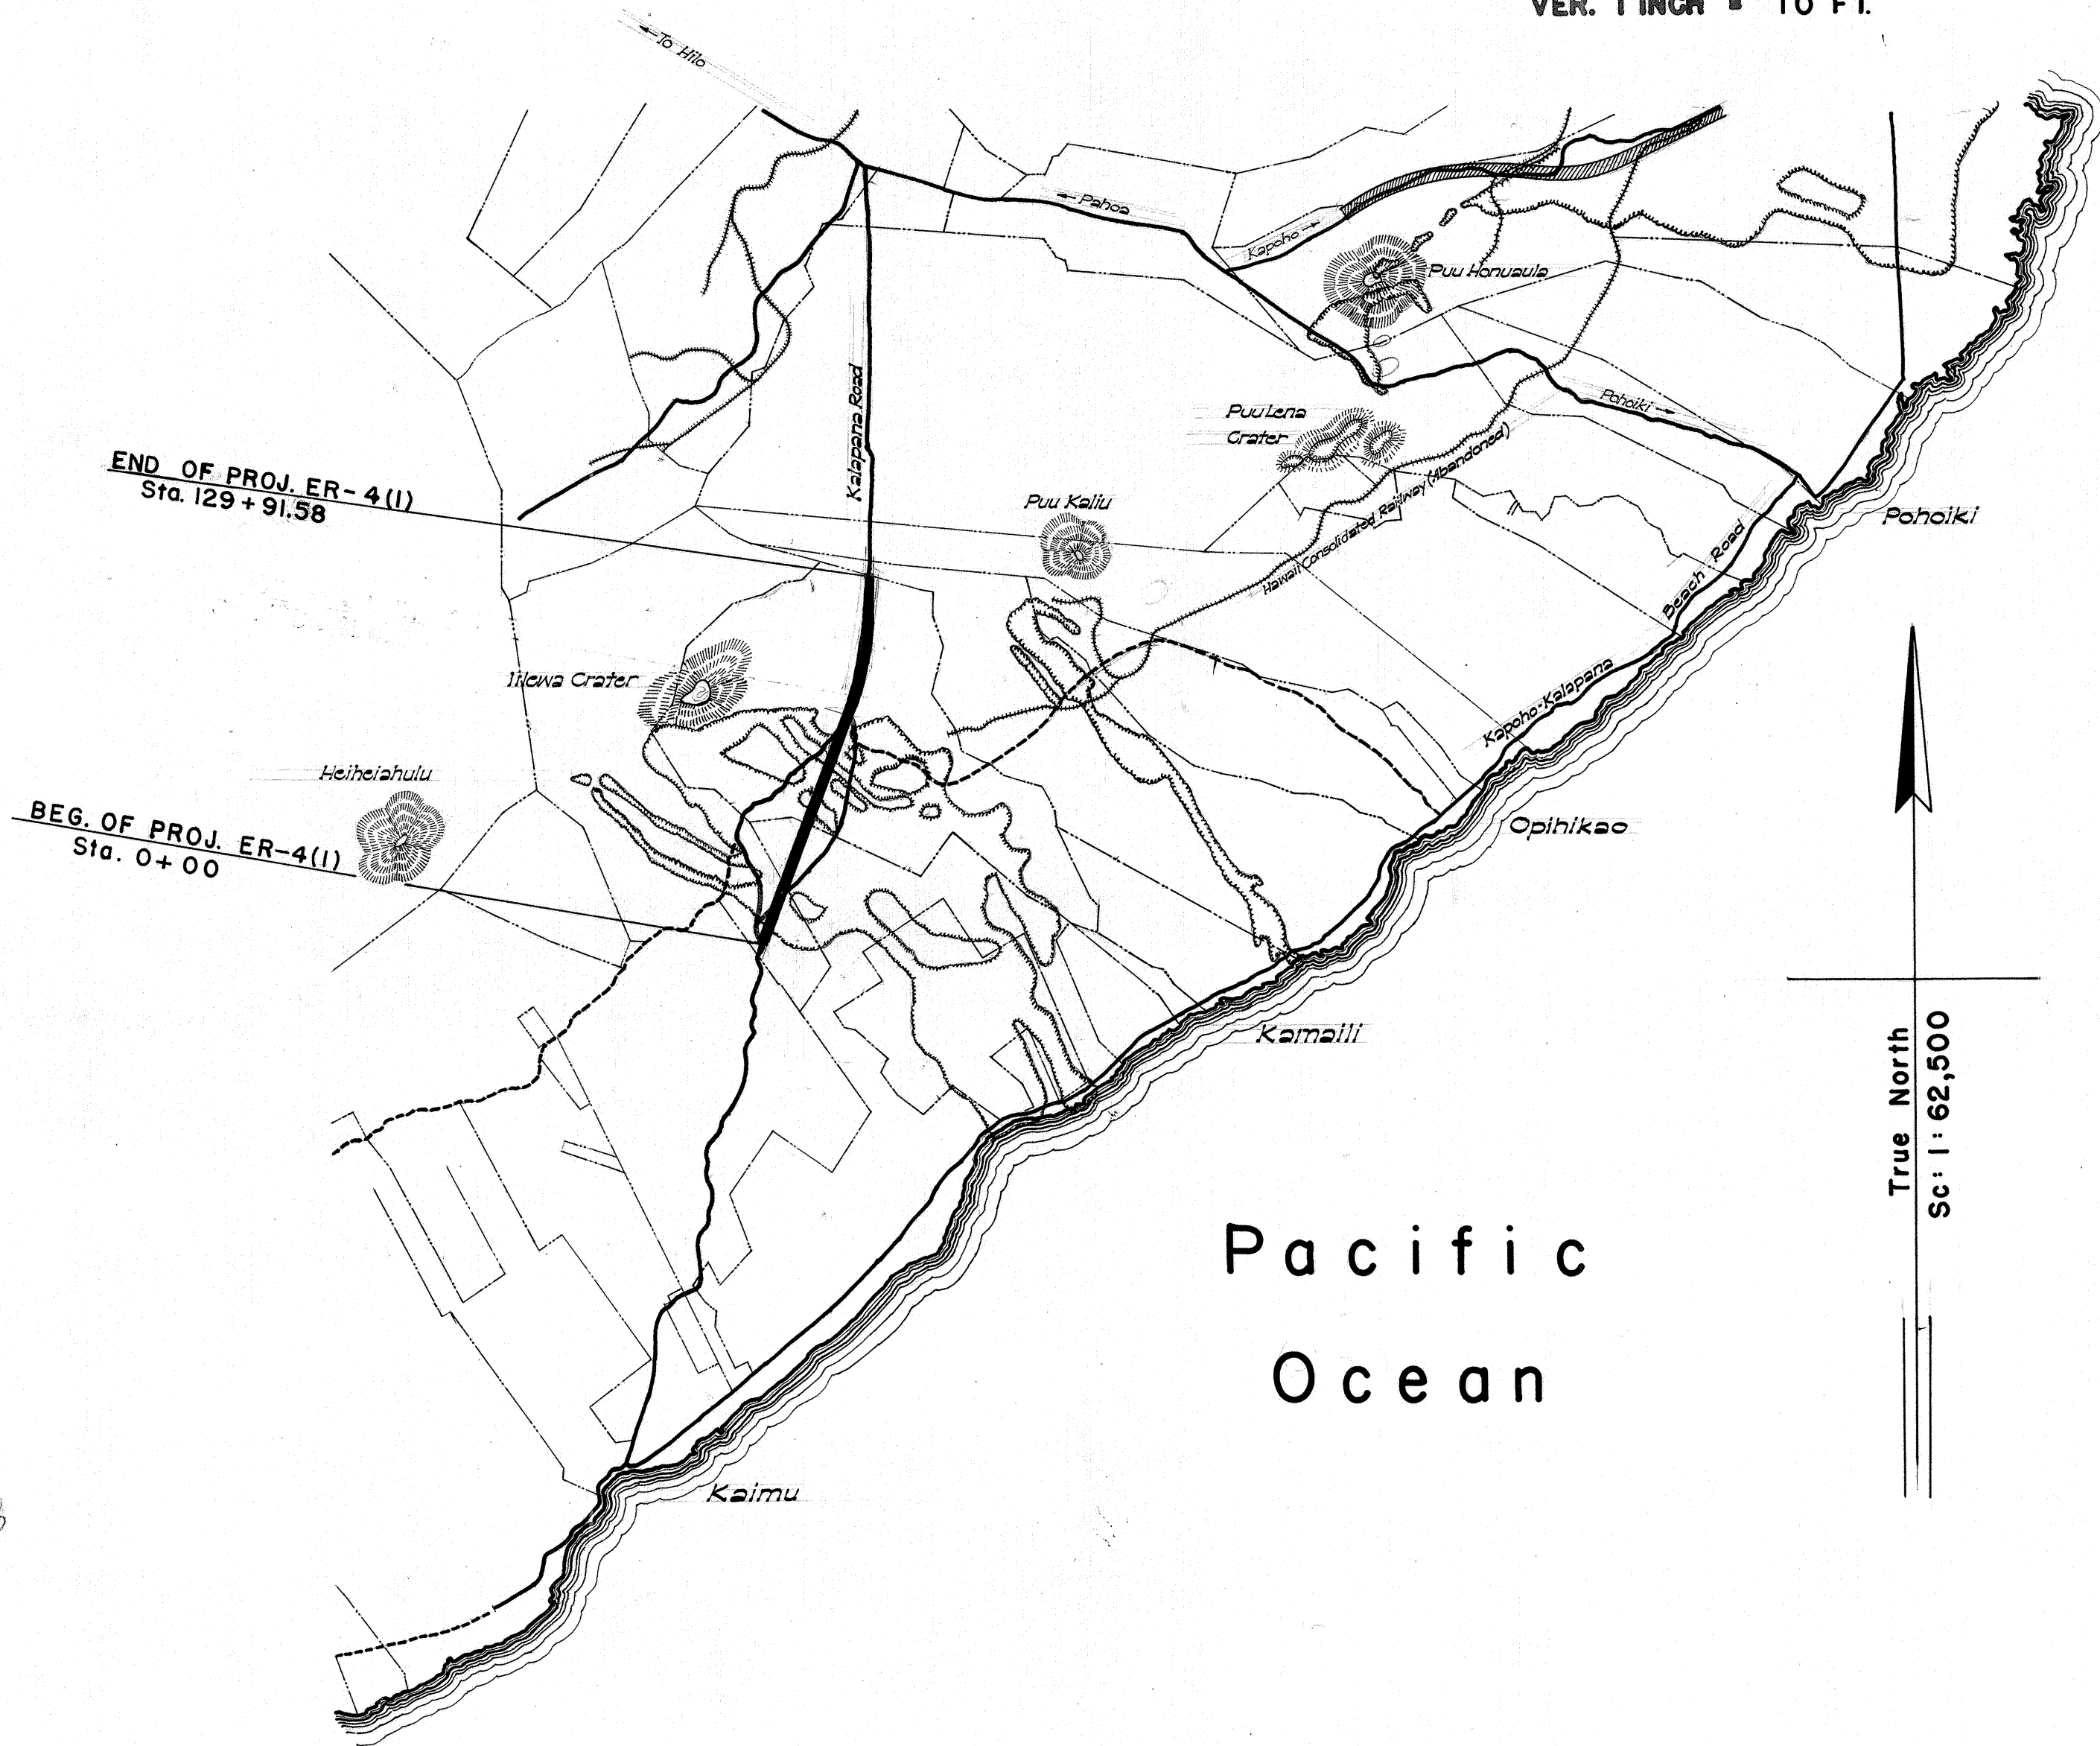

NOTE: ALL CHANGES MADE DURING CONSTRUCTION  
HAVE BEEN NOTED IN RED ON THESE  
TRACINGS AND CHECKED BY:

NET & GROSS LENGTH OF PROJECT 2.461 Miles

T. Harano

ACT'g DISTRICT ENGINEER

5/4/50

DATE

APPROVED: DATE 9/12/57

Wm. Waites

TERRITORIAL HIGHWAY ENGINEER

DEPARTMENT OF COMMERCE  
BUREAU OF PUBLIC ROADS

APPROVED:

DIVISION

ENGINEER

DATE