

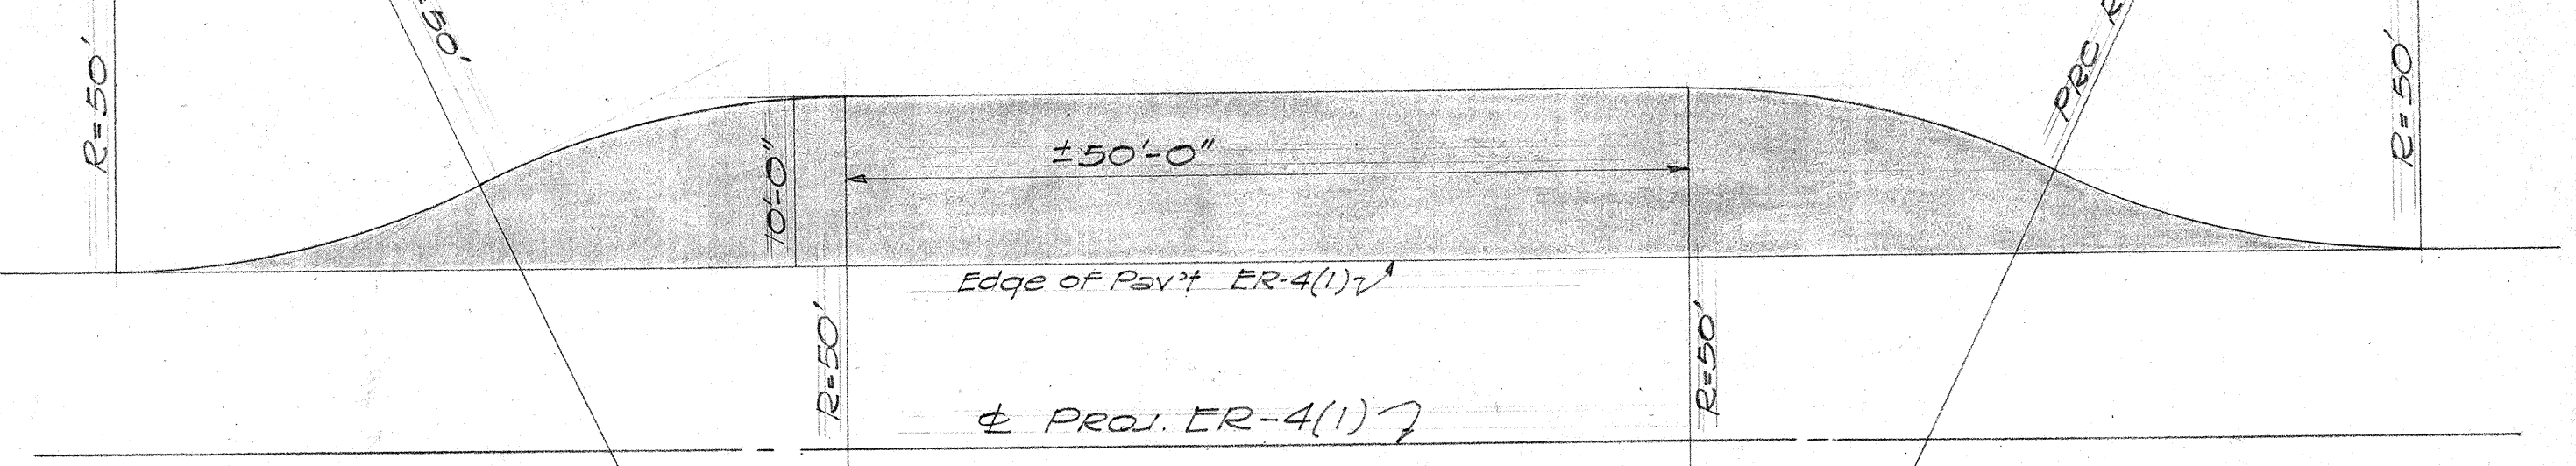
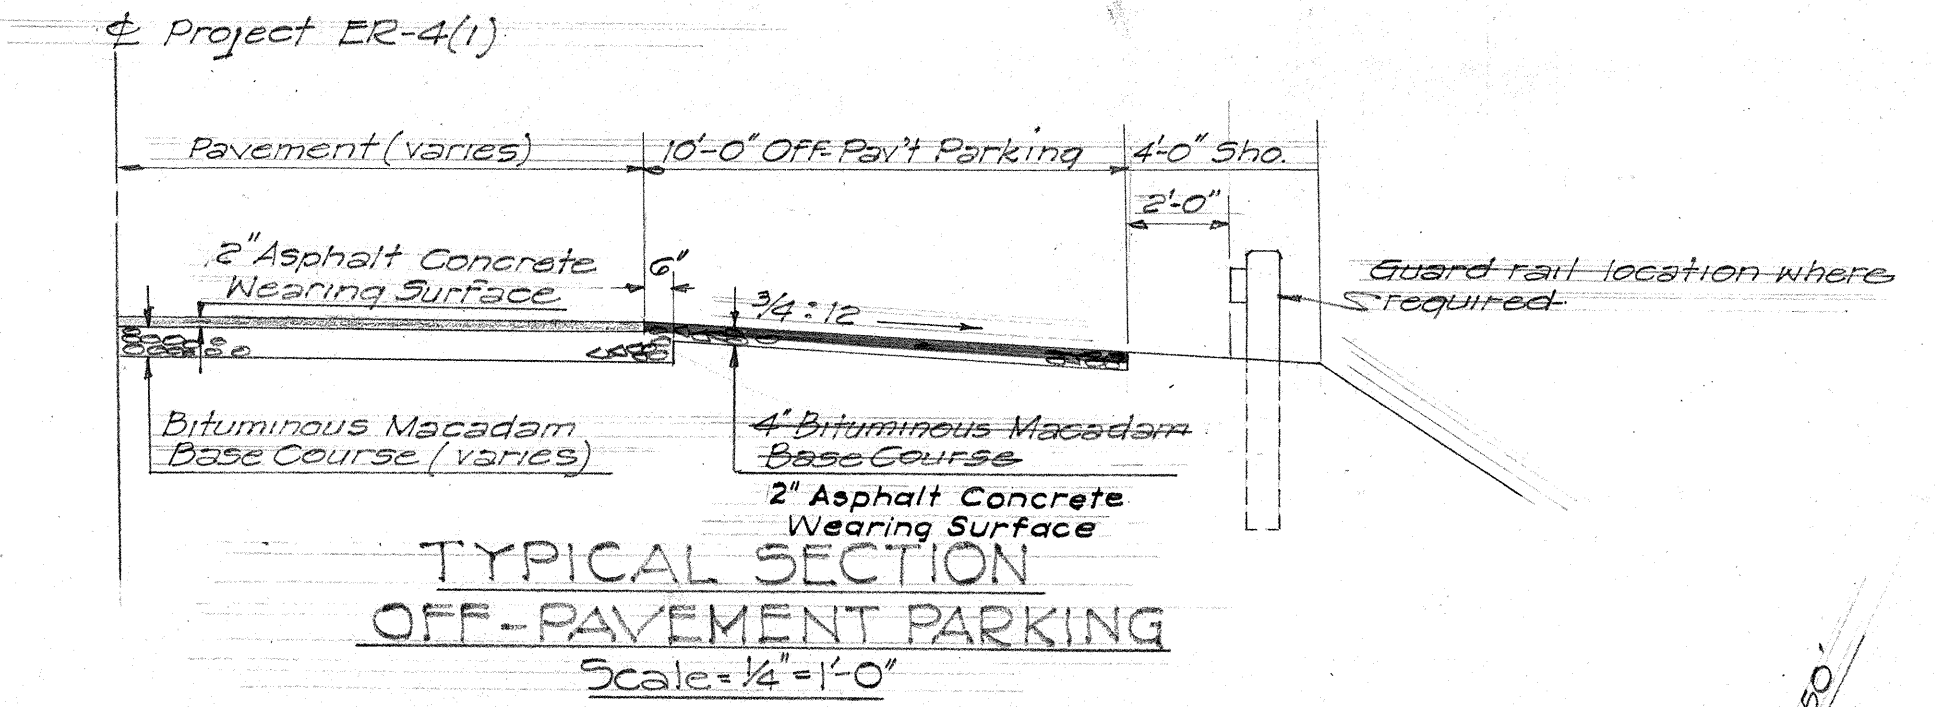


GENERAL NOTES:

1. Pavement - Sta. 0+00 to 133+00 pavement shall be asphalt concrete wearing surface, Mix III, laid in one layer of 2" compacted thickness. Opihikao Road - pavement shall be asphalt concrete wearing surface, Mix V, laid in one layer of 1" compacted thickness.
2. Base Course - Sta. 0+00 to 72+00 and Opihikao Road - base course shall be bituminous macadam base course, laid in one layer of 4" compacted thickness. Sta. 72+00 to 133+00 base course shall be bituminous macadam base 6" thick, laid in 2 layers of 3" compacted thickness. (See special provisions)
3. Shoulders - Shoulders shall be dressed with borrow and primed with slow curing liquid asphalt at the approx. rate of 0.35 gals. per sq. yd.
4. Off-Pavement Parking - At places designated by the Engineer, off-pavement parking shall be constructed as detailed below to provide parking for sightseeing.

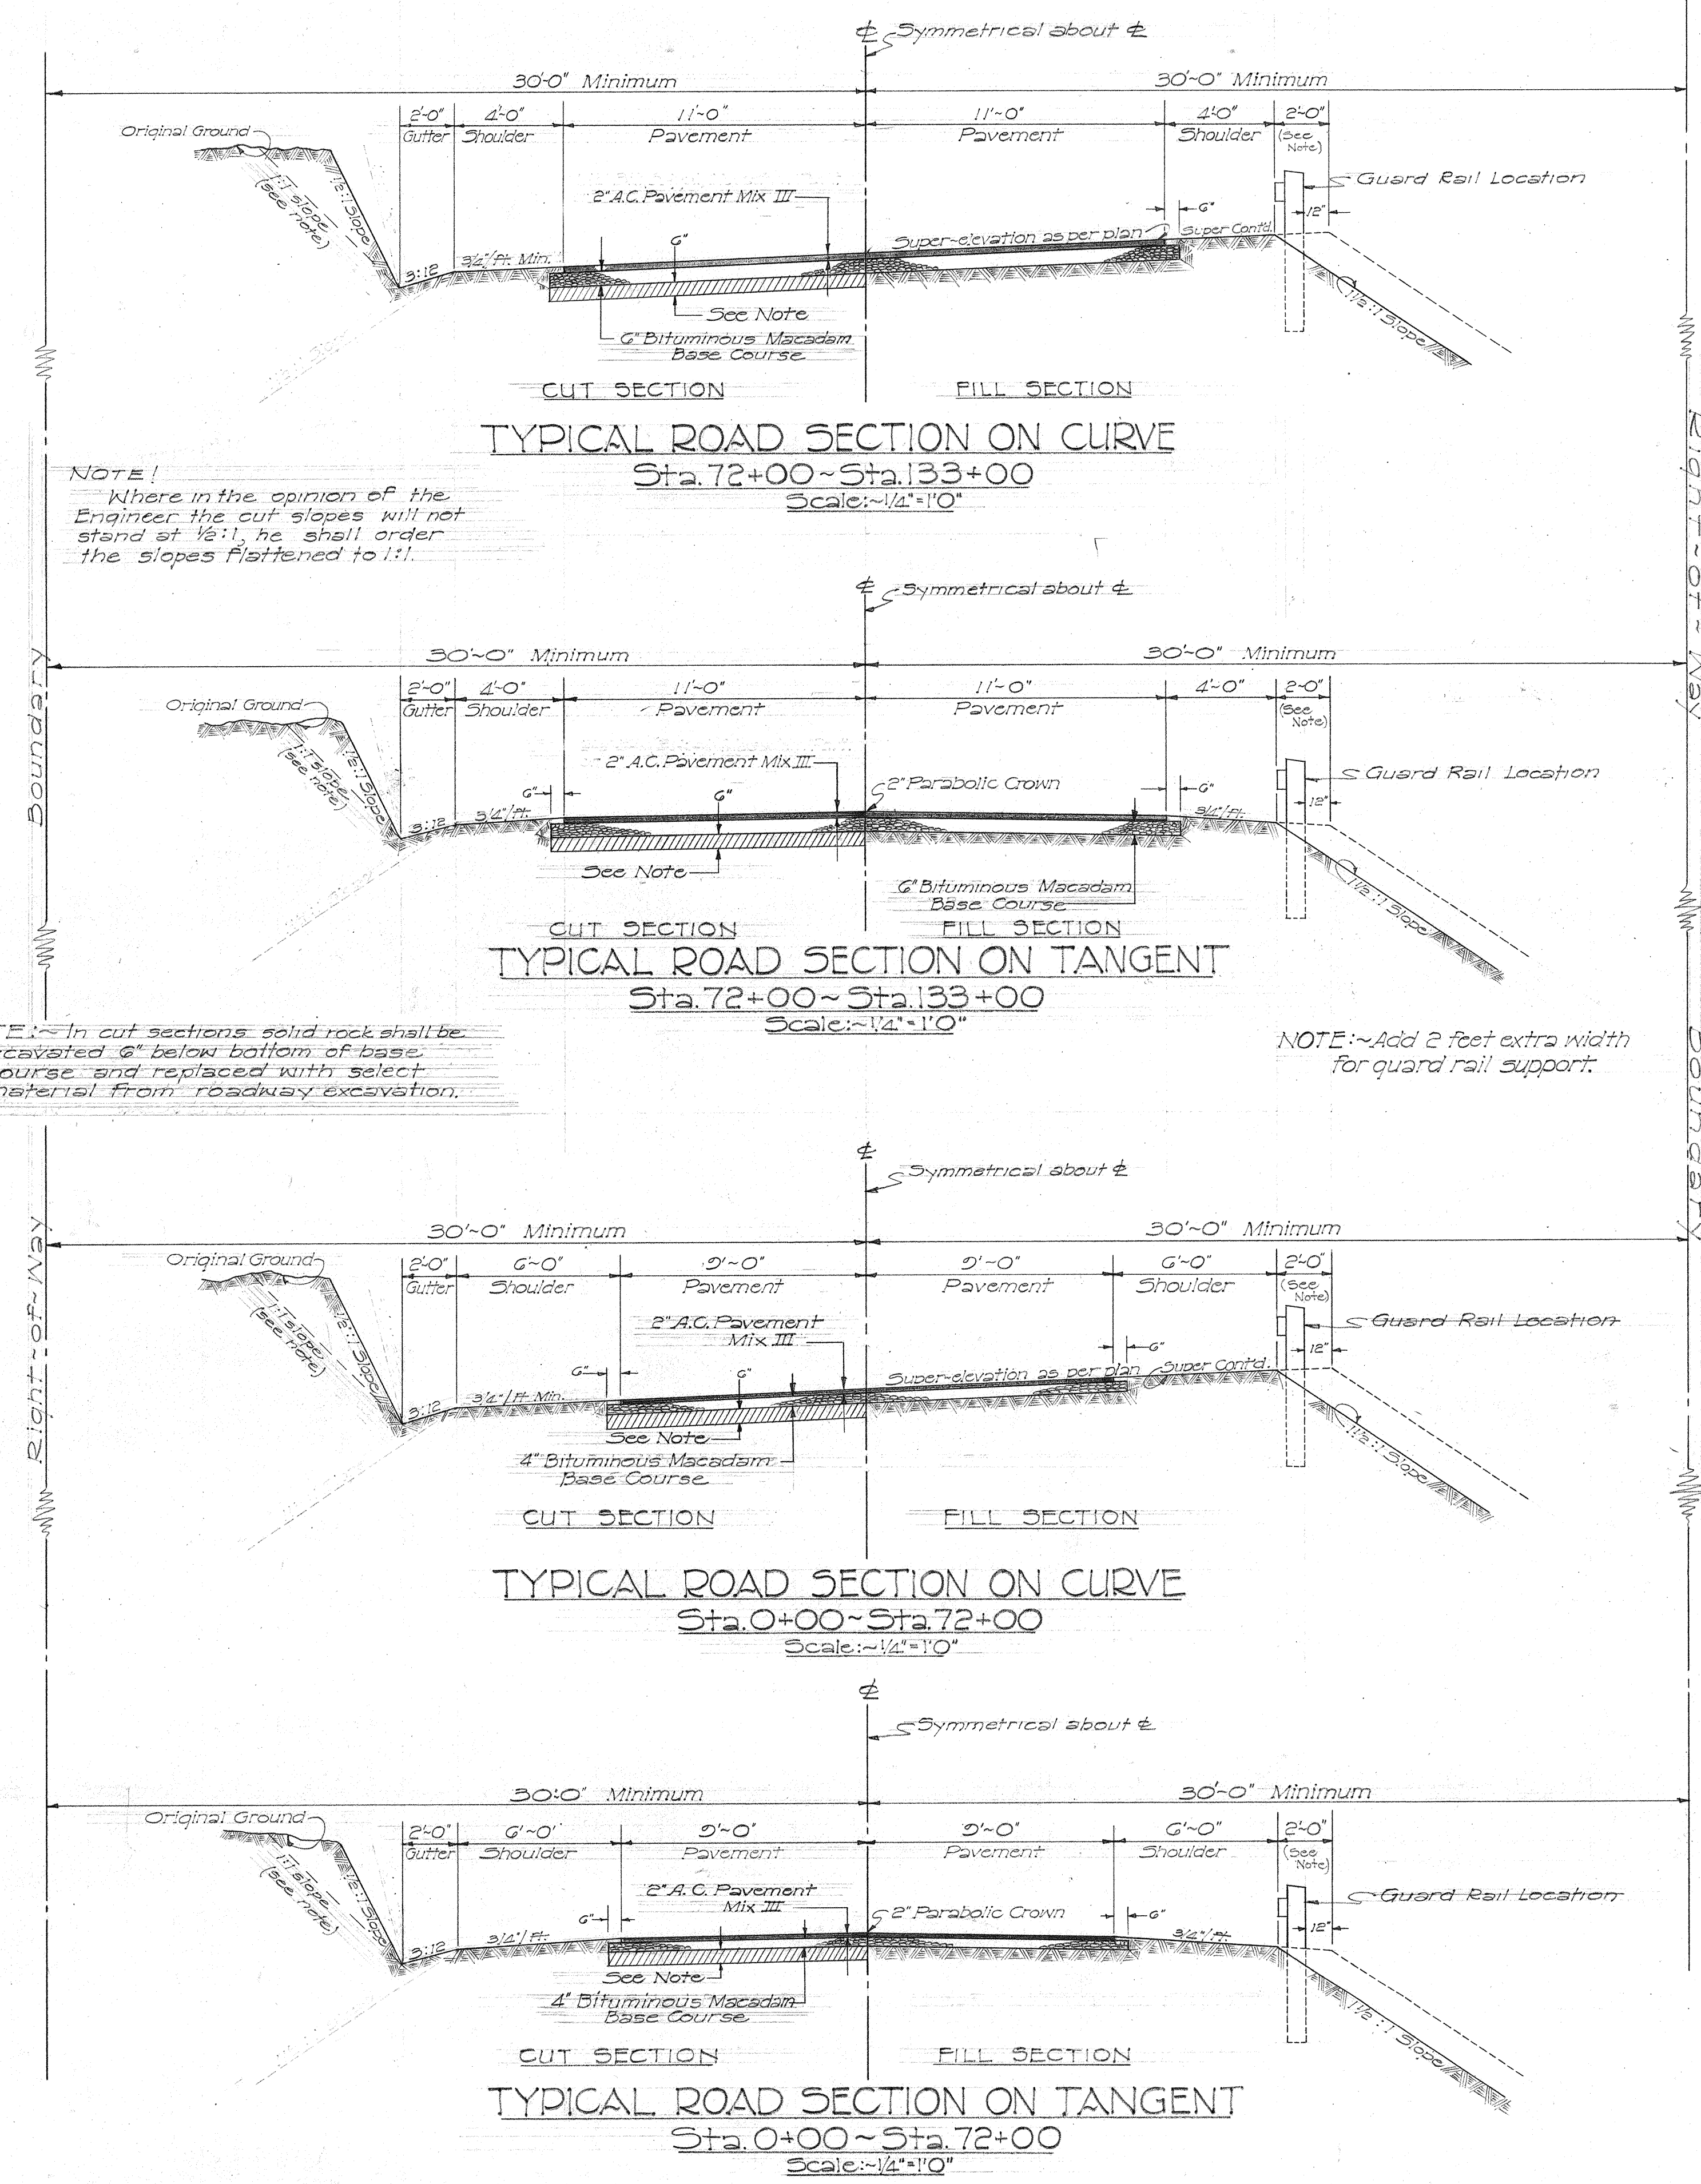

LAYOUT OF OFF-PAVEMENT PARKING

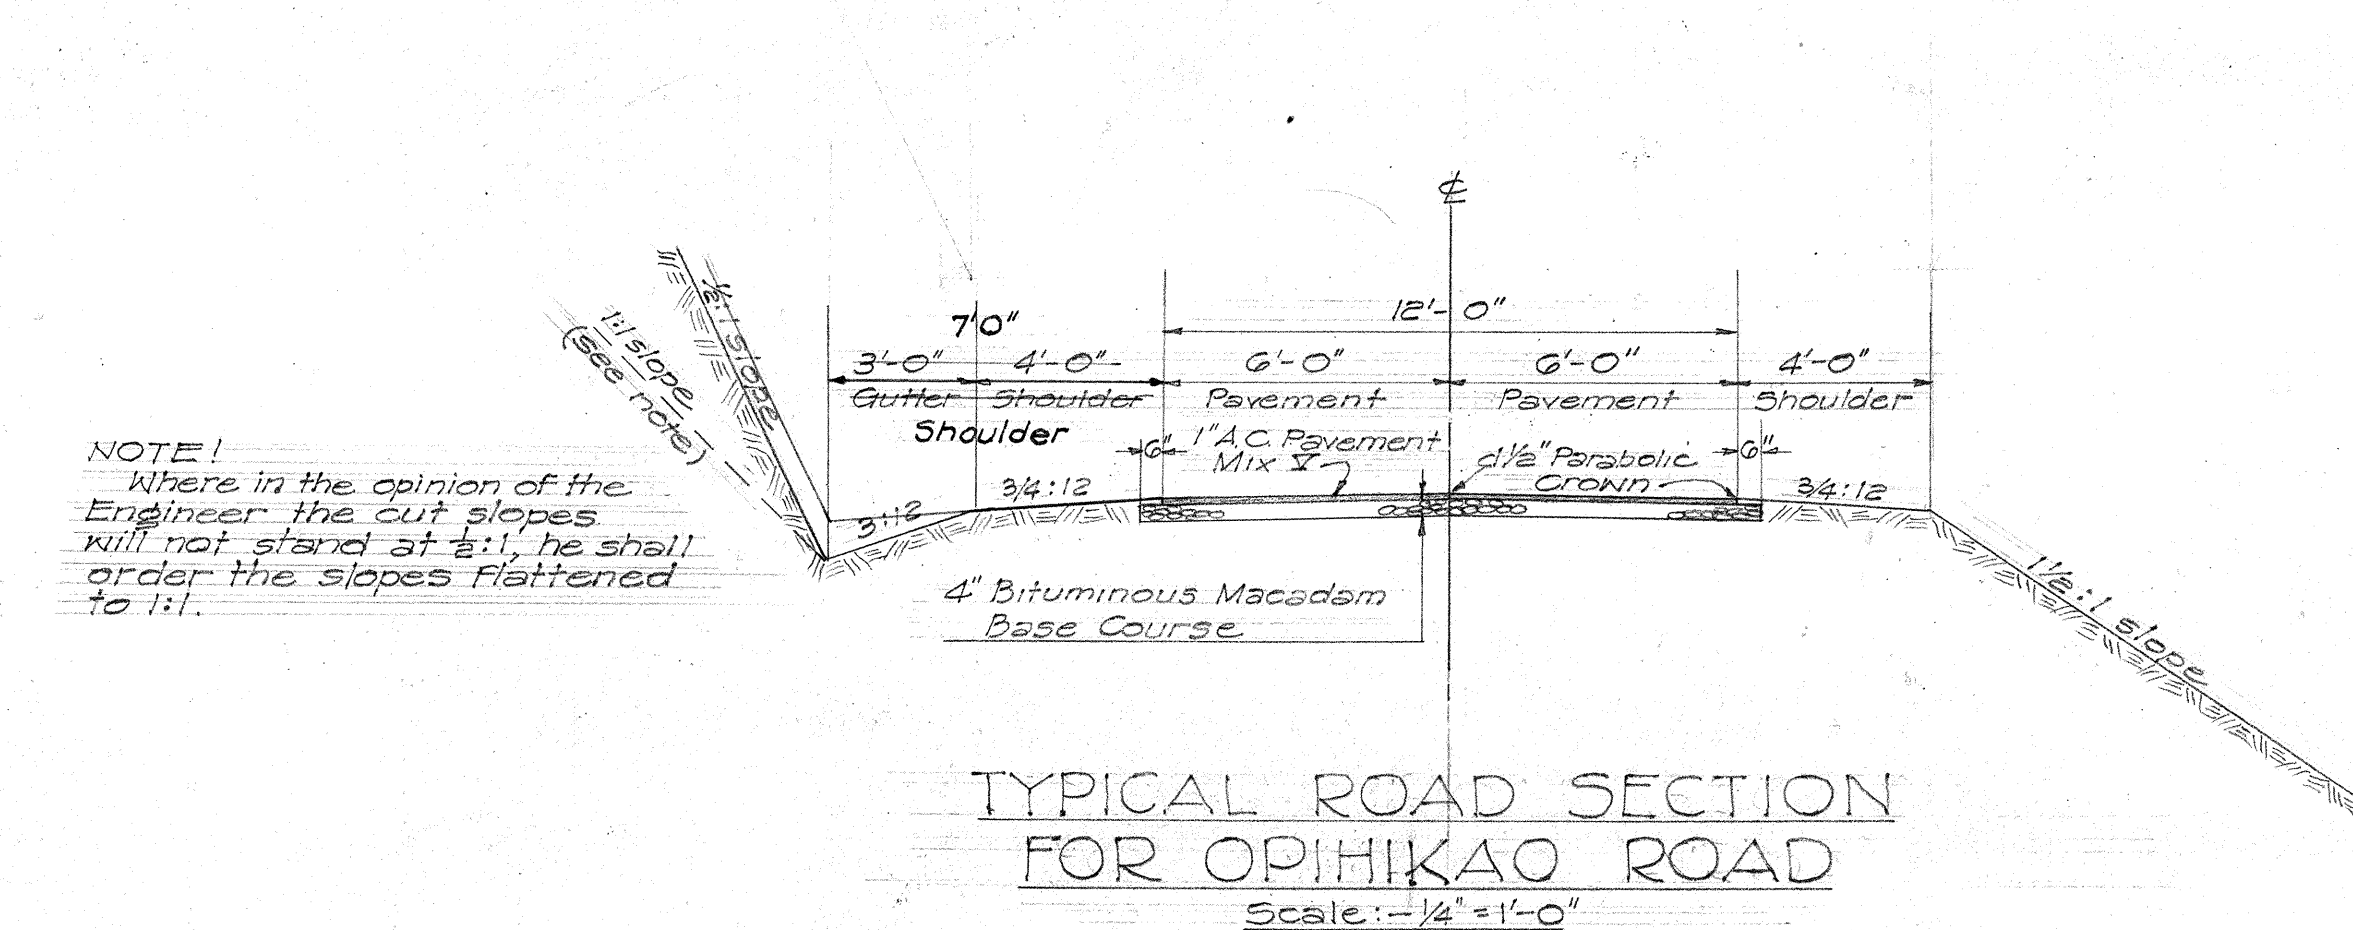

TERRITORIAL HIGHWAY DEPARTMENT
TERRITORY OF HAWAII

TYPICAL ROAD SECTIONS
PAHOA-KALAPANA ROAD
PROJ. No. ER 4(1)
Scale as noted May, 1957

DATE
DESIGNED BY
CHECKED BY
NOTED BY
ORIGINAL PLAN
NOTE BOOK
No.