


FINAL SURVEY	NO. _____	NOTE BOOK	SURVEYED PLOTTED	BY _____	DATE _____	
						REMARKS
						PLANNED
						AREAS CHECKED

ORIGINAL SURVEY	NO. _____	NOTE BOOK	SURVEYED PLOTTED	BY _____	DATE _____	
						REMARKS
						PLANNED
						AREAS CHECKED

FED. ROAD DIST. NO.	STATE	FED. AID PROJ. NO.	FISCAL YEAR	SHEET NO.	TOTAL SHEETS
HAWAII	HAW.	A-192-01-60	1960	5	10


April 7, 1960

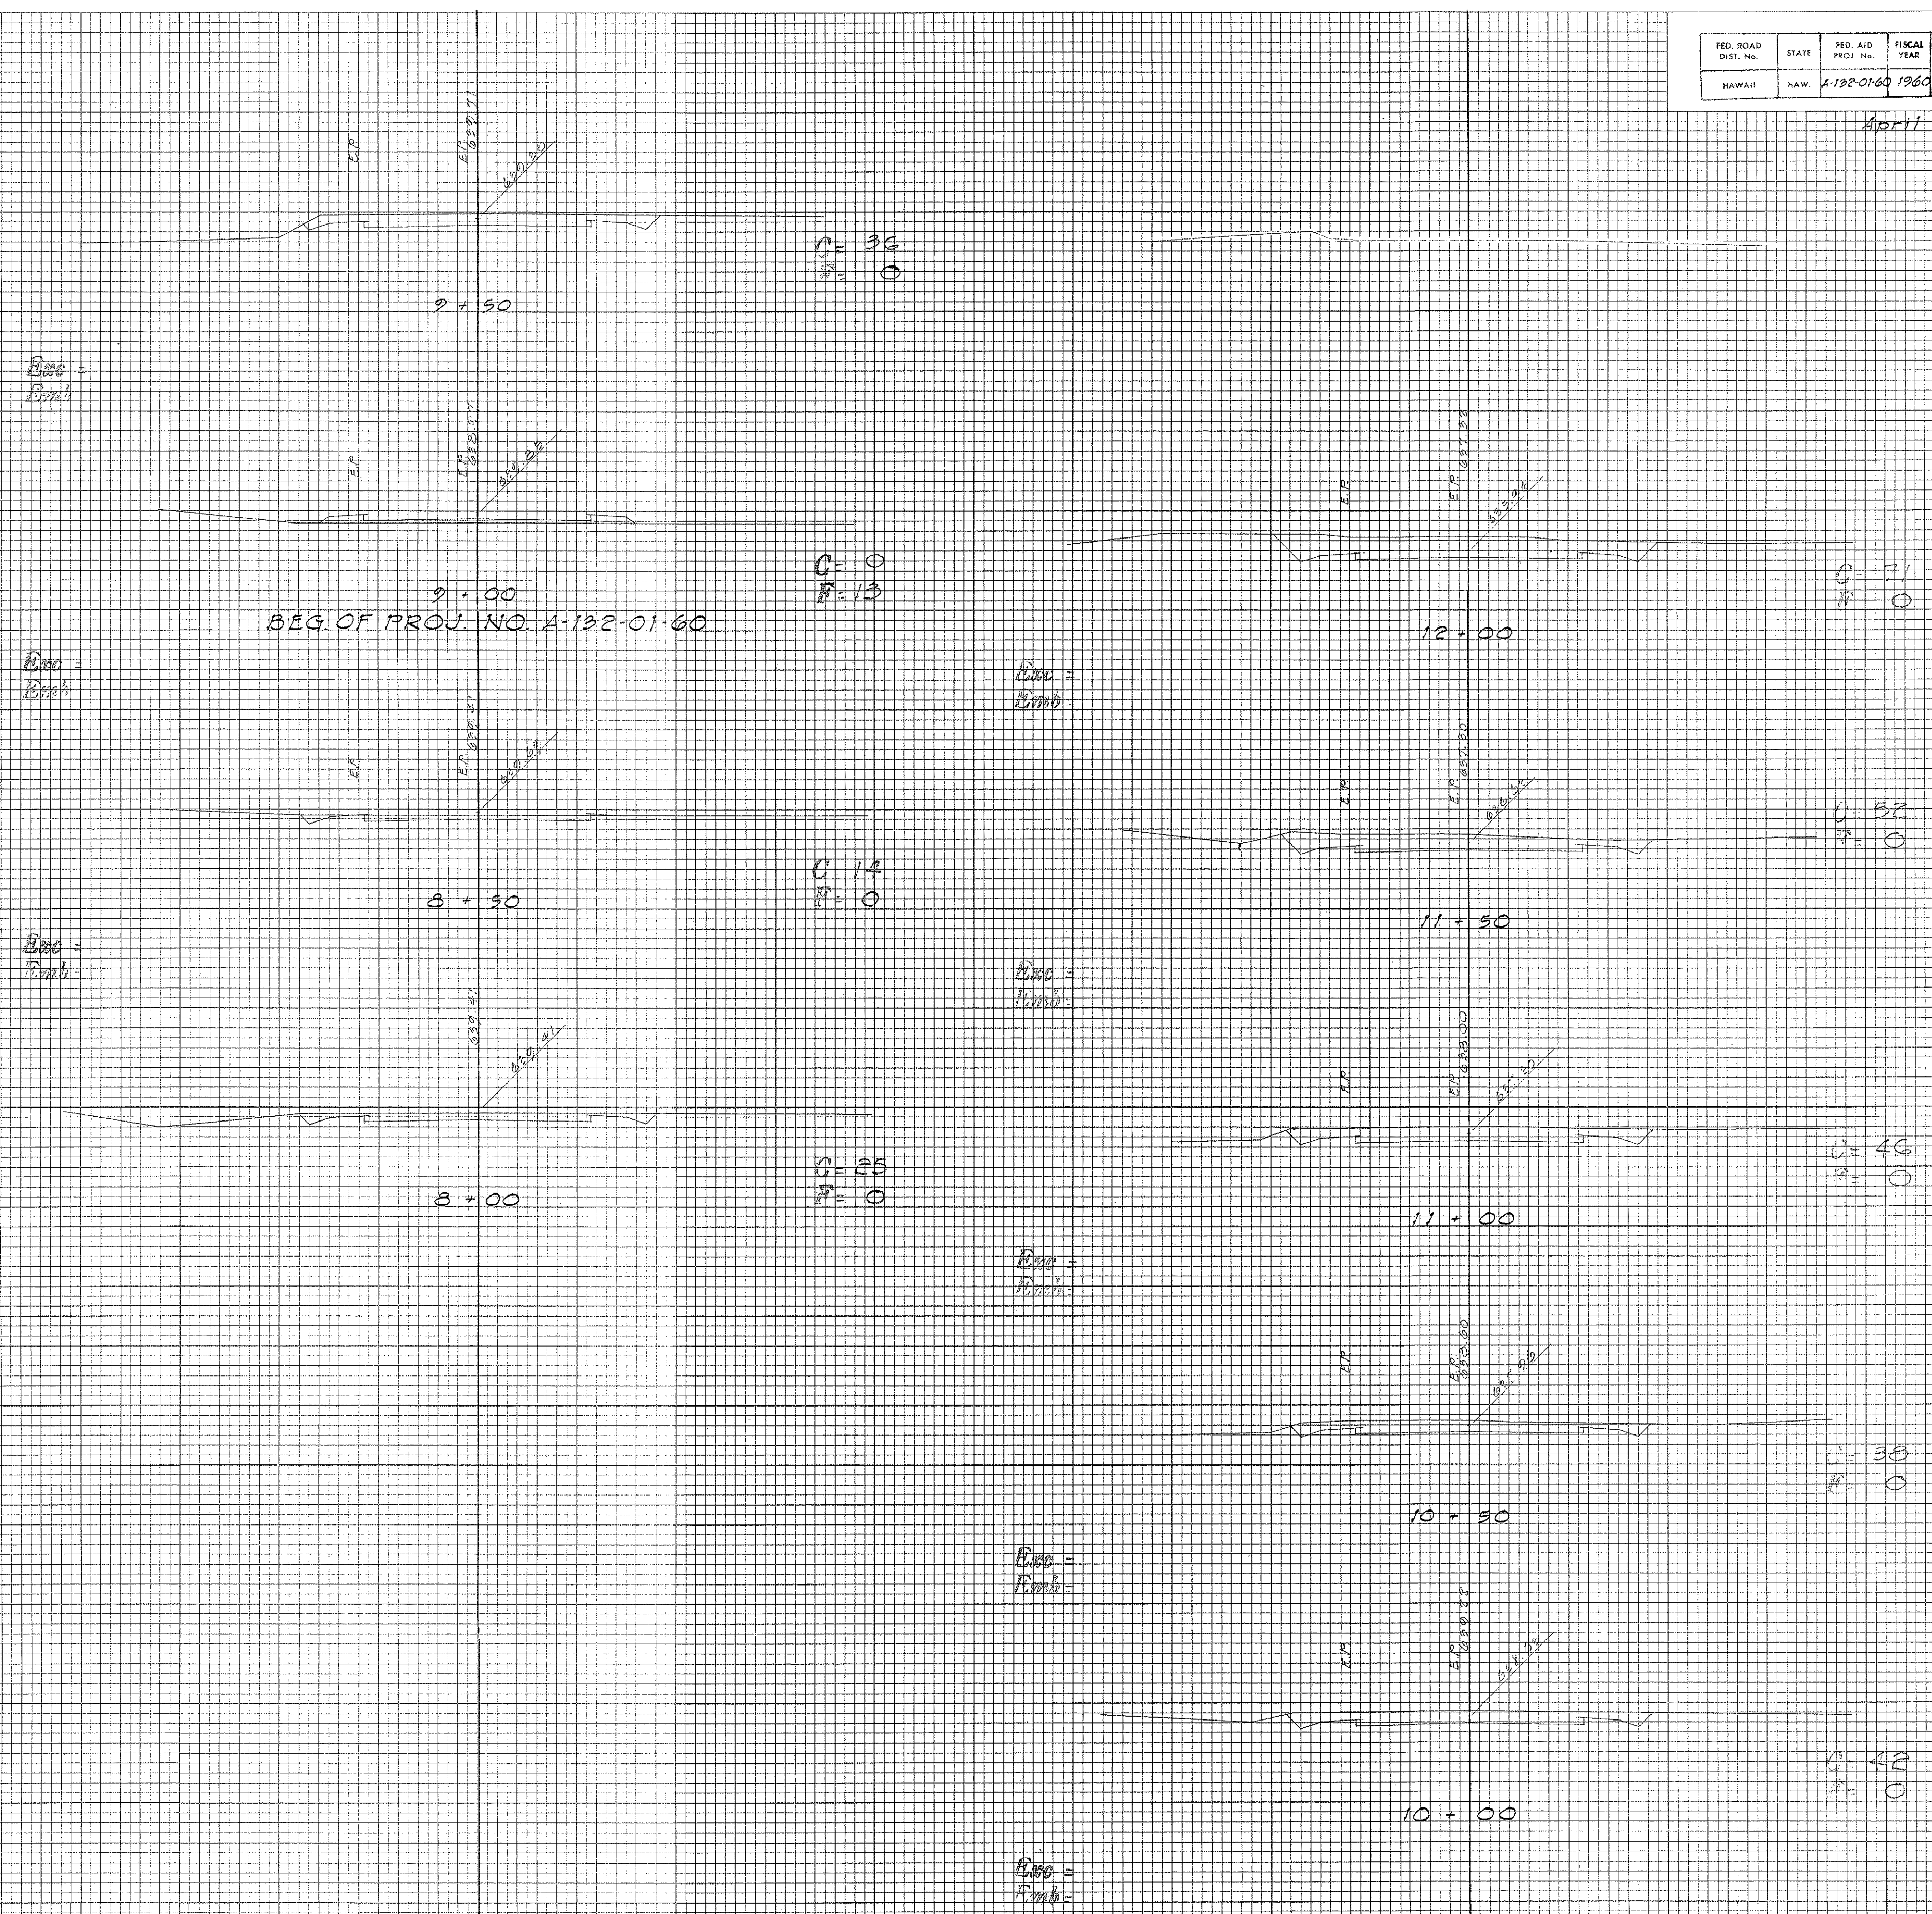

APR 17 1960


FINAL SURVEY
 SURVEYED
 PLOTTED
 NOTE BOOK
 AREAS
 CHECKED
 NO.

ORIGINAL SURVEY
 SURVEYED
 PLOTTED
 NOTE BOOK
 AREAS
 CHECKED
 NO.

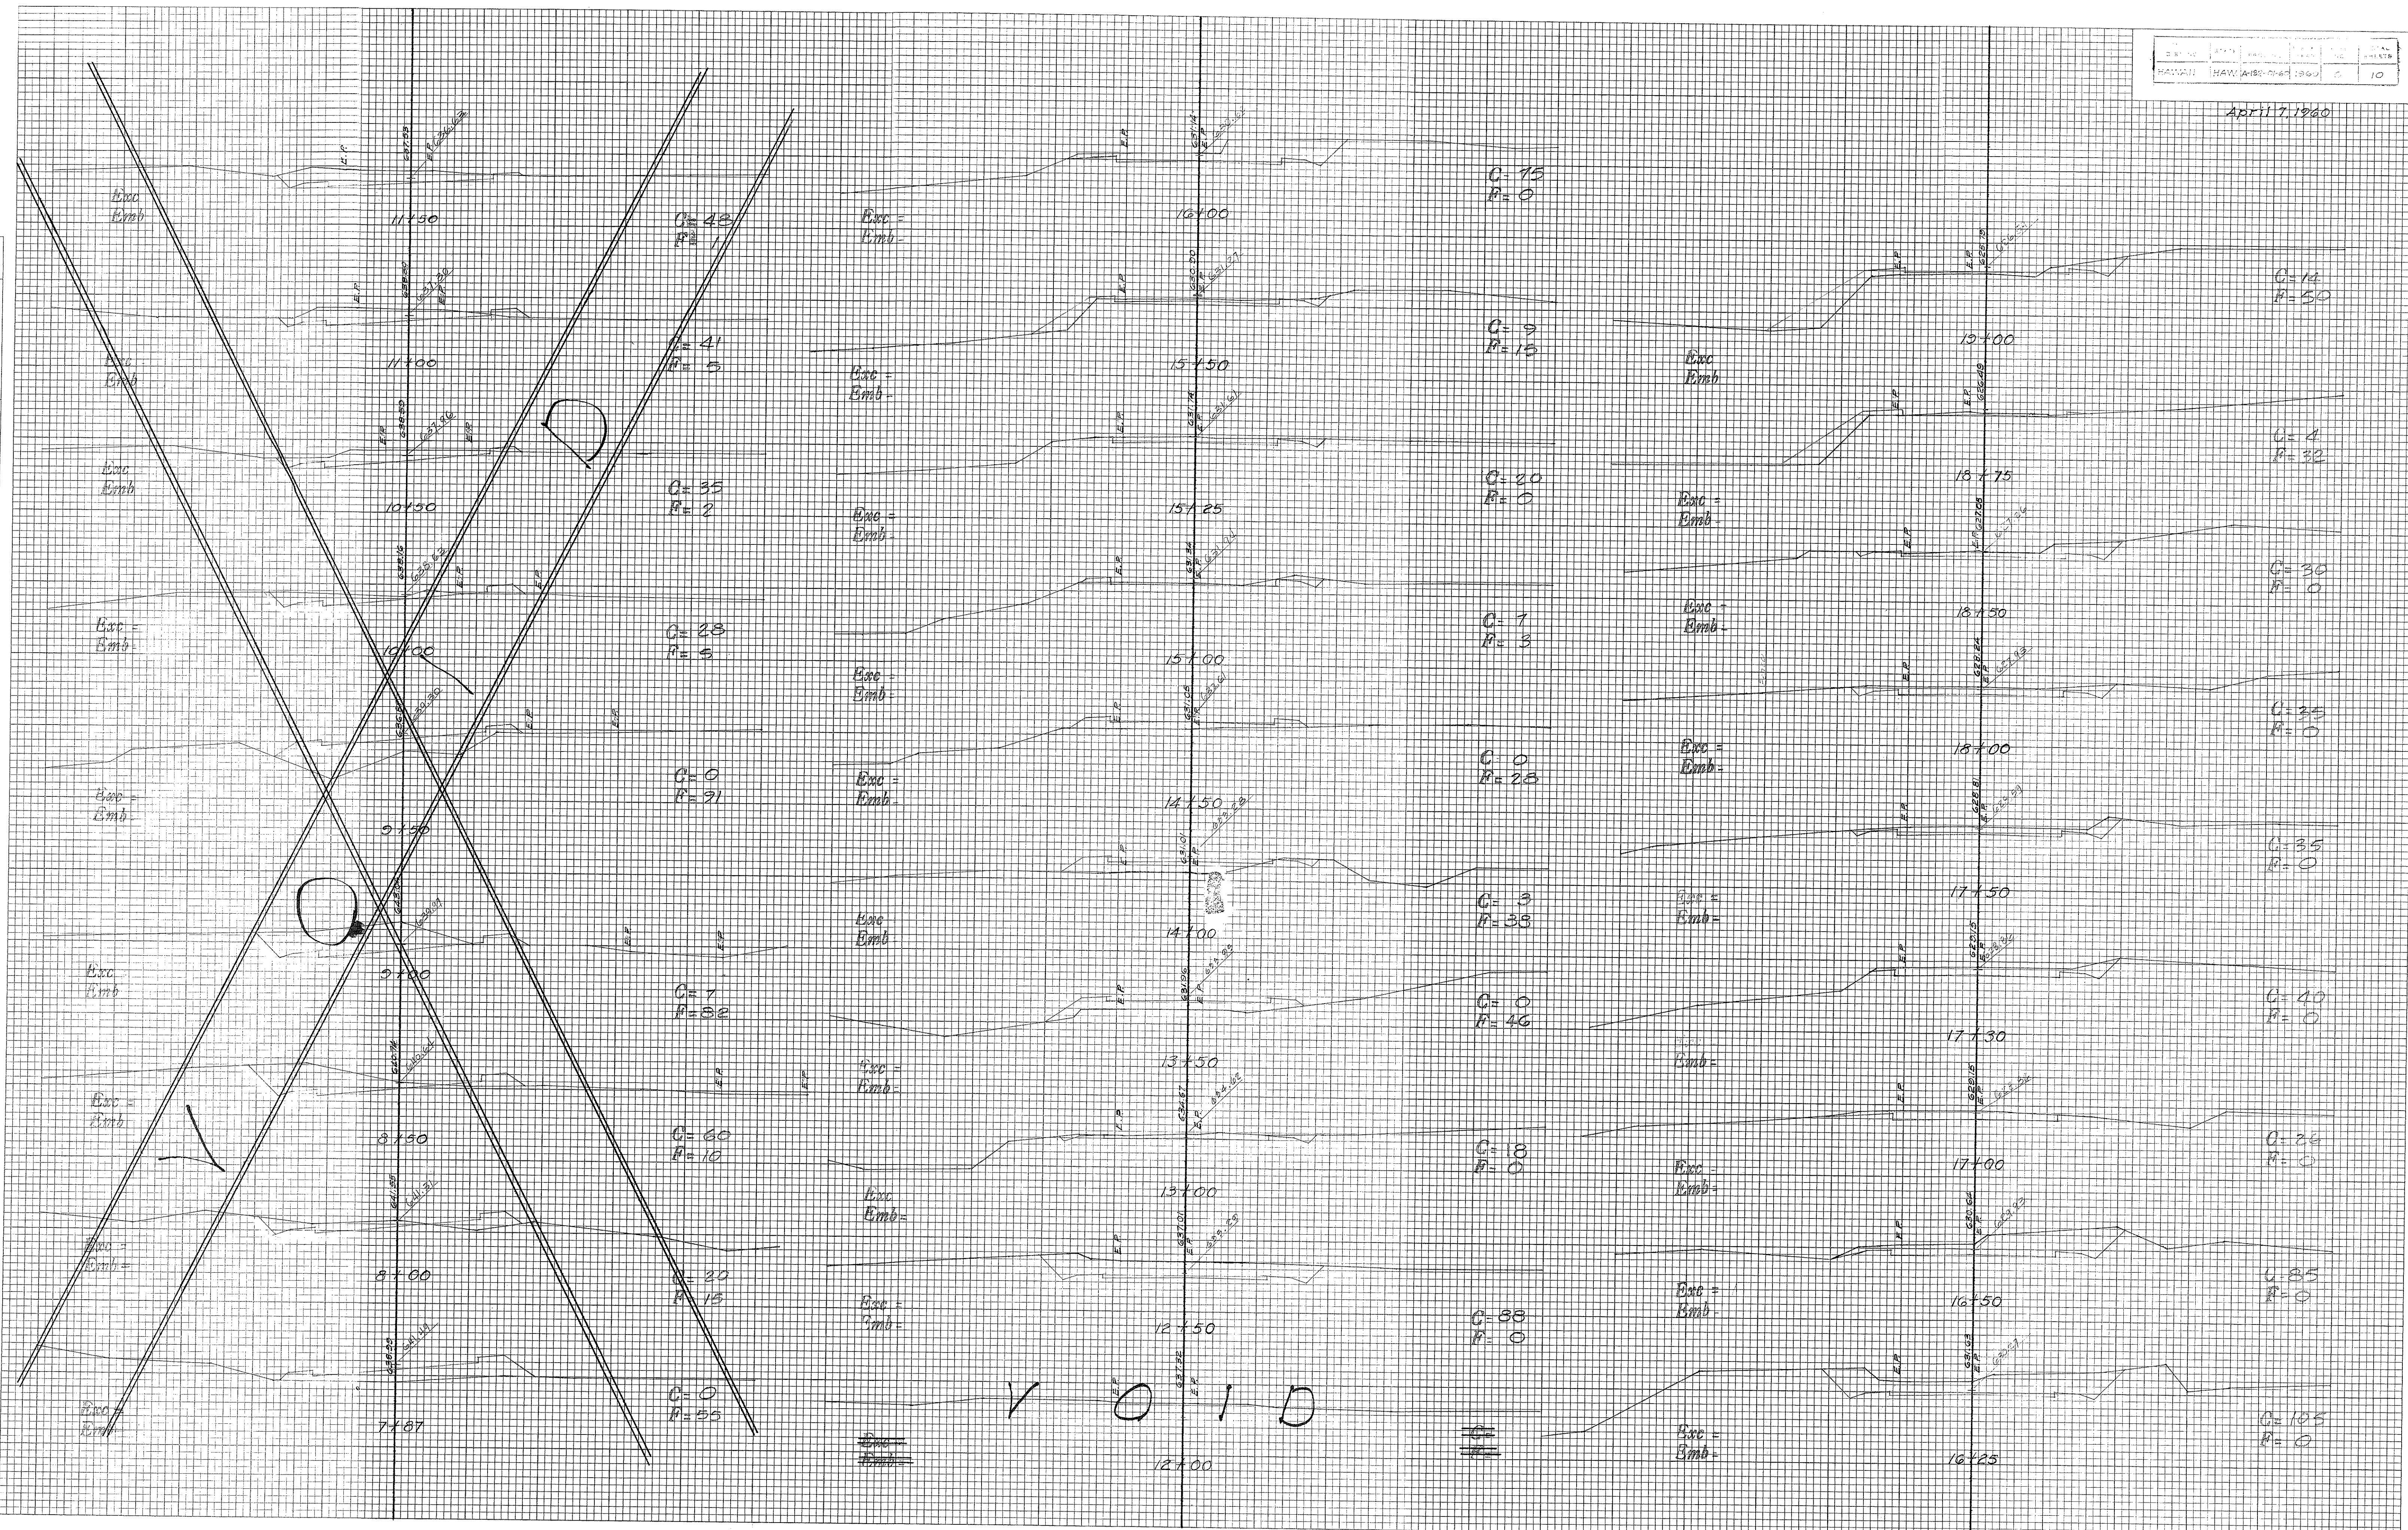

FINAL
SURVEY
NOTE BOOK
NO.


ORIGINAL
SURVEY
NOTE BOOK
NO.

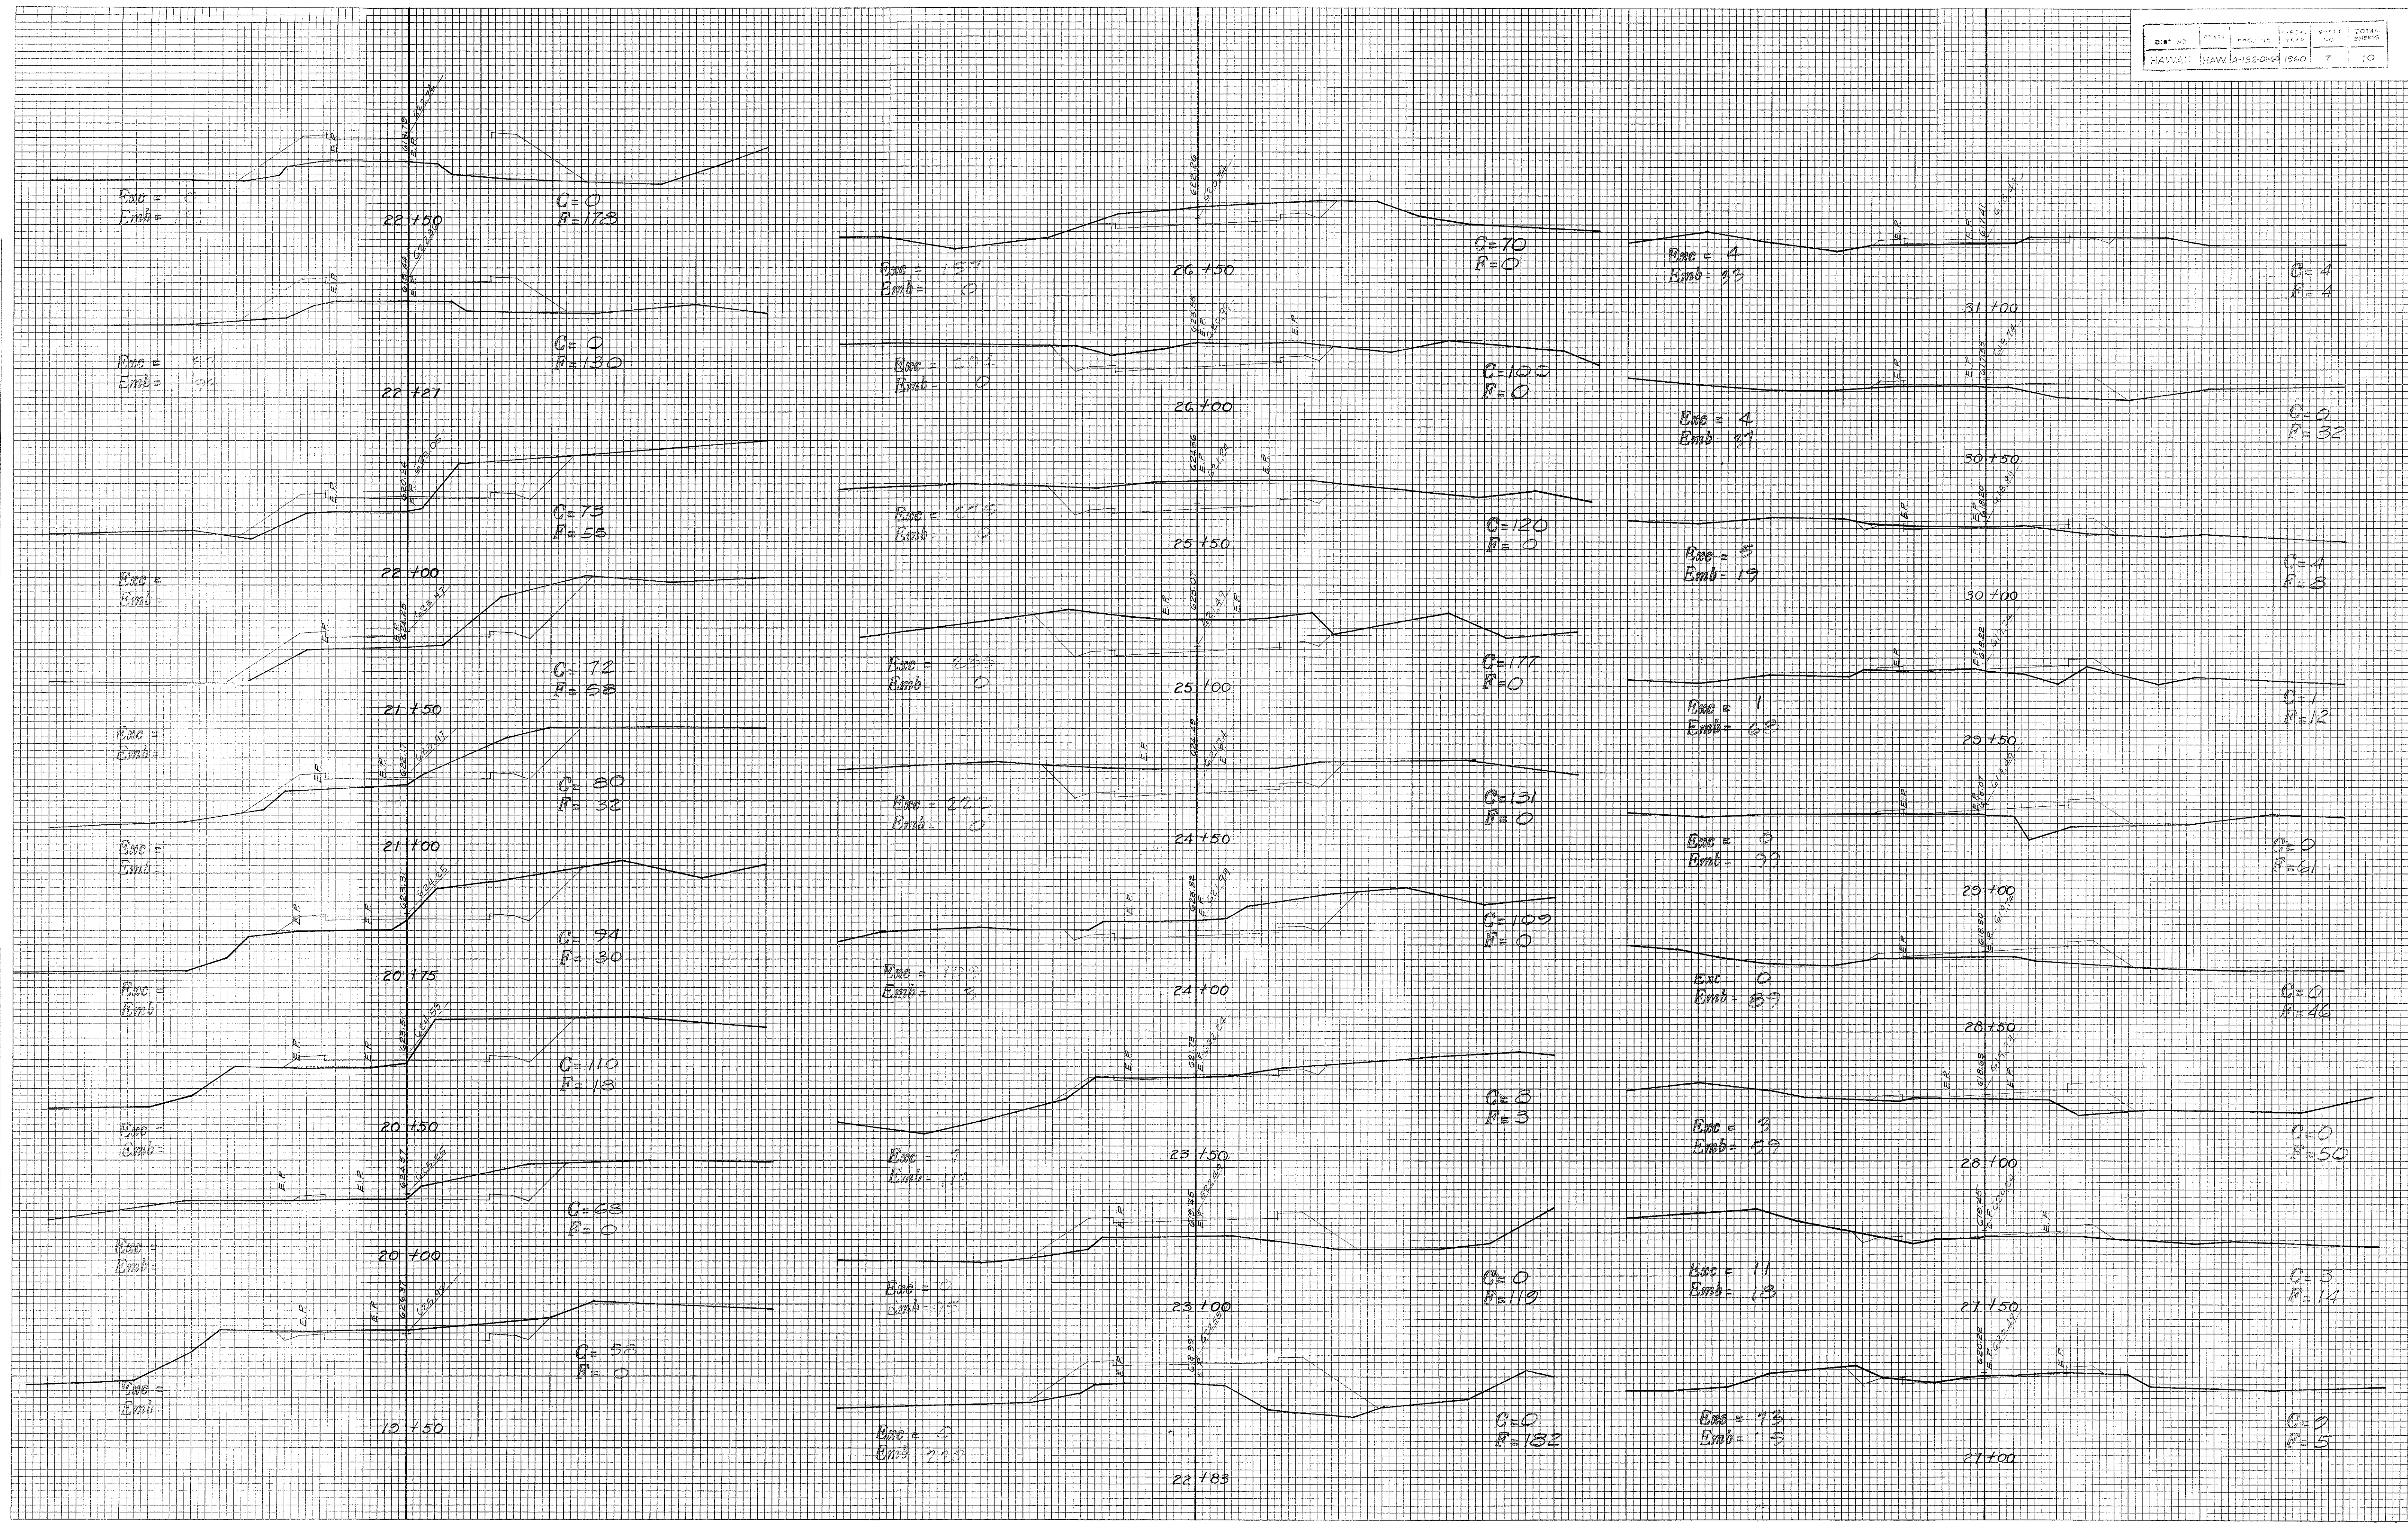

FINAL SURVEY	DATE	BY
	SURVEYED	PLOTTED
	NOTED	AREAS
	CHECKED	CHECKED
	NO.	NO.

ORIGINAL SURVEY	DATE	BY
	SURVEYED	PLOTTED
	NOTED	AREAS
	CHECKED	CHECKED
	NO.	NO.

DATE	NO.	NO.	NO.	NO.	NO.
10/1/11	100	100	100	100	100

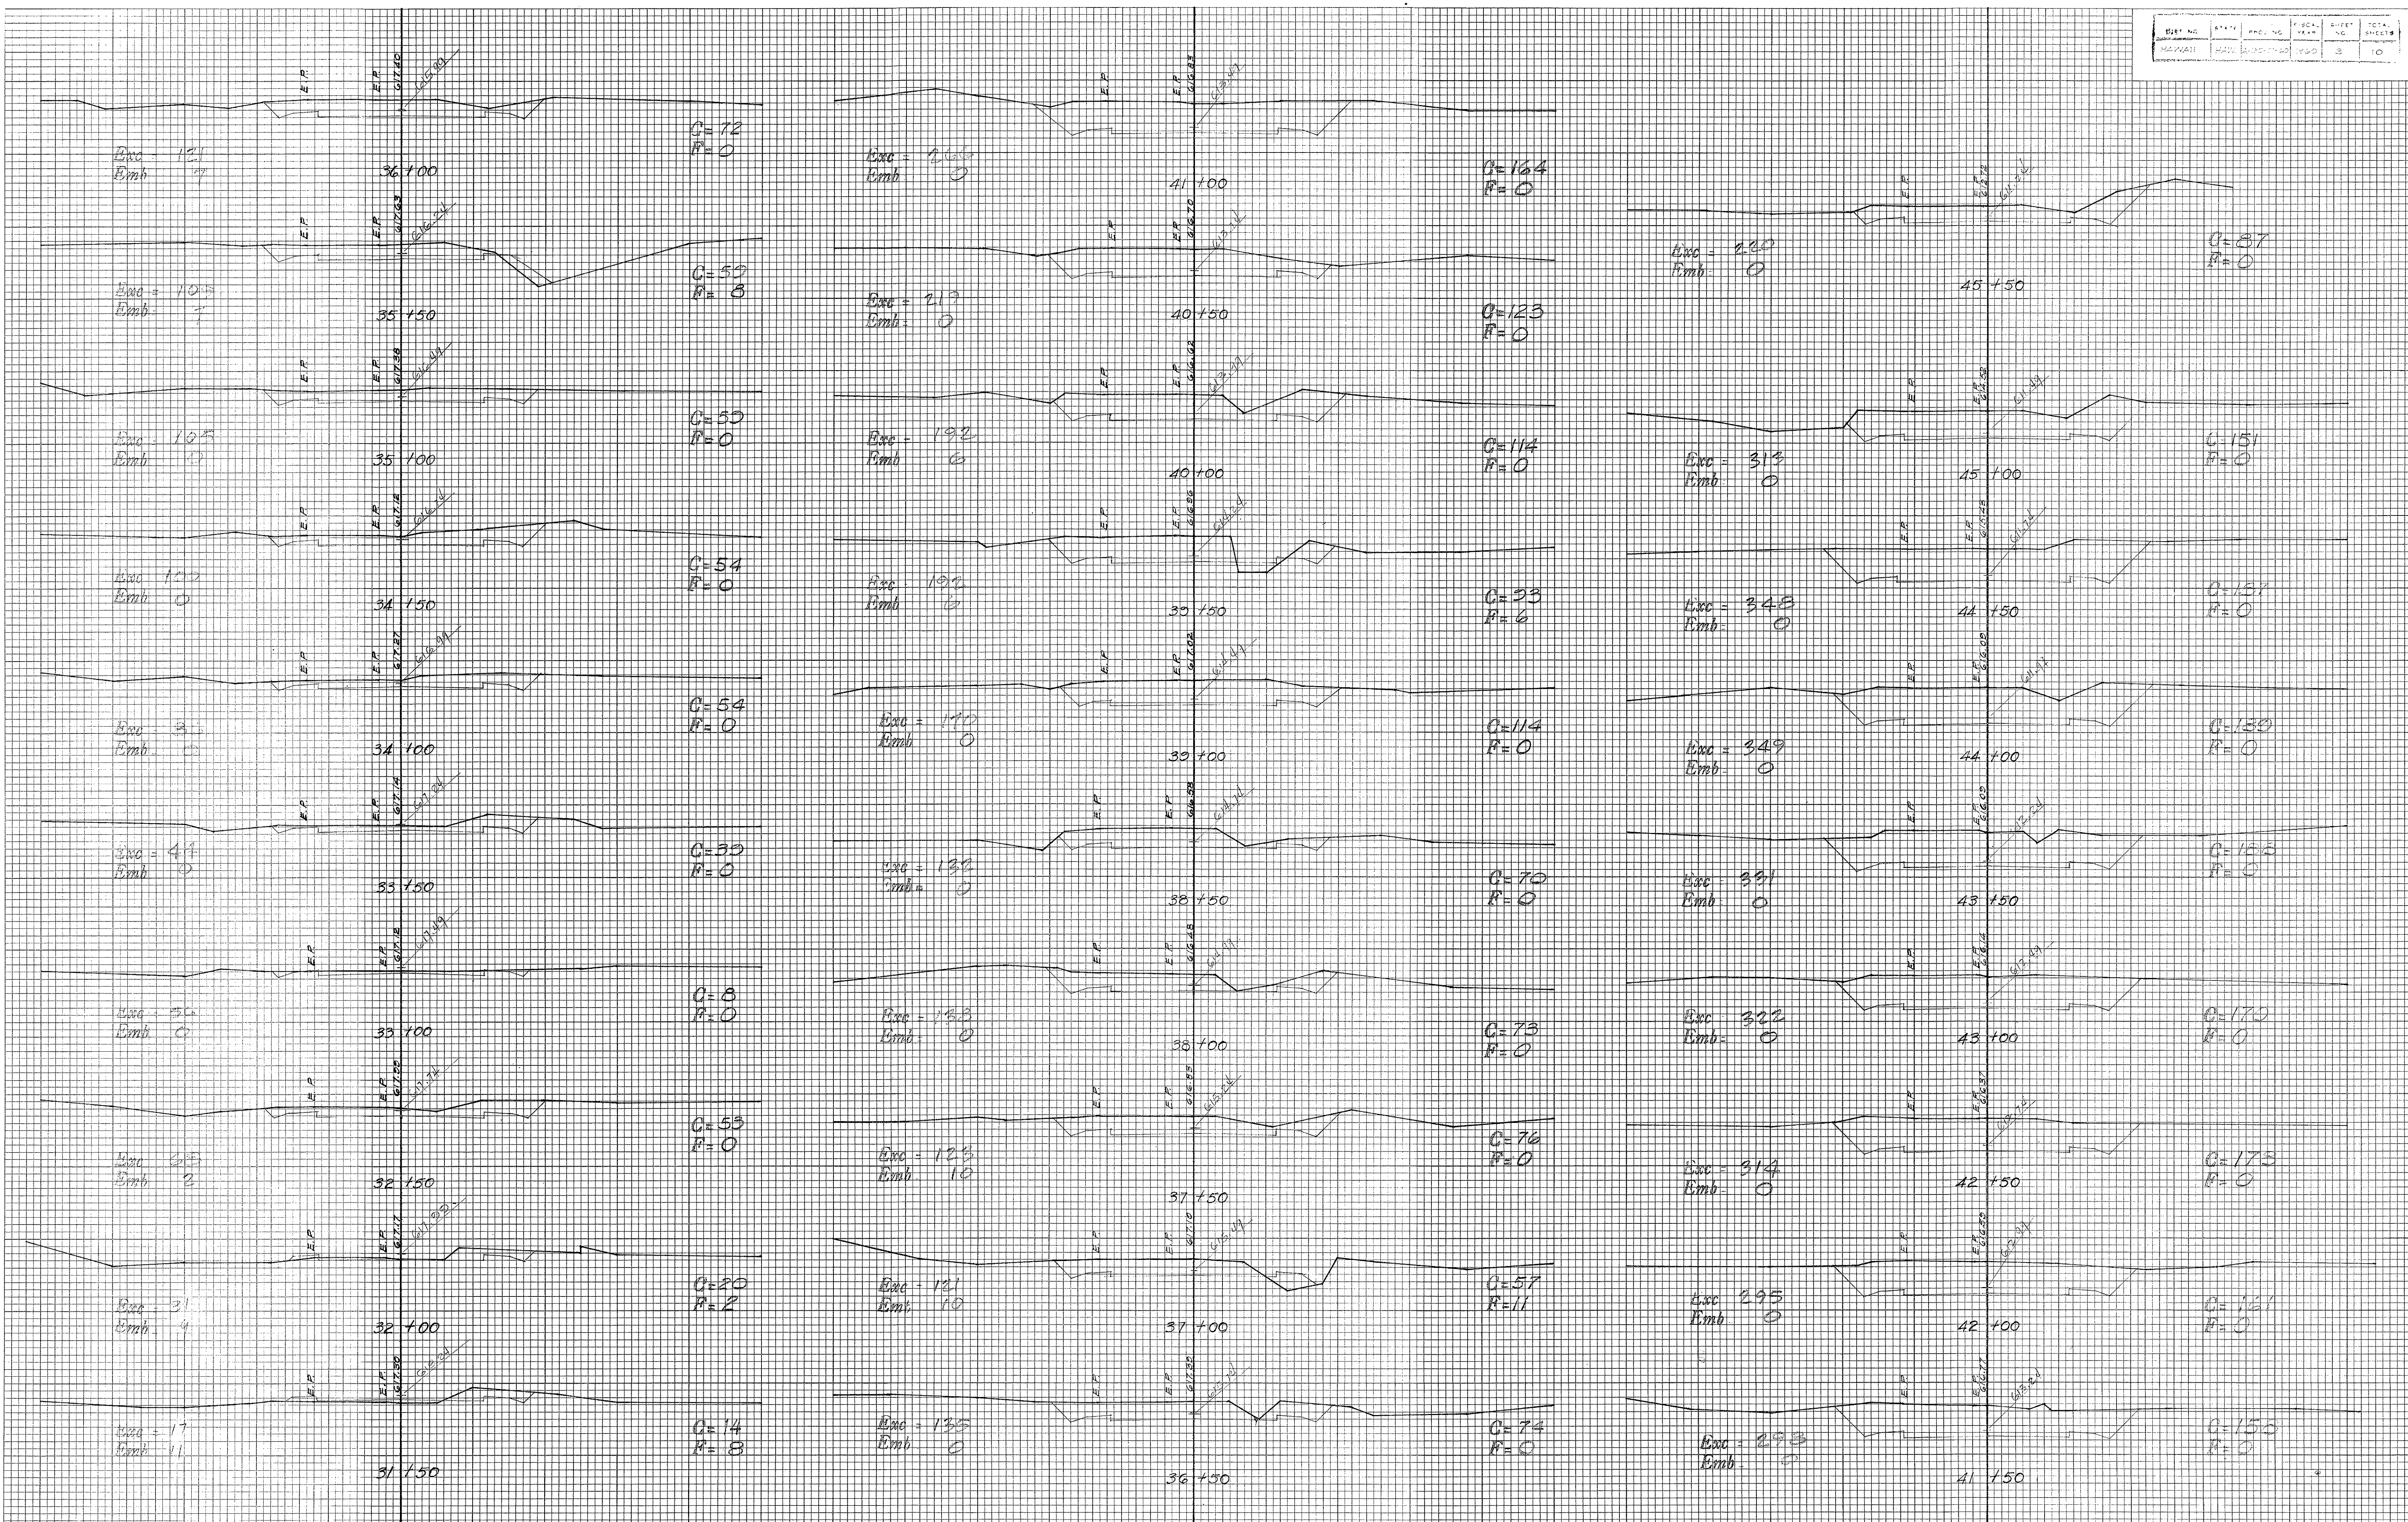

FINAL	DATE
SURVEY	BY
NOTE BOOK	NO.
AREAS	AREAS CHECKED

ORIGINAL	DATE
SURVEY	BY
NOTE BOOK	NO.
AREAS	AREAS CHECKED

DET. NO.	DATE	NO. OF	NO. OF	TOTAL
100	100	100	100	100

