

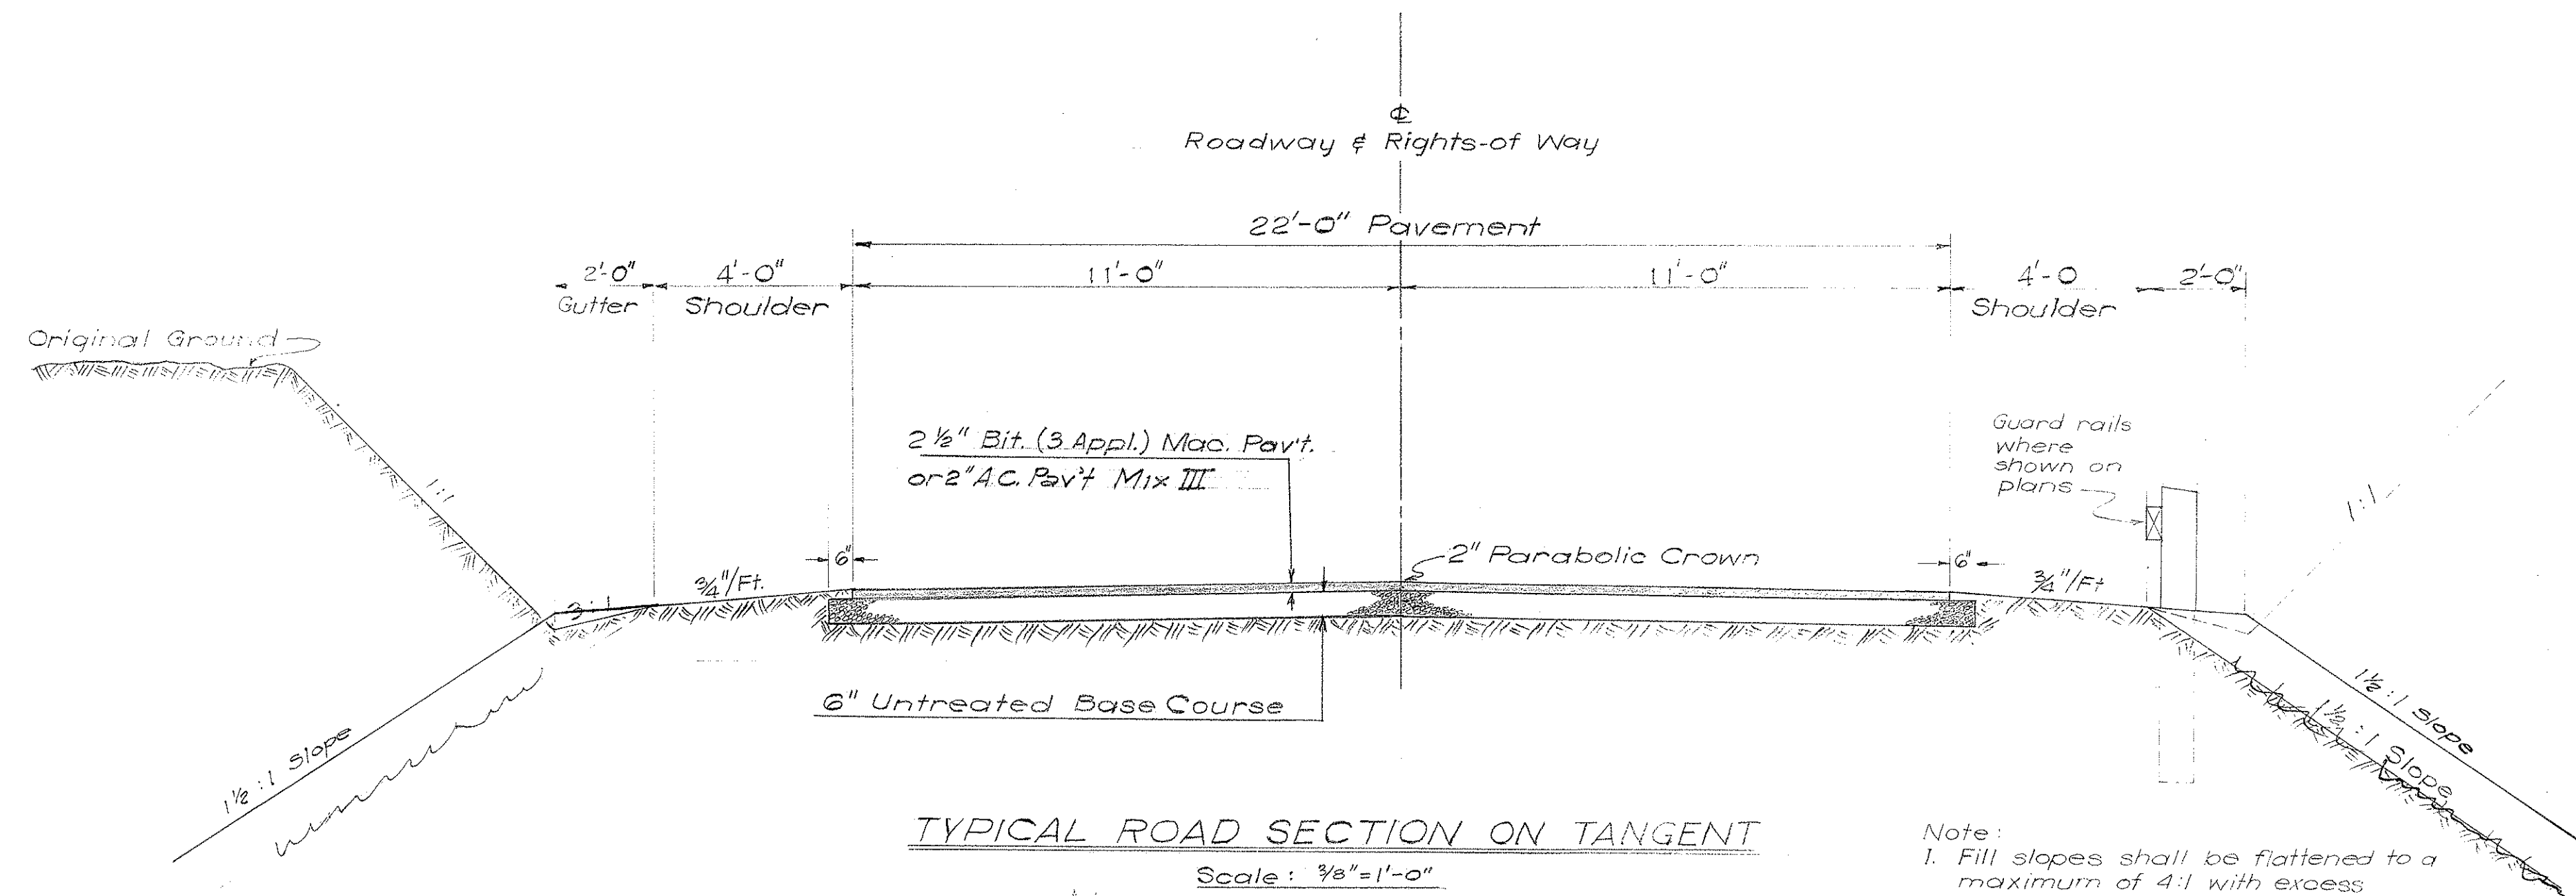
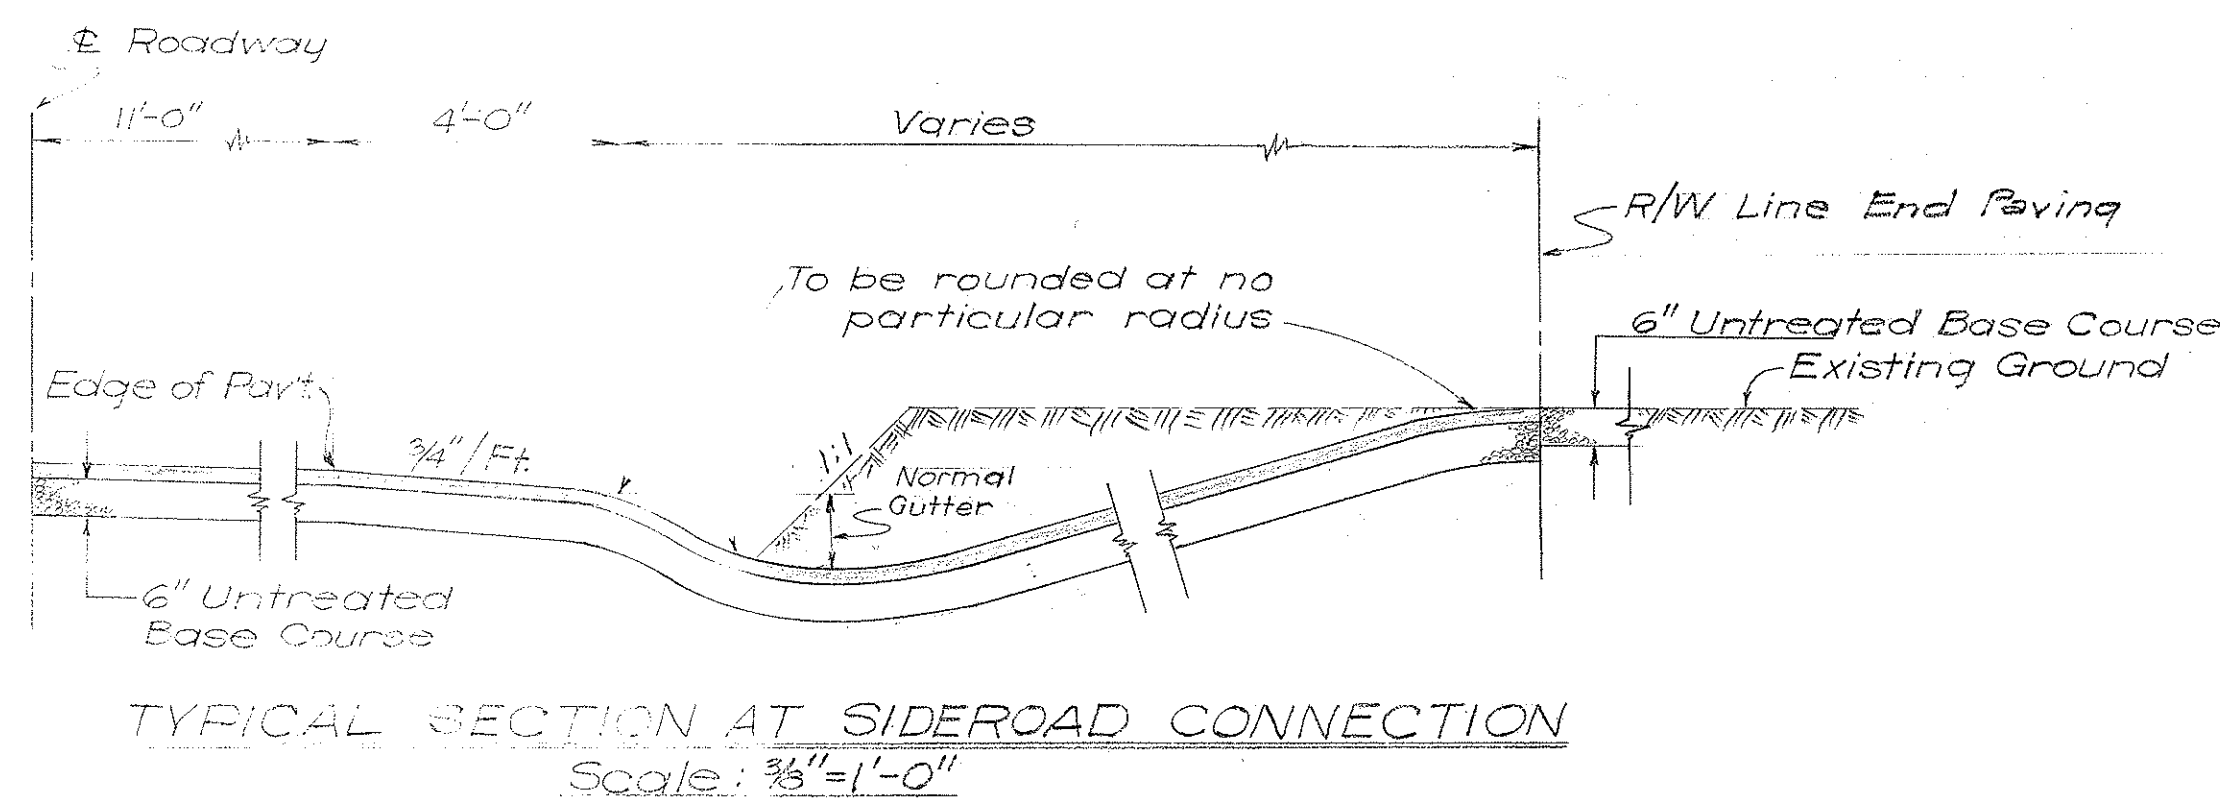


DIST. No.	STATE	PROJ. No.	FISCAL YEAR	SHEET No.	TOTAL SHEETS
HAWAII	HAW.	A-132-01-64	1960	2	10

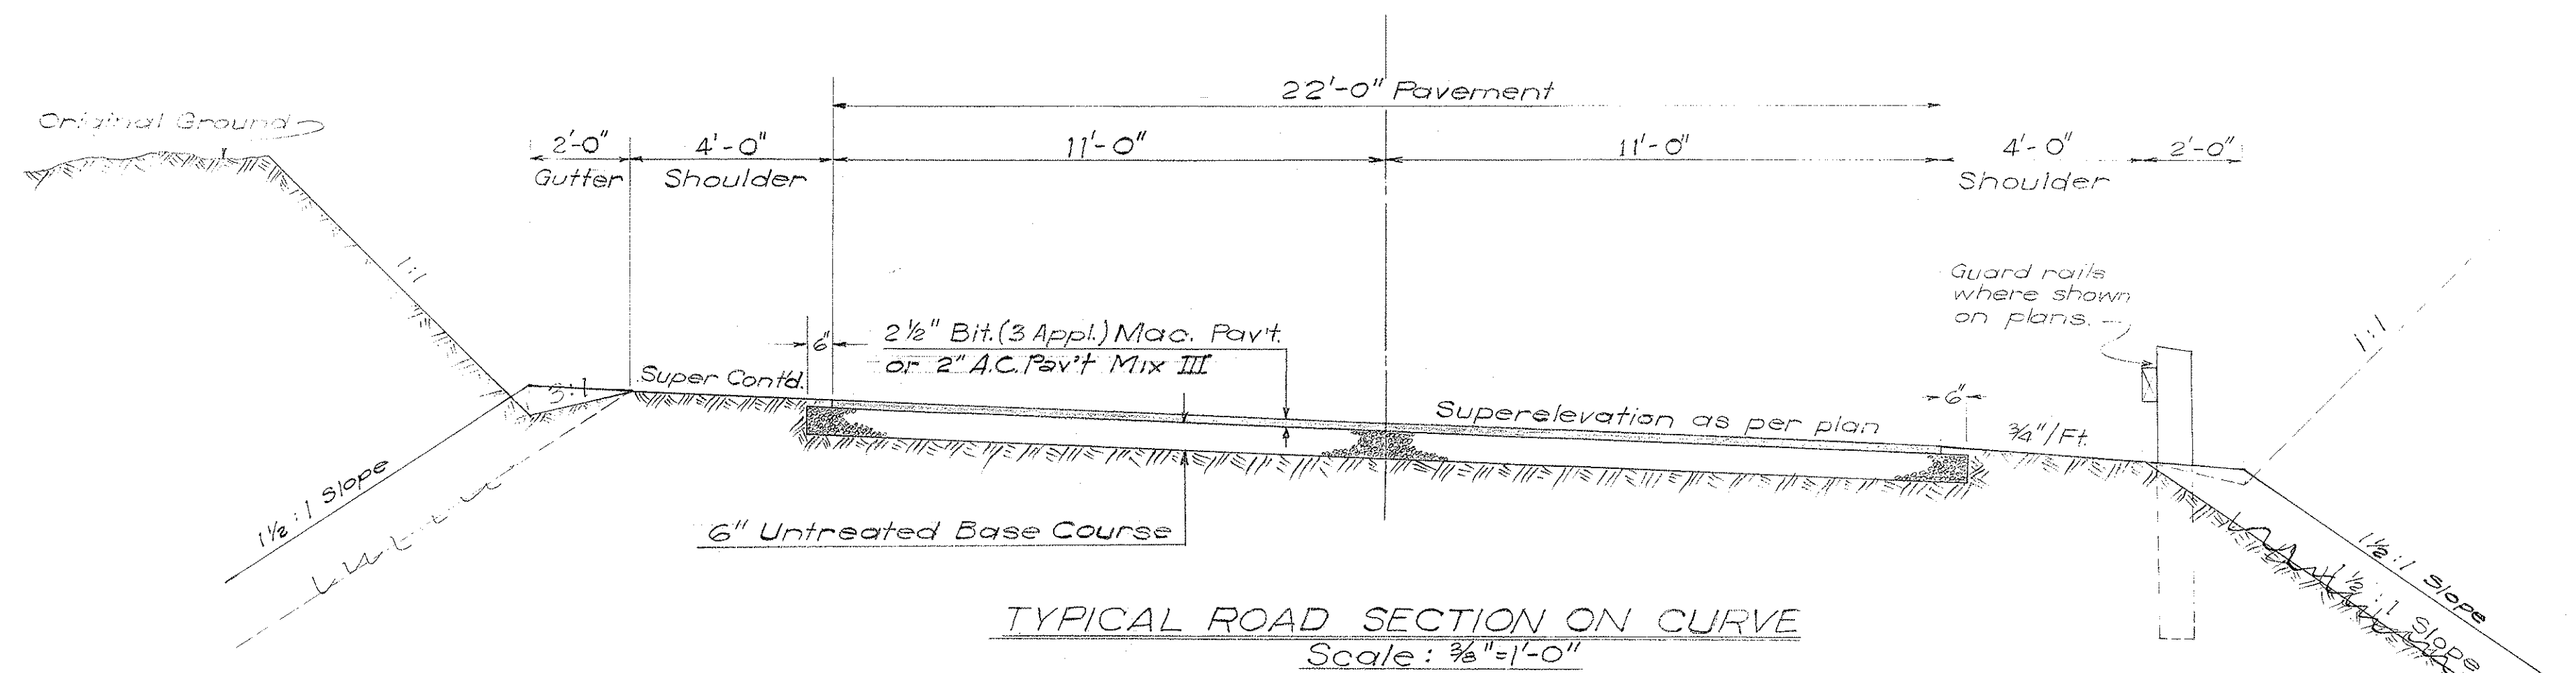

- Note:
1. Fill slopes shall be flattened to a maximum of 4:1 with excess material where ordered by the Engineer.
 2. Shoulders shall be widened 2 feet where guard rails are constructed.
 3. Type of pavement shall be determined prior to awarding of contract.

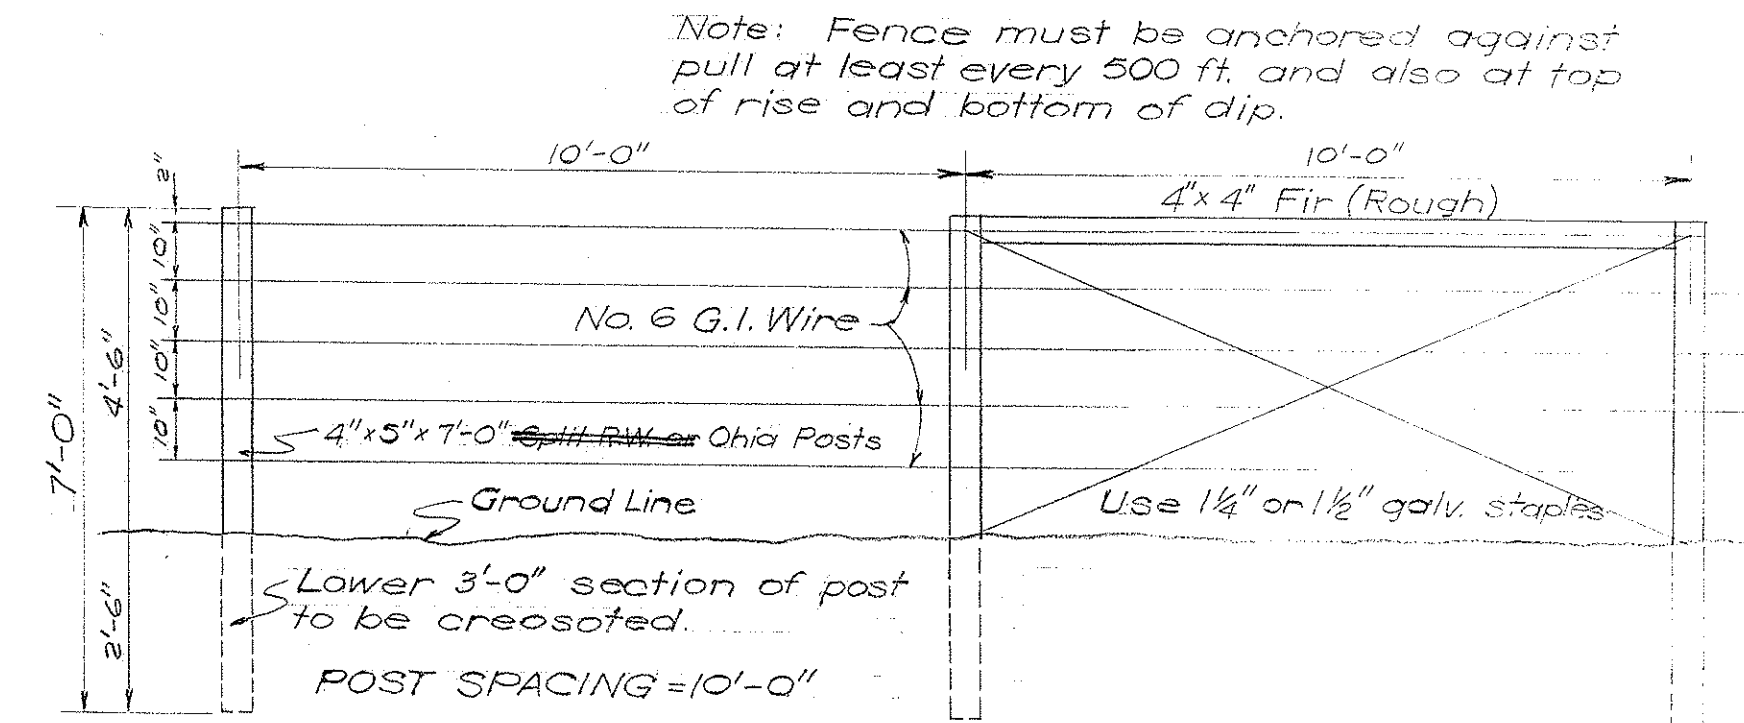

DEPARTMENT OF TRANSPORTATION
BUREAU OF HIGHWAYS
STATE OF HAWAII

TYPICAL SECTIONS AND
DETAILS FOR STD. WIRE FENCE

KAPOHU-PAHOA ROAD
PROJ. NO. A-132-01-60
Scale As Noted Feb. 1960

SHEET No. OF SHEETS

SURVEY PLOTTED BY	DATE
DRAWN BY	
TRACED BY	
QUANTITIES CHECKED BY	
NOTE BOOK	
No.	