


FINAL SURVEY	BY	DATE
SURVEYED PLOTTED NOTE BOOK AREAS CHECKED	BY	DATE

ORIGINAL SURVEY	BY	DATE
SURVEYED PLOTTED NOTE BOOK AREAS CHECKED	BY	DATE


FED. ROAD DIST. No.	STATE	FED. AID PROJ. No.	FISCAL YEAR	SHEET No.	TOTAL SHEETS
HAWAII	HAW.	S-01500	1964	9	16

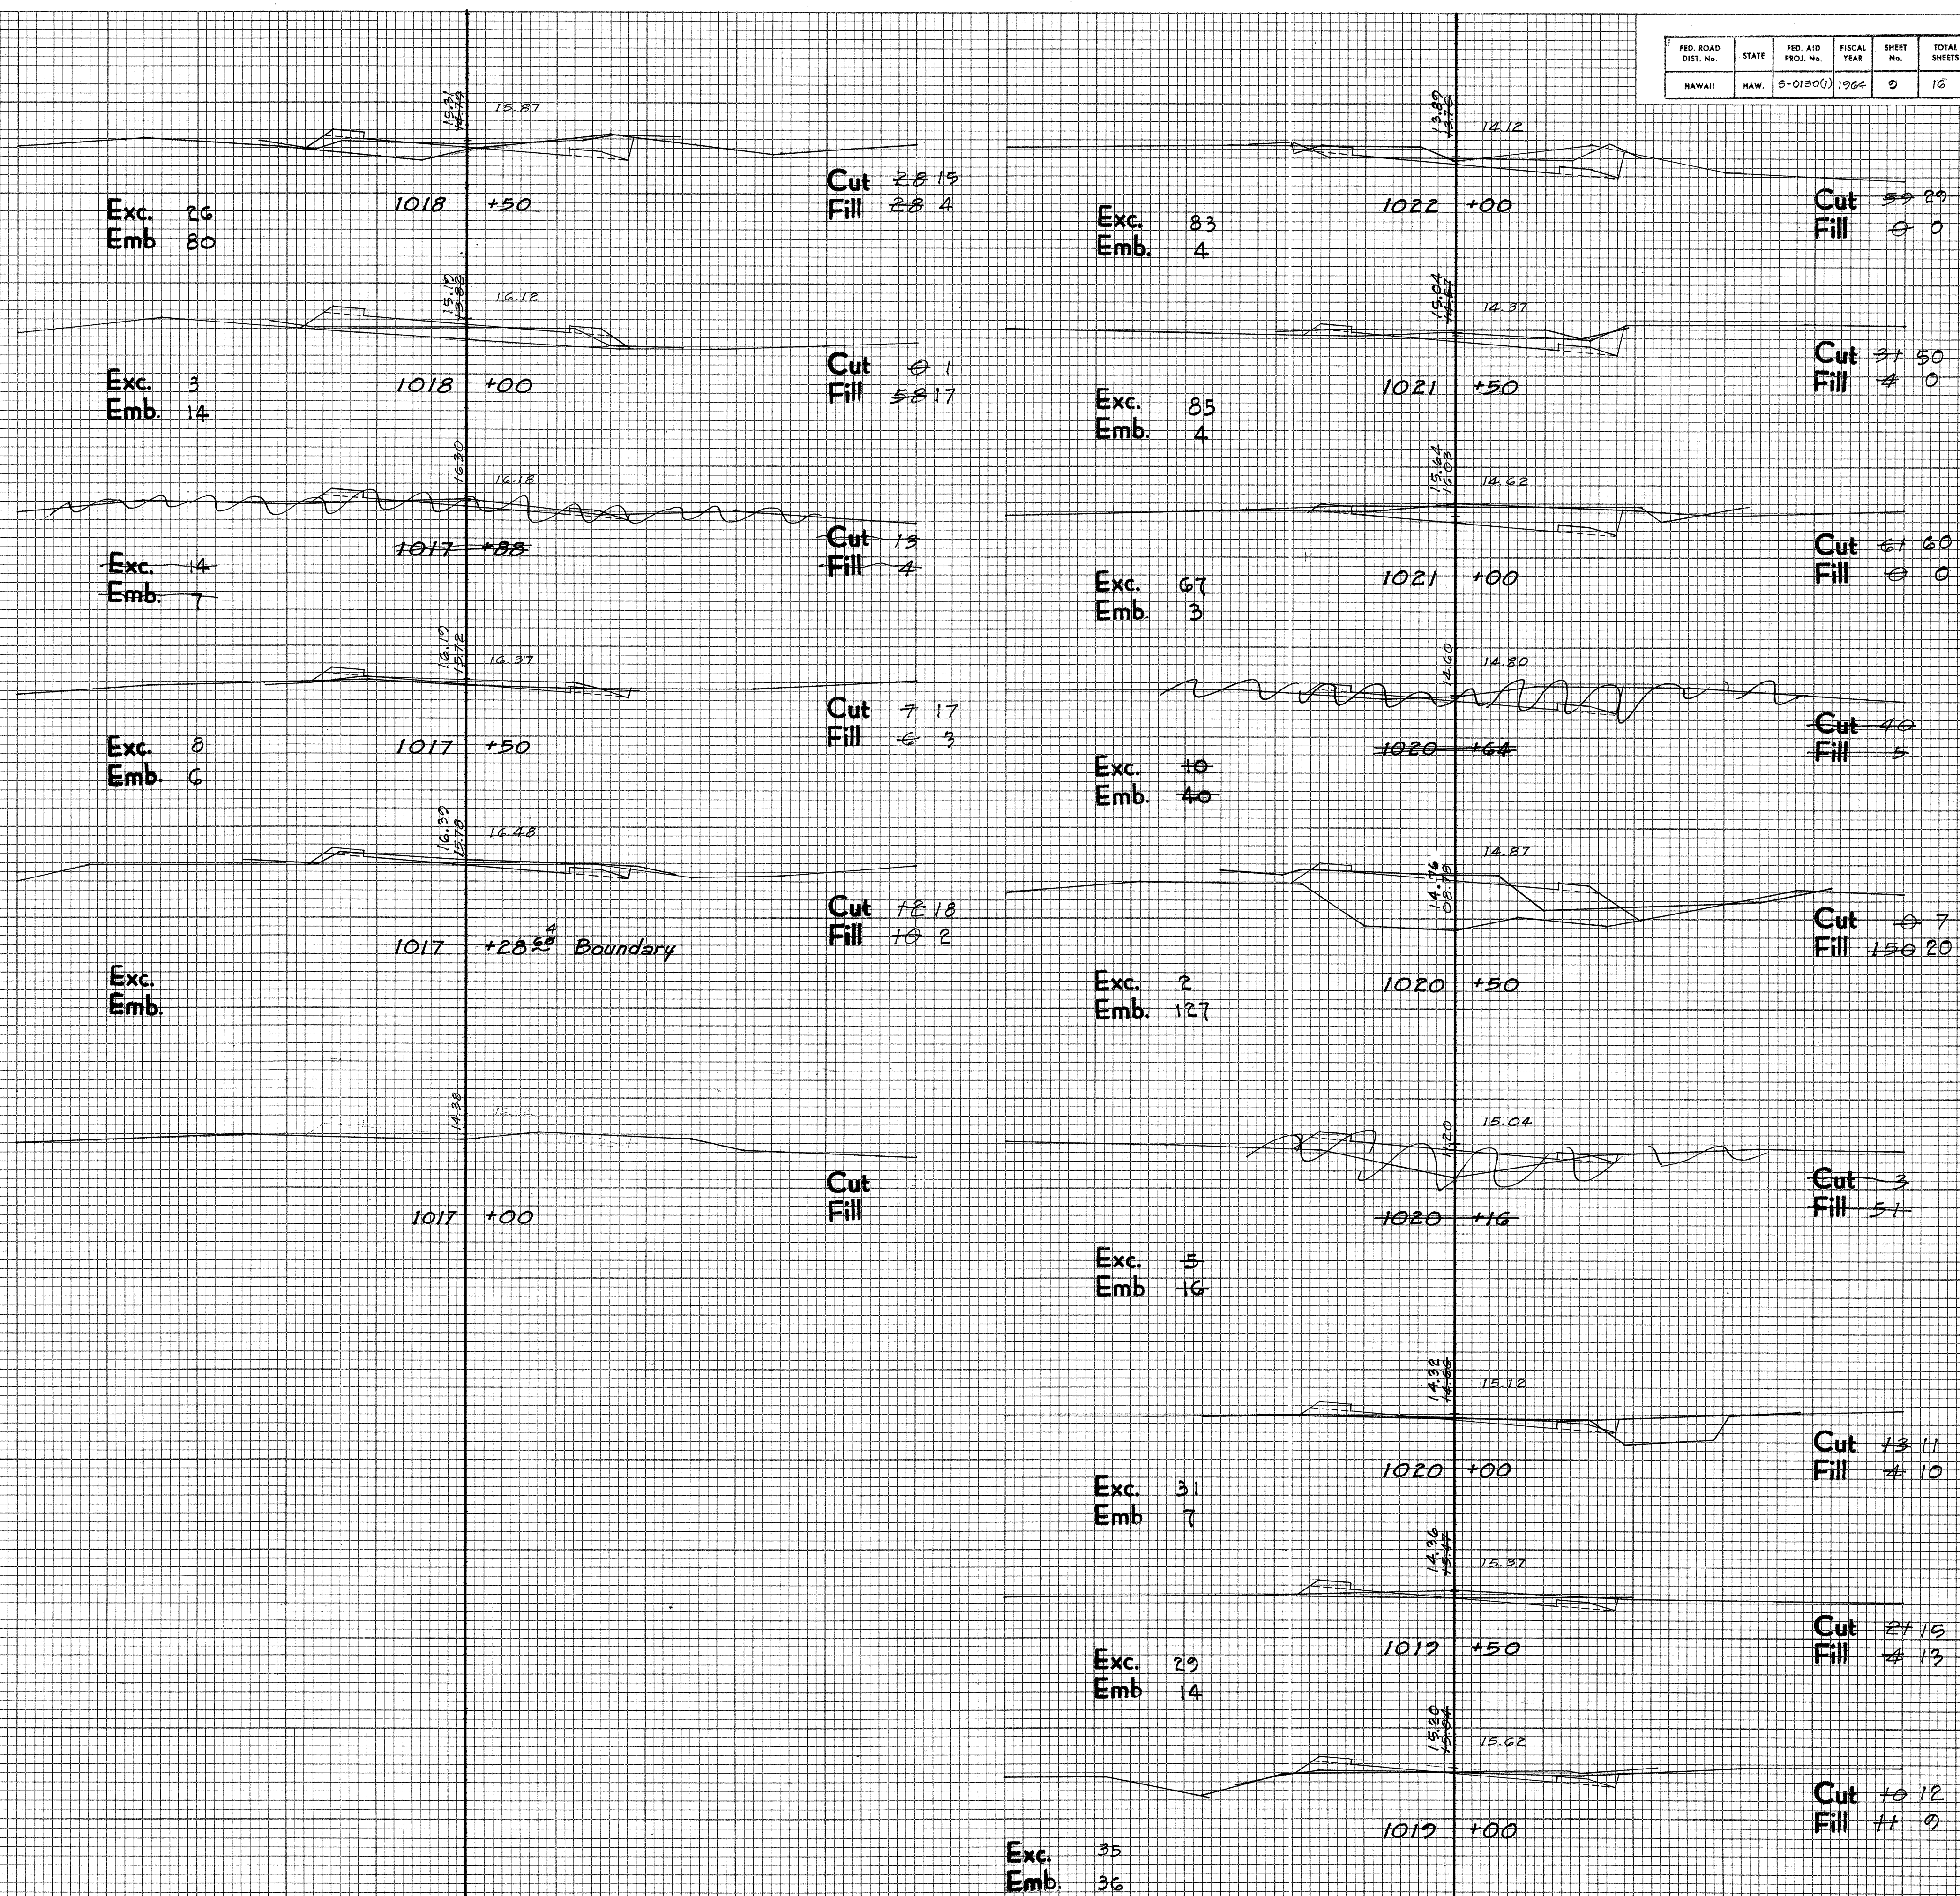

FED. ROAD DIST. No.	STATE	FED. AID PROJ. No.	FISCAL YEAR	SHEET No.	TOTAL SHEETS
HAWAII	HAW.	5-0130(1)	1964	10	16




DATE	BY	REVIEWED	DATE

DATE	BY	REVIEWED	DATE
3-15-61	S. KAWAHAU	W. K.	4-6-61

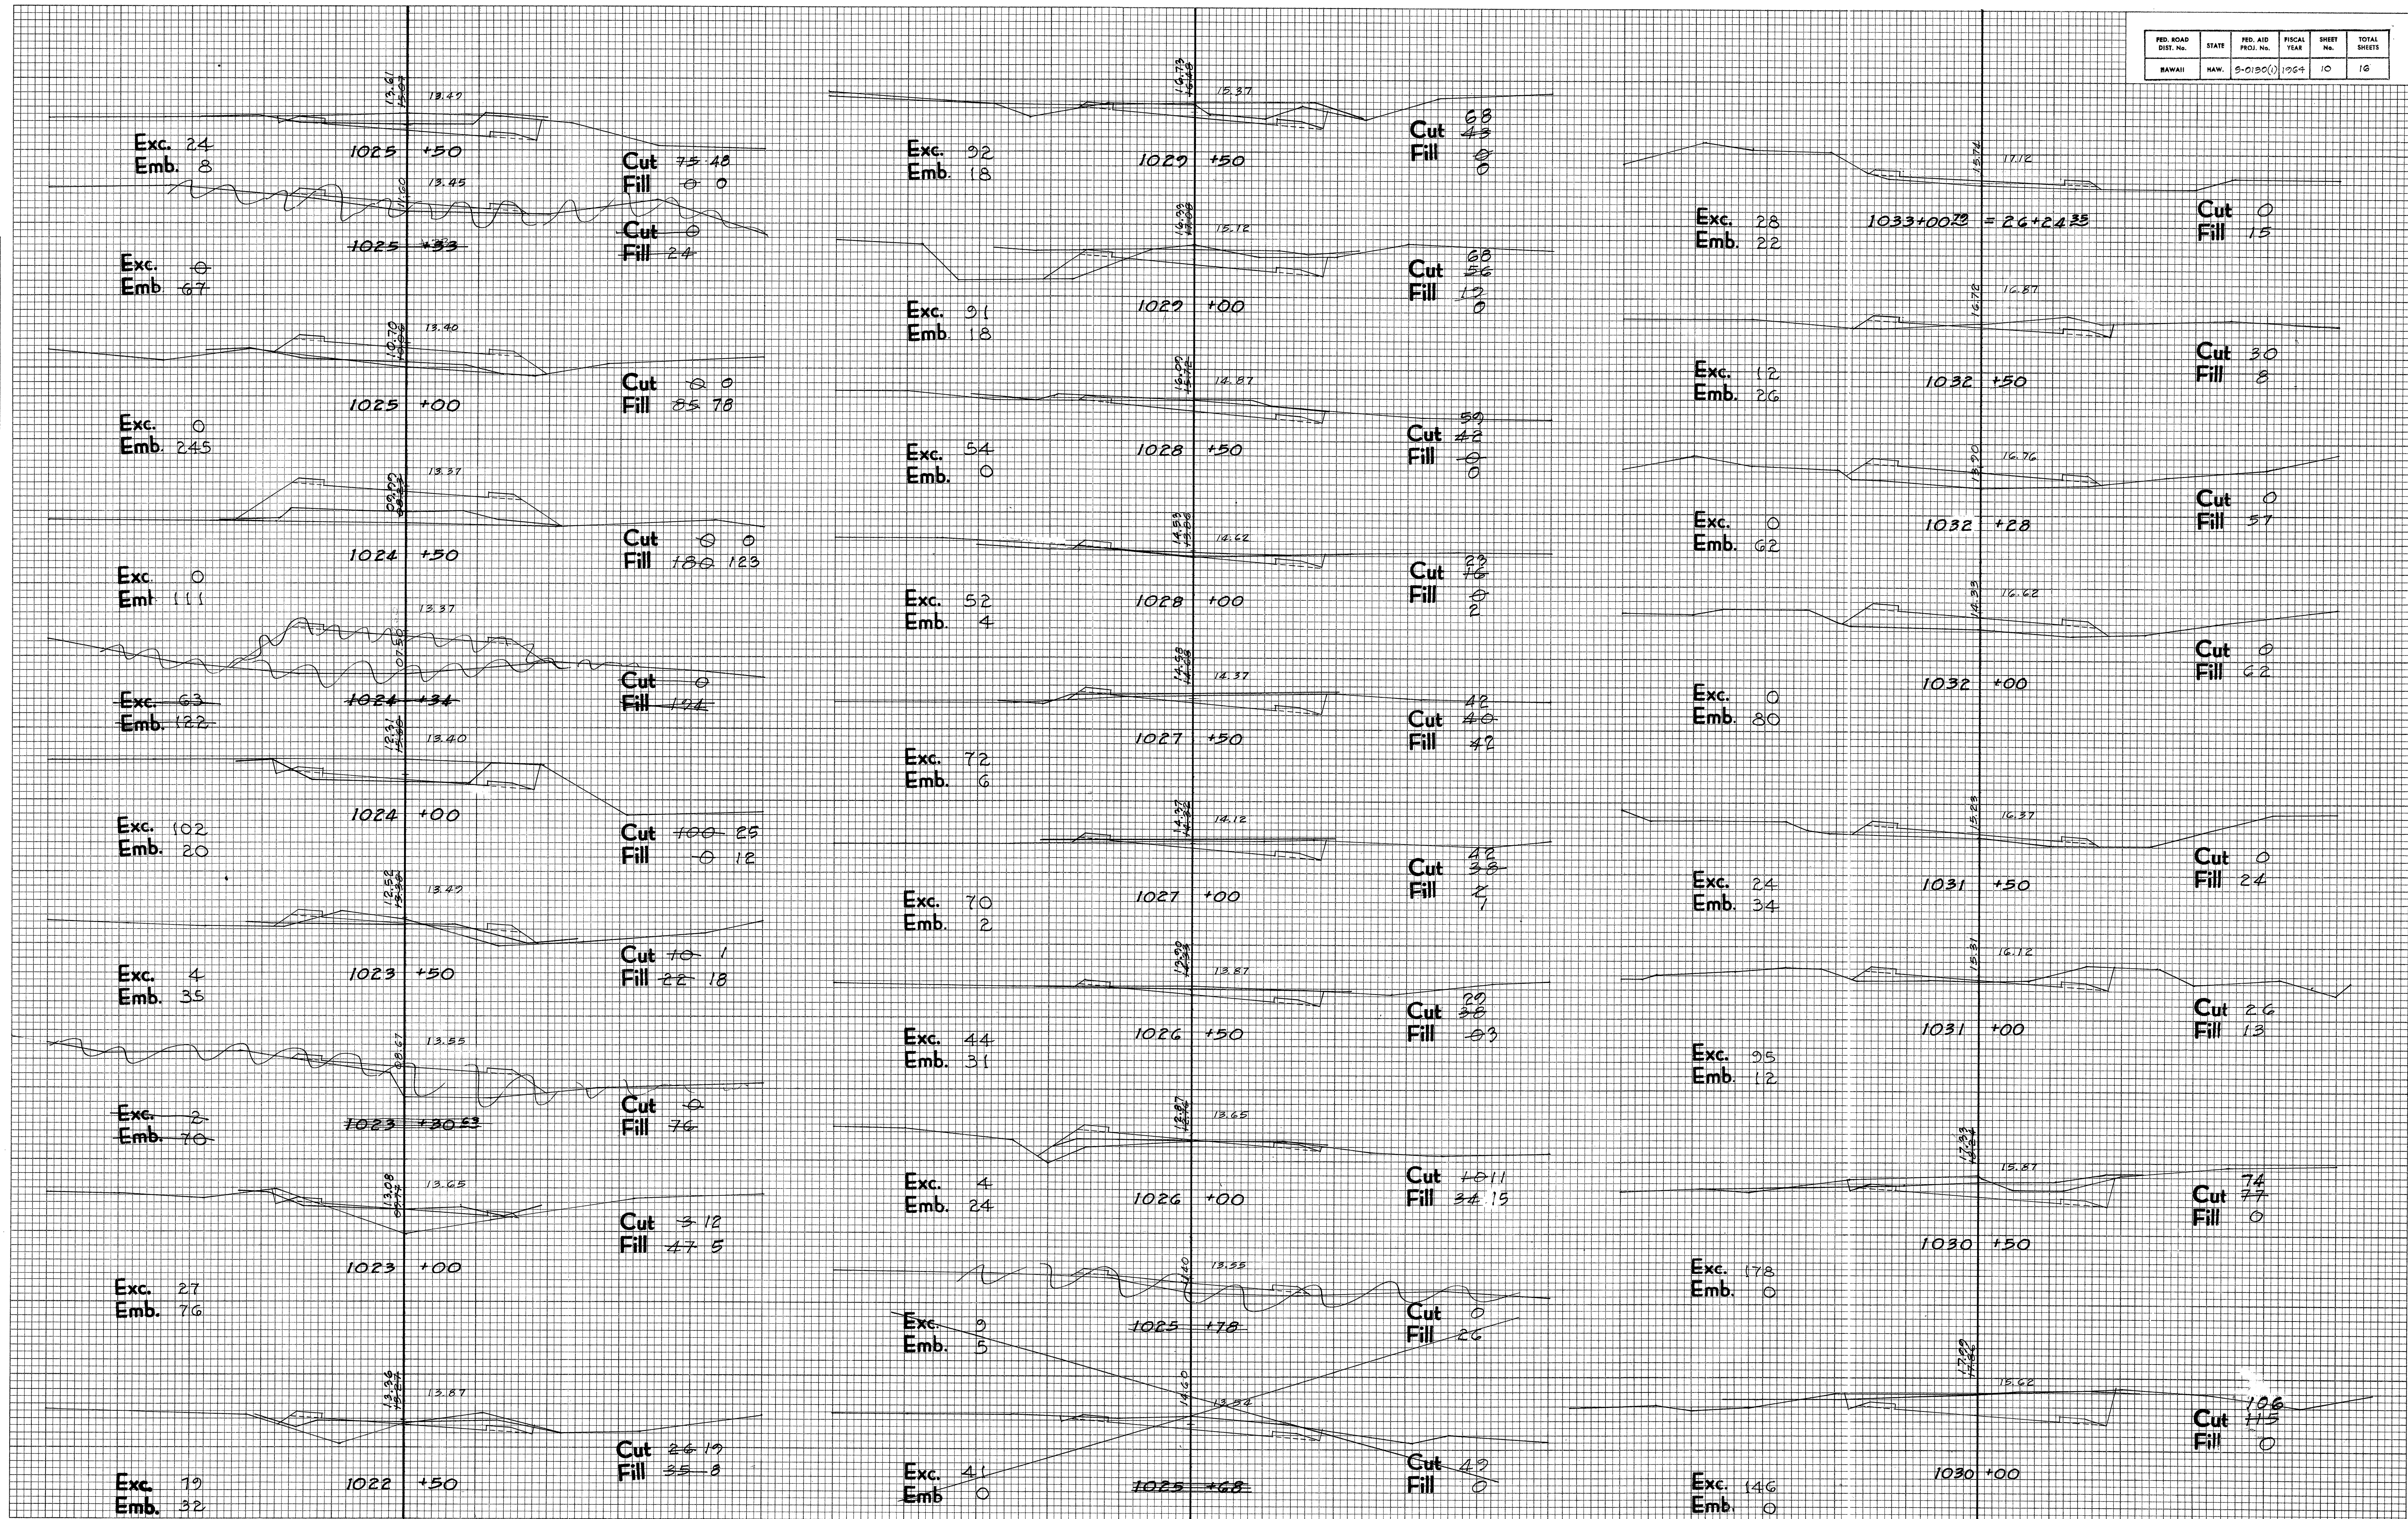

FINAL SURVEY					
NOTE BOOK	SURVEYED _____	BY _____	DATE _____		
NO. _____	PLOTTED _____				
	TEMPLATE _____				
	AREAS _____				
	AREAS CHECKED _____				


ORIGINAL SURVEY	SURVEYED _____	BY _____	DATE _____
NOTE BOOK	PLOTTED _____	<i>S. KAMAU</i>	<i>A-61</i>
	TEMPLATE _____	<i>W. K.</i>	<i>5-61</i>
	AREAS _____	<i>K. O.</i>	<i>5-91-62</i>
NO. _____	AREAS CHECKED _____	<i>F. H.</i>	<i>3-15-62</i>

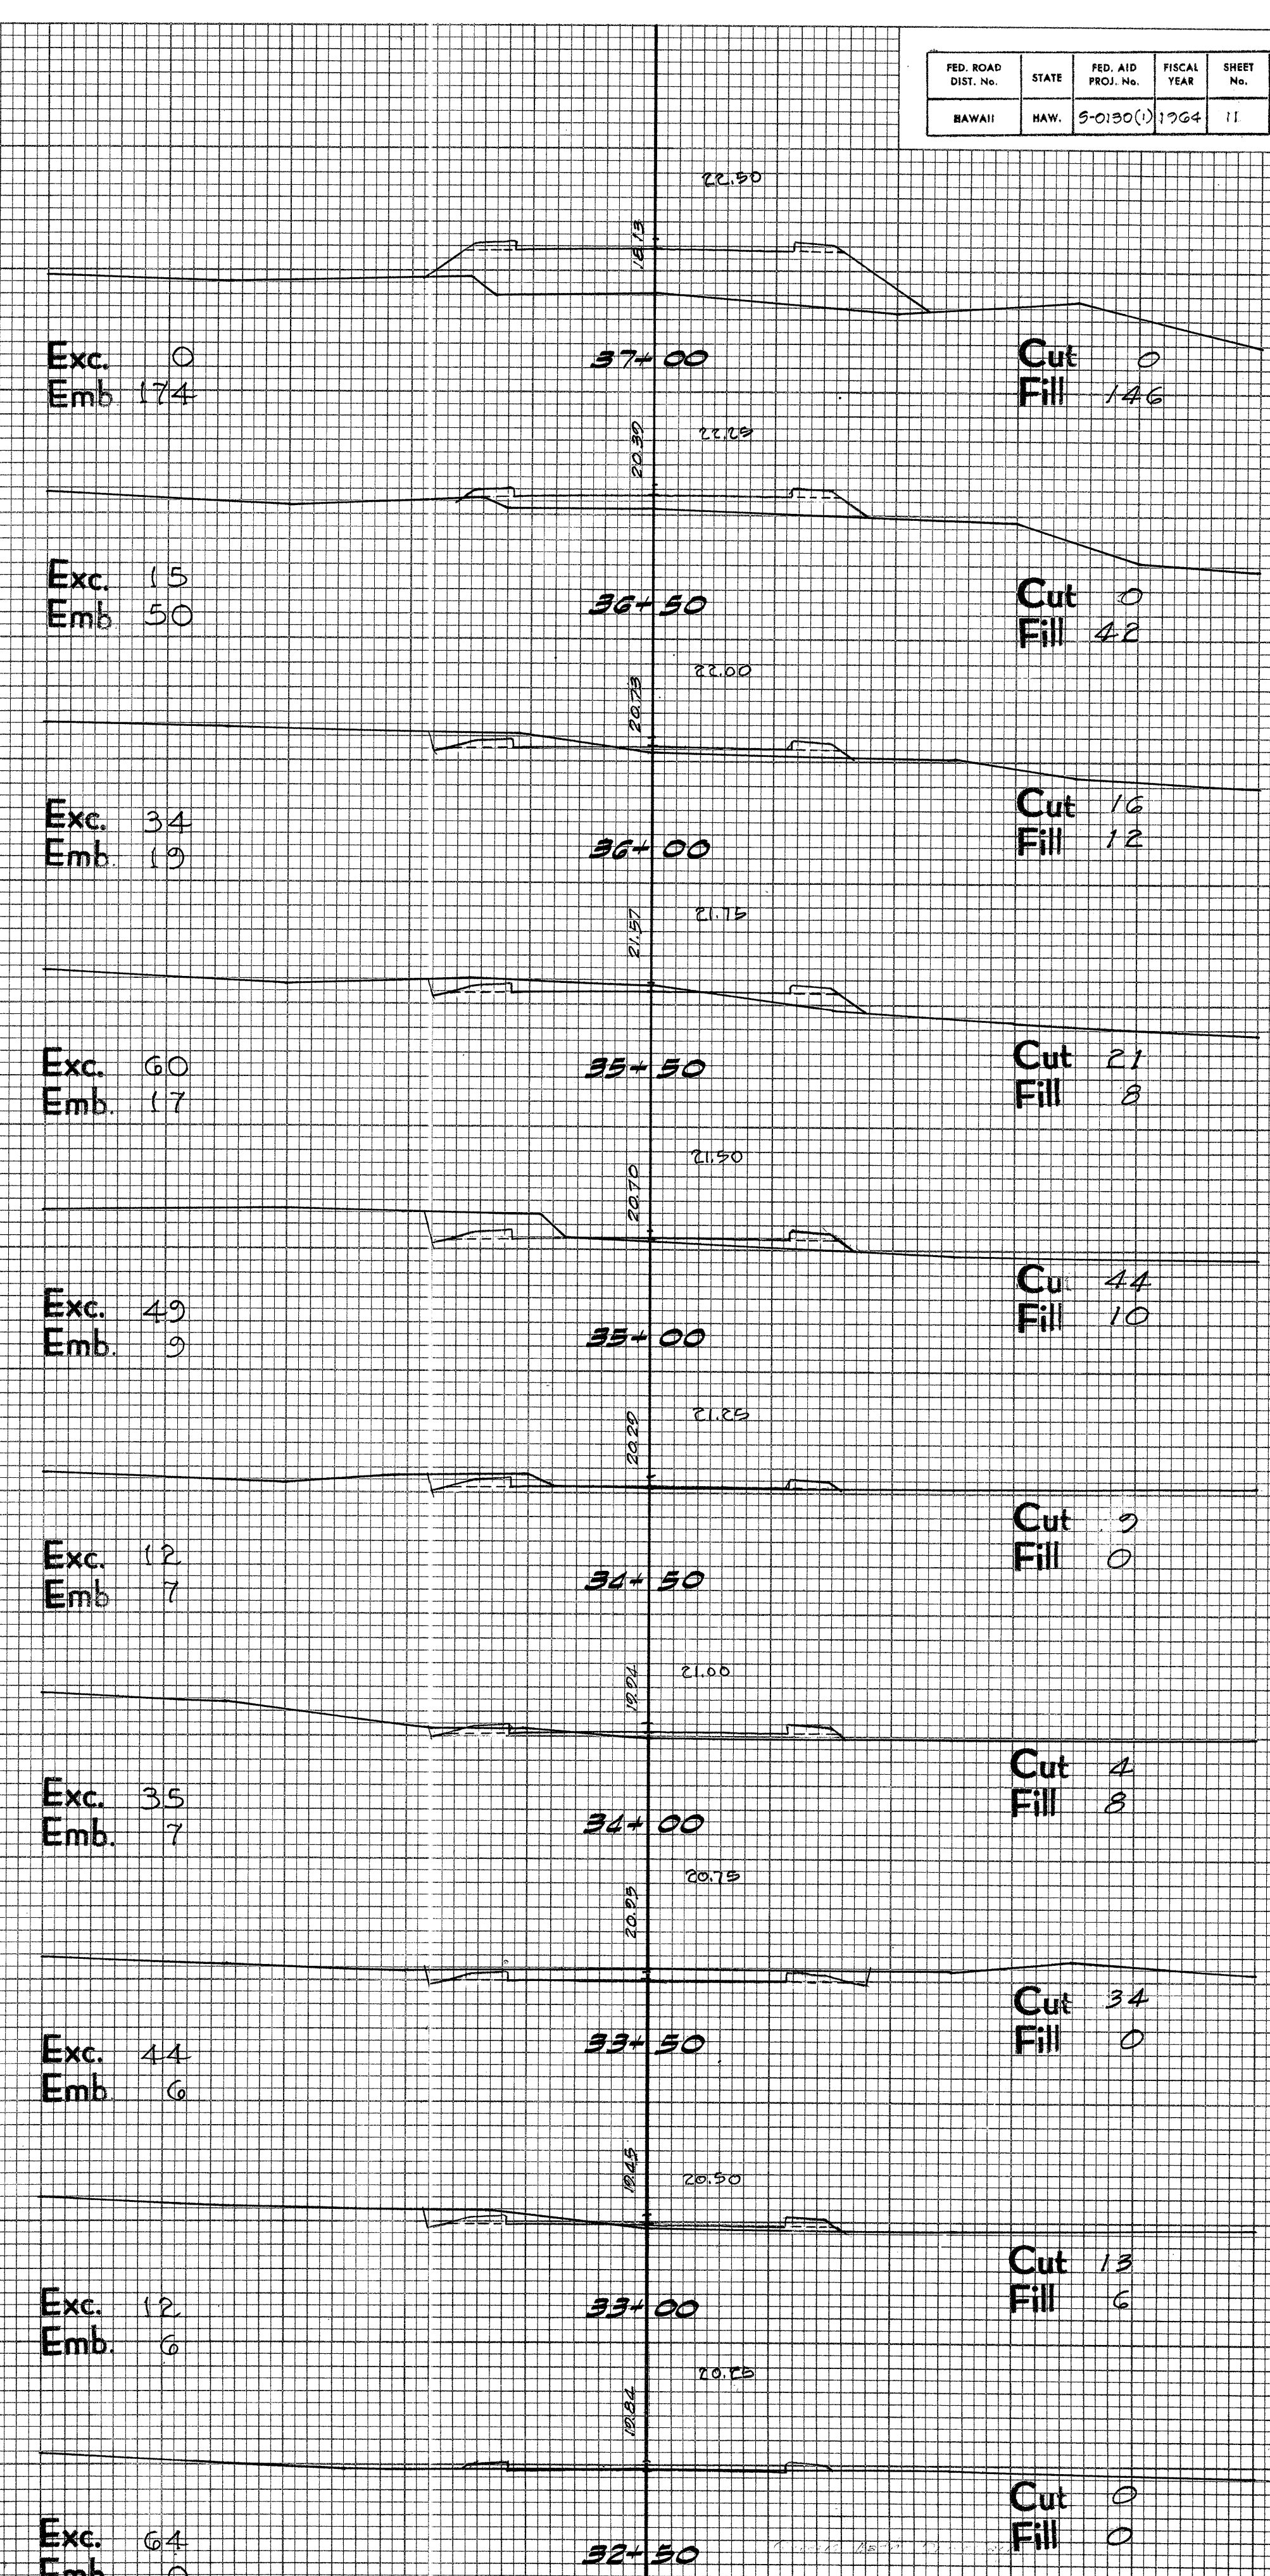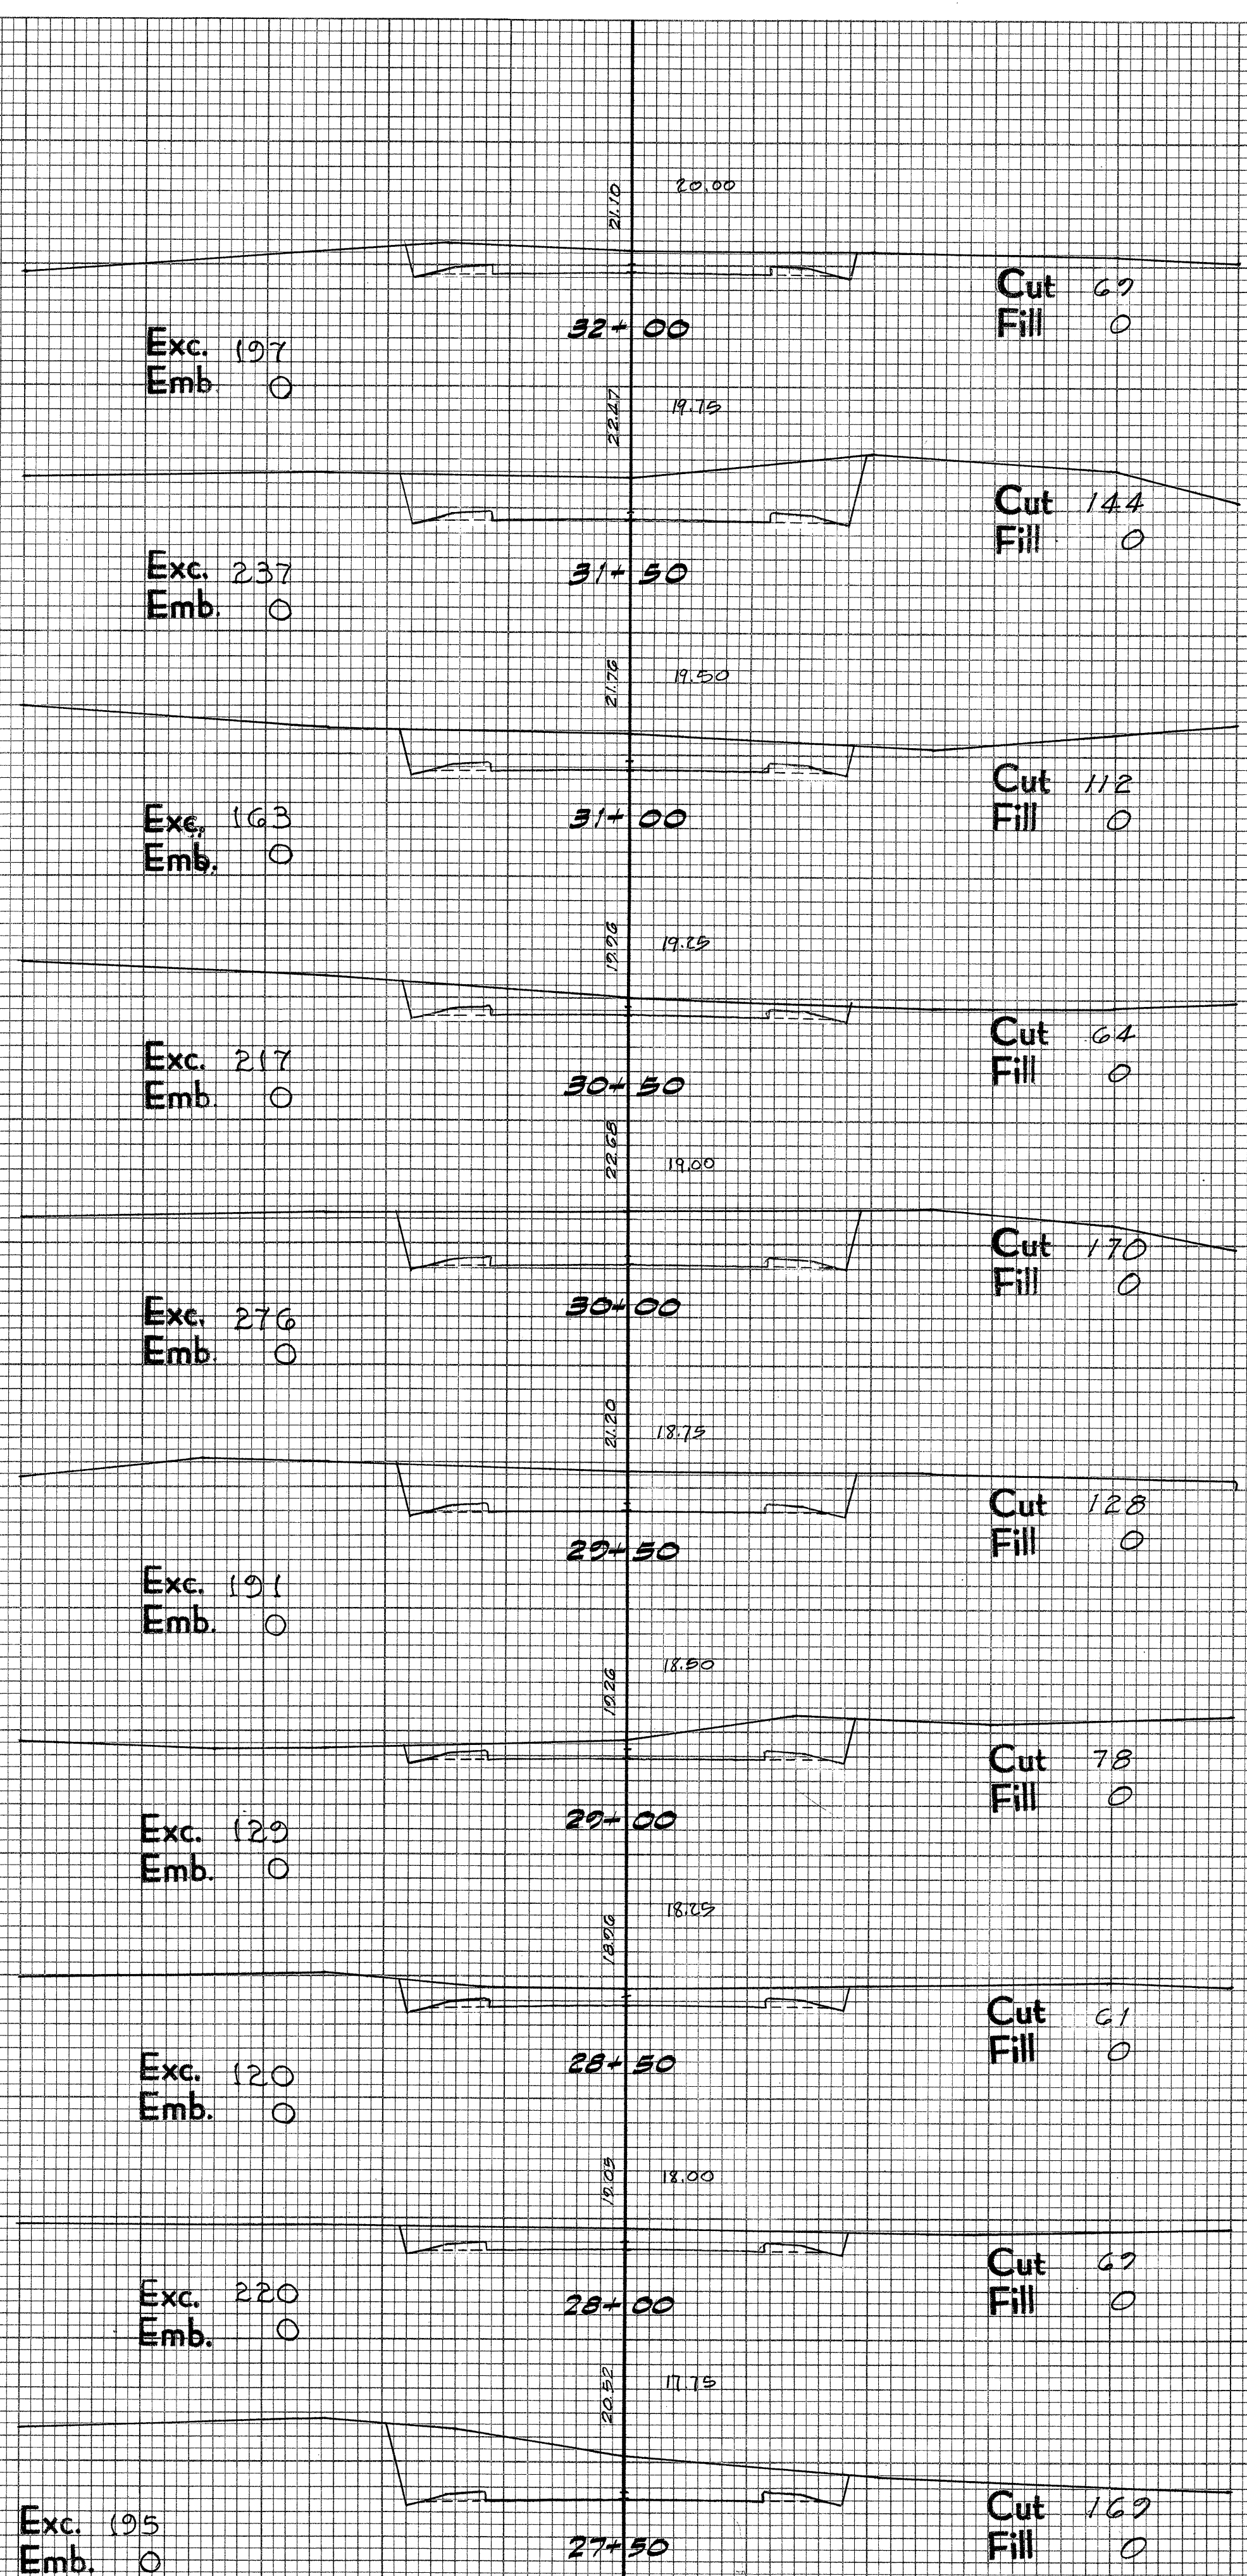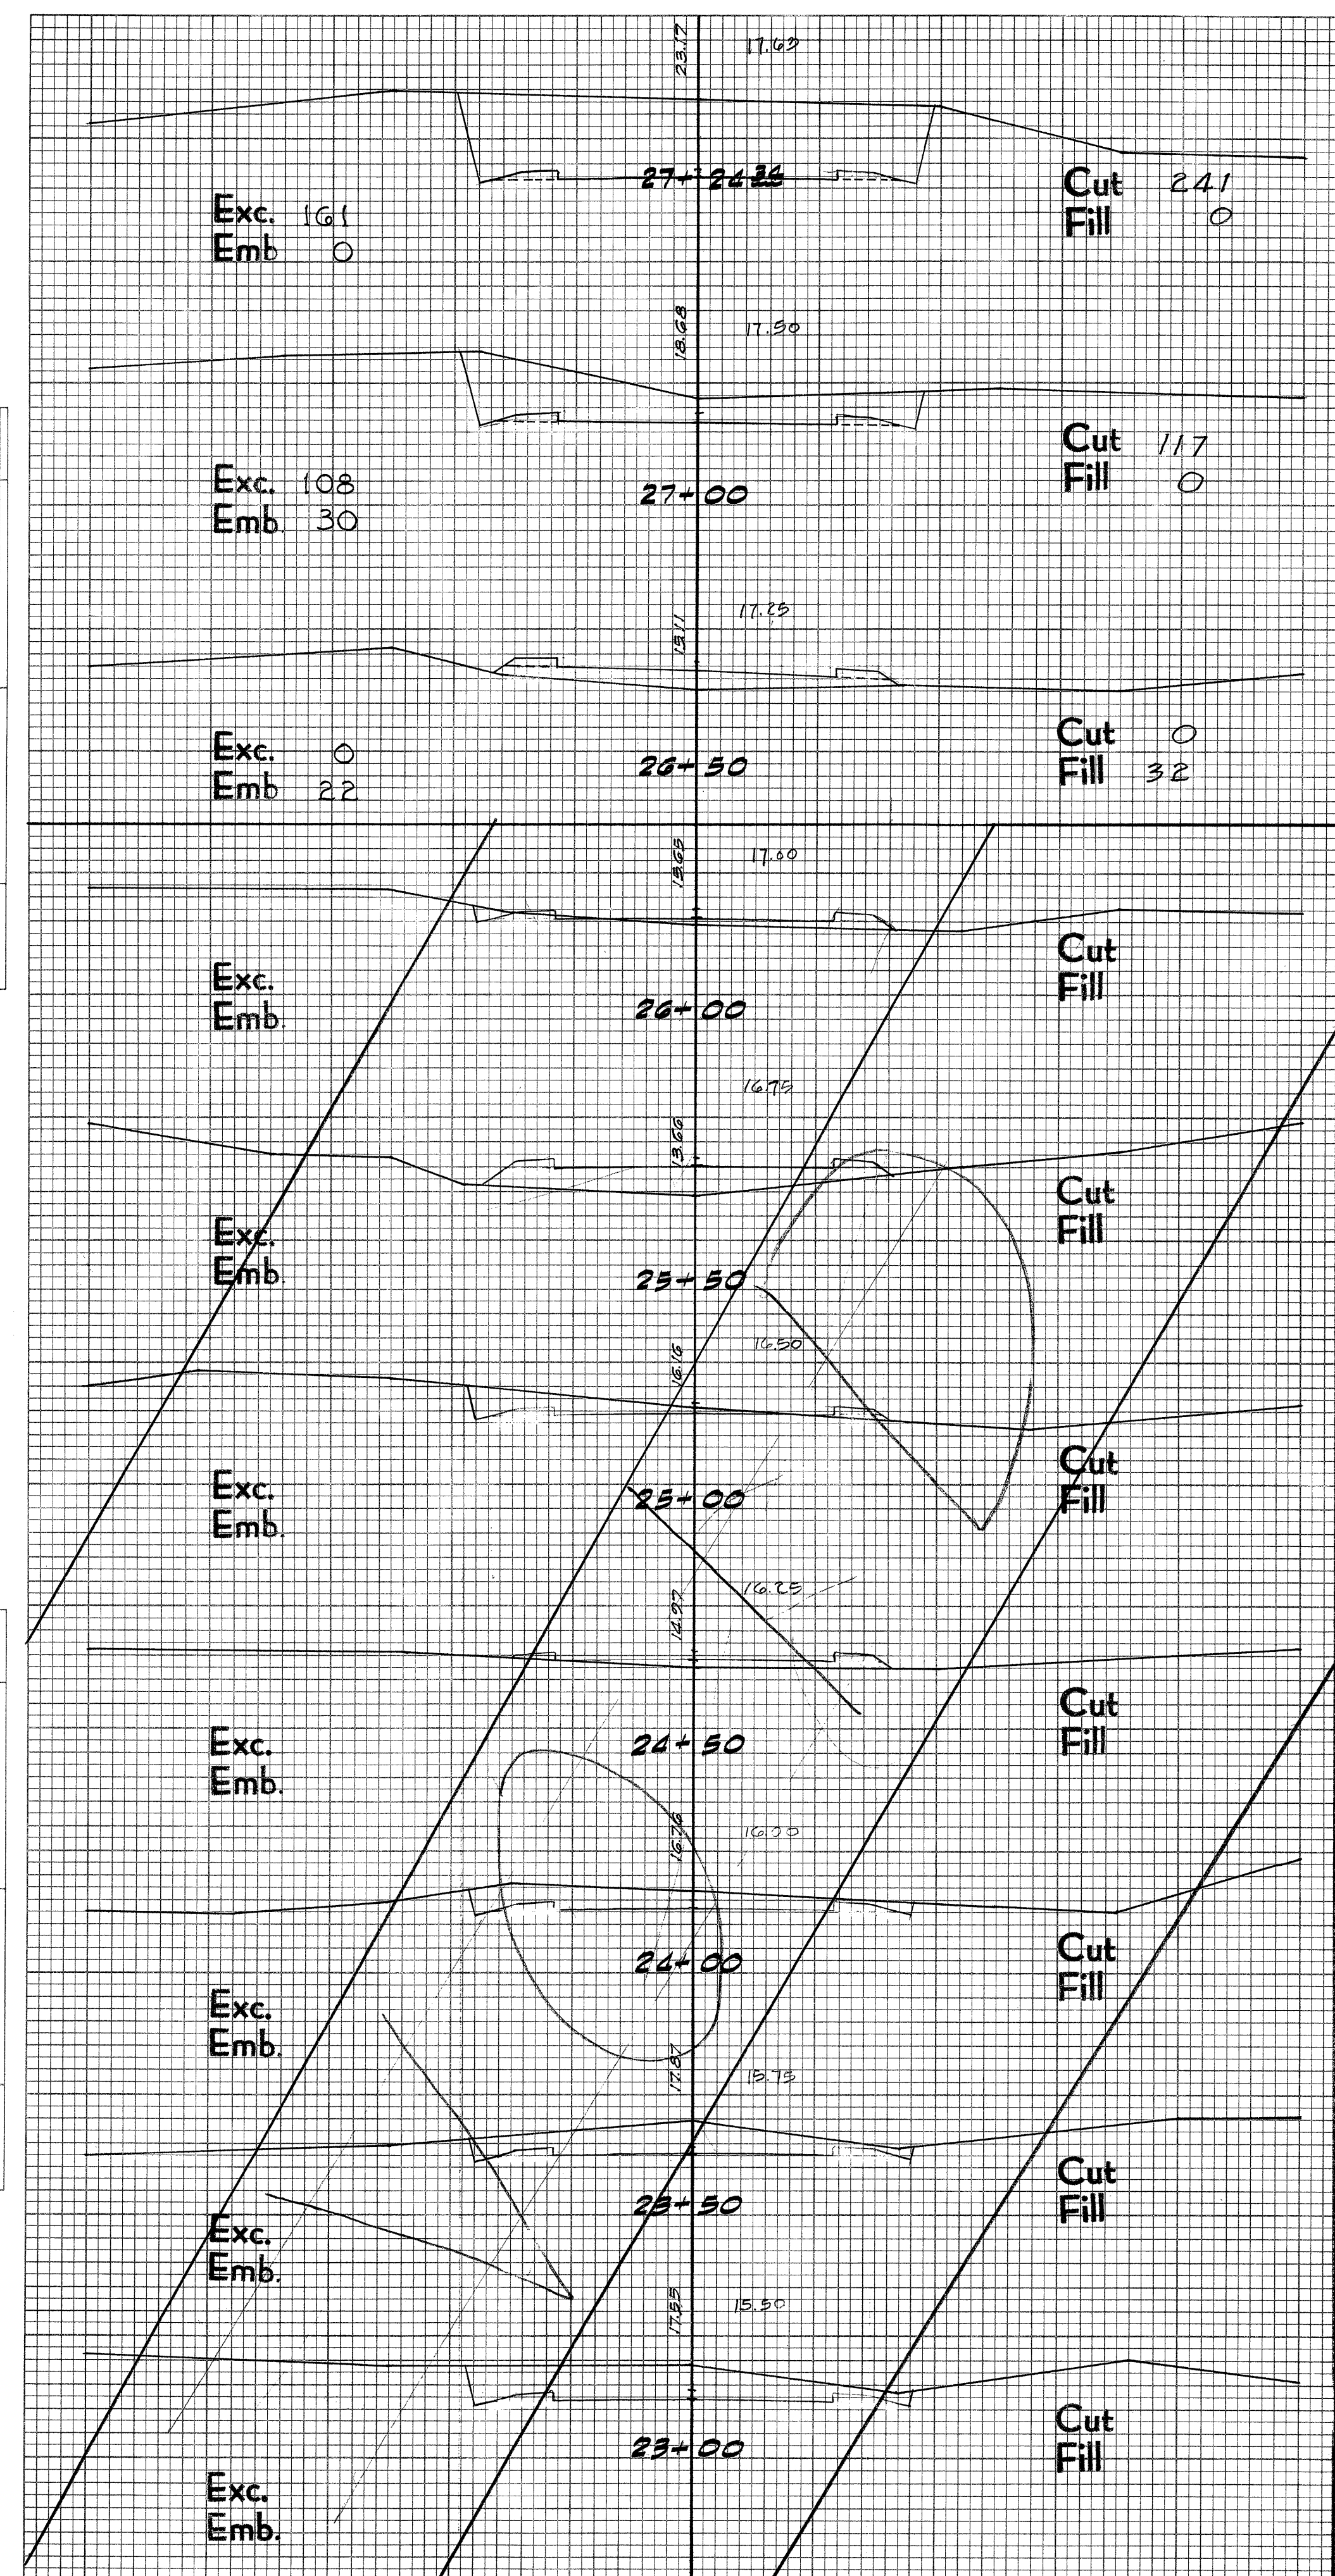

DATE	
BY	
FINAL SURVEY	
NOTE BOOK	
NO.	

DATE	
BY	
ORIGINAL SURVEY	
NOTE BOOK	
NO.	

FED. ROAD DIST. No.	STATE	FED. AID PROJ. No.	FISCAL YEAR	SHEET No.	TOTAL SHEETS
HAWAII	HAW.	5-01300	1964	12	16

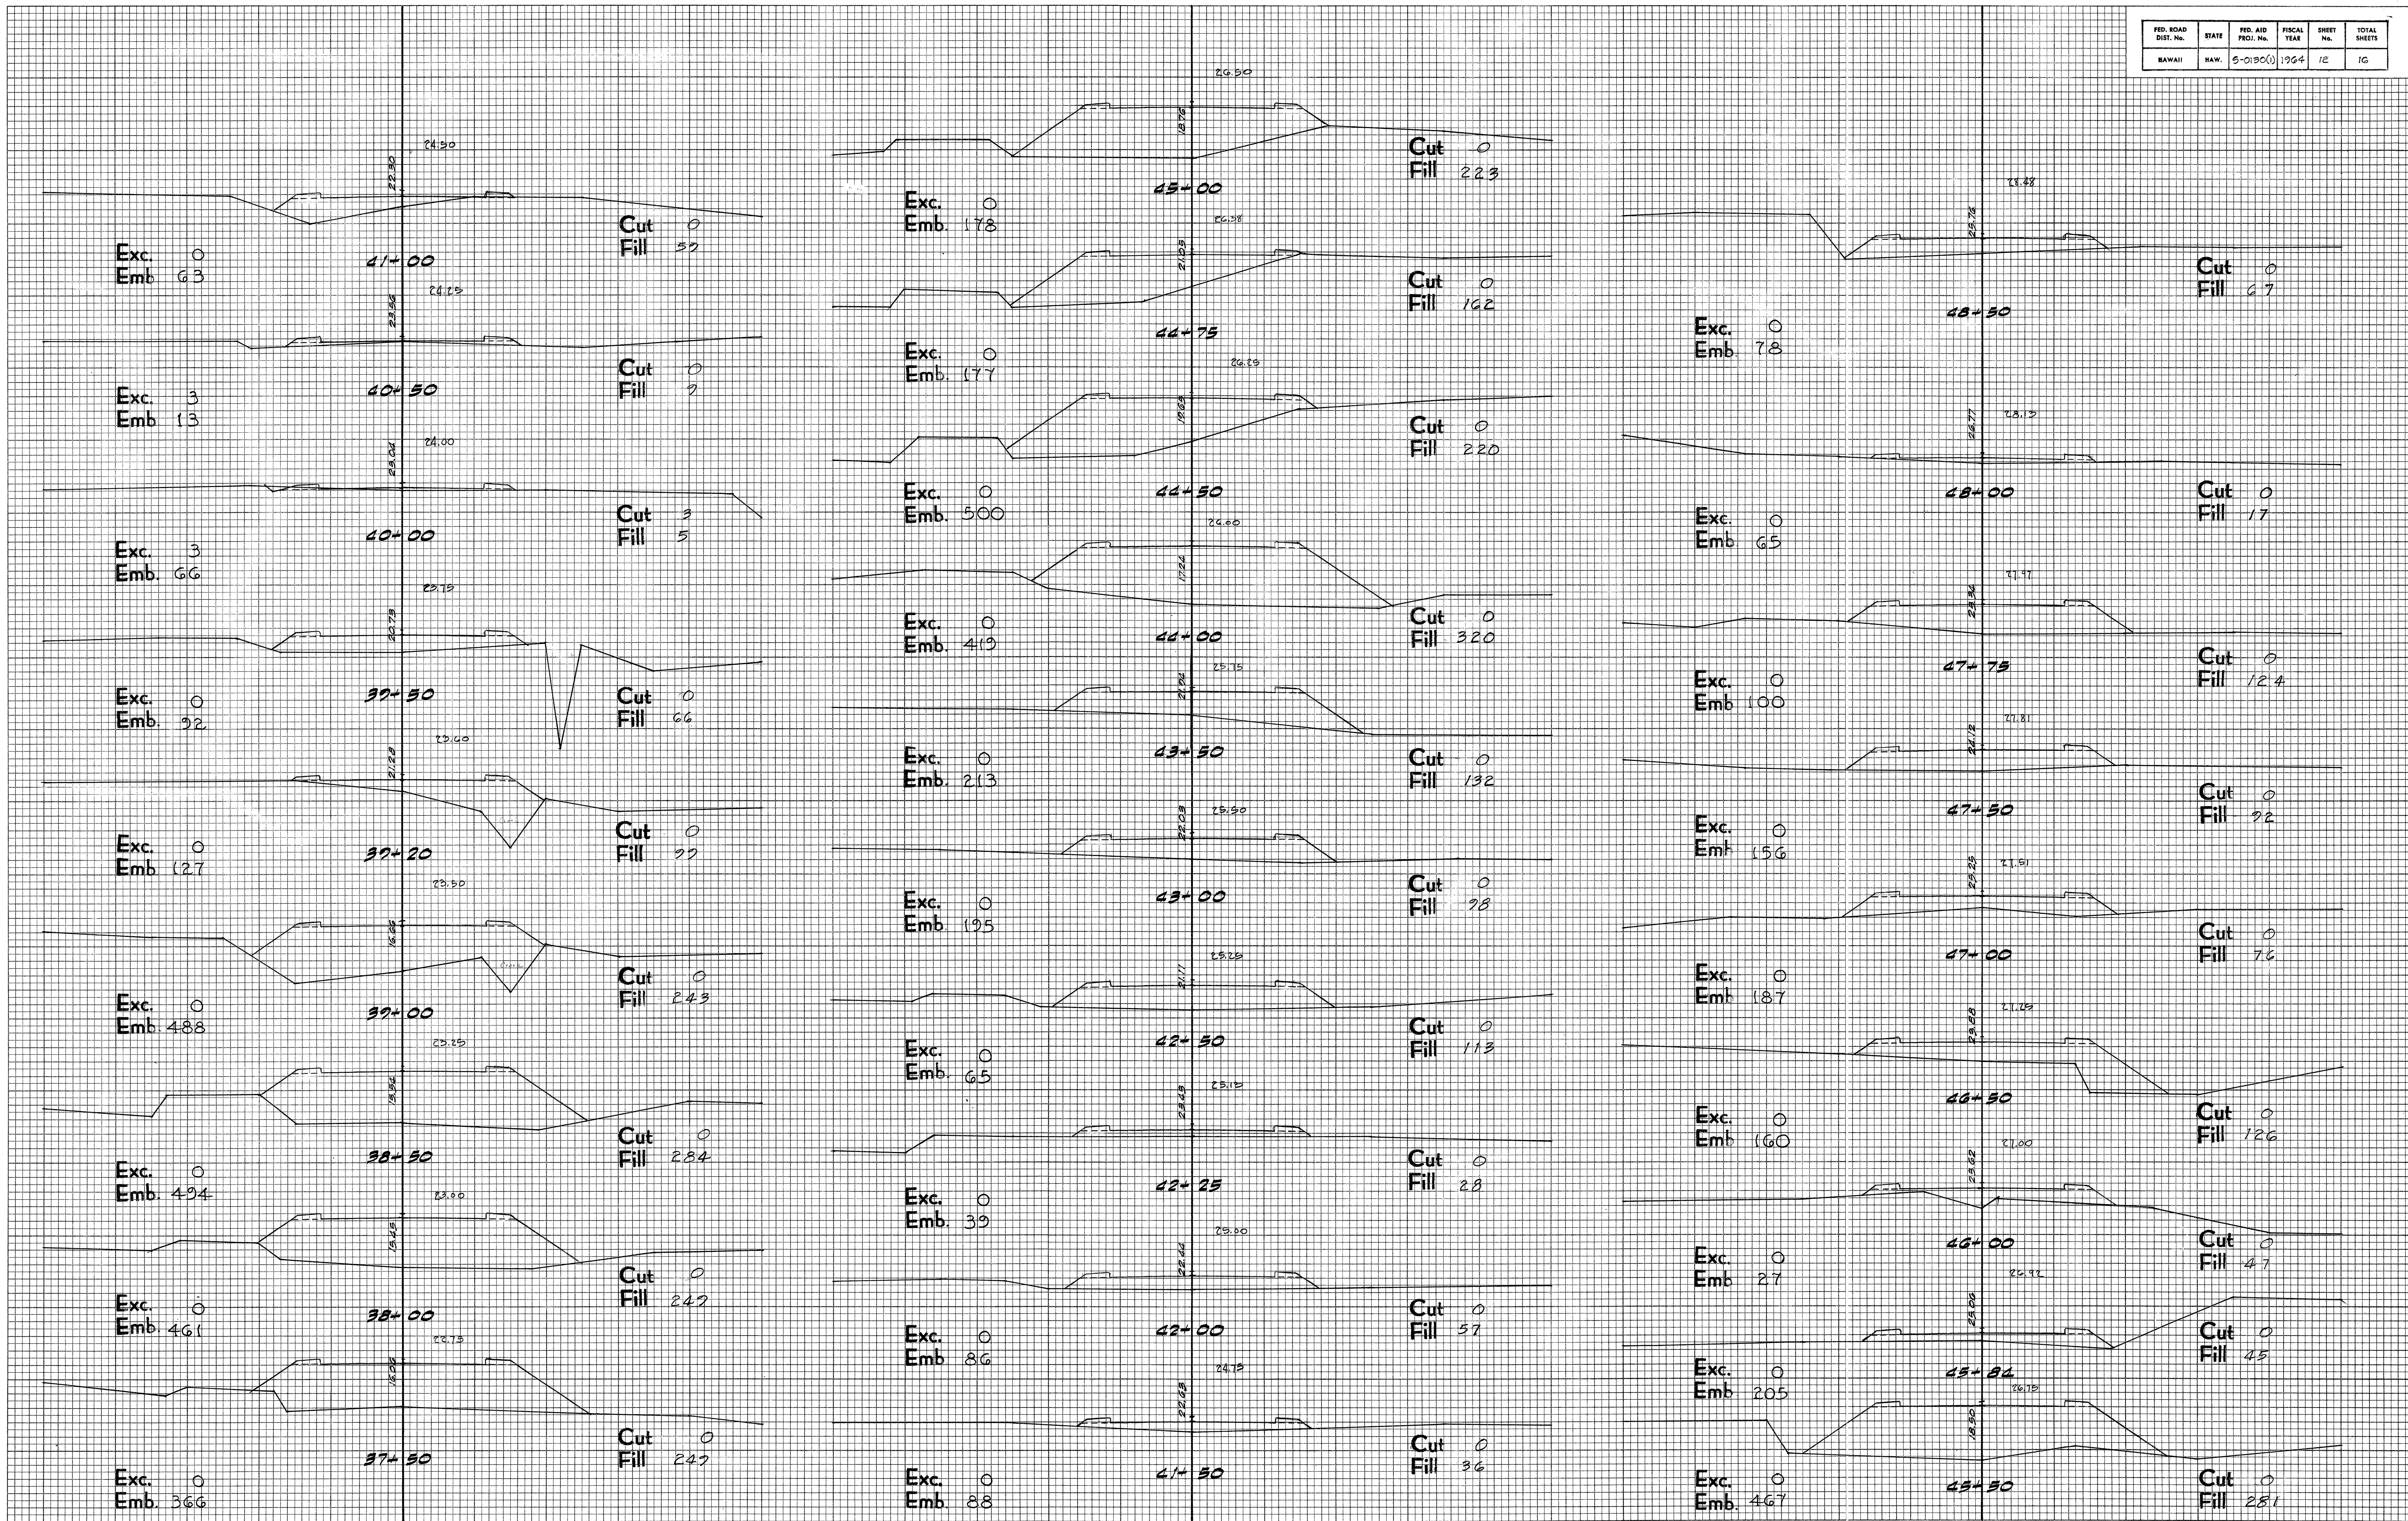

FINAL SURVEY	DATE	BY
SURVEYED PLOTTER	DATE	
NOTE BOOK	DATE	
AREAS CHECKED	DATE	

ORIGINAL SURVEY	DATE	BY
SURVEYED PLOTTER	DATE	
NOTE BOOK	DATE	
AREAS CHECKED	DATE	

FED. ROAD DIST. No.	STATE	FED. AID PROJ. No.	FISCAL YEAR	SHEET No.	TOTAL SHEETS
HAWAII	HAW.	5-0130(1)	1964	13	16


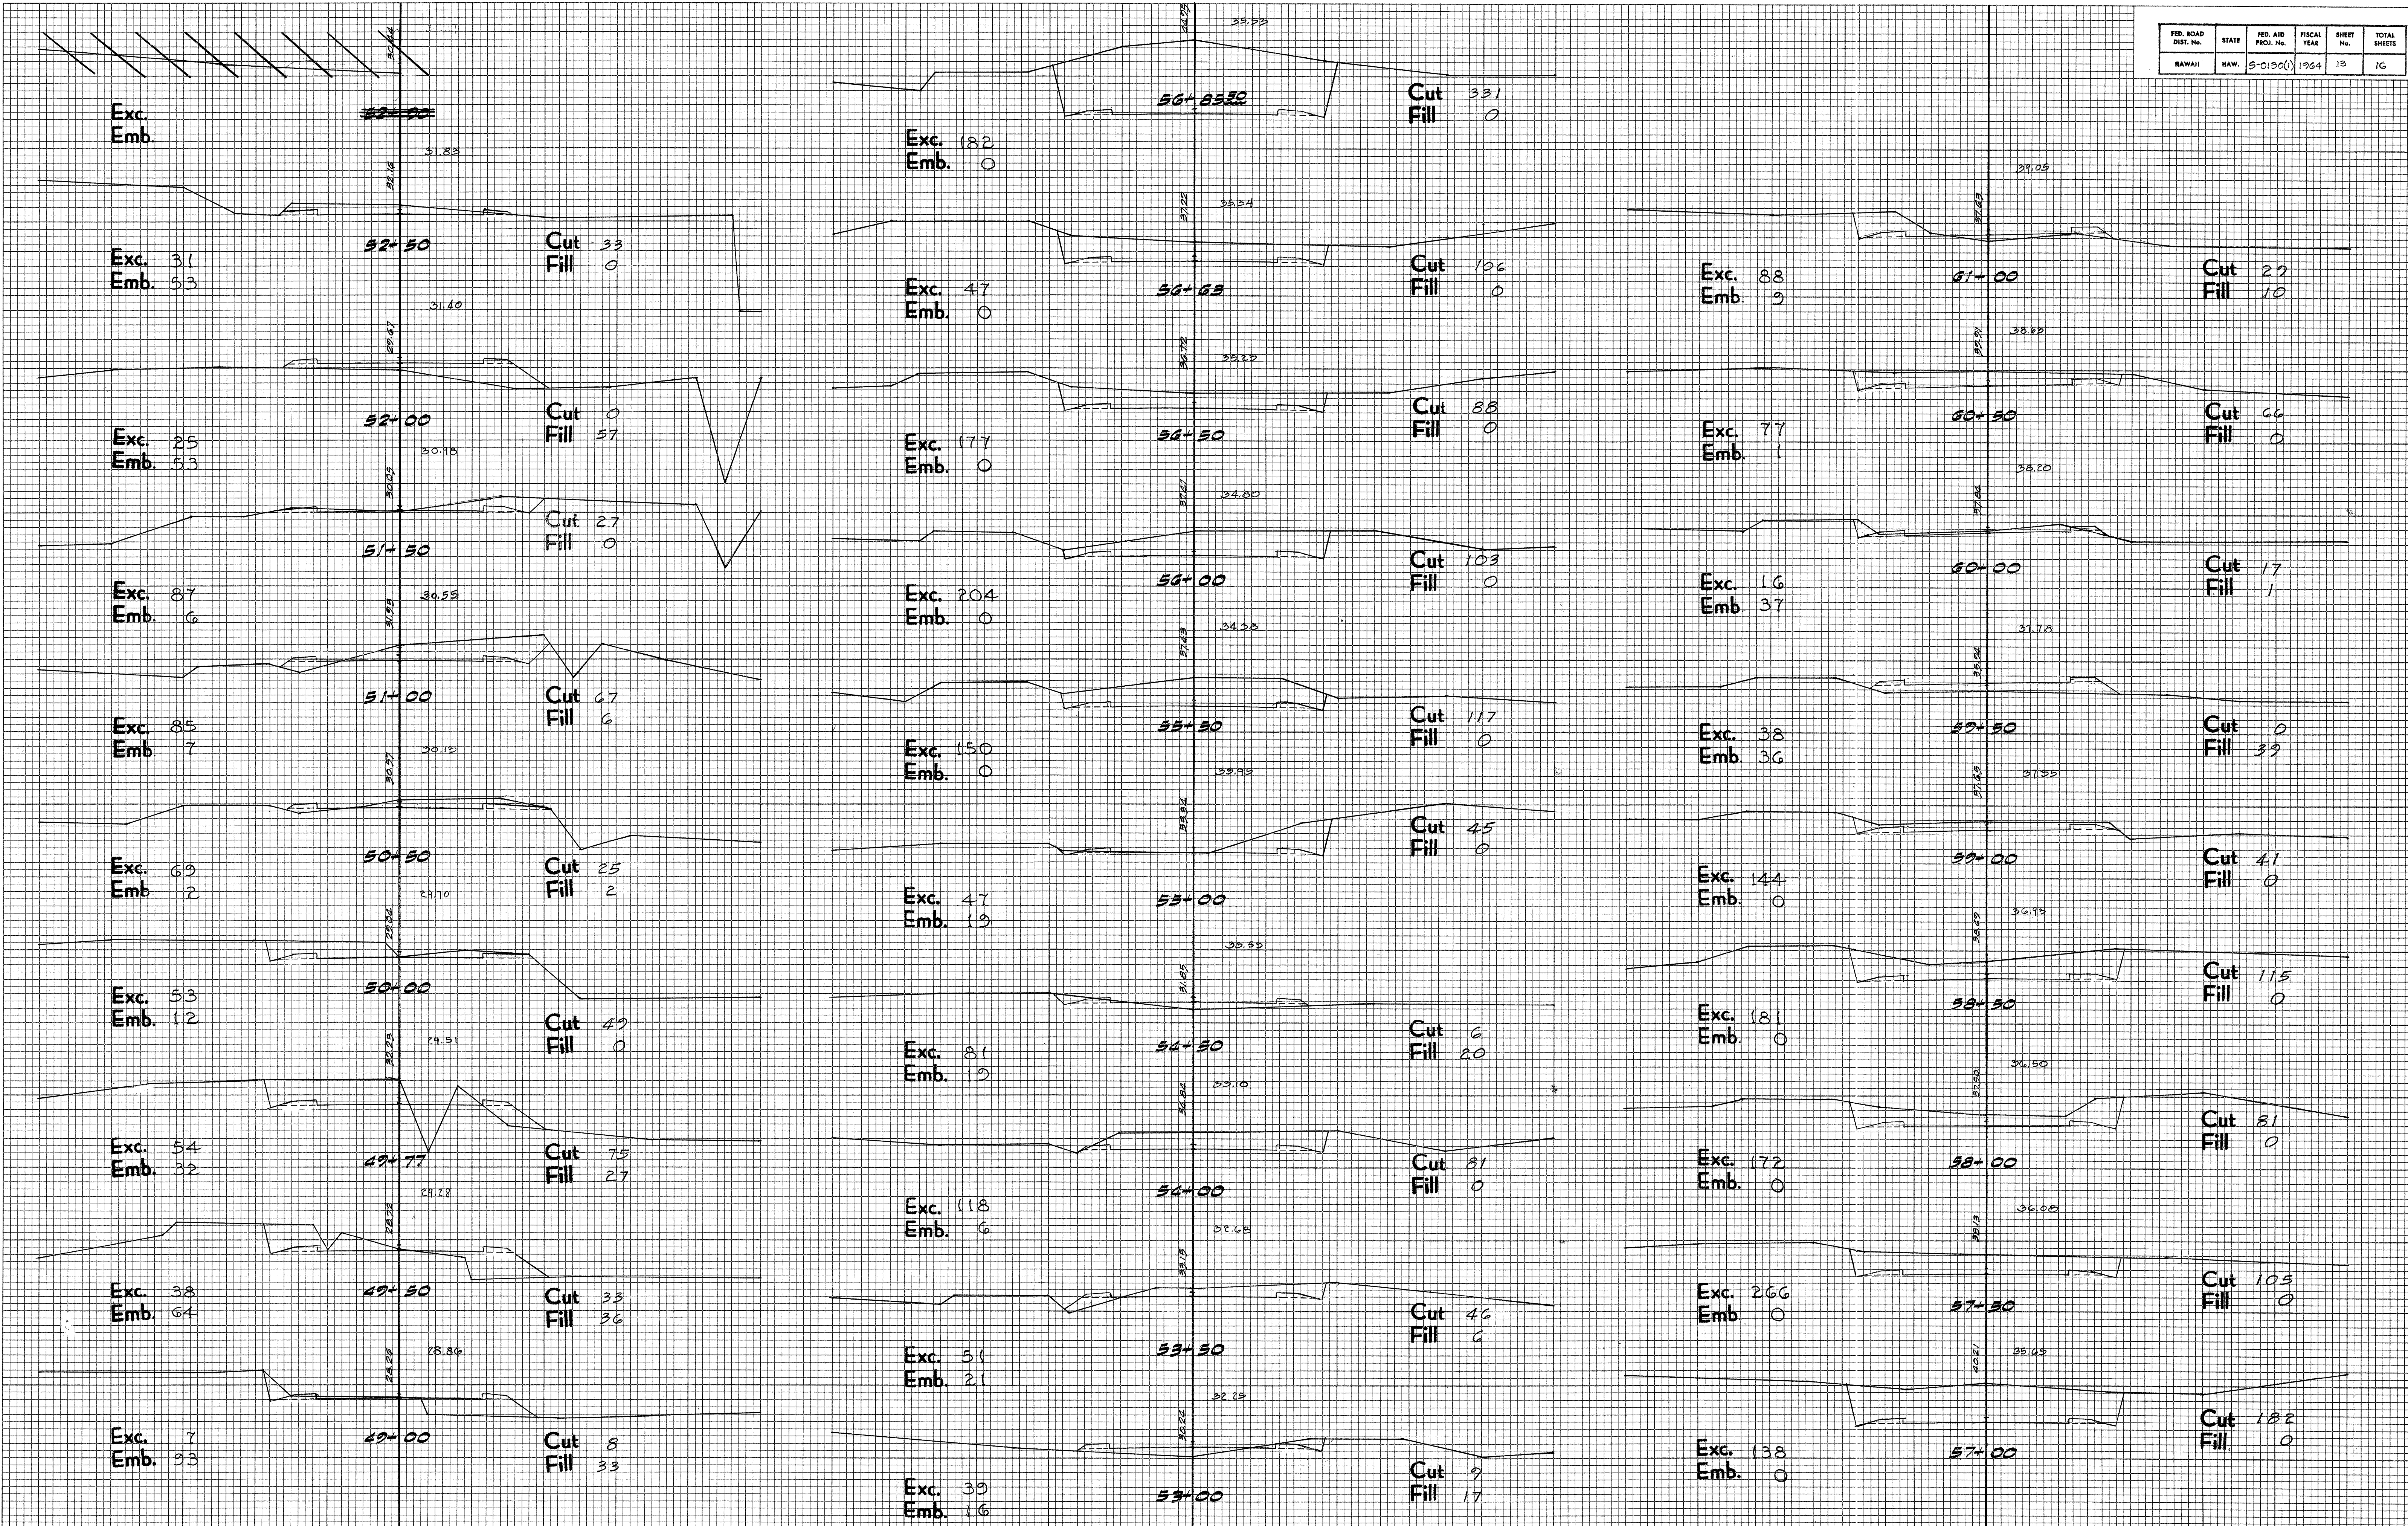


PLATE 3 CROSS SECTION D. P. R. & E. STANDARD
100% RAS PAPER-MADE AND PRINTED IN U. S. A.
EUGENE DIETZGEN CO.

FED. ROAD DIST. No.	STATE	FED. AID PROJ. No.	FISCAL YEAR	SHEET No.	TOTAL SHEETS
SAWAI	HAU	5-0-30(1)	1964	14	16

DATE	BY	FINAL SURVEY	PLOTTED	NOTED	AREAS CHECKED

DATE	BY	ORIGINAL SURVEY	PLOTTED	NOTED	AREAS CHECKED
4-61	S. KAMAU				

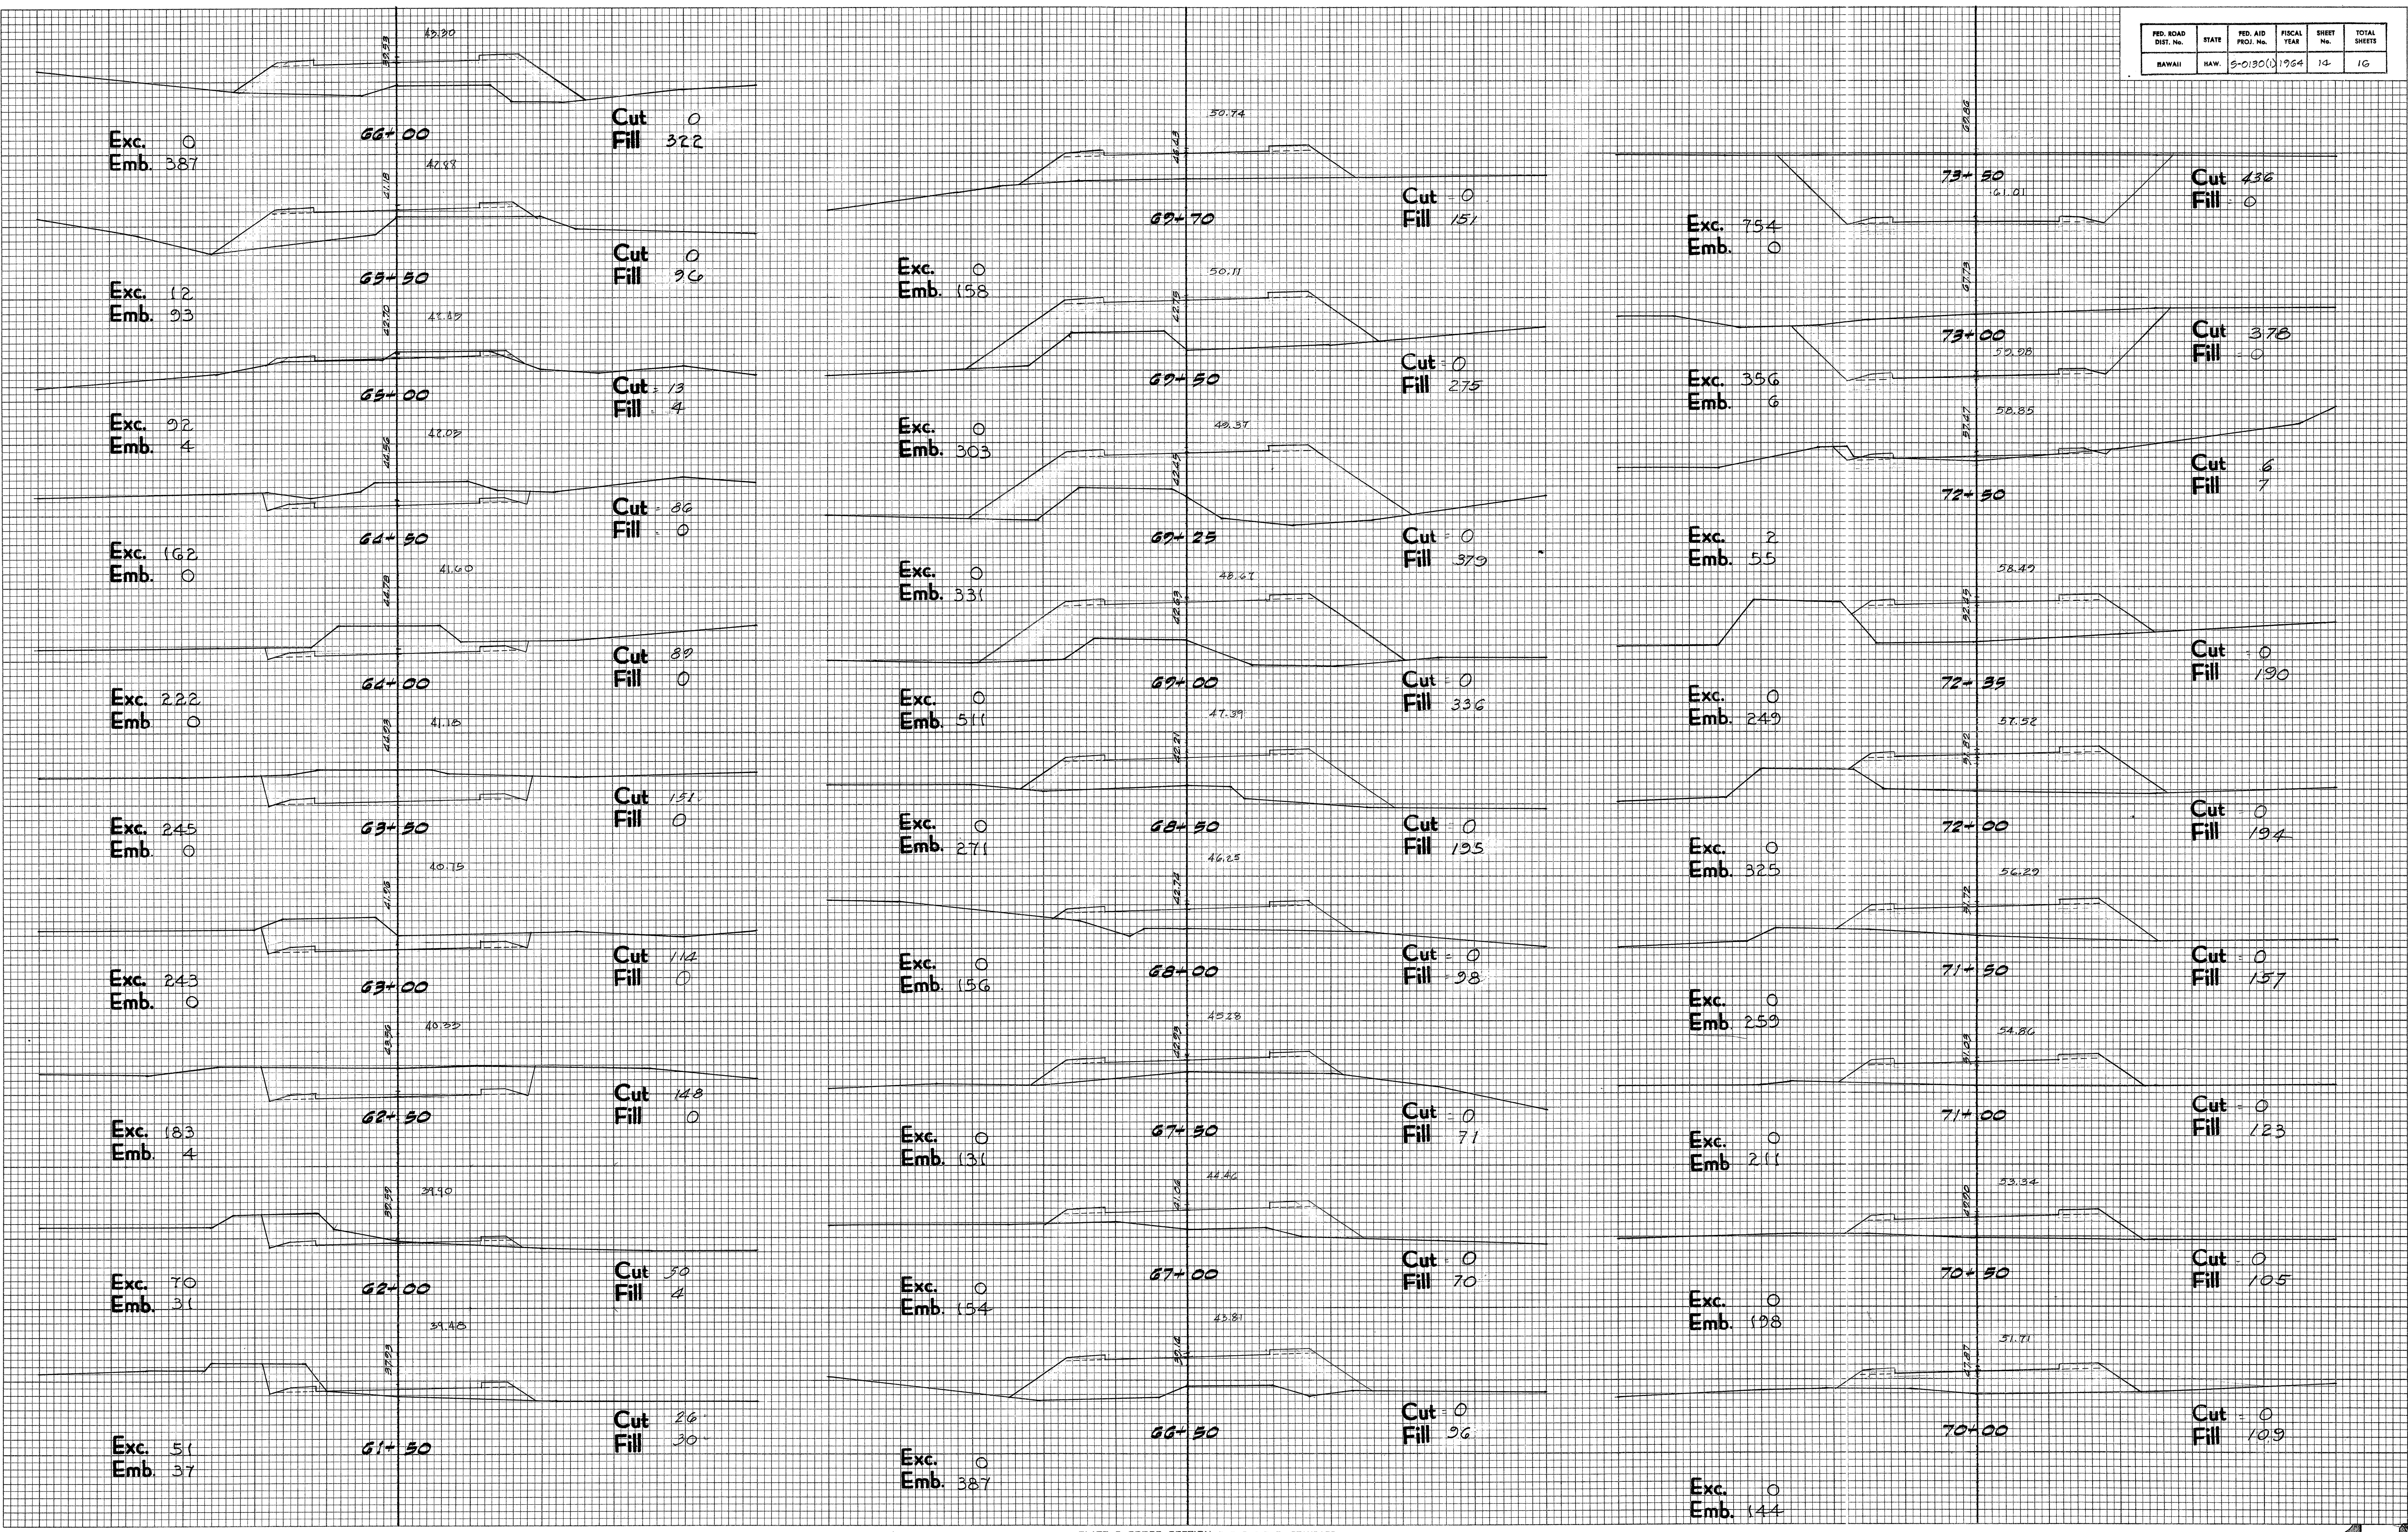

FINAL SURVEY	DATE	
	BY	
	SURVEYED PLOTTED TEMPLATE	
	NOTE BOOK AREAS CHECKED NO.	

ORIGINAL SURVEY	DATE	4-01
	BY	S. CAMALL
	SURVEYED PLOTTED TEMPLATE	5-61
	NOTE BOOK AREAS CHECKED NO.	5-31-62

FED. ROAD DIST. NO.	STATE	FED. AID PROJ. NO.	FISCAL YEAR	SHEET NO.	TOTAL SHEETS
HAWAII	HAW.	5-0130(1)	1964	15	16

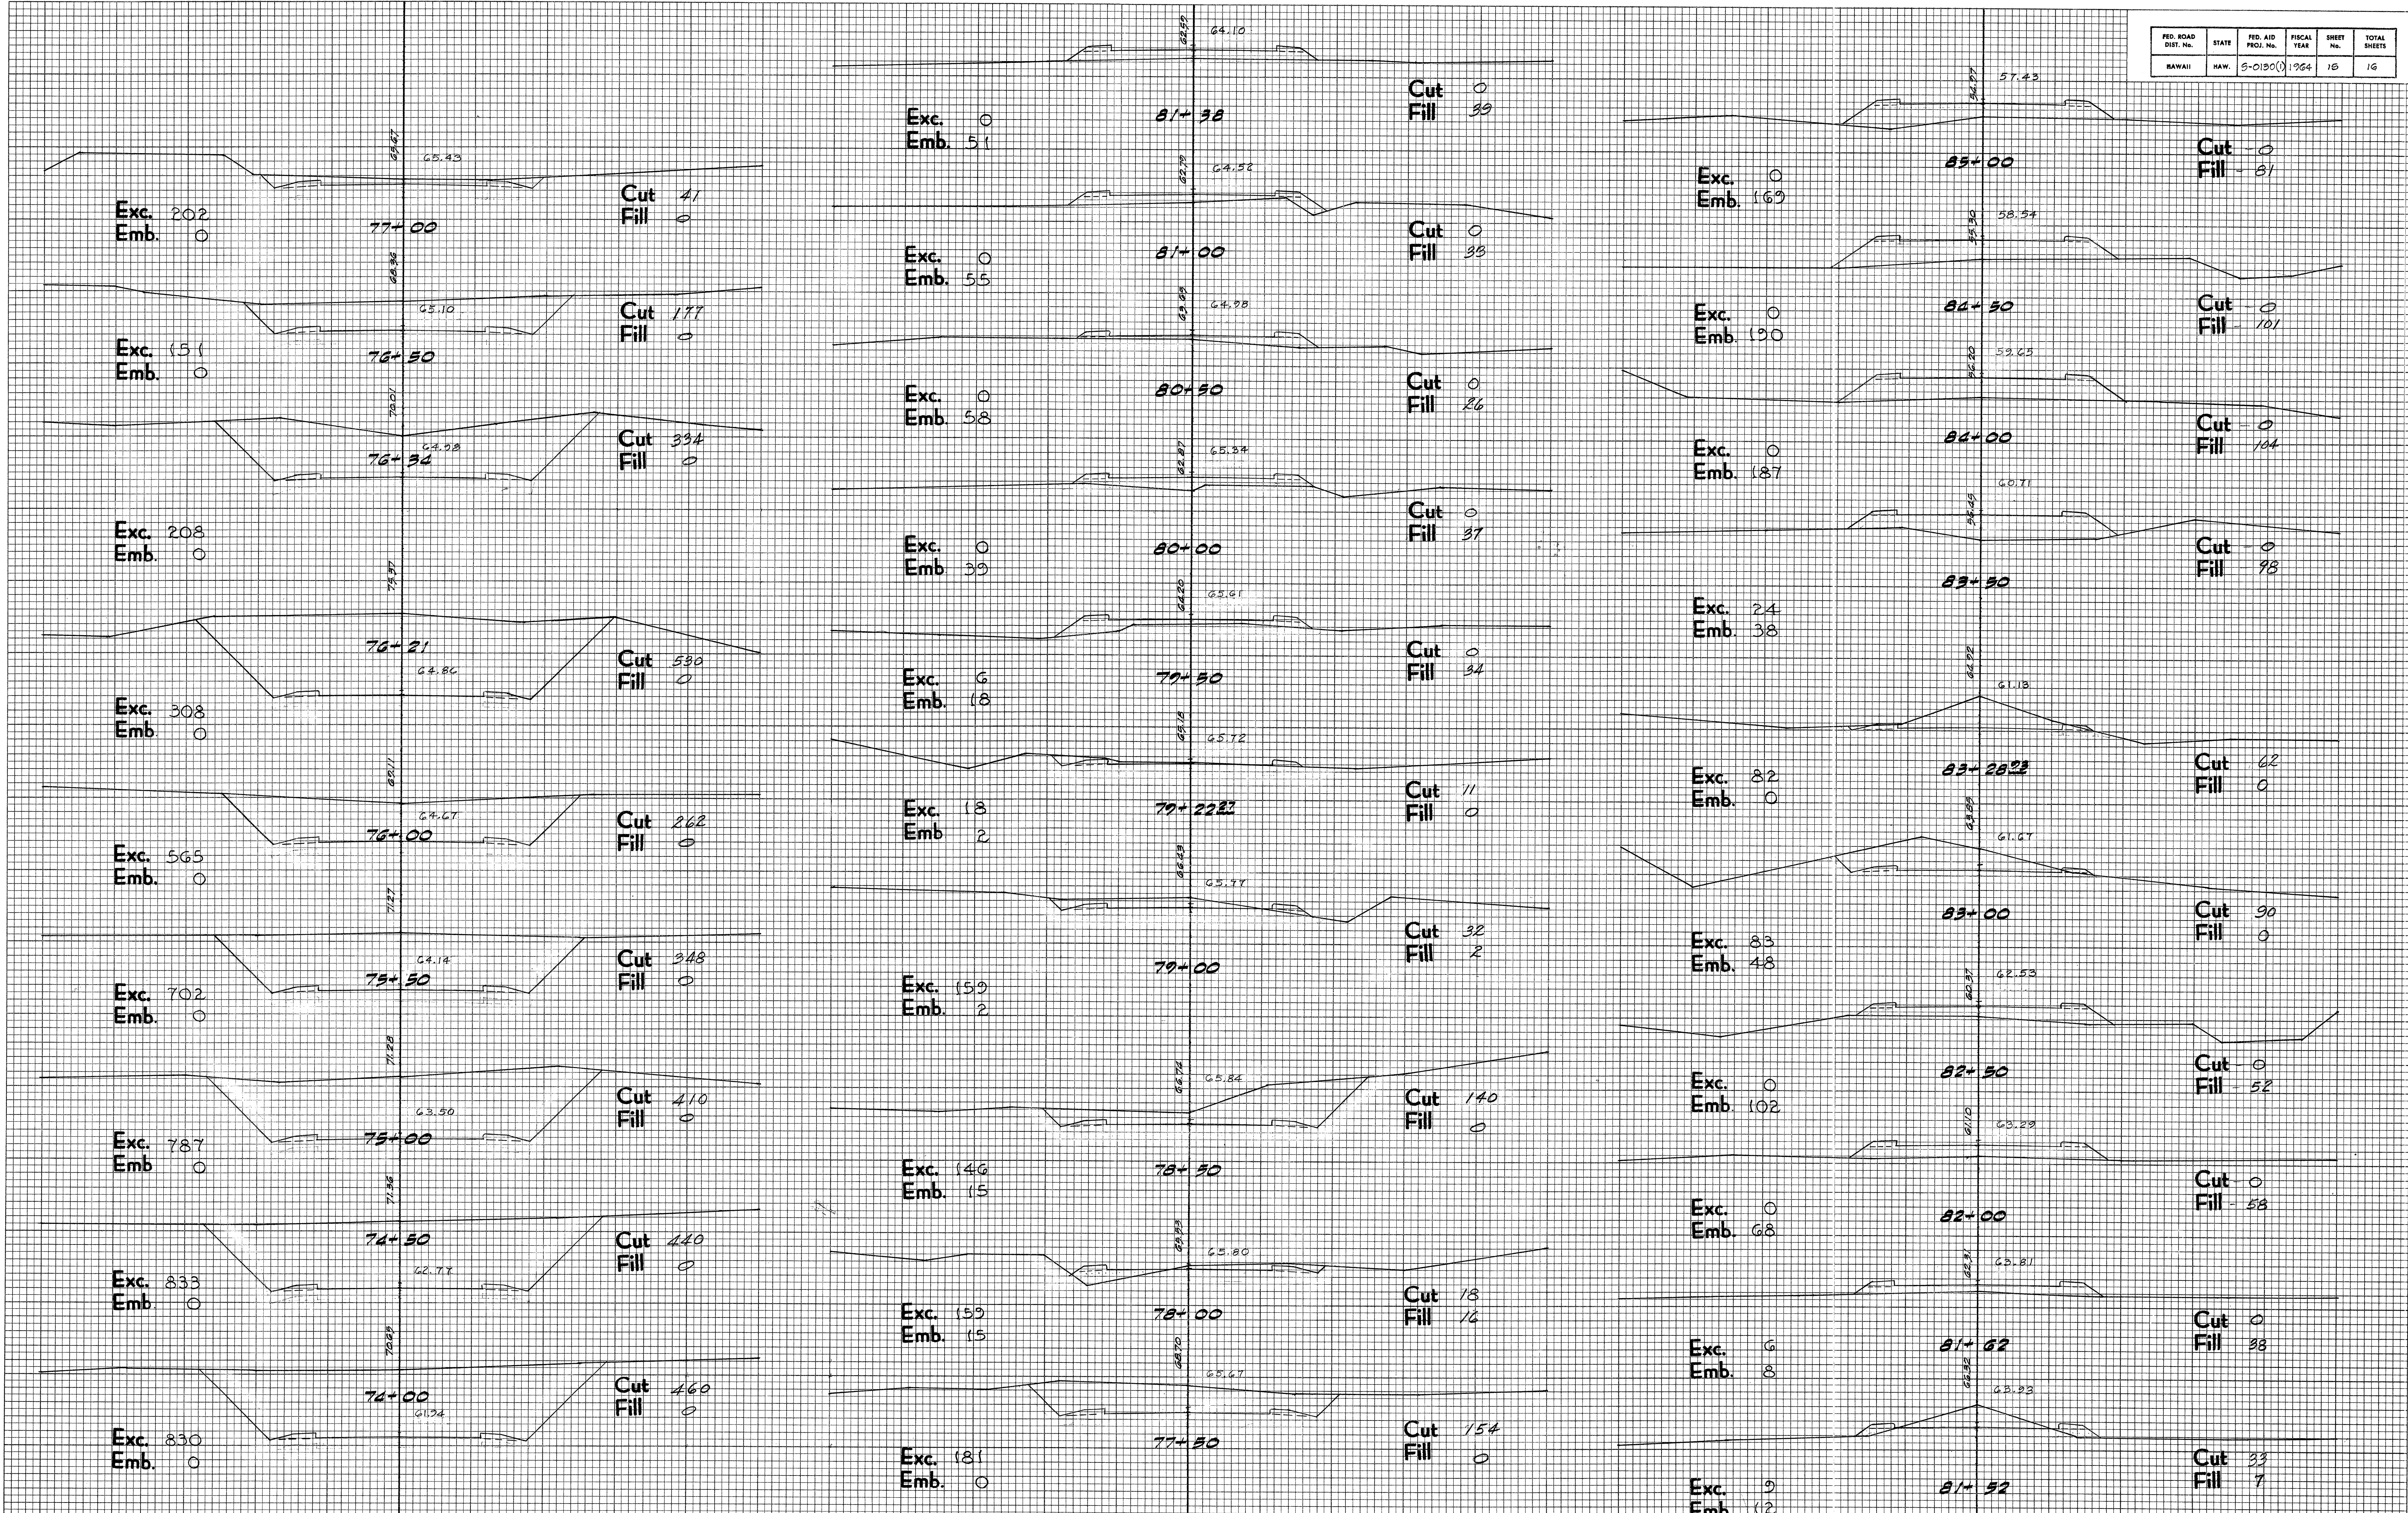


PLATE 3 CROSS SECTION D.P.R. & R.E. STANDARD
100% RAS PAPER-MADE AND PRINTED IN U. S. A.
EUGENE DIETZEN CO.

FINAL SURVEY	DATE	
	BY	
	SURVEYED	
	NOTE BOOK	
	AREAS CHECKED	

ORIGINAL SURVEY	DATE	4-67
	BY	S. KAMALI
	SURVEYED	
	NOTE BOOK	5-31-67
	AREAS CHECKED	5-15-67

FED. ROAD DIST. No.	STATE	FED. AID PROJ. No.	FISCAL YEAR	SHEET No.	TOTAL SHEETS
HAWAII	HAW.	5-01300	1964	16	16

