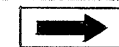



SUMMARY OF REGULATORY & WARNING SIGNS		
TYPE	MESSAGE	QTY
RI-1	STOP	1
WS-1	ROAD NARROWS	1
RM-1	DELINEATOR	9
W1-G		1
TOTAL		12

- GENERAL NOTES**
- Origin of Azimuths and Coordinates are referred to "HAKUNA" (U.S.G.S Sta.) U.S.G.S. 1959 Data adopted.
 - Bench Marks are referred to mean sea level datum.
 - Install $\pm$ Monuments as shown on the plans and staked out by the State.


NOTE



The boring data shown on these profile sheets are for design purposes only and for the convenience of the Engineer in the control of earthwork. The borings were carefully taken and are believed to be reliable but the Engineer does not guarantee the accuracy of same. The Contractor is hereby advised and will be presumed to have made his own investigation on the site prior to submission of his bid.

The State will not be responsible for accuracy of the boring data shown on these sheets.

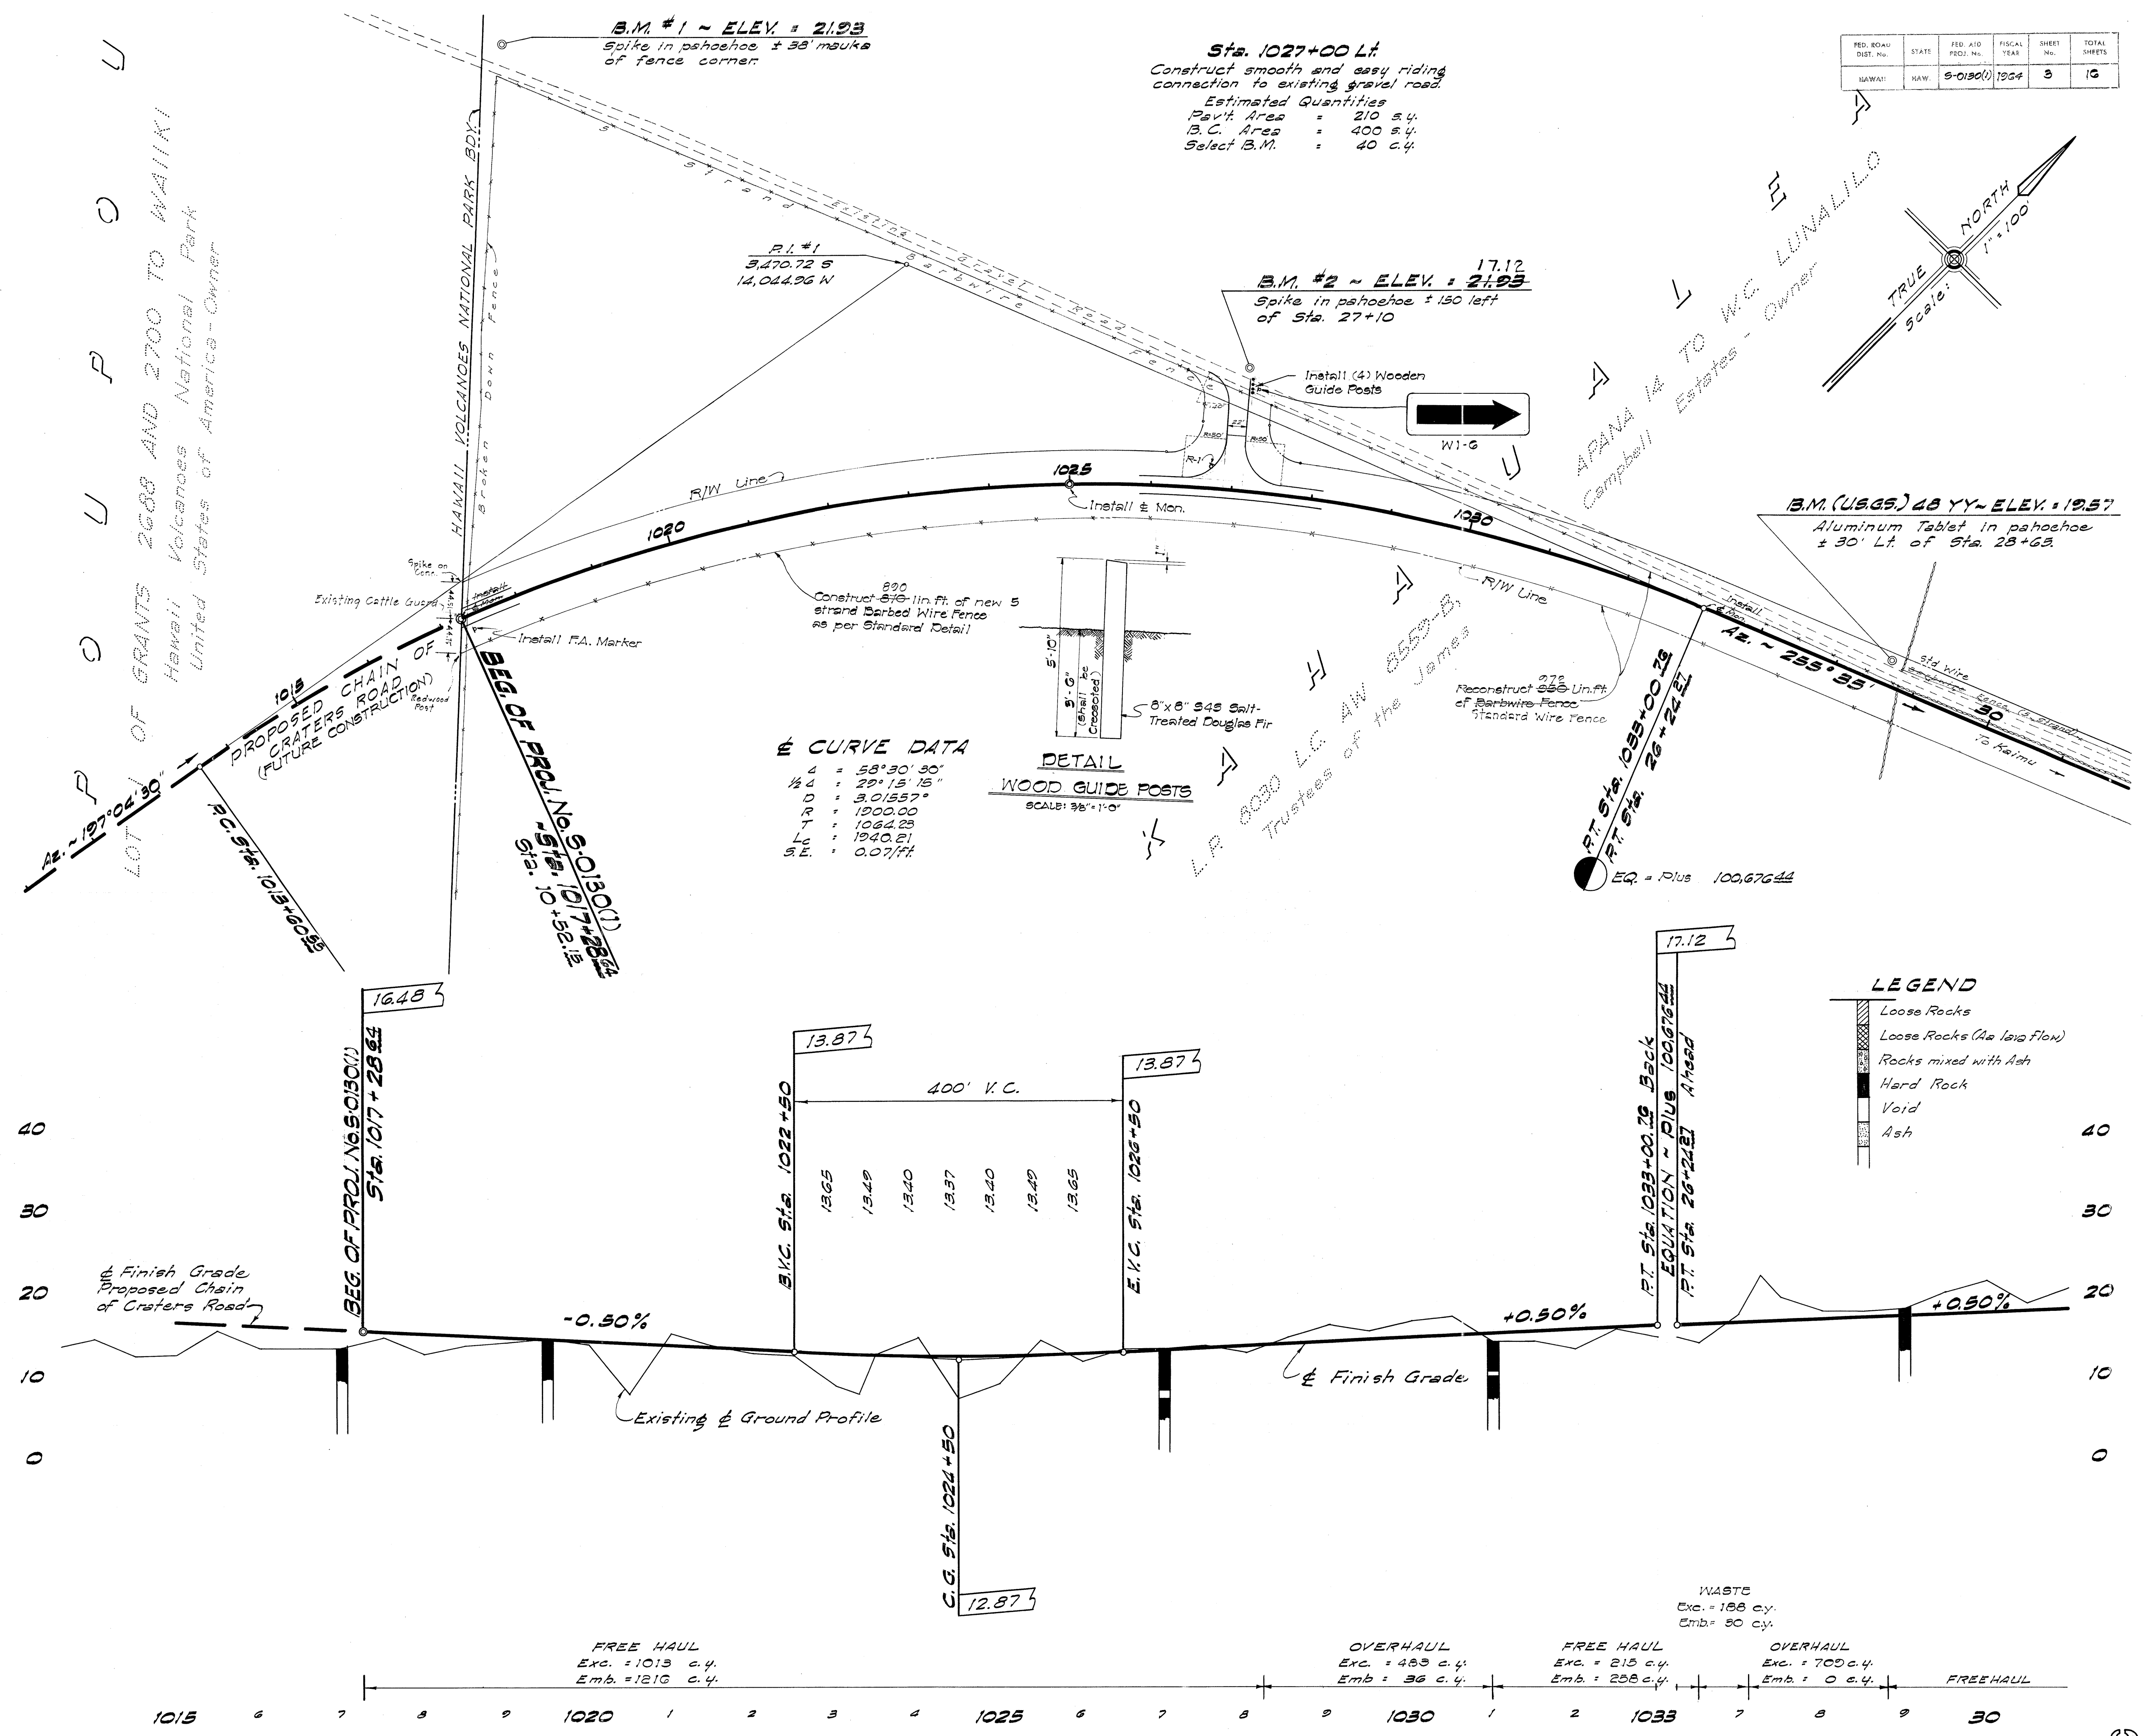

PROJ. ROAD DIST. No.	STATE	FED. AID PROJ. No.	FISCAL YEAR	SHEET No.	TOTAL SHEETS
HAWAII	HAW.	5-0130(1)	1954	3	10


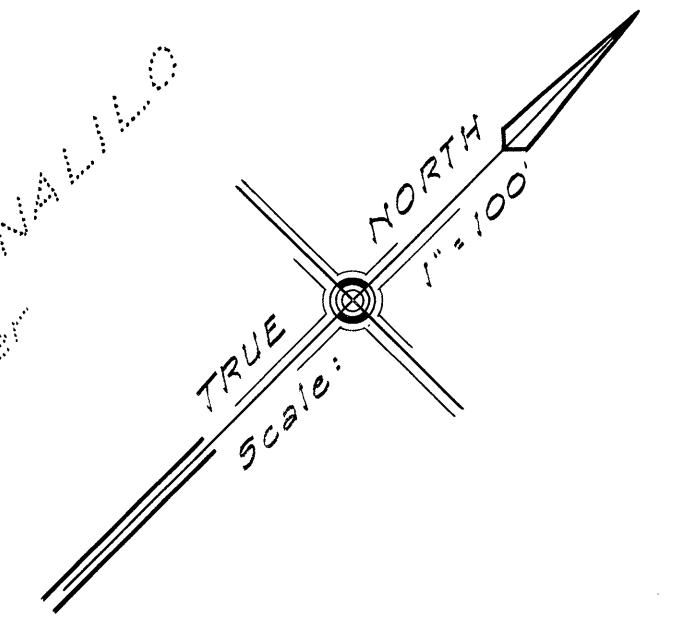


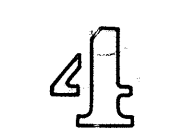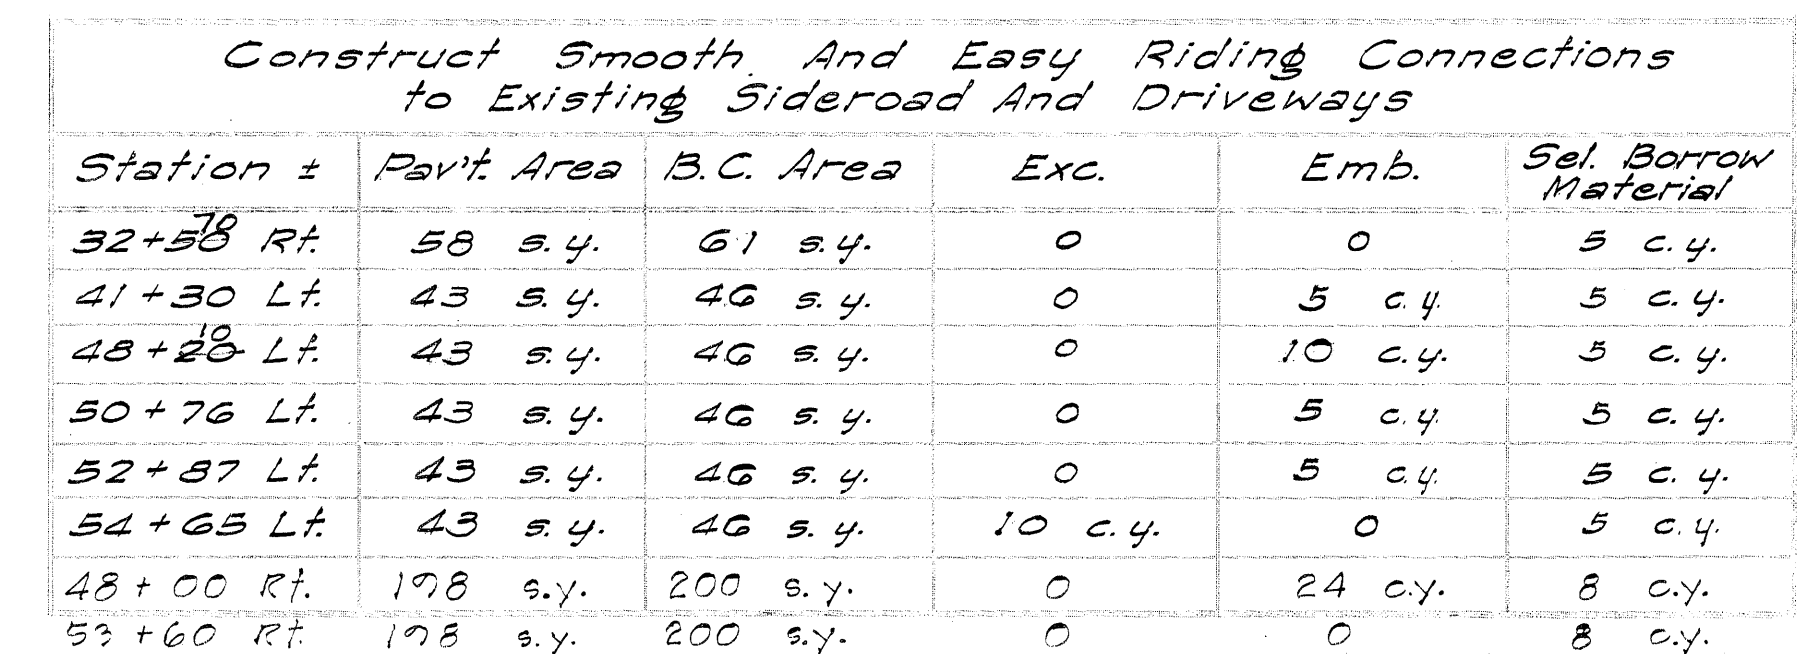


4 CURVE DATA

Δ	=	13° 44'
D	=	1° 00'
R	=	5729.58
T	=	689.97
L_c	=	1373.33
E	=	41.40
$S.E.$	=	0.022/ft.

FED. ROAD DIST. NO.	STATE	FED. AID PROJ. NO.	FISCAL YEAR	SHEET NO.	TOTAL SHEETS
HAWAII	HAW.	5-0130(1)	1964	5	16

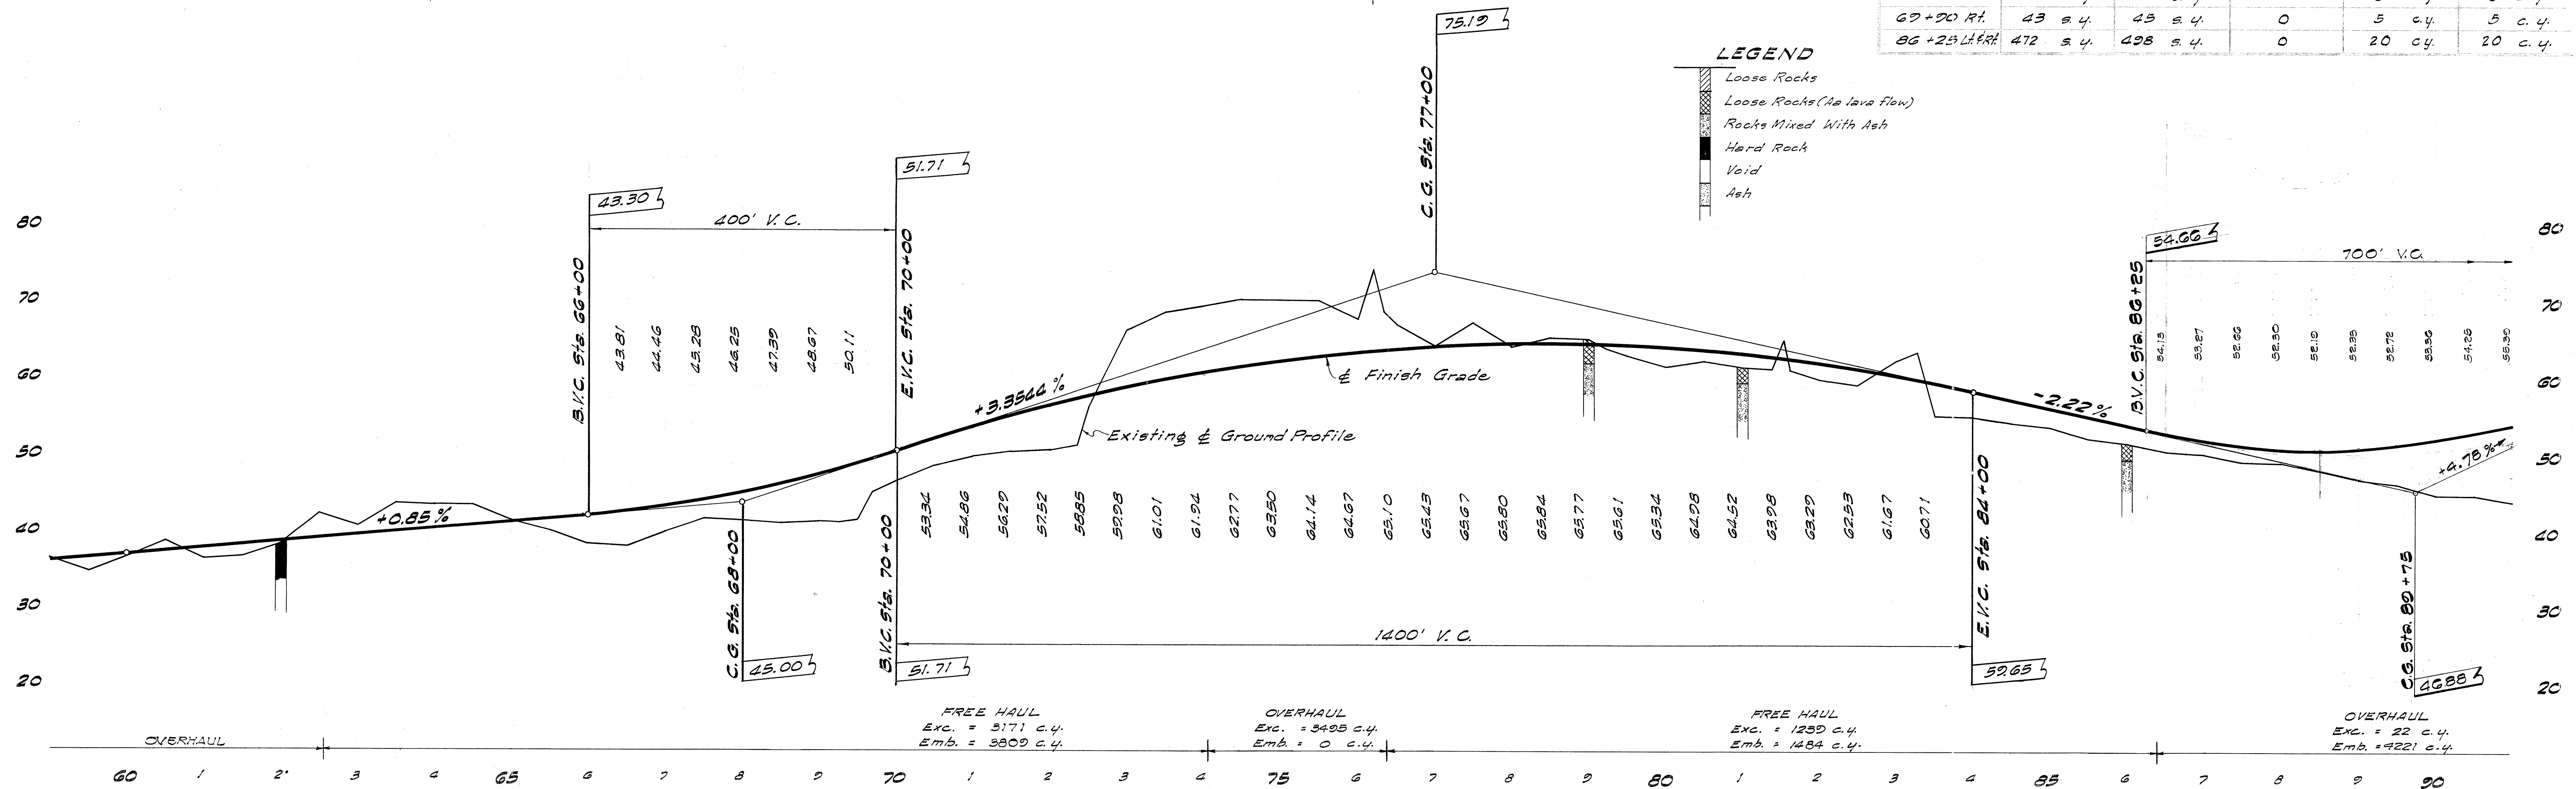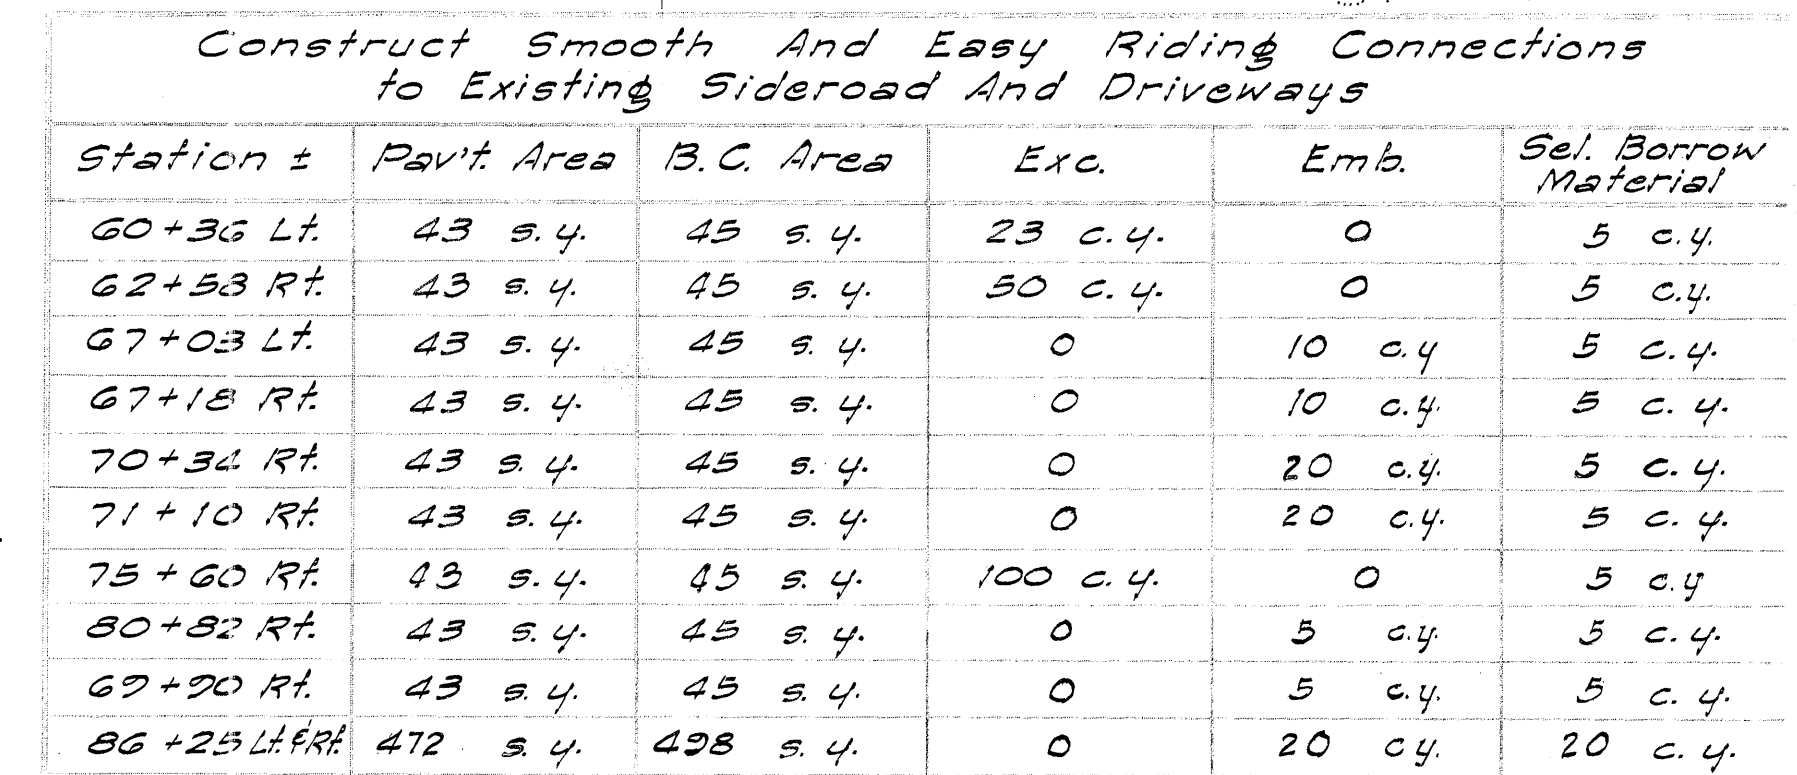


FED. ROAD DIST. NO.	STATE	FED. AID PROJ. NO.	FISCAL YEAR	SHEET NO.	TOTAL SHEETS
HAWAII	HAW.	5-0130(1)	1964	6	16

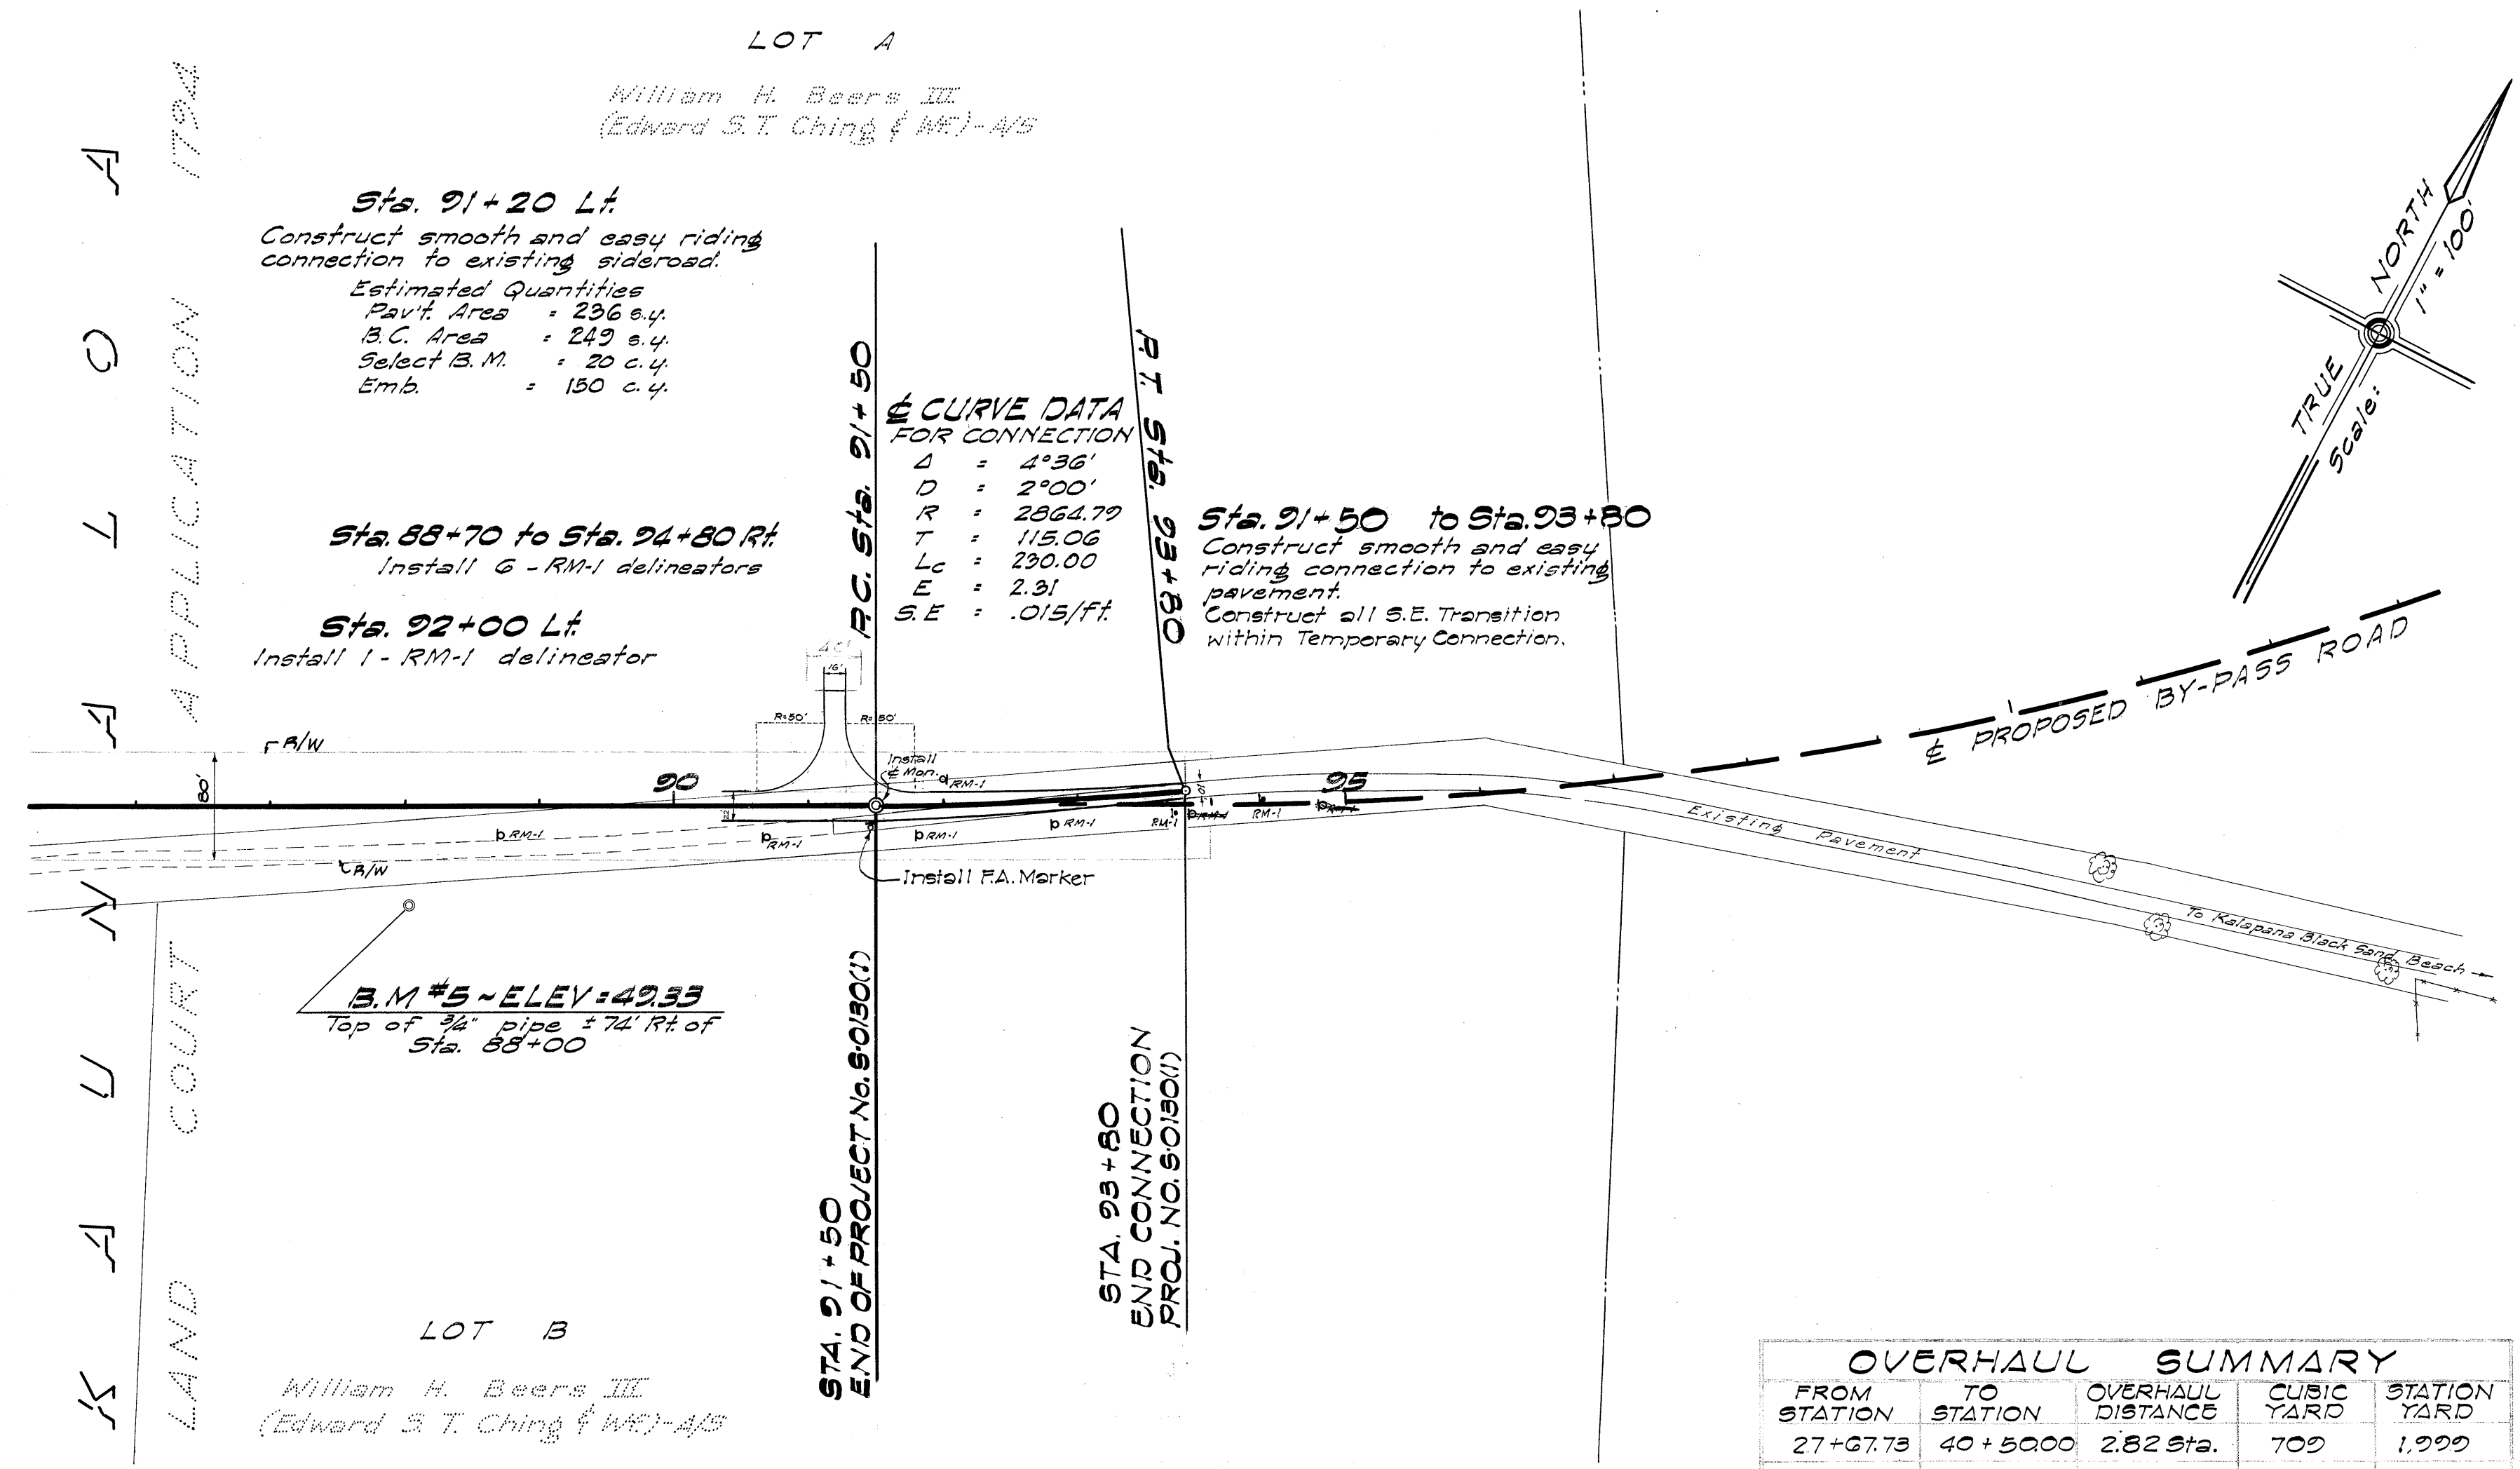

OVERHAUL SUMMARY


FROM STATION	TO STATION	OVERHAUL DISTANCE	CUBIC YARD	STATION YARD
27+67.73	40+50.00	2.82 Sta.	709	1,999
57+50.00	44+50.00	3.14 Sta.	1,836	5,765
75+11.61	90+90.46	5.79 Sta.	3,495	20,236
TOTAL				28,000

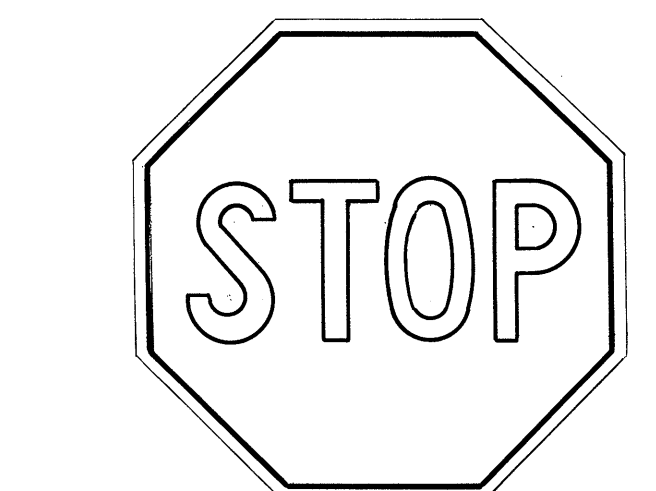

R1-1 30" x 30"



W5-1 30" x 30"

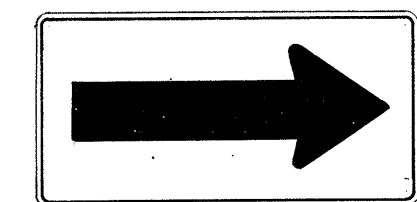

W1-6 48" x 24"


- CONSTRUCTION IDENTIFICATION SIGN NOTES
- The legend shall be black on white background.
 - All letters shall be of size and design shown and shall conform with "Standard Alphabets for Highway Signs" as set forth by the Public Roads Administration, Federal Work Agency.
 - Letters shall be Series "D" sizes as shown on the plan.
 - Contractor shall fill in proper figures in place of Ciphers as ordered by the State Department of Transportation.

YOUR HIGHWAY TAXES AT WORK


FEDERAL HIGHWAY TRUST FUNDS	STATE HIGHWAY FUNDS
\$0,000,000	\$0,000,000
U.S. DEPT OF COMMERCE	HAWAII STATE
Bureau of Public Roads	HIGHWAYS DIVISION

HAWAII 13


PLAN VIEW
Not to Scale

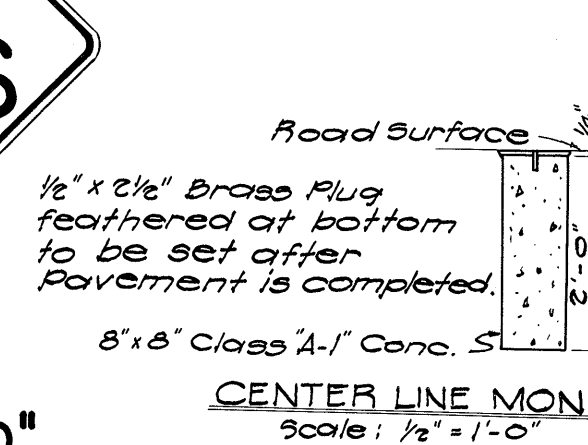

CENTER LINE MONUMENT
Scale: 1/2" = 1'-0"

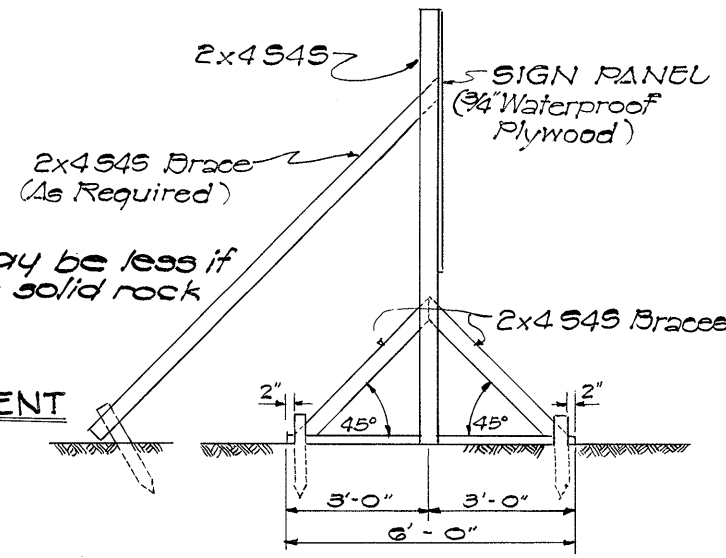

SIDE VIEW

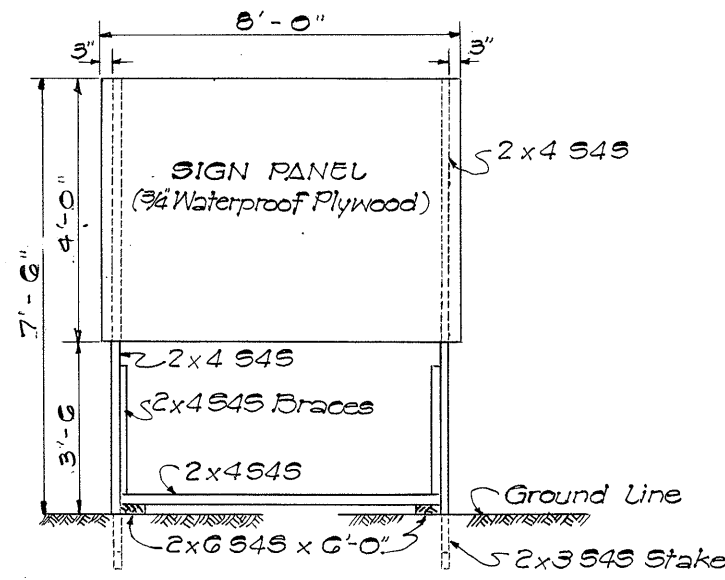

FRONT VIEW

ELEVATIONS
CONSTRUCTION IDENTIFICATION SIGN
Not to Scale

- NOTE: (Regulatory and Warning Signs)
- The Shape, Color, dimensions, symbols, wording, lettering and reflectorization of all signs shall be in accordance with the "Manual on Uniform Traffic Control Devices for Streets and Highways" dated June 1961, and the BPR Manual "Standard Highway Signs" dated September 1961 unless otherwise specified.
 - All Signs shall be Reflectorized.
 - All Signs shall have 3/8" bolt holes at appropriate location.

