

INDEX TO DRAWINGS	
SHEET	DESCRIPTION
1	TITLE SHEET
2	TYPICAL SECTIONS
3-6	PLAN & PROFILE
7-8	STANDARD DETAILS
9-16	CROSS SECTIONS

STATE OF HAWAII
DEPARTMENT OF TRANSPORTATION
HIGHWAYS DIVISION

"AS BUILT" PLANS OF A PORTION OF


CHAIN OF CRATERS ROAD

HAWAII NATIONAL PARK BOUNDARY TO KAUNALOA
F.A.S. PROJECT NO. S-0130(1)

DISTRICT OF PUNA
ISLAND OF HAWAII

SCALES

PLAN	-----	1 INCH = 100 FT.
PROFILE	-----	HOR. 1 INCH = 100 FT.
	-----	VER. 1 INCH = 10 FT.
GROSS SECTION	-----	HOR. 1 INCH = 10 FT.
	-----	VER. 1 INCH = 10 FT.

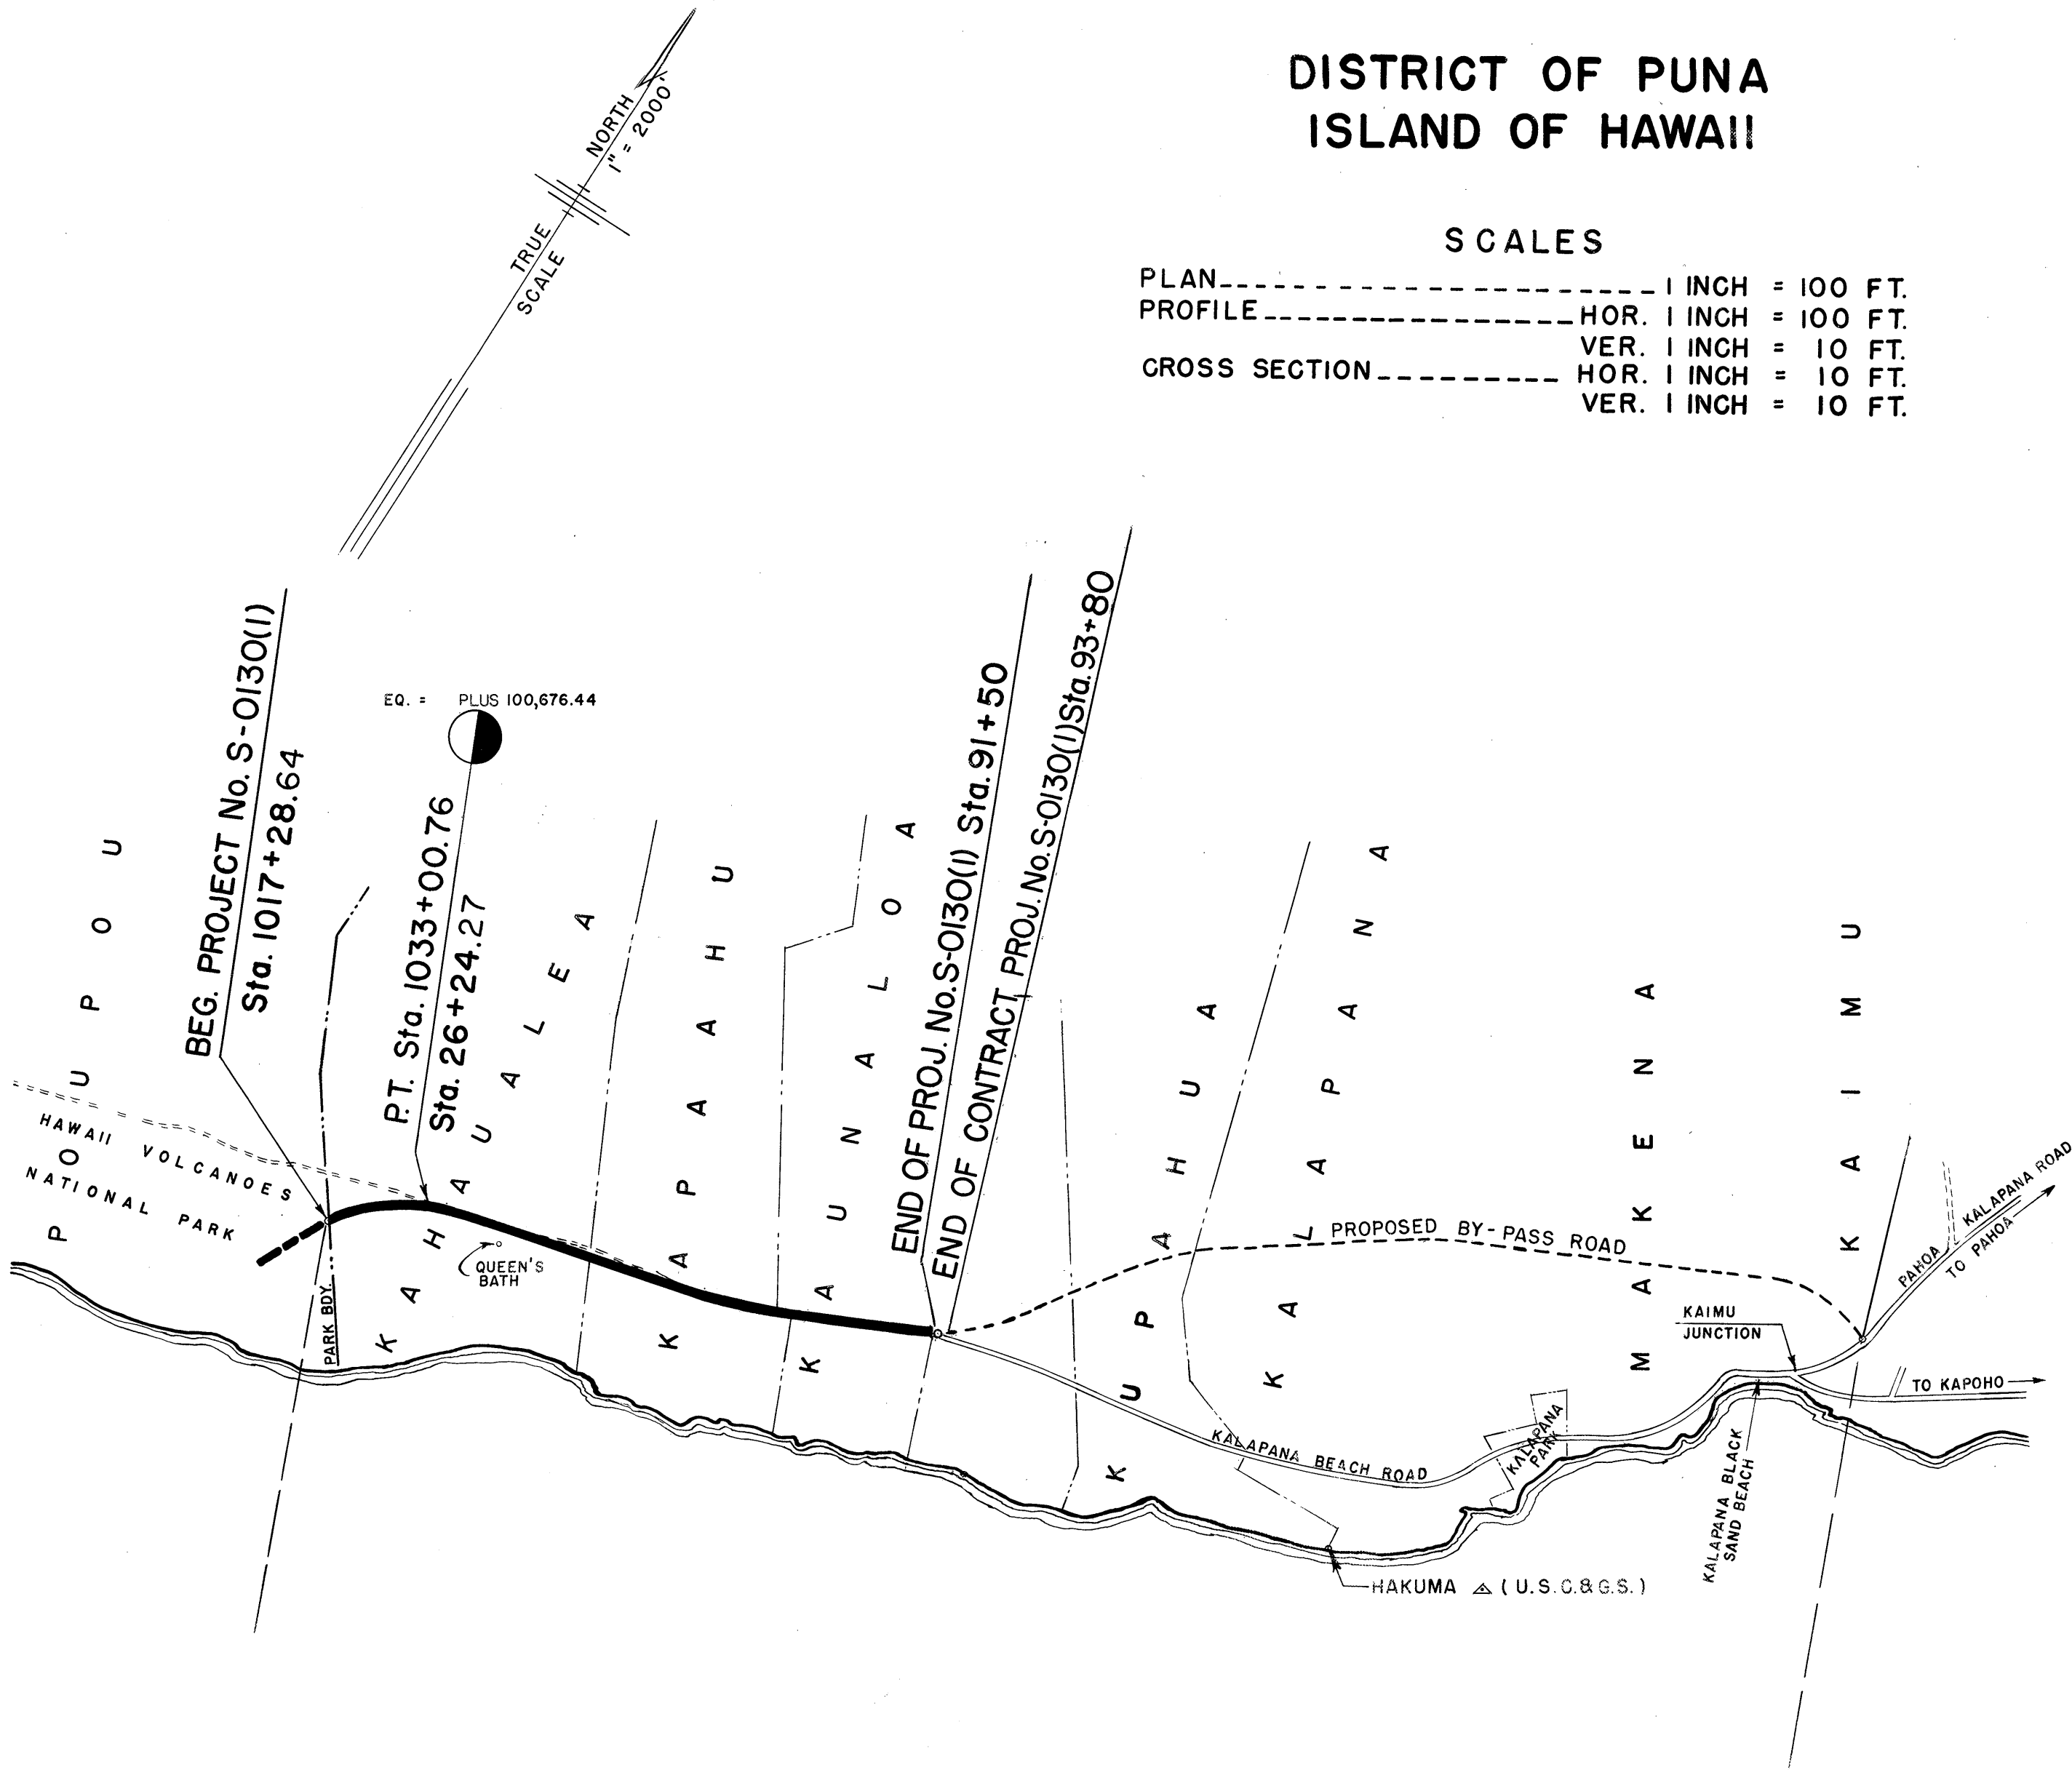

NOTE:

ALL CHANGES MADE DURING CONSTRUCTION
HAVE BEEN NOTED IN RED ON THESE
TRACINGS AND CHECKED BY

Harumi Okamura
PROJECT ENGINEER

DATE 2/28/68


DESIGN CLASSIFICATION

ADT	1963	= 112
ADT	1983	= 340
DHV		= 10 %
D		= 45/55
T		= 10 %
V		= 60 MPH

LAYOUT OF PROJECT

LENGTH OF PROJECT No. S-0130(1)1.534 Miles

LOCATION PLAN
SCALE: 1" = 2000'

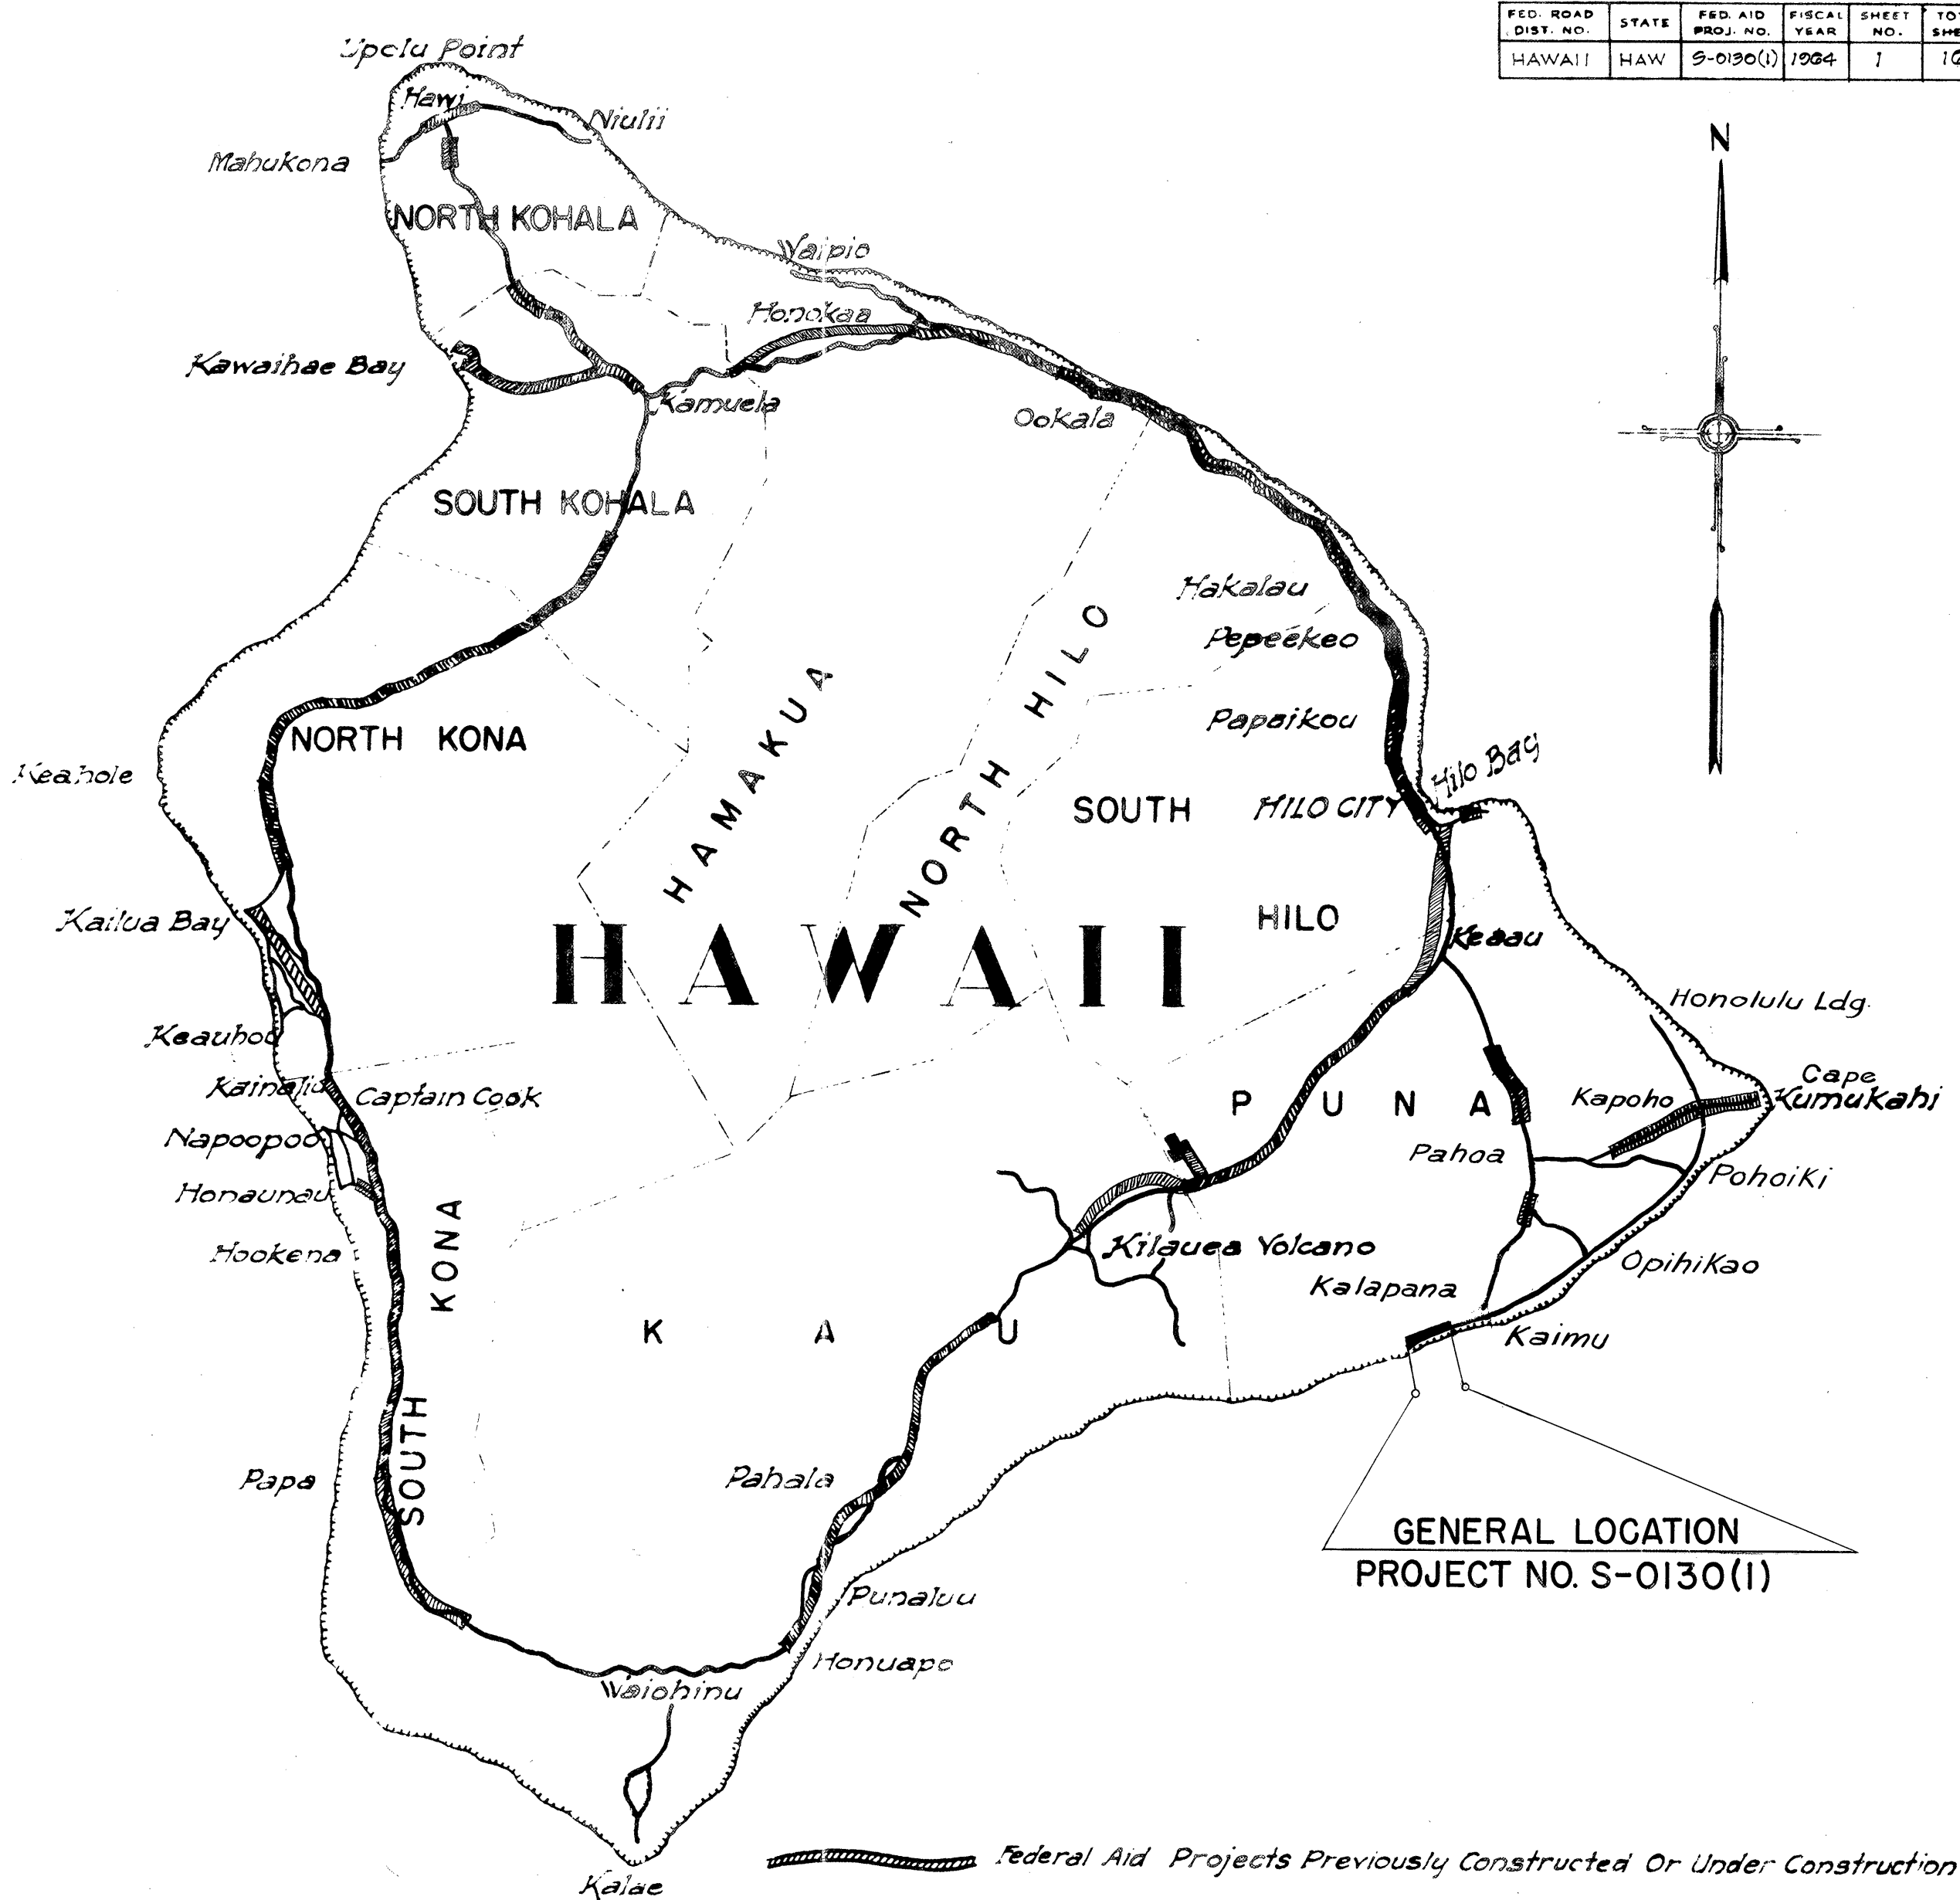

APPROVED: DATE 18 Feb 68

Luis Uchida
DIRECTOR OF TRANSPORTATION

DEPARTMENT OF COMMERCE
BUREAU OF PUBLIC WORKS

APPROVED: _____

DIVISION ENGINEER DATE