
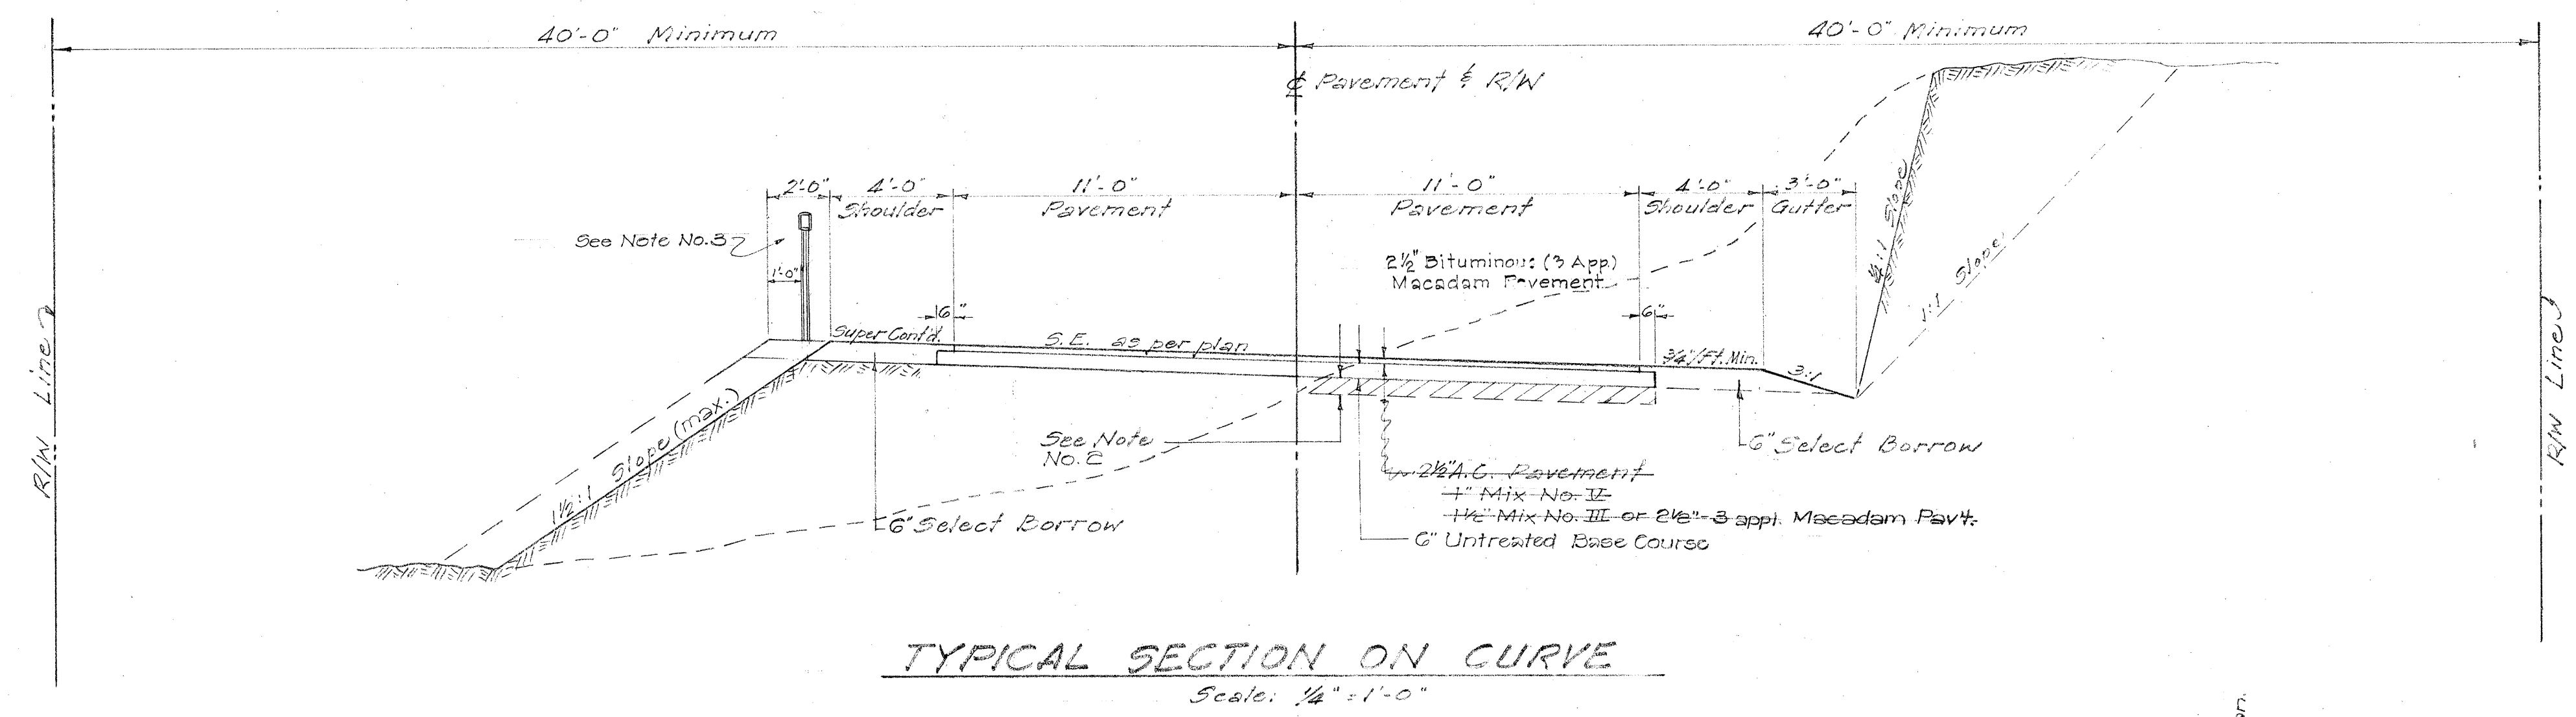



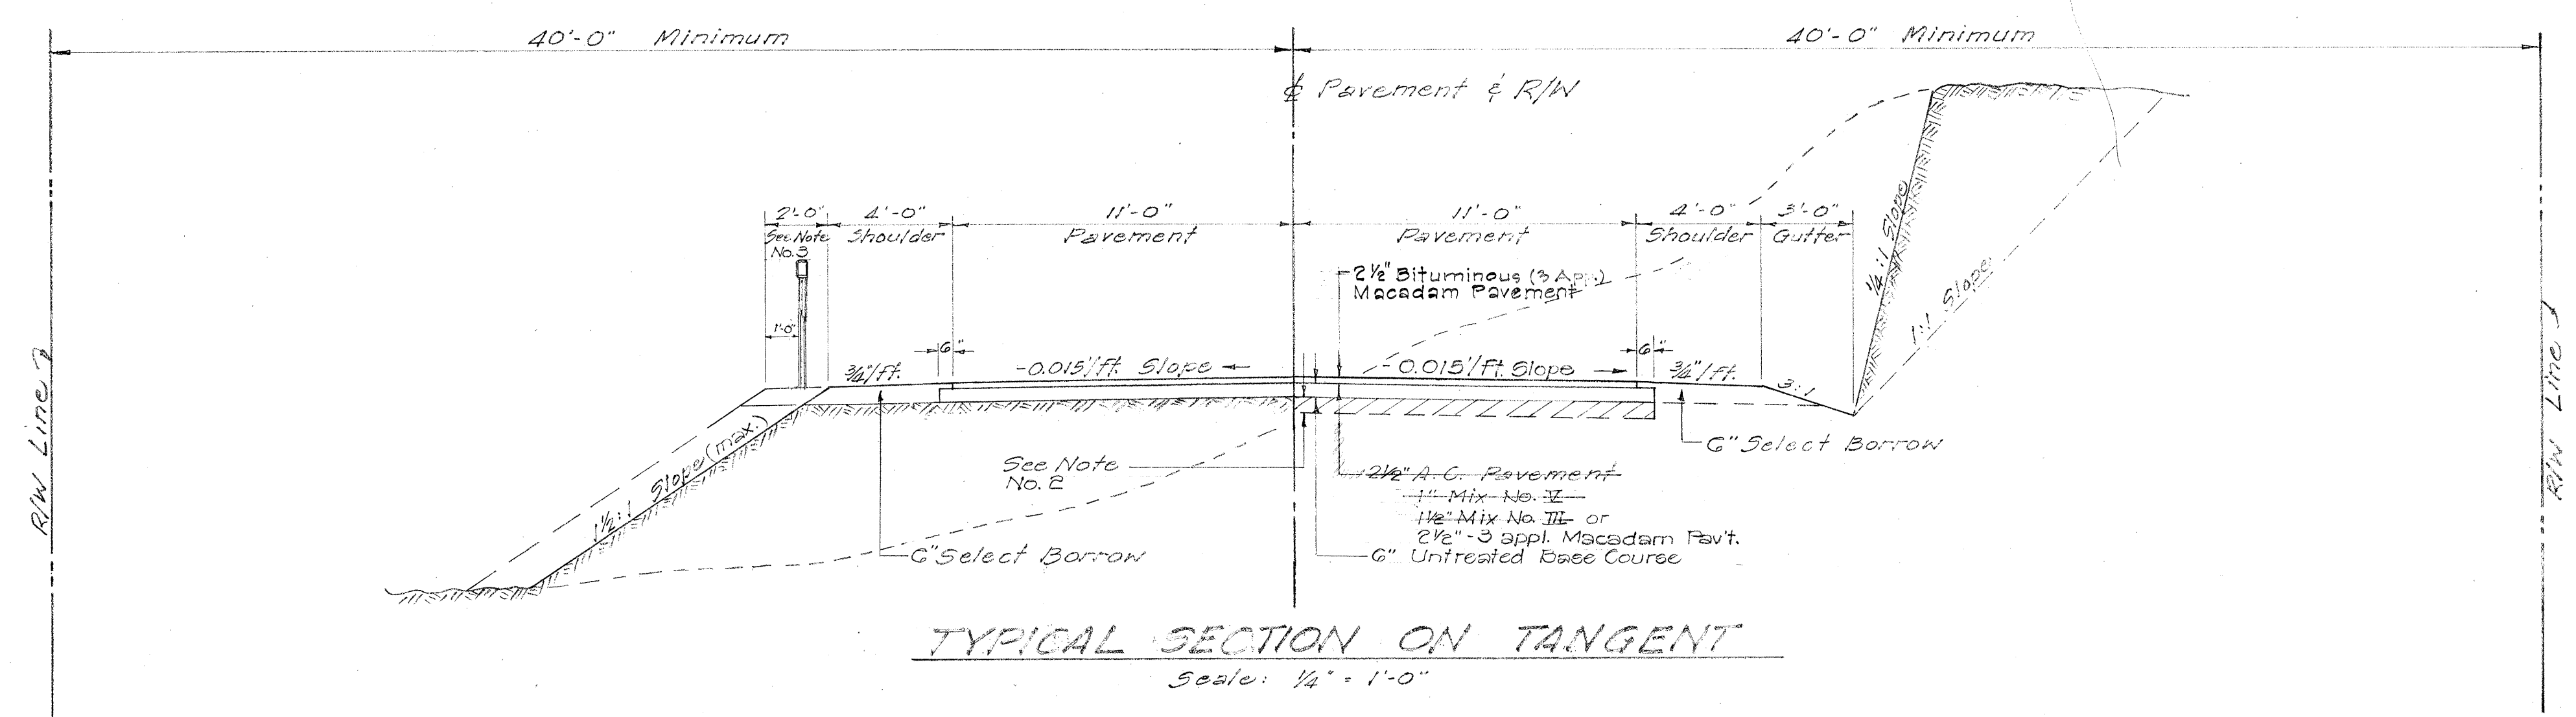


- GENERAL NOTES**
1. Cut Slopes in Rock shall be 1/4:1, otherwise the slopes shall be flattened to 1:1.
 2. In rock excavation, the rocks shall be loosened and broken up to a depth 6" below the bottom of the base course.
 3. Where Delimiters are to be installed shoulders shall be widened 2 ft.
 4. Shoulders shall be dressed with select borrow and primed with slow curing liquid asphalt at the approx. rate of 0.35 gal. per sq. yd.

FILL SLOPE TABLE

Height of Fill Feet	Fill Slope
0' - 4'	4:1
4' - 10'	3:1 to 2:1
10' - Over	1 1/2 to 1

NOTE:
R/W requirements supersede above Table.

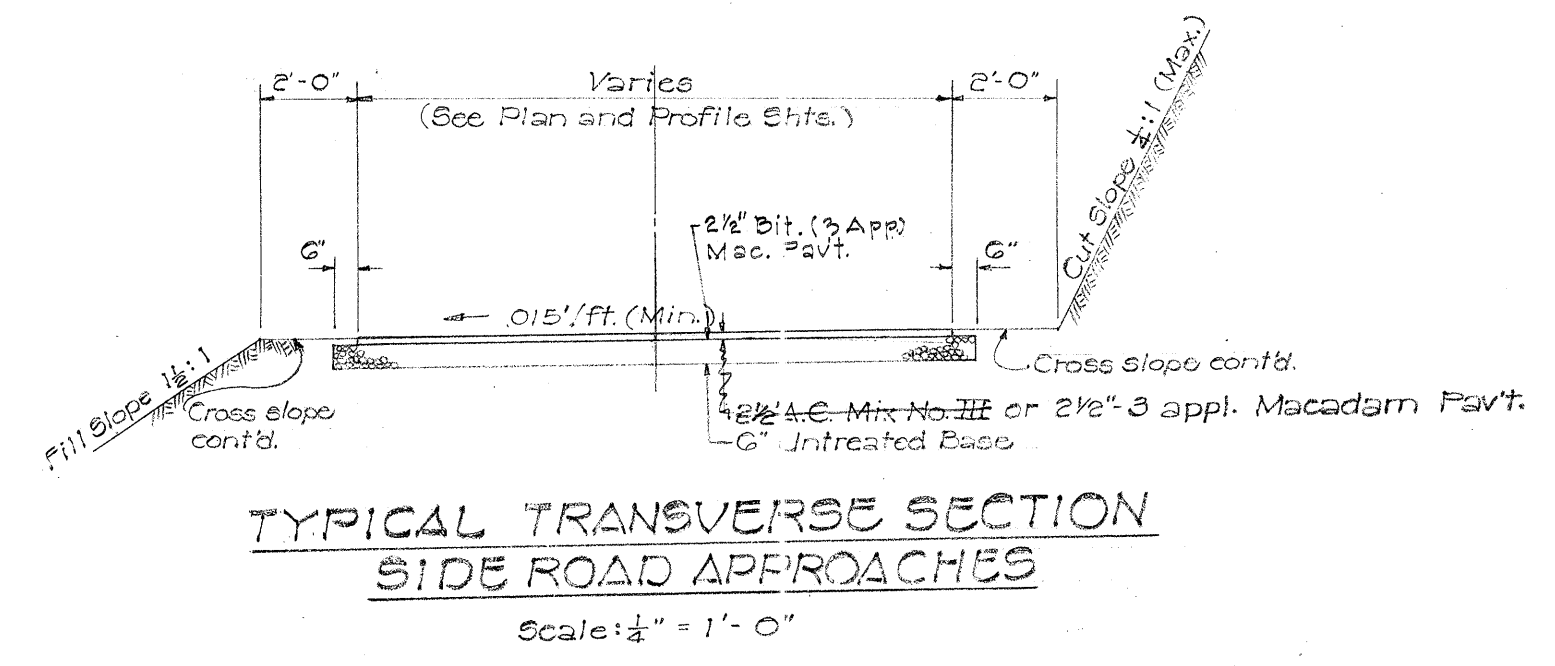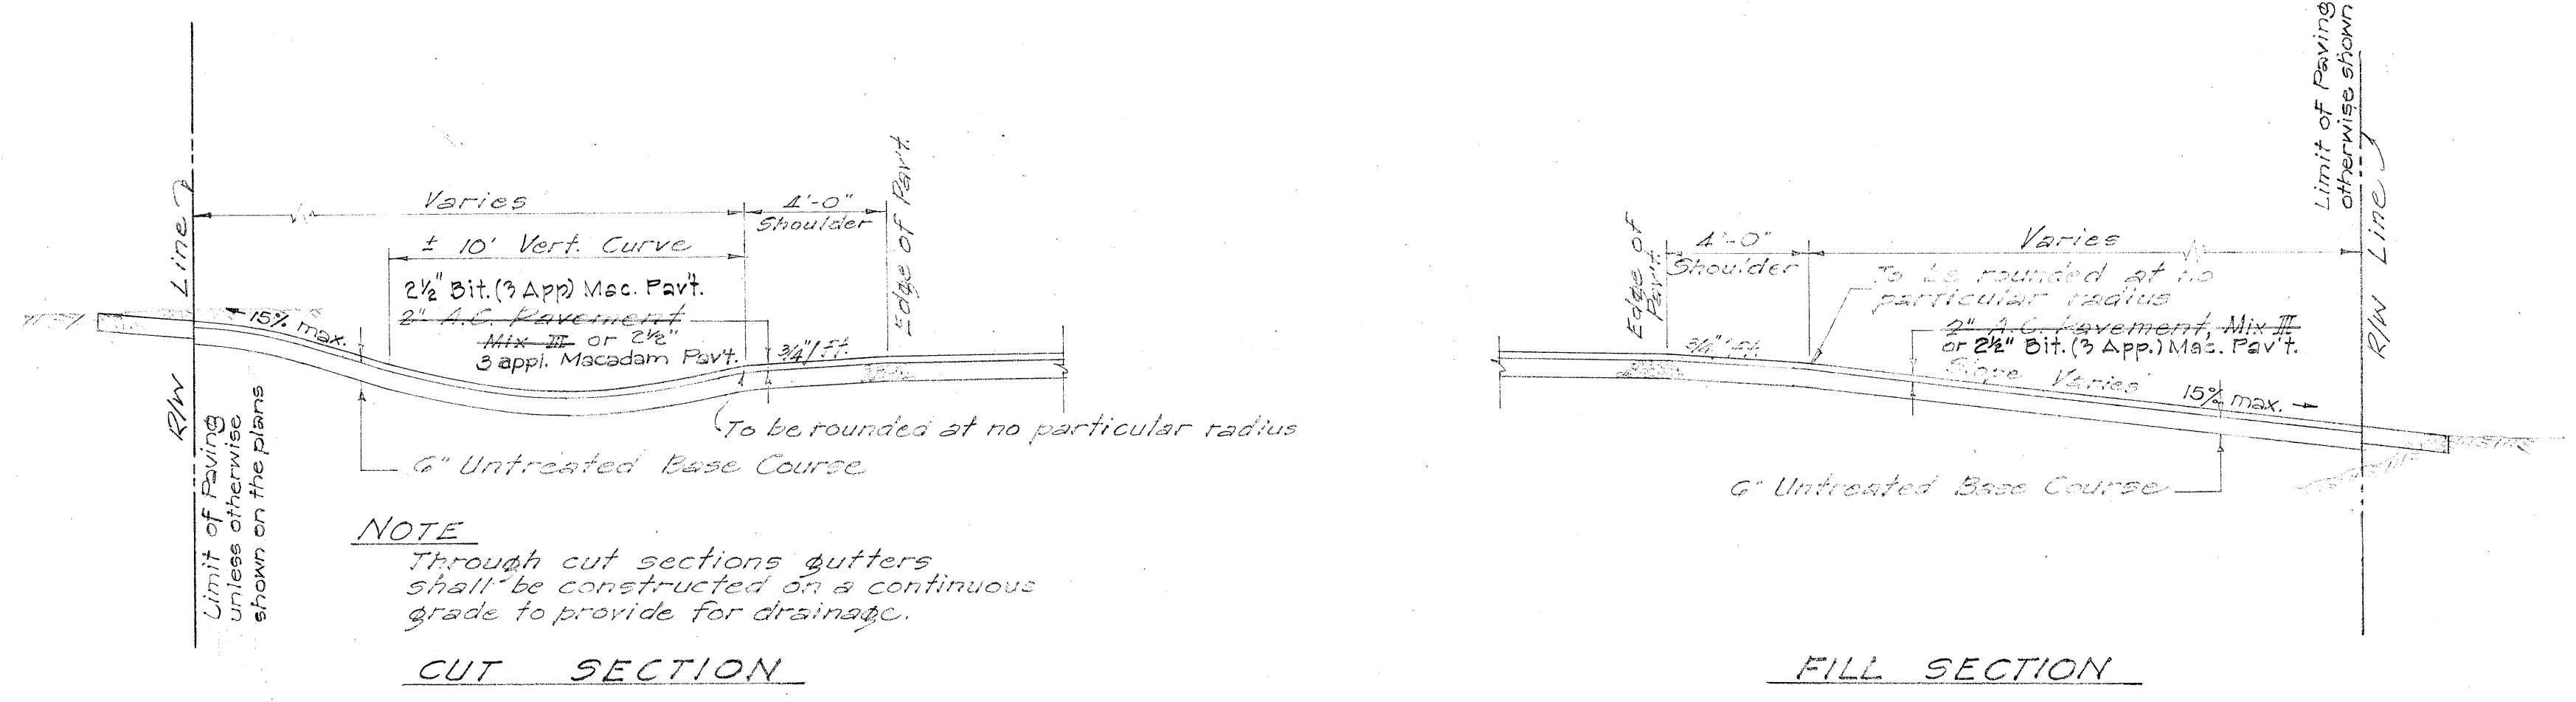

NOTE: Side road Cross Slopes shall be in same direction as Profile Slope of adjacent Highway.