

INDEX TO DRAWINGS	
SHEET	DESCRIPTION
1	TITLE SHEET
2	TYPICAL SECTIONS
3-4	PLAN AND PROFILE
5-6	ROADWAY DETAIL PLAN
7	DRAINAGE DETAILS
8-13	DESTINATION & TRAFFIC SIGNS
14	DEMOLITION OF BUILDINGS
15-16	CROSS-SECTIONS
17-19	STANDARD DETAIL

STATE OF HAWAII
DEPARTMENT OF TRANSPORTATION
HIGHWAYS DIVISION
AS BUILT
PLANS OF
KEAAU - PAHOA ROAD JUNCTION
FEDERAL AID SECONDARY PROJECT NO. S-0130(2)

DISTRICT OF PUNA
ISLAND OF HAWAII

SCALES

PLAN

PROFILE

CROSS SECTION


1 INCH = 50 FT.

HOR. 1 INCH = 50 FT.

VER. 1 INCH = 5 FT.

HOR. 1 INCH = 10 FT.

VER. 1 INCH = 10 FT.

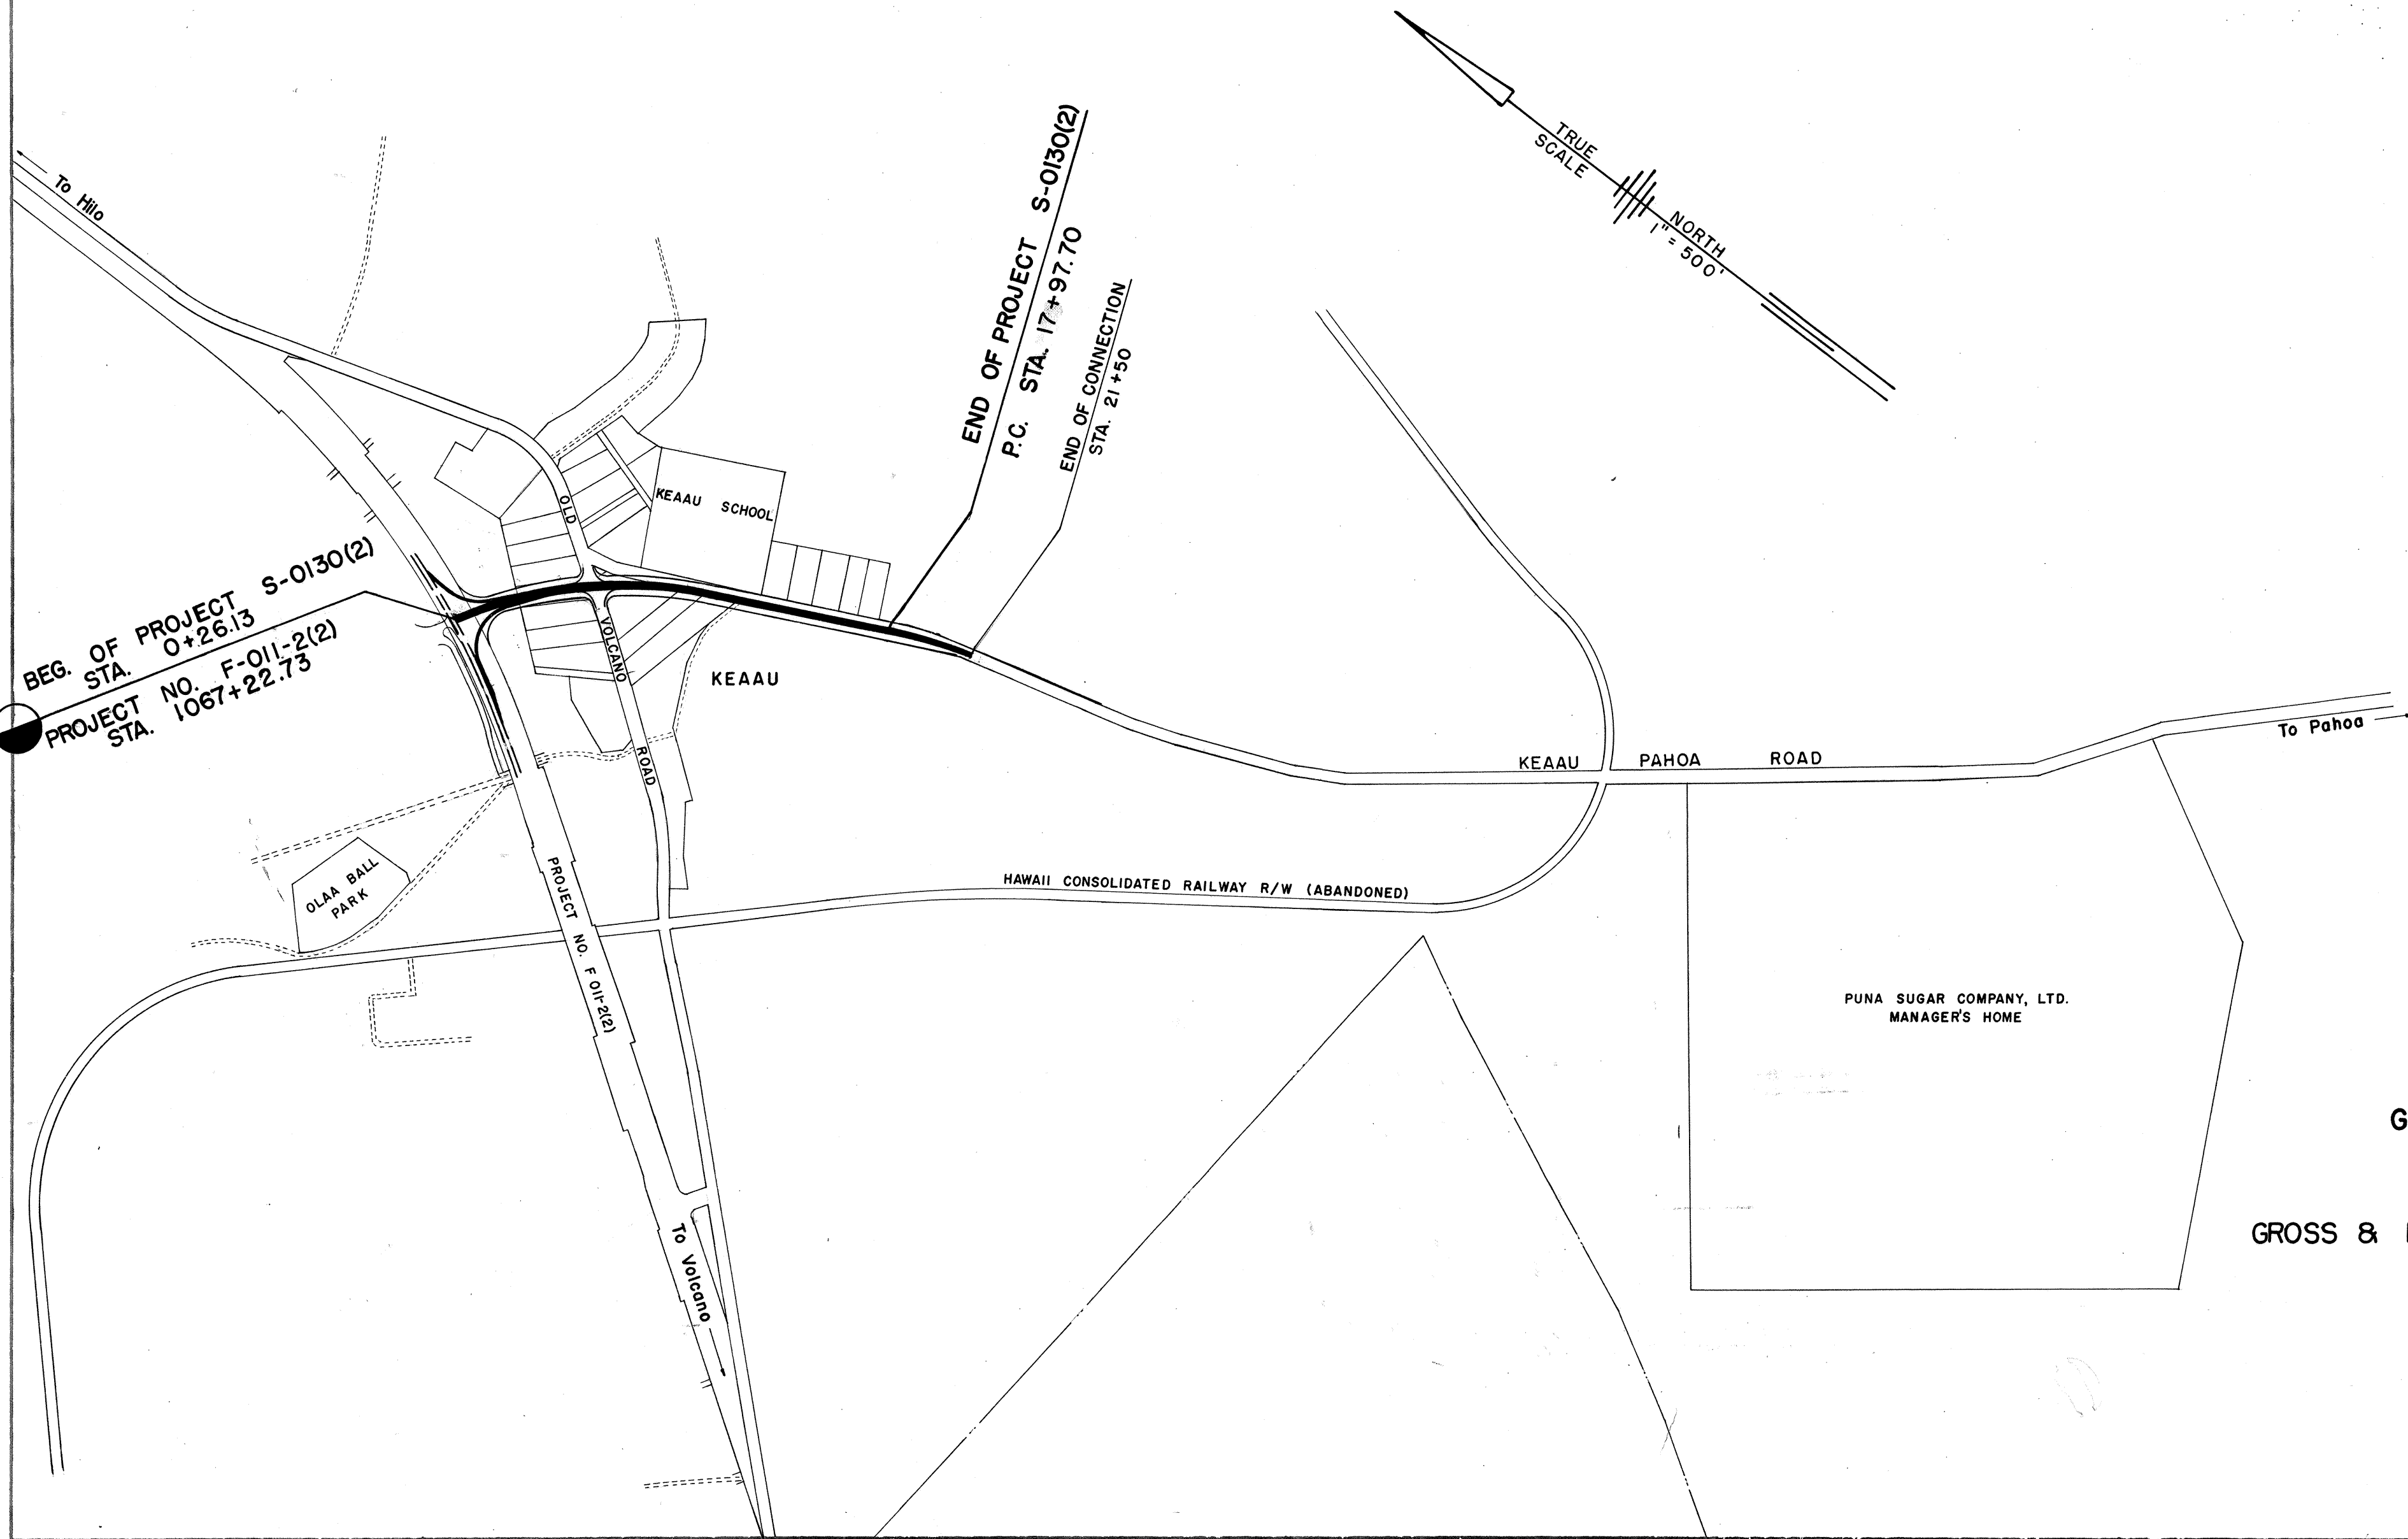

NOTE:
ALL CHANGES MADE DURING CONSTRUCTION
HAVE BEEN NOTED ON THESE TRACINGS IN
RED AND CHECKED BY:

Steve Nishimoto

PROJECT ENGINEER

Nov 23 1966

DATE

GENERAL LOCATION PLAN

GROSS & NET LENGTH OF PROJECT: 0.335 MILE

APPROVED:

DATE 11 Apr 67

DEPARTMENT OF COMMERCE
BUREAU OF PUBLIC ROADS

APPROVED: