

INDEX TO DRAWINGS	
SHEET	DESCRIPTION
1	Title Sheet
2	Typical Section

STATE OF HAWAII

DEPARTMENT OF TRANSPORTATION

HIGHWAYS DIVISION

"AS BUILT"



PLANS OF

RESURFACING OF KALAPANA BEACH ROAD

PROJECT NO. A-130-01-60

DISTRICT OF PUNA

ISLAND OF HAWAII

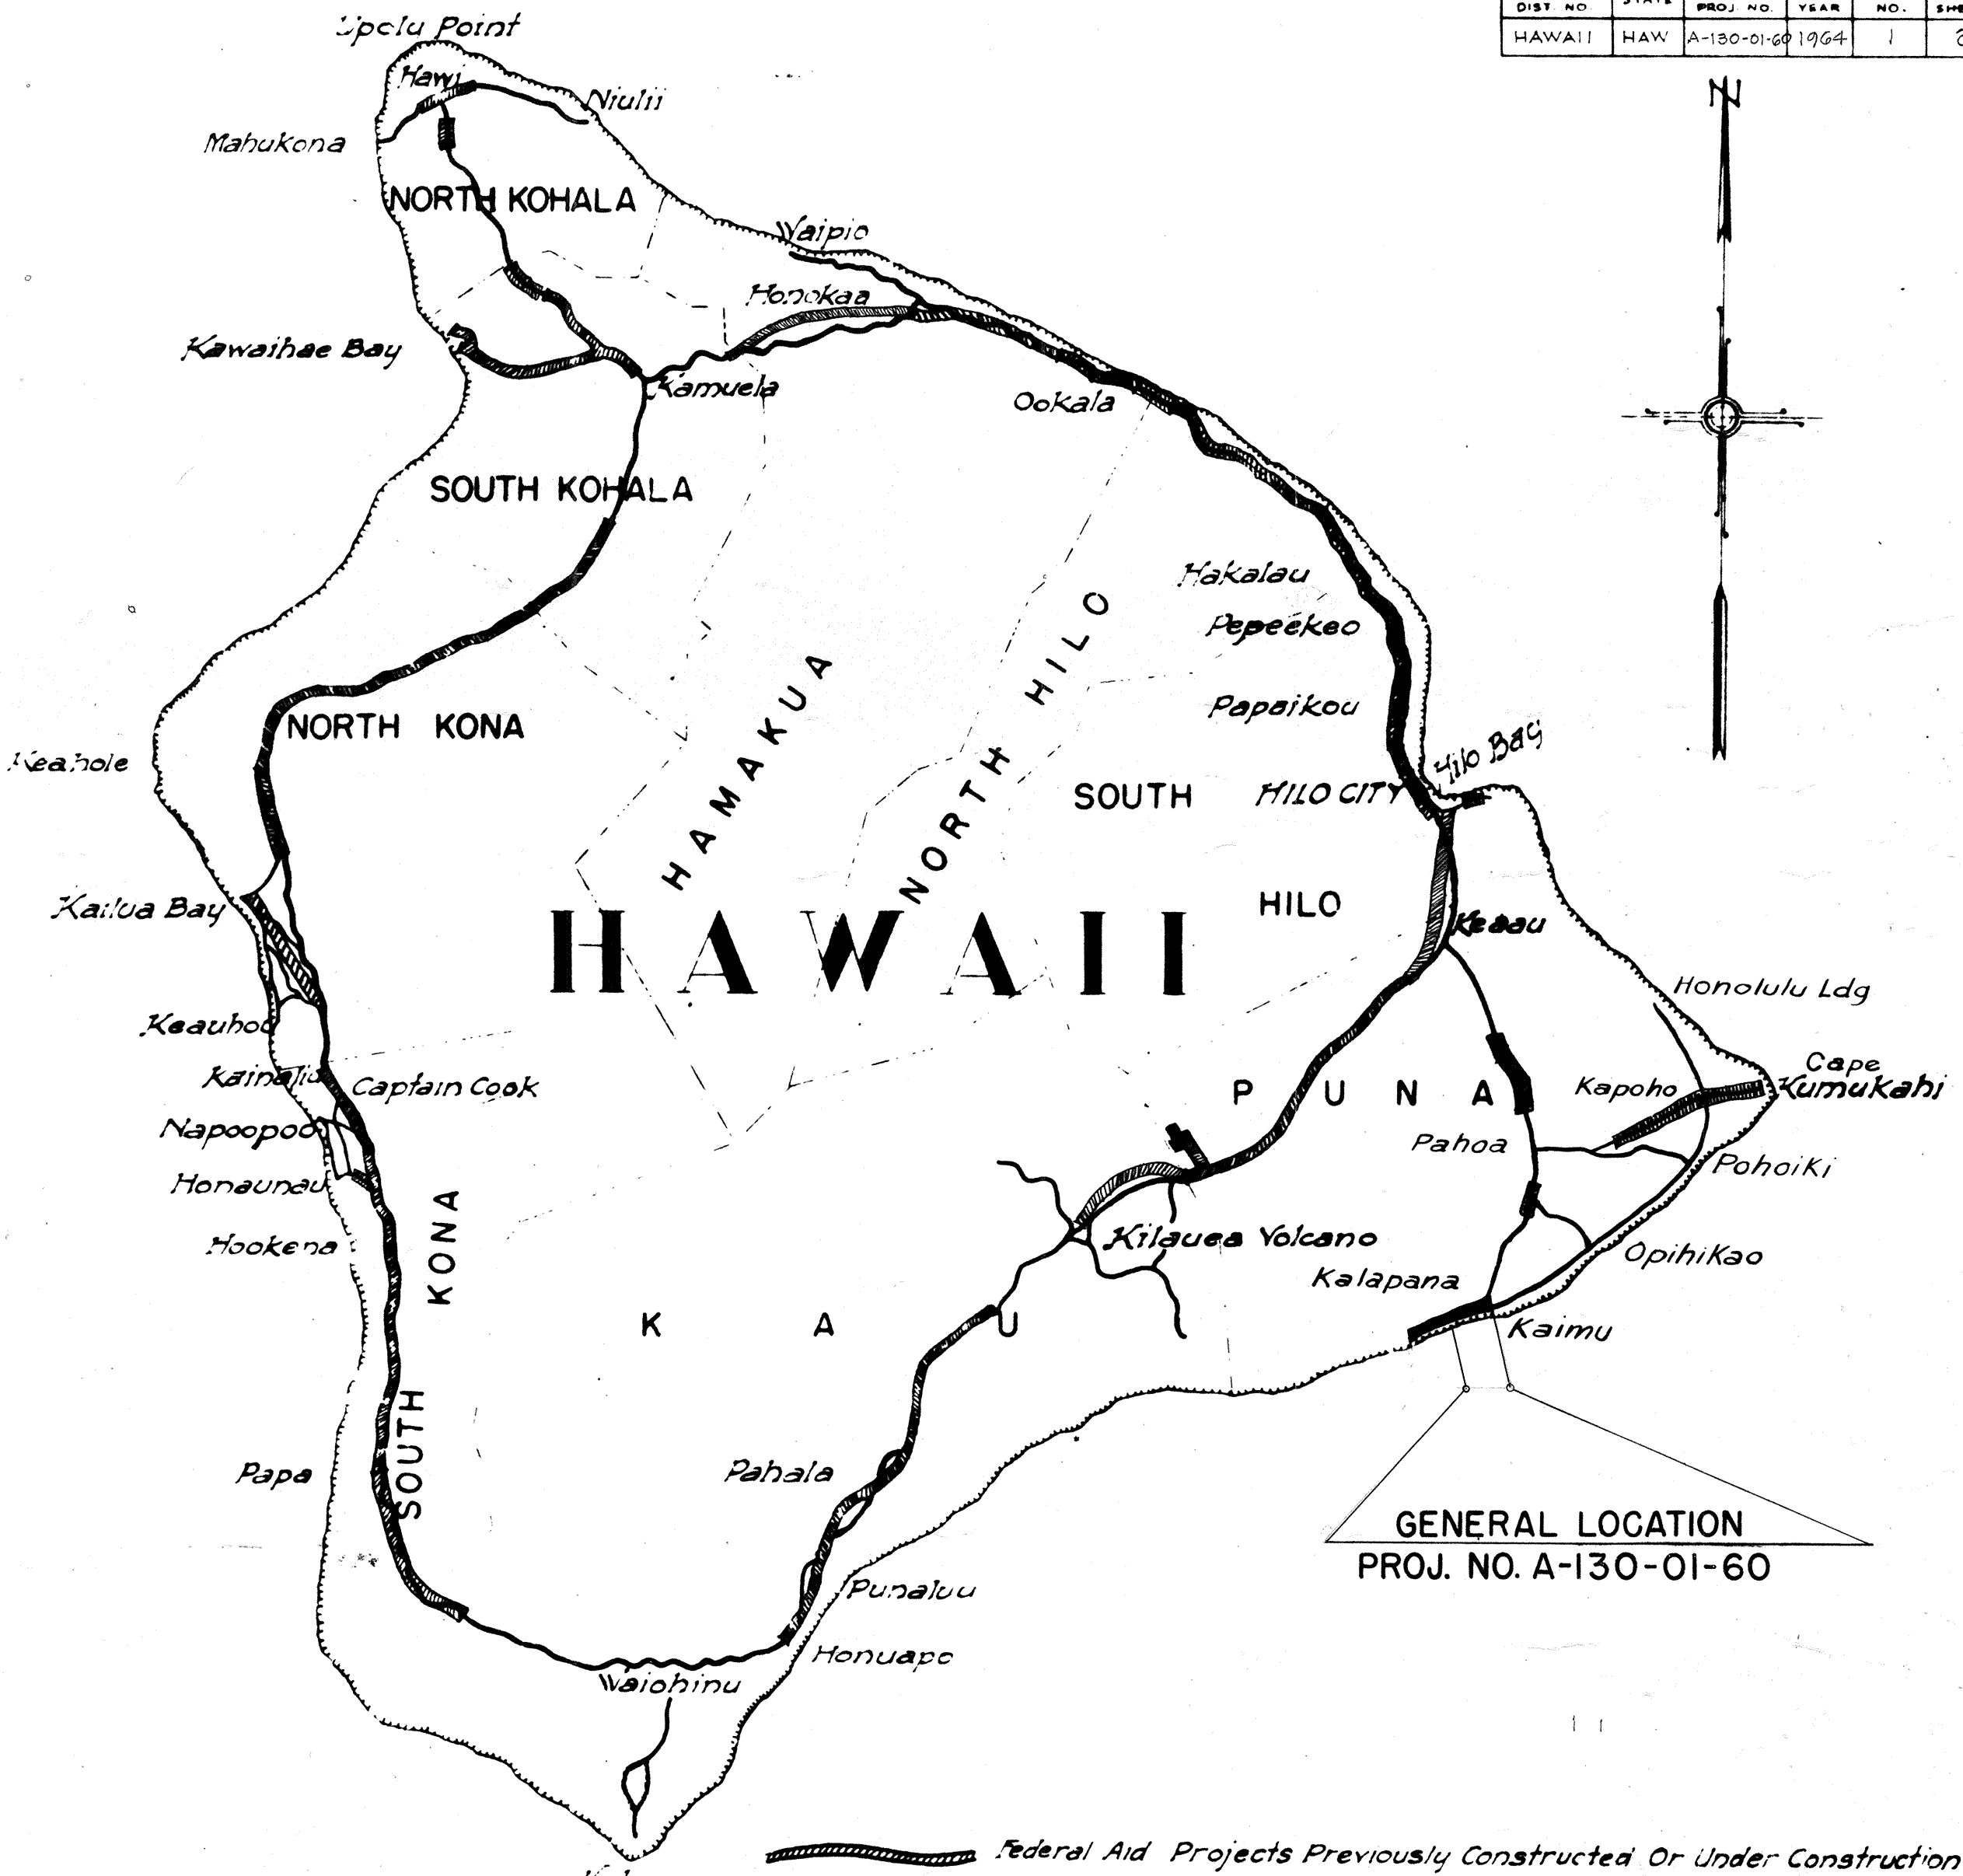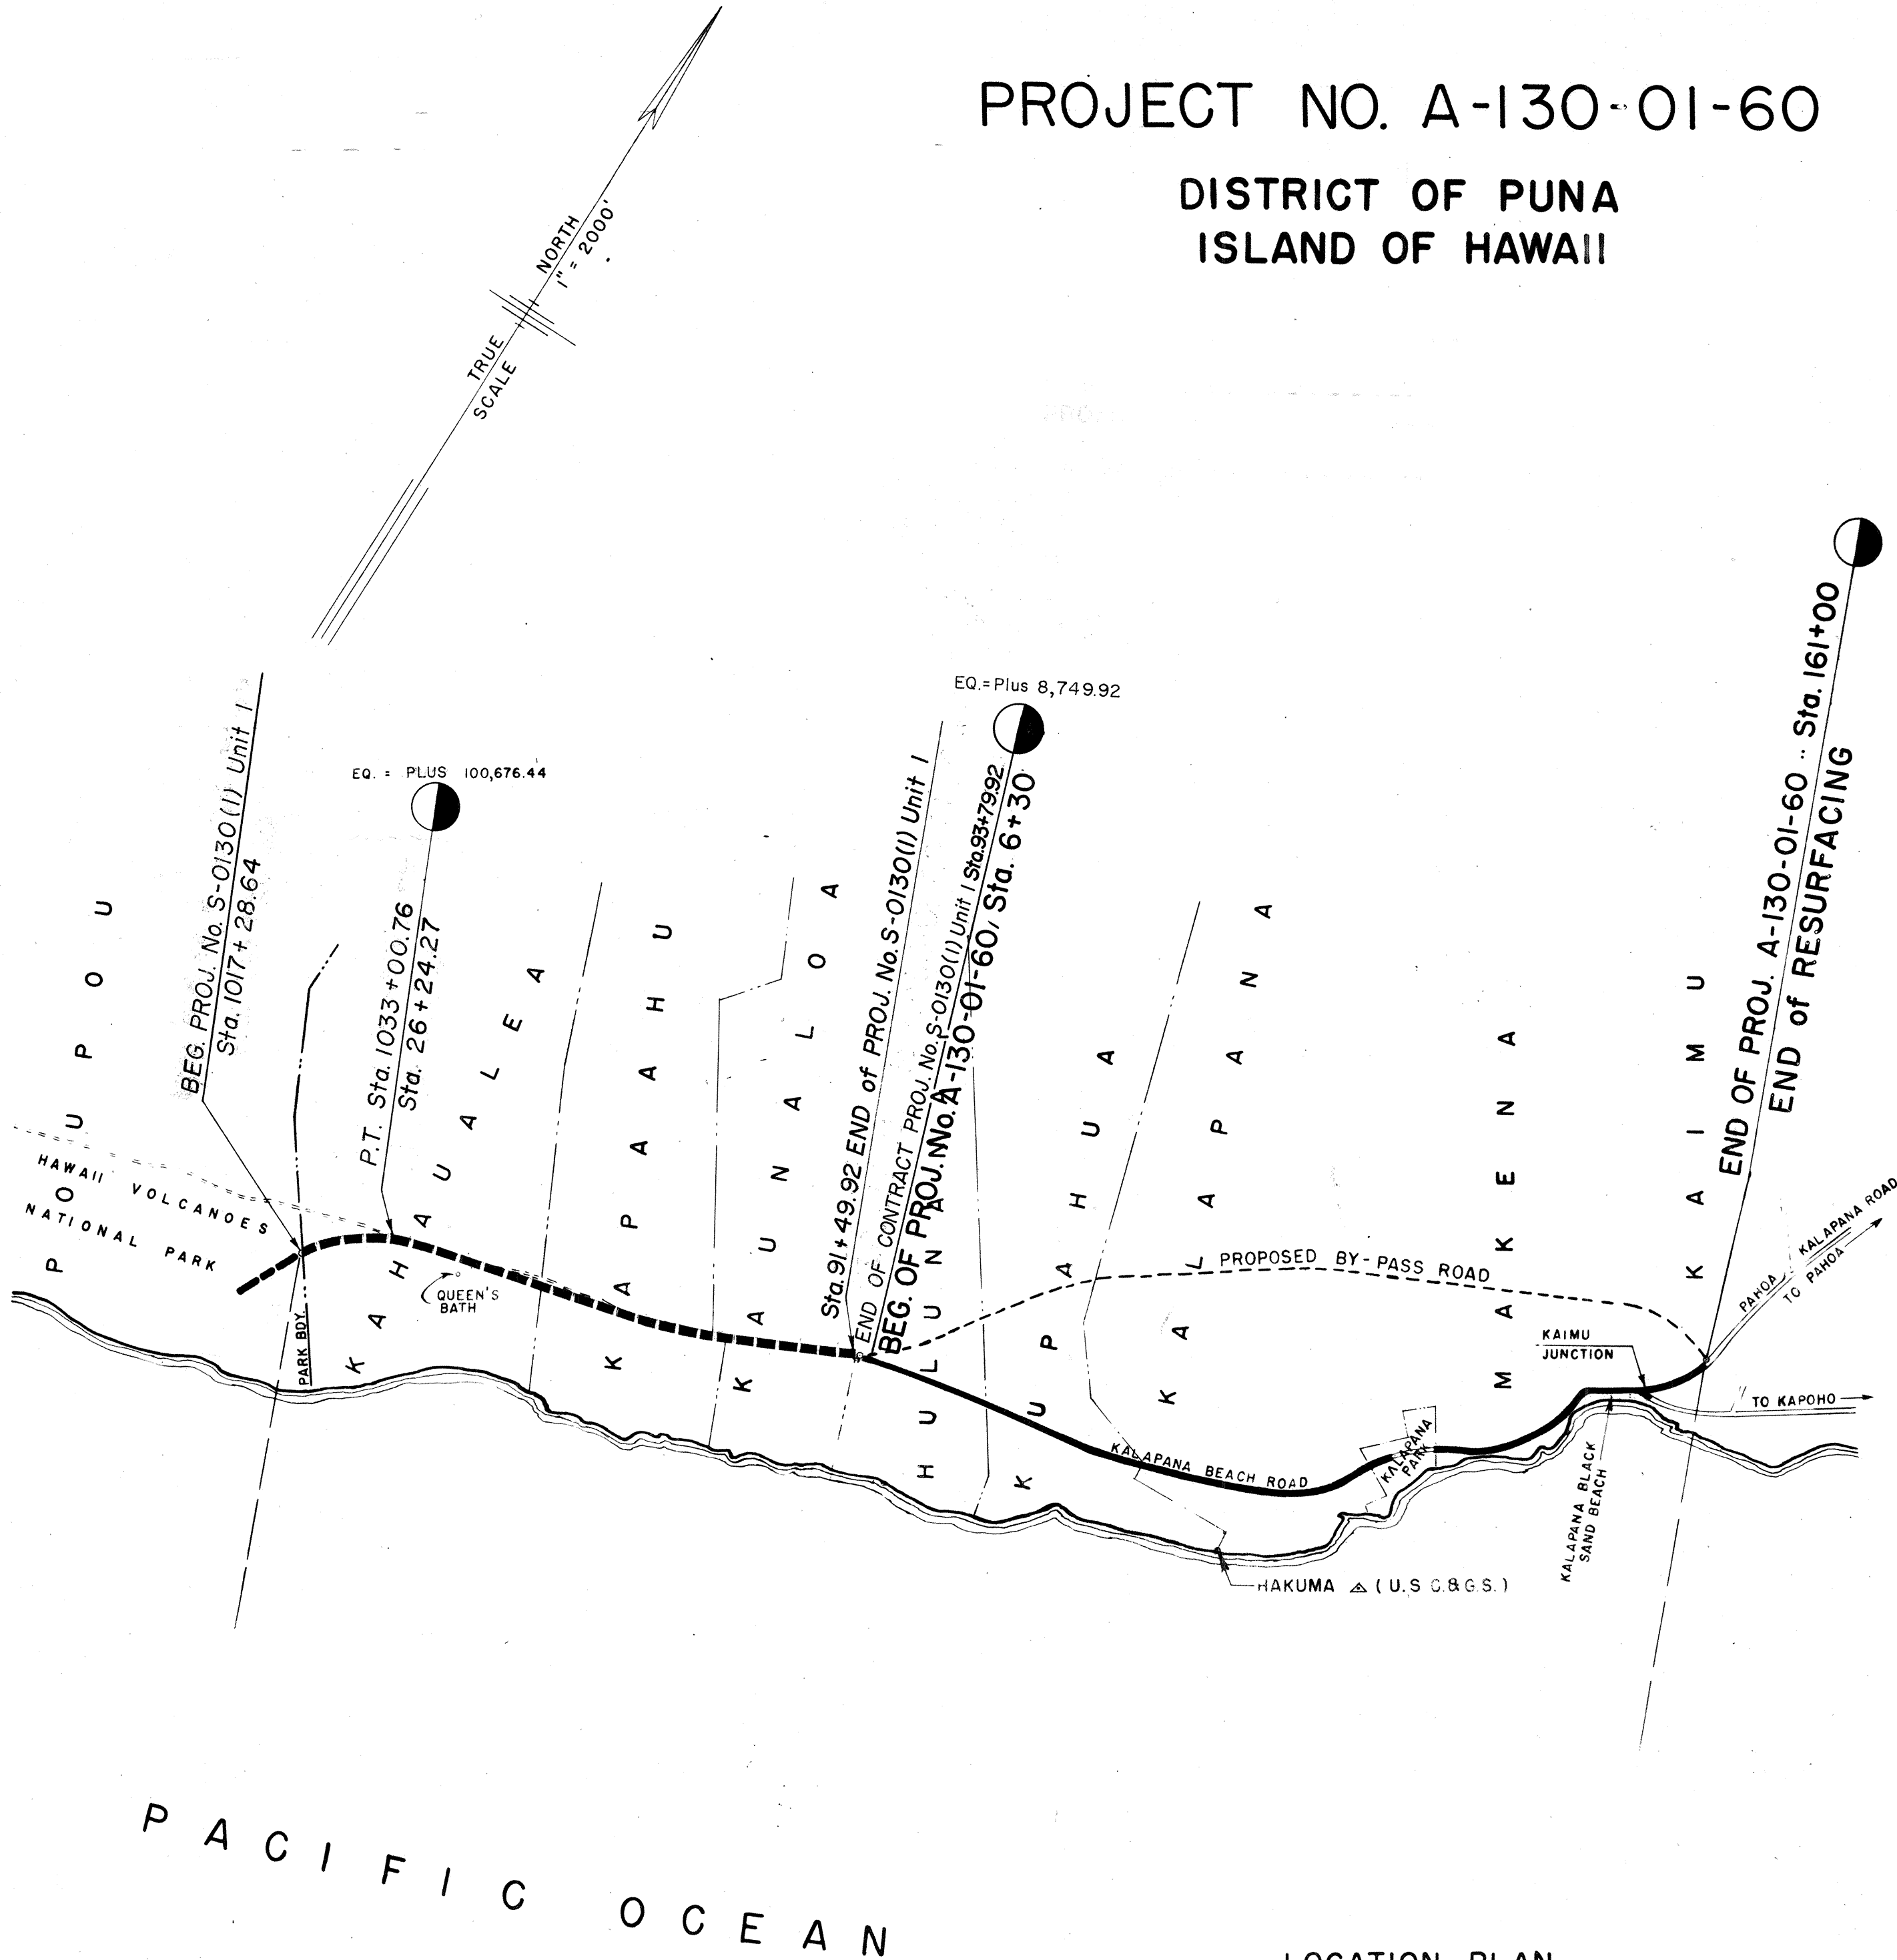

NOTE :

ALL CHANGES MADE DURING CONSTRUCTION

HAVE BEEN NOTED ON THESE TRACINGS IN

RED AND CHECKED BY :

Kenny T. Kodani

PROJECT ENGINEER

2-28-68

DATE

APPROVED: DATE 8-11-64

Kaipo T. Kaupā

ACTING DIRECTOR OF TRANSPORTATION

DATE

DESIGNED BY

DRAWN BY

CHECKED BY

NOTED BY

ORIGINAL PLAN

NOTED BY

DATE

LAYOUT OF PROJECT

LENGTH OF PROJECT..... 2.930 MILES

LOCATION PLAN

SCALE: 1" = 2000'