


FINAL SURVEY	DATE
	BY
	SURVEYED PLOTTER
	NOTE BOOK NO.

ORIGINAL SURVEY	DATE
	BY
	SURVEYED PLOTTER
	NOTE BOOK NO.


FED. ROAD DIST. NO.	STATE	FED. AID PROJ. NO.	FISCAL YEAR	SHEET NO.	TOTAL SHEETS
HAWAII	HAW	5-0130(9)	1966	10	13

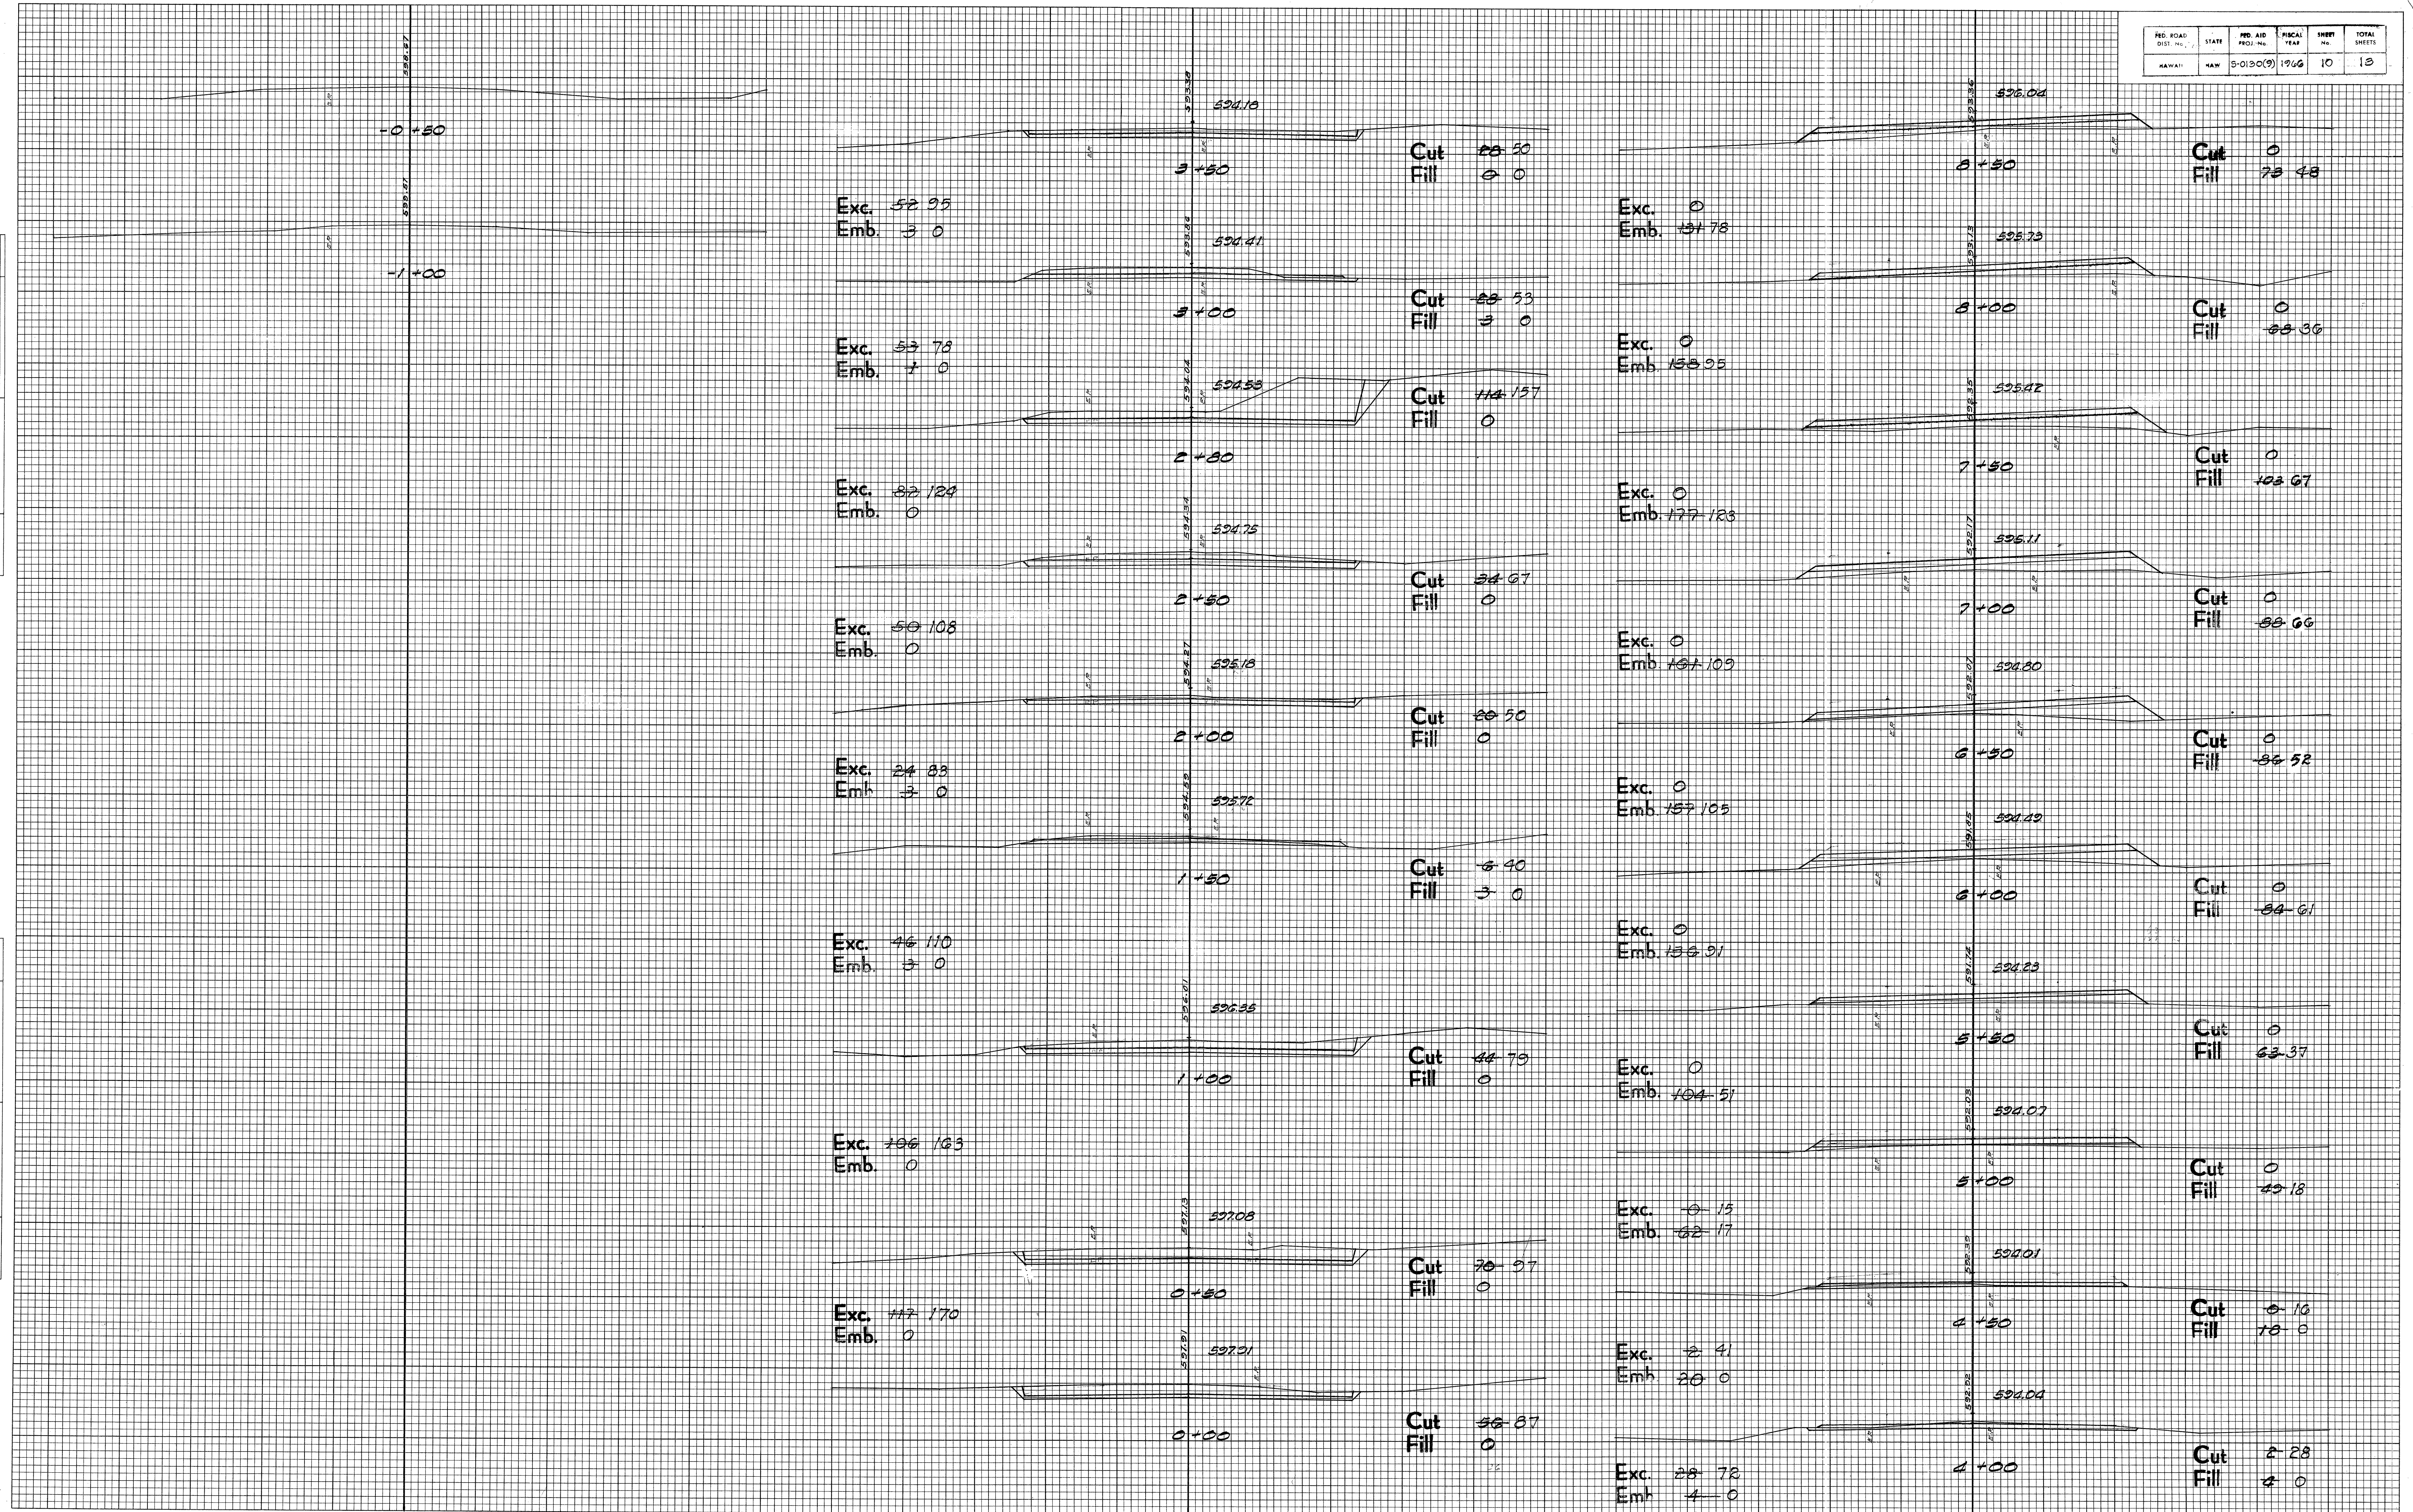

FINAL SURVEY	DATE	
	BY	
	SURVEYED PLOTTER	
	NOTE BOOK NO.	


ORIGINAL SURVEY	DATE	
	BY	
	SURVEYED PLOTTER	
	NOTE BOOK NO.	

FED. ROAD DIST. NO.	STATE	FED. AID PROJ. NO.	FISCAL YEAR	SHEET NO.	TOTAL SHEETS
HAWAII	HAW.	5013009	1966	11	13

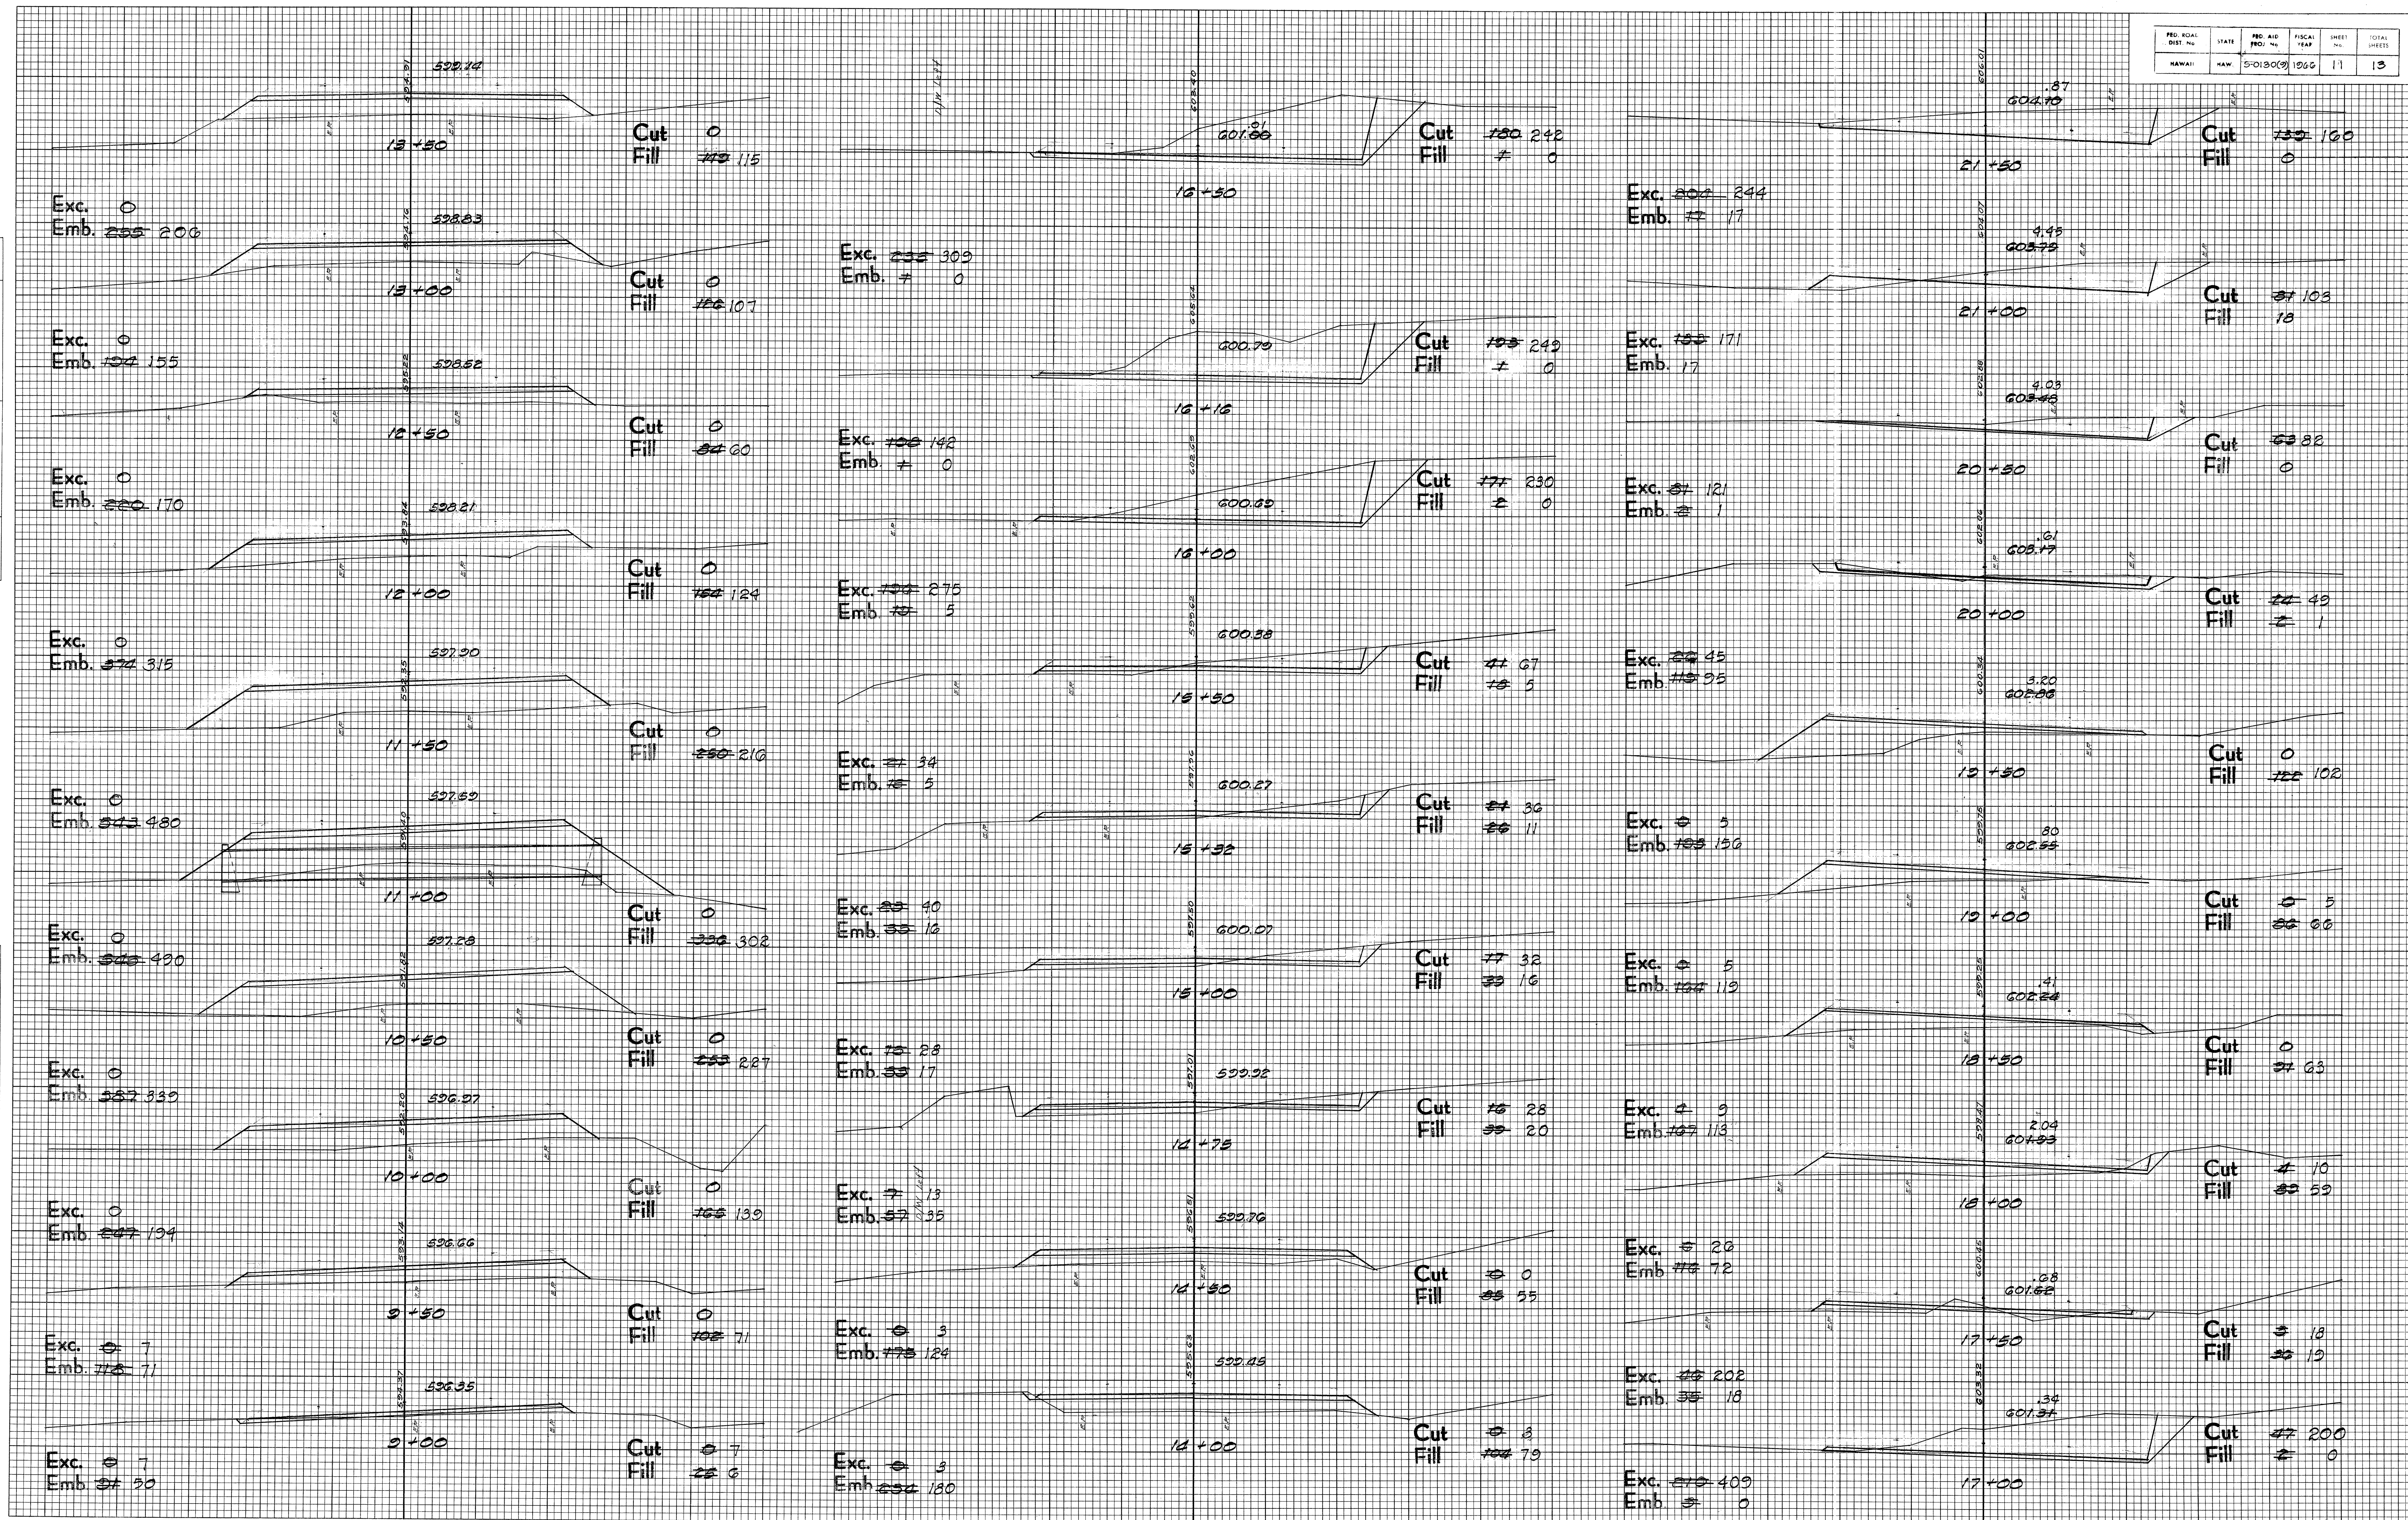

FED. ROAD DIST. No.	STATE	FED. AID PROJ. No.	FISCAL YEAR	SHEET No.	TOTAL SHEETS
HAWAII	HAW.	5-0130(9)	1966	12	13

ORIGINAL SURVEY				
NOTE BOOK	SURVEYED	BY	DATE	
	PLOTTED			
	TEMPLATE			
	AREAS			
NO. _____	AREAS CHECKED			

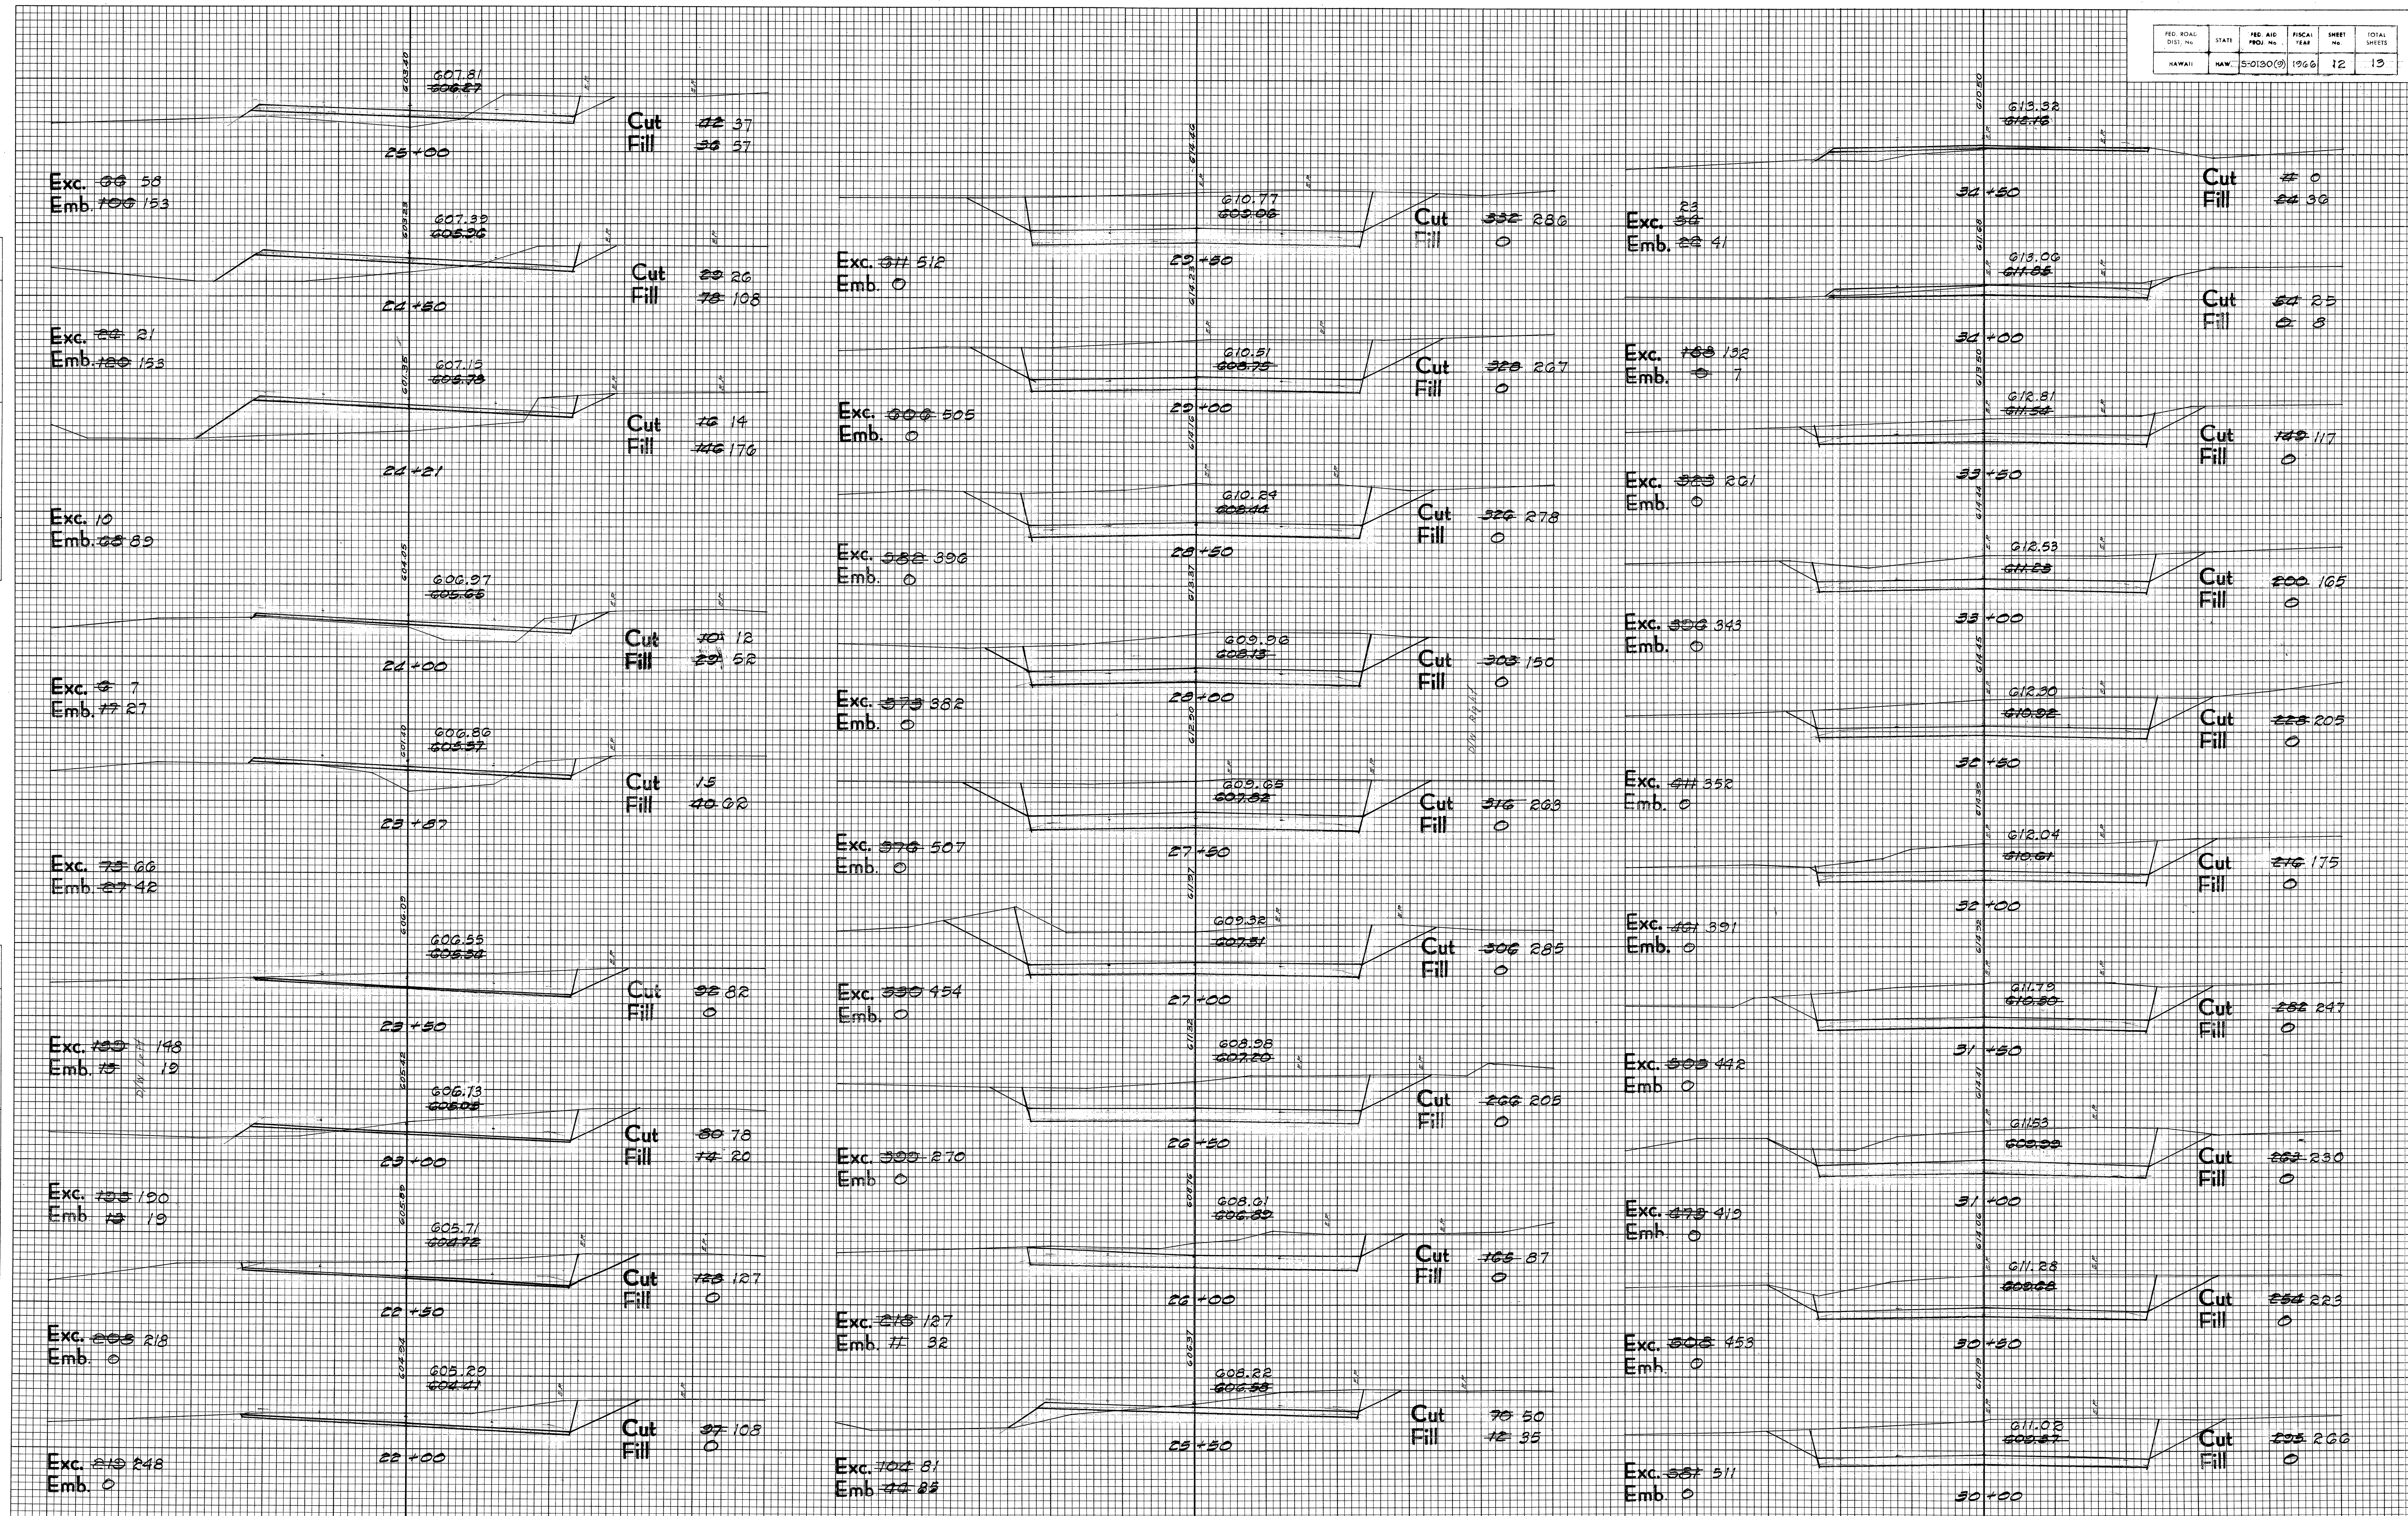

DATE	BY	FINAL SURVEY	SURVEYED	PLOTTED	IN SCALE	AREAS CHECKED
		NO.				

DATE	BY	ORIGINAL SURVEY	SURVEYED	PLOTTED	IN SCALE	AREAS CHECKED
		NO.				

FED. ROAD DIST. NO.	STATE	FED. AID PROJ. NO.	FISCAL YEAR	SHEET NO.	TOTAL SHEETS
HAWAII	HAW.	5-0130(9)	1966	13	13

