
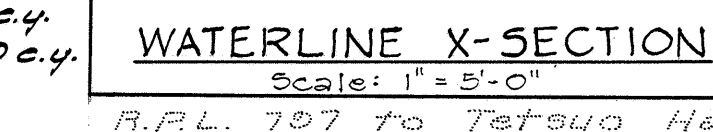


1. Azimuths and coordinates are referred to "Olson" Δ, U.S.C. & G.S. 1982 Datum.
2. Bench Marks are referred to mean sea level Datum.
3. Install & Monuments as shown on the plans and as ~~staked out by the Engineer~~ Staked out according to R/W Plan.
4. Where the existing Water Lines are disturbed by the new construction, they shall be relocated and or lowered as shown on the plans or as directed by the Engineer.
5. Existing Regulatory and Warning signs to be removed, shall be stockpiled where ordered by the Engineer.
6. All Utility Poles to be relocated by others. Contractor shall notify utility company two weeks in advance of the date he wants the utility company to do the work.

A-a
Ash mixed with Rock
Ginder mixed with Ash
Pahoehoe

The soil profile data shown on these sheets are for design purposes only and are intended for the convenience of the Engineer in the control of earthwork. The borings were carefully made and are believed to be reliable, but the Engineer does not guarantee the accuracy of same. The Contractor is hereby advised and will be presumed to have made his own investigation on the site prior to submission of his bid.

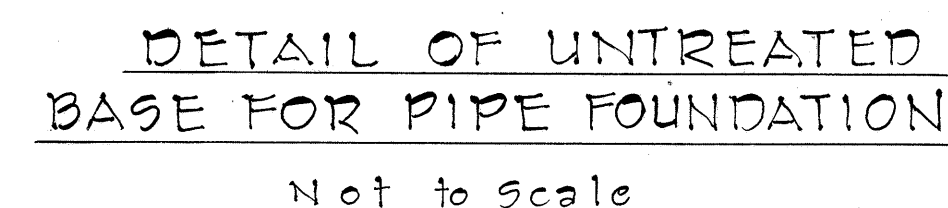


Grant 13450 to Kumaichi Kawazoe

R.P.L. 775 to Hiroshi Ooka

Grant 13647 to Henry M.W. Choy

R.P.L. 755 to Kazumi Shimizu & Iyano M. Shimizu

PRO. ROAD DIST. NO.	STATE	PRO. AID PROJ. NO.	FISCAL YEAR	SHEET NO.	TOTAL SHEETS
HAWAII	HAW.	S-0130(9)	1966	4	13

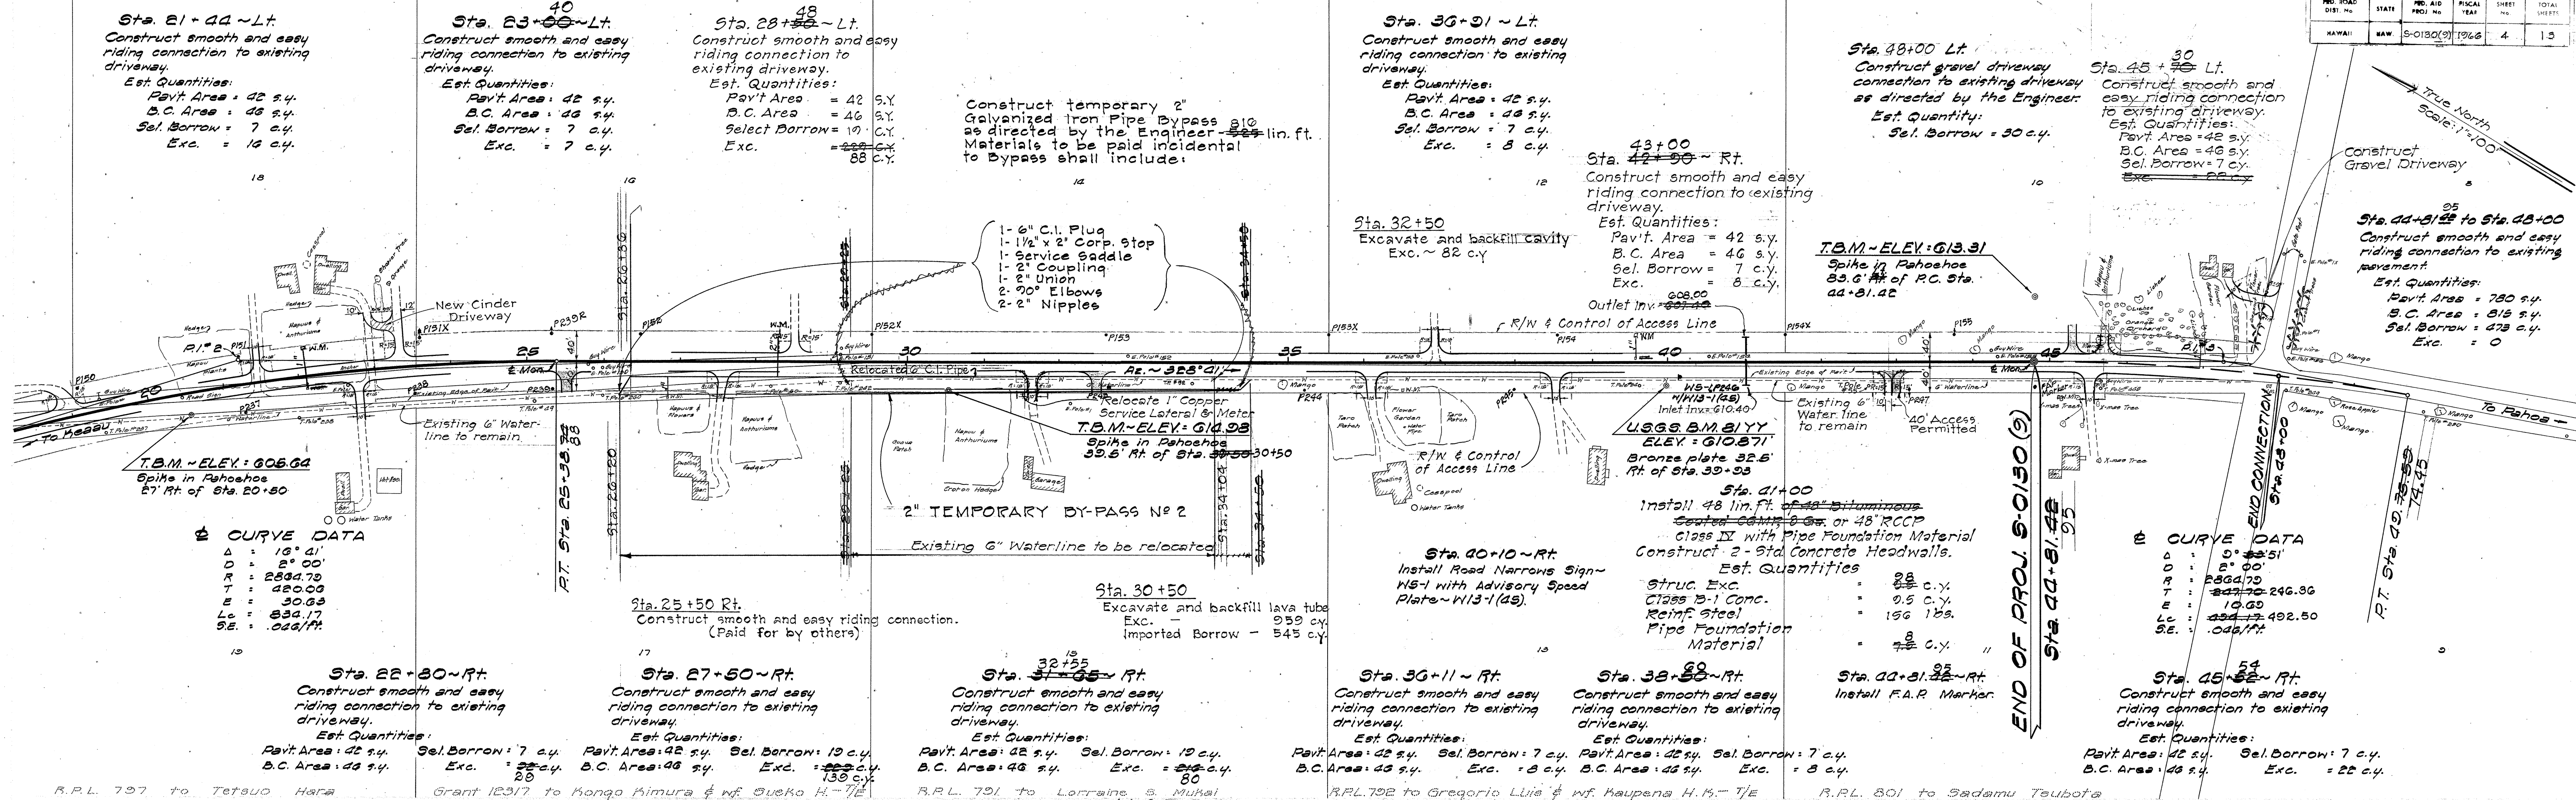

TYPE	DESCRIPTION	QUANTITY	W/POST	W/O POST	RELOCATE
W5-1	ROAD NARROWS	1			
W13-1(45)	45 M.P.H.			1	
	ROUTE MKR HAWAII 13				2
	FAP MARKER	1			1
	ADDITIONAL NO. PLATE			1	

