
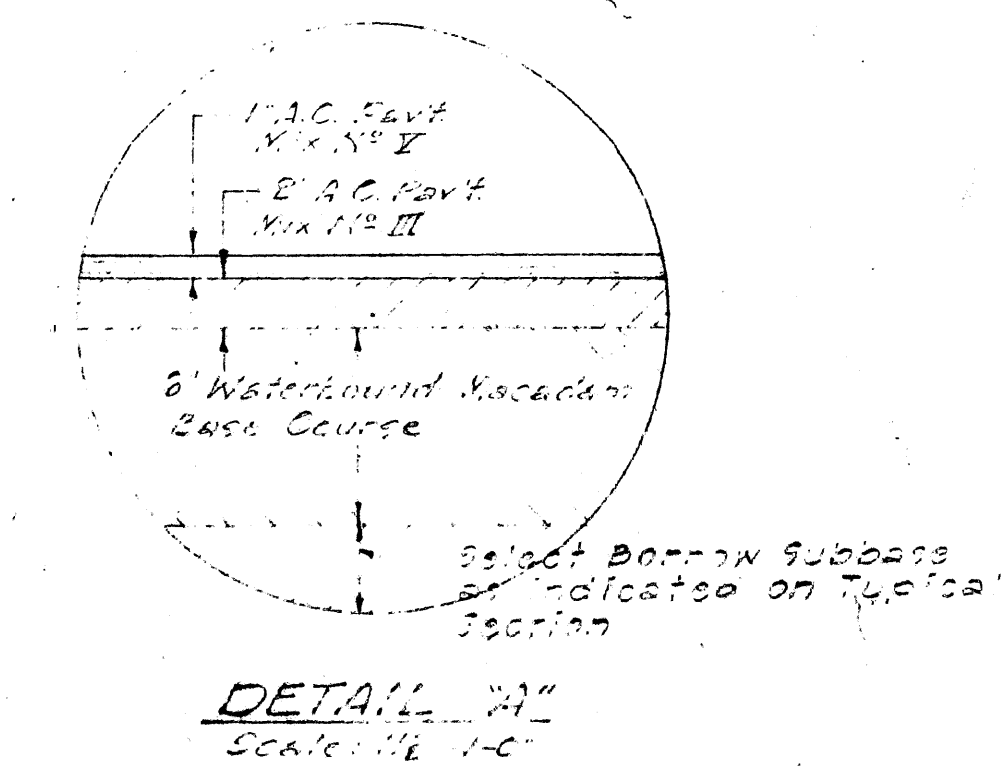
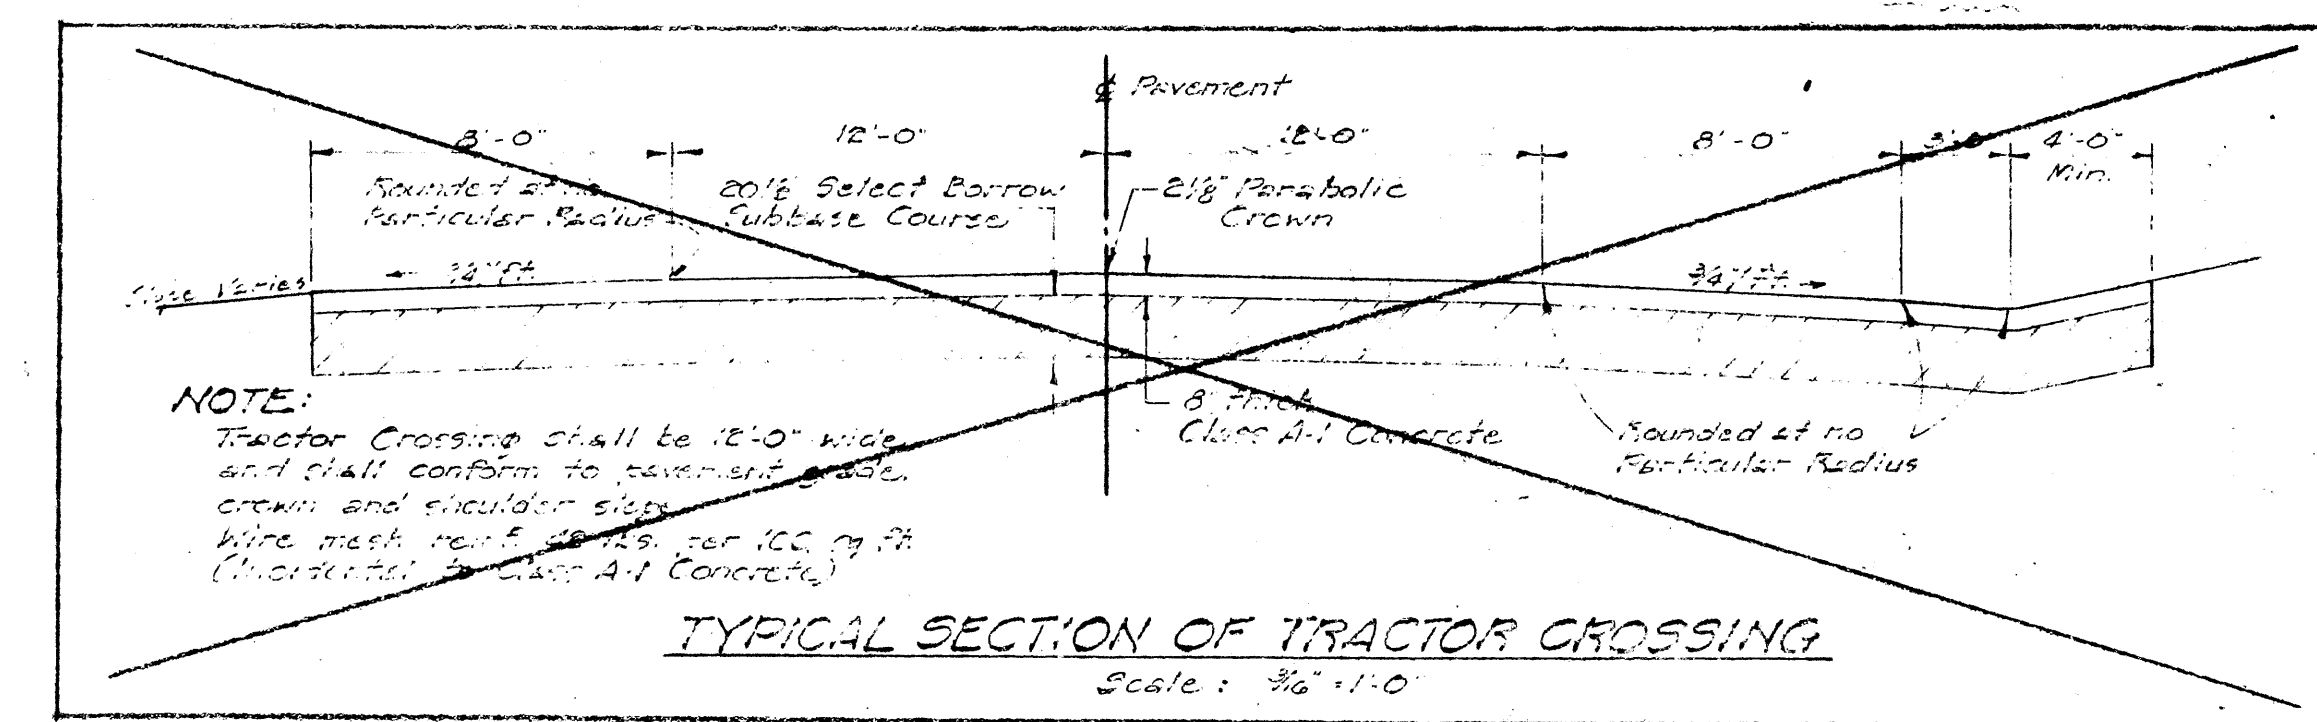
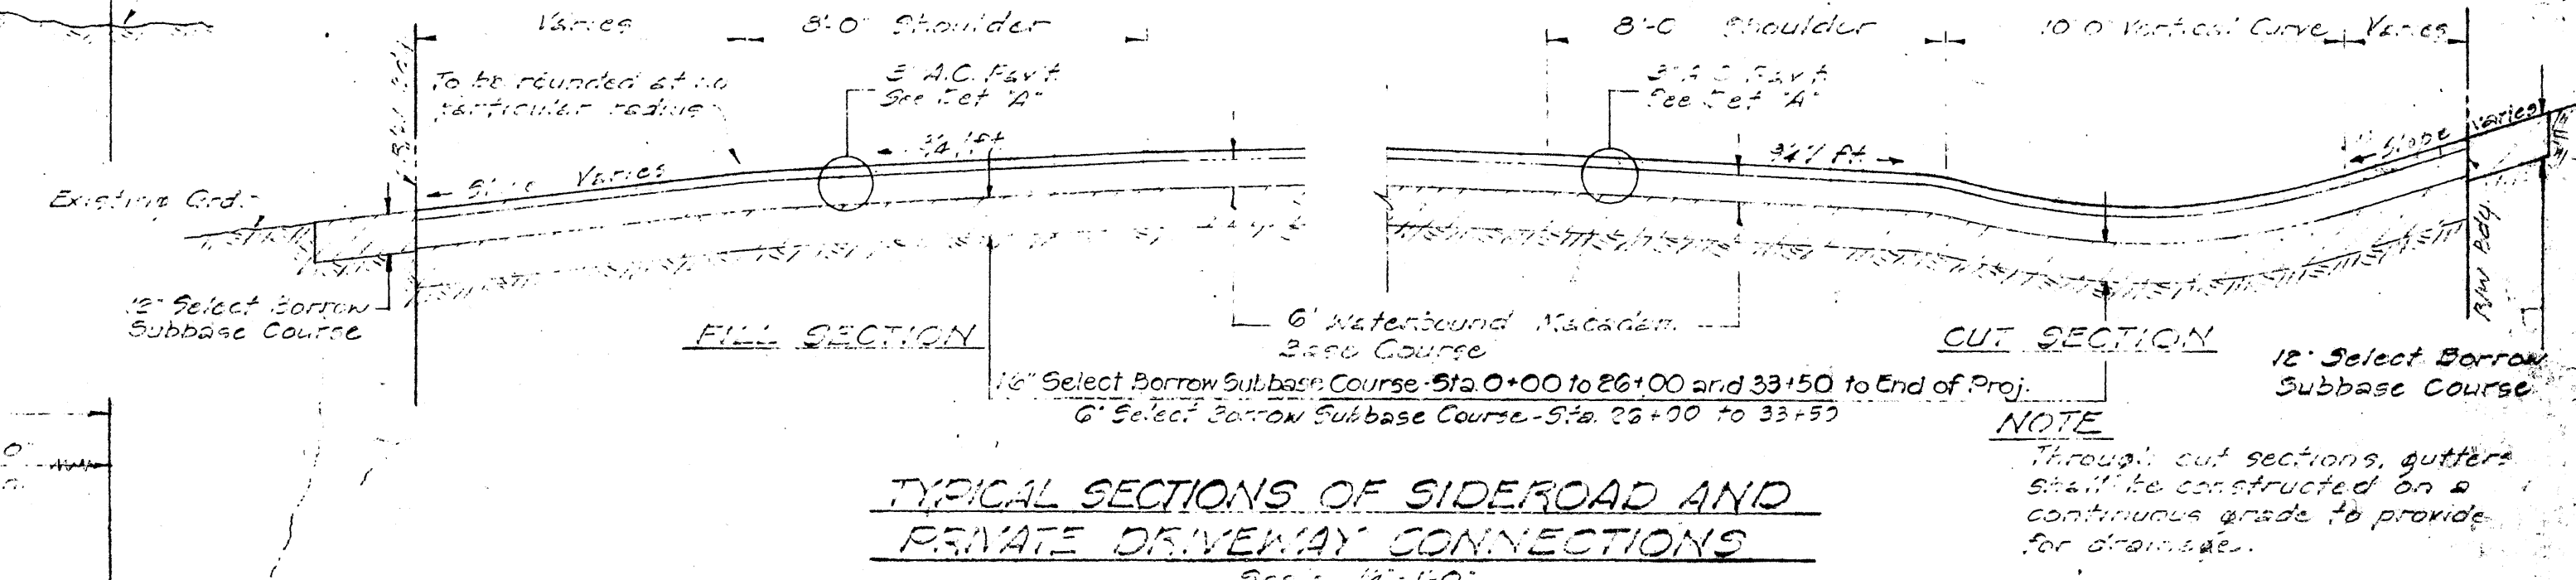
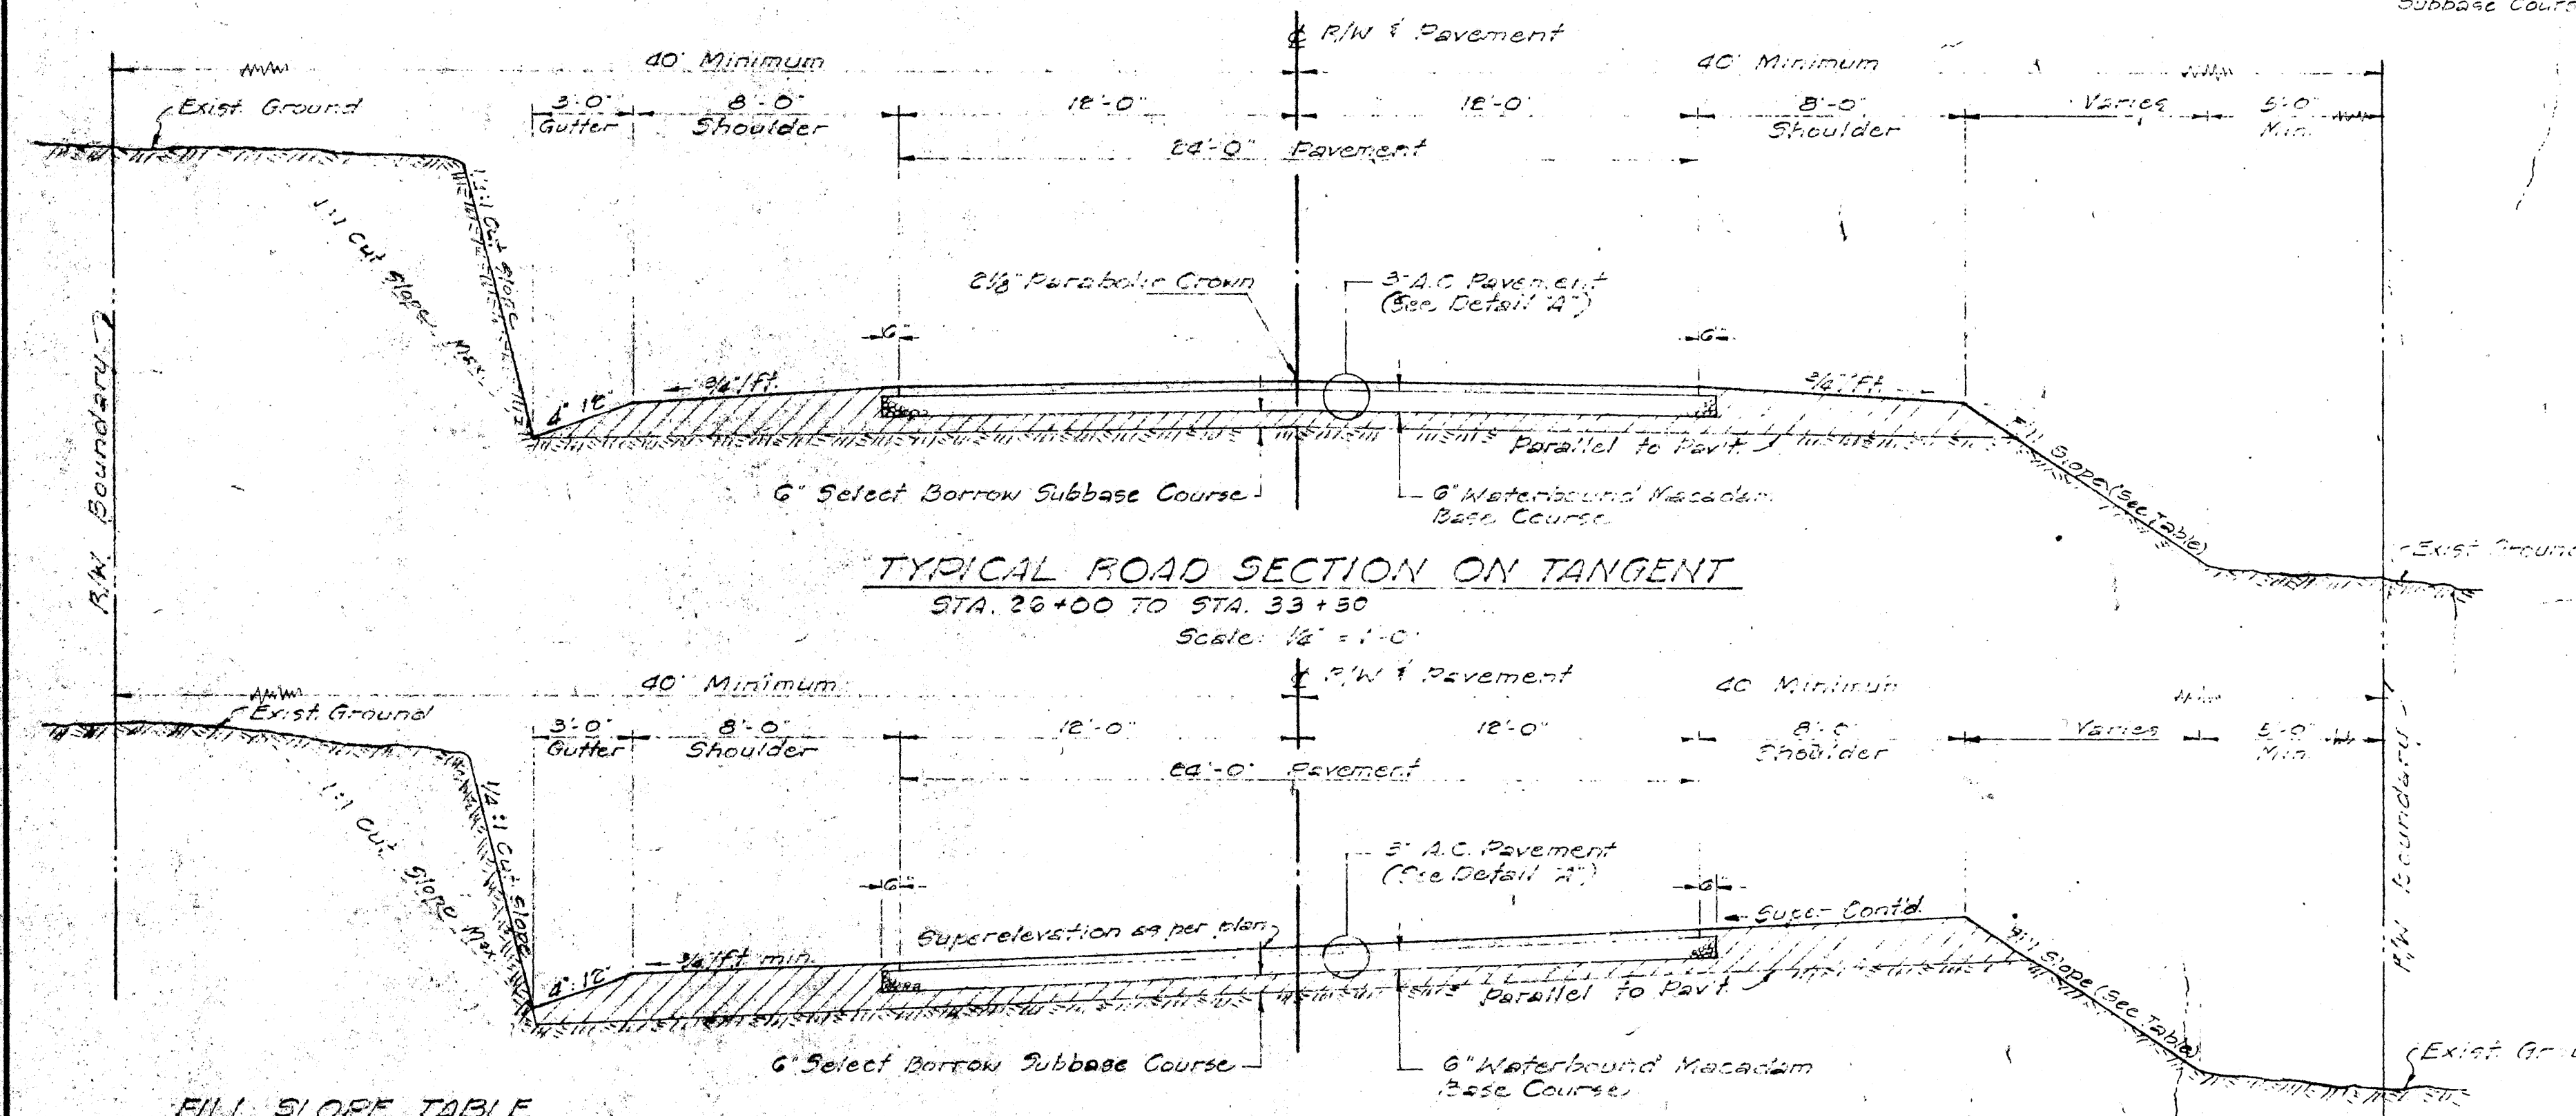
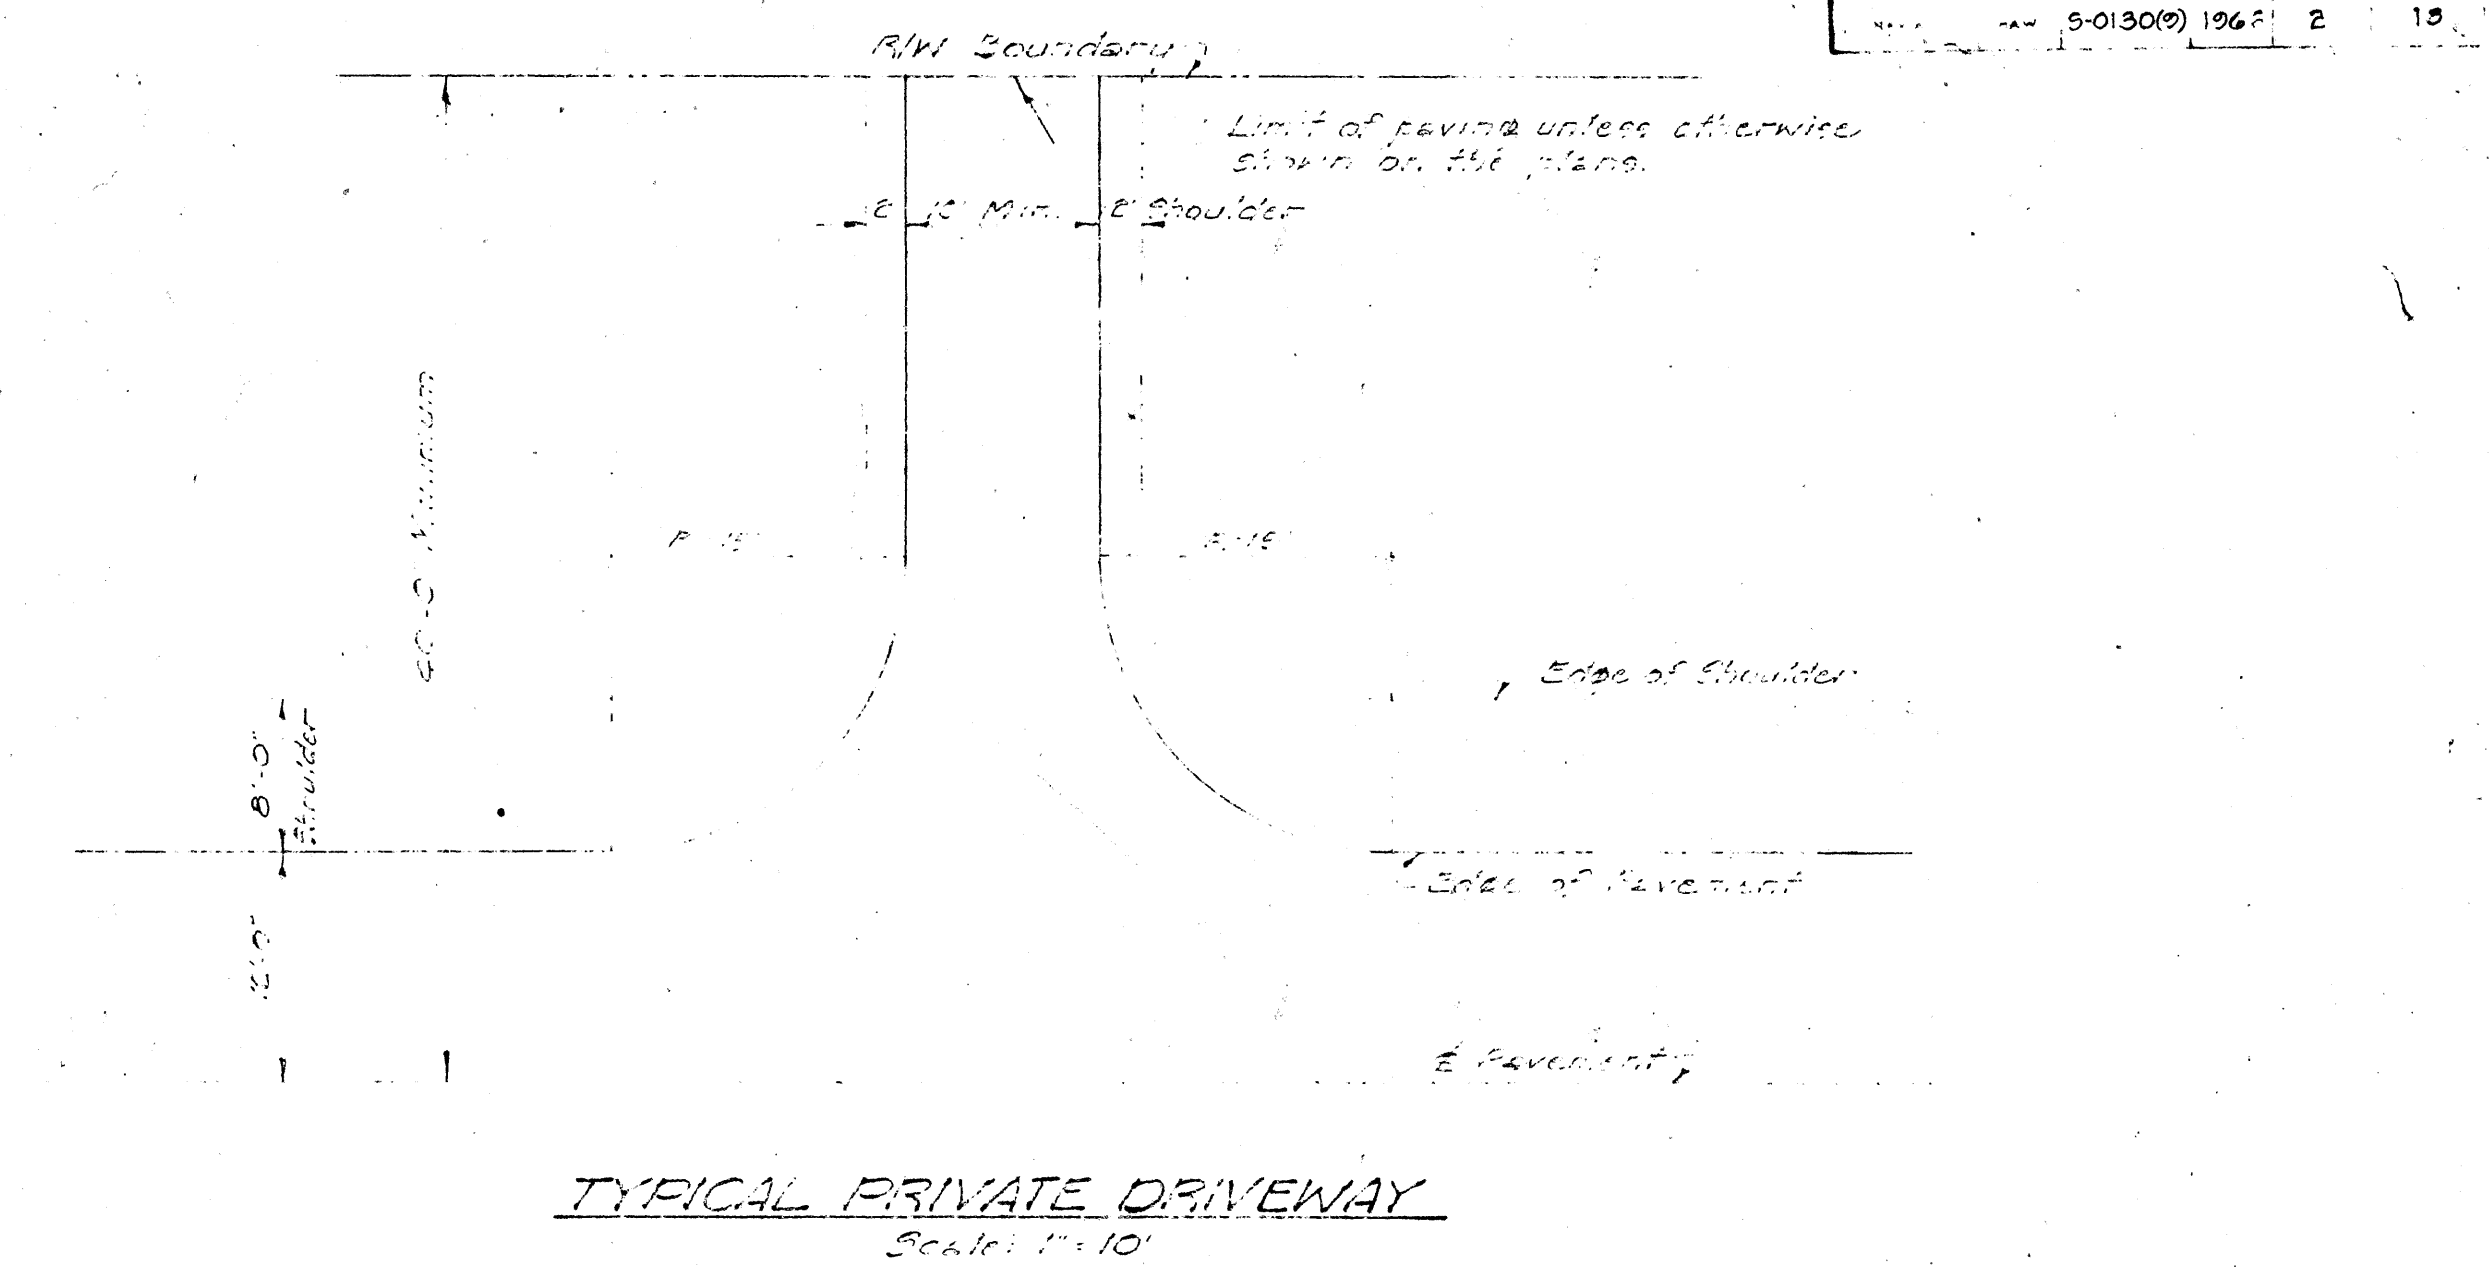


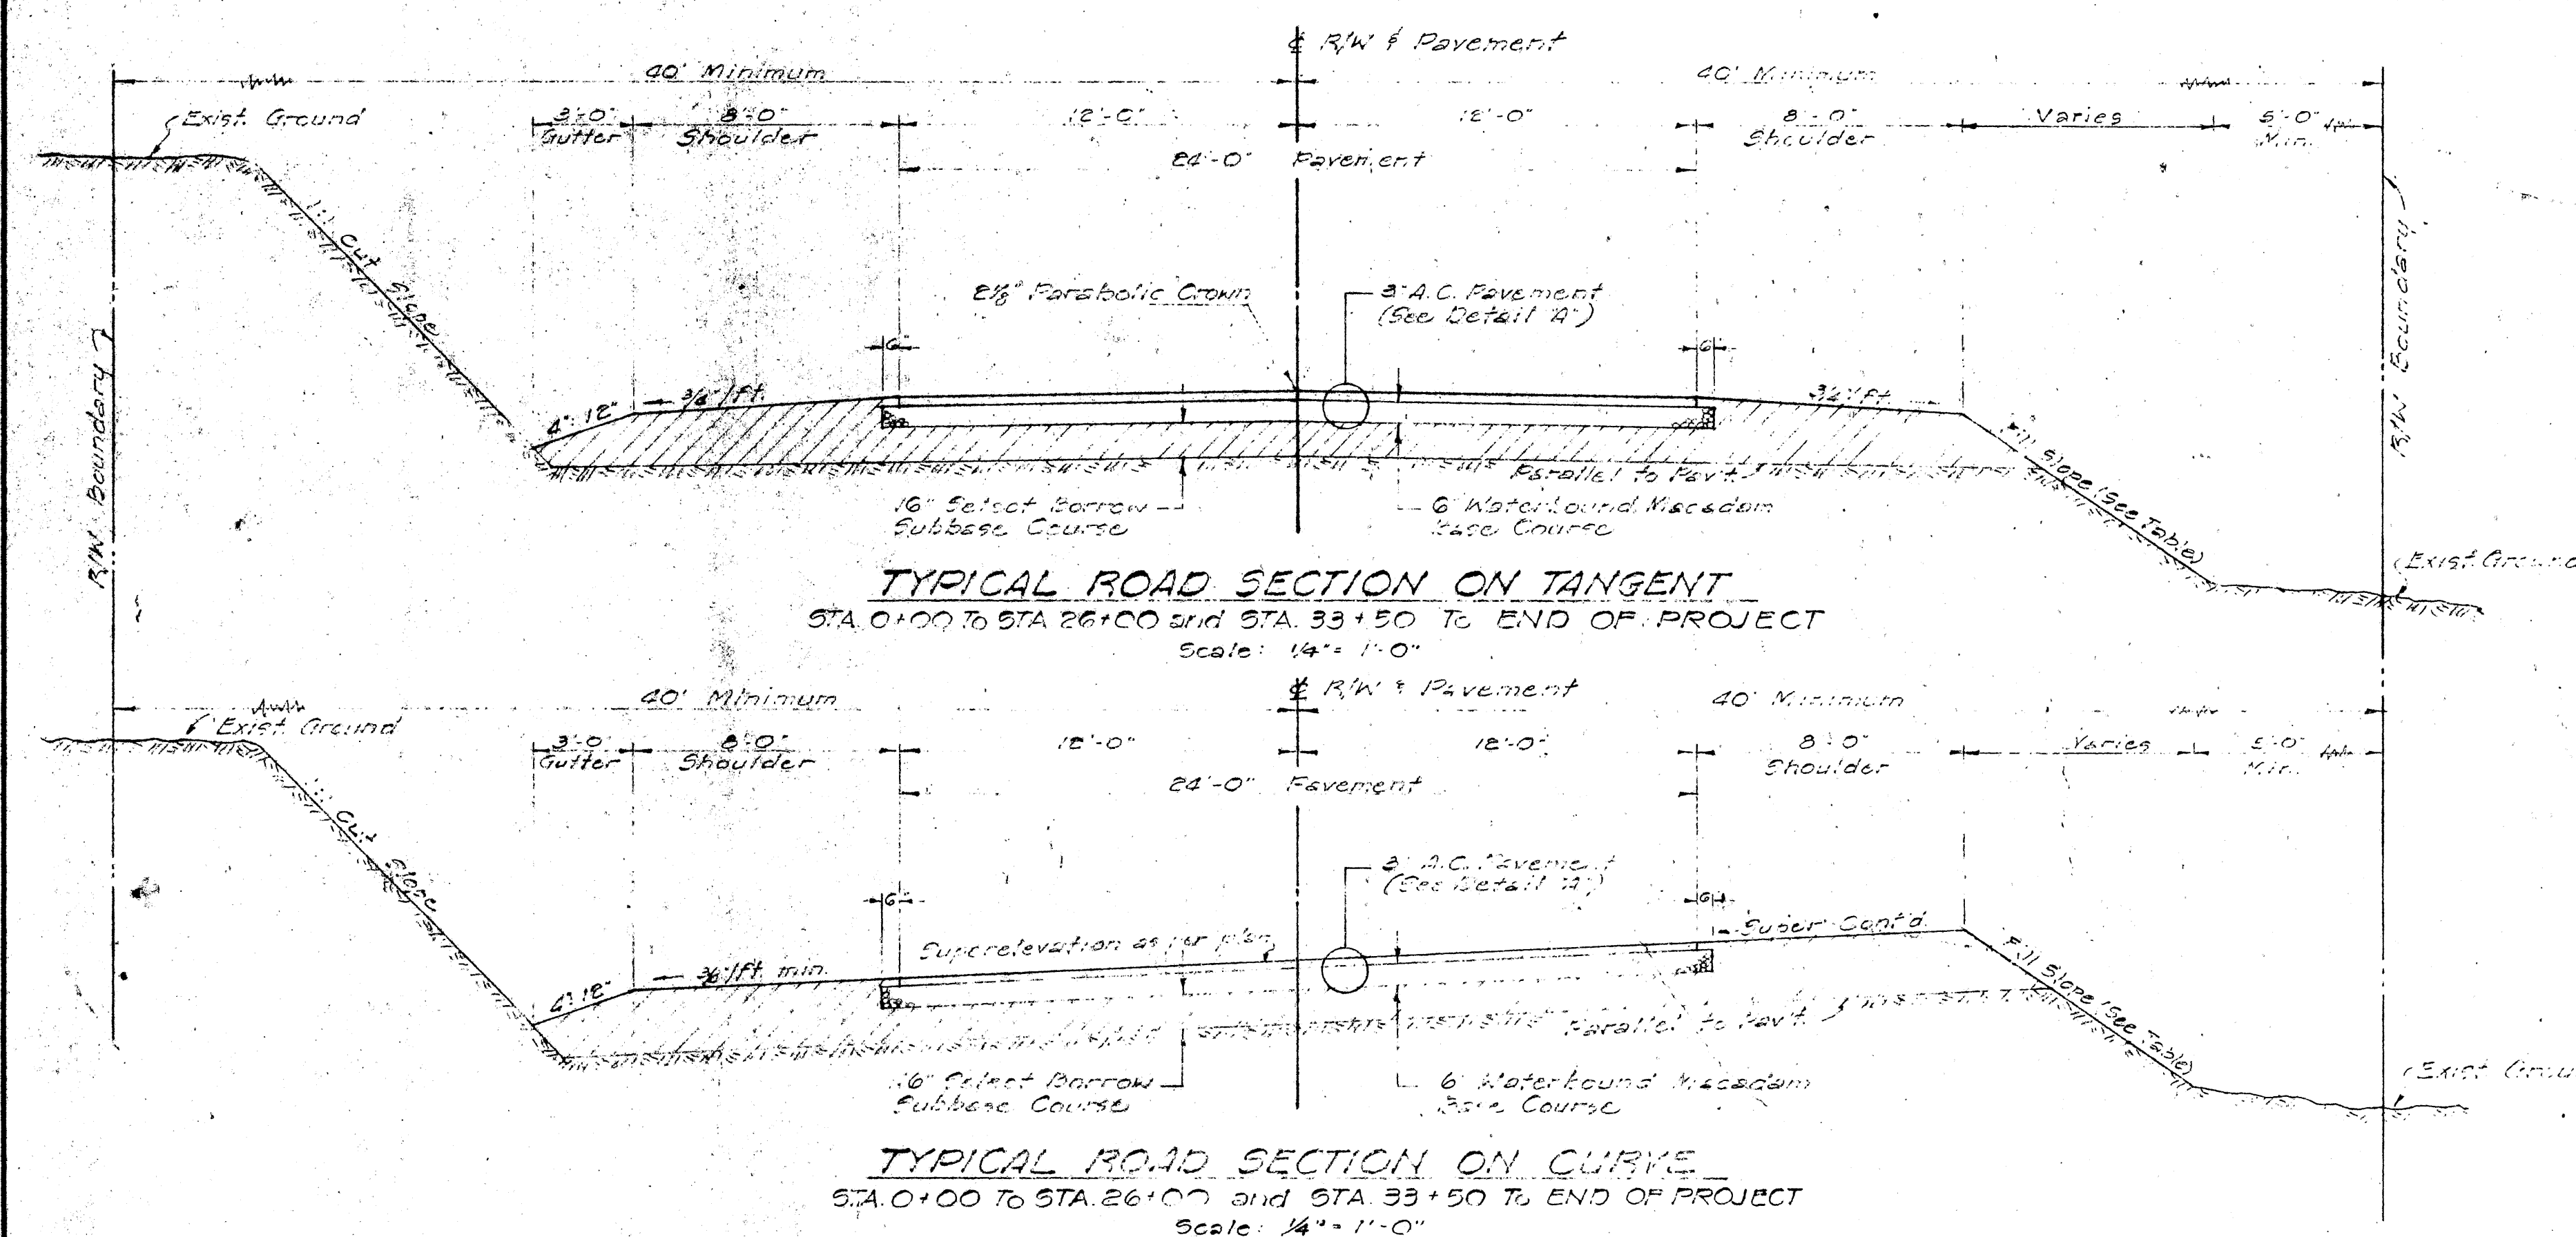

**FILL SLOPE TABLE**

| HT. OF FILL | FILL SLOPE   |
|-------------|--------------|
| 0' - 4'     | 4:1          |
| 4' - 10'    | 3:1 to 2:1   |
| 10' - Over  | 1 1/2:1 to 1 |

**NOTE:**  
R/W requirements supersede above table.

DEPARTMENT OF TRANSPORTATION  
HIGHWAYS DIVISION  
STATE OF HAWAII

**TYPICAL SECTIONS & OTHER DETAILS**

KEAAU-PAHOA ROAD  
Project S-0130(9)

Scale: As Noted Date: Aug. 1966