


PLAN	SURVEYED	DATE
NO.	BY	
NOTE BOOK	PLOTTED	
ALIGNMENT CHECKED		
RT. OF WAY CHECKED		

PROFILE					
NOTE BOOK					
NO.					

FED. ROAD DIST. NO.	STATE	FED. AID PROJ. NO.	FISCAL YEAR	SHEET NO.	TOTAL SHEETS
HAWAII	HAW.	S-0130(7)	1967	13	53

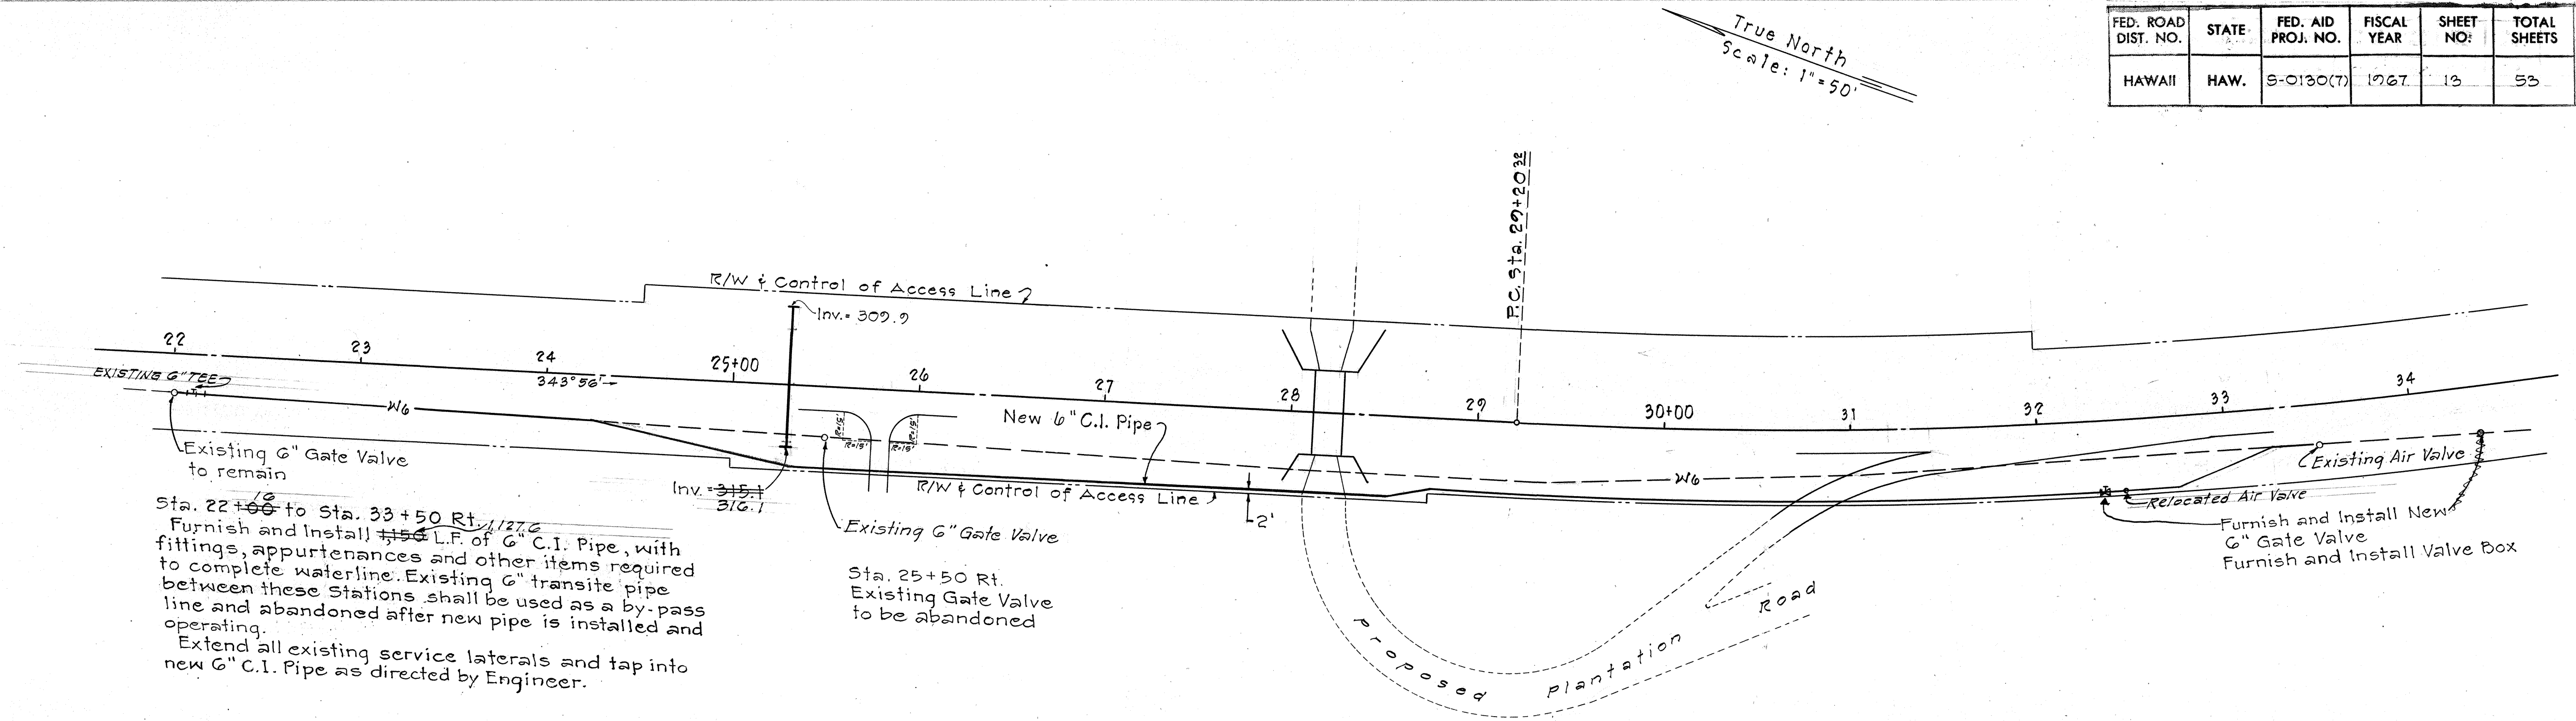

NEW 6" C.I. PIPE

