


PLAN	SURVEYED		BY	DATE
	PLOTTED			
NOTE BOOK	ALIGNMENT CHECKED			
NO.	RT. OF WAY CHECKED			

PROFILE	SURVEYED	BY	DATE
NOTE BOOK	PLOTTED		
NO	R. M. & NOTED		
	STRUCTURE NOTAT'S CH'KD		

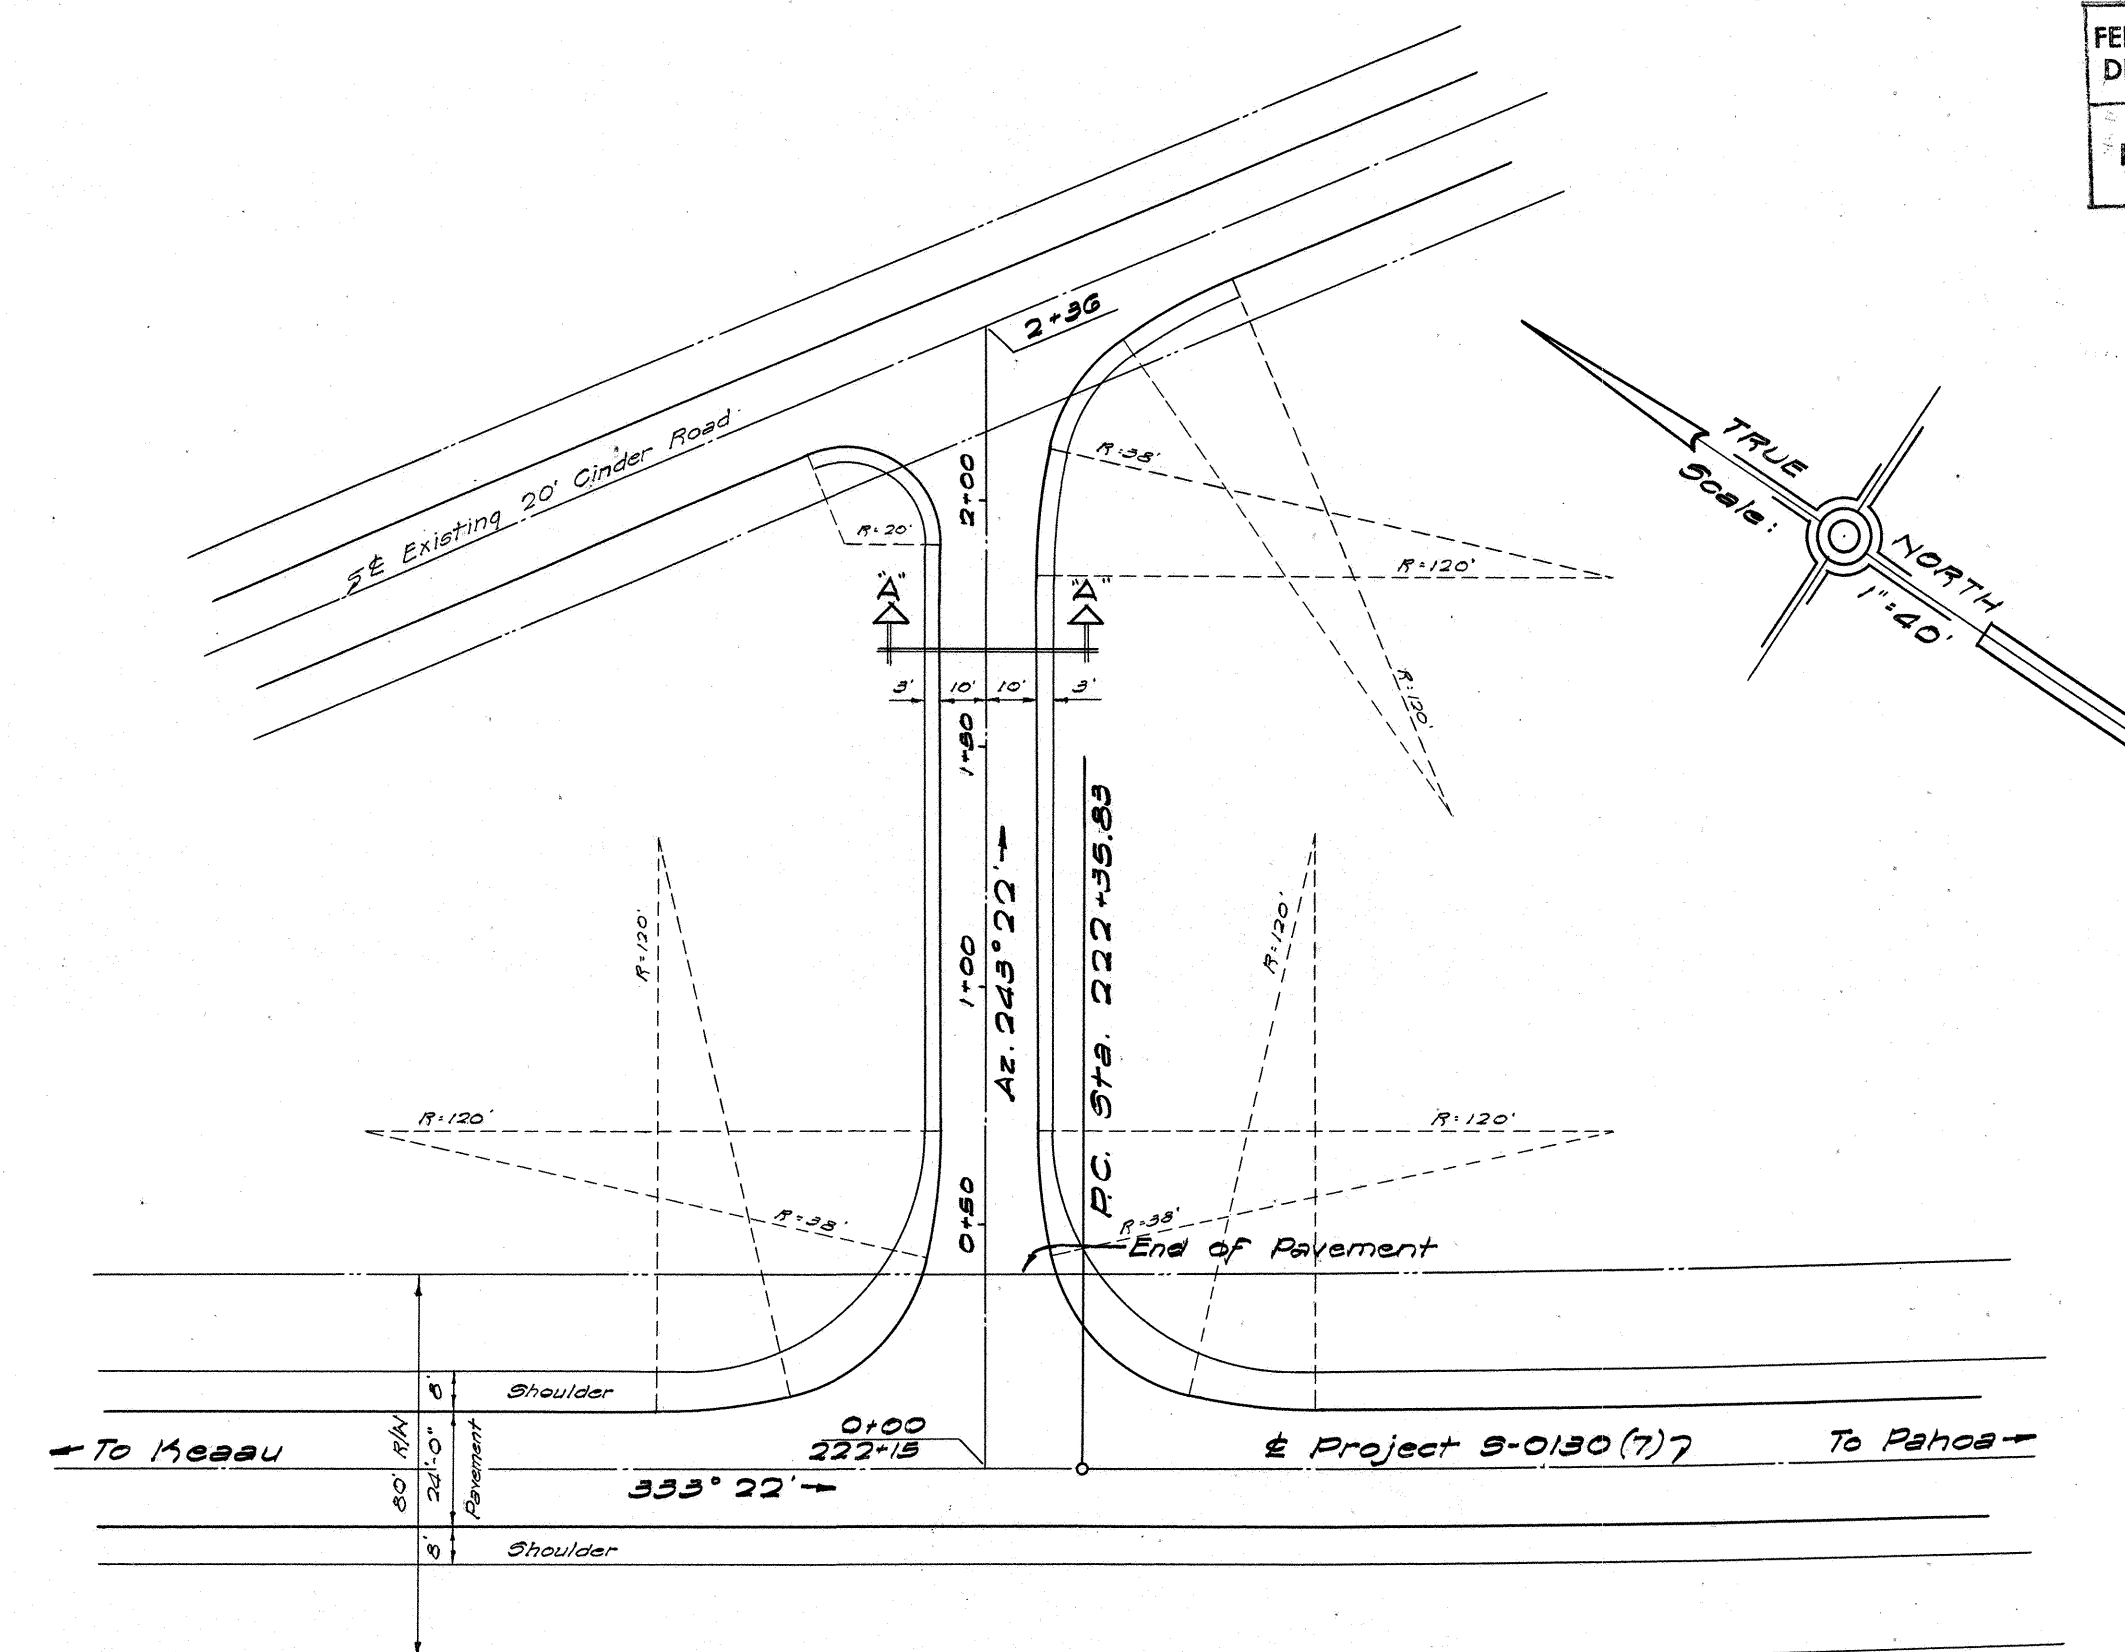

SIDEROAD CONNECTION DETAIL AT STA. 222+15
Scale: 1" = 40'

