

INDEX TO DRAWINGS	
SHEET	DESCRIPTION
1	TITLE SHEET
2	TYPICAL SECTIONS
3-11	PLAN & PROFILE
12	SIDEROAD CONNECTION DETAILS
13	NEW 6" C.I. PIPE
14	CONSTRUCTION IDENTIFICATION SIGN & WOOD BARRICADES
15-22	STANDARD DETAILS
23	CANE HAUL ROAD SEPARATION
24	TWIN 7'x5' BOX CULVERT
25-27	WAIPAHOEHOE STREAM BRIDGE
28	LOG OF BORINGS
29-33	STANDARD DETAILS - BRIDGE
34-53	CROSS SECTIONS

STATE OF HAWAII

DEPARTMENT OF TRANSPORTATION

HIGHWAYS DIVISION

"AS BUILT" PLANS OF

KEAAU - PAHOA ROAD

FEDERAL AID SECONDARY PROJECT NO. S-0130(7)

DISTRICT OF PUNA

ISLAND OF HAWAII

SCALES

PLAN	1 INCH = 100 FT.
PROFILE	HOR. 1 INCH = 100 FT.
	VER. 1 INCH = 10 FT.
CROSS SECTION	HOR. 1 INCH = 10 FT.
	VER. 1 INCH = 10 FT.

NOTE:


ALL CHANGES MADE DURING CONSTRUCTION HAVE BEEN NOTED IN RED ON THESE TRACINGS AND CHECKED BY:

George T. Kildani

PROJECT ENGINEER

5/8/69

DATE

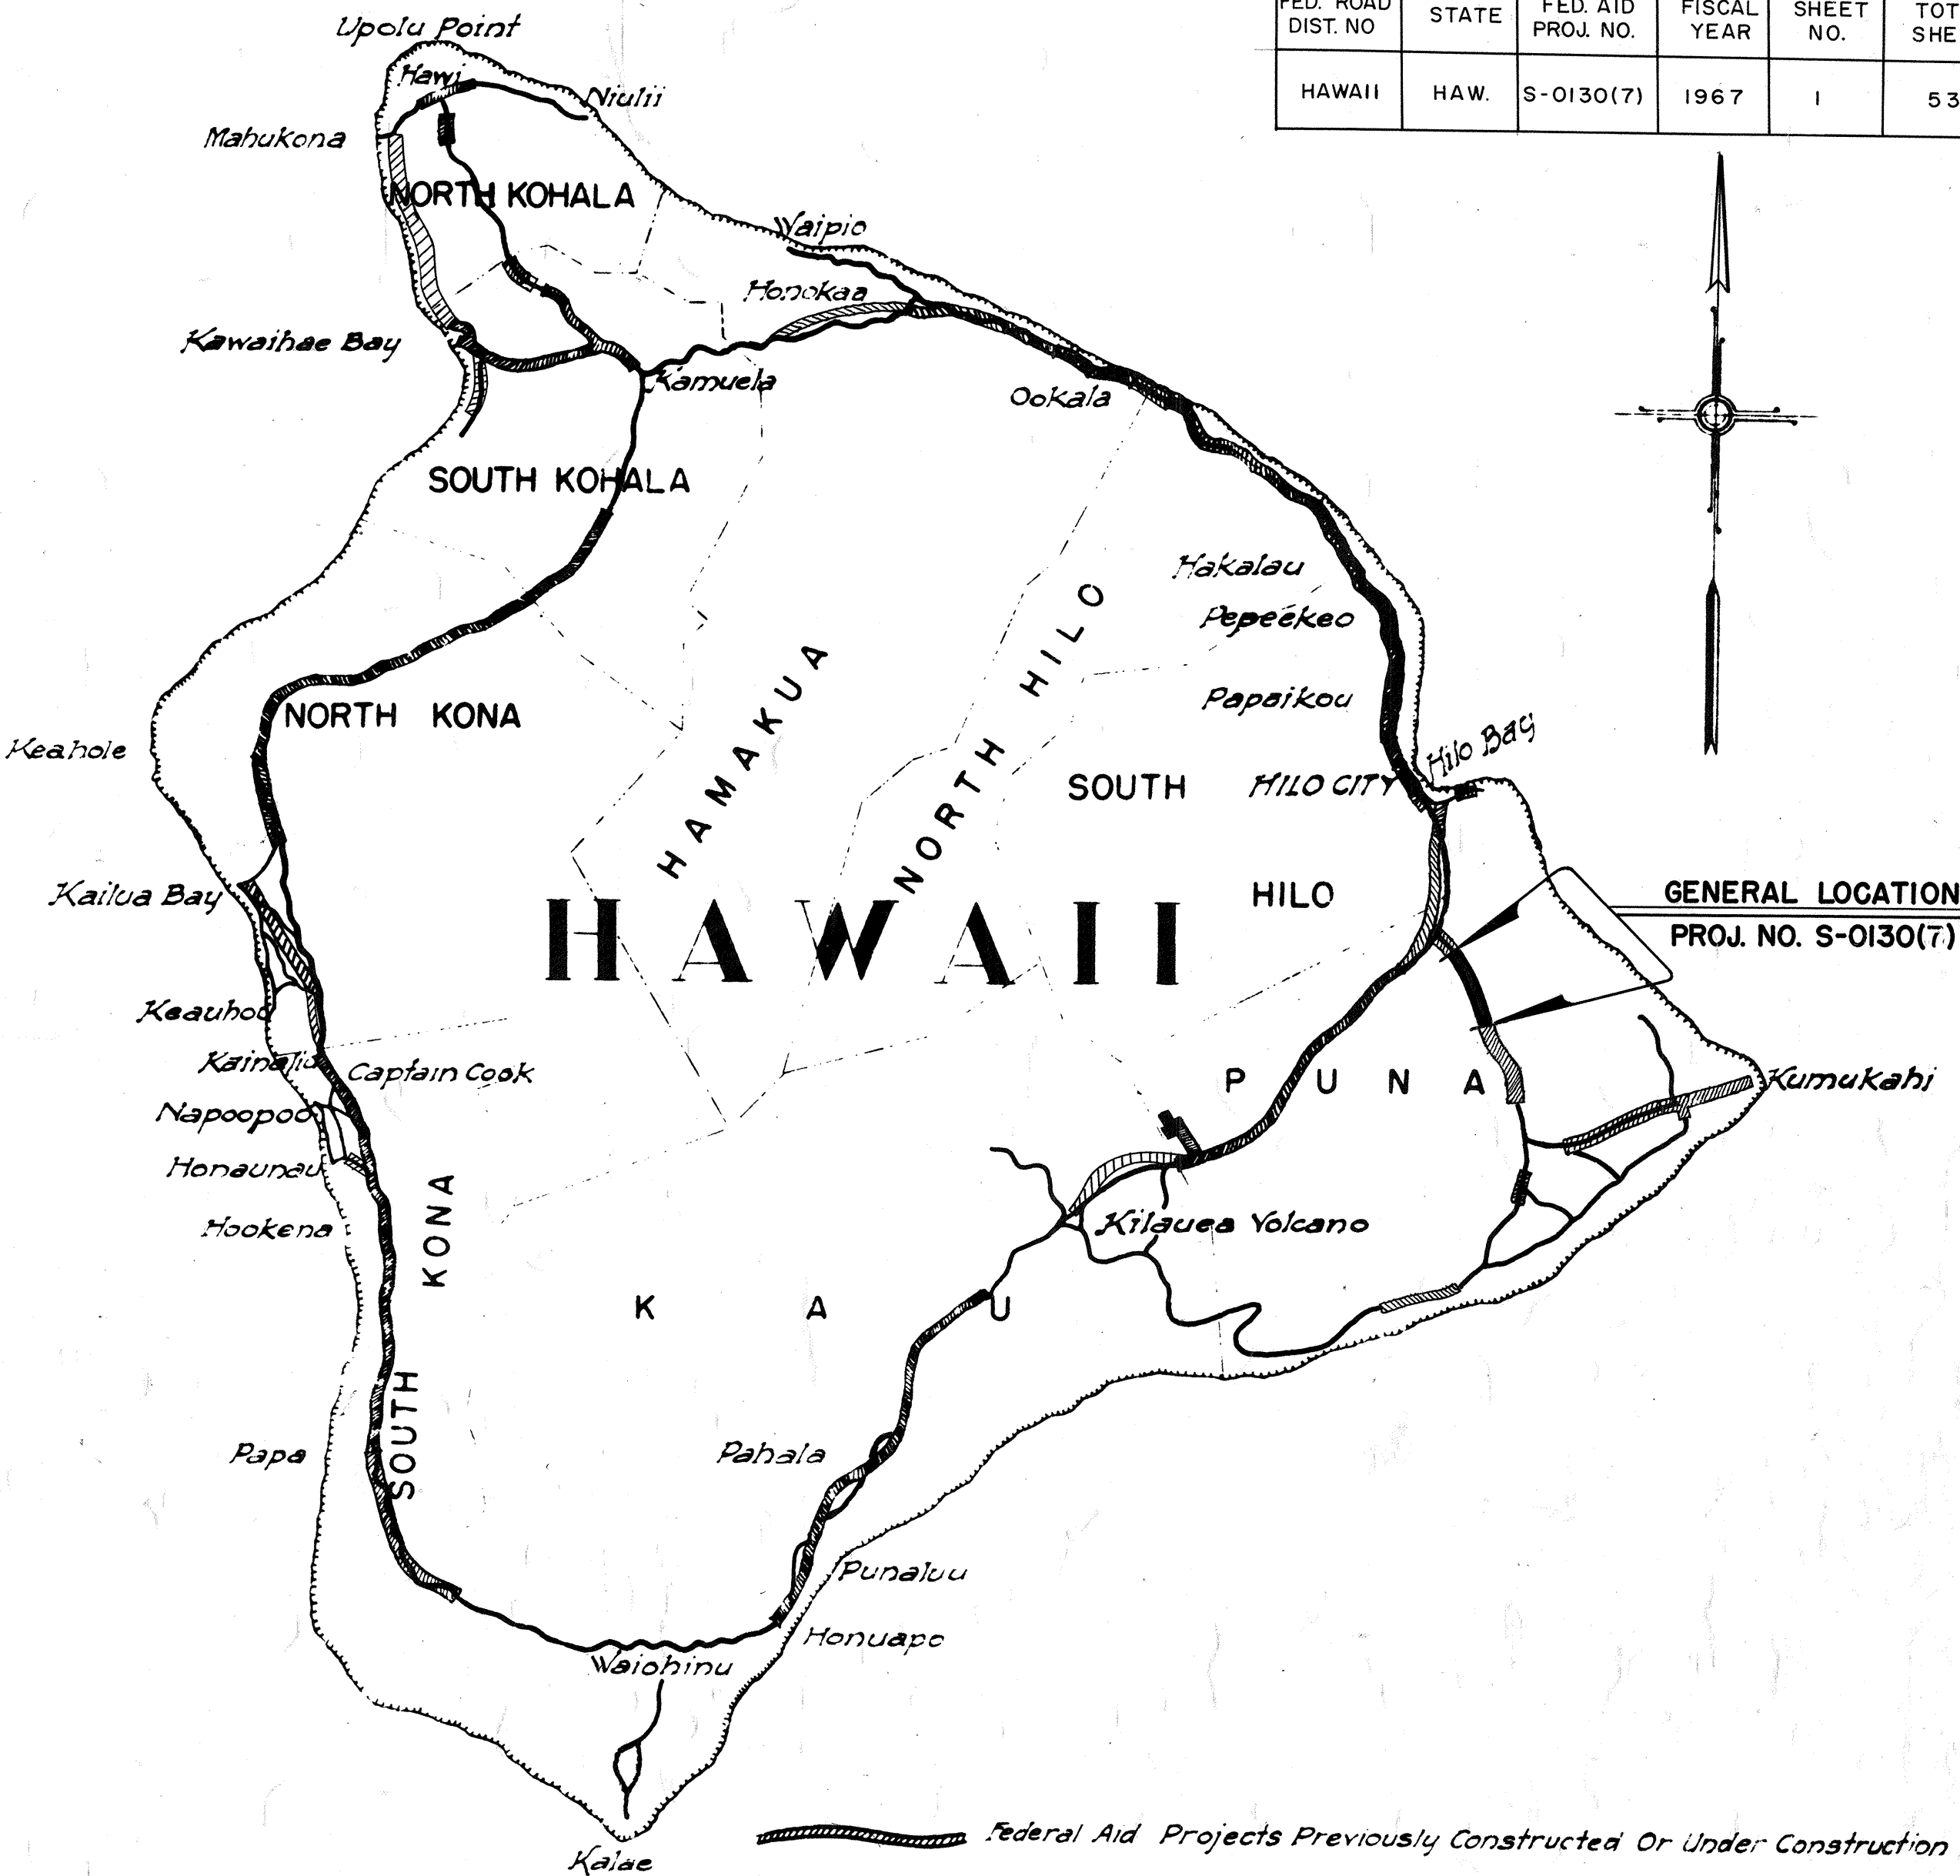

DESIGN CLASSIFICATION

ADT (1967)	1000
Design ADT (1987)	3000
DHV	12 %
D	60/40
T	13 %
V	60 M.P.H.

LAYOUT OF PROJECT

GROSS LENGTH OF PROJECT	4.346 Mi.
BRIDGE	0.015 Mi.
NET LENGTH OF ROADWAY	4.331 Mi.

APPROVED:

DATE: 7/25/67

E. Alvey Knight

DIRECTOR OF TRANSPORTATION

DEPARTMENT OF TRANSPORTATION

BUREAU OF PUBLIC ROADS

APPROVED:

John M. Stearns

DIVISION ENGINEER

9/13/67

DATE

00-0-1-3

DESIGNED BY

DATE

5/8/69

TRACED BY

DATE

5/8/69

CHECKED BY

DATE

5/8/69