

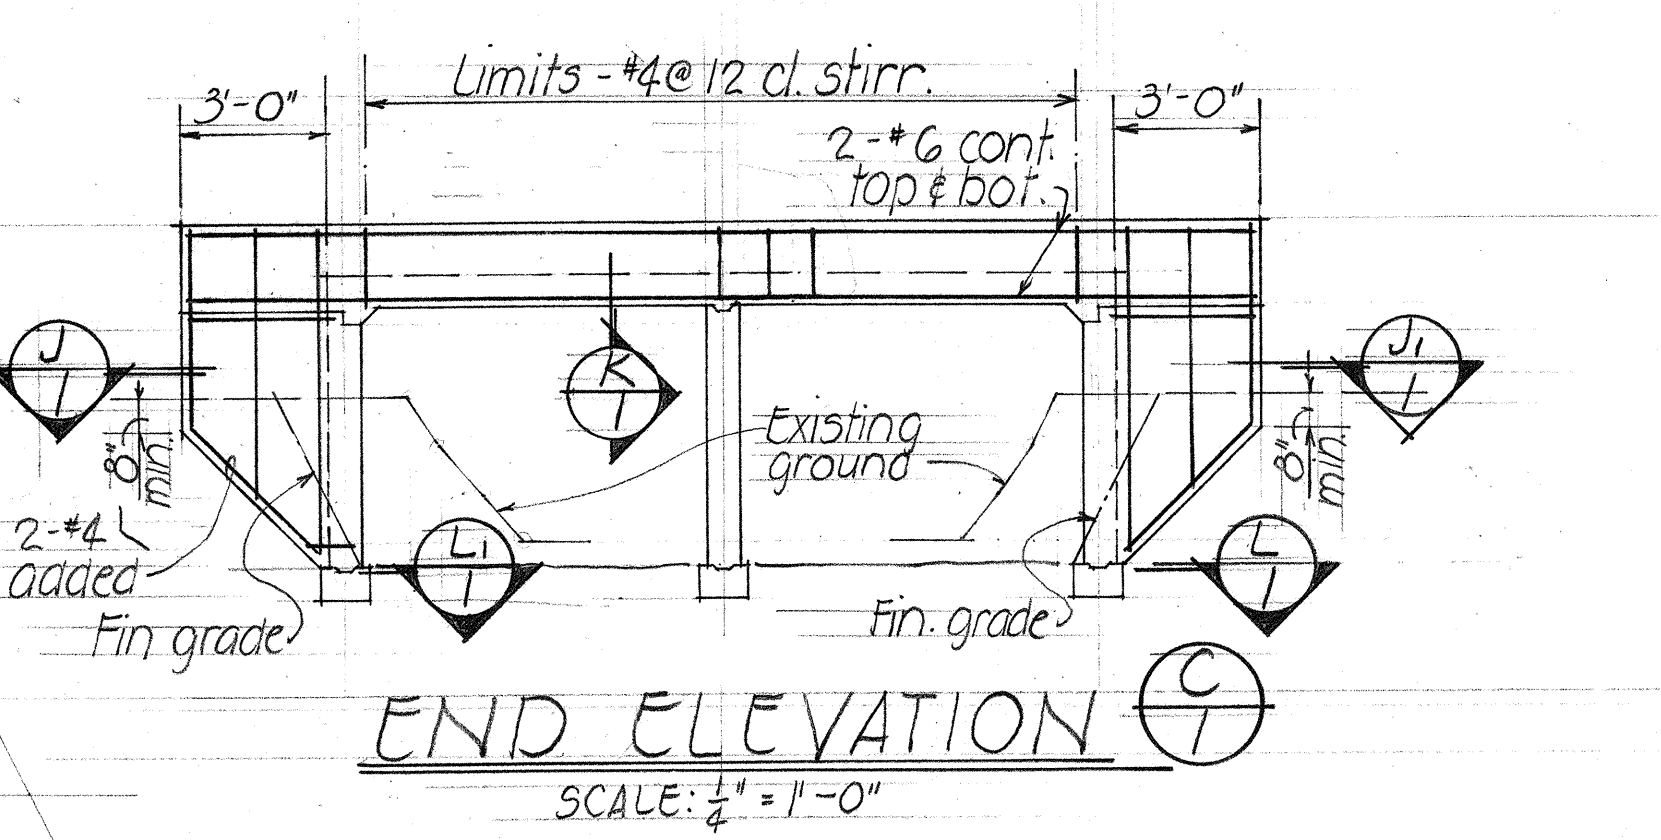
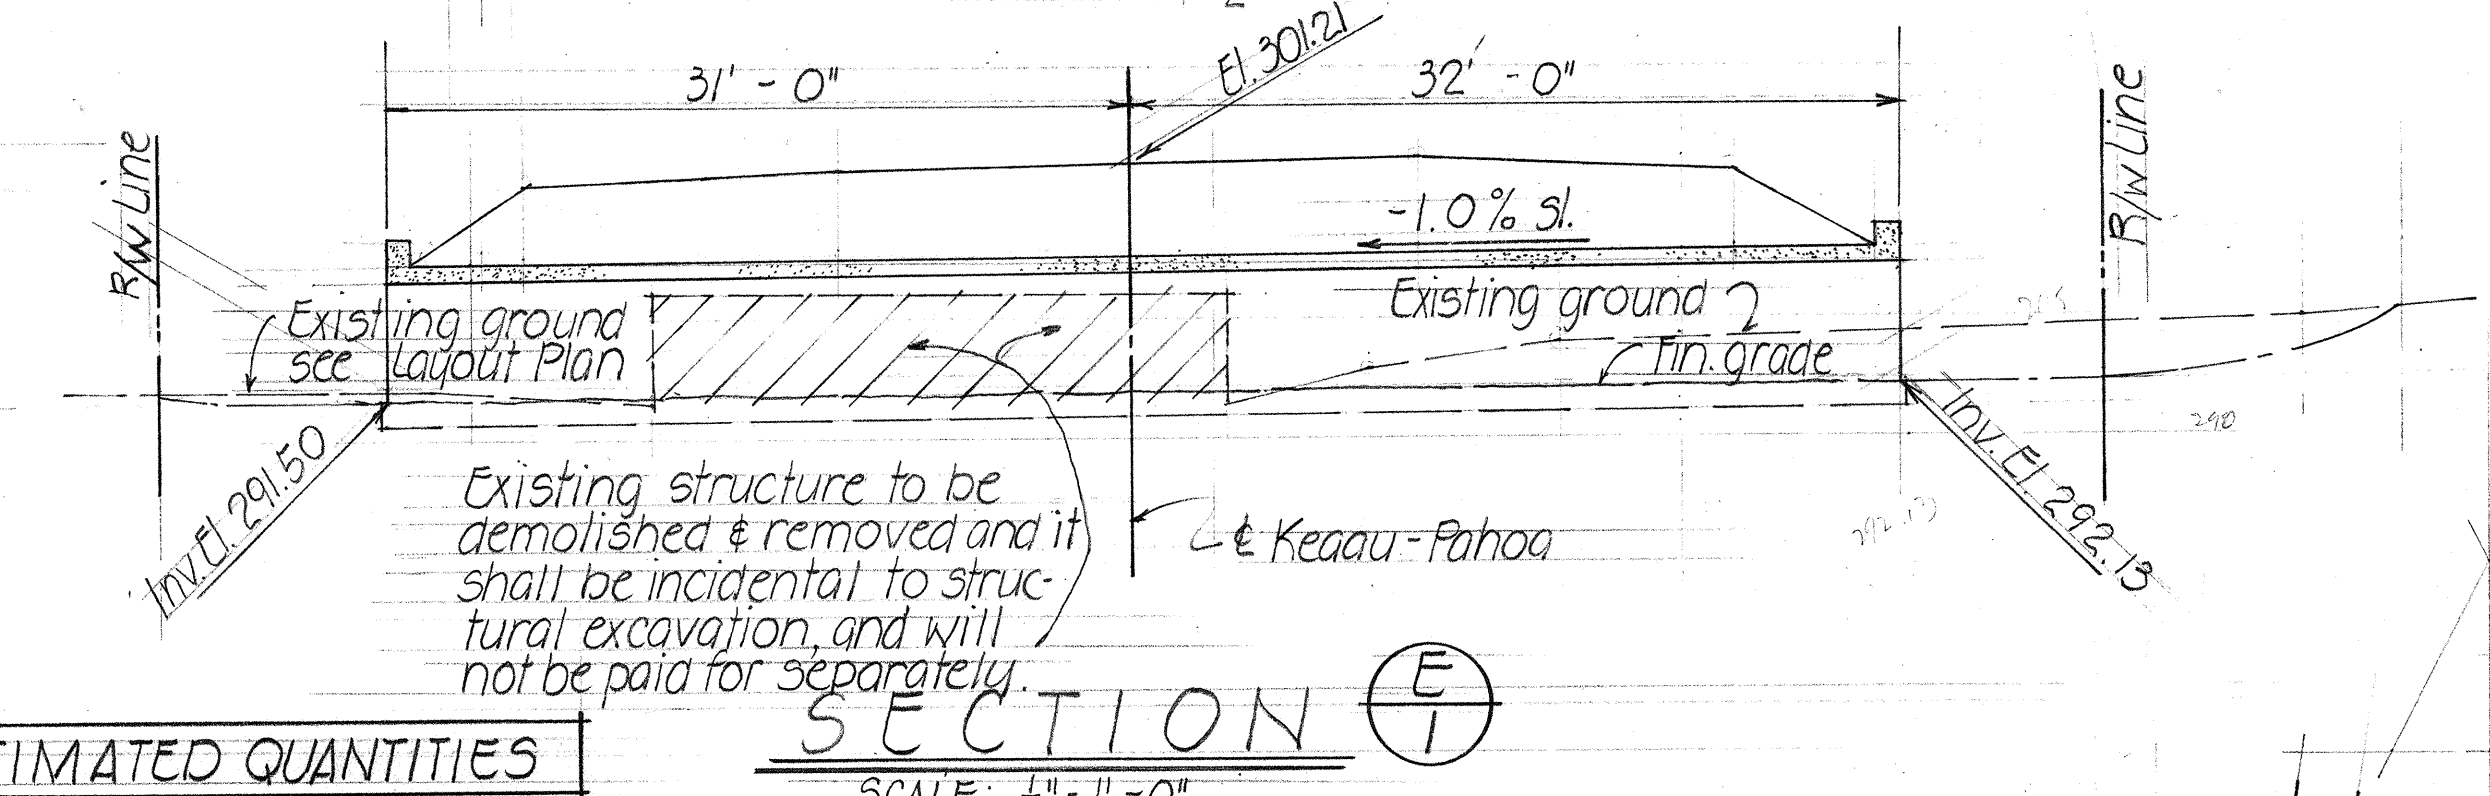
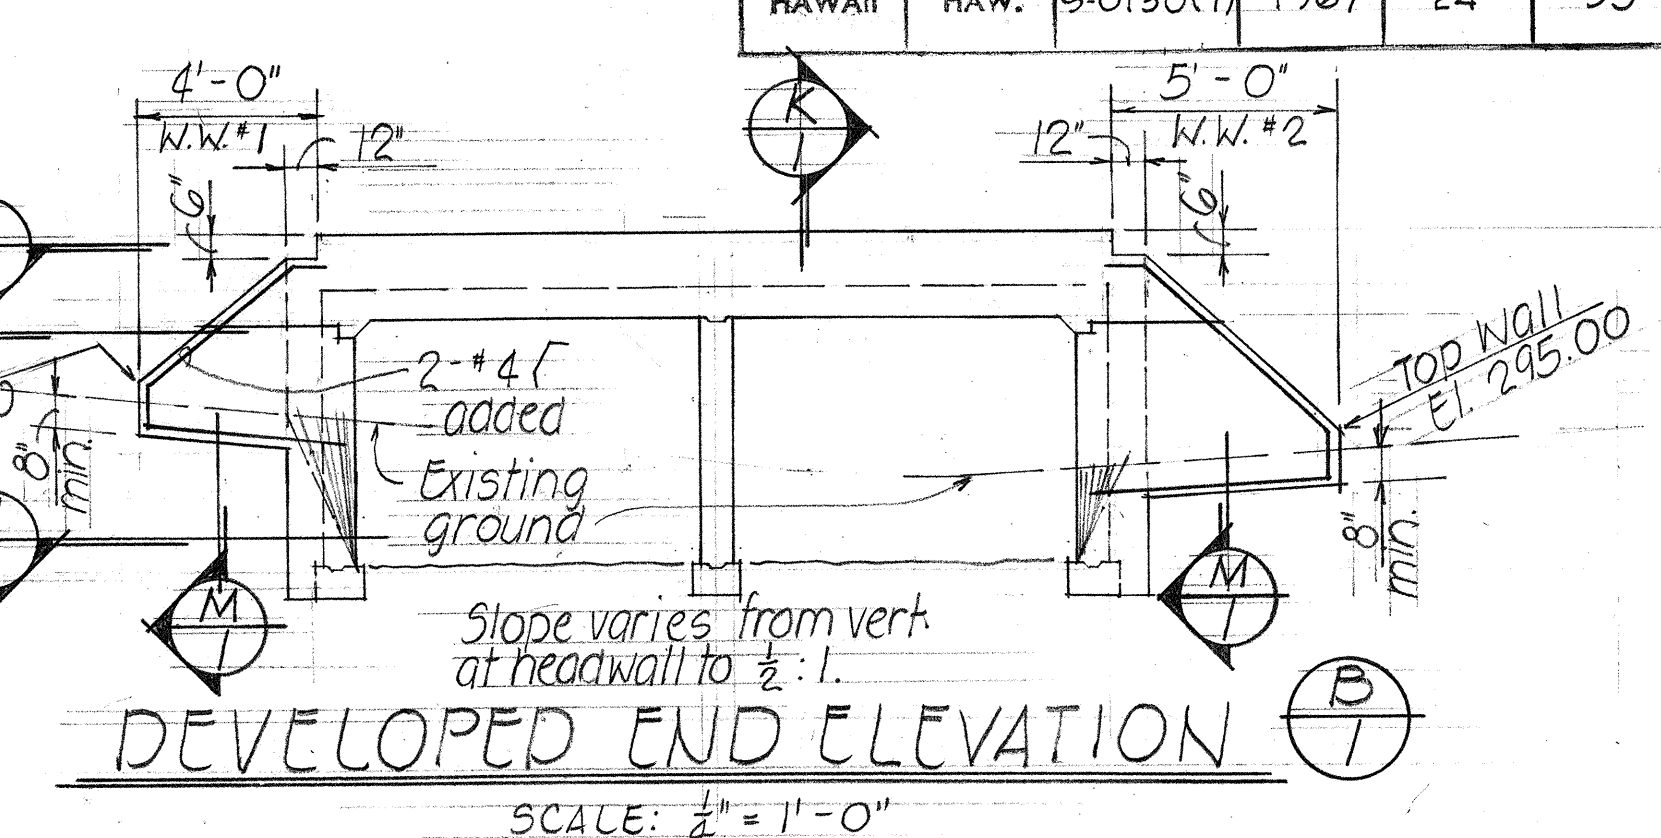
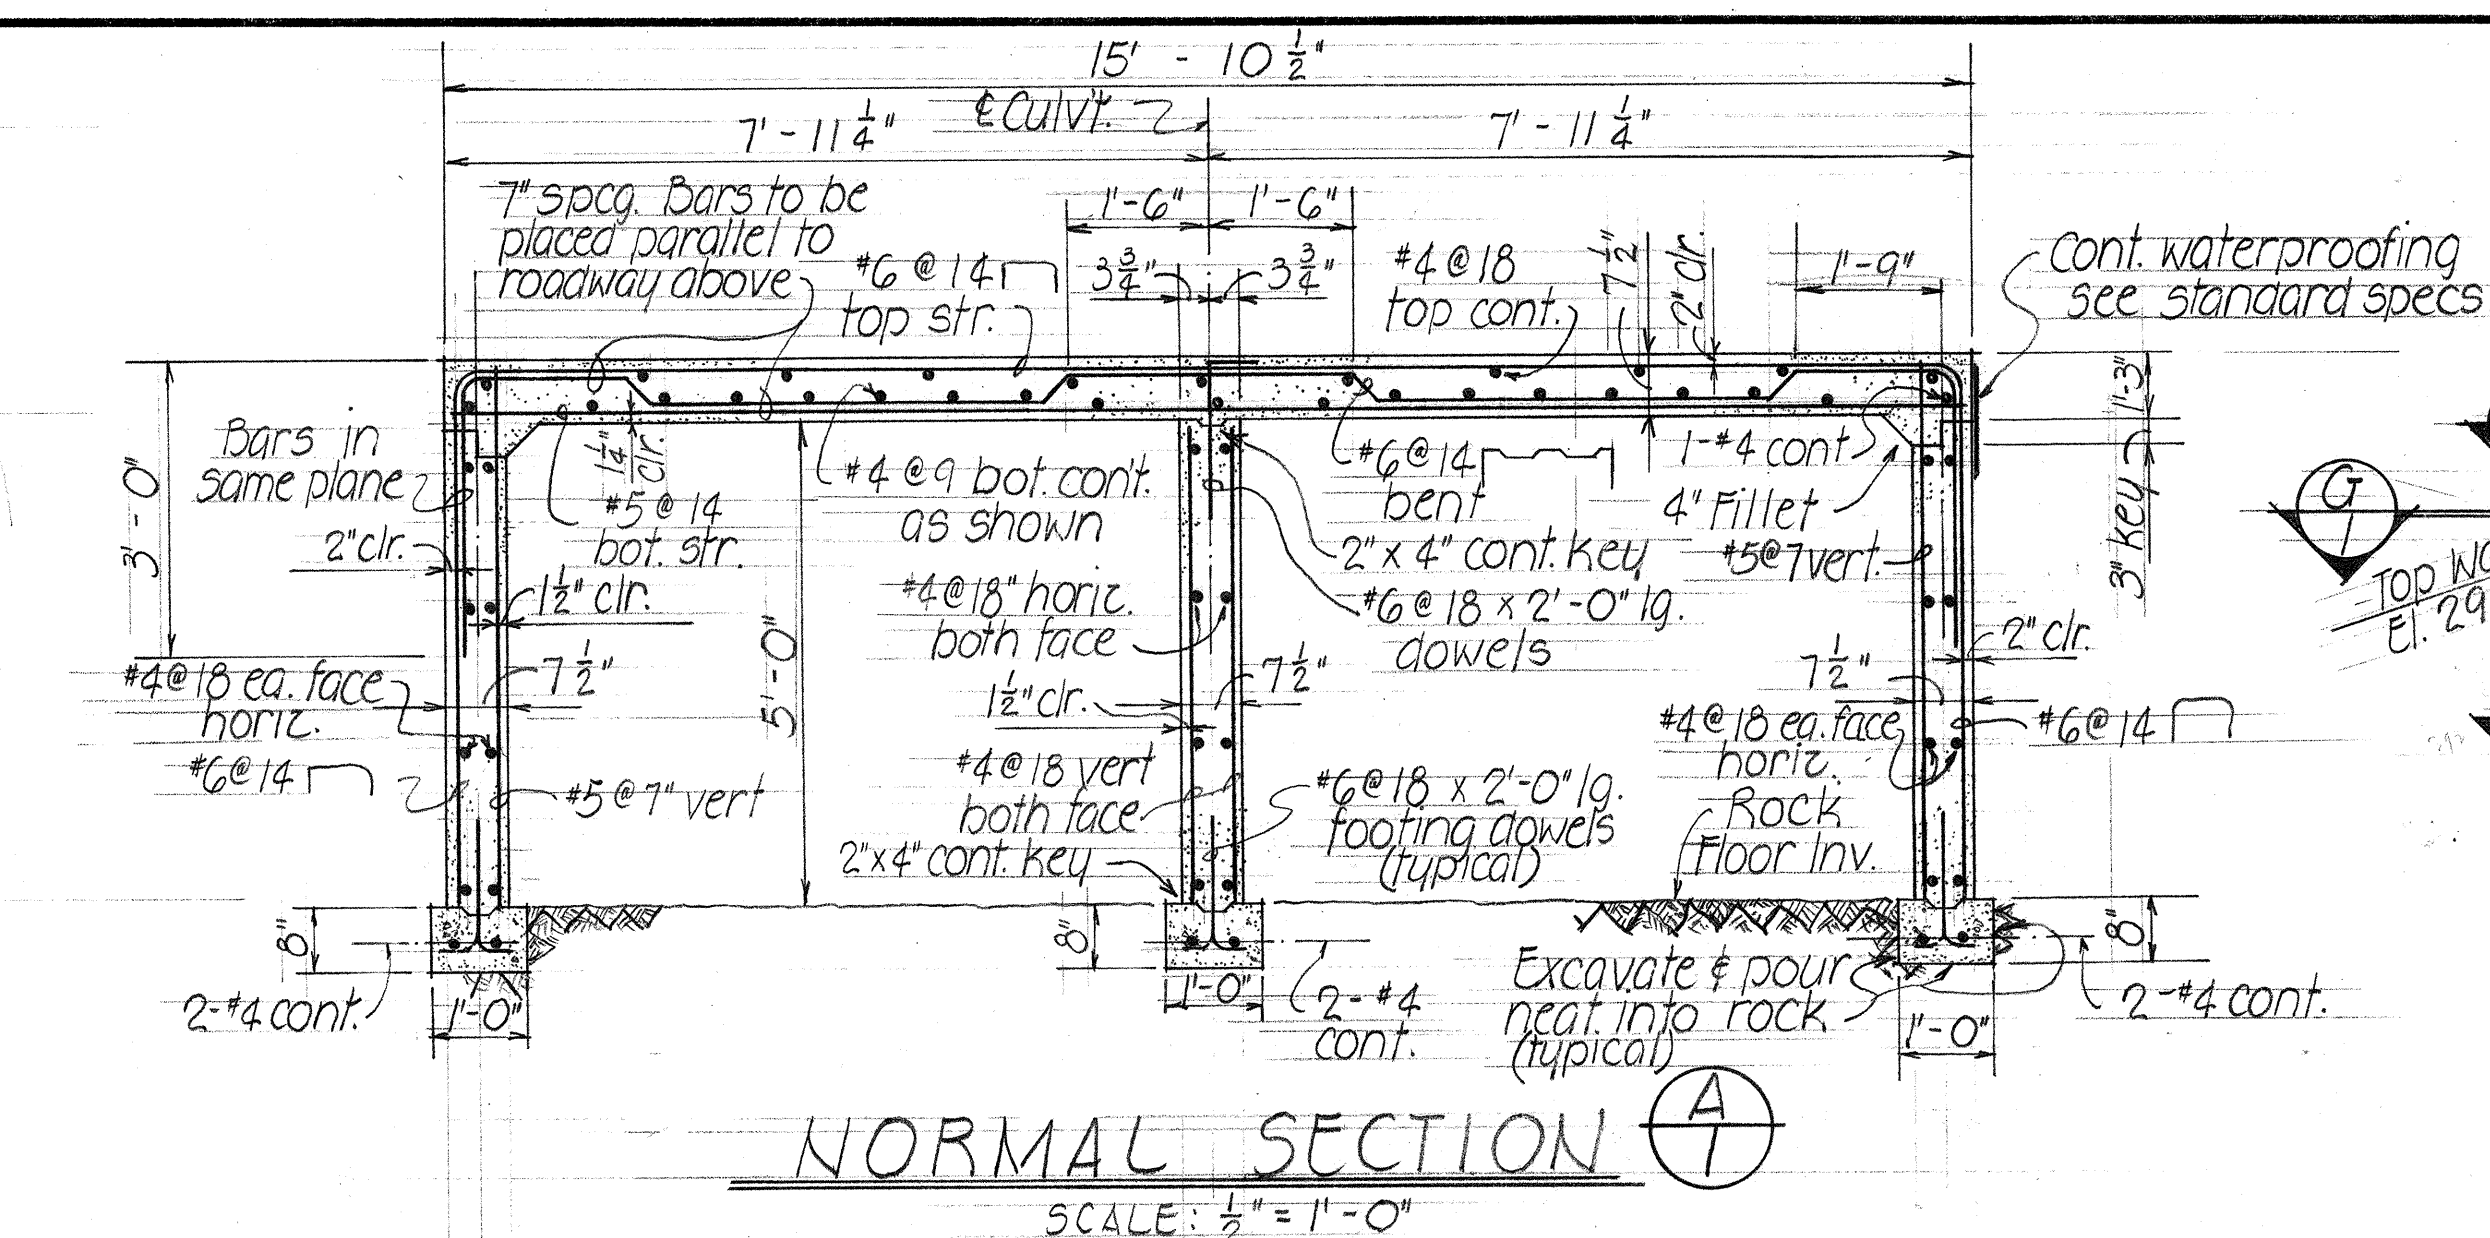
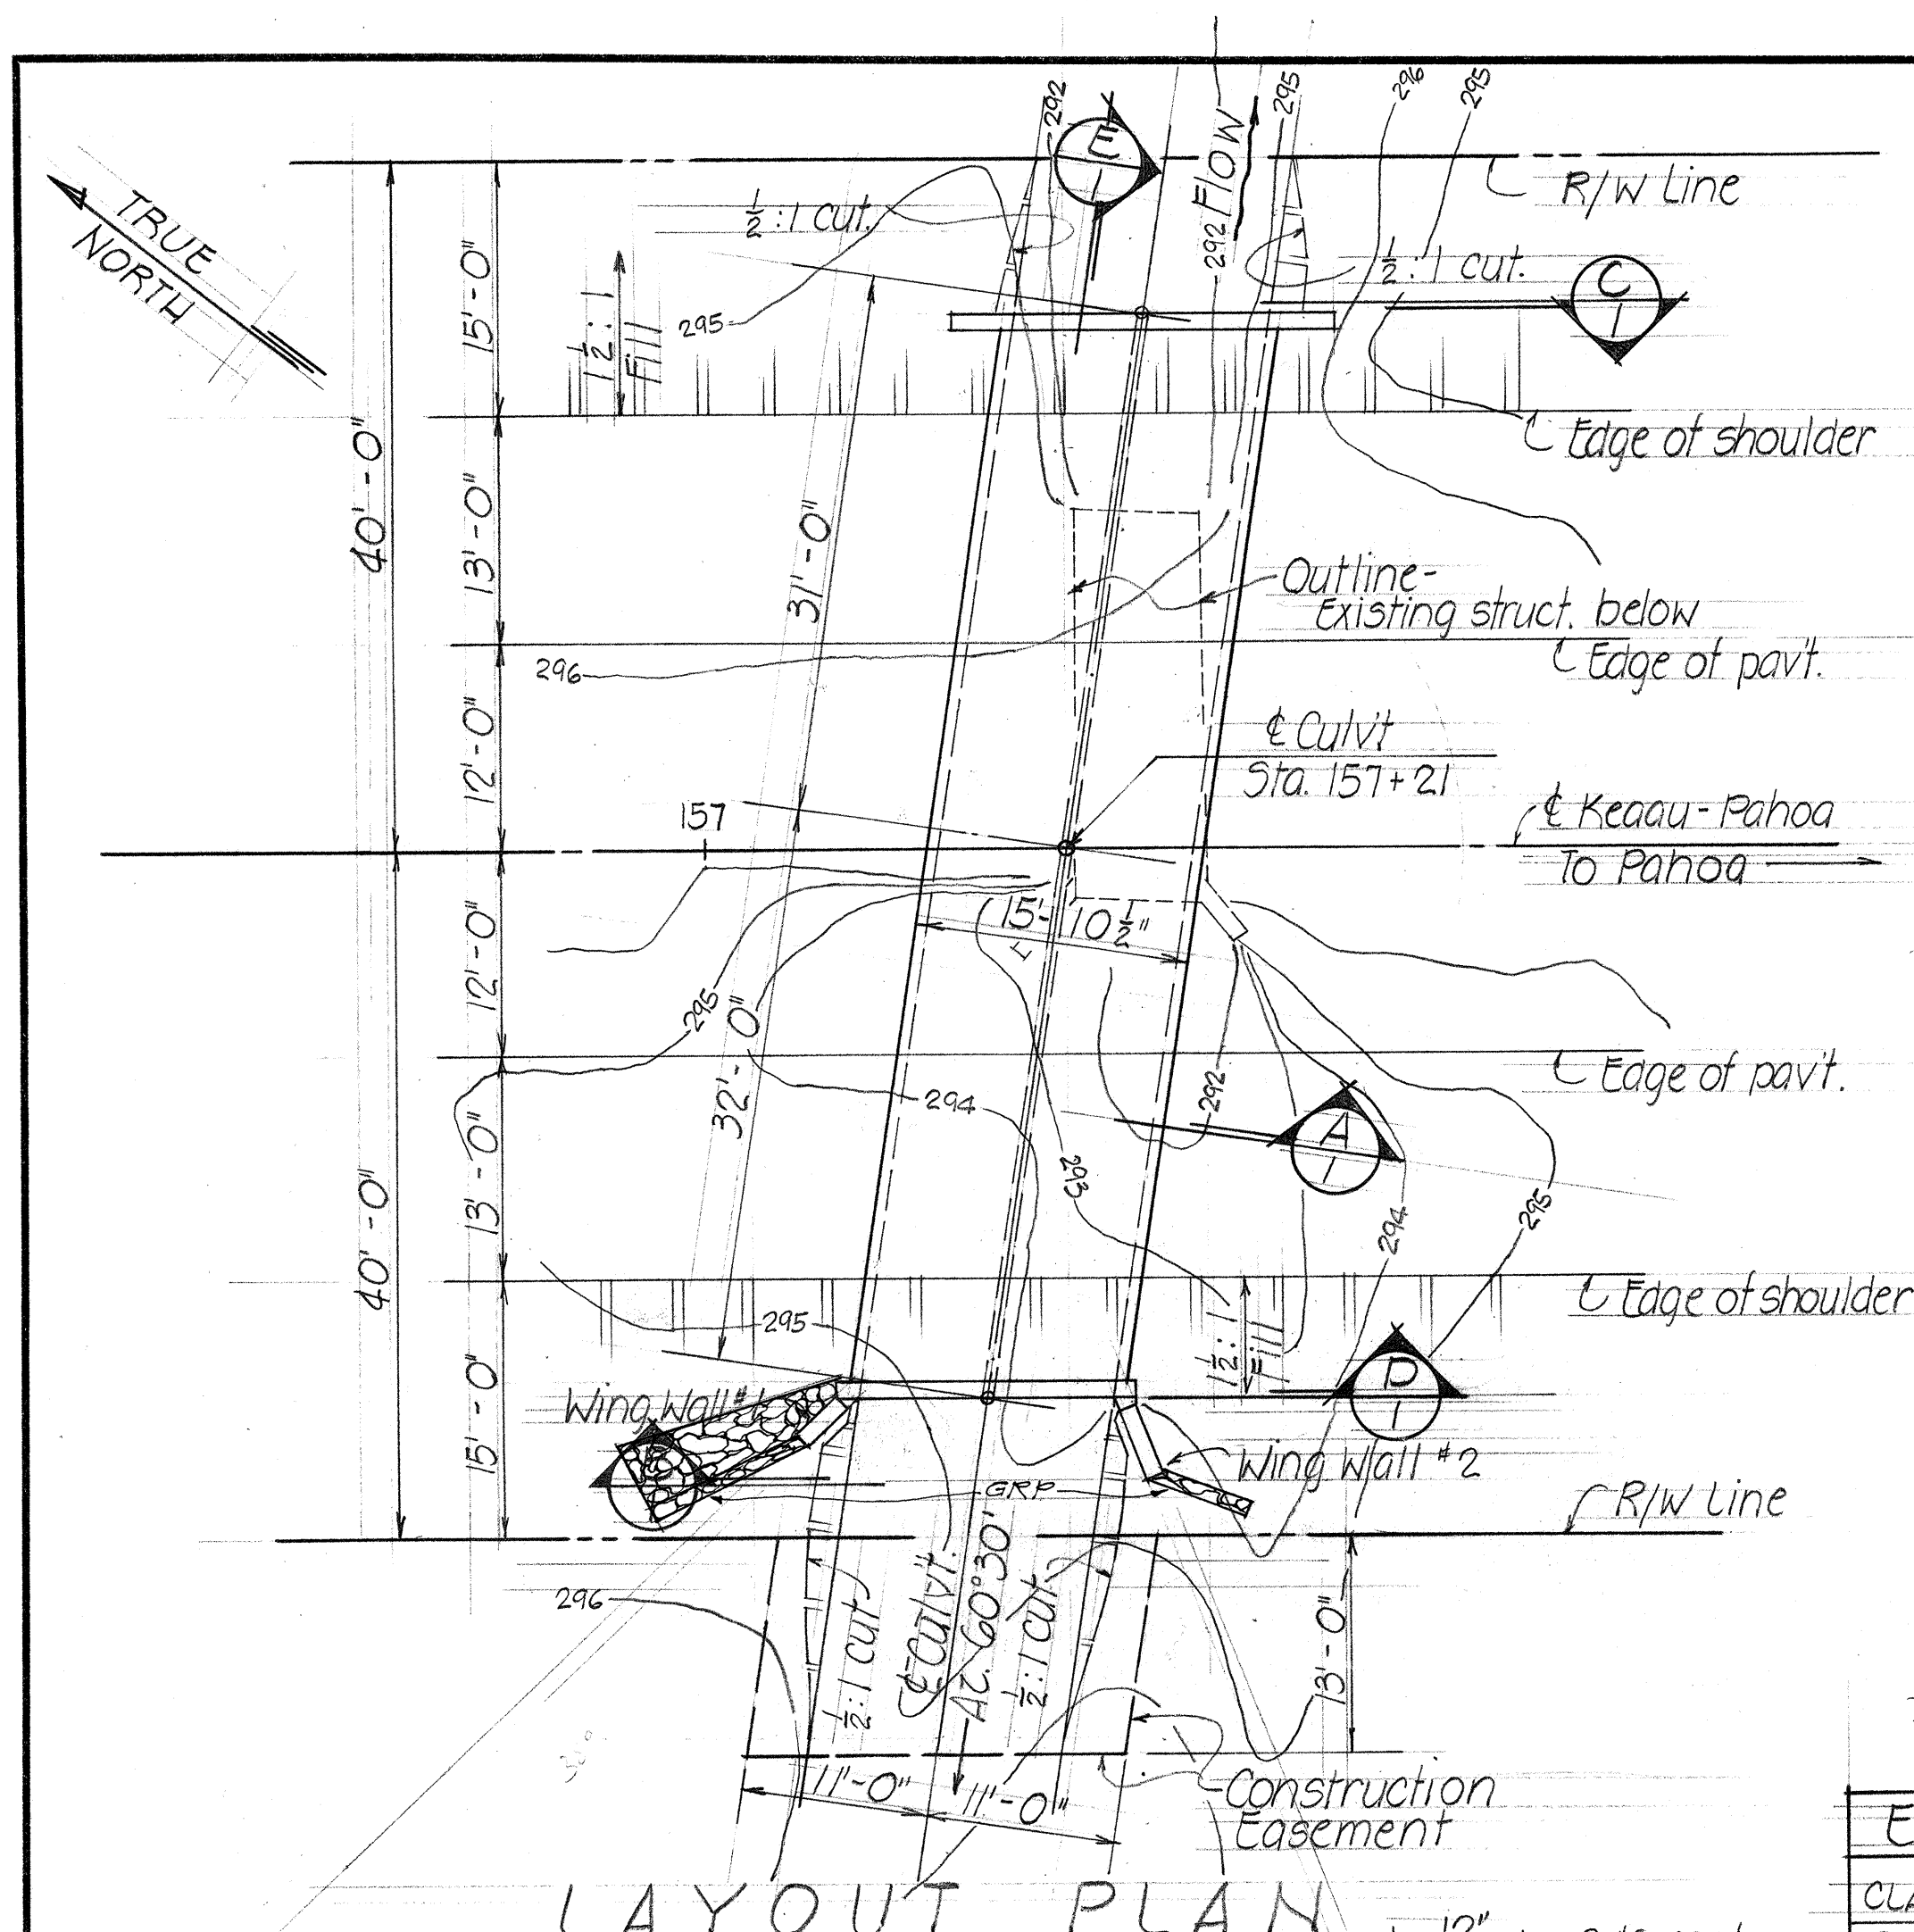
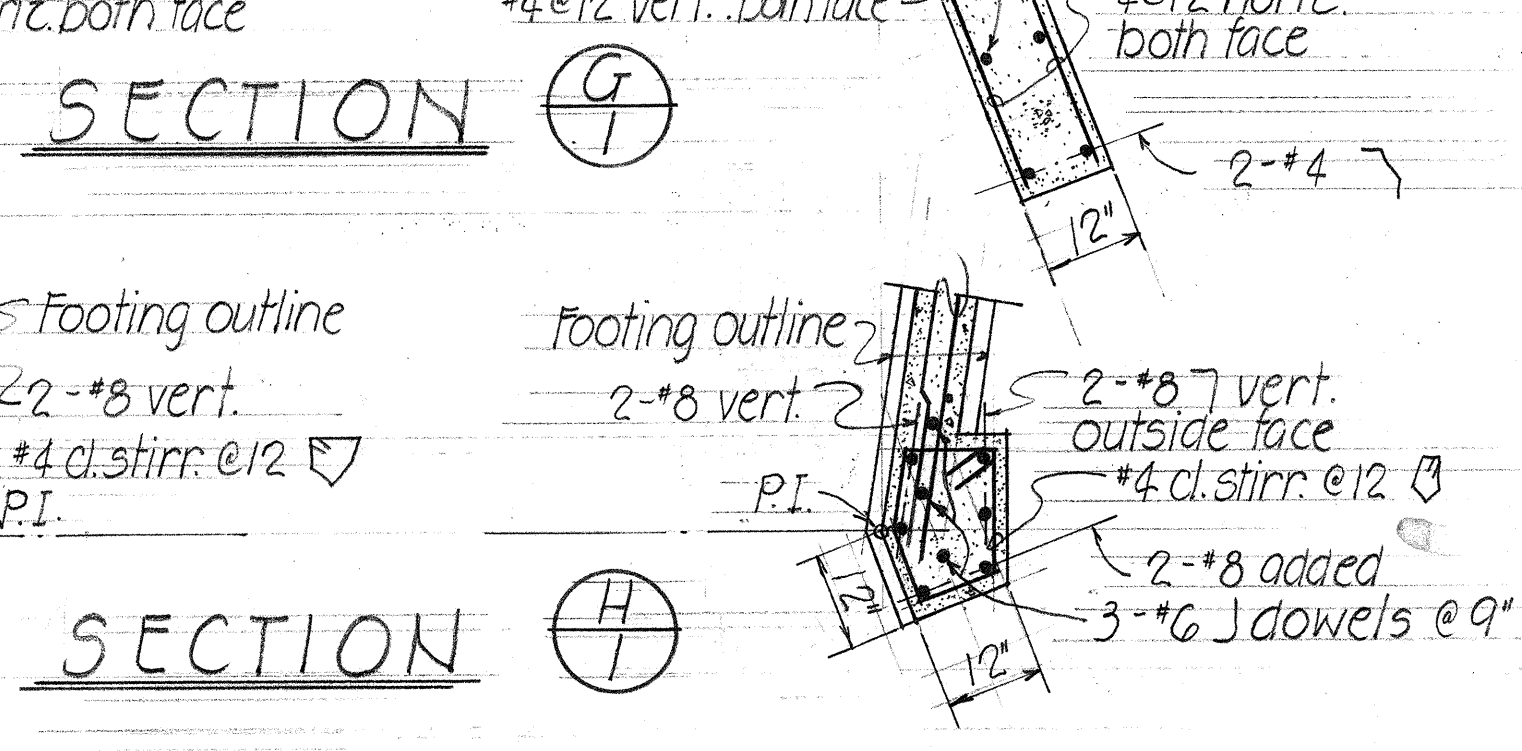
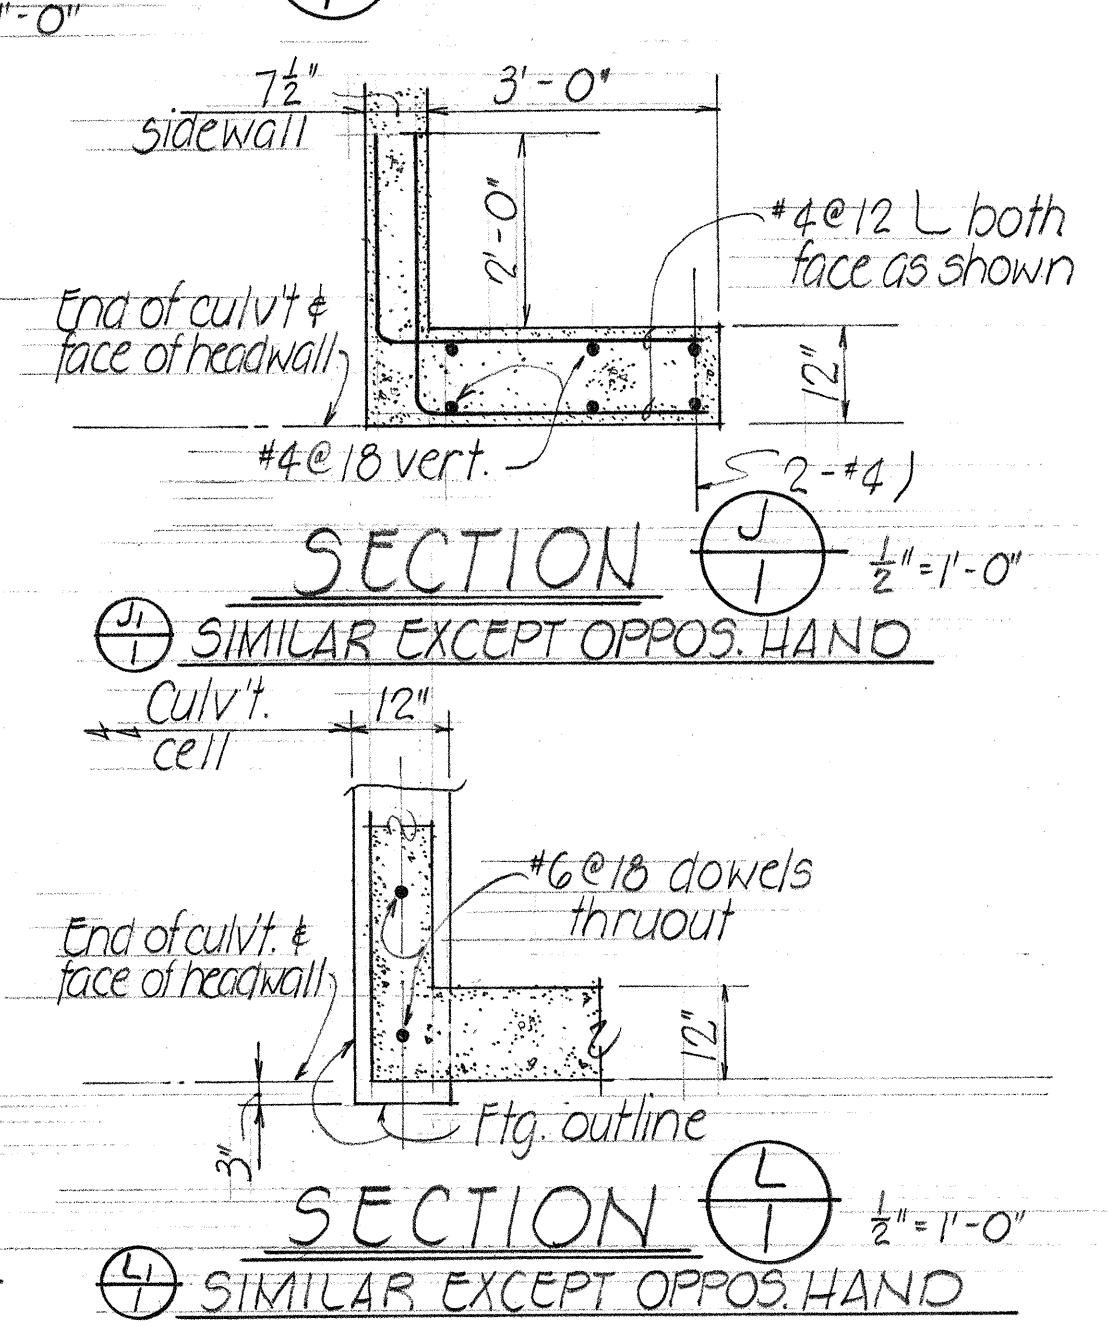
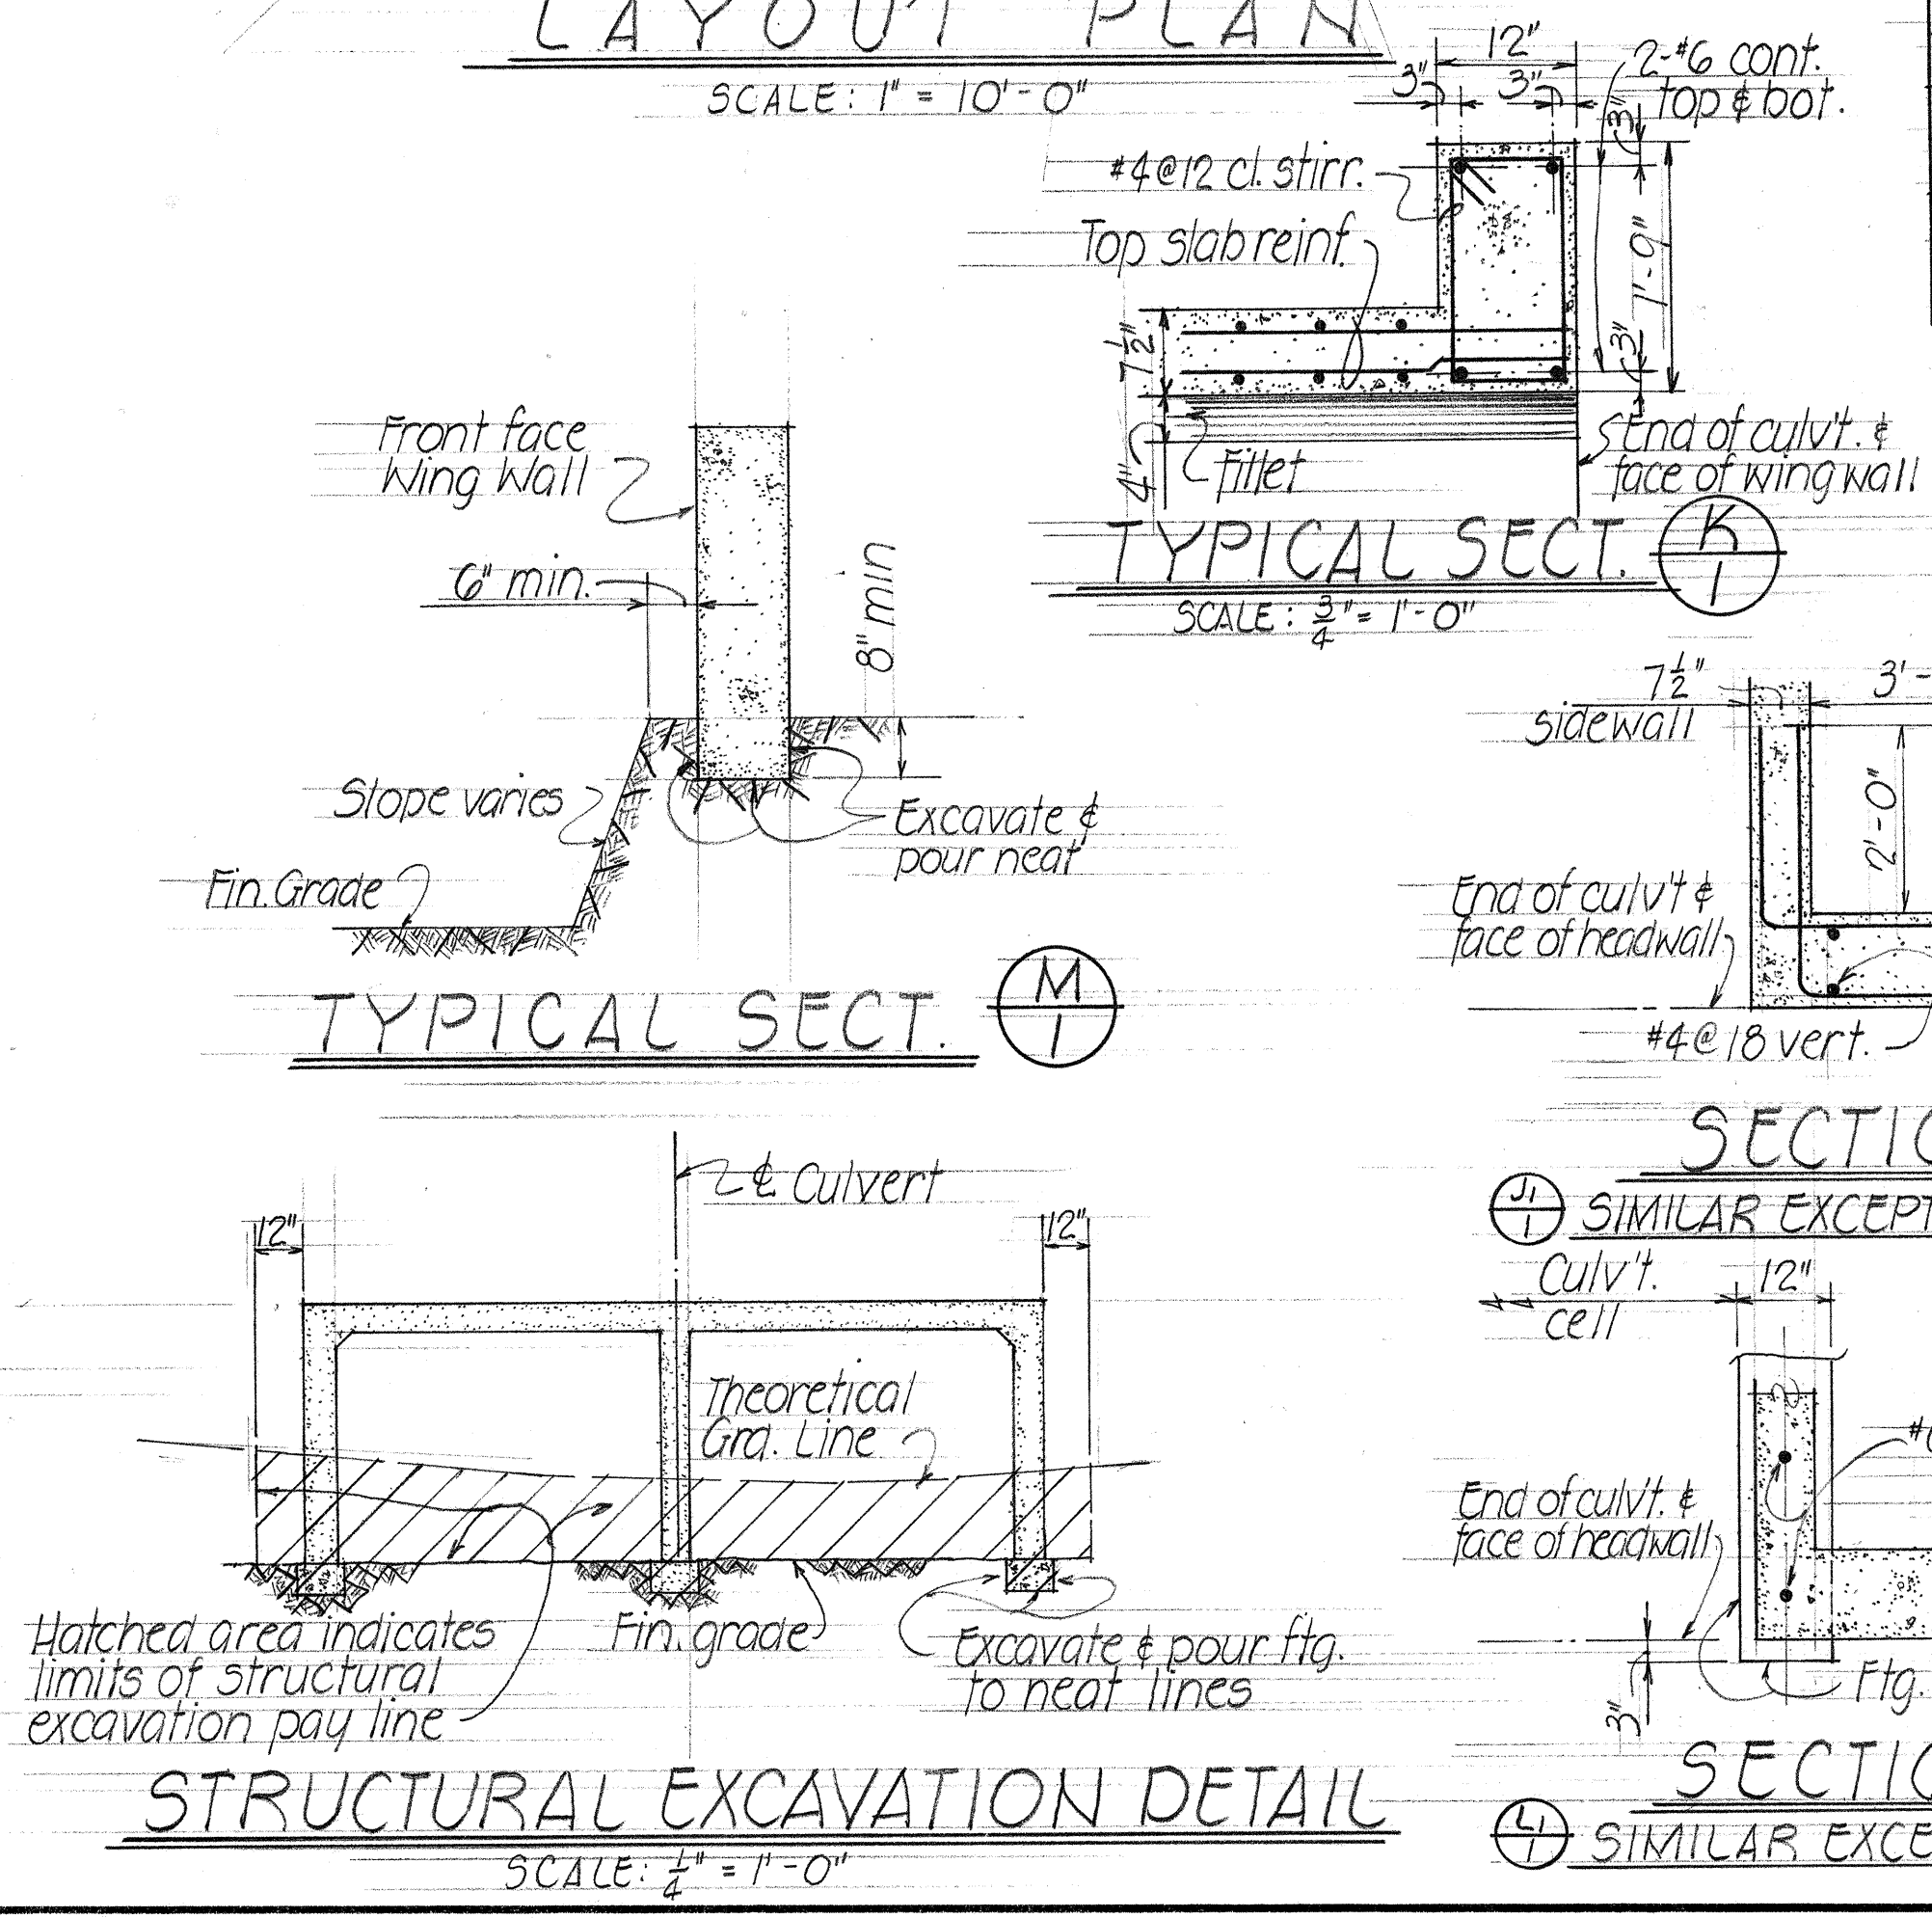
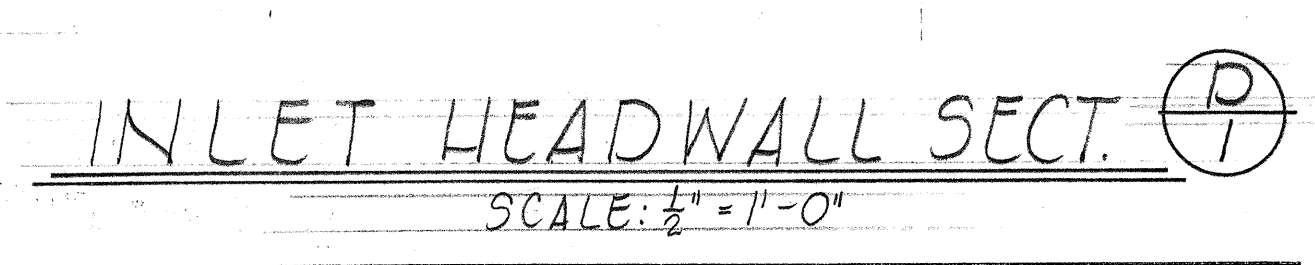


FED. ROAD DIST. NO.	STATE	FED. AID PROJ. NO.	FISCAL YEAR	SHEET NO.	TOTAL SHEETS
HAWAII	HAW.	9-0130(7)	1967	24	53

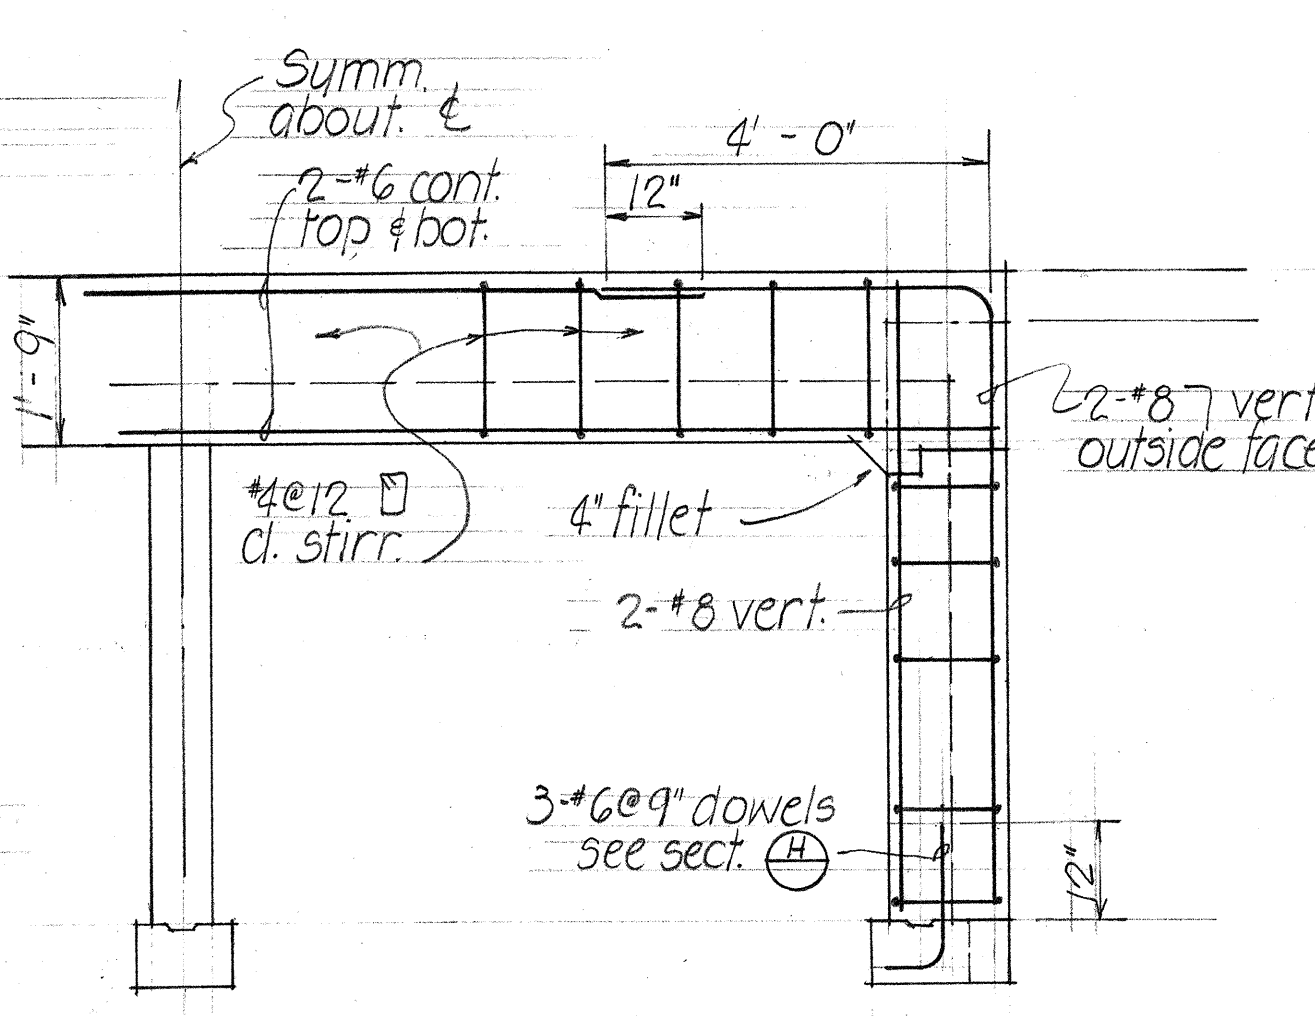

ESTIMATED QUANTITIES	
CLASS A-1 CONCRETE	59.8 (54.4) CY
REINFORCING STEEL	10.8 (12.4) 2.5"
STRUCTURAL EXC.	125.4 110 CY
CHANNEL EXC.	32.6 40 CY
GRP	39 CY

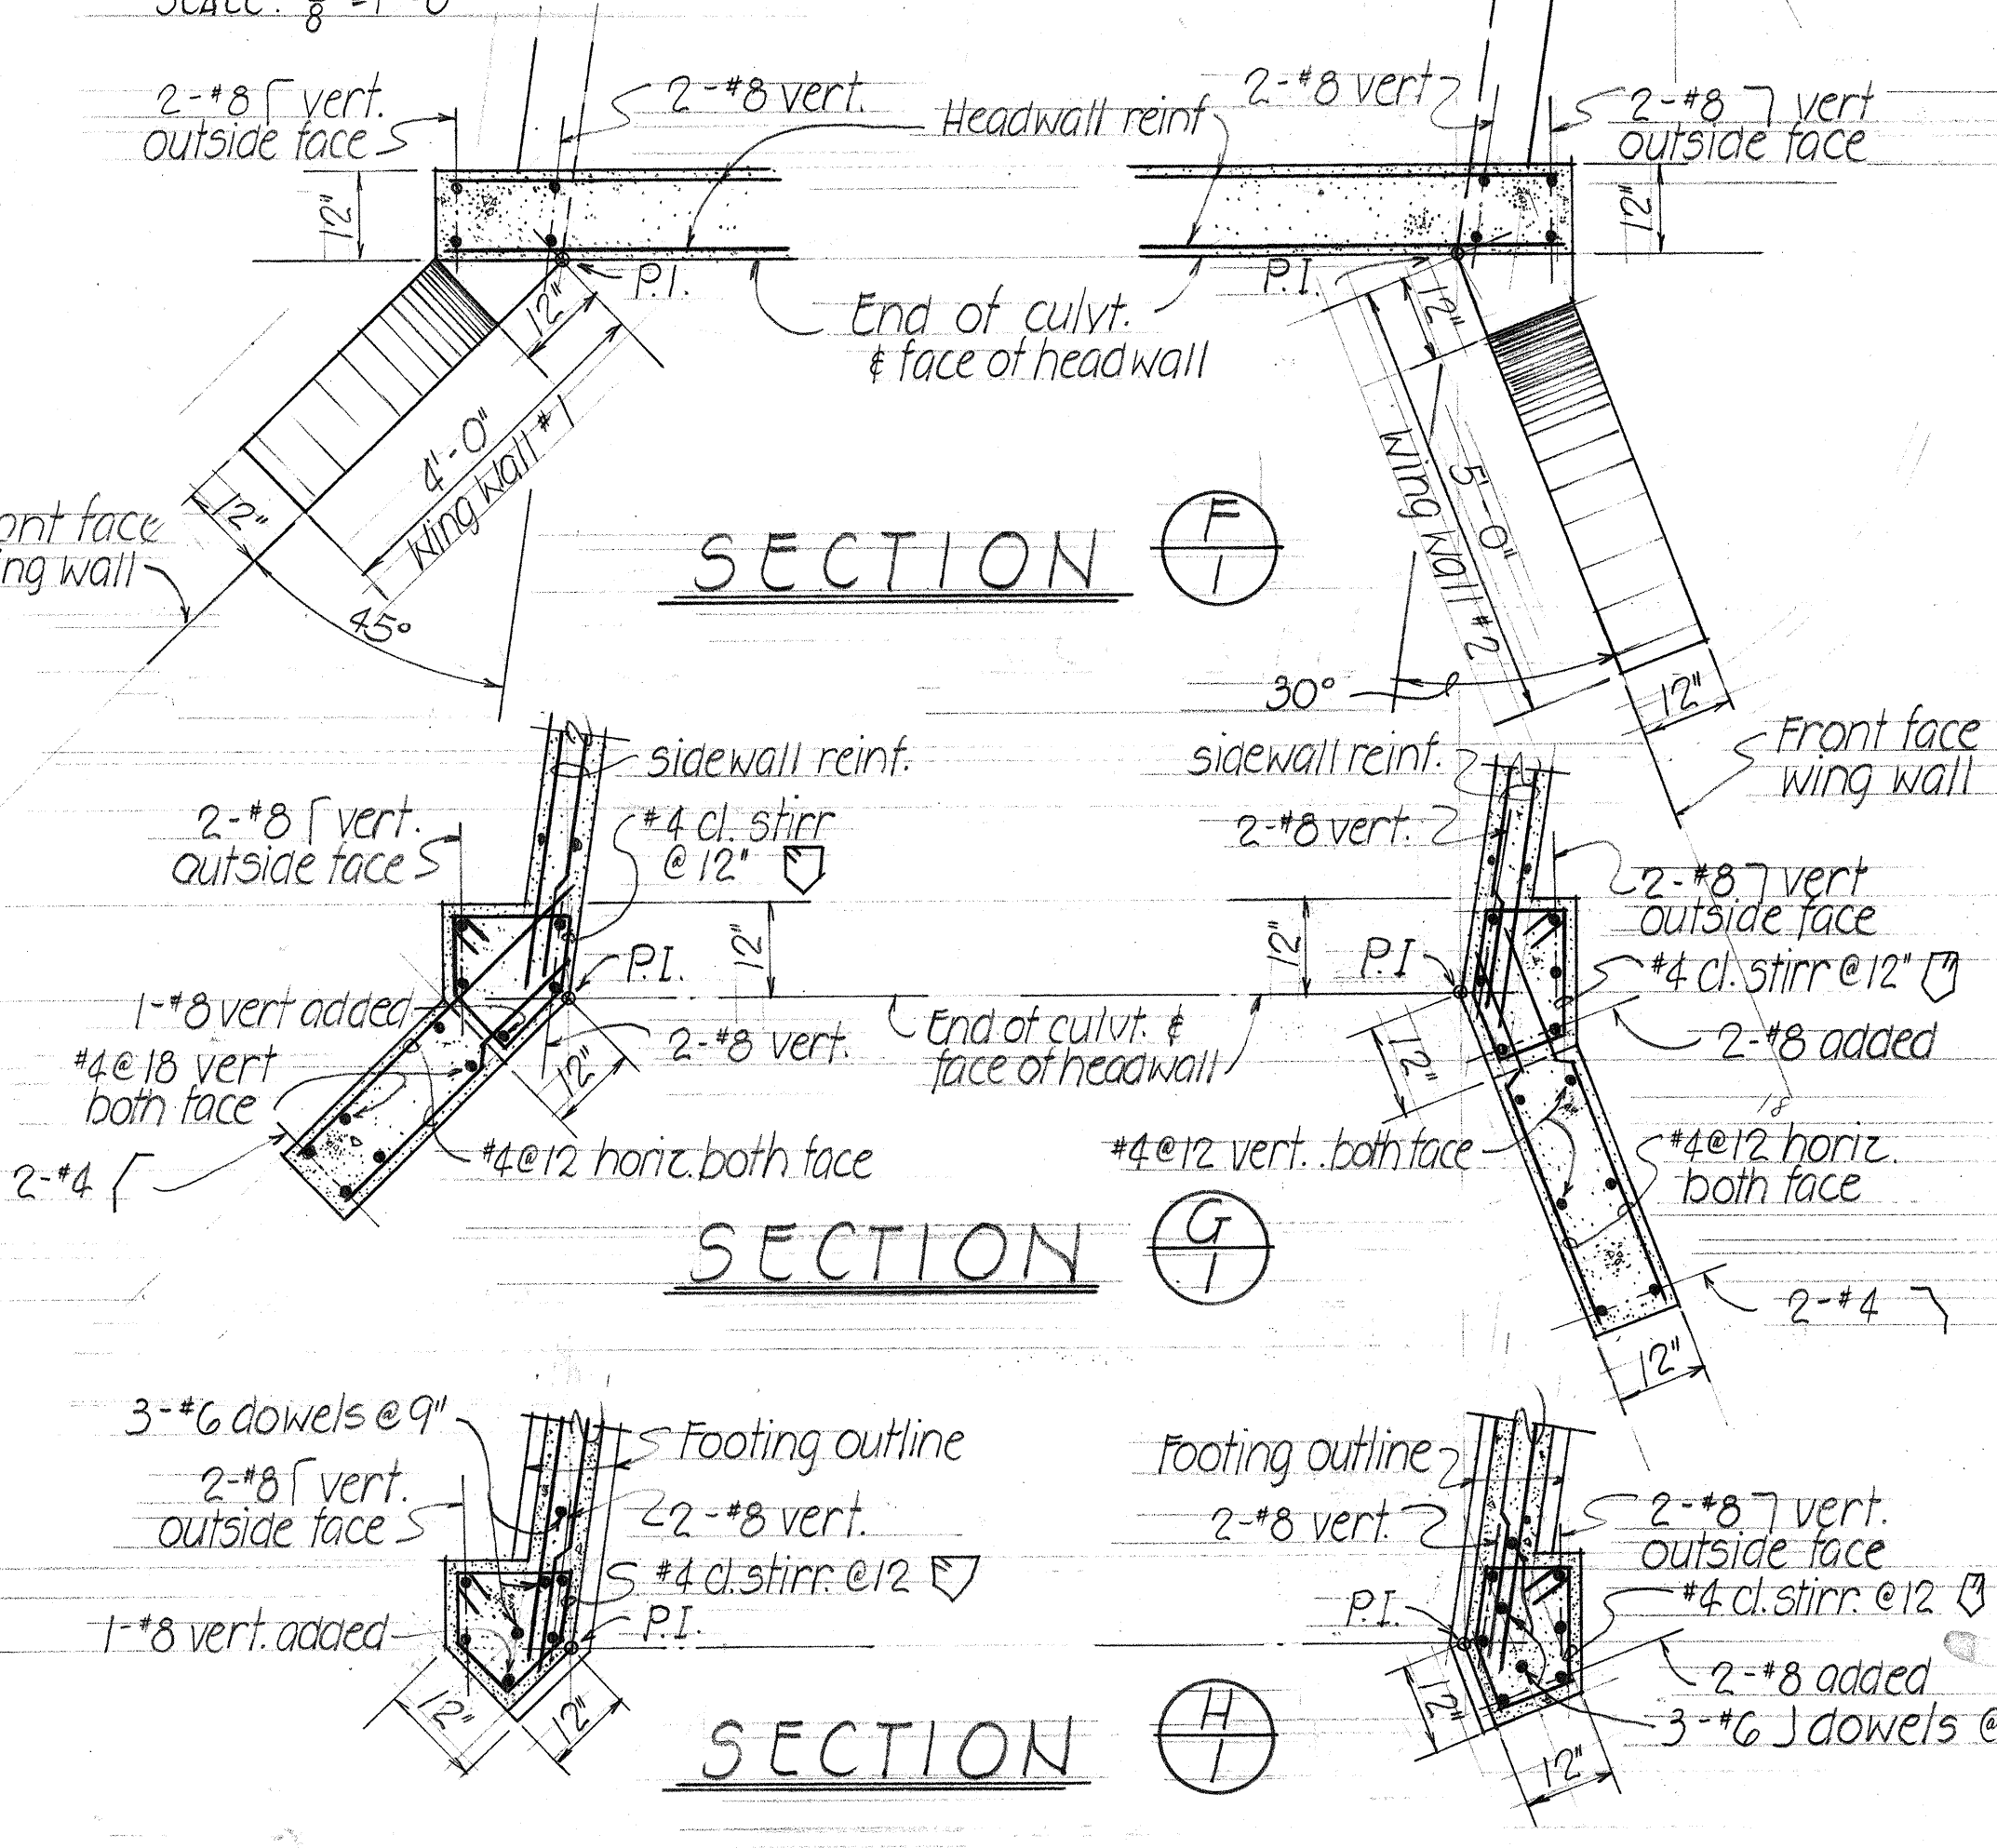

STATE OF HAWAII
DEPARTMENT OF TRANSPORTATION
HIGHWAYS DIVISION

TWIN 7' x 5' BOX CULVERT

KEAAU - PAHOA RD STA. 157+21

PROJ. N° S-0130(7) DATE: MAY, 1967

SHEET No. / OF / SHEETS