
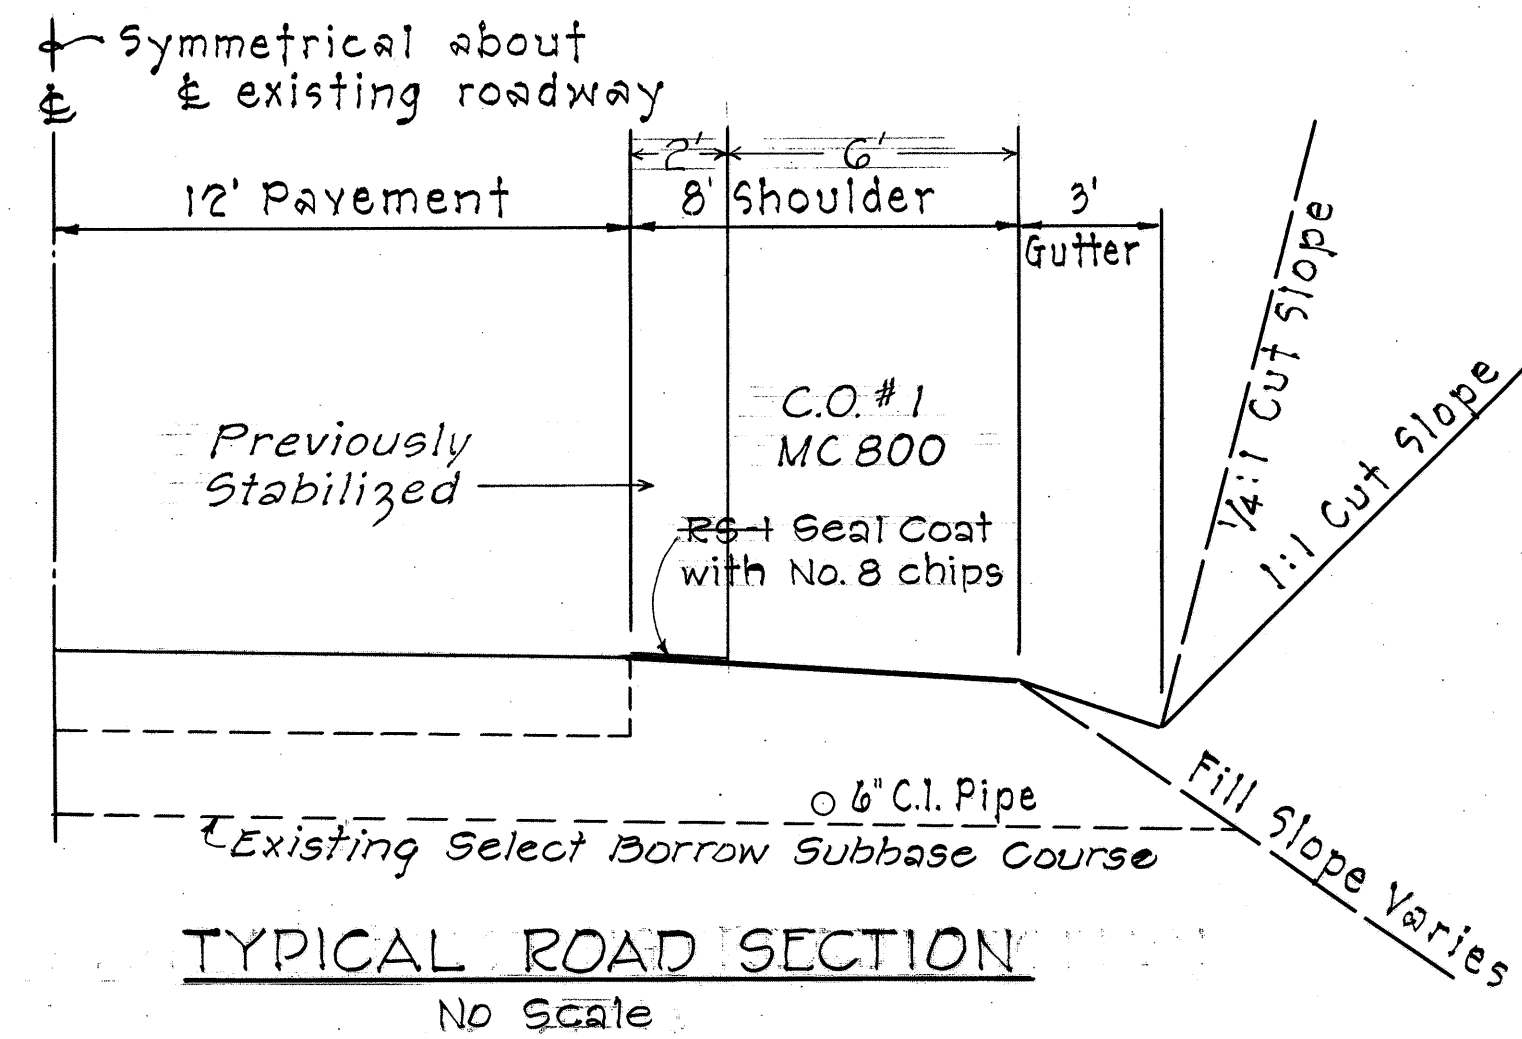


FED. ROAD DIST. NO.	STATE	PROJ. NO.	FISCAL YEAR	SHEET NO.	TOTAL SHEETS
HAWAII	HAW.	130B-01-69	1969	2	3

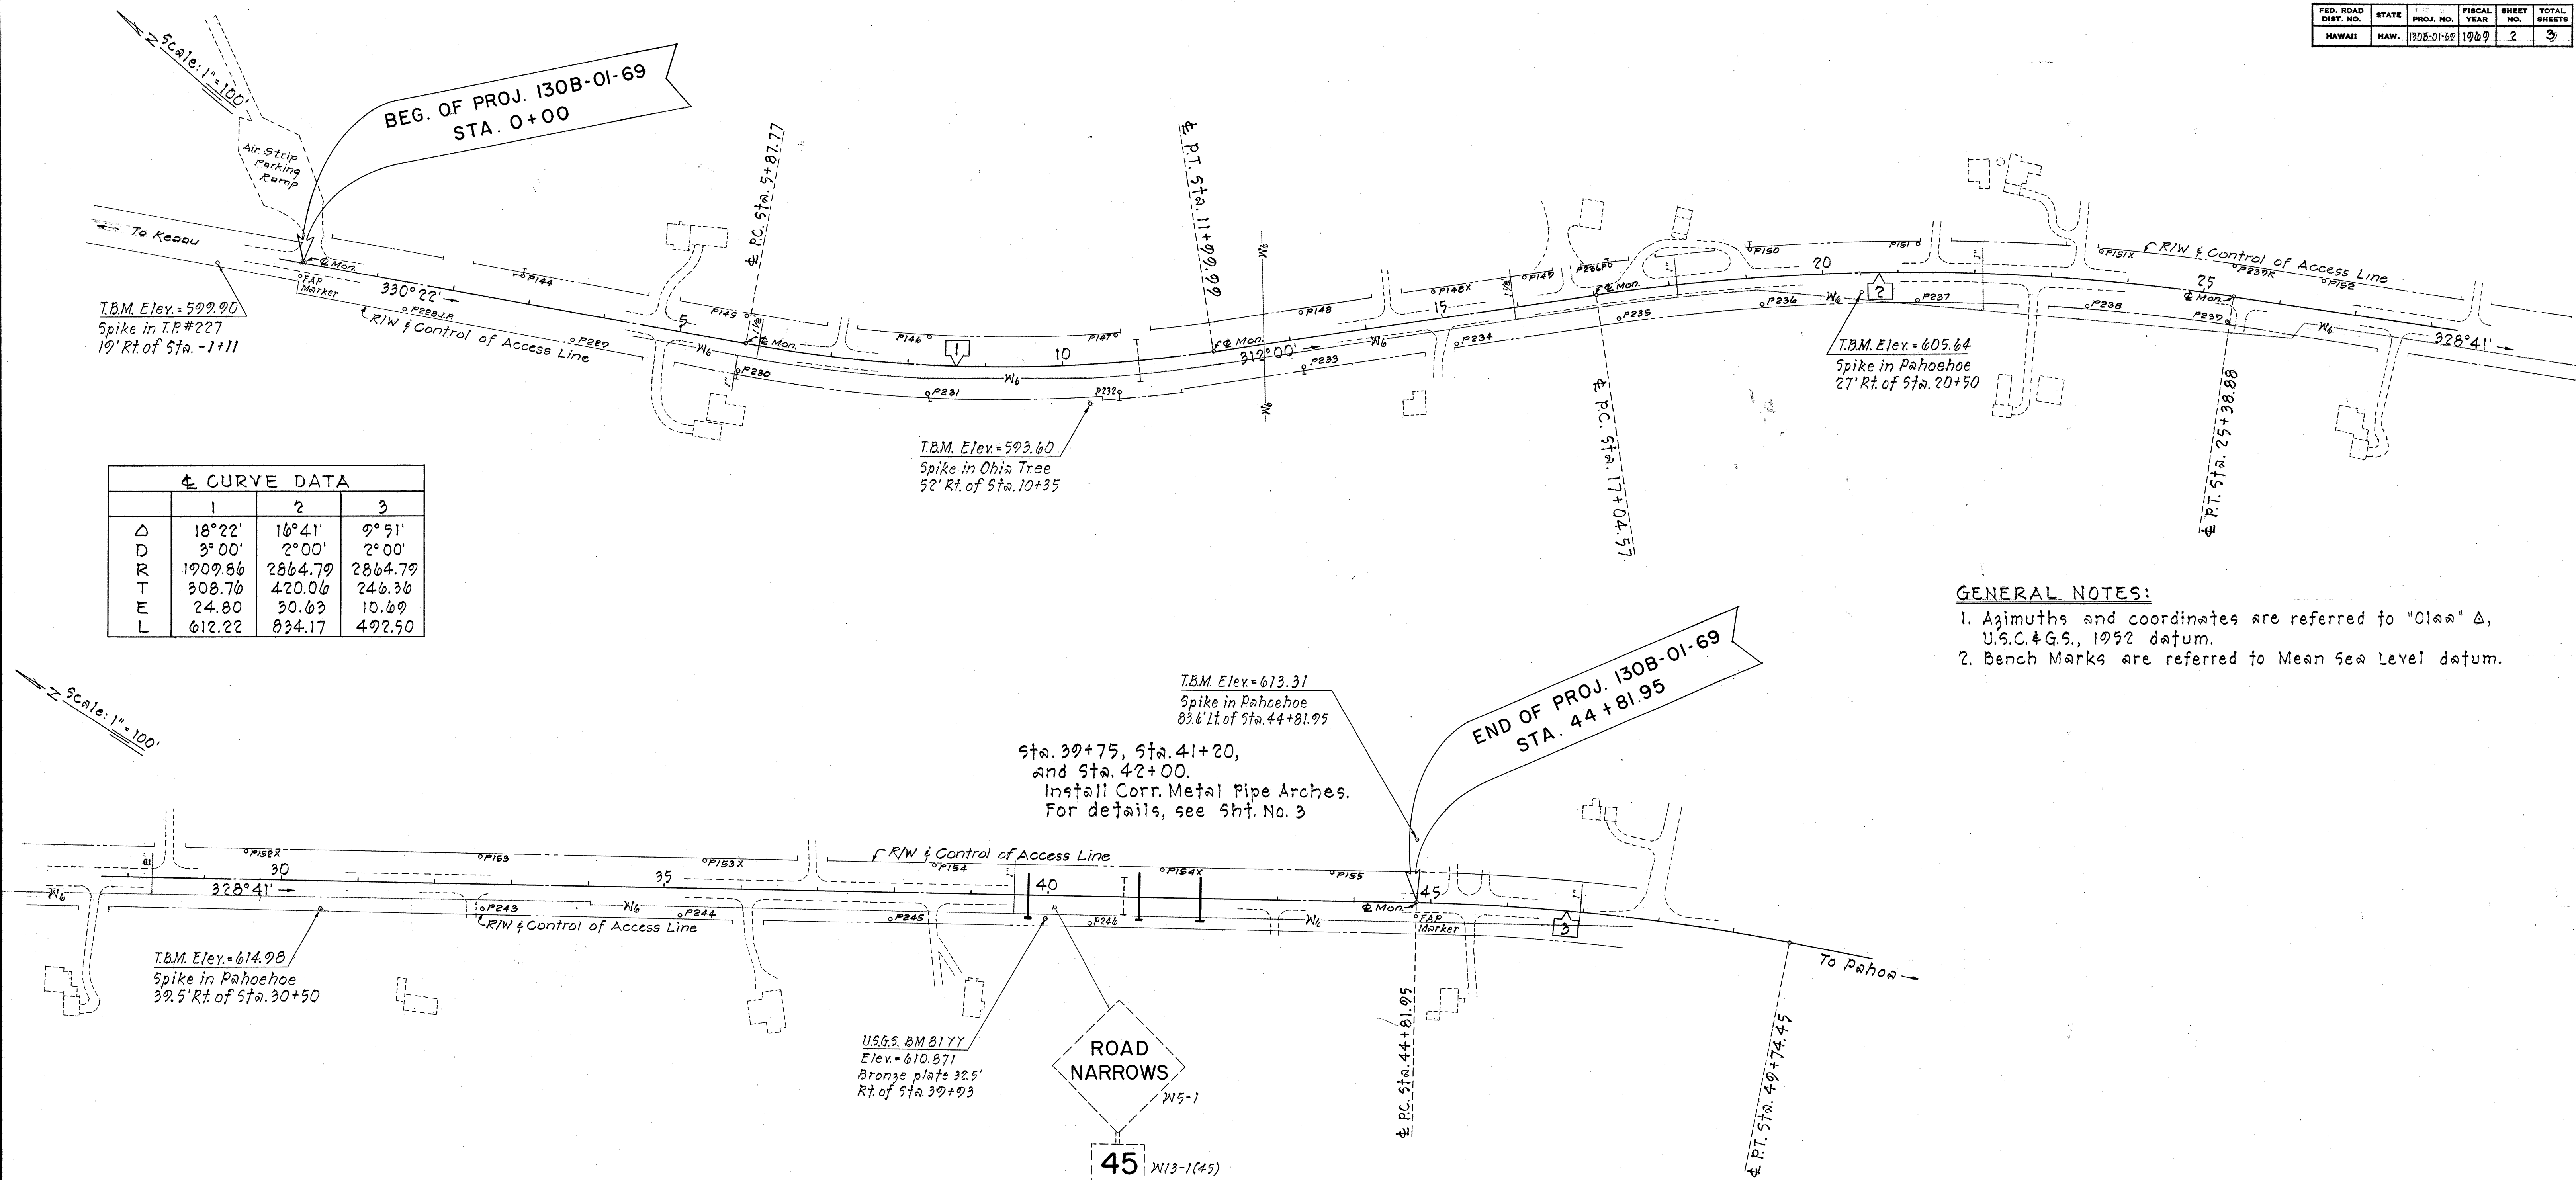

Note: Contractor shall dress and prepare shoulder as directed by the Engineer before placing seal coat.

STATE OF HAWAII
DEPARTMENT OF TRANSPORTATION
HIGHWAYS DIVISION

PLAN
PROJECT NO. 130B-01-69

Scale As Noted
February 1969
SHEET No. 1 OF 1 SHEETS

DATE	_____
DESIGNED BY	_____
DRAWN BY	_____
CHECKED BY	_____
NO.	_____