

INDEX TO DRAWINGS	
SHEET NO.	DESCRIPTION
1	TITLE SHEET
2	PLAN
3	DRAINAGE DETAILS



STATE OF HAWAII
DEPARTMENT OF TRANSPORTATION
HIGHWAYS DIVISION
AS BUILT
PLANS FOR

ADDITIONAL DRAINAGE FACILITIES
AND
SHOULDER STABILIZATION
FOR
KEAAU-PAHOA ROAD — SECTION 2

PROJECT NO. 130B — 01 — 69

DISTRICT OF PUNA
ISLAND OF HAWAII

FED. ROAD DIST. NO.	STATE	PROJ. NO.	FISCAL YEAR	SHEET NO.	TOTAL SHEETS
HAWAII	HAW.	130B-01-69	1969	1	3

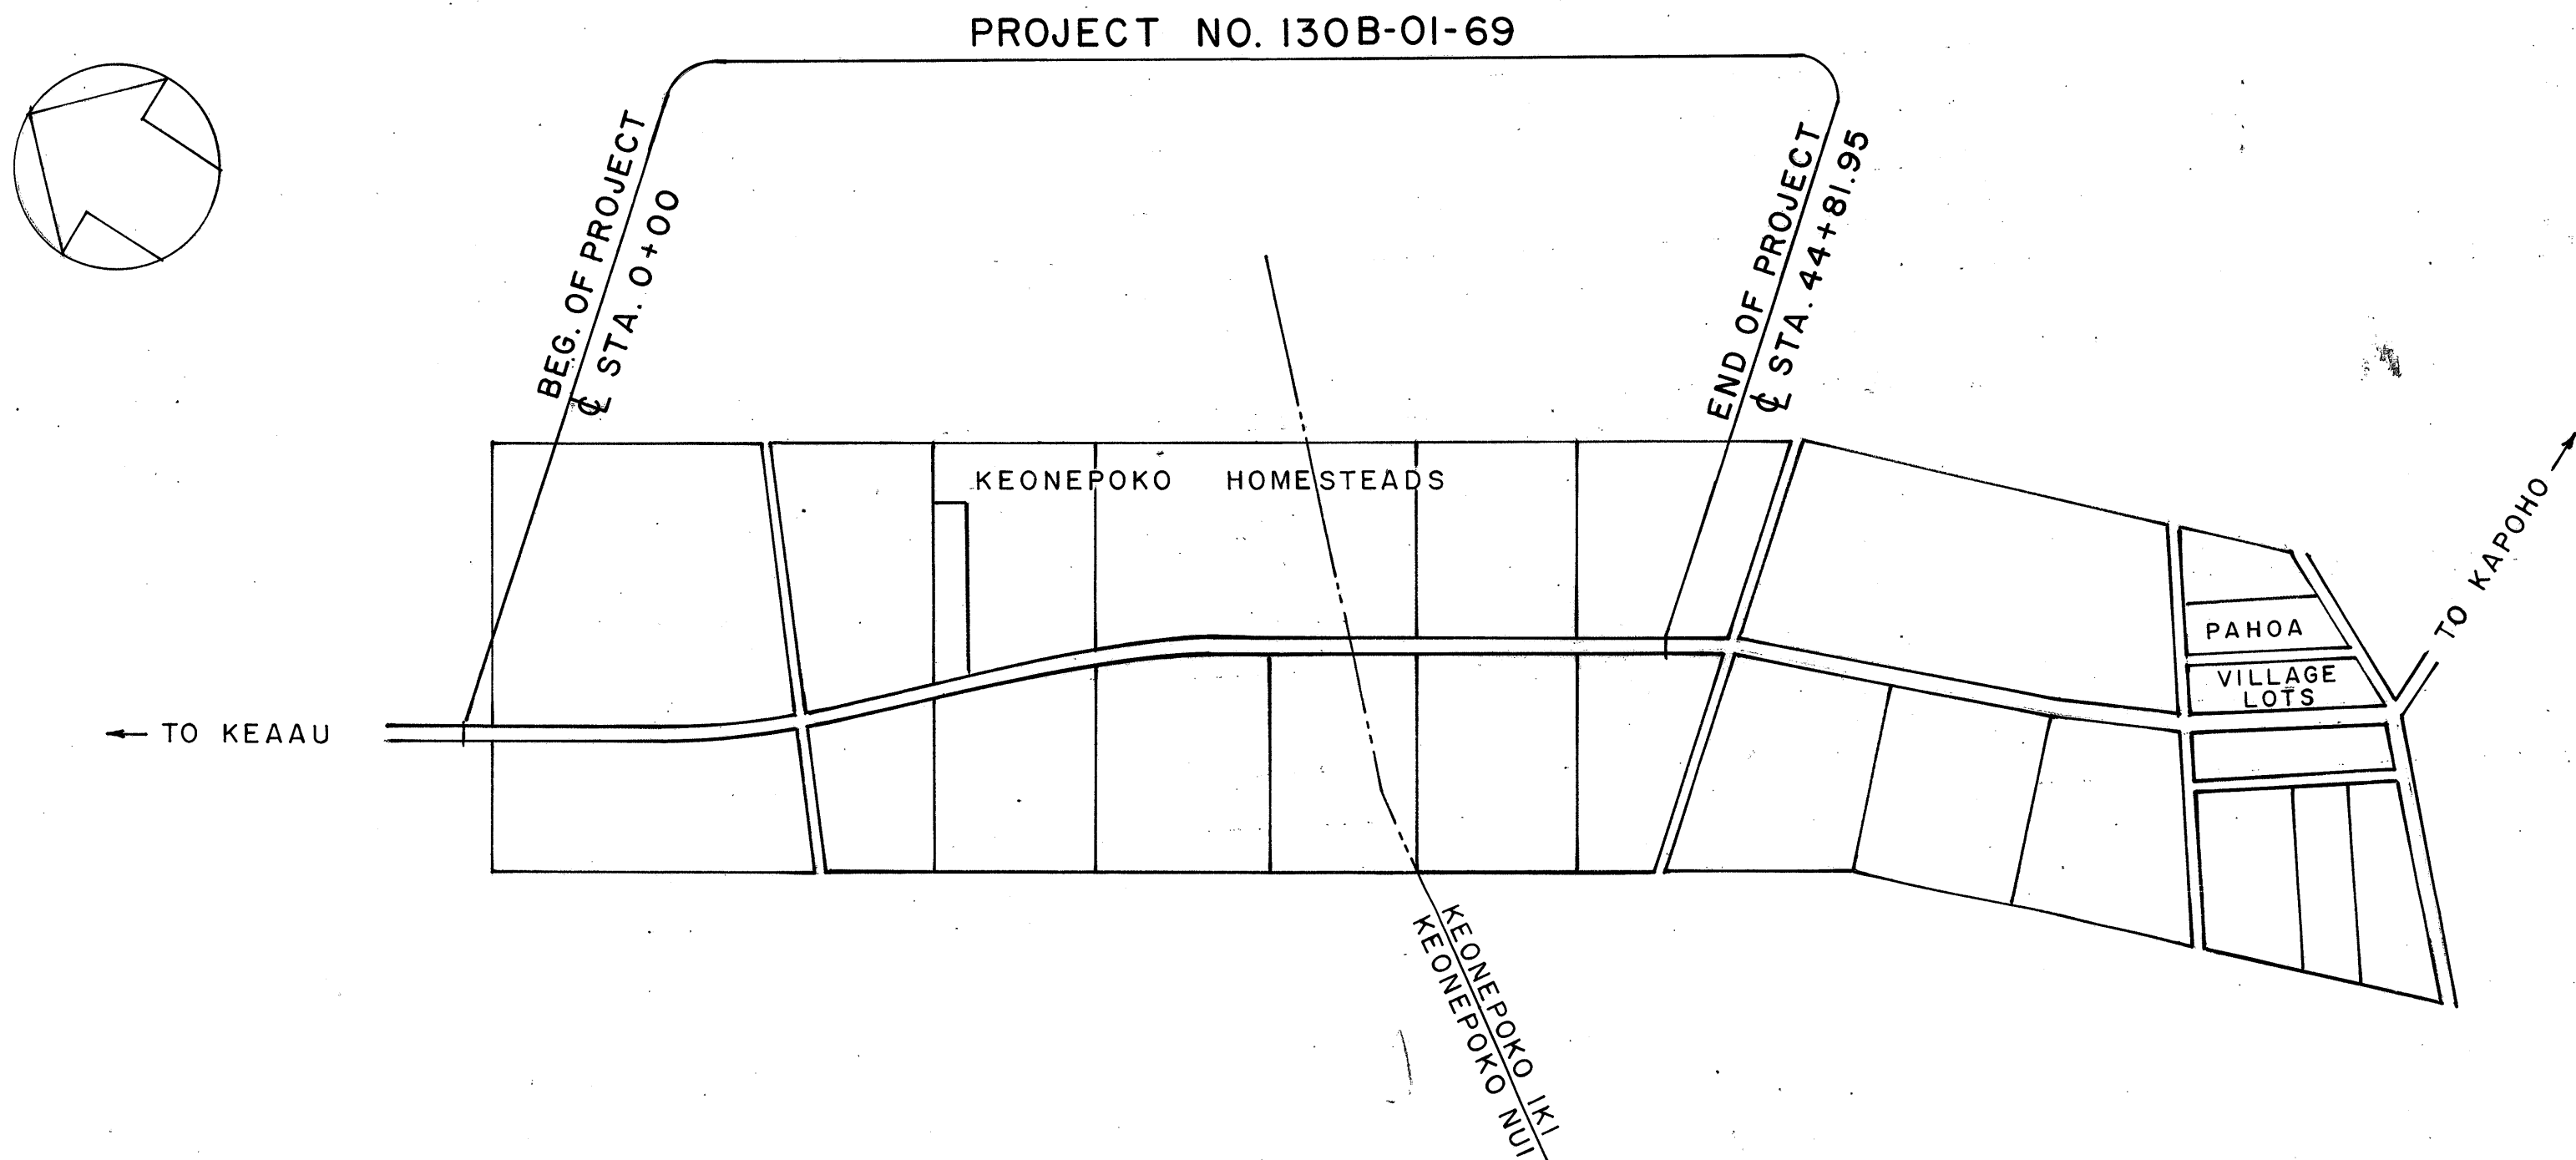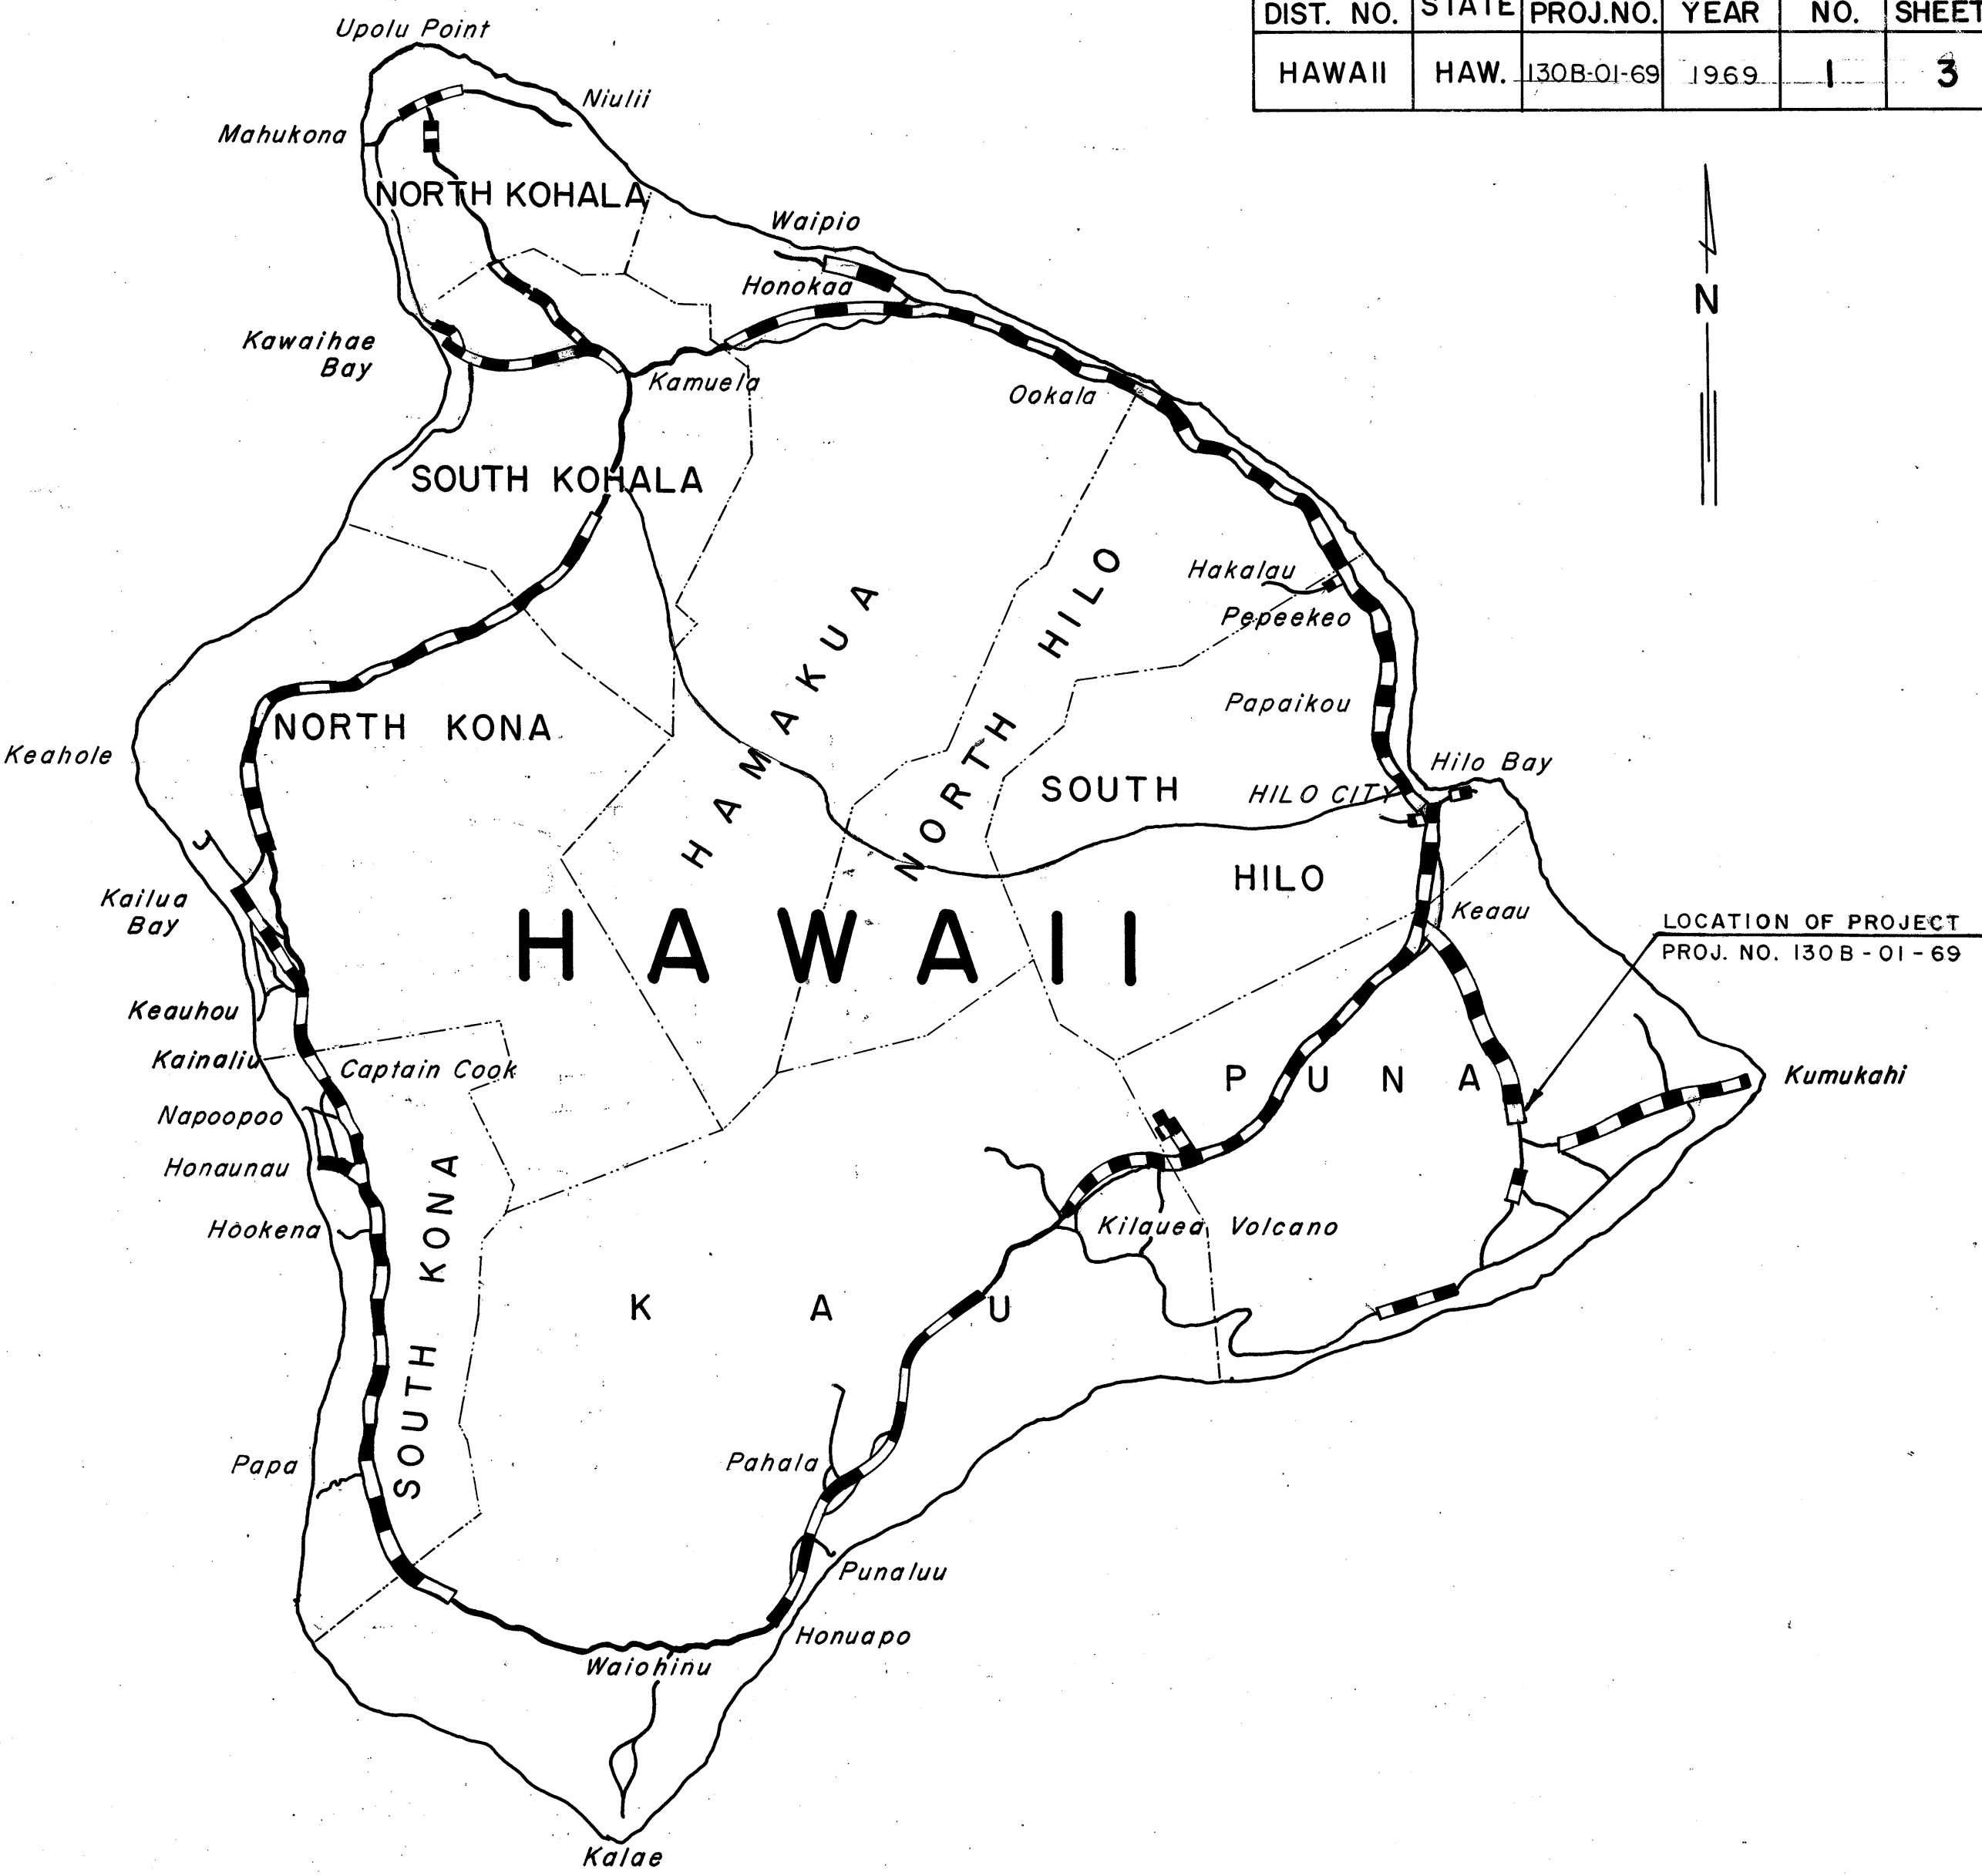

LAYOUT OF PROJECT
SCALE: 1" = 600'
GROSS & NET LENGTH OF PROJECT 0.849 Mile

NOTE:
ALL CHANGES MADE DURING CONSTRUCTION
HAVE BEEN NOTED IN RED ON THESE TRACINGS
AND CHECKED BY:

Phadine H. Wynn
PROJECT ENGINEER

12/17/71
DATE

DEPARTMENT OF TRANSPORTATION
STATE OF HAWAII
APPROVED:
E. Alvey Wright 2/28/69
For DIR. OF TRANSPORTATION DATE

DESIGNED BY: Roy Terada