

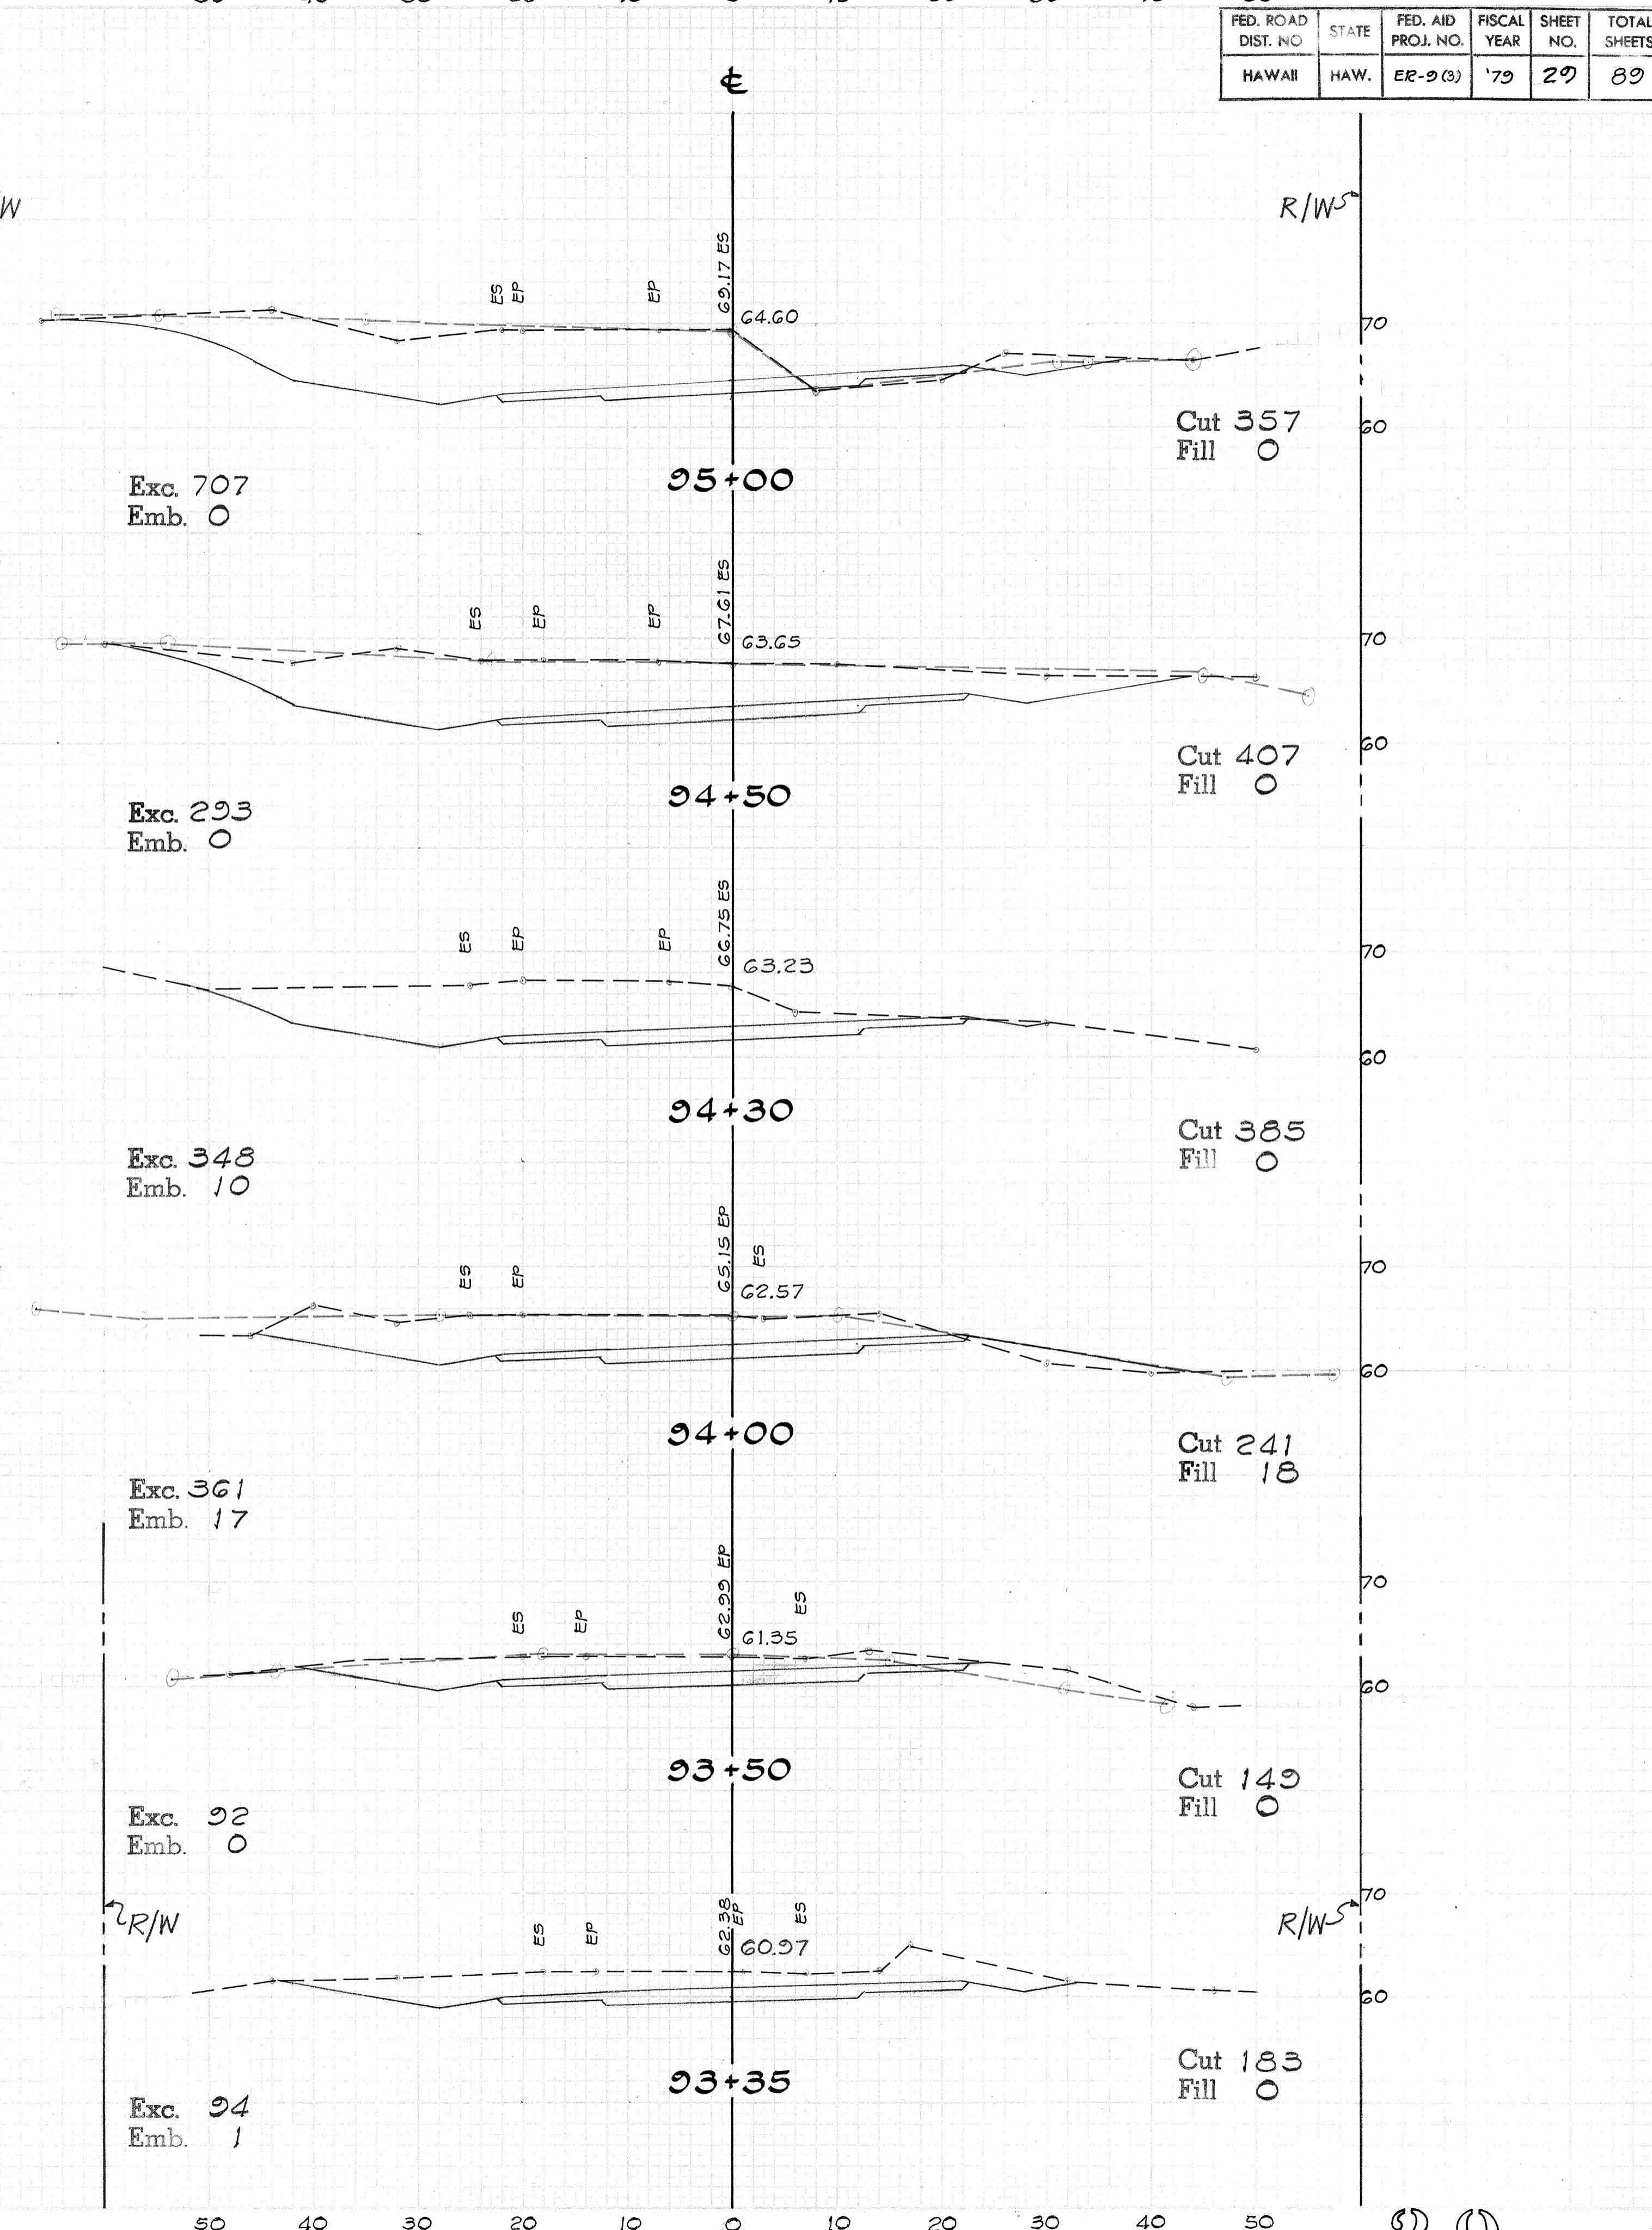
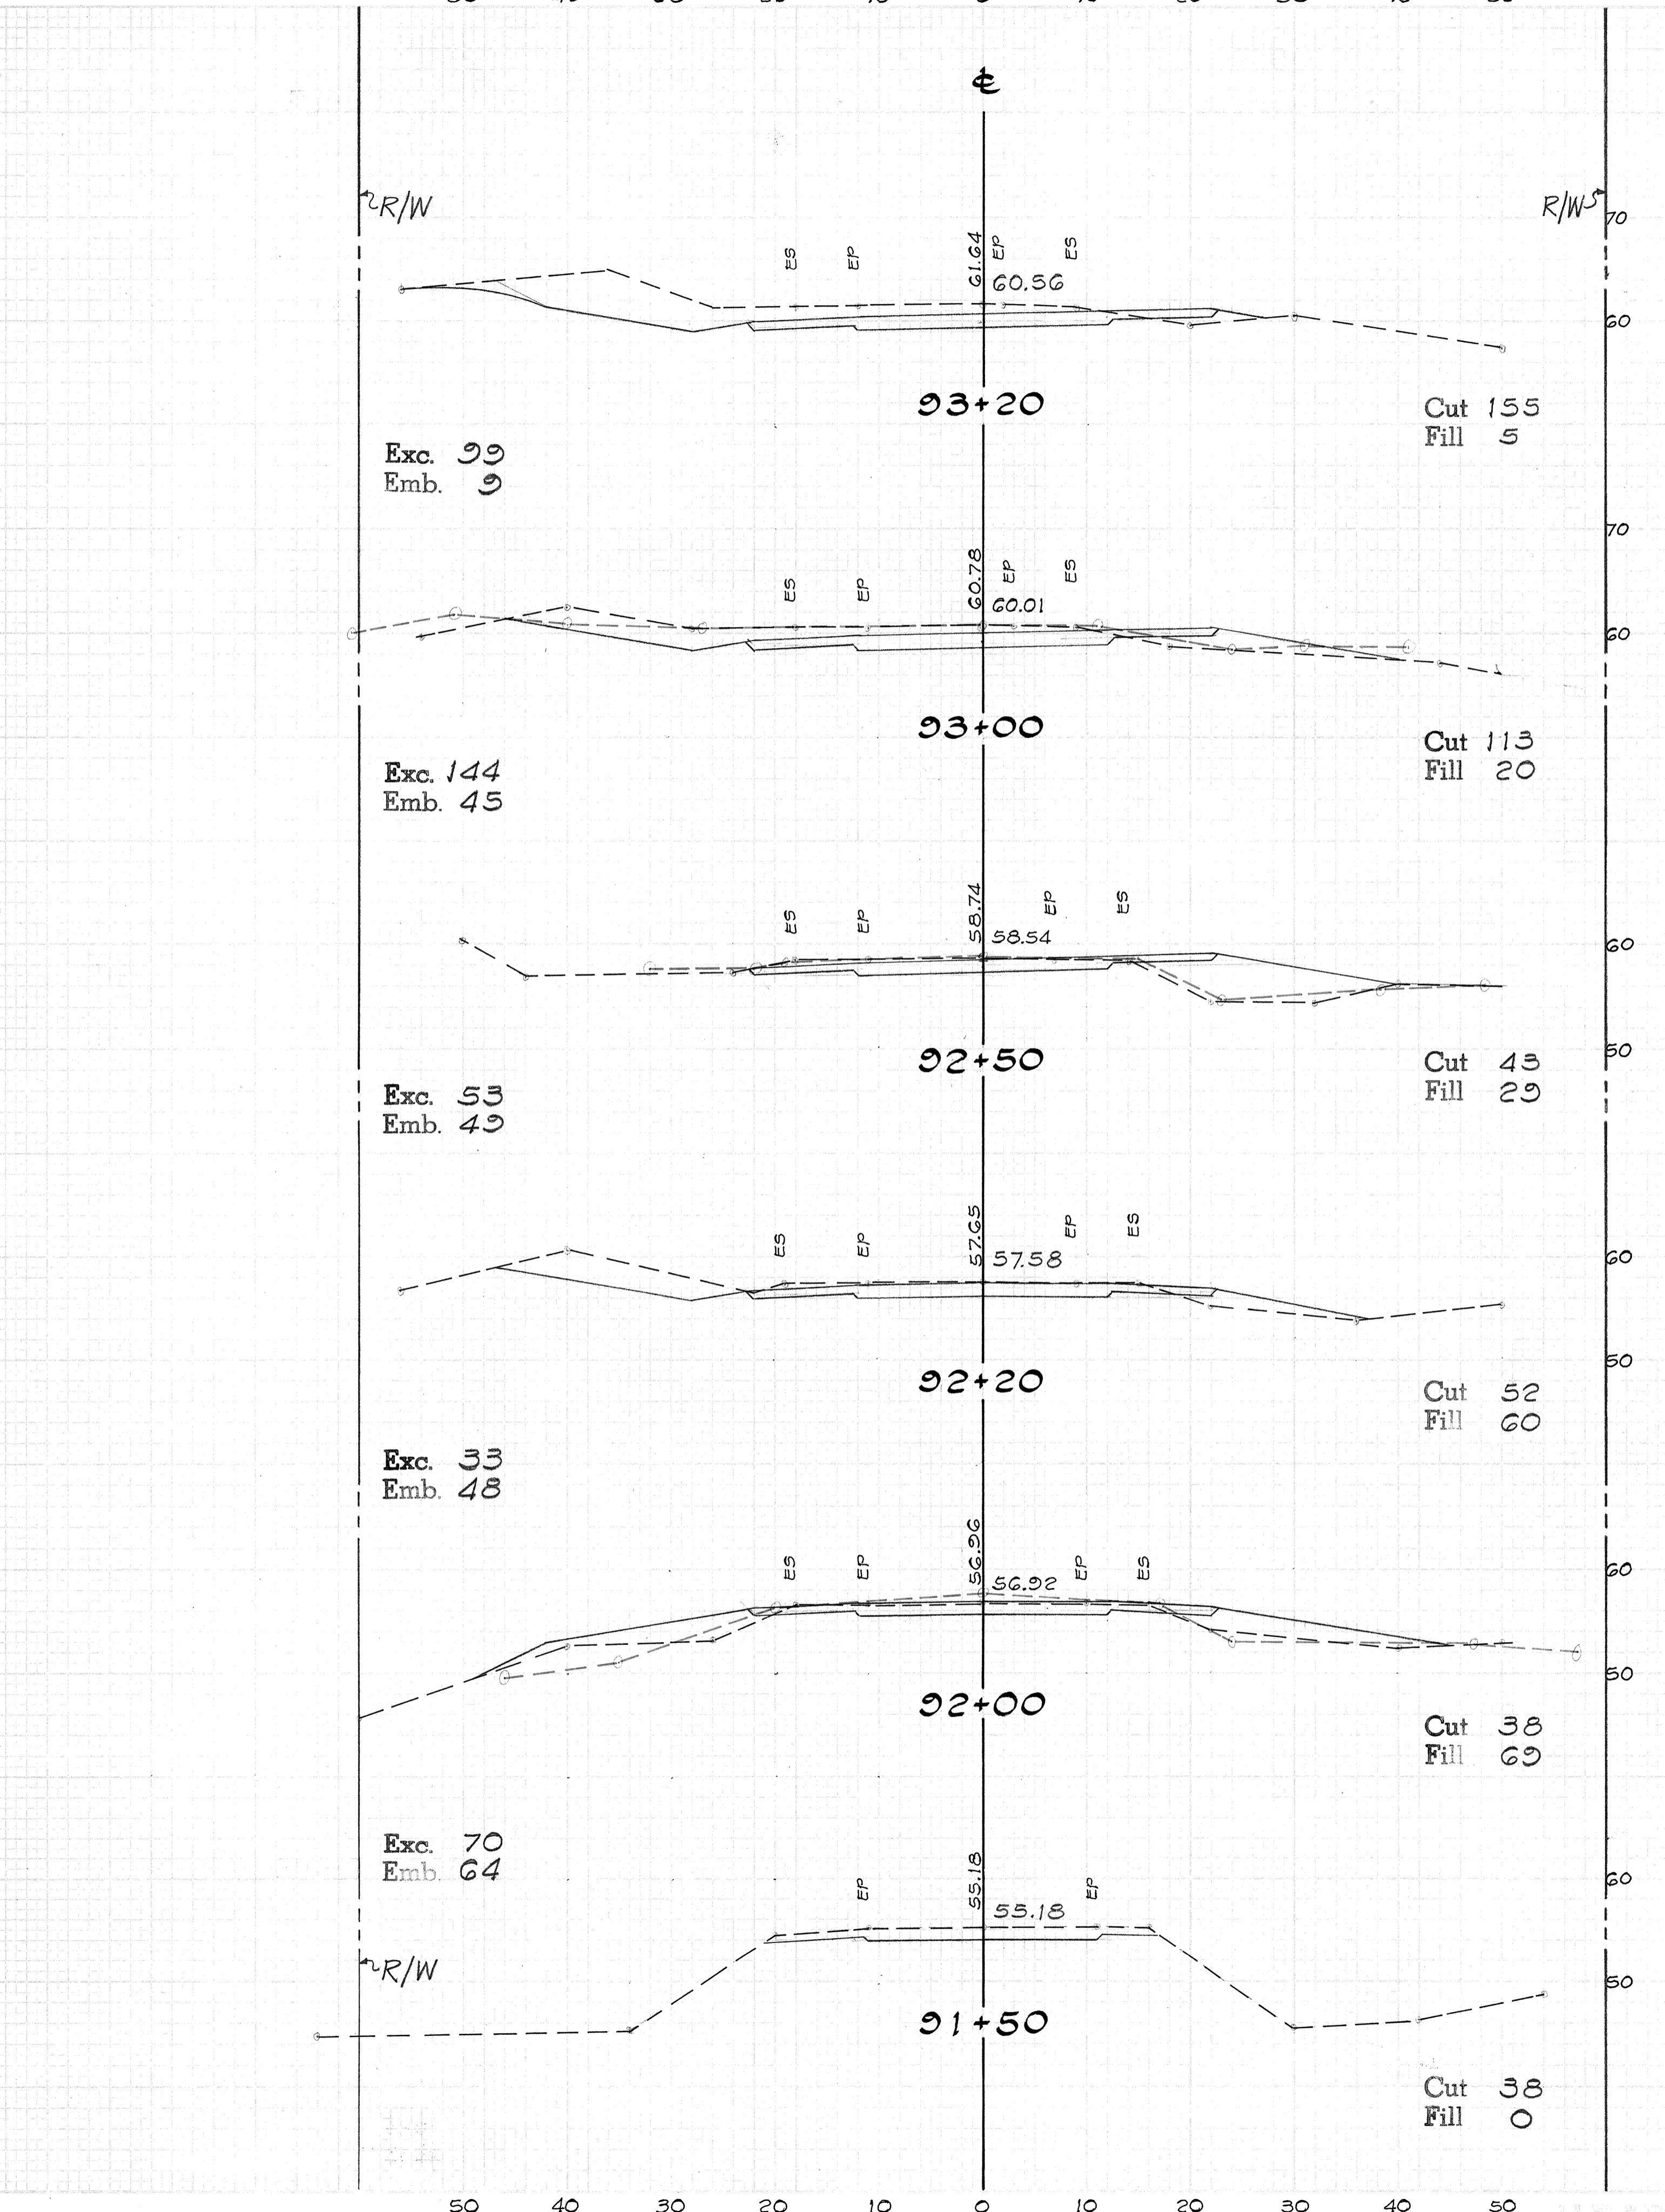


ED. ROAD DIST. NO	STATE	FED. AID PROJ. NO.	FISCAL YEAR	SHEET NO.	TOTAL SHEETS
HAWAII	HAW.	ER-9 (3)	'79	29	89

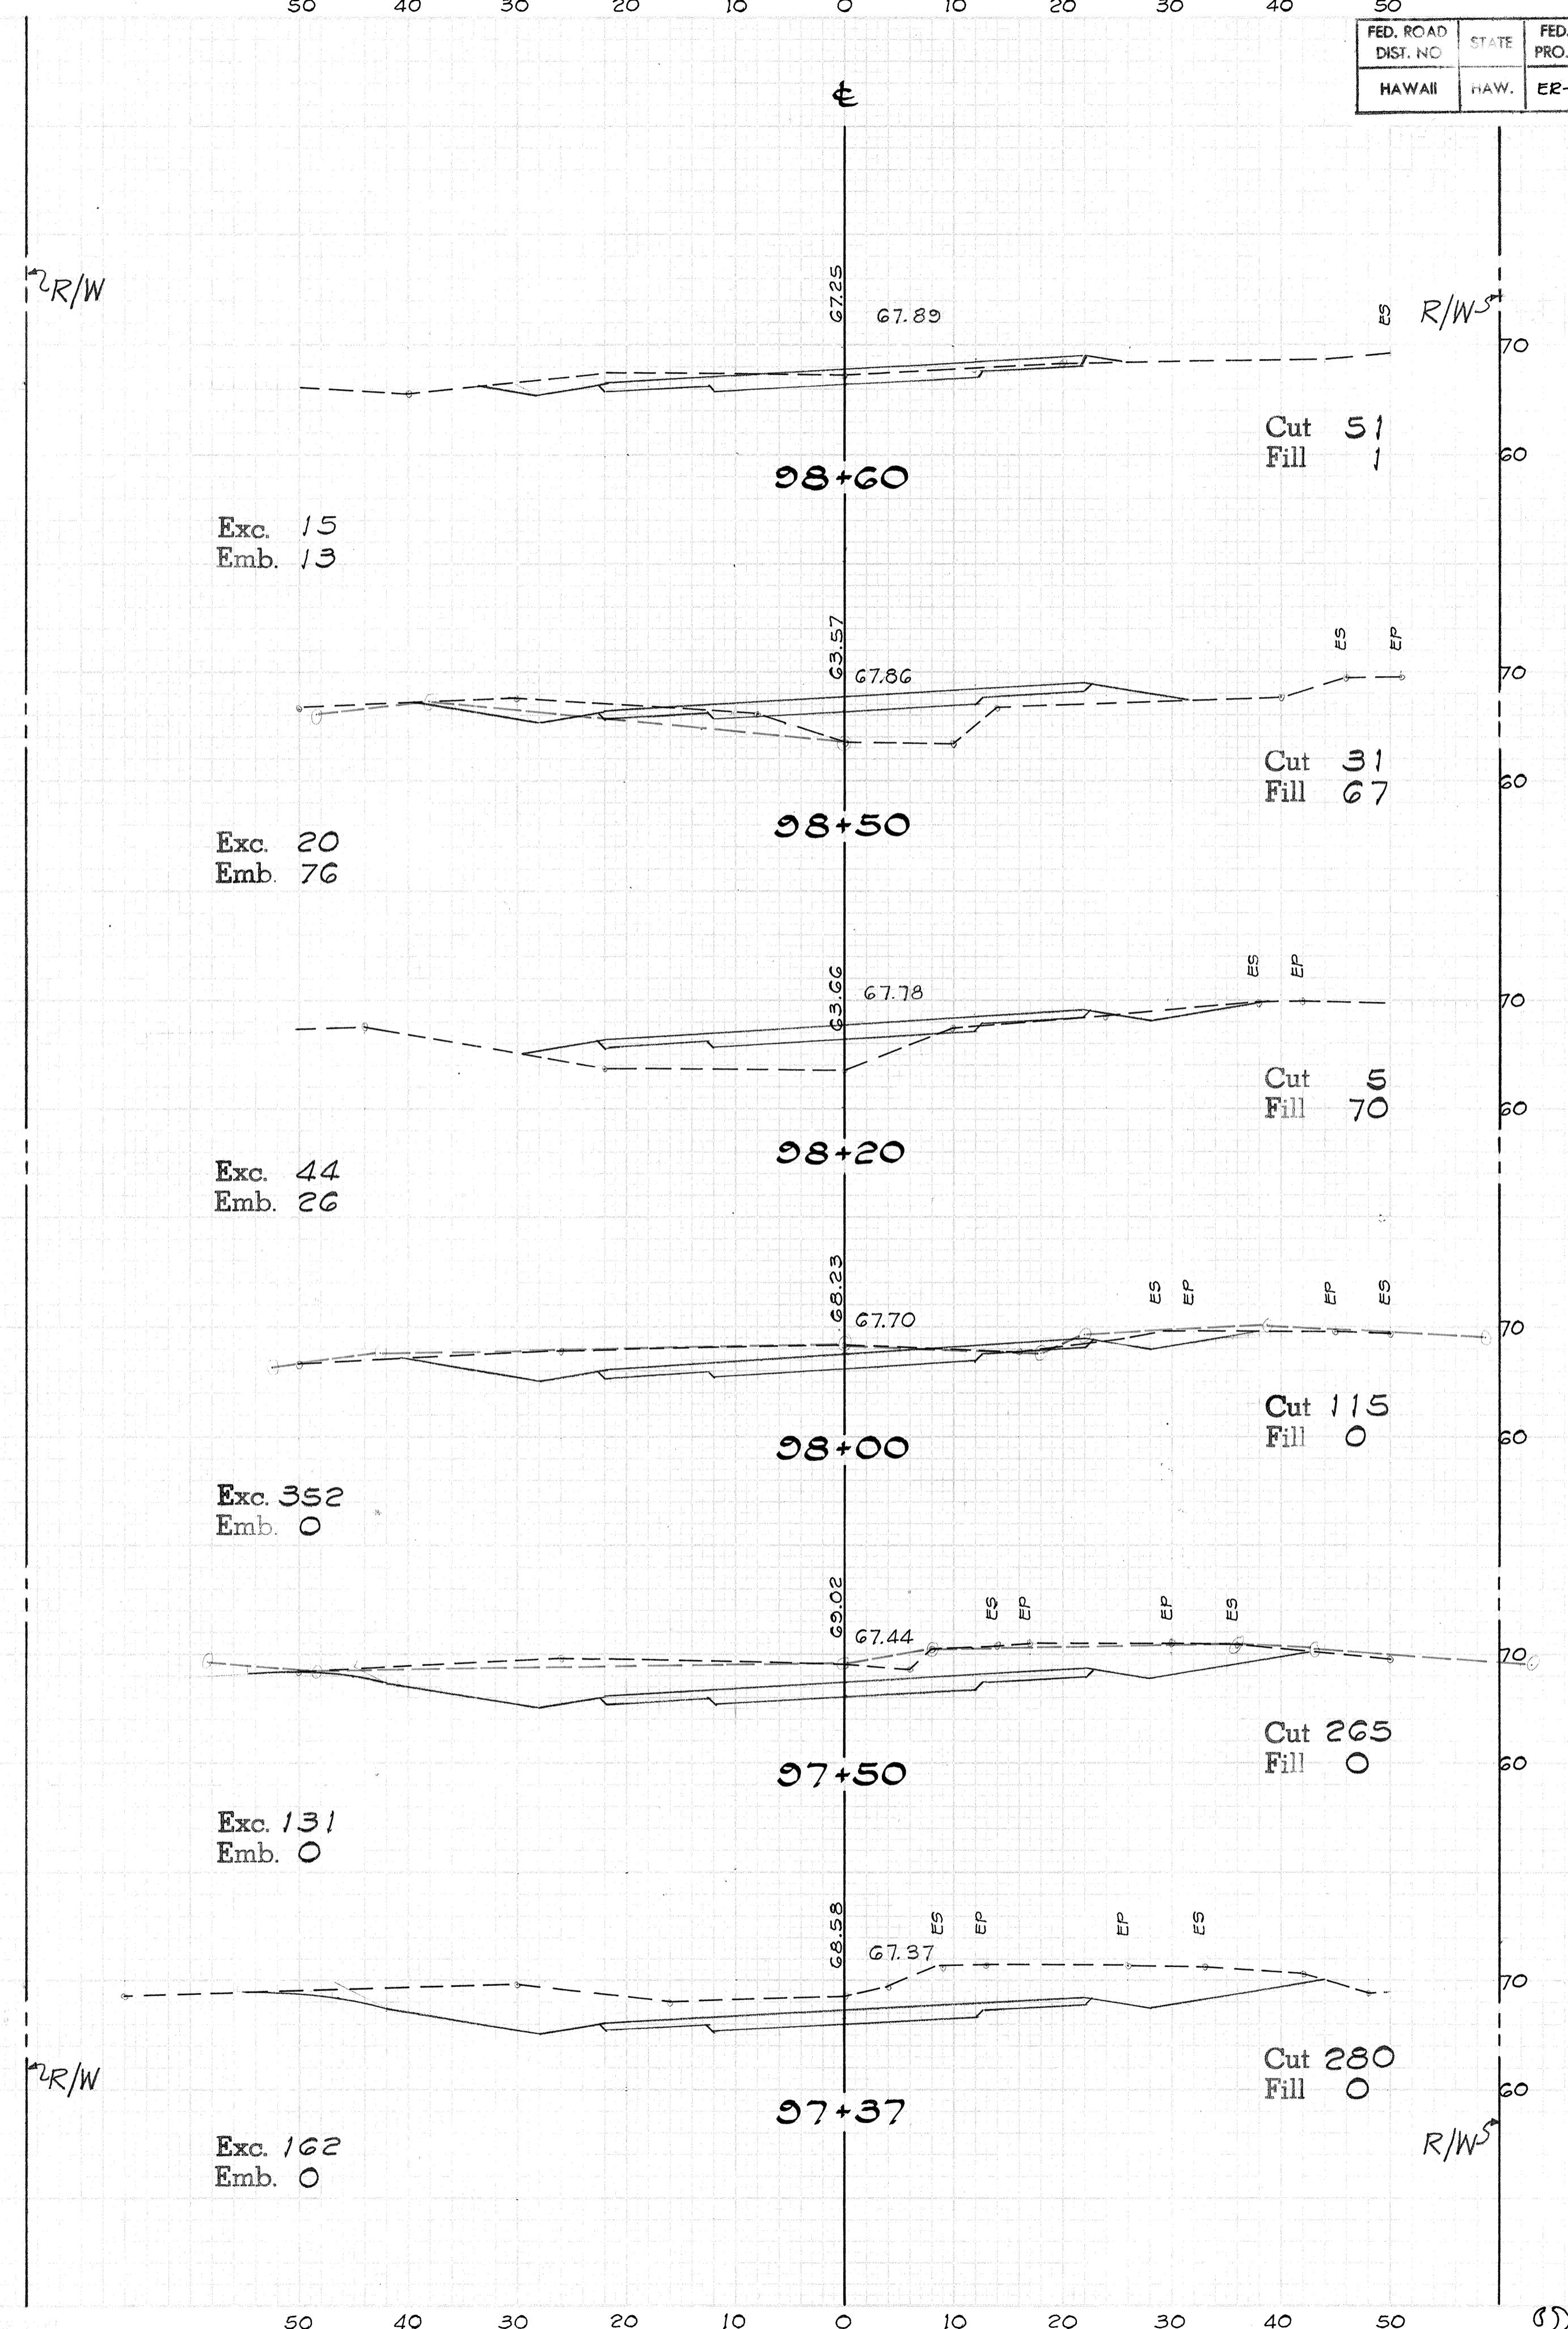


FED. ROAD DIST. NO.	STATE	FED. AID PROJ. NO.	FISCAL YEAR	SHEET NO.	TOTAL SHEETS
HAWAII	NAW.	ER-9(3)	'79	30	89

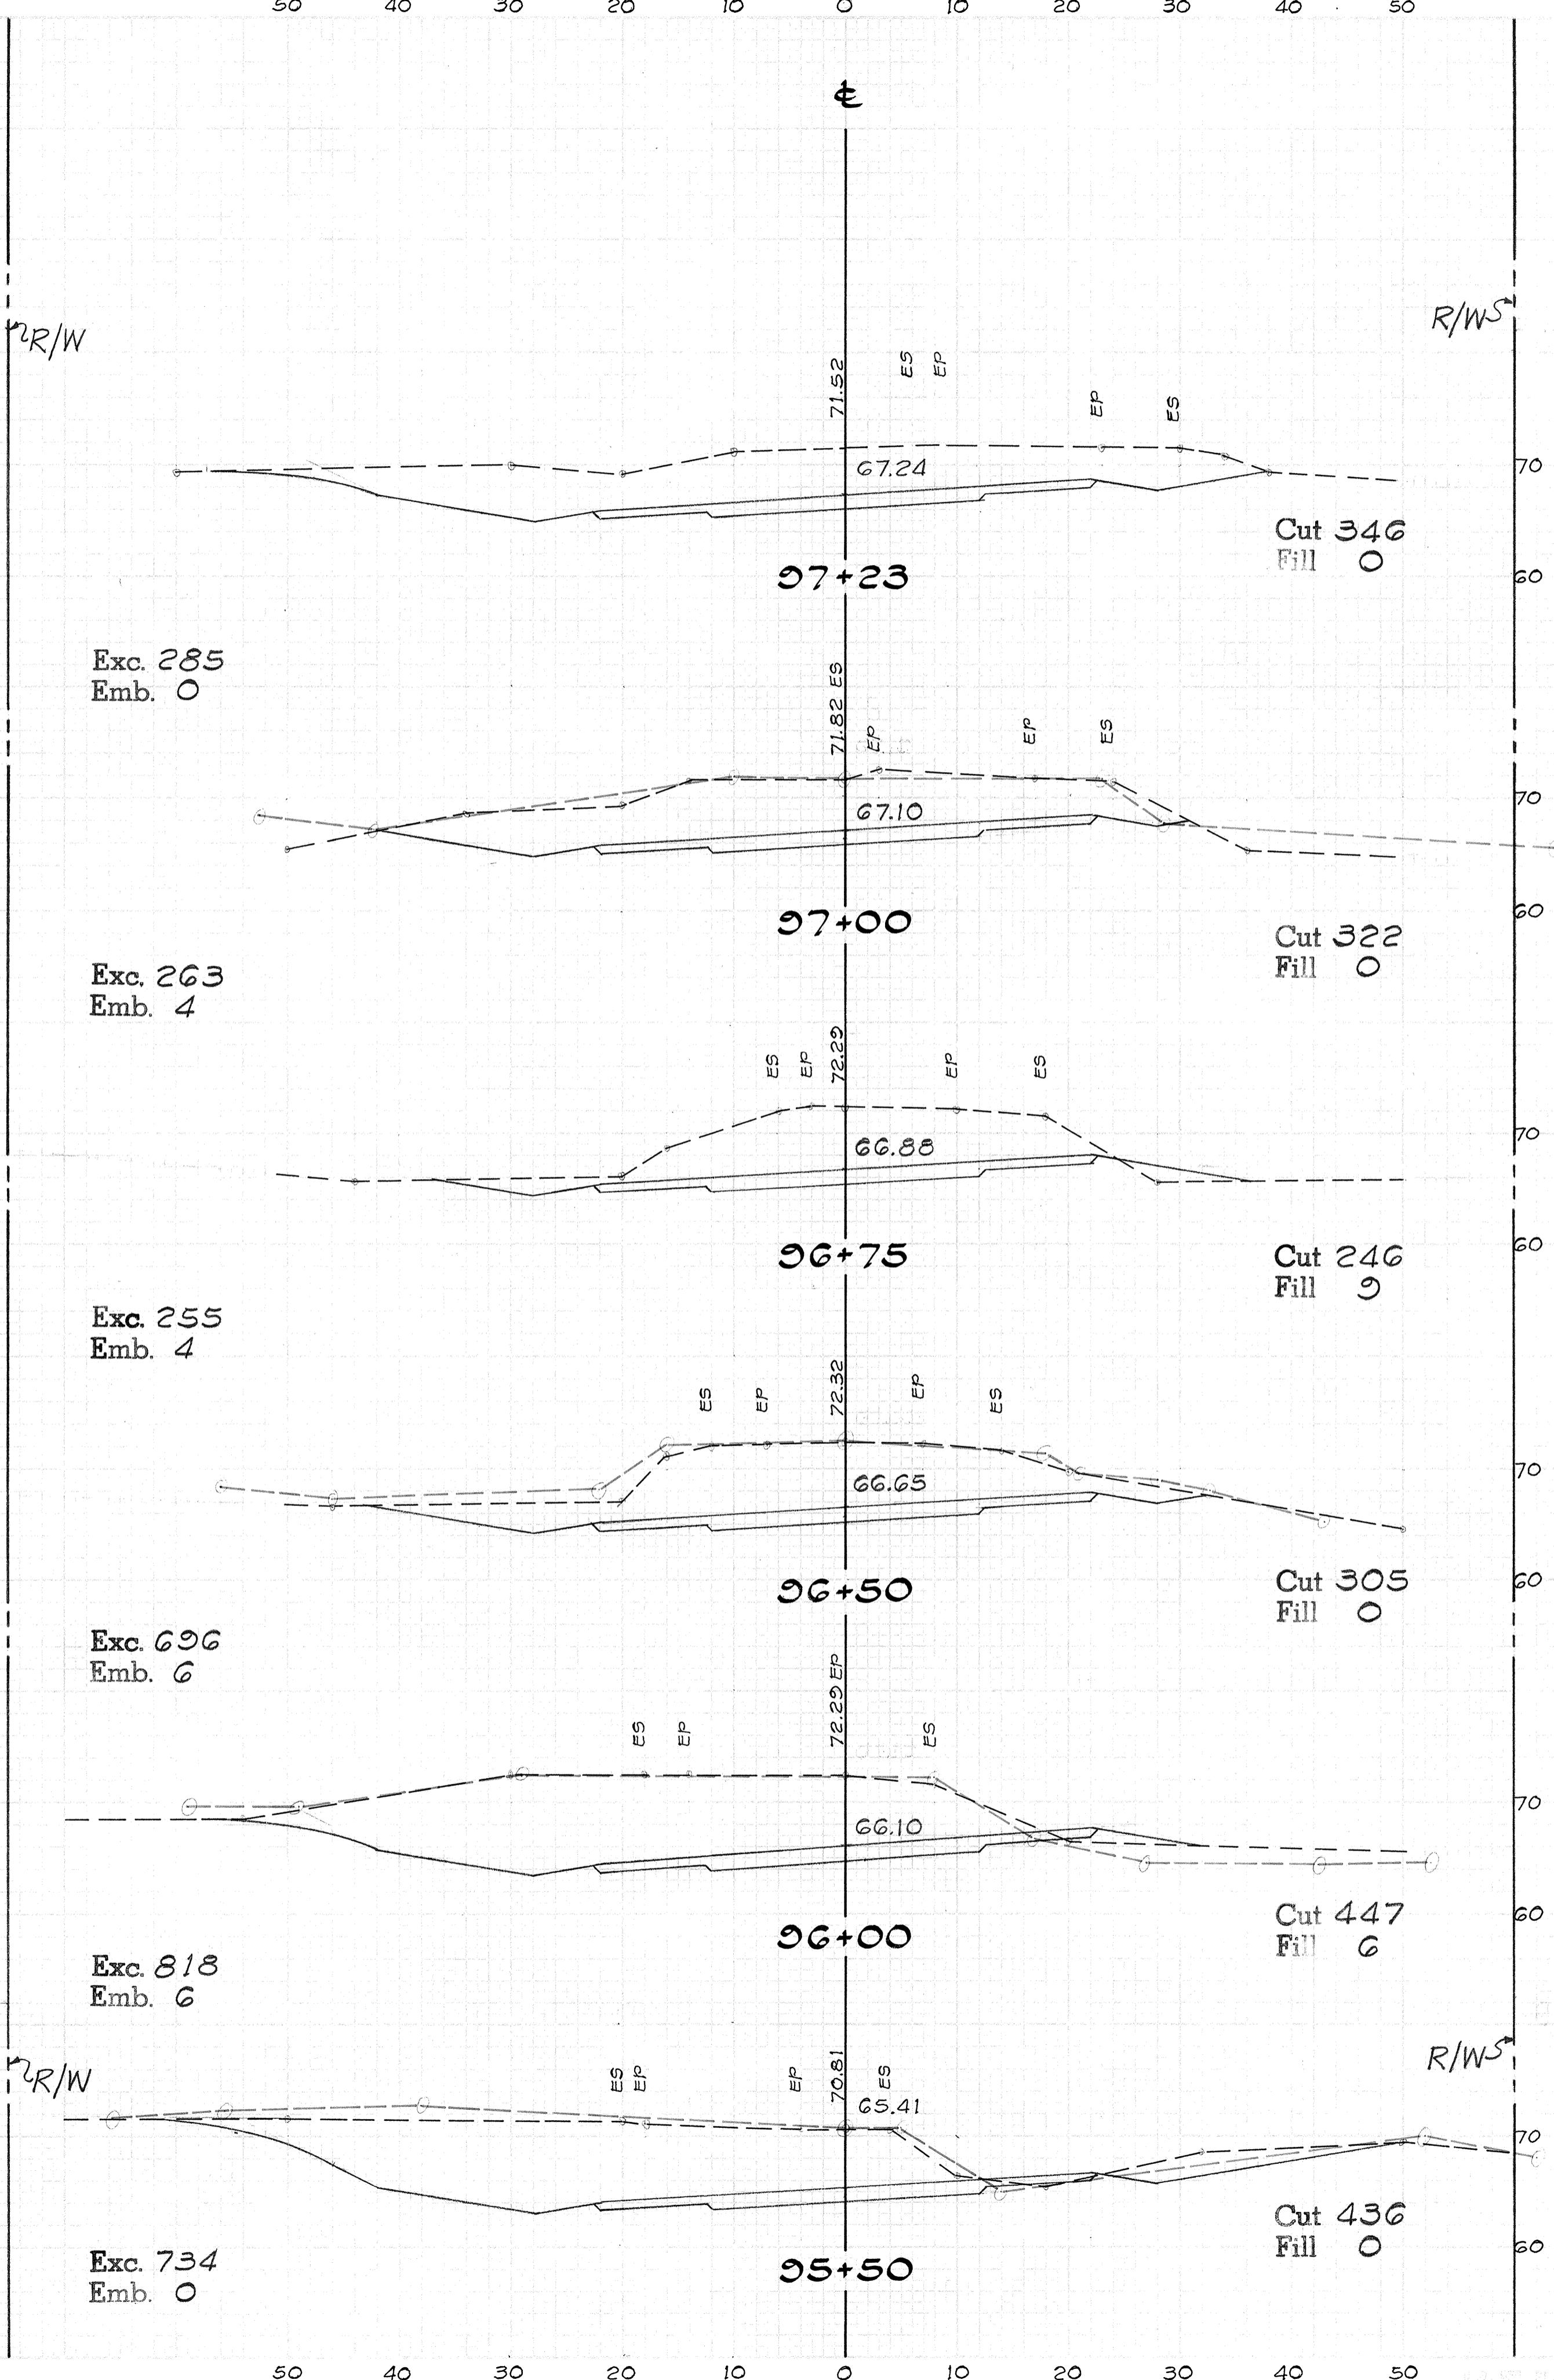

FED. ROAD DIST. NO.	STATE	FED. AID PROJ. NO.	FISCAL YEAR	HEET NO.	TOTAL SHEETS
HAWAII	HAW.	ER-9(3)	79	31	89

FINAL SURVEYED  
SURVEY PLOTTED  
SHEET BOOK  
AREAS SHOWN



UNPLOTTED  
SURVEY  
BOOK  
AREAS SHOWN

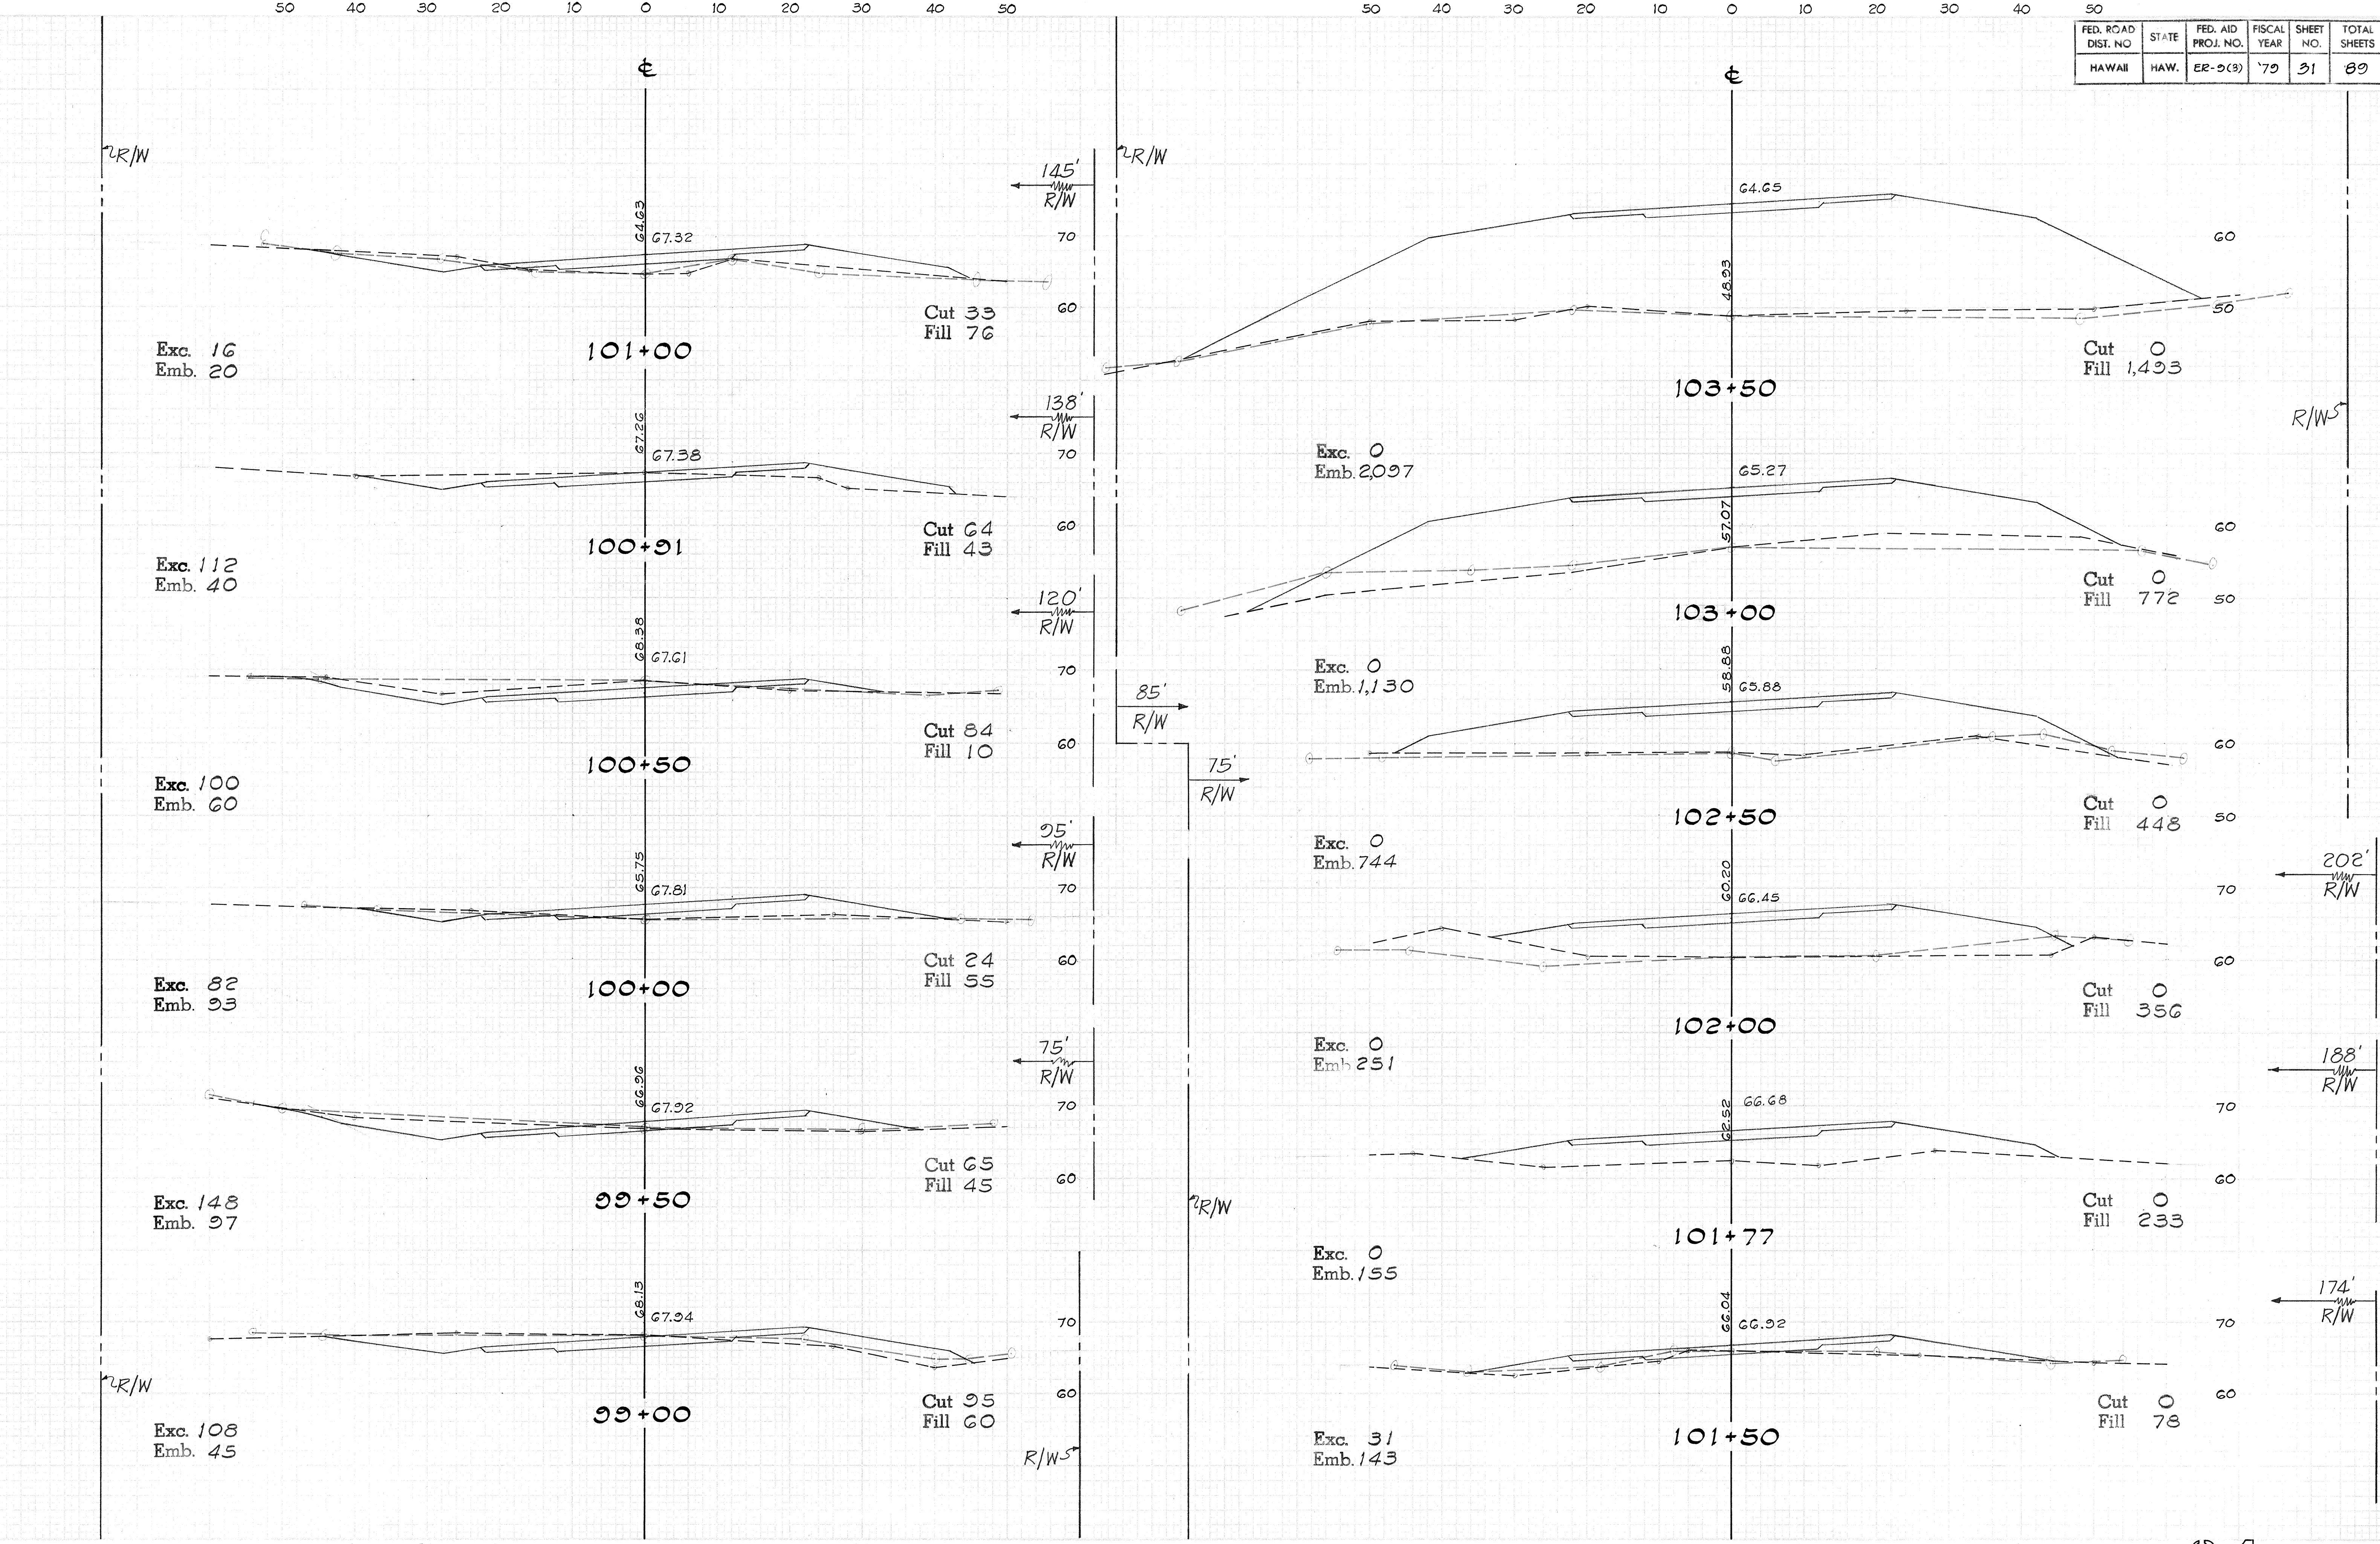



FED. ROAD DIST. NO.	STATE	FED. AID PROJ. NO.	FISCAL YEAR	SHEET NO.	TOTAL SHEETS
HAWAII	HAW.	ER-9(3)	'79	32	89

FINAL SURVEY SURVEYED BY DATE  
NOTE: HIGHLIGHTED AREAS ARE CHECKED



ORIGINAL SURVEY SURVEYED BY DATE  
NOTE: BLOCK TERMINATE AREAS ARE CHECKED

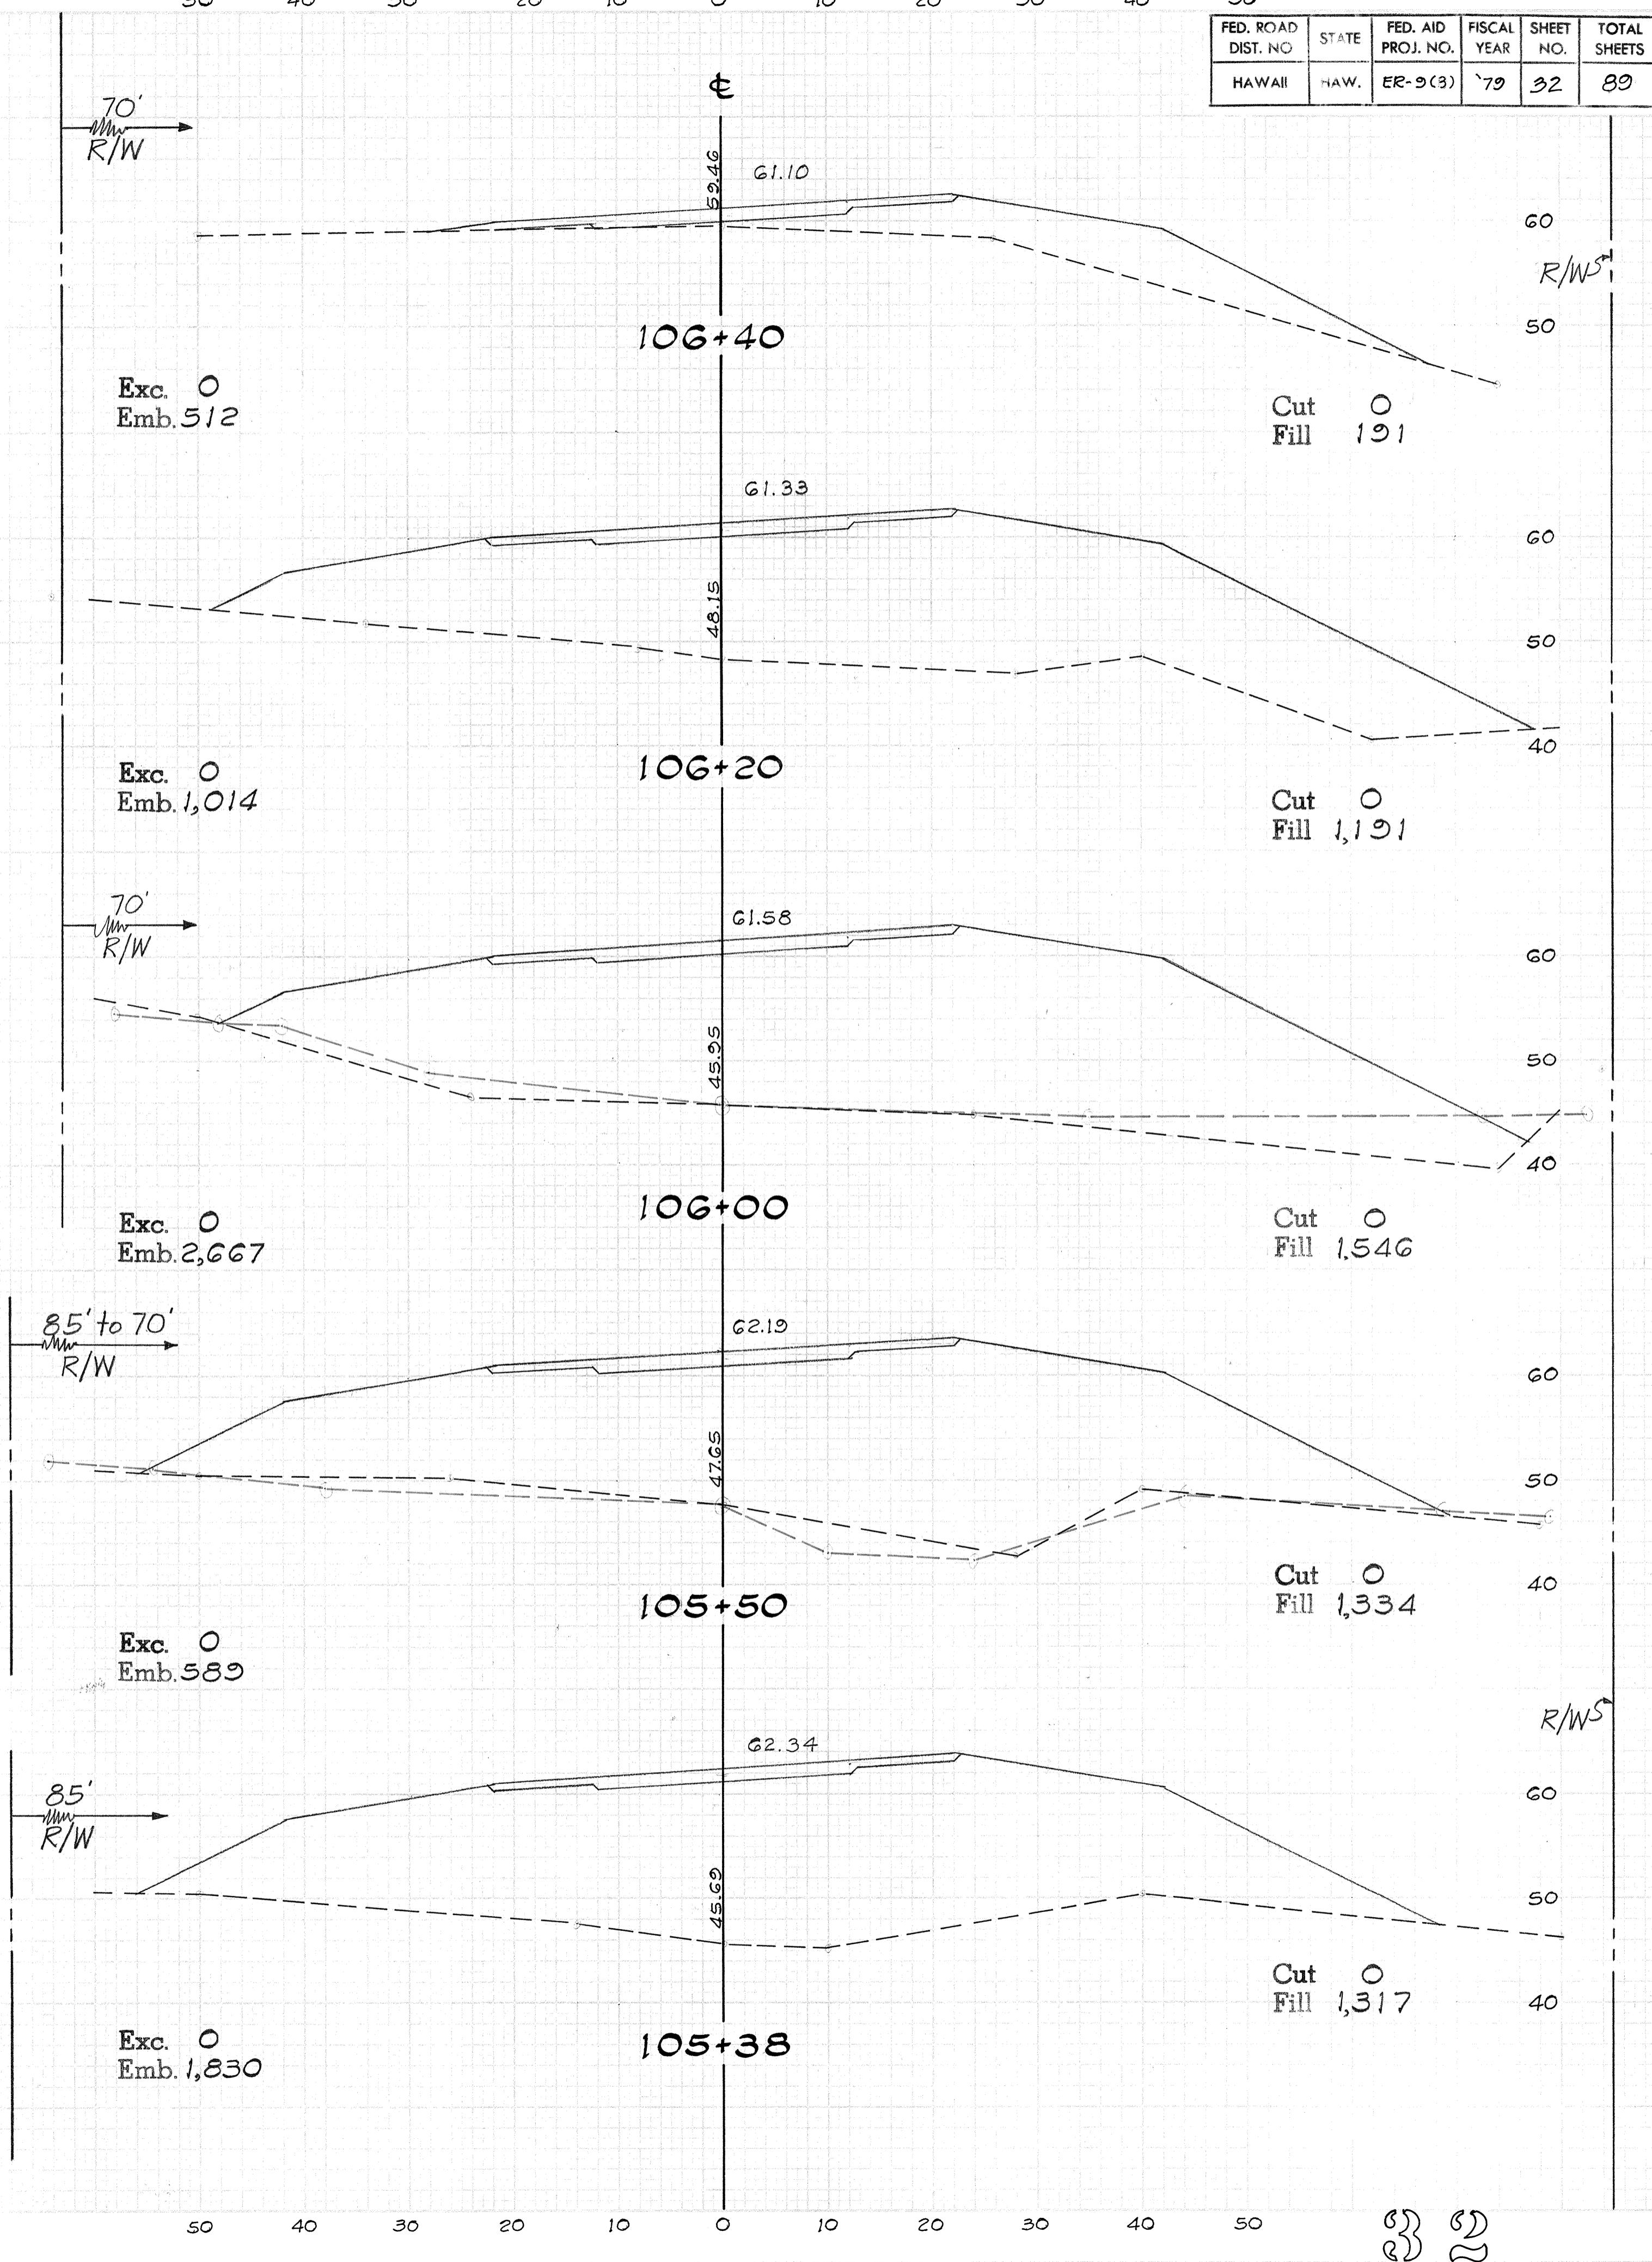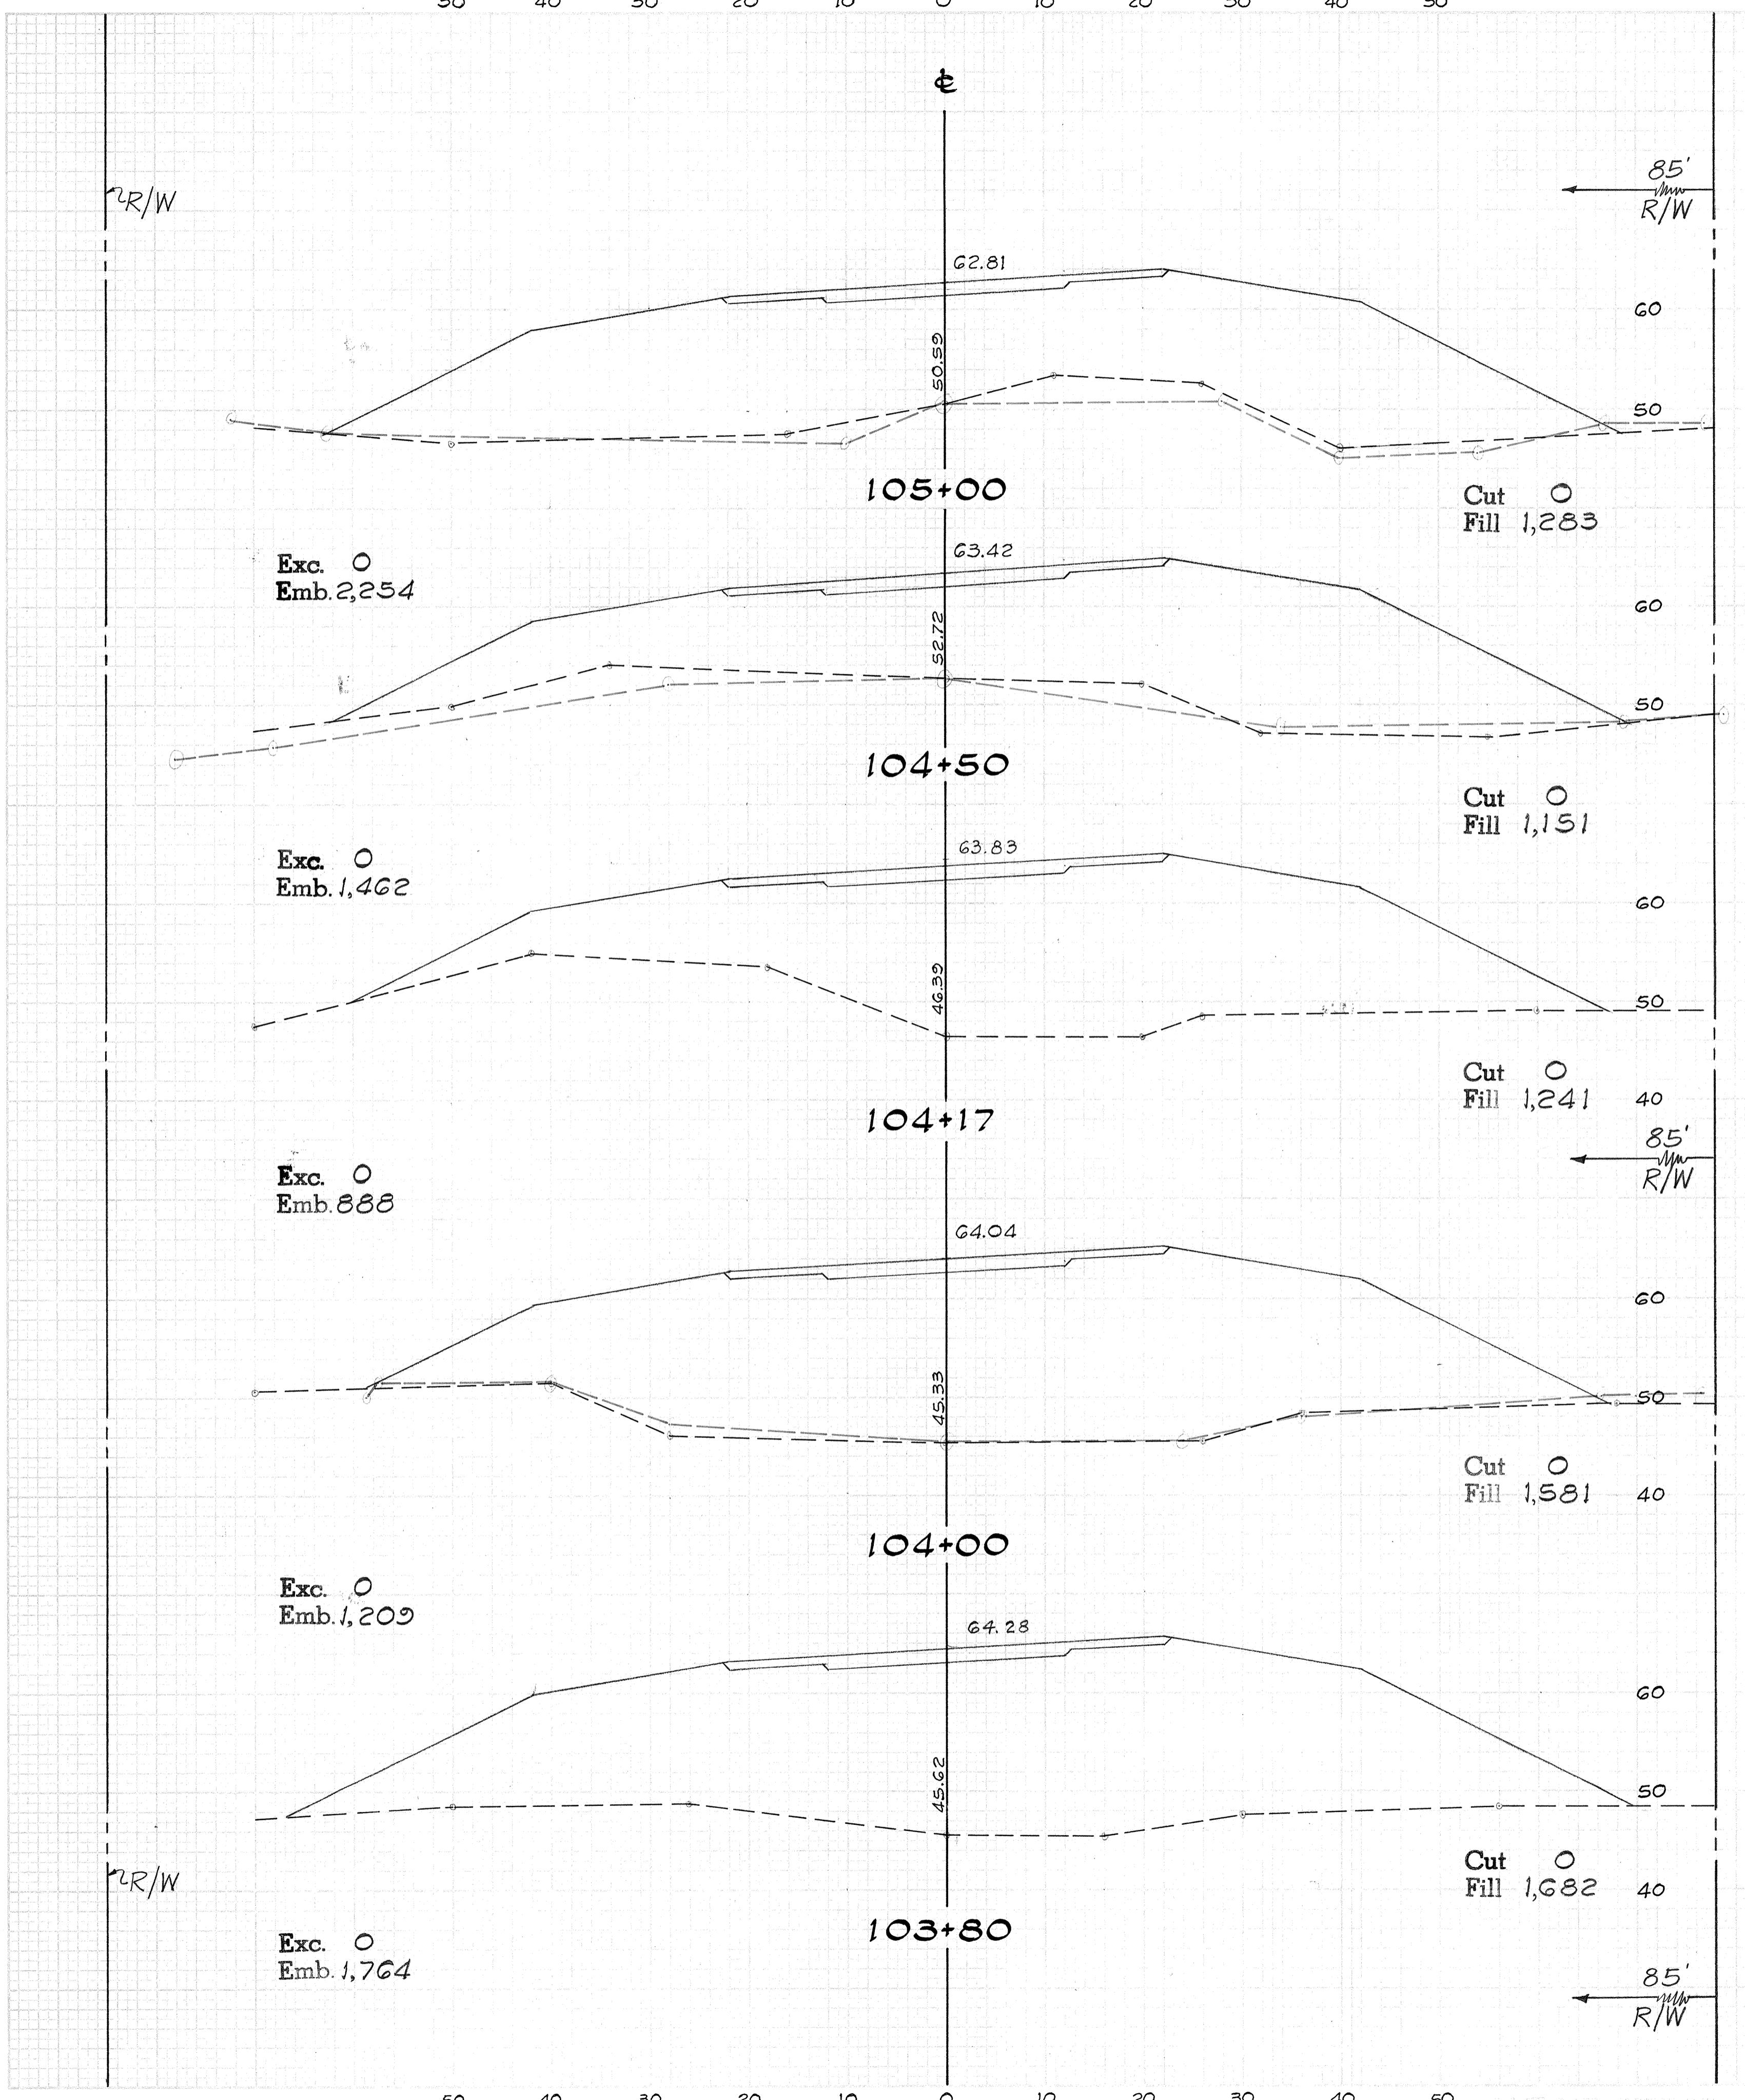



FED. ROAD DIST. NO.	STATE	FED. AID PROJ. NO.	FISCAL YEAR	SHEET NO.	TOTAL SHEETS
HAWAII	HAW.	ER-9(3)	'79	33	89

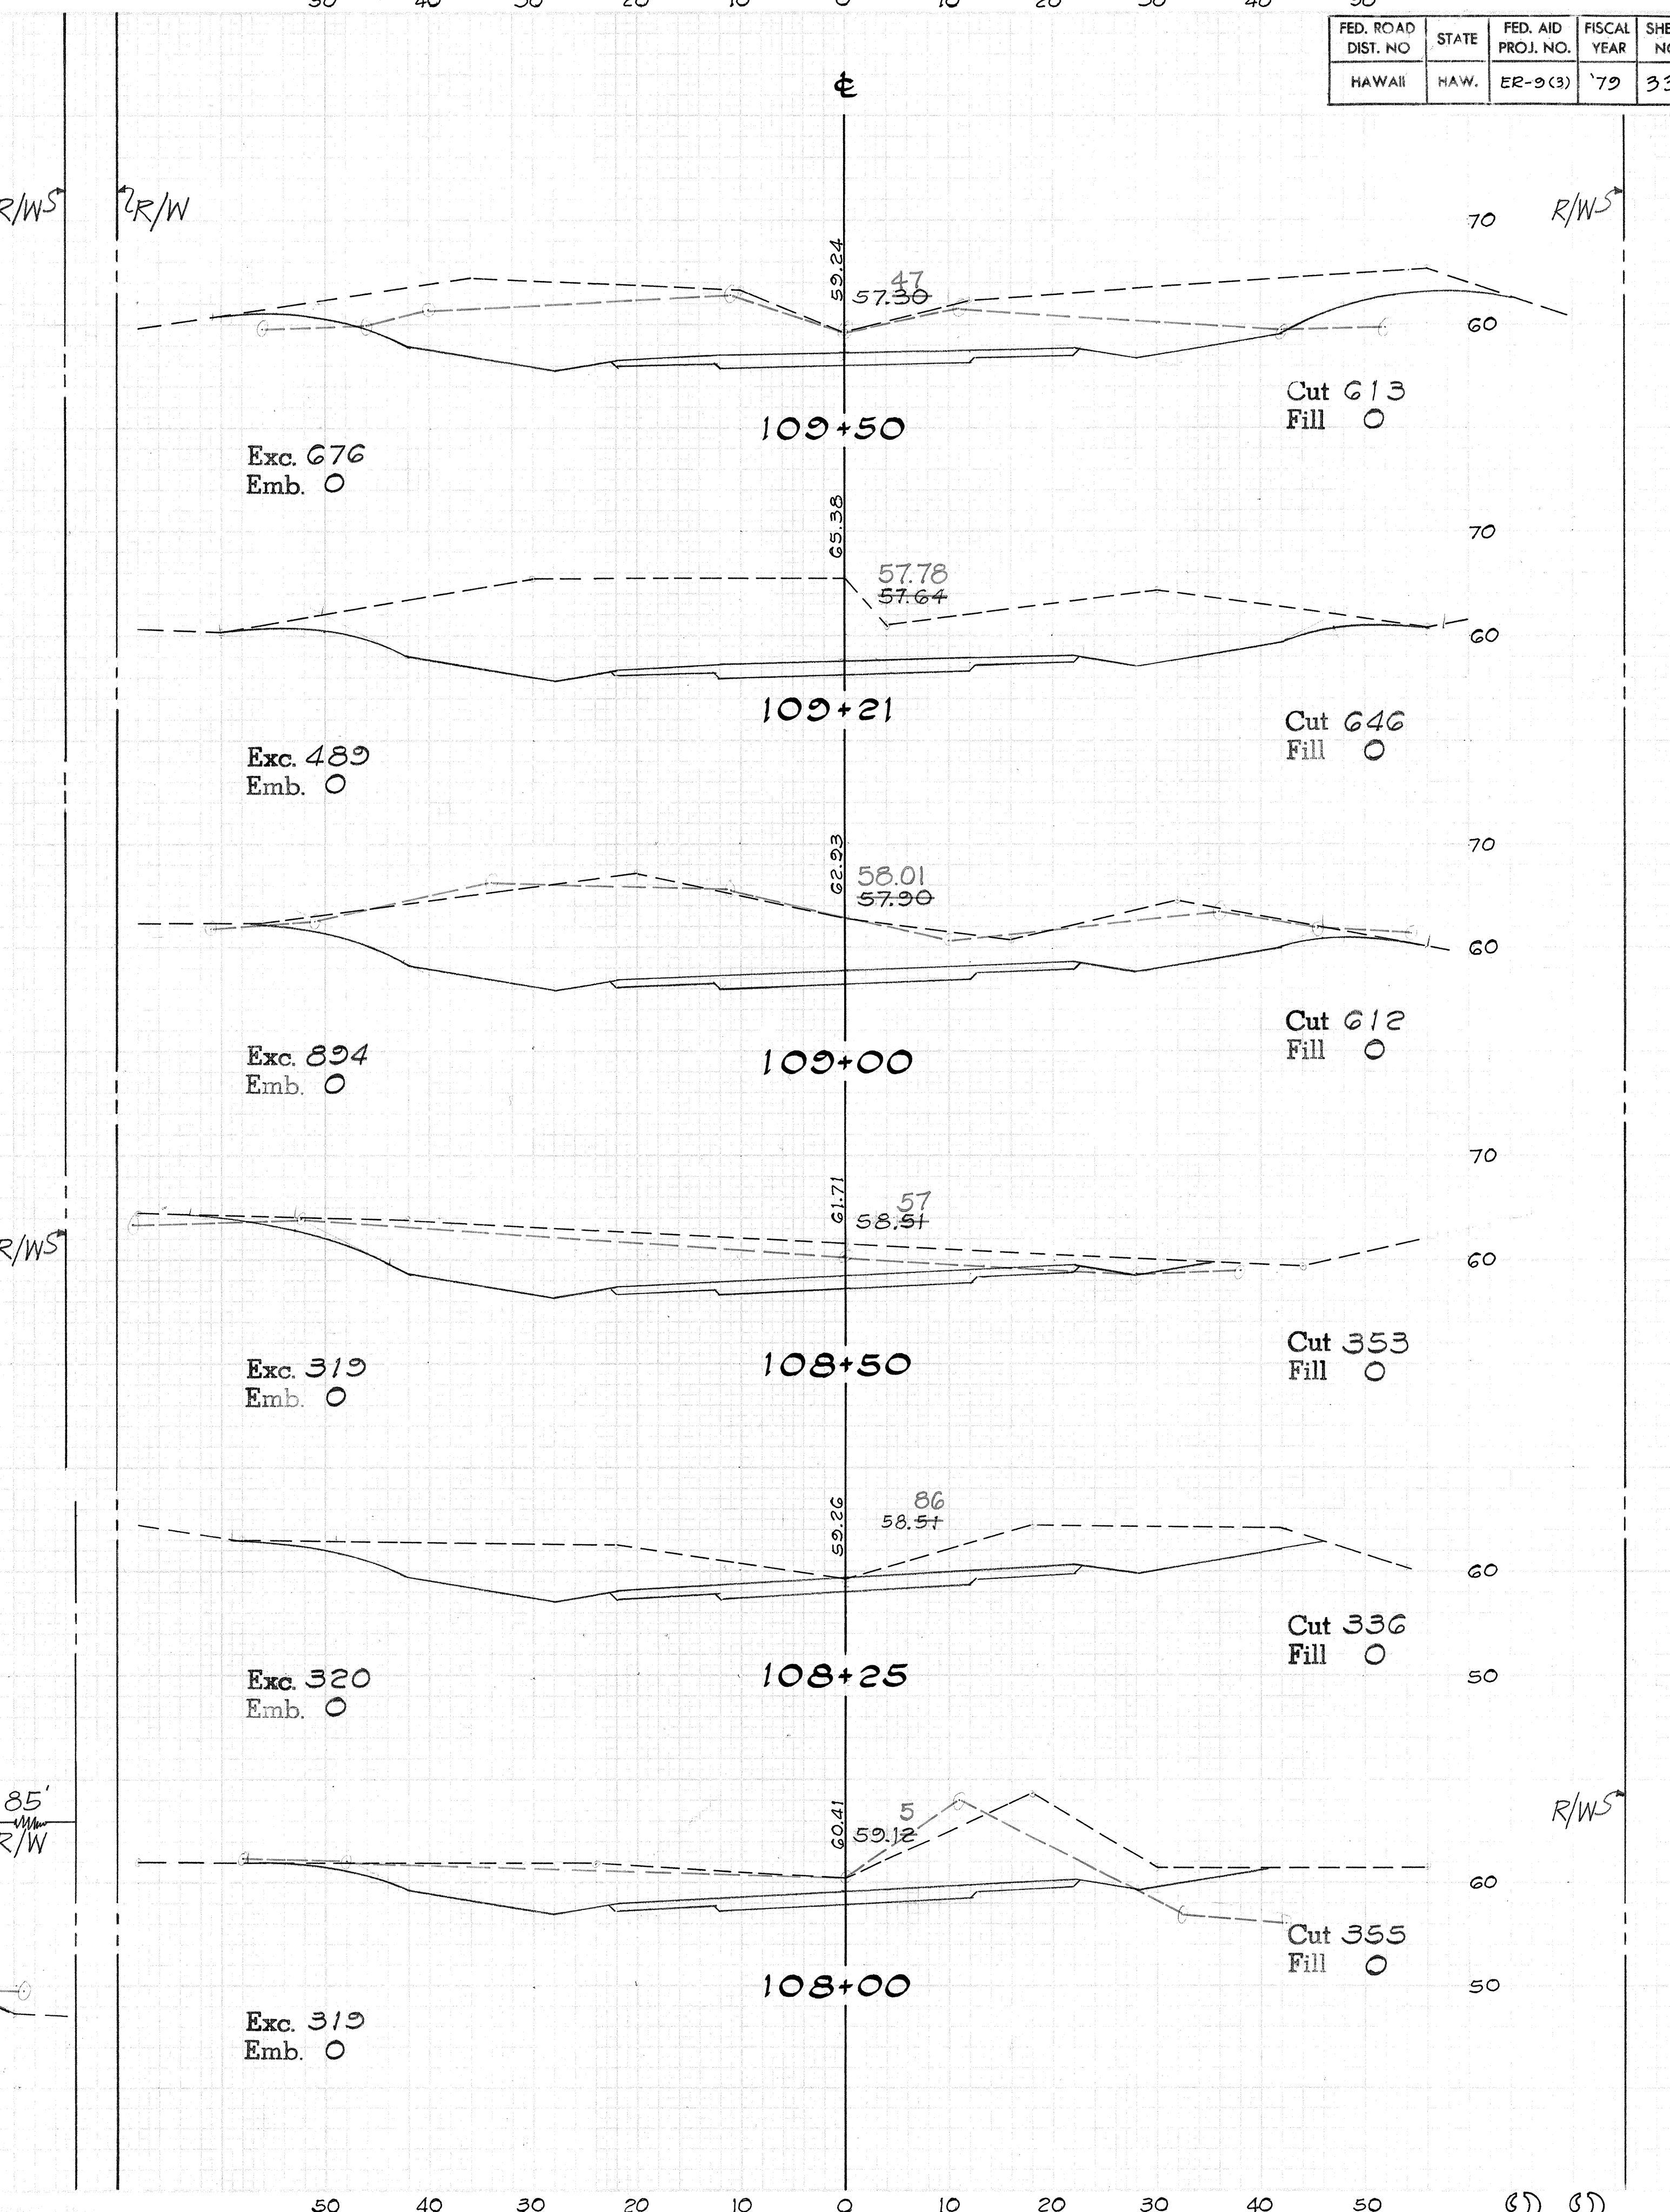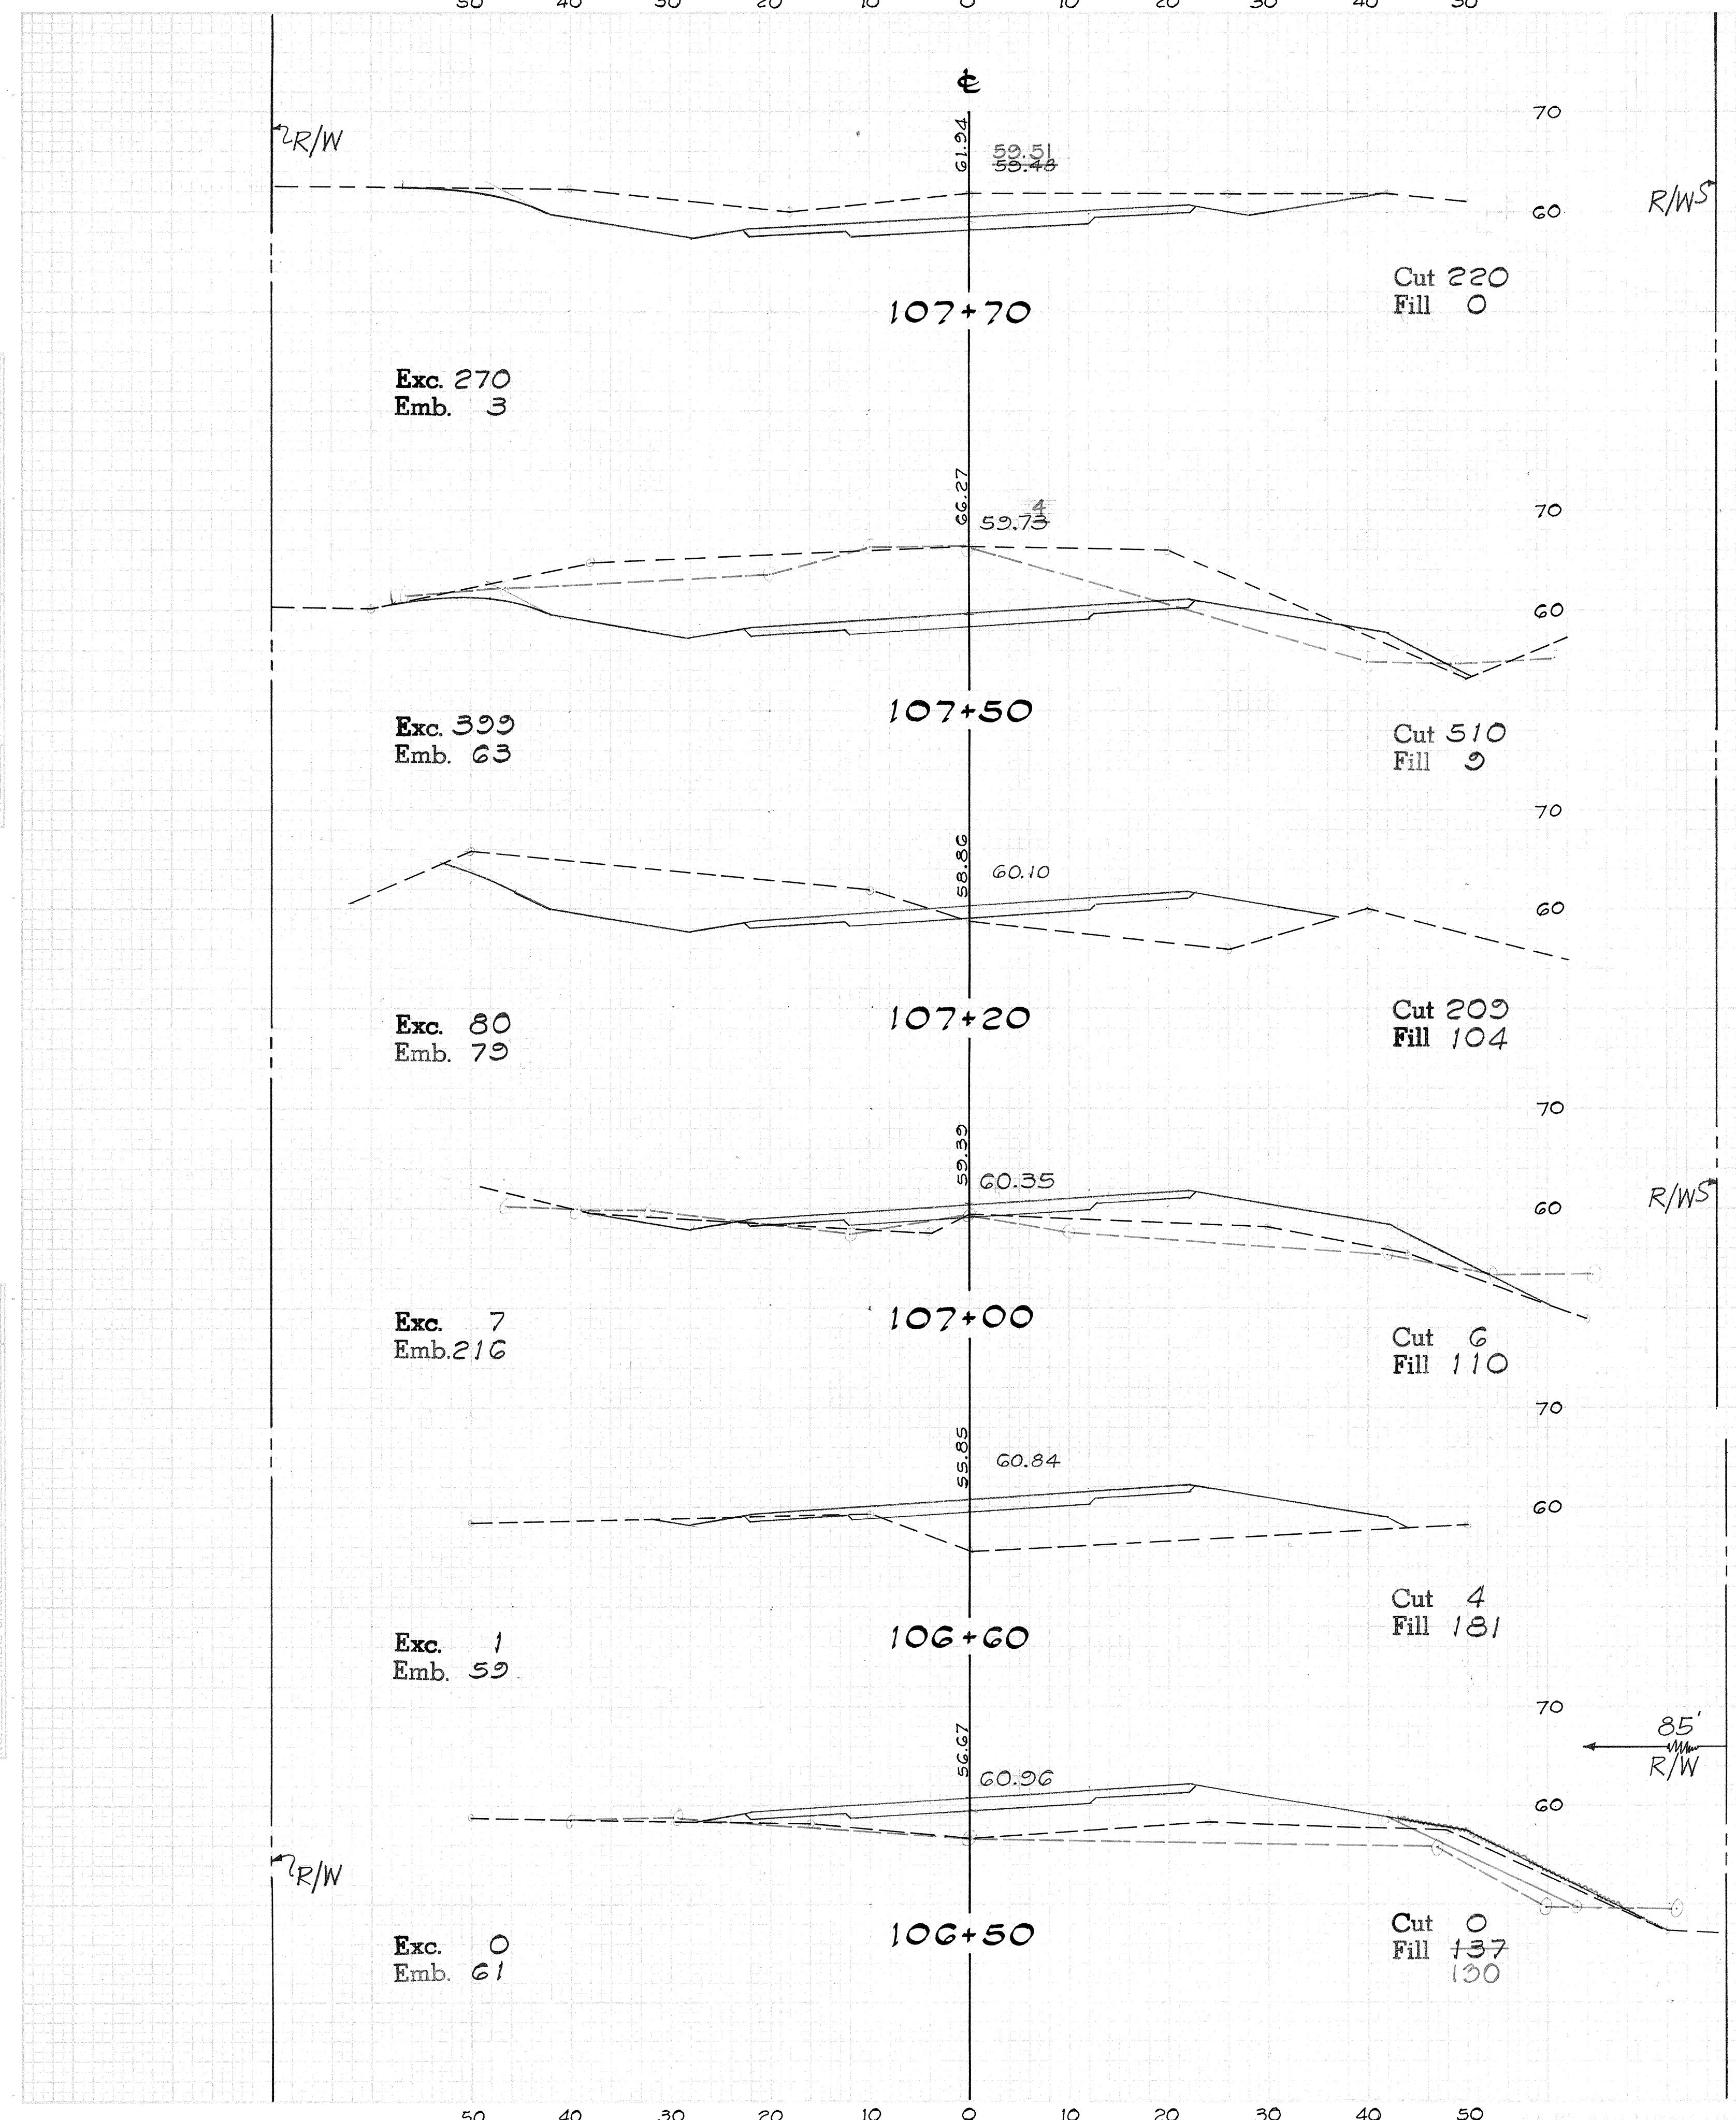

FED. ROAD DIST. NO.	STATE	FED. AID PROJ. NO.	FISCAL YEAR	SHEET NO.	TOTAL SHEETS
HAWAII	HAW.	ER-9(3)	'79	34	89

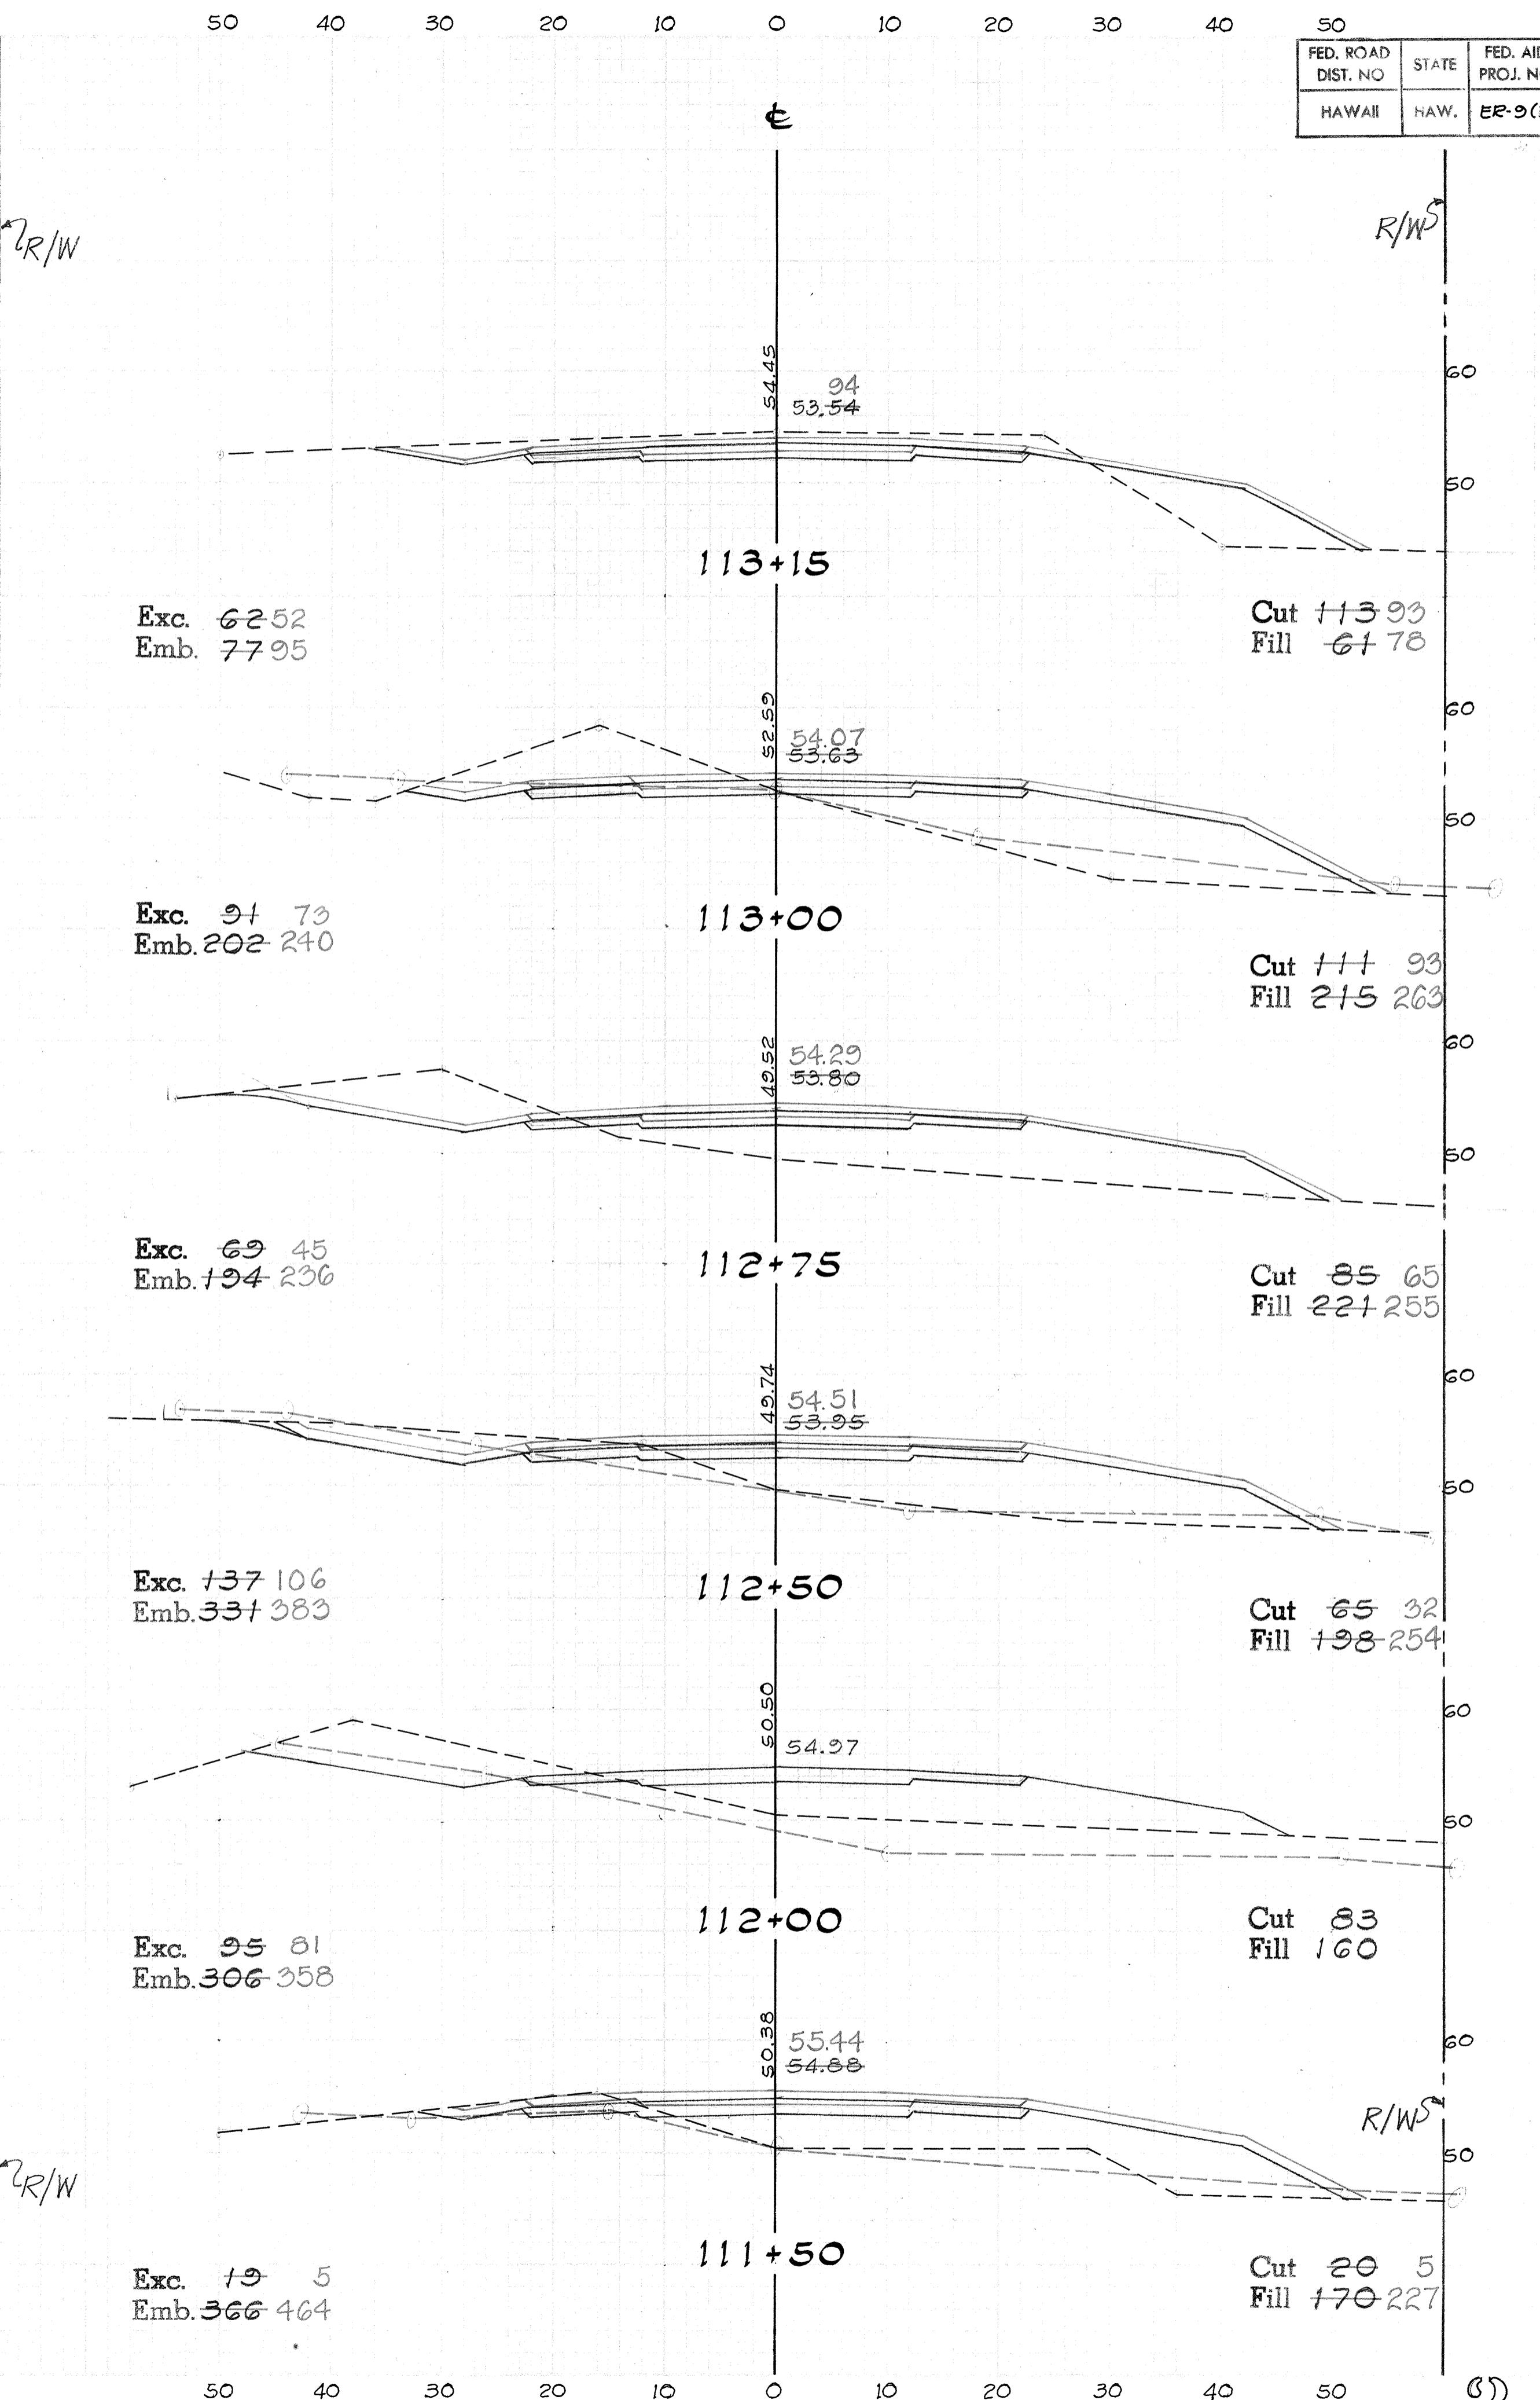
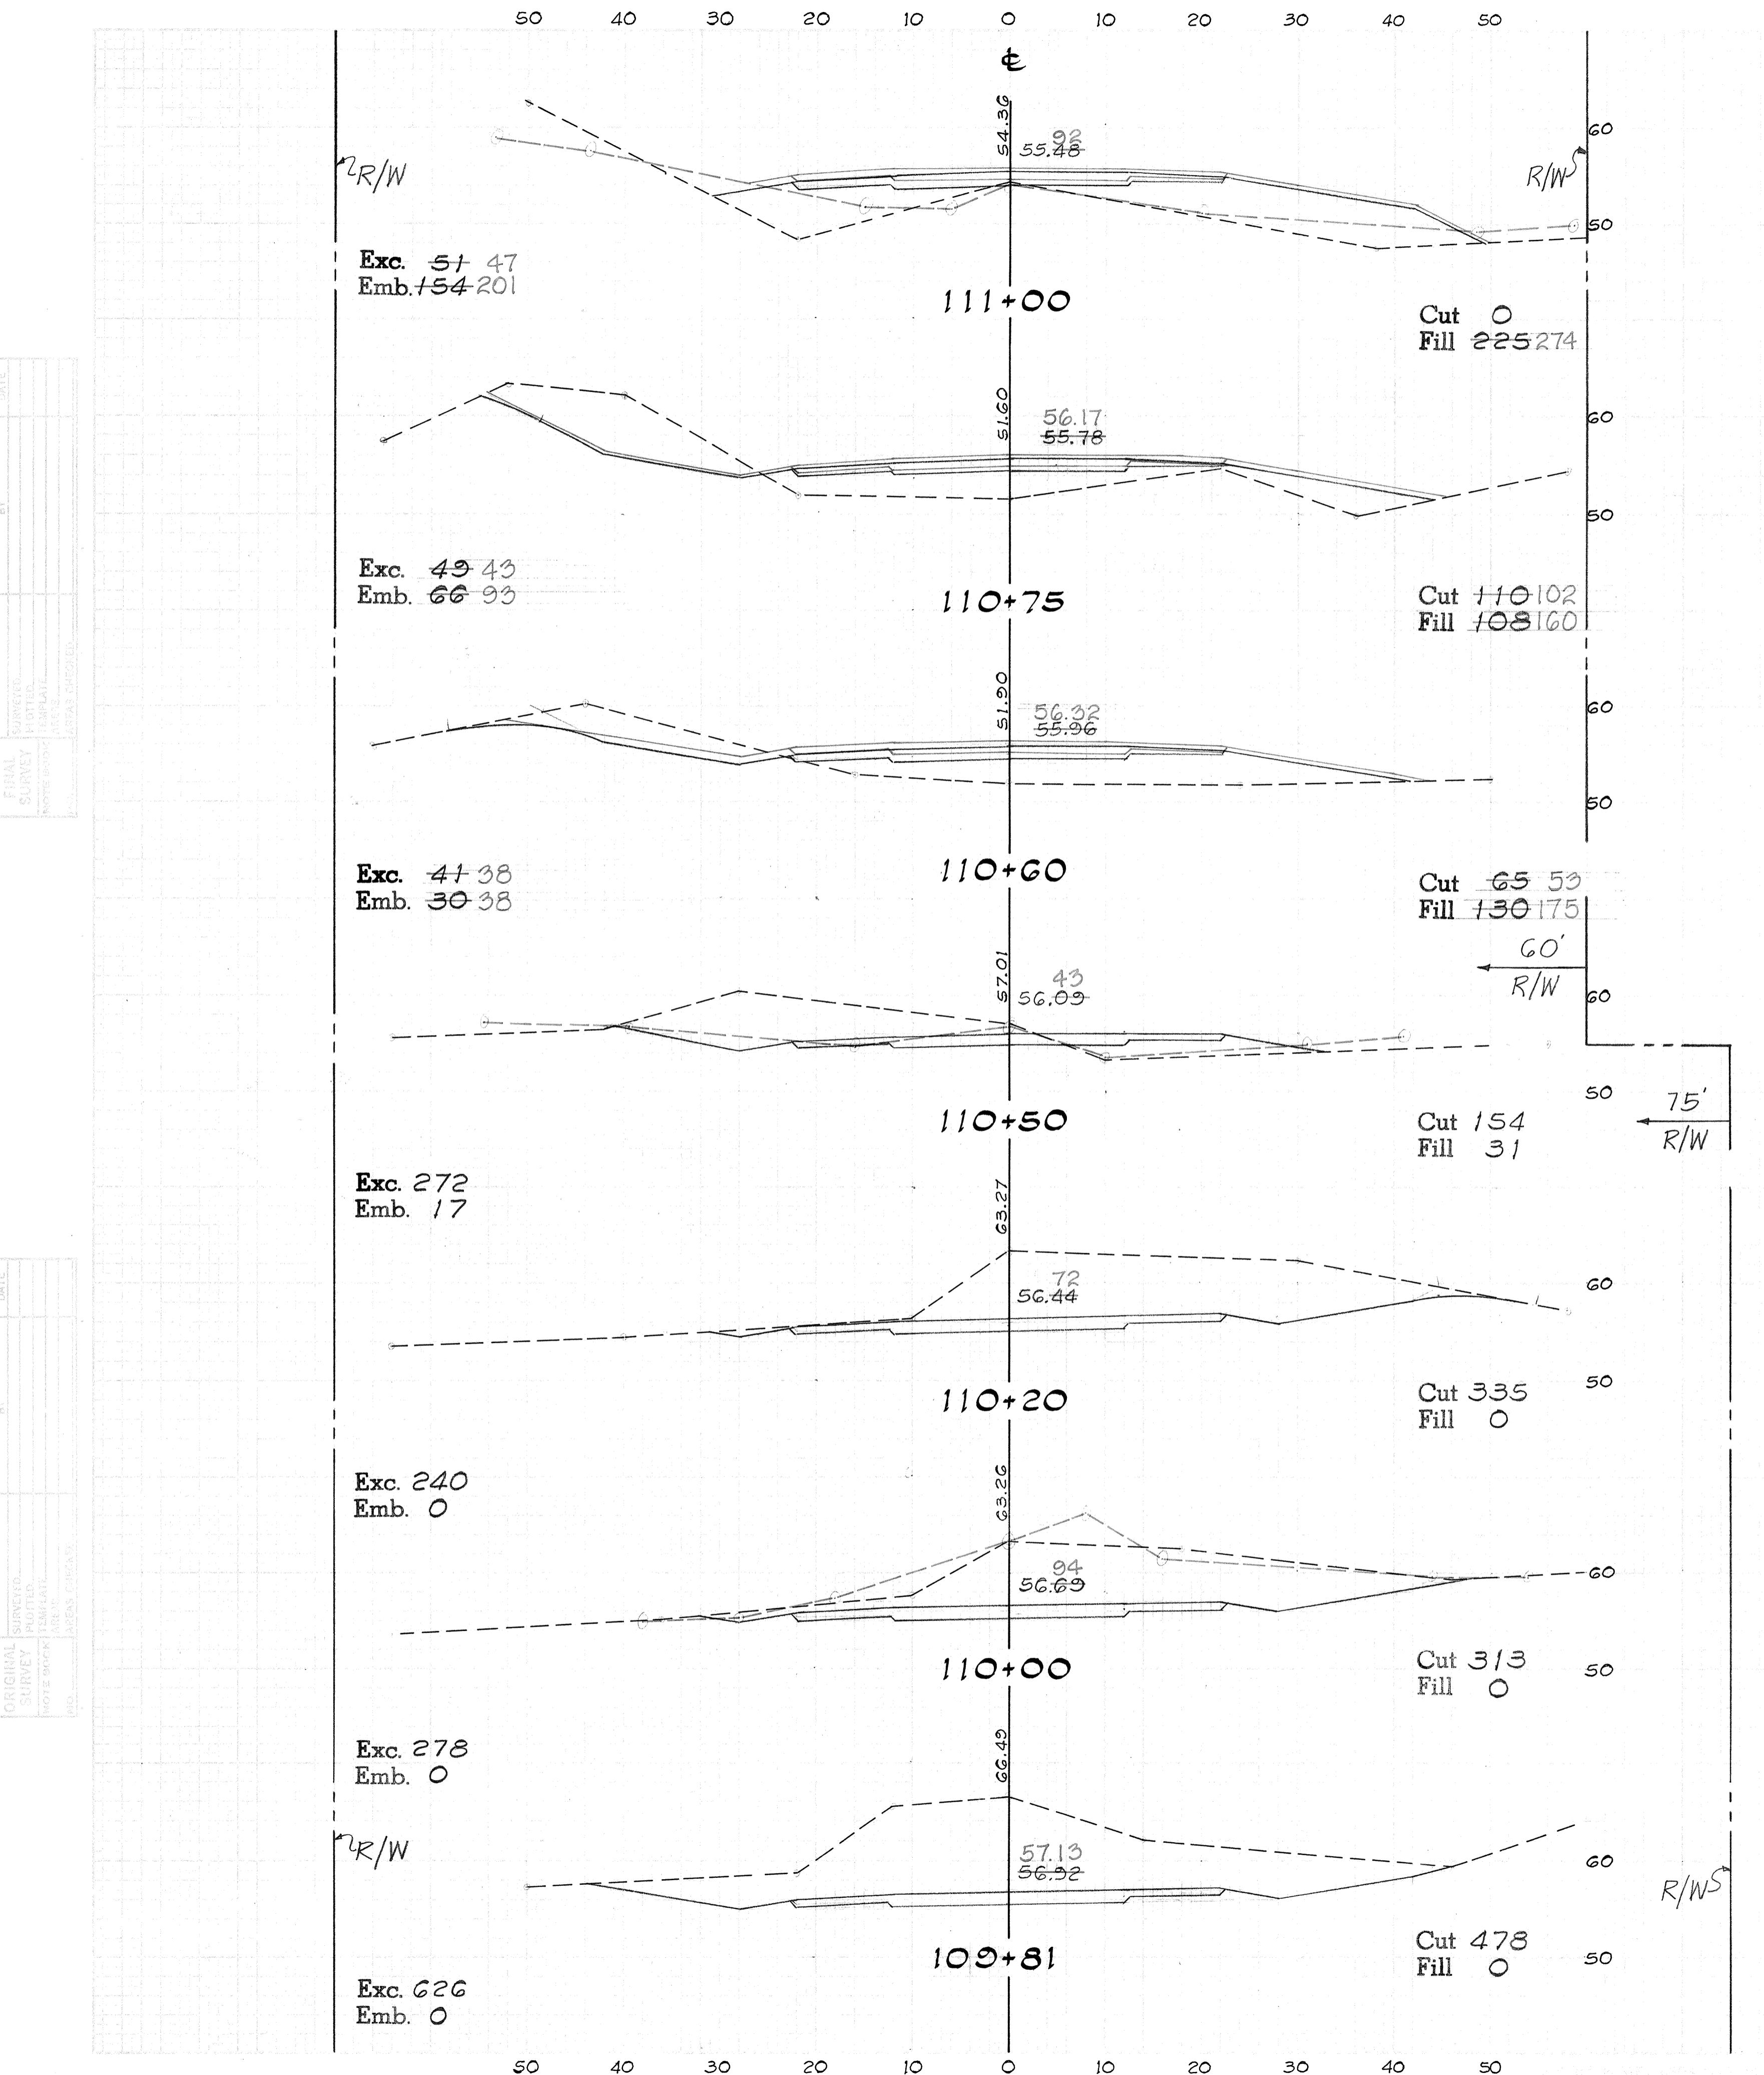


FED. ROAD DIST. NO.	STATE	FED. AID PROJ. NO.	FISCAL YEAR	SHEET NO.	TOTAL SHEETS
HAWAII	HAW.	ER-9(3)	'79	35	89

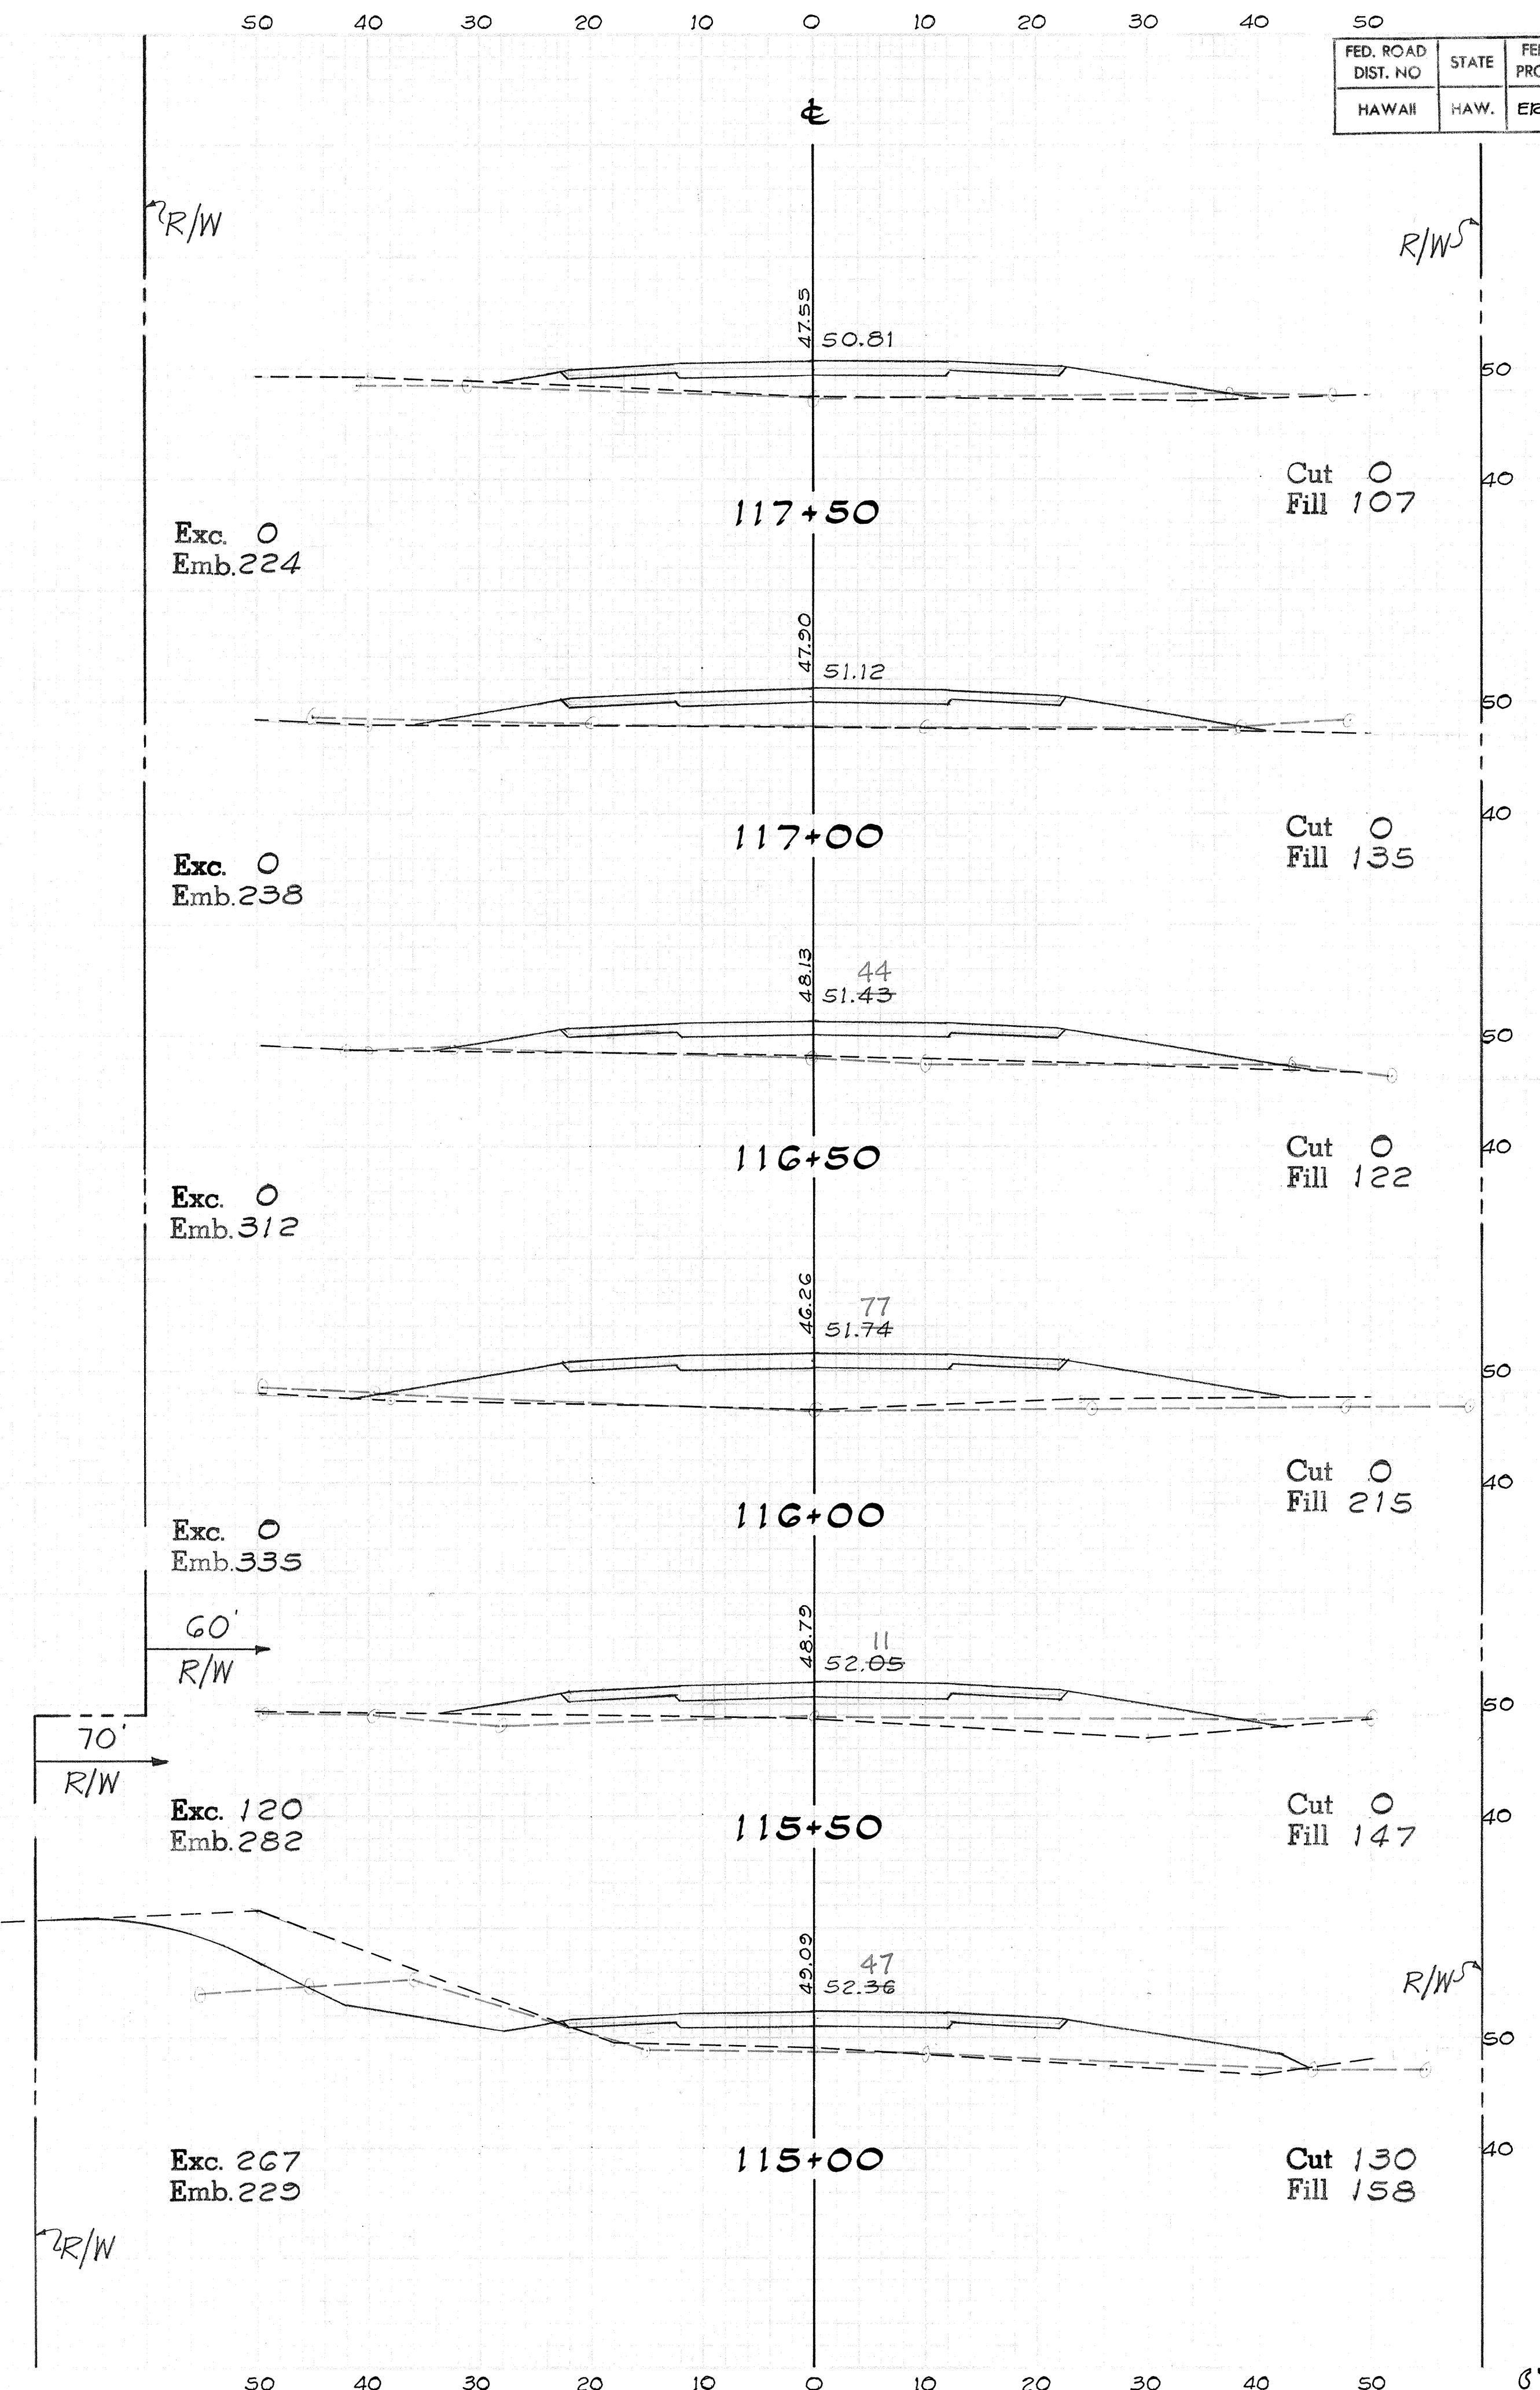
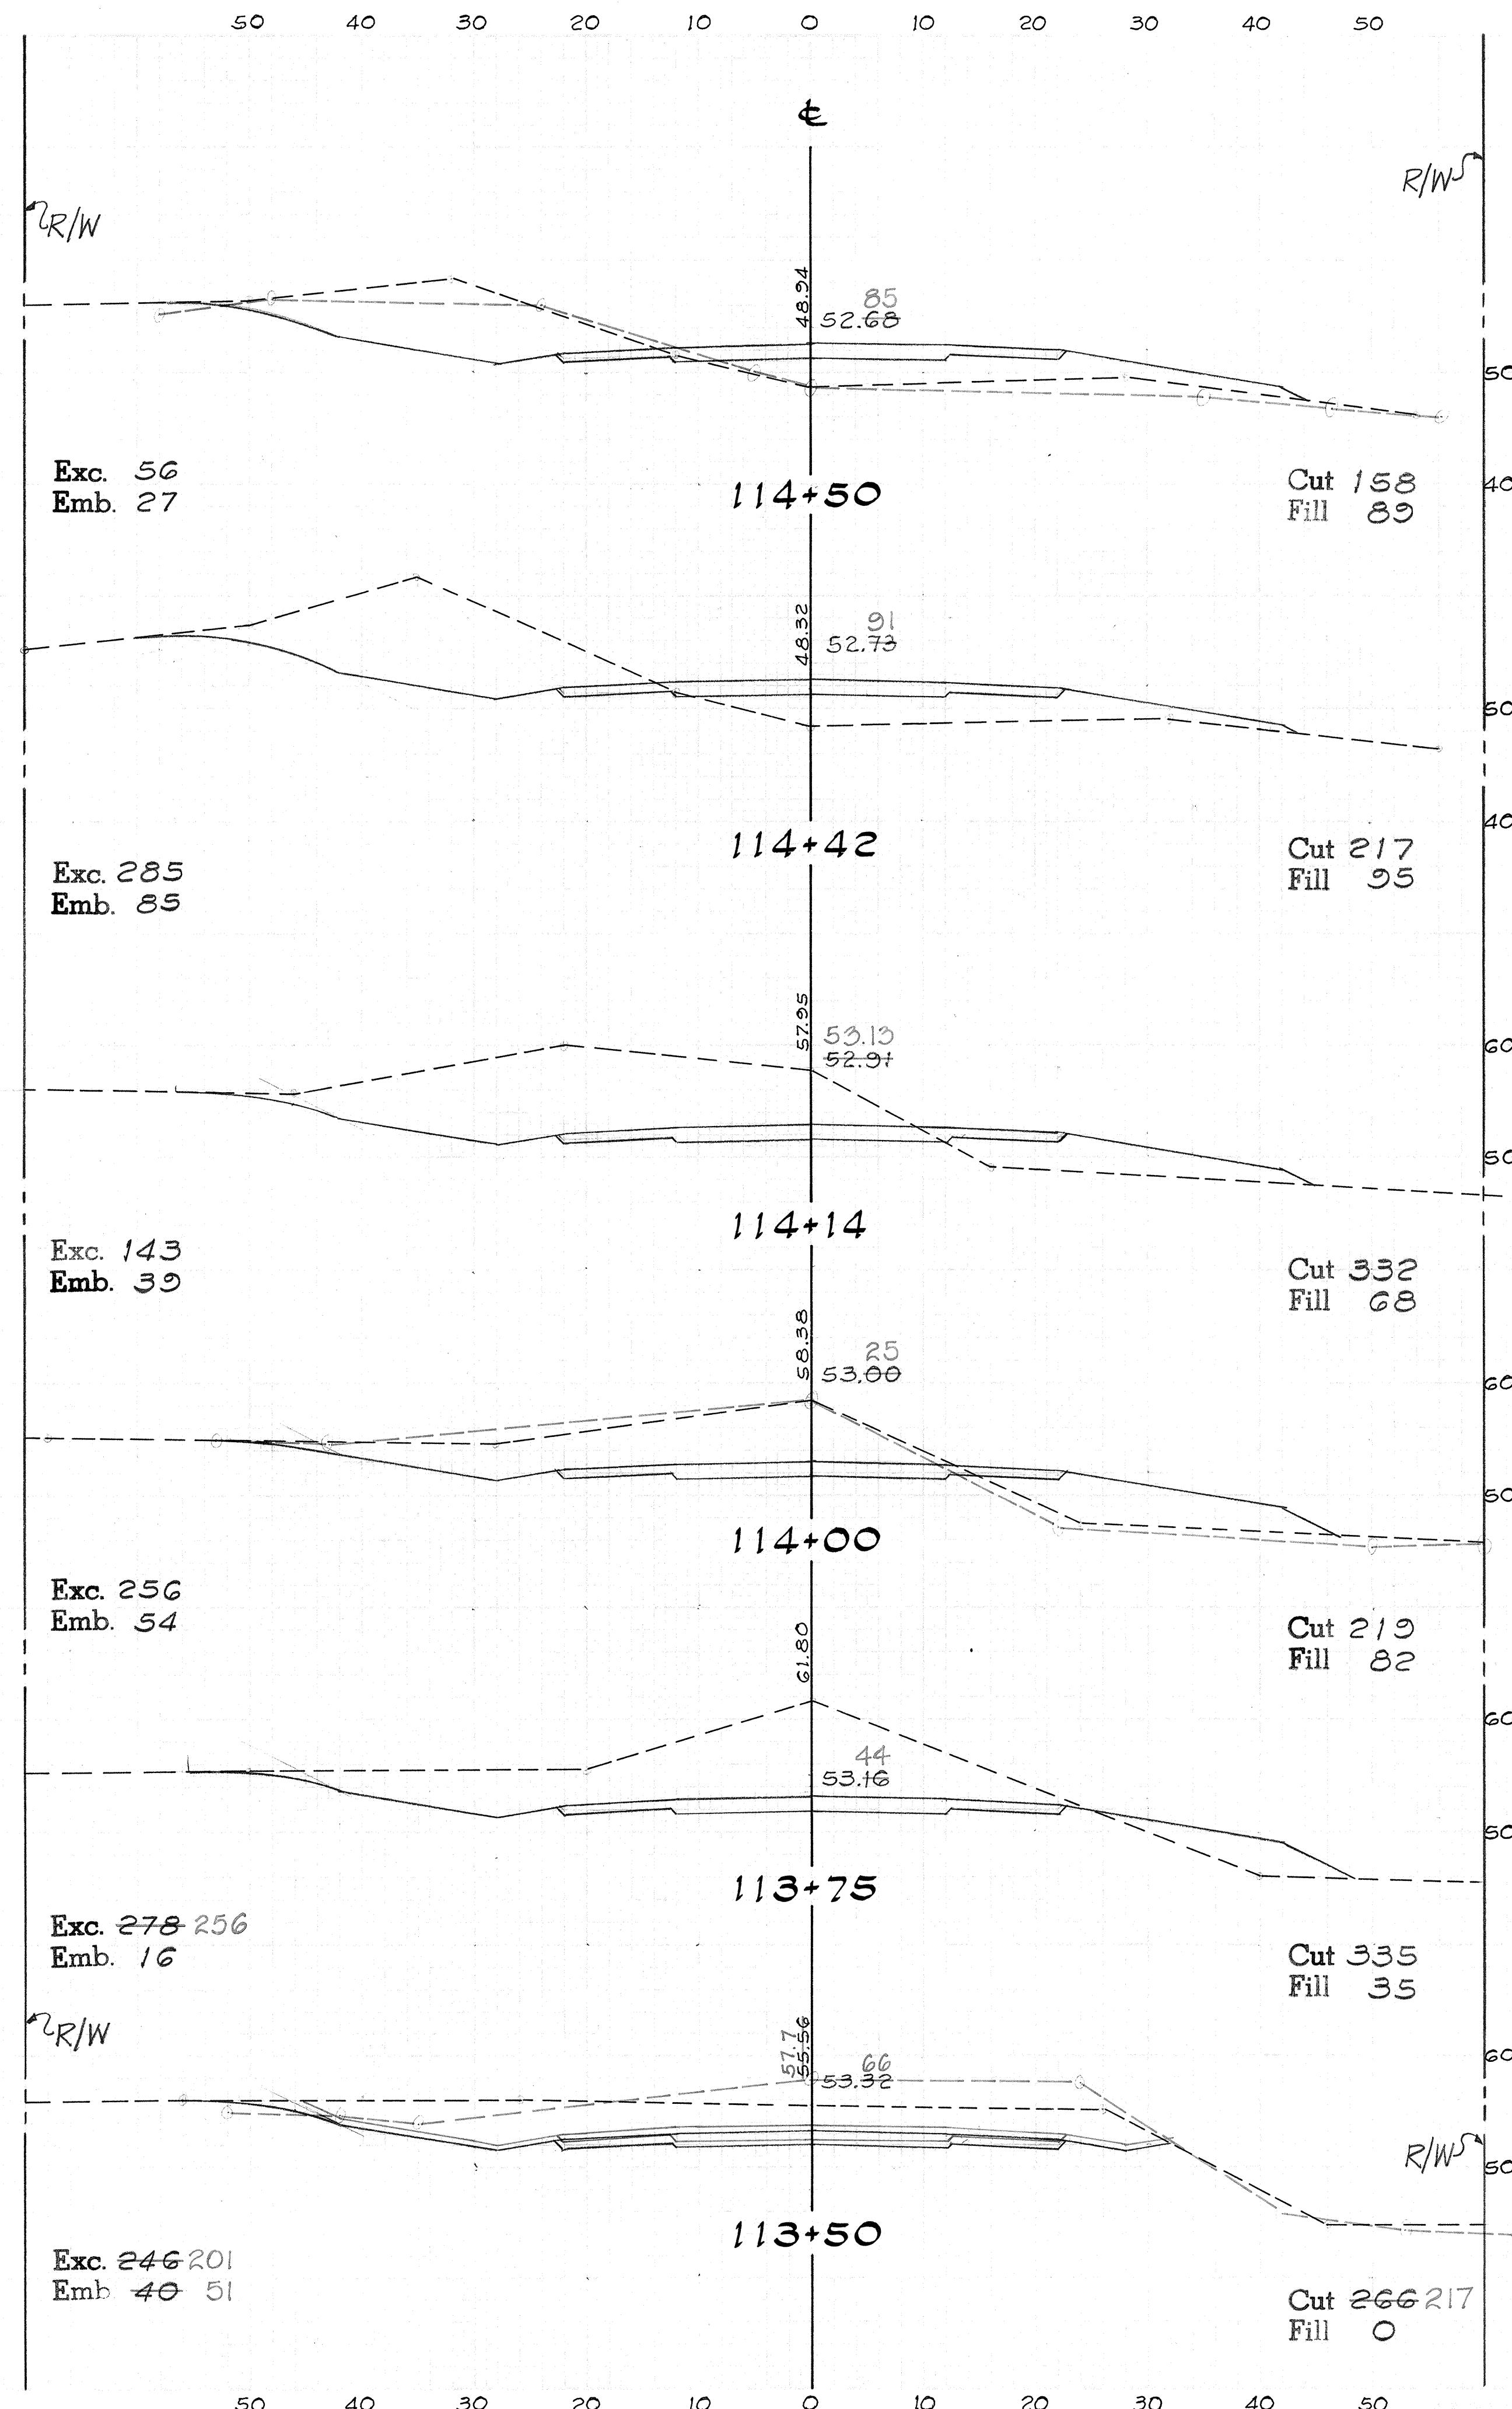


Q3 55


FED. ROAD DIST. NO.	STATE	FED. AID PROJ. NO.	FISCAL YEAR	HEET NO.	TOTAL SHEETS
HAWAII	HAW.	ER-5(3)	79	36	89

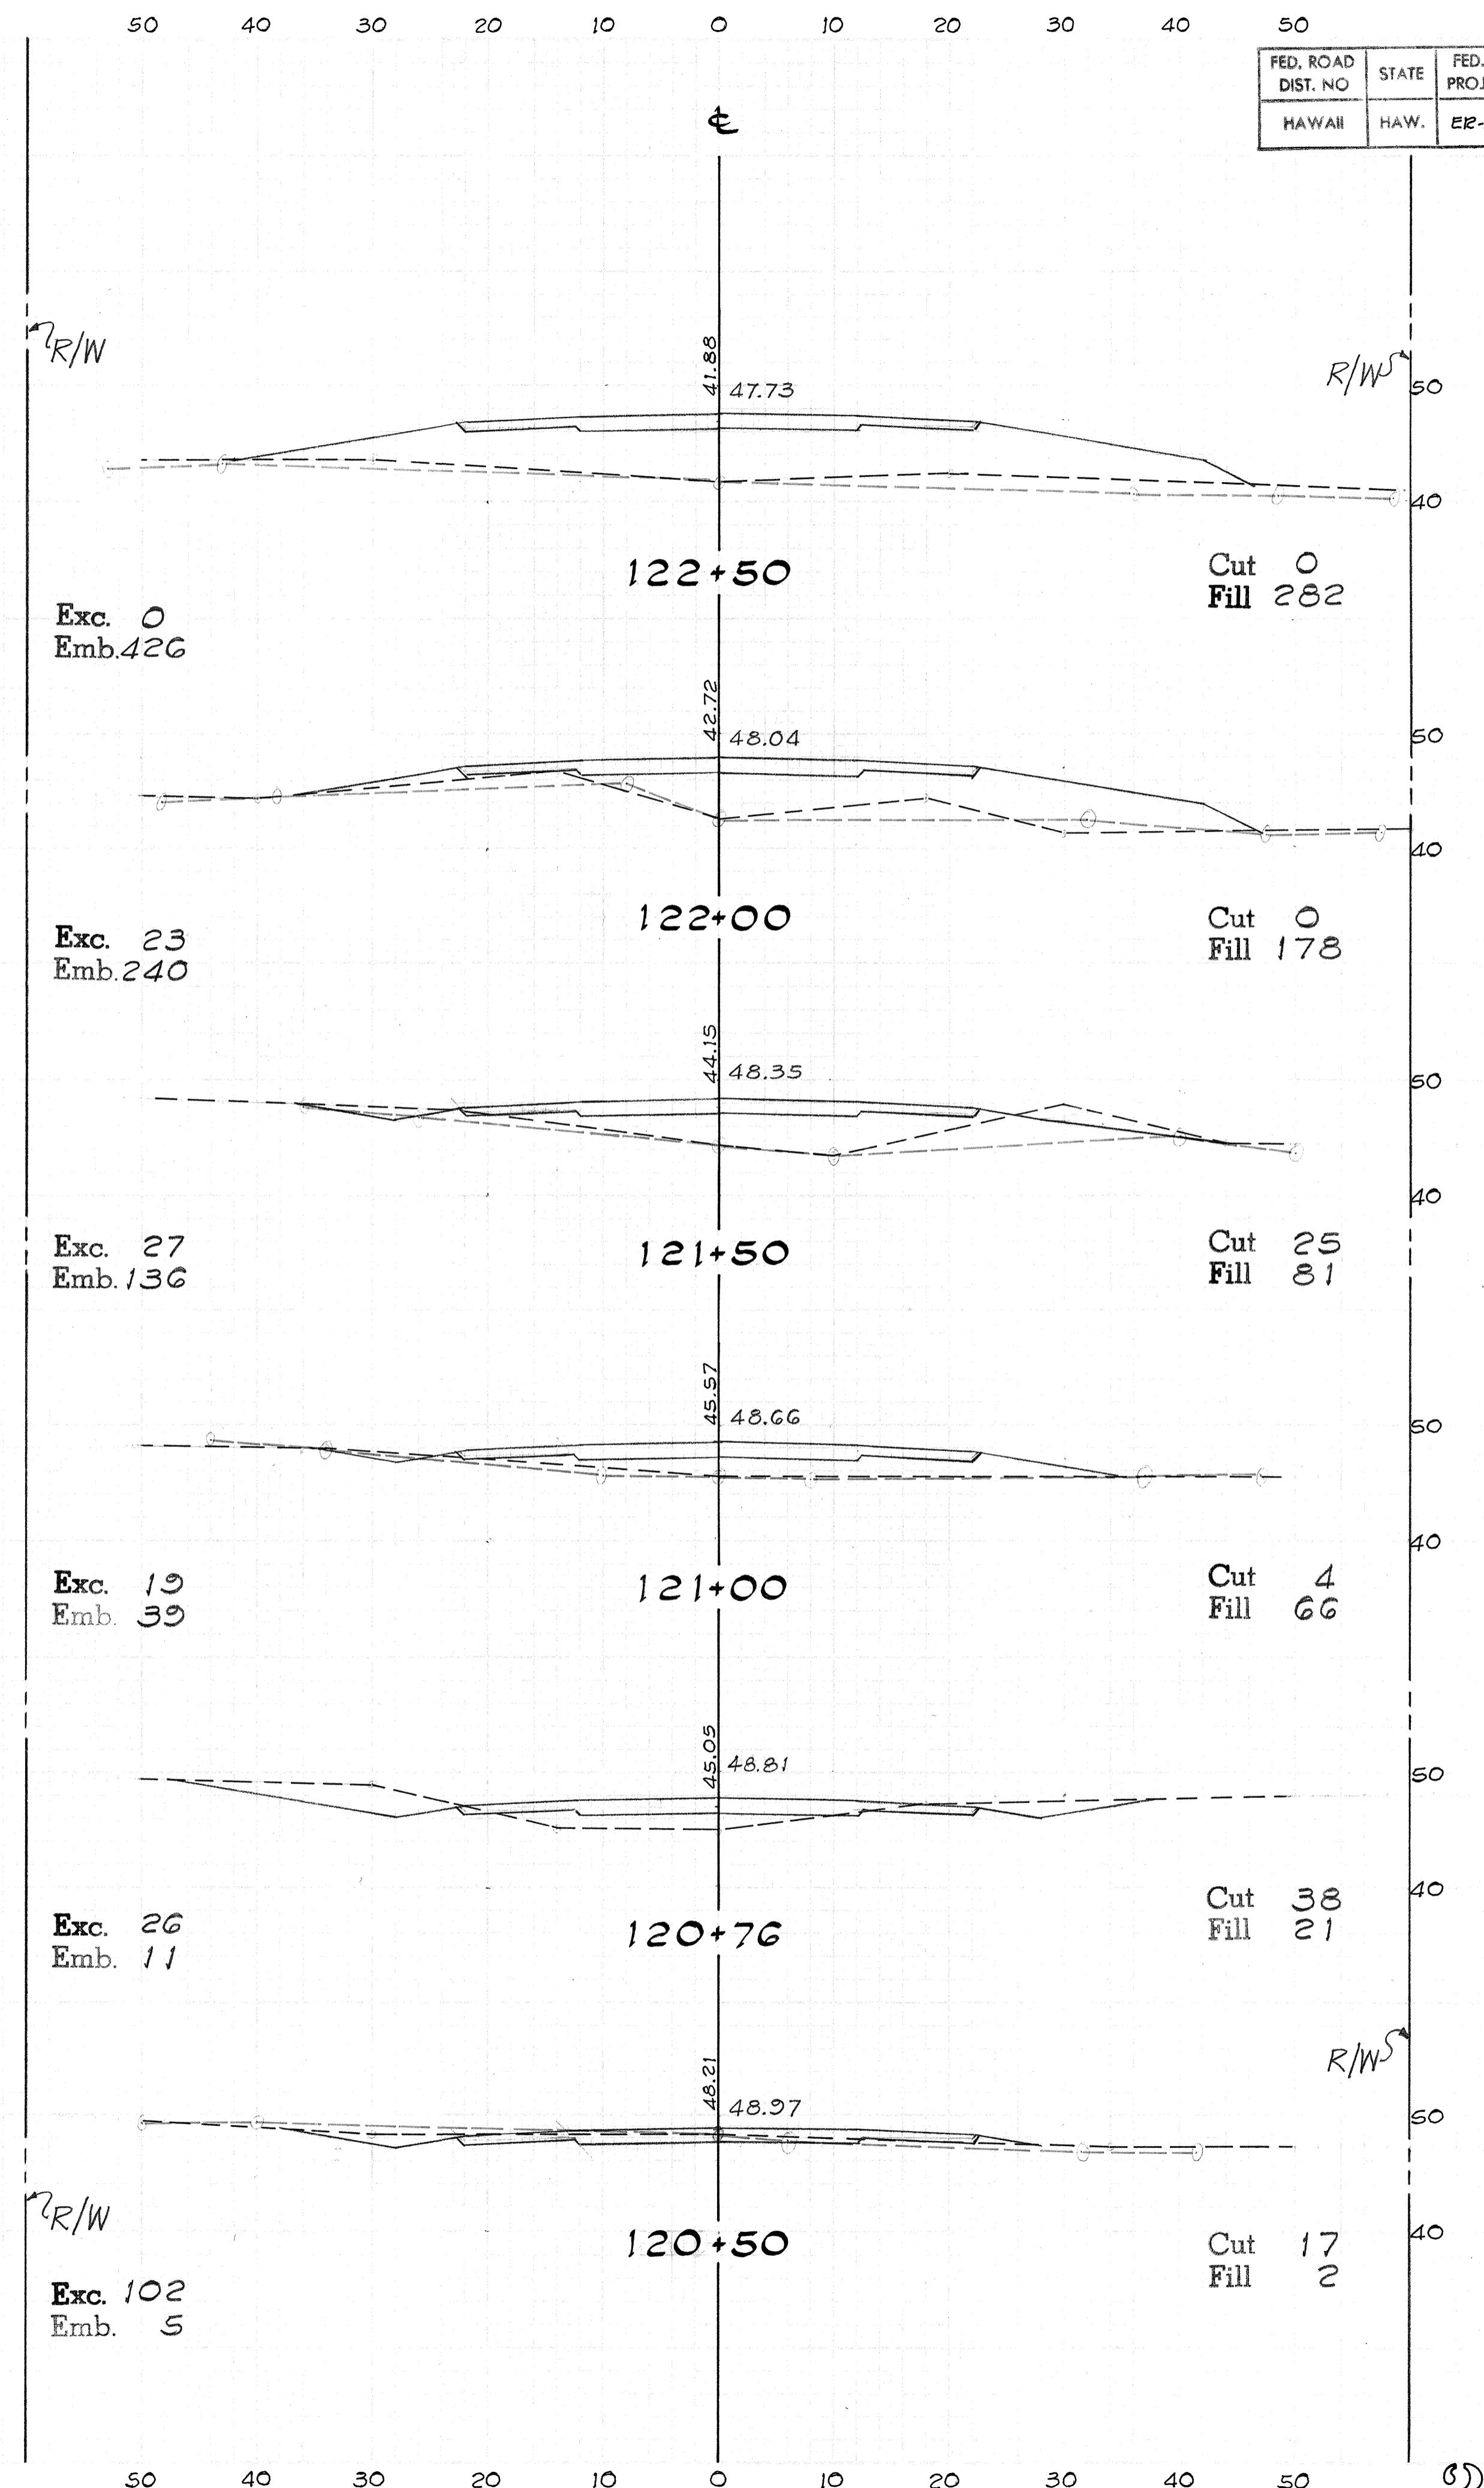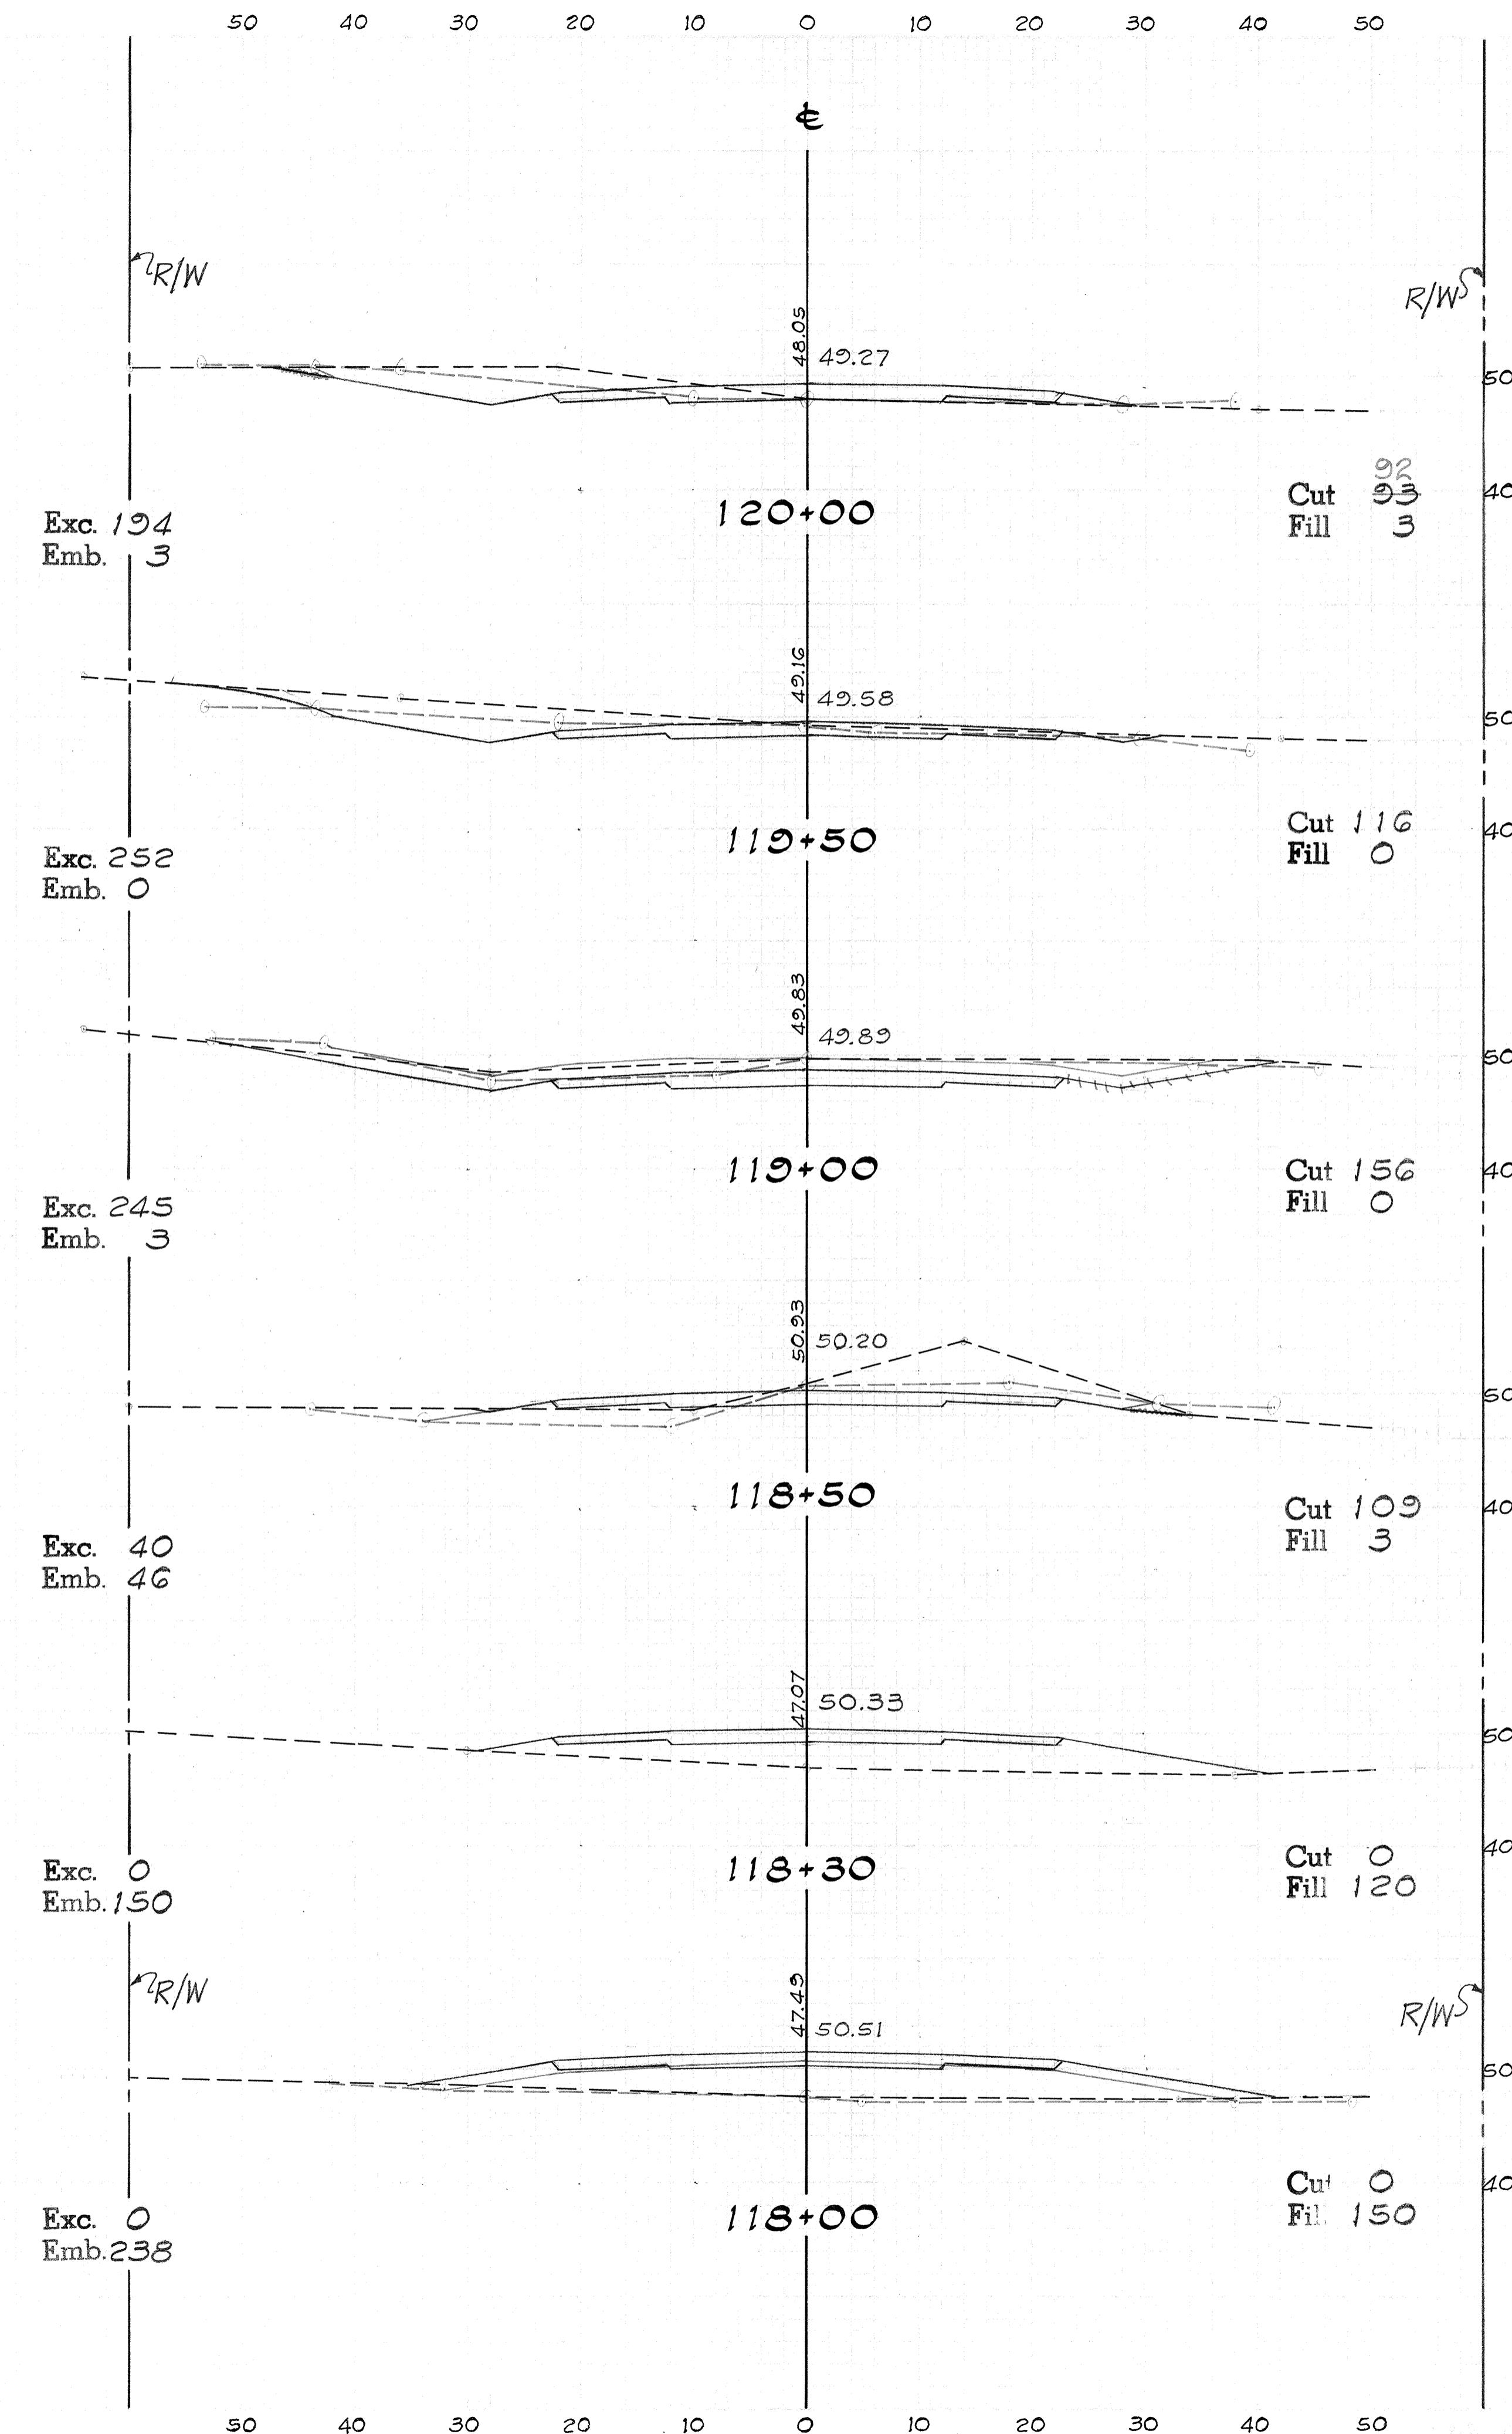



FED. ROAD DIST. NO.	STATE	FED. AID PROJ. NO.	FISCAL YEAR	SHEET NO.	TOTAL SHEETS
HAWAII	HAW.	ER-9(3)	'79	37	89

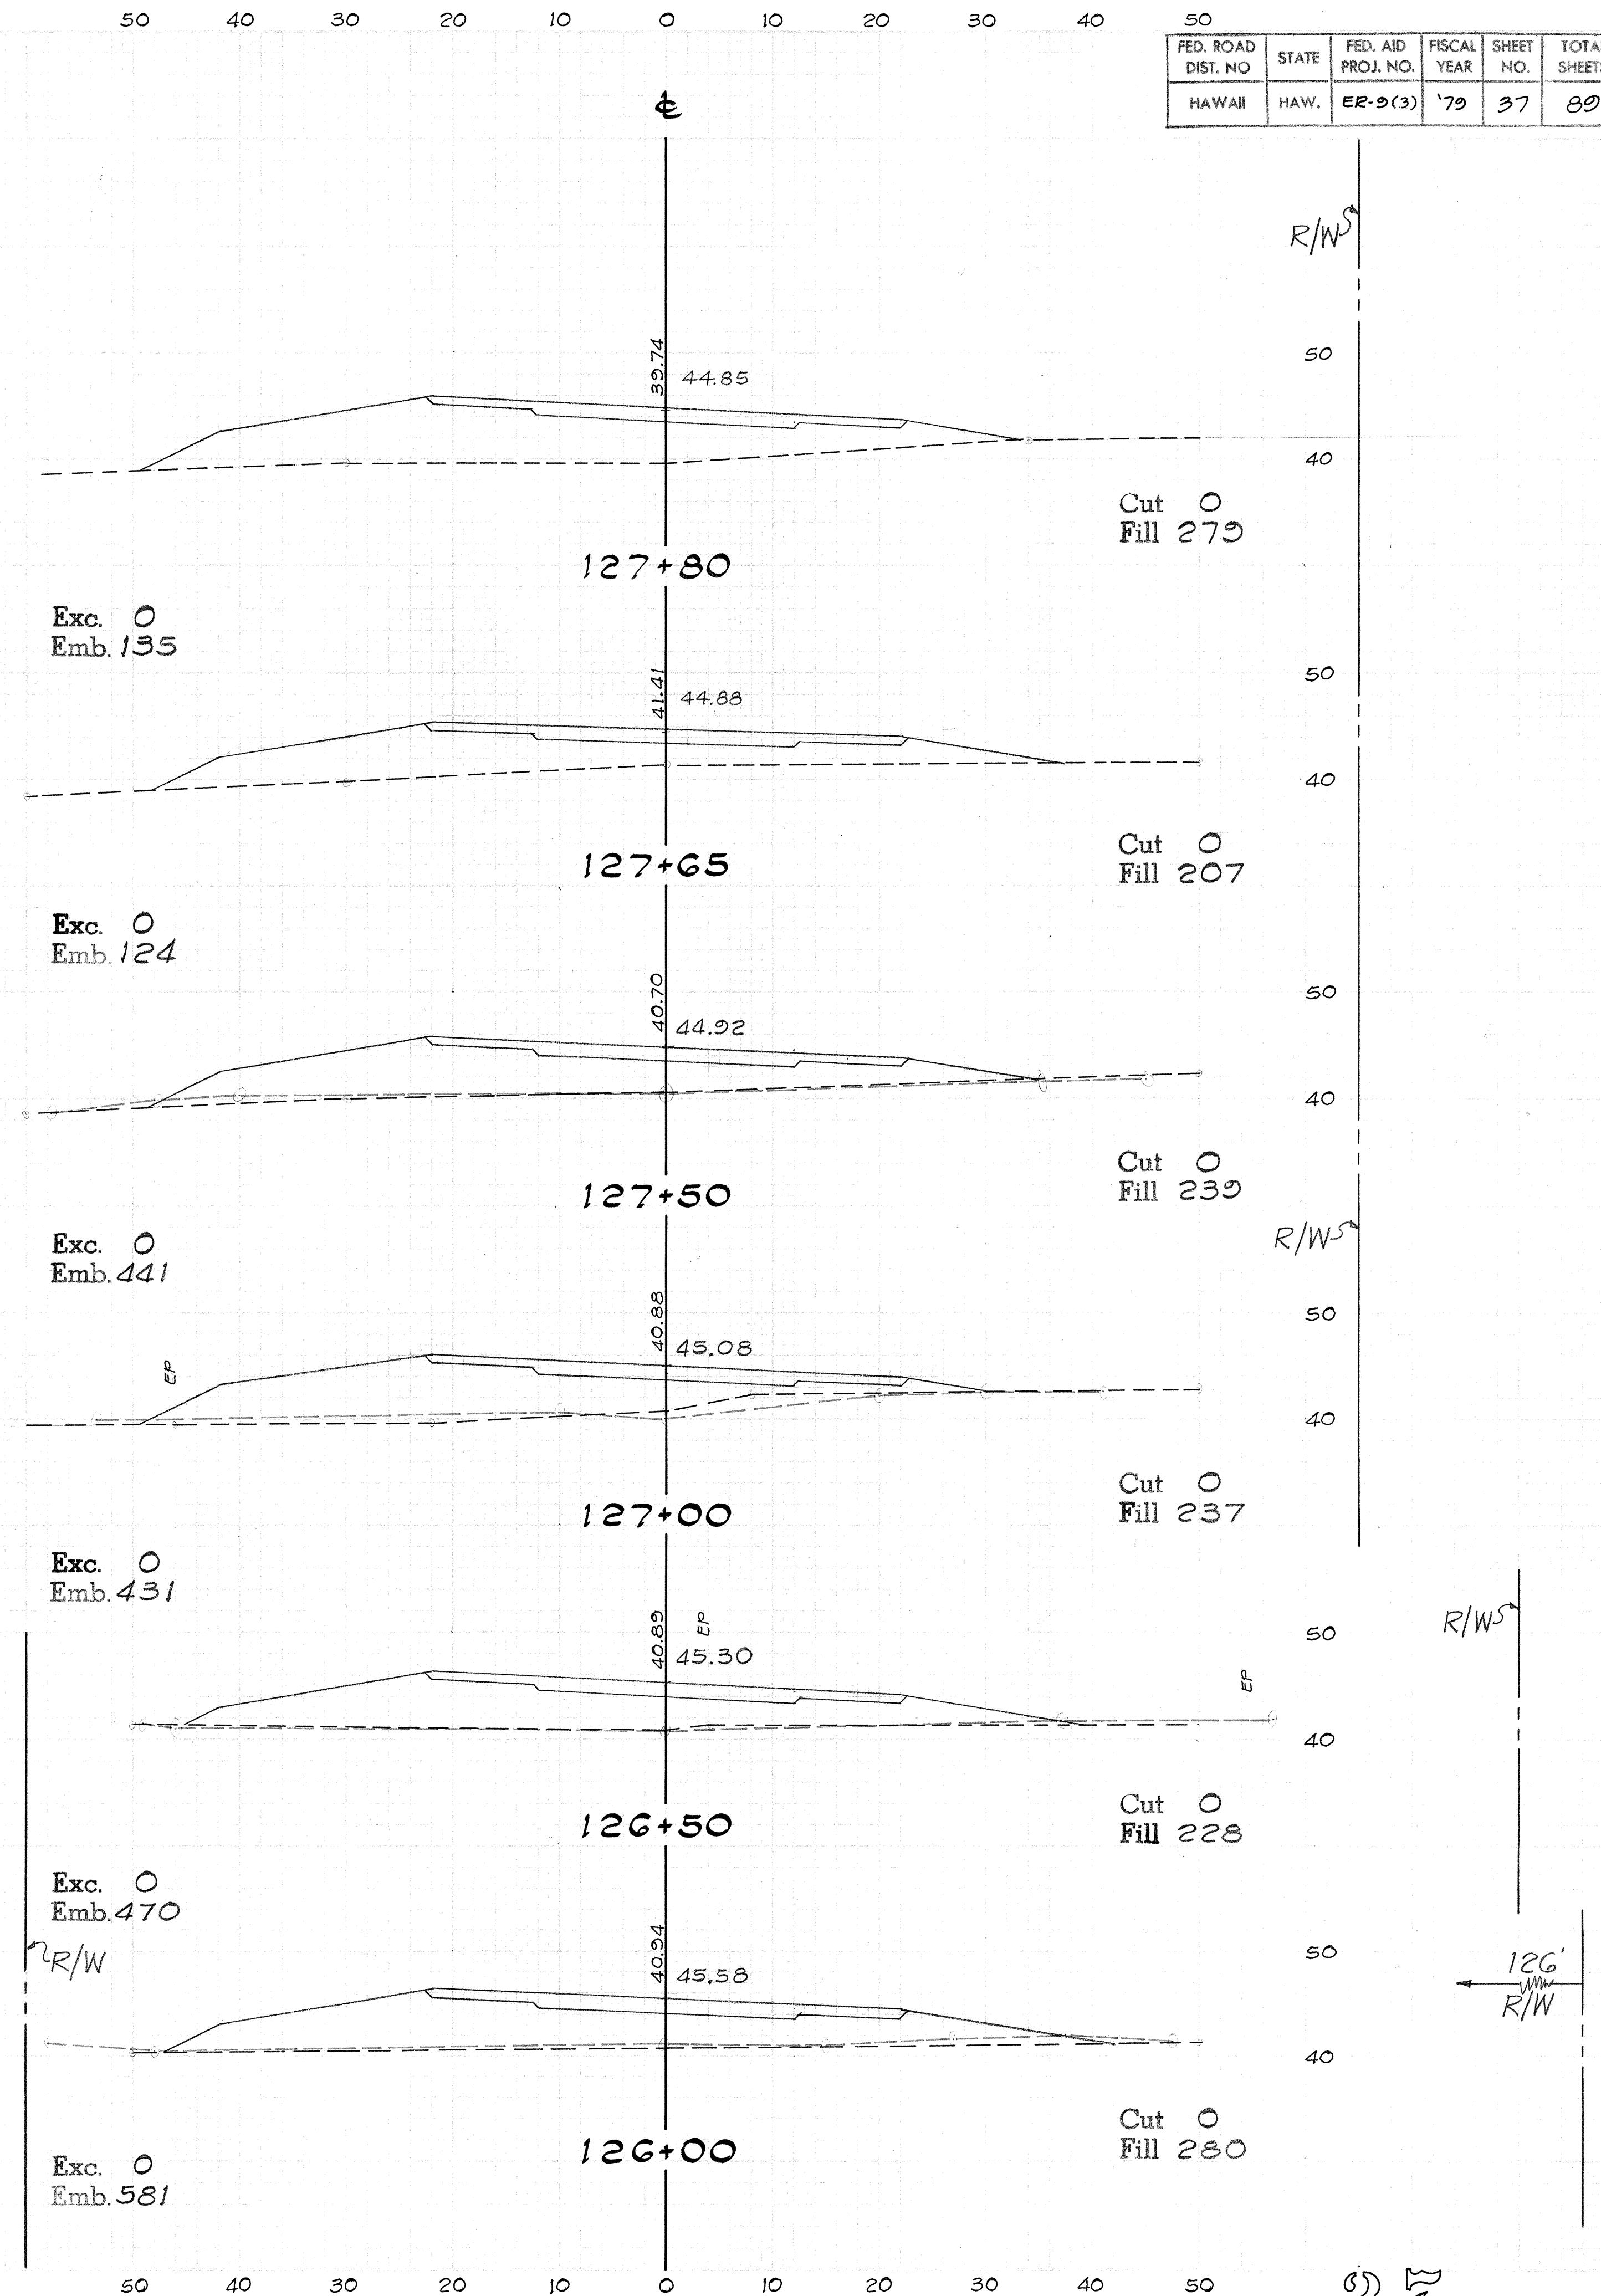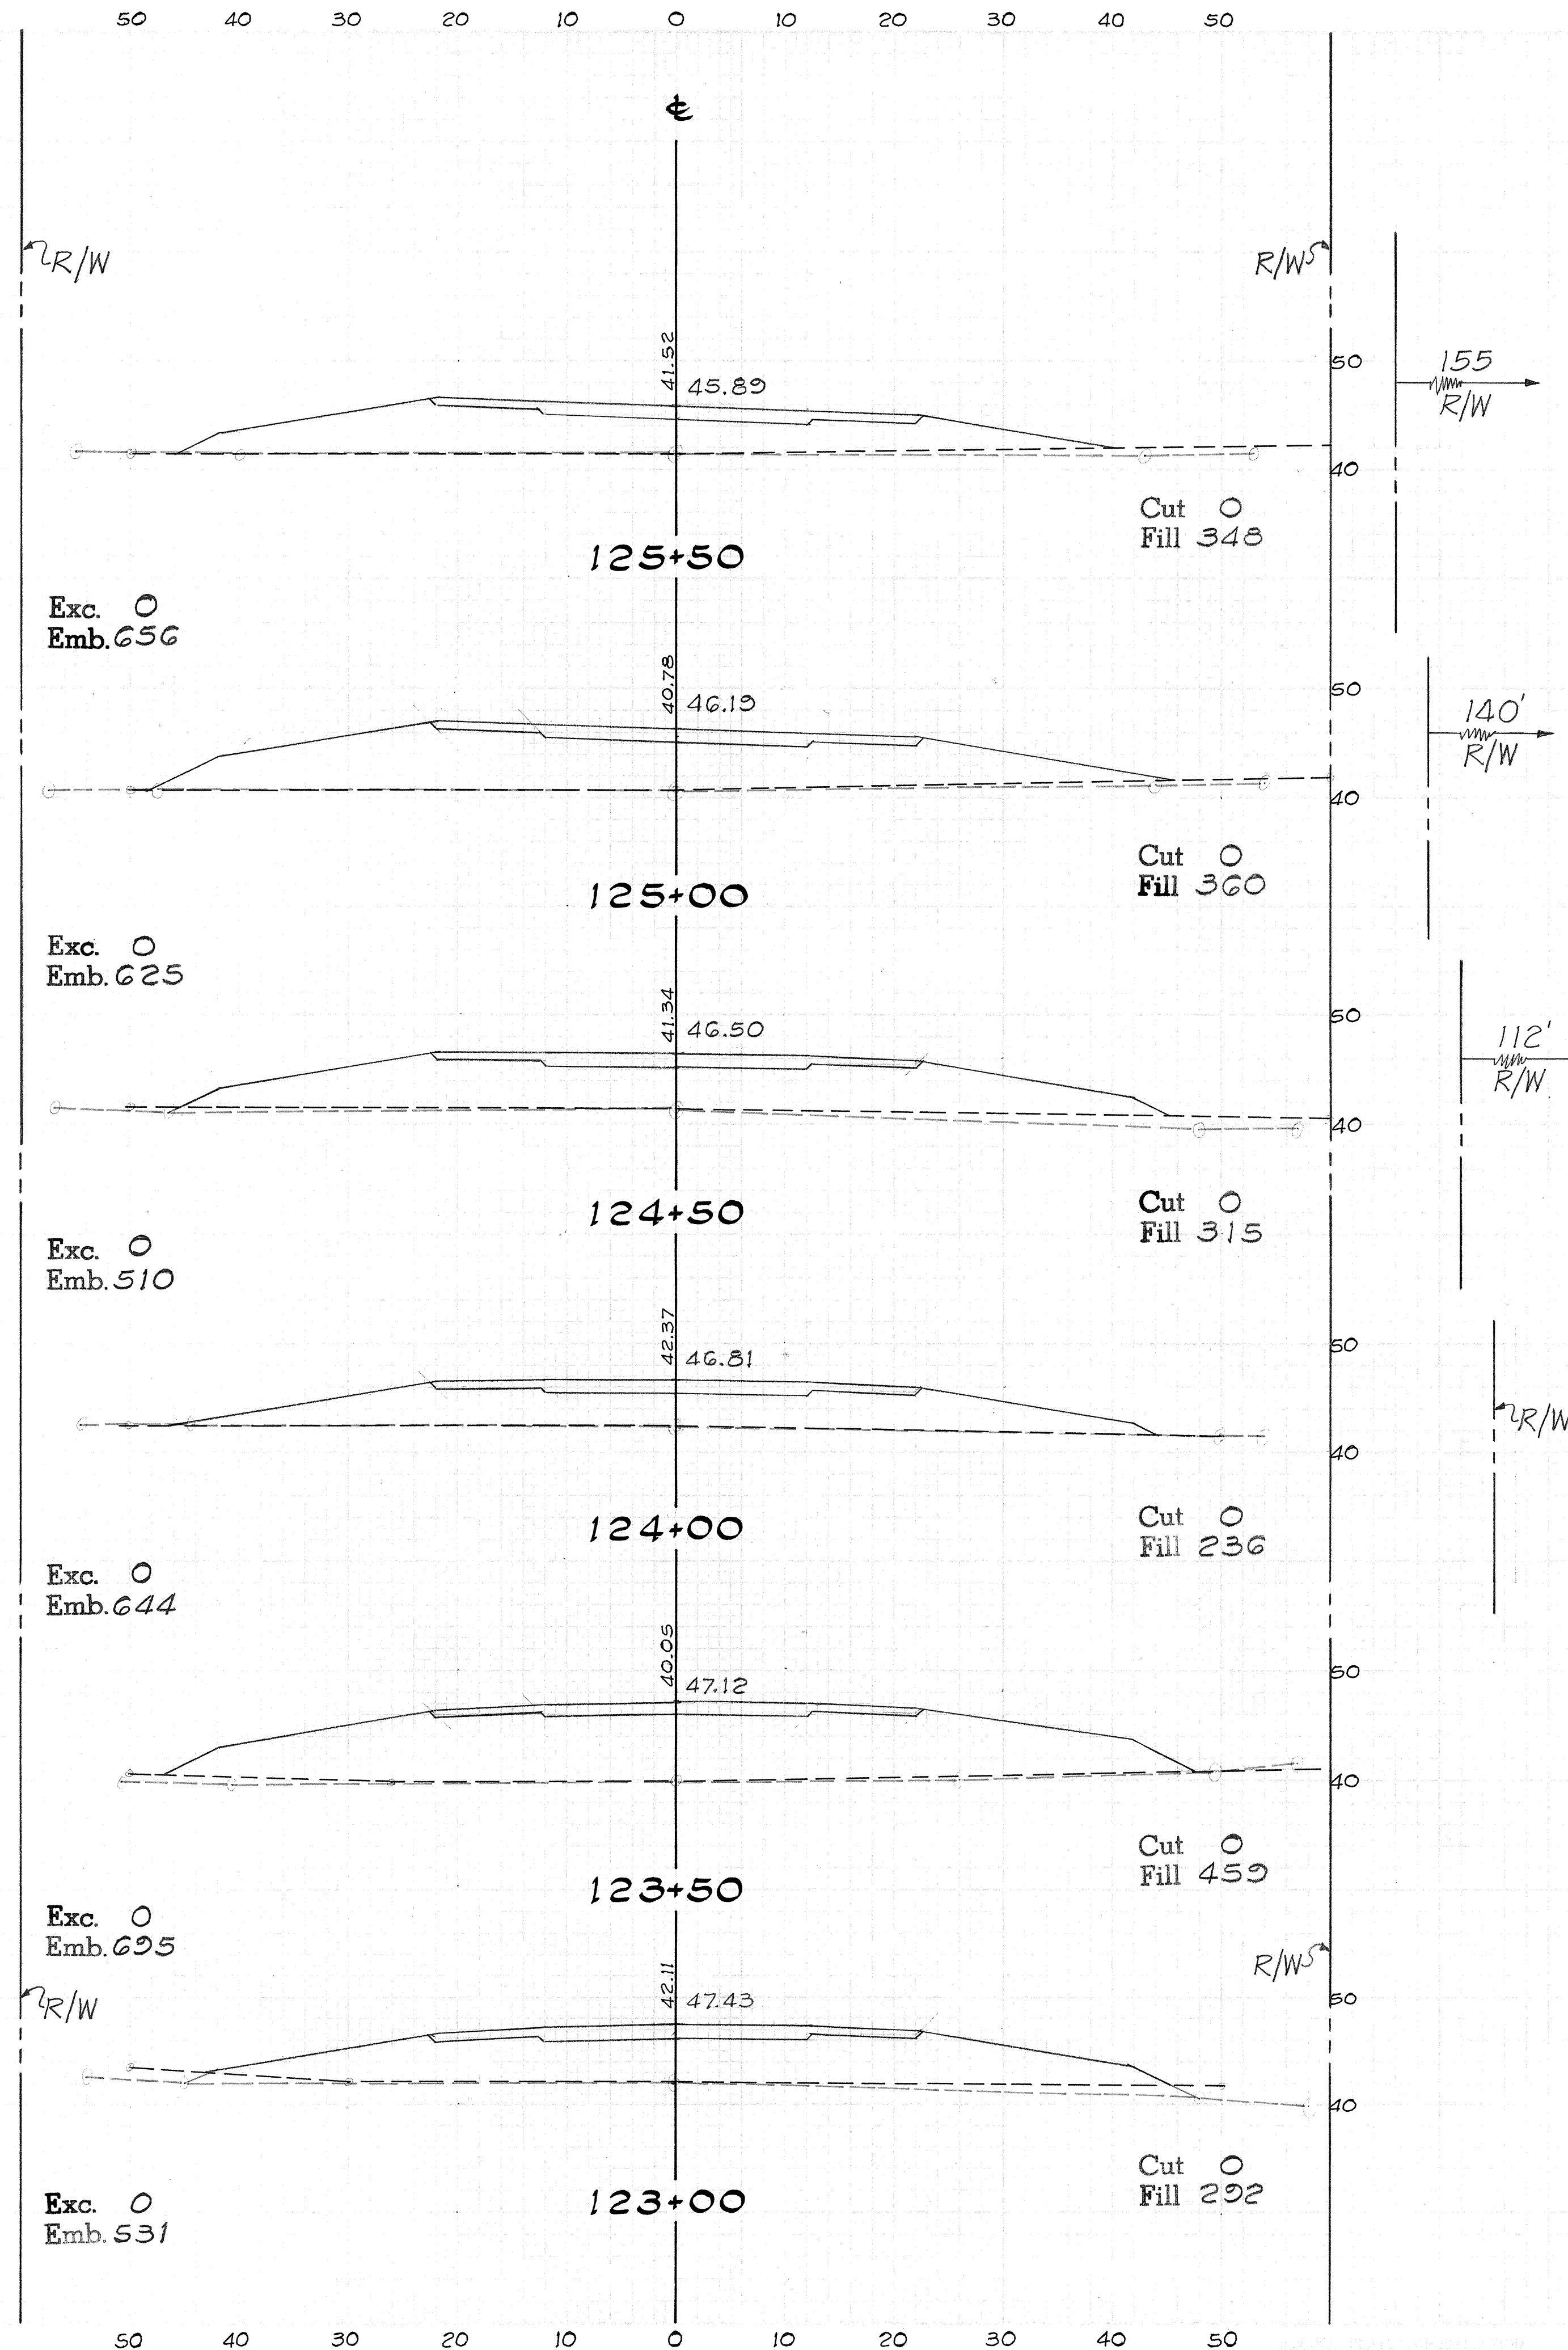

FED. ROAD DIST. NO.	STATE	FED. AID PROJ. NO.	FISCAL YEAR	SHEET NO.	TOTAL SHEETS
HAWAII	HAW.	EP-9(3)	'79	38	89

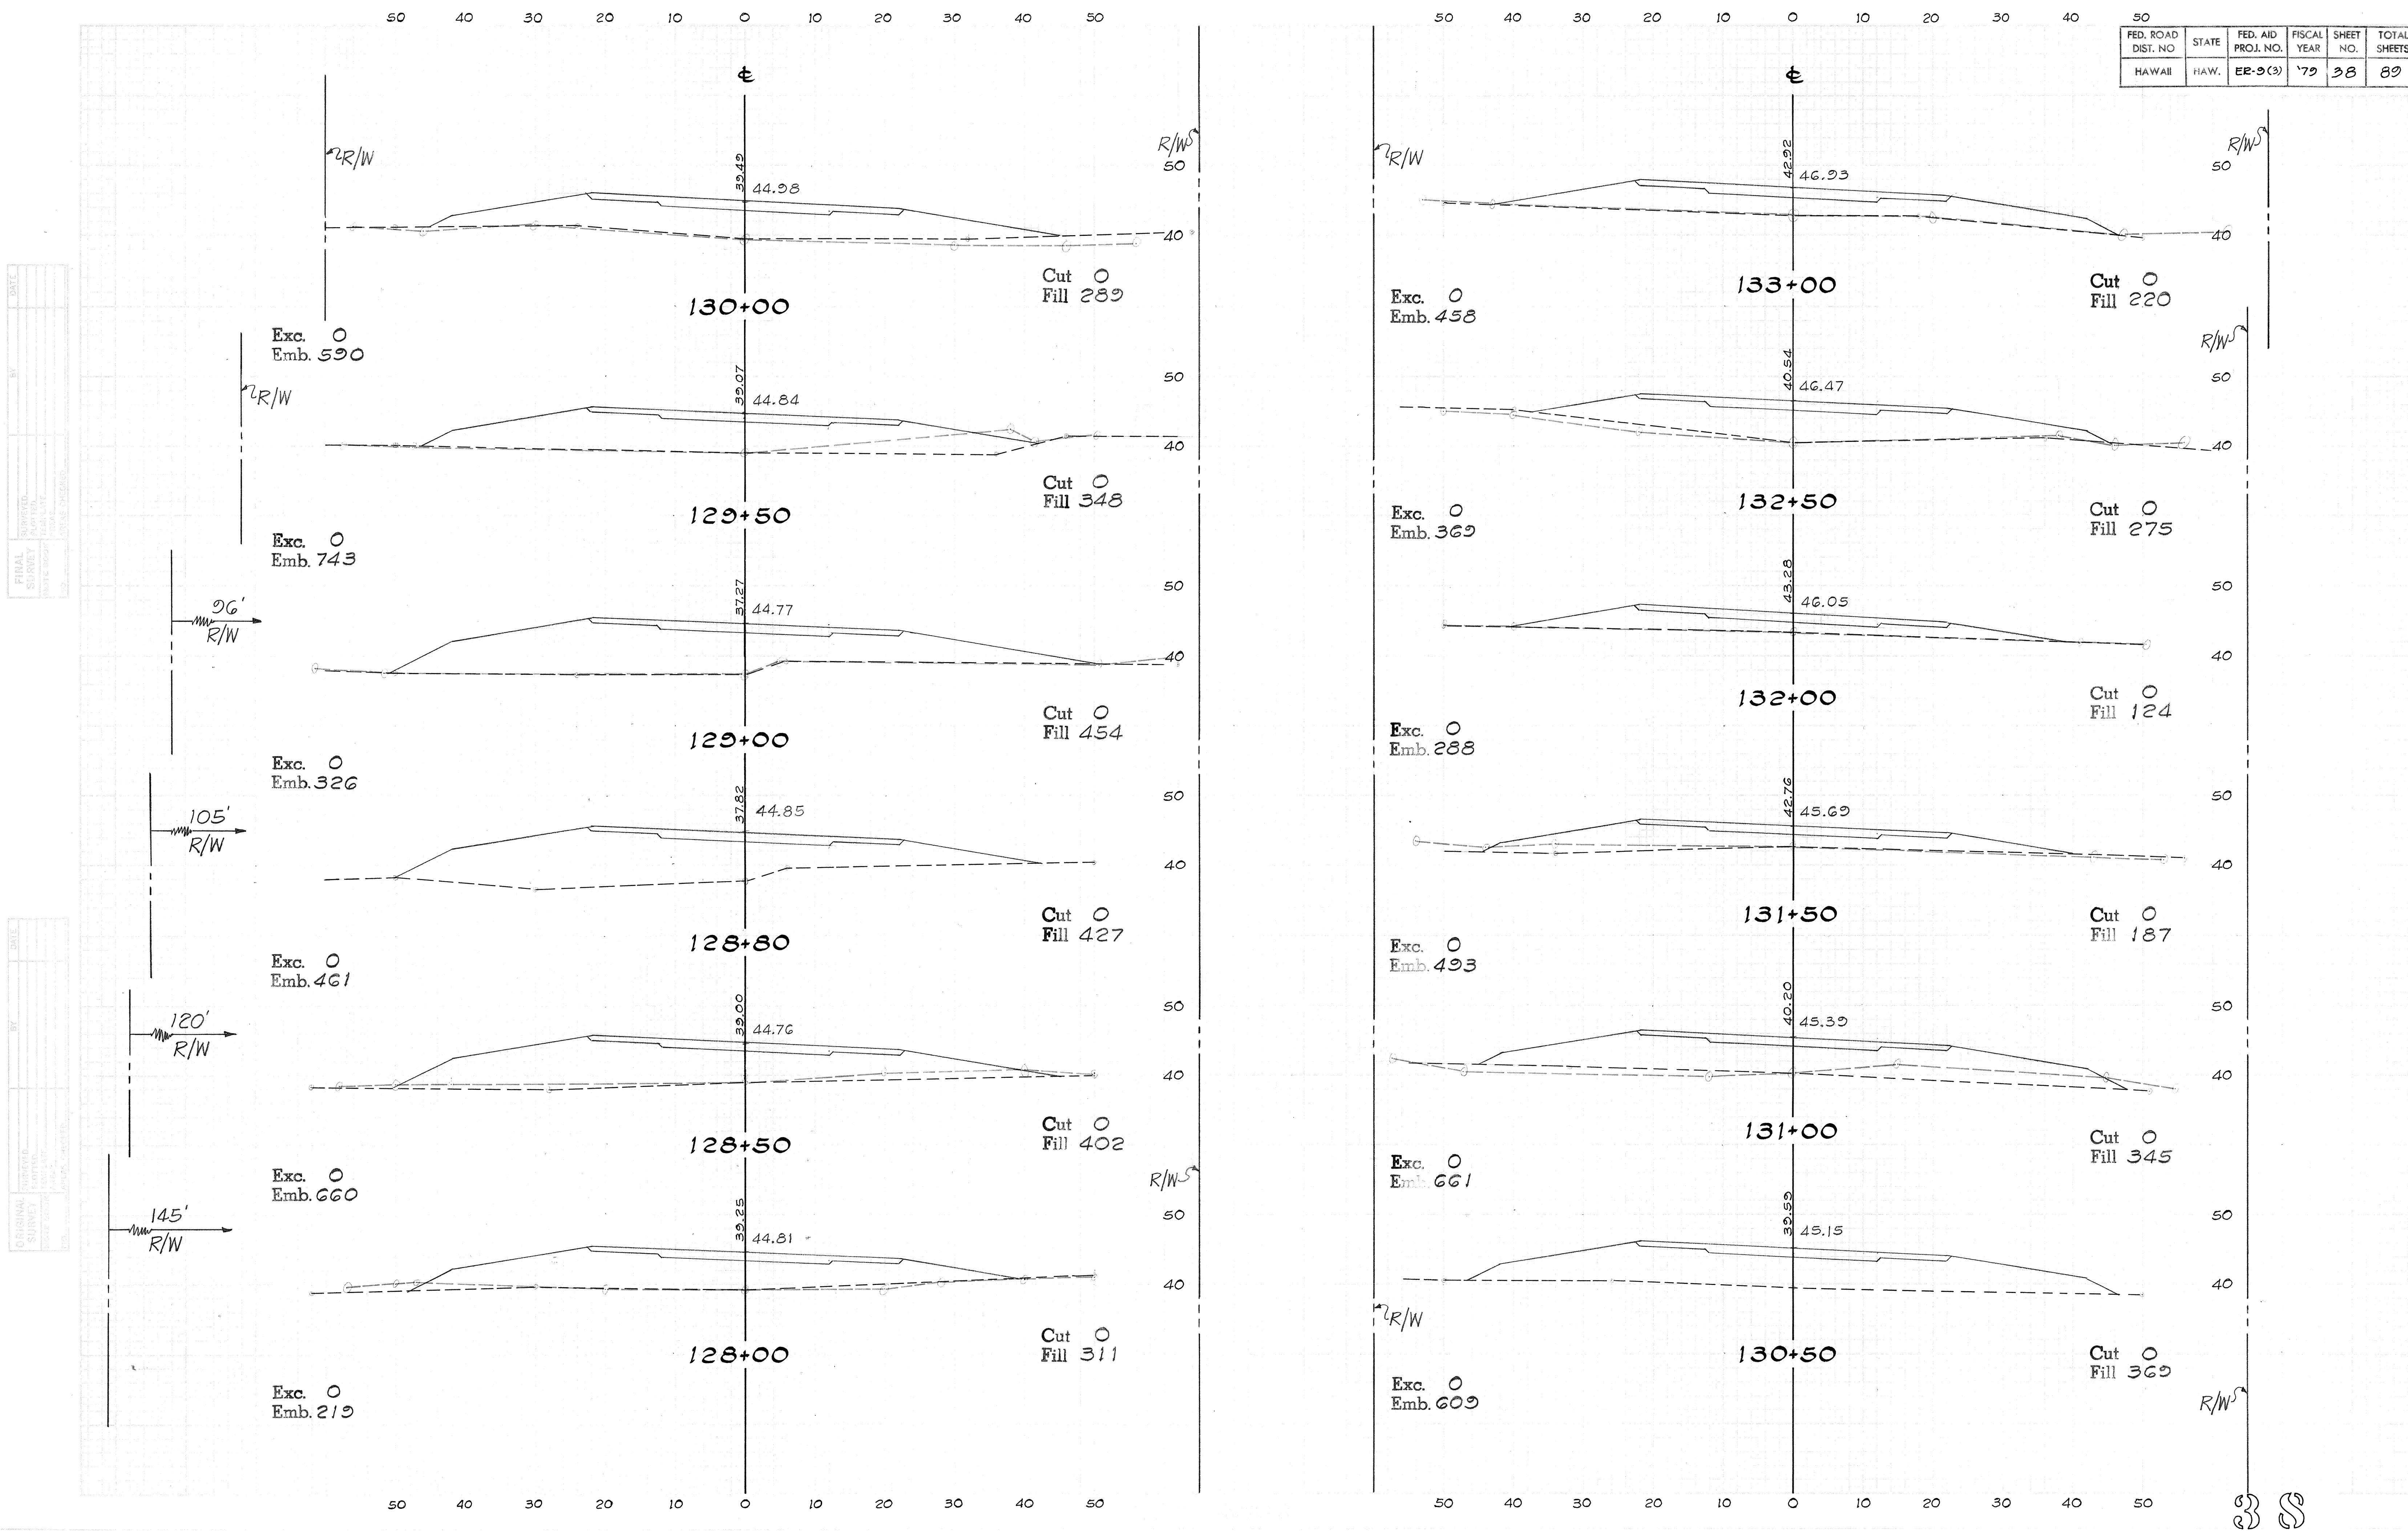

FED. ROAD CUT. NO.	STATE	FED. AID PROJ. NO.	FISCAL YEAR	SHEET NO.	TOTAL SHEETS
HAWAII	HAWAII	ER-9(3)	'79	30	80

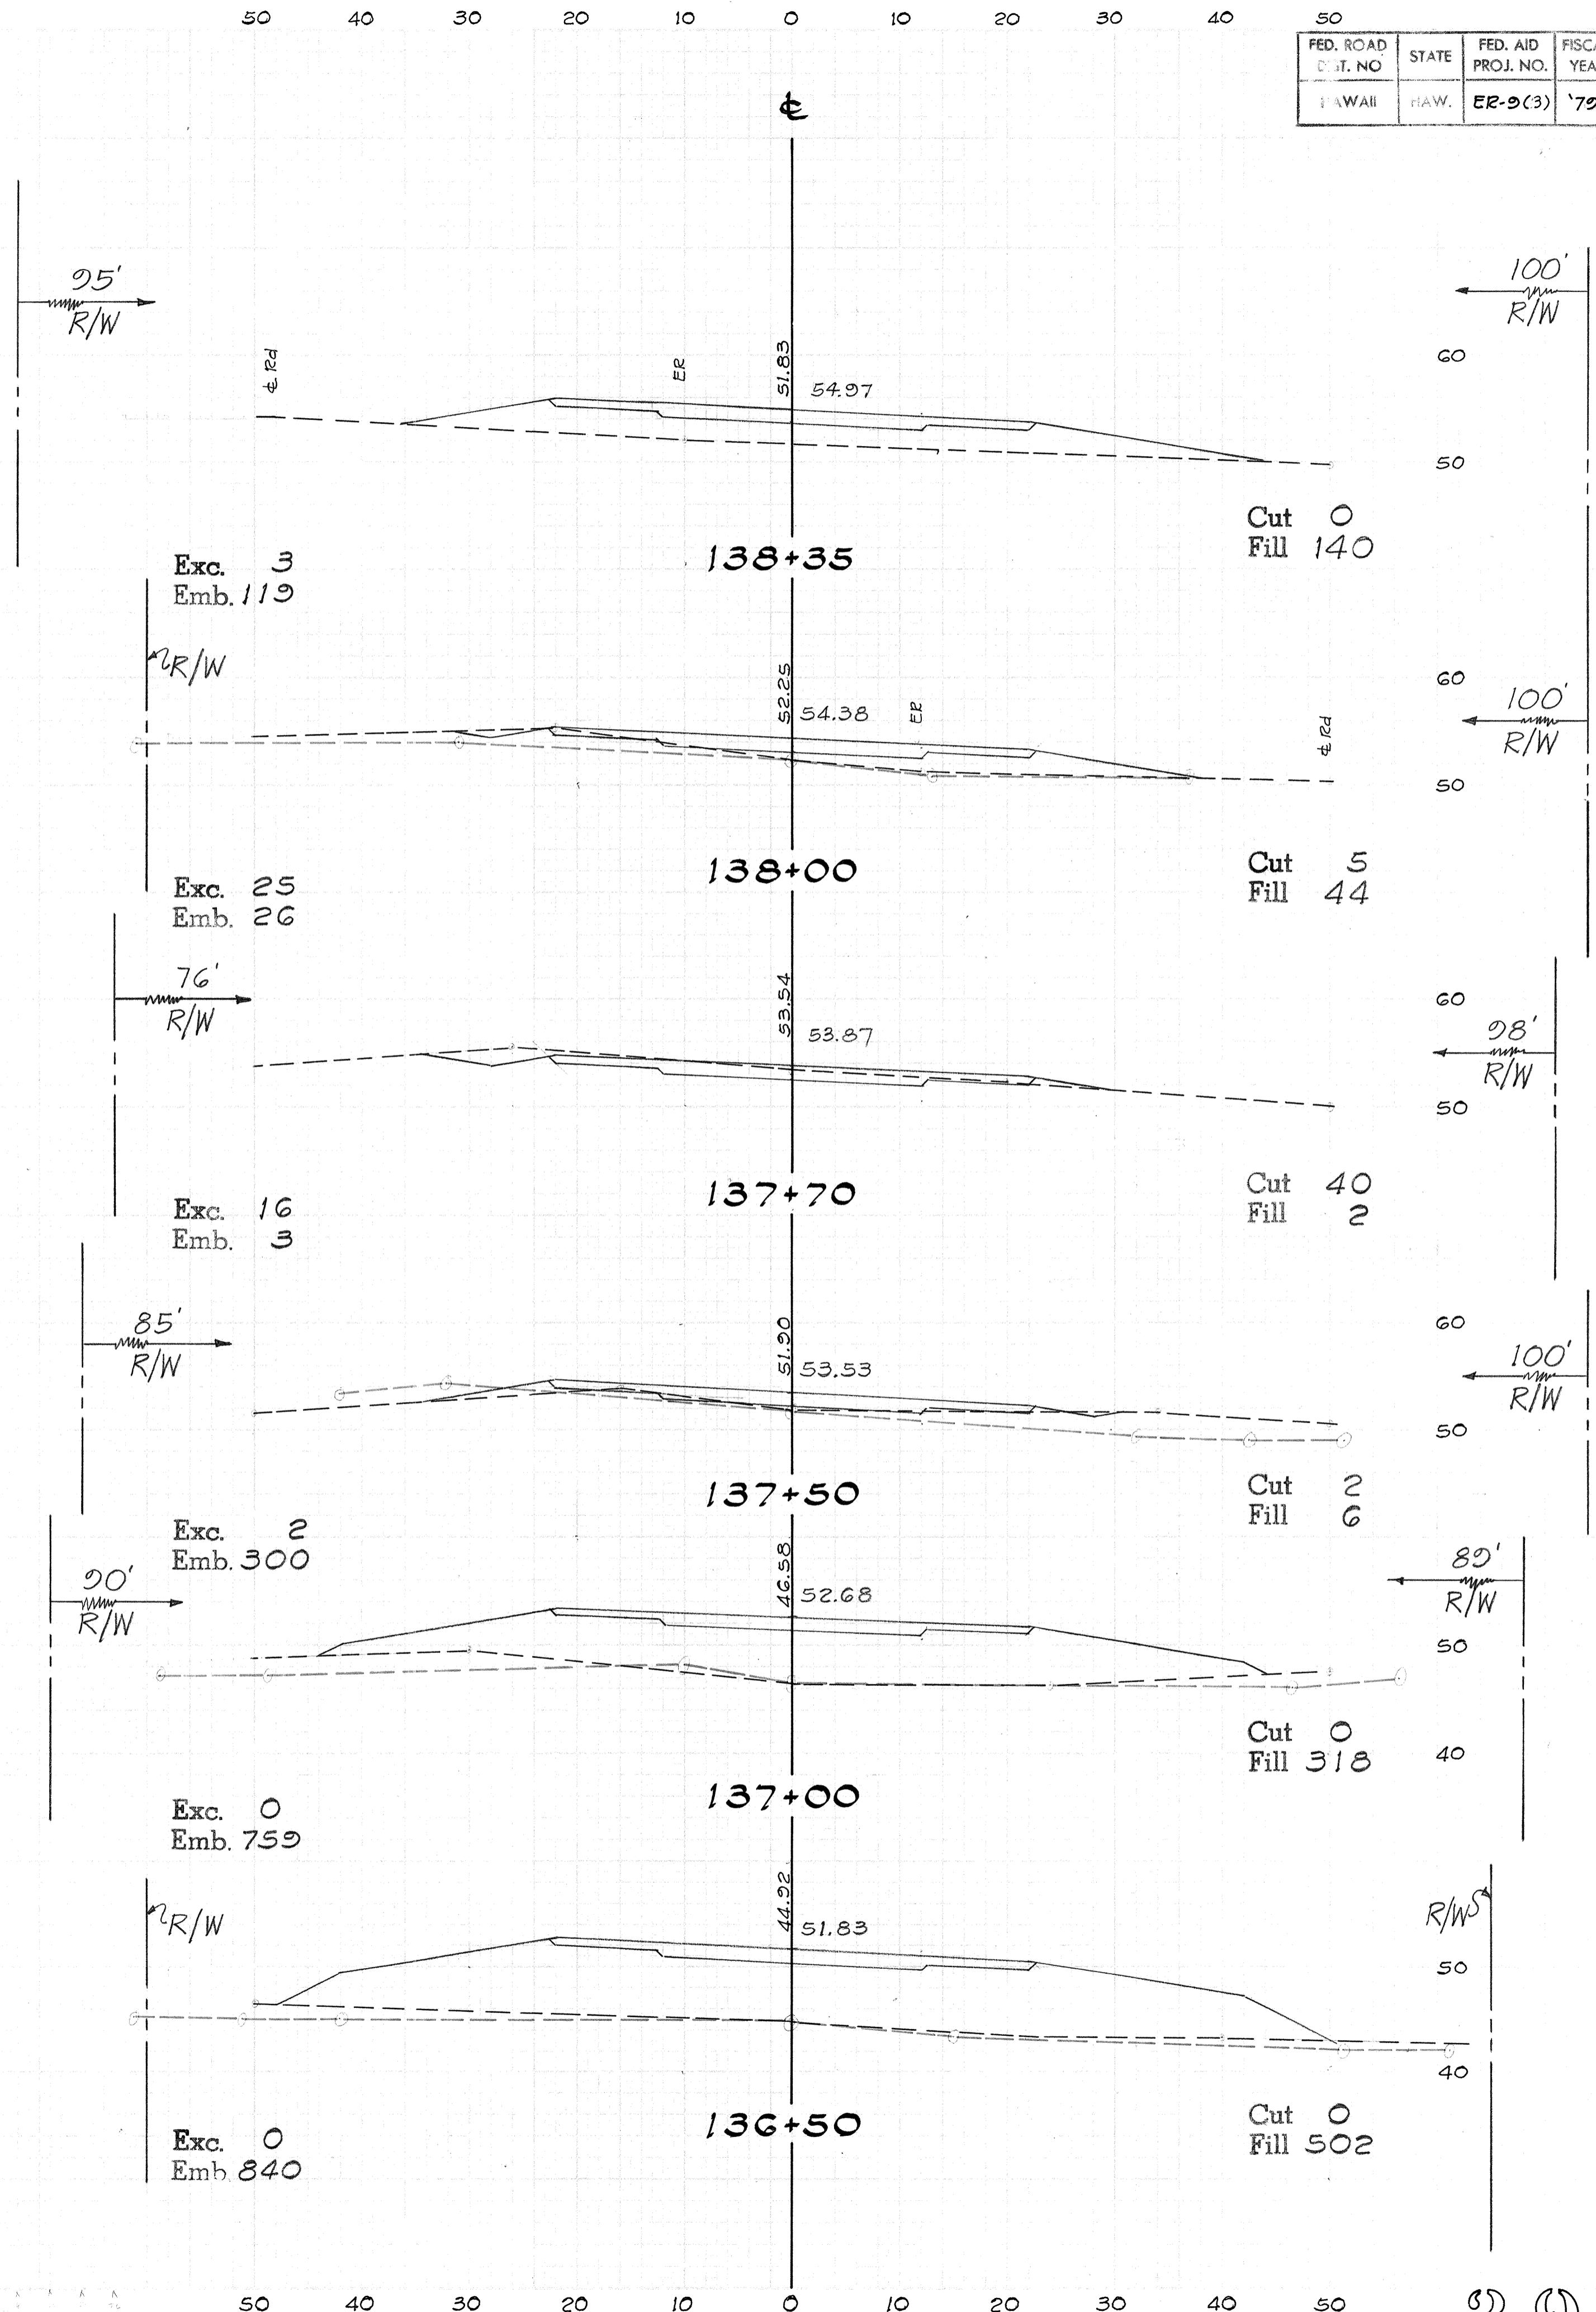
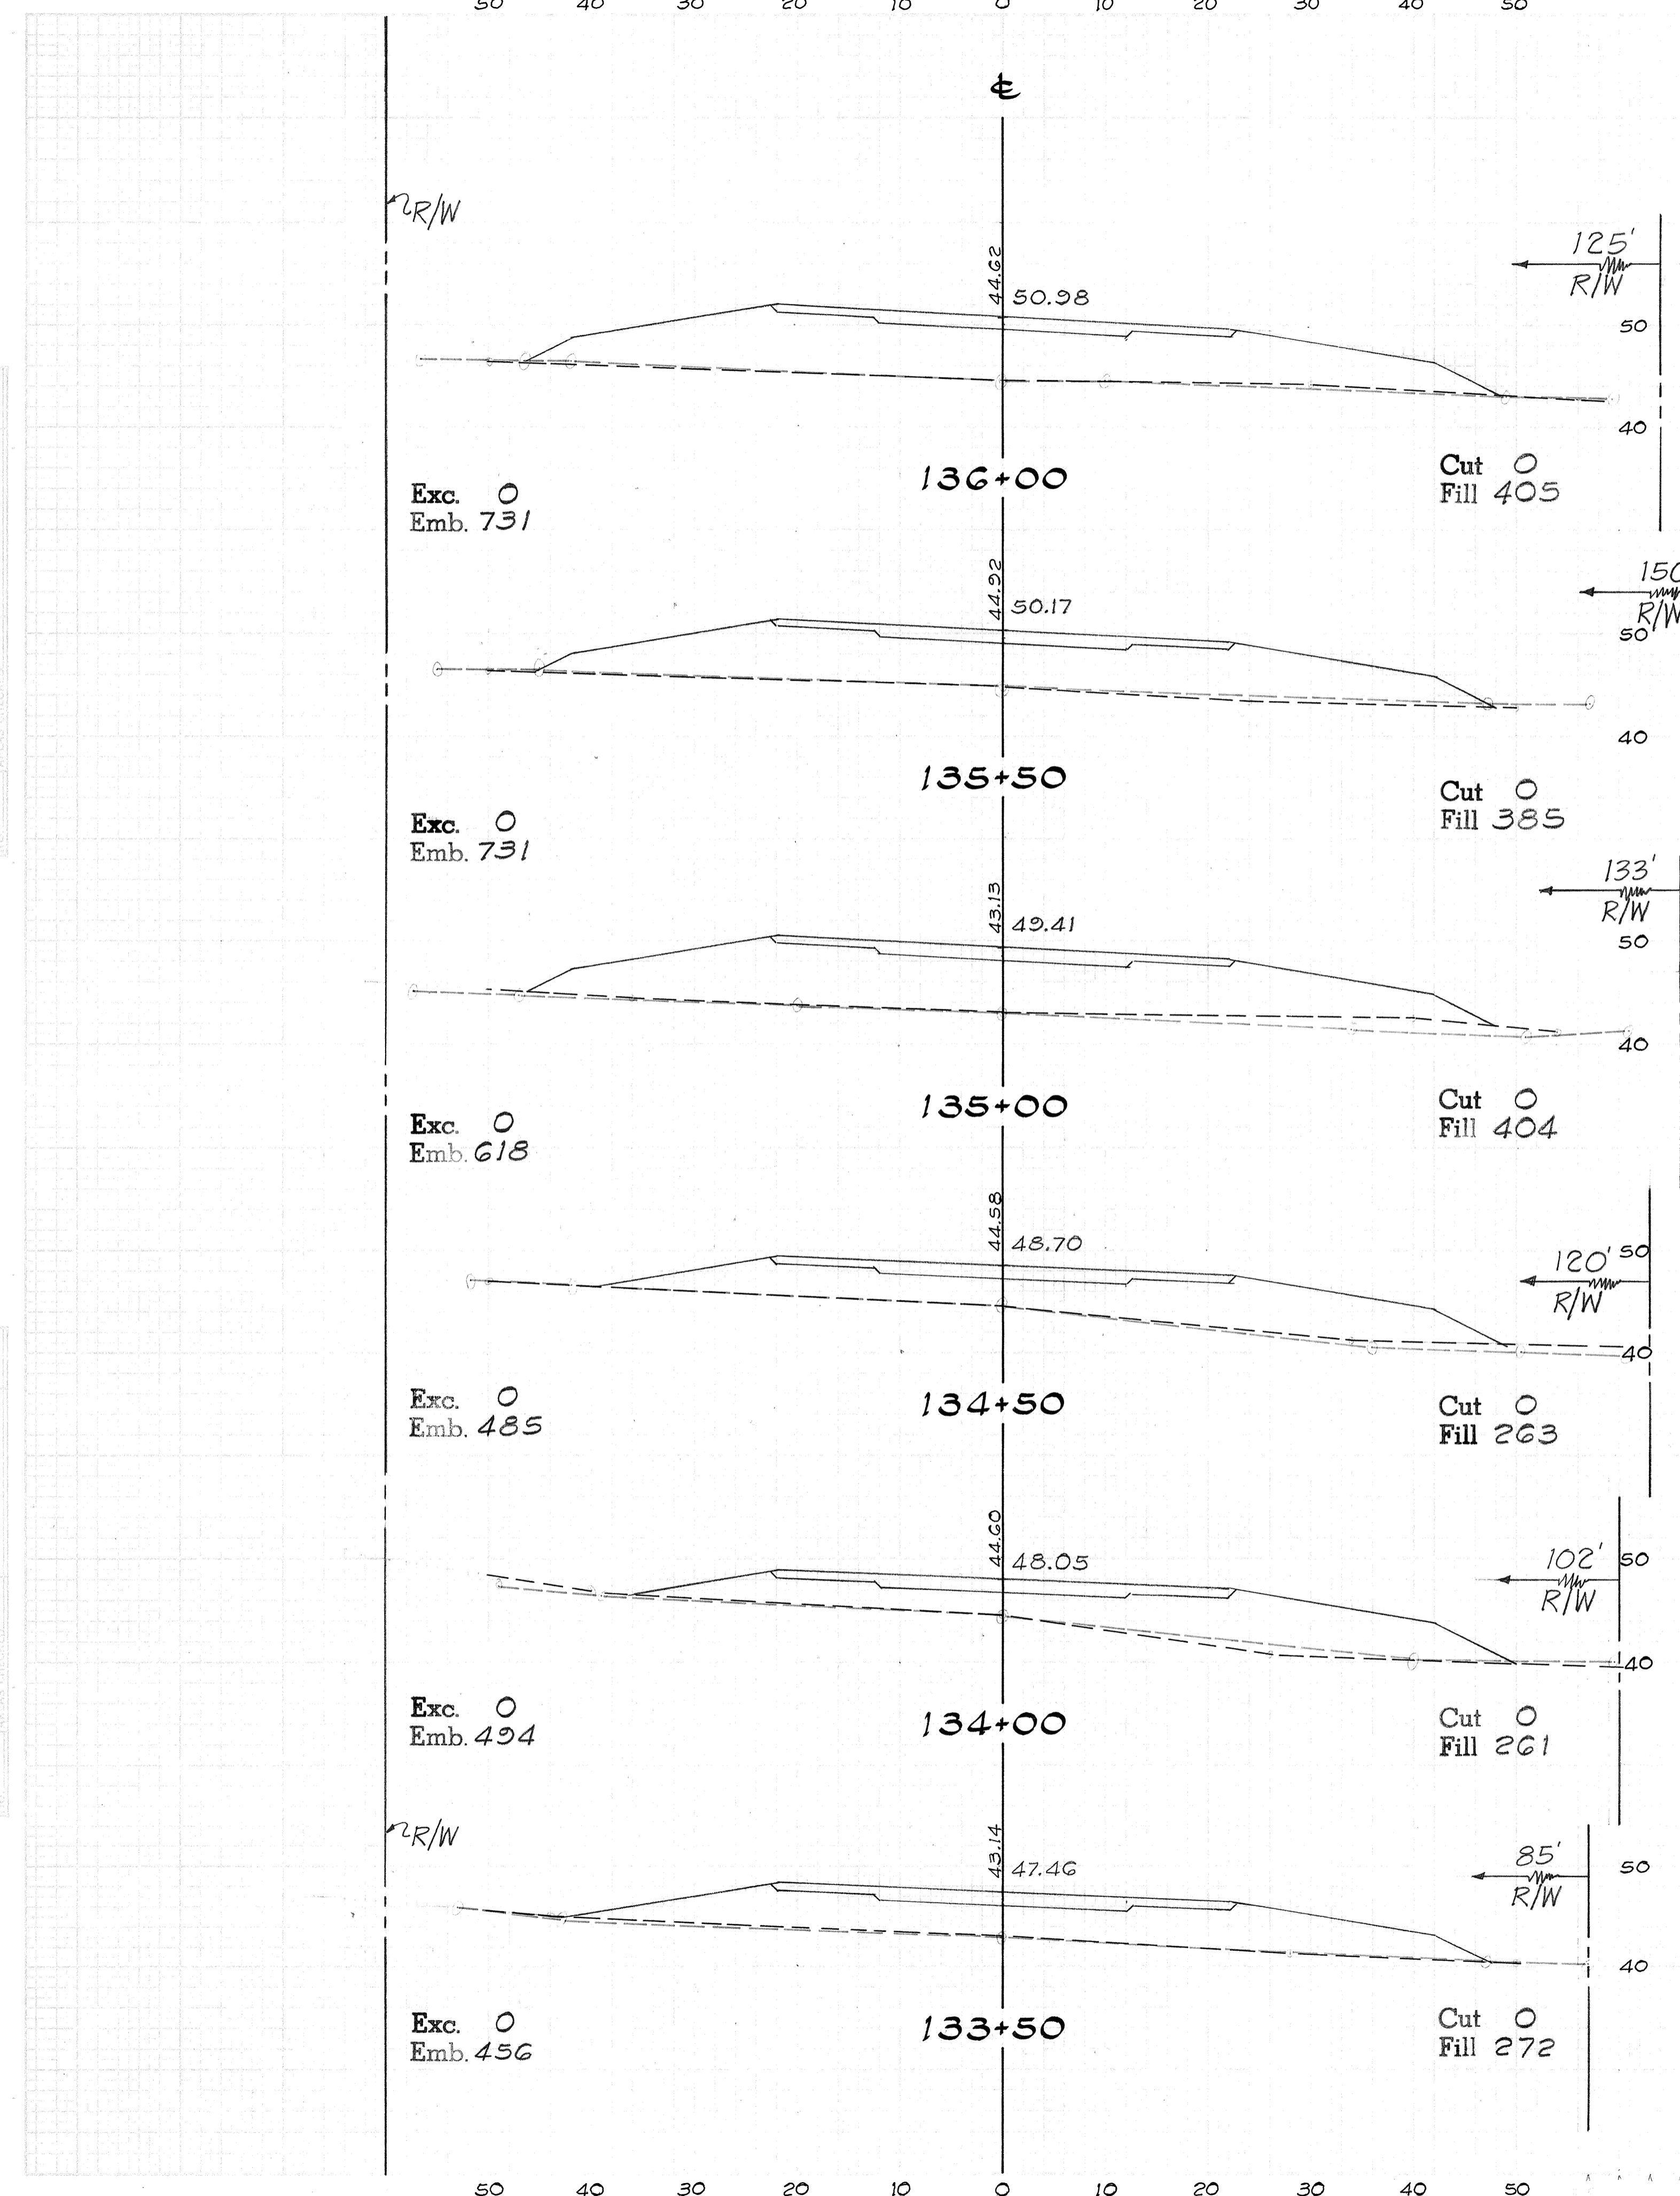


(3) (4)



FED. ROAD DIST. NO.	STATE	FED. AID PROJ. NO.	FISCAL YEAR	HEET NO.	TOTAL SHEETS
HAWAII	HAW.	ER-9(3)	'79	40	89

FINAL SURVEYED PLOTTED DRAWINGS  
BY DATE SURVEYED PLOTTED DRAWINGS  
NOTES: DRAWINGS ARE UNCHECKED



ORIGINAL SURVEYED PLOTTED DRAWINGS  
NOTES: DRAWINGS ARE UNCHECKED

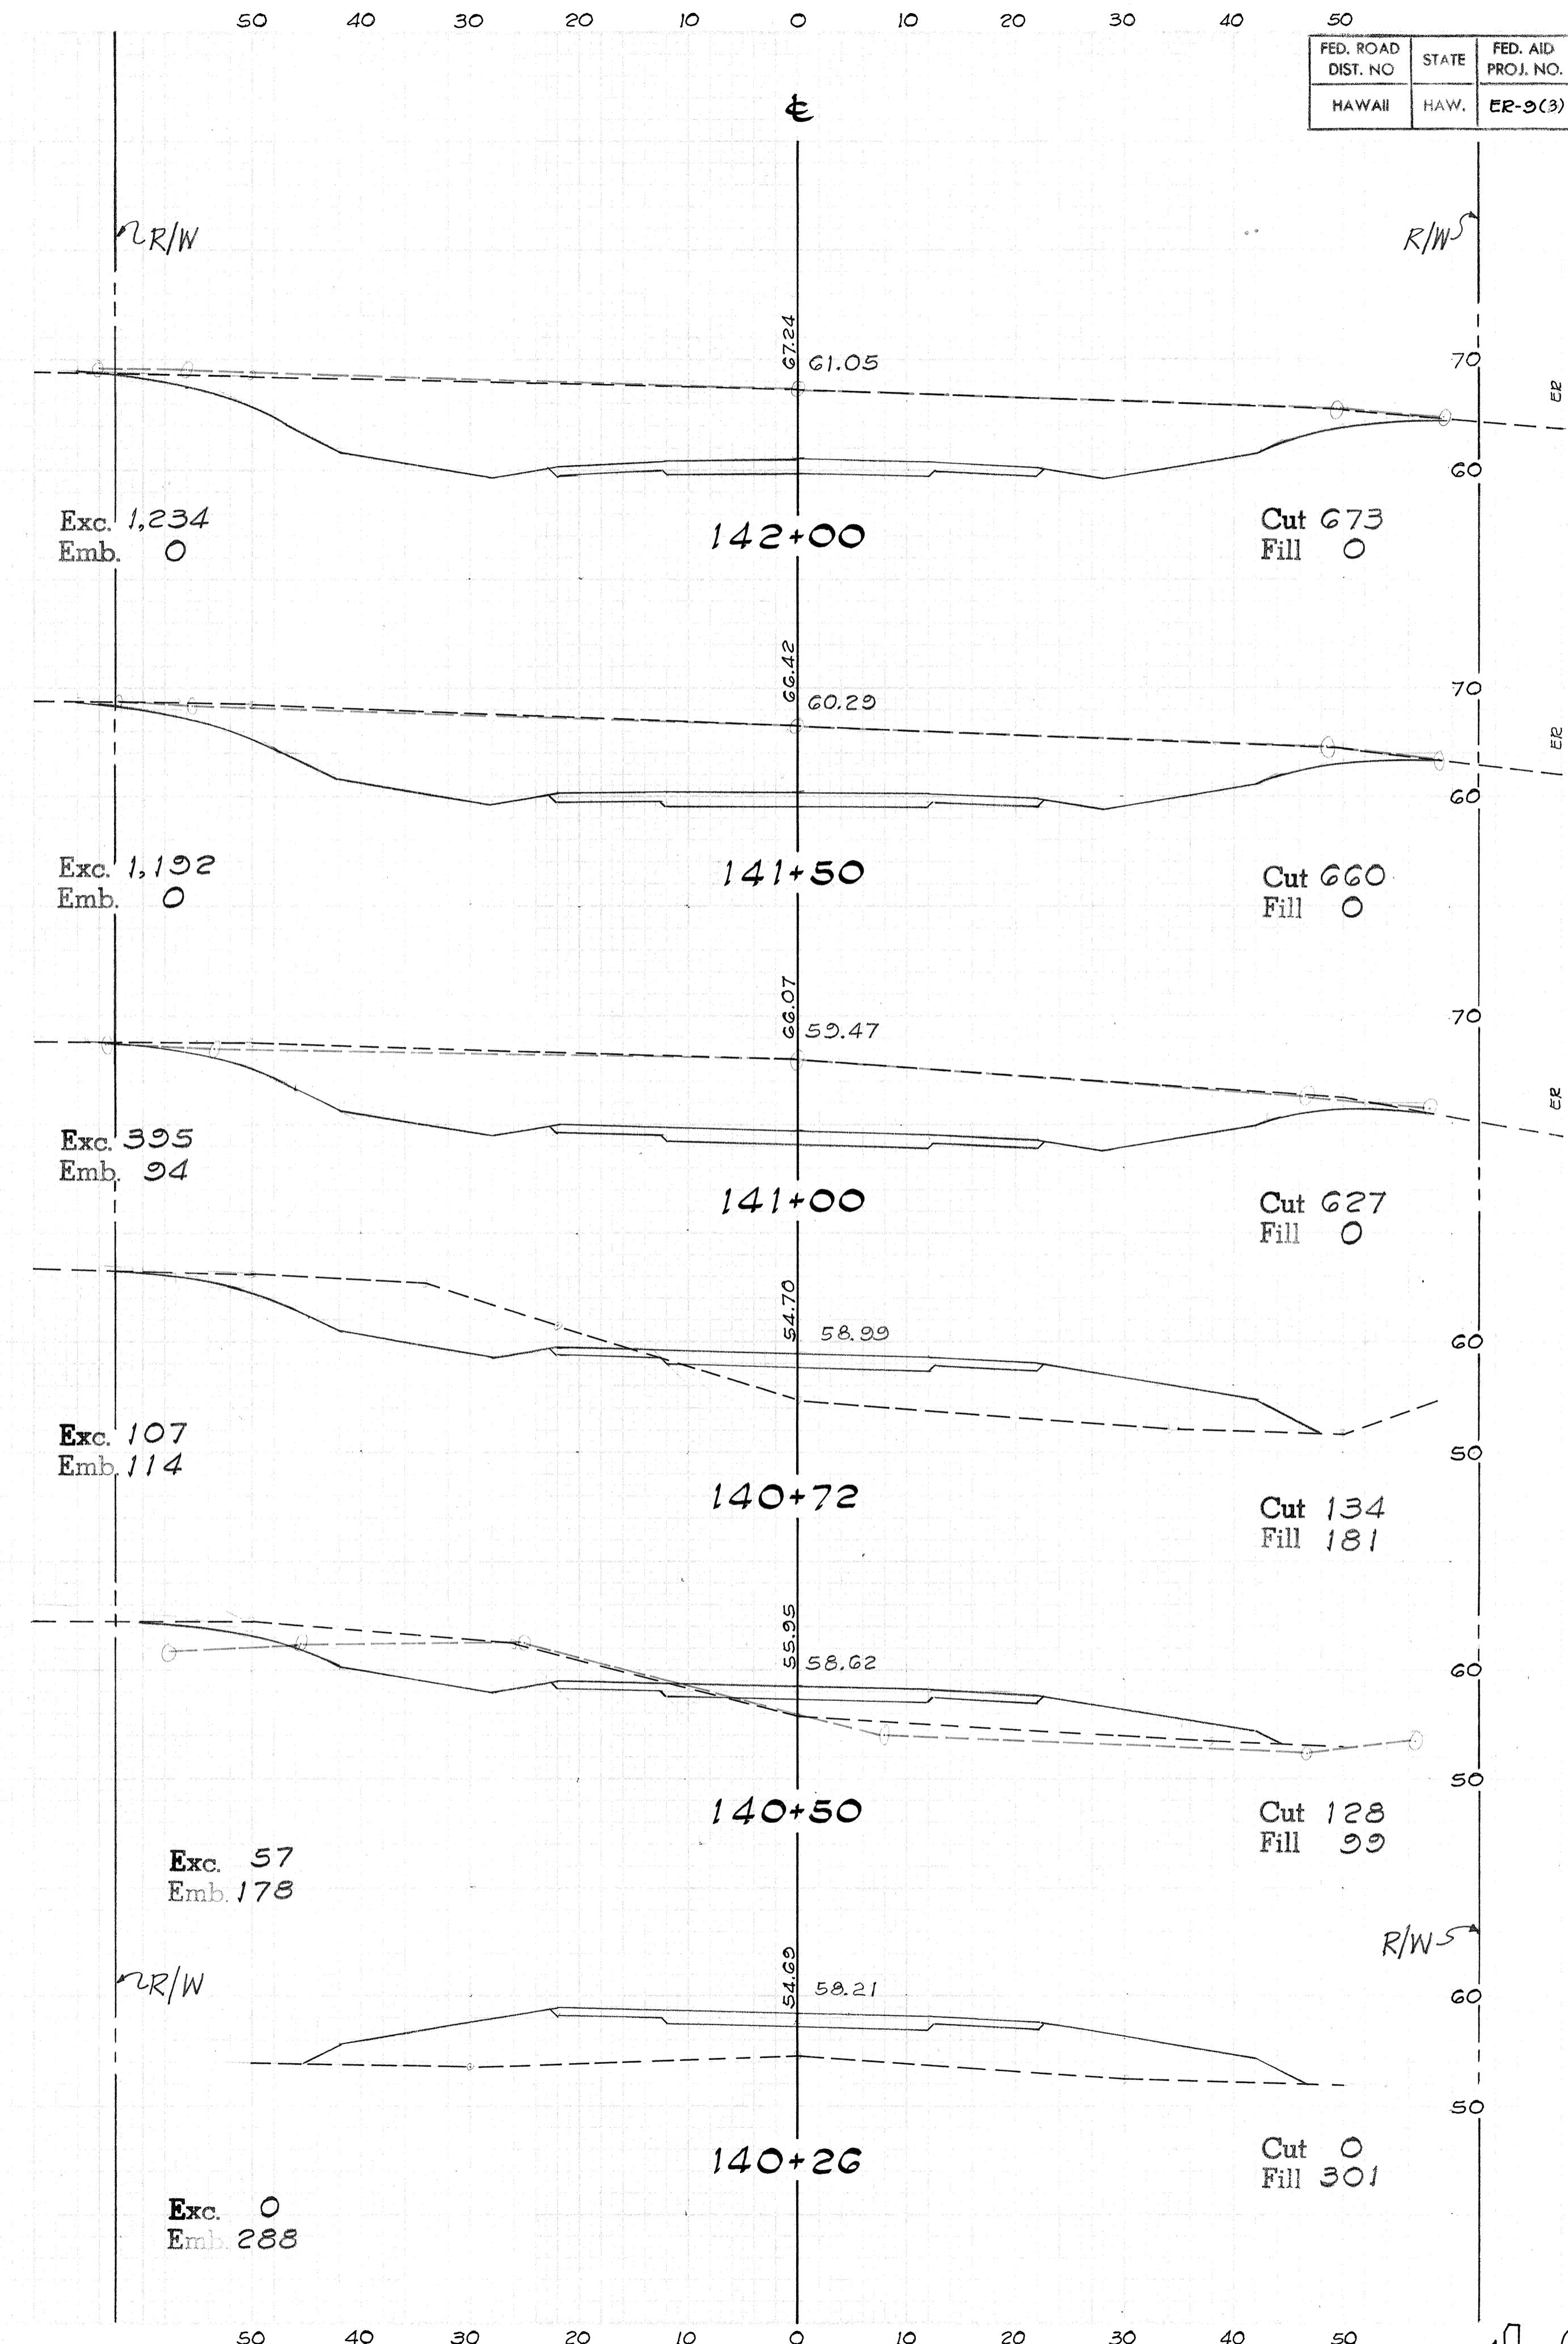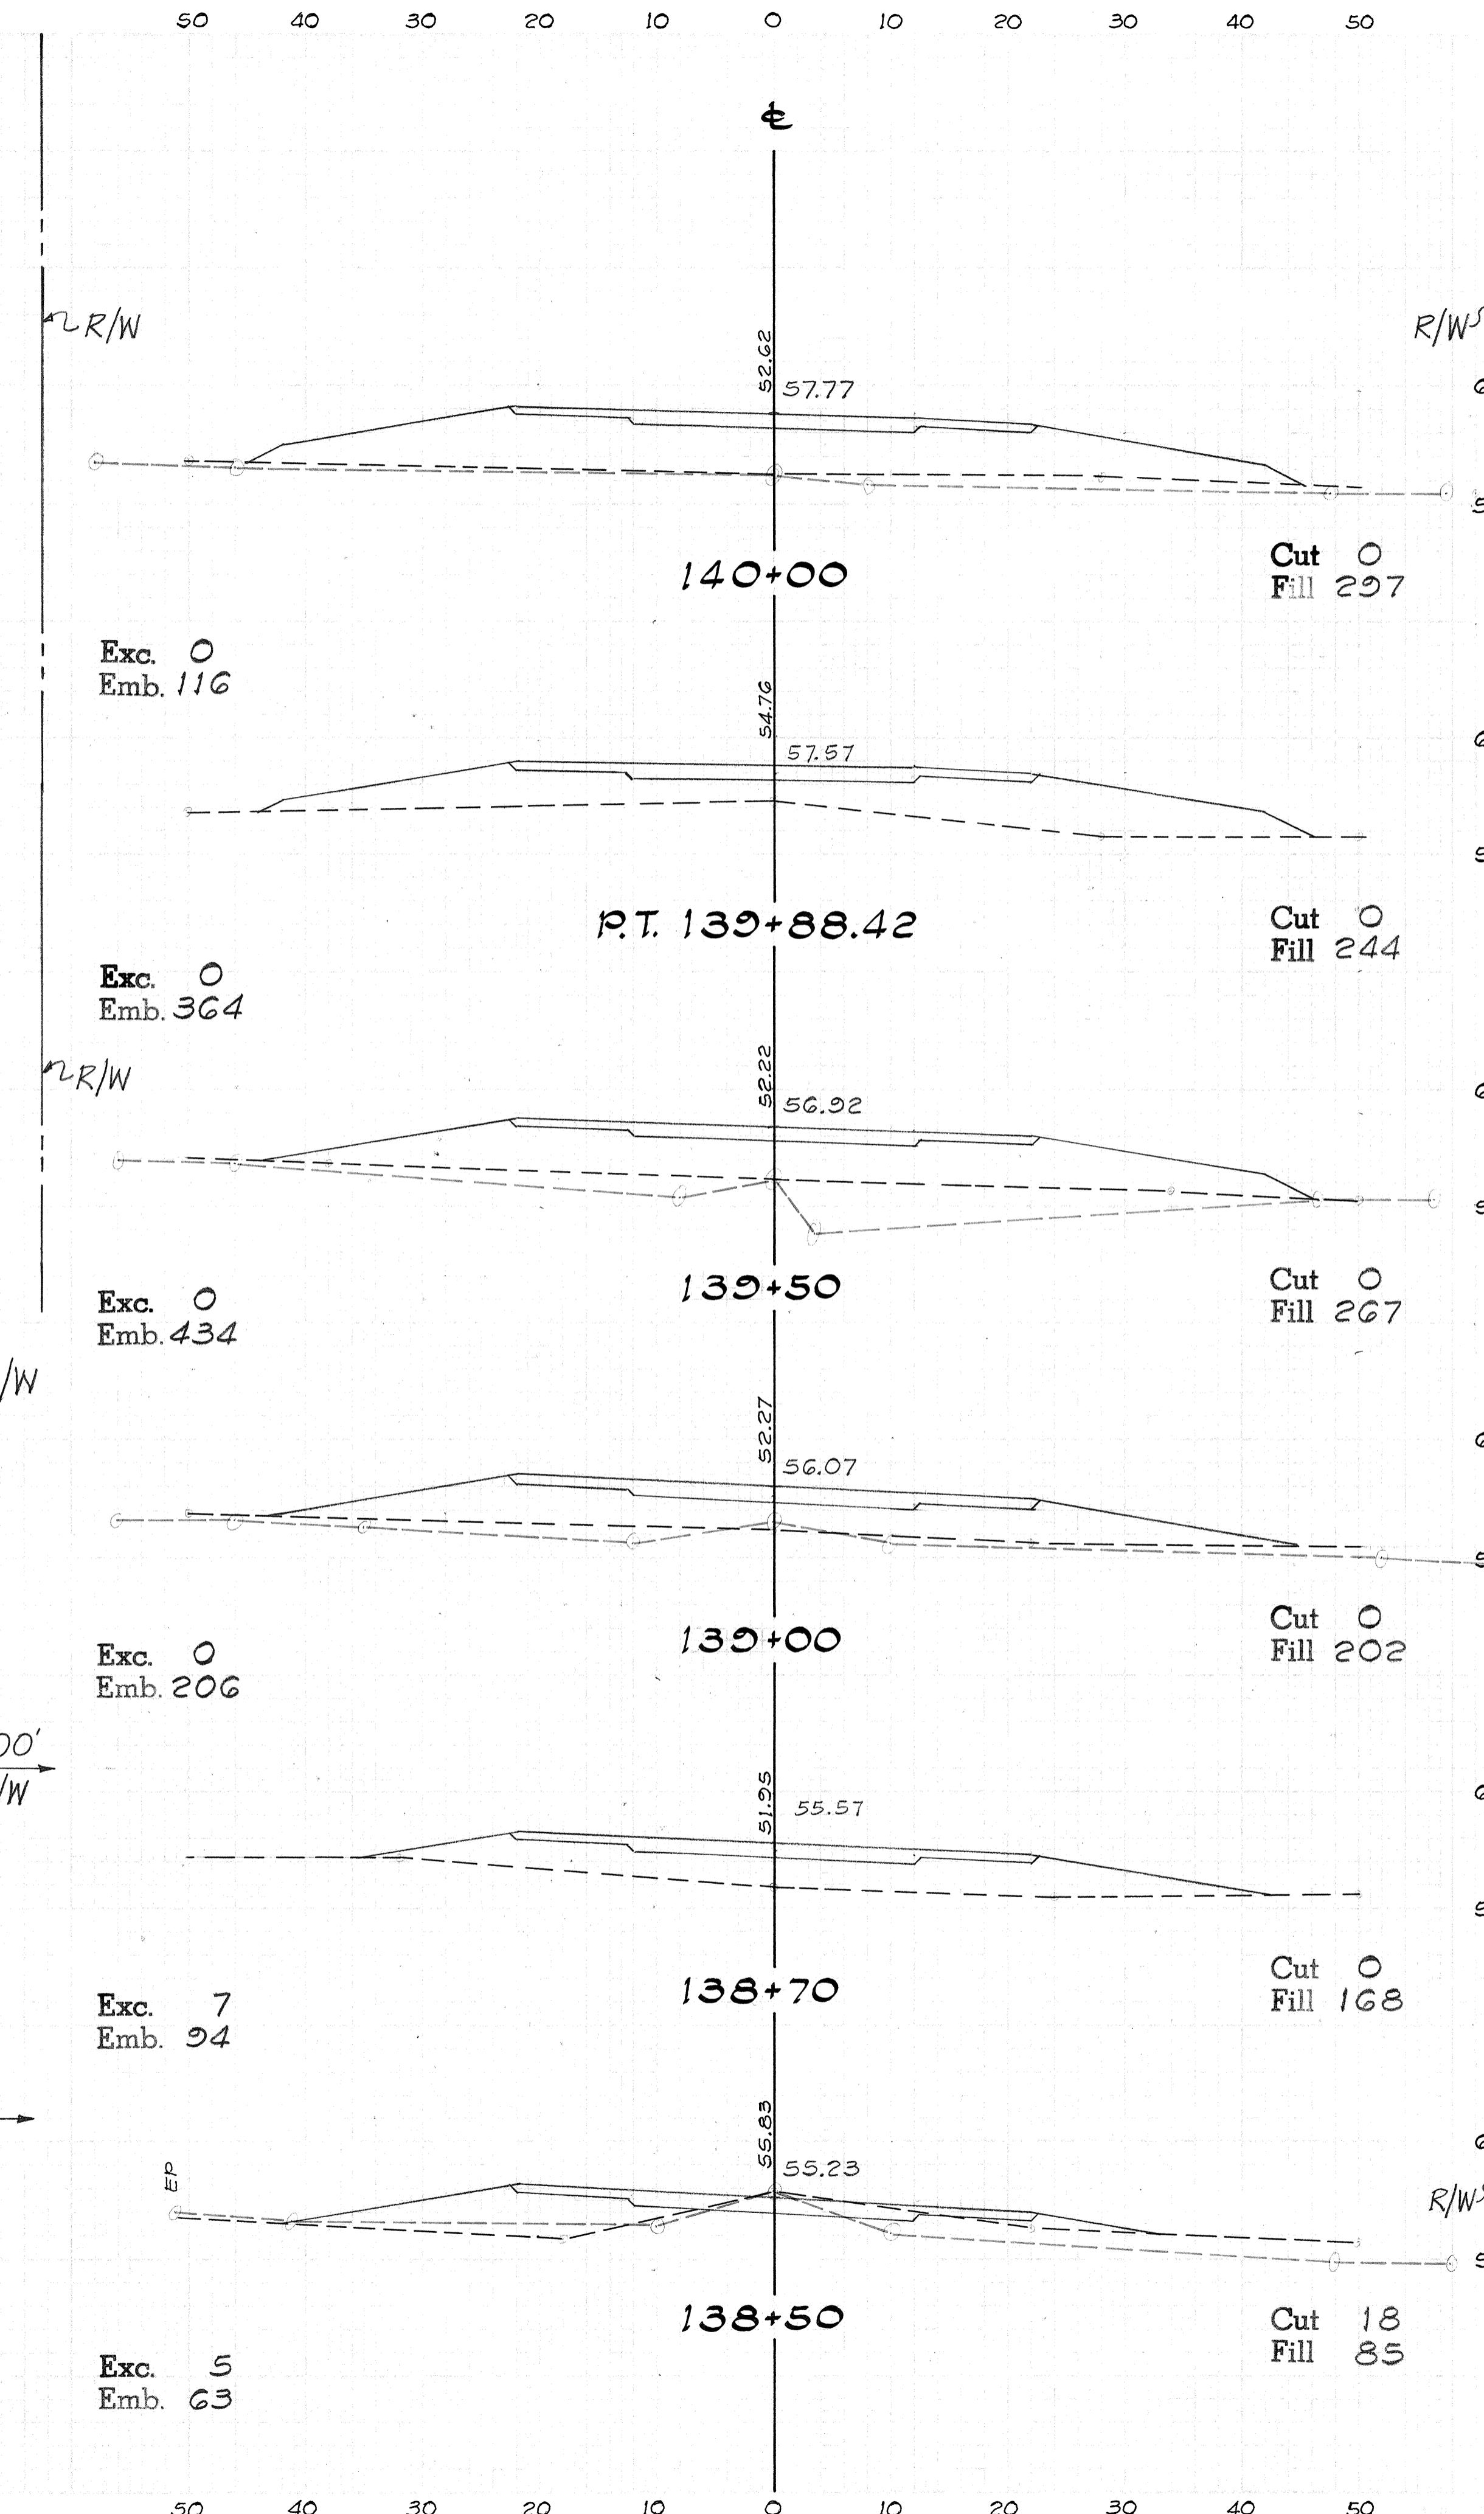



FED. ROAD DIST. NO.	STATE	FED. AID PROJ. NO.	FISCAL YEAR	SHEET NO.	TOTAL SHEETS
HAWAII	HAW.	ER-9(3)	'79	41	80

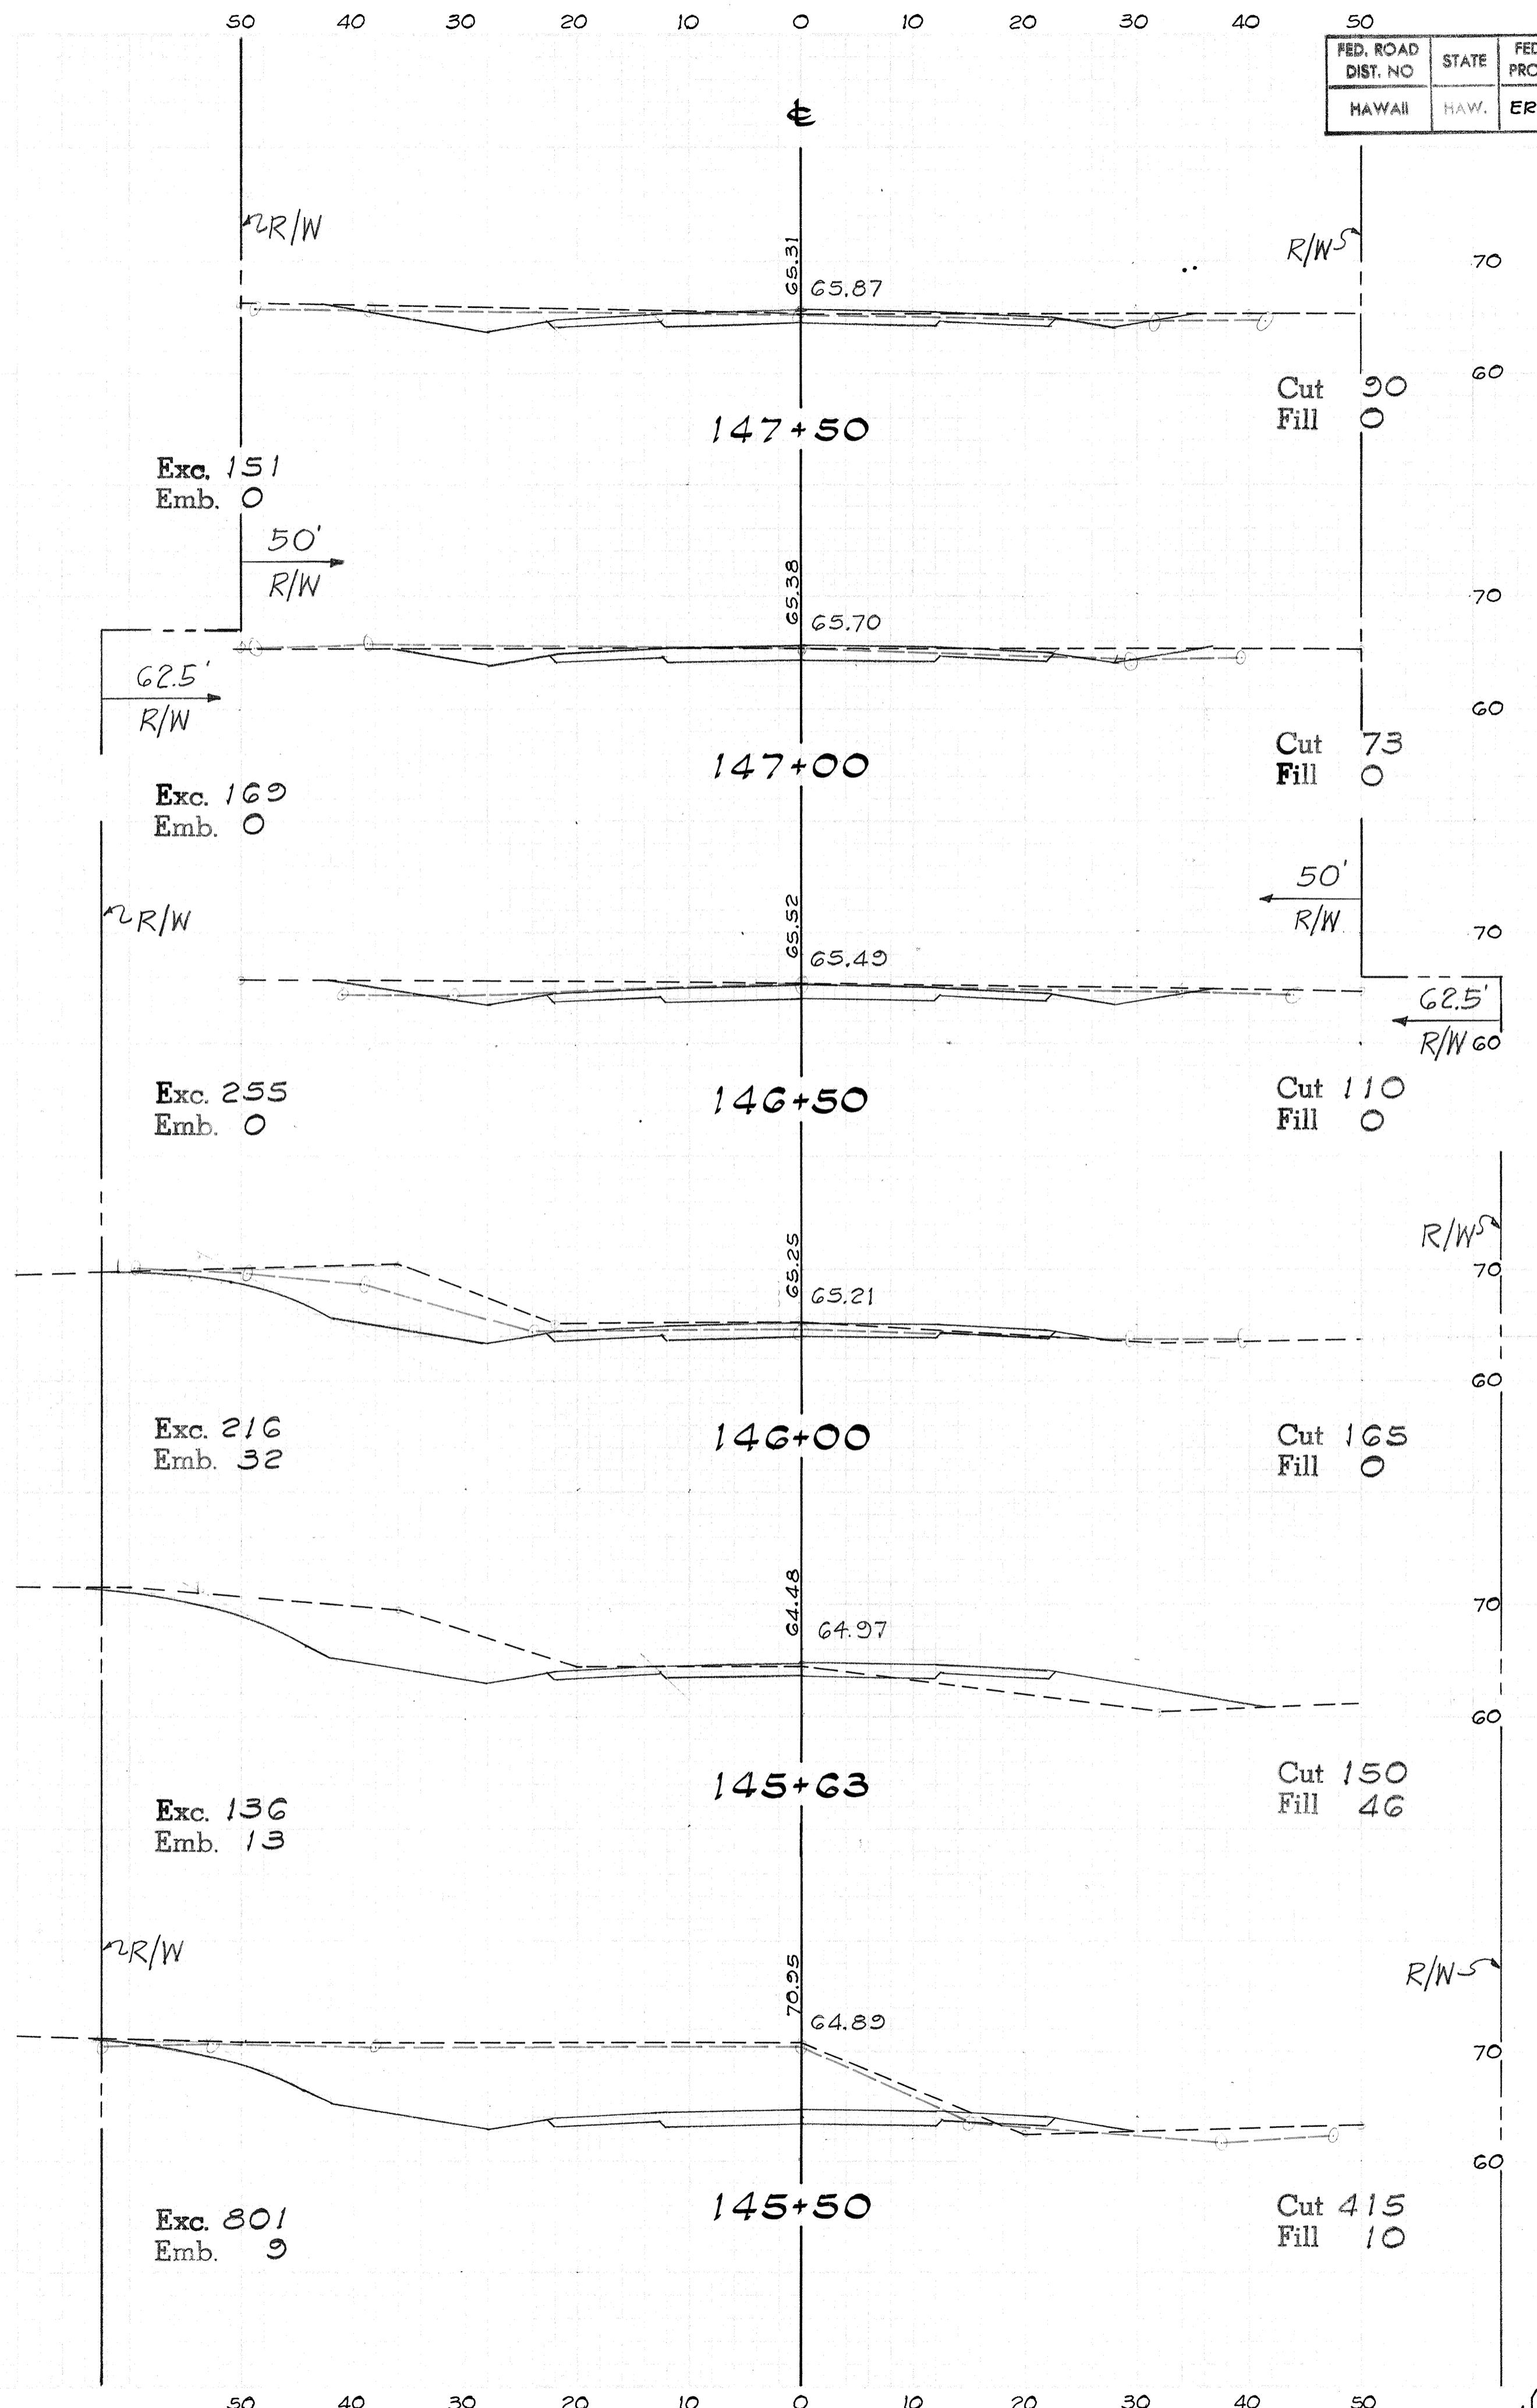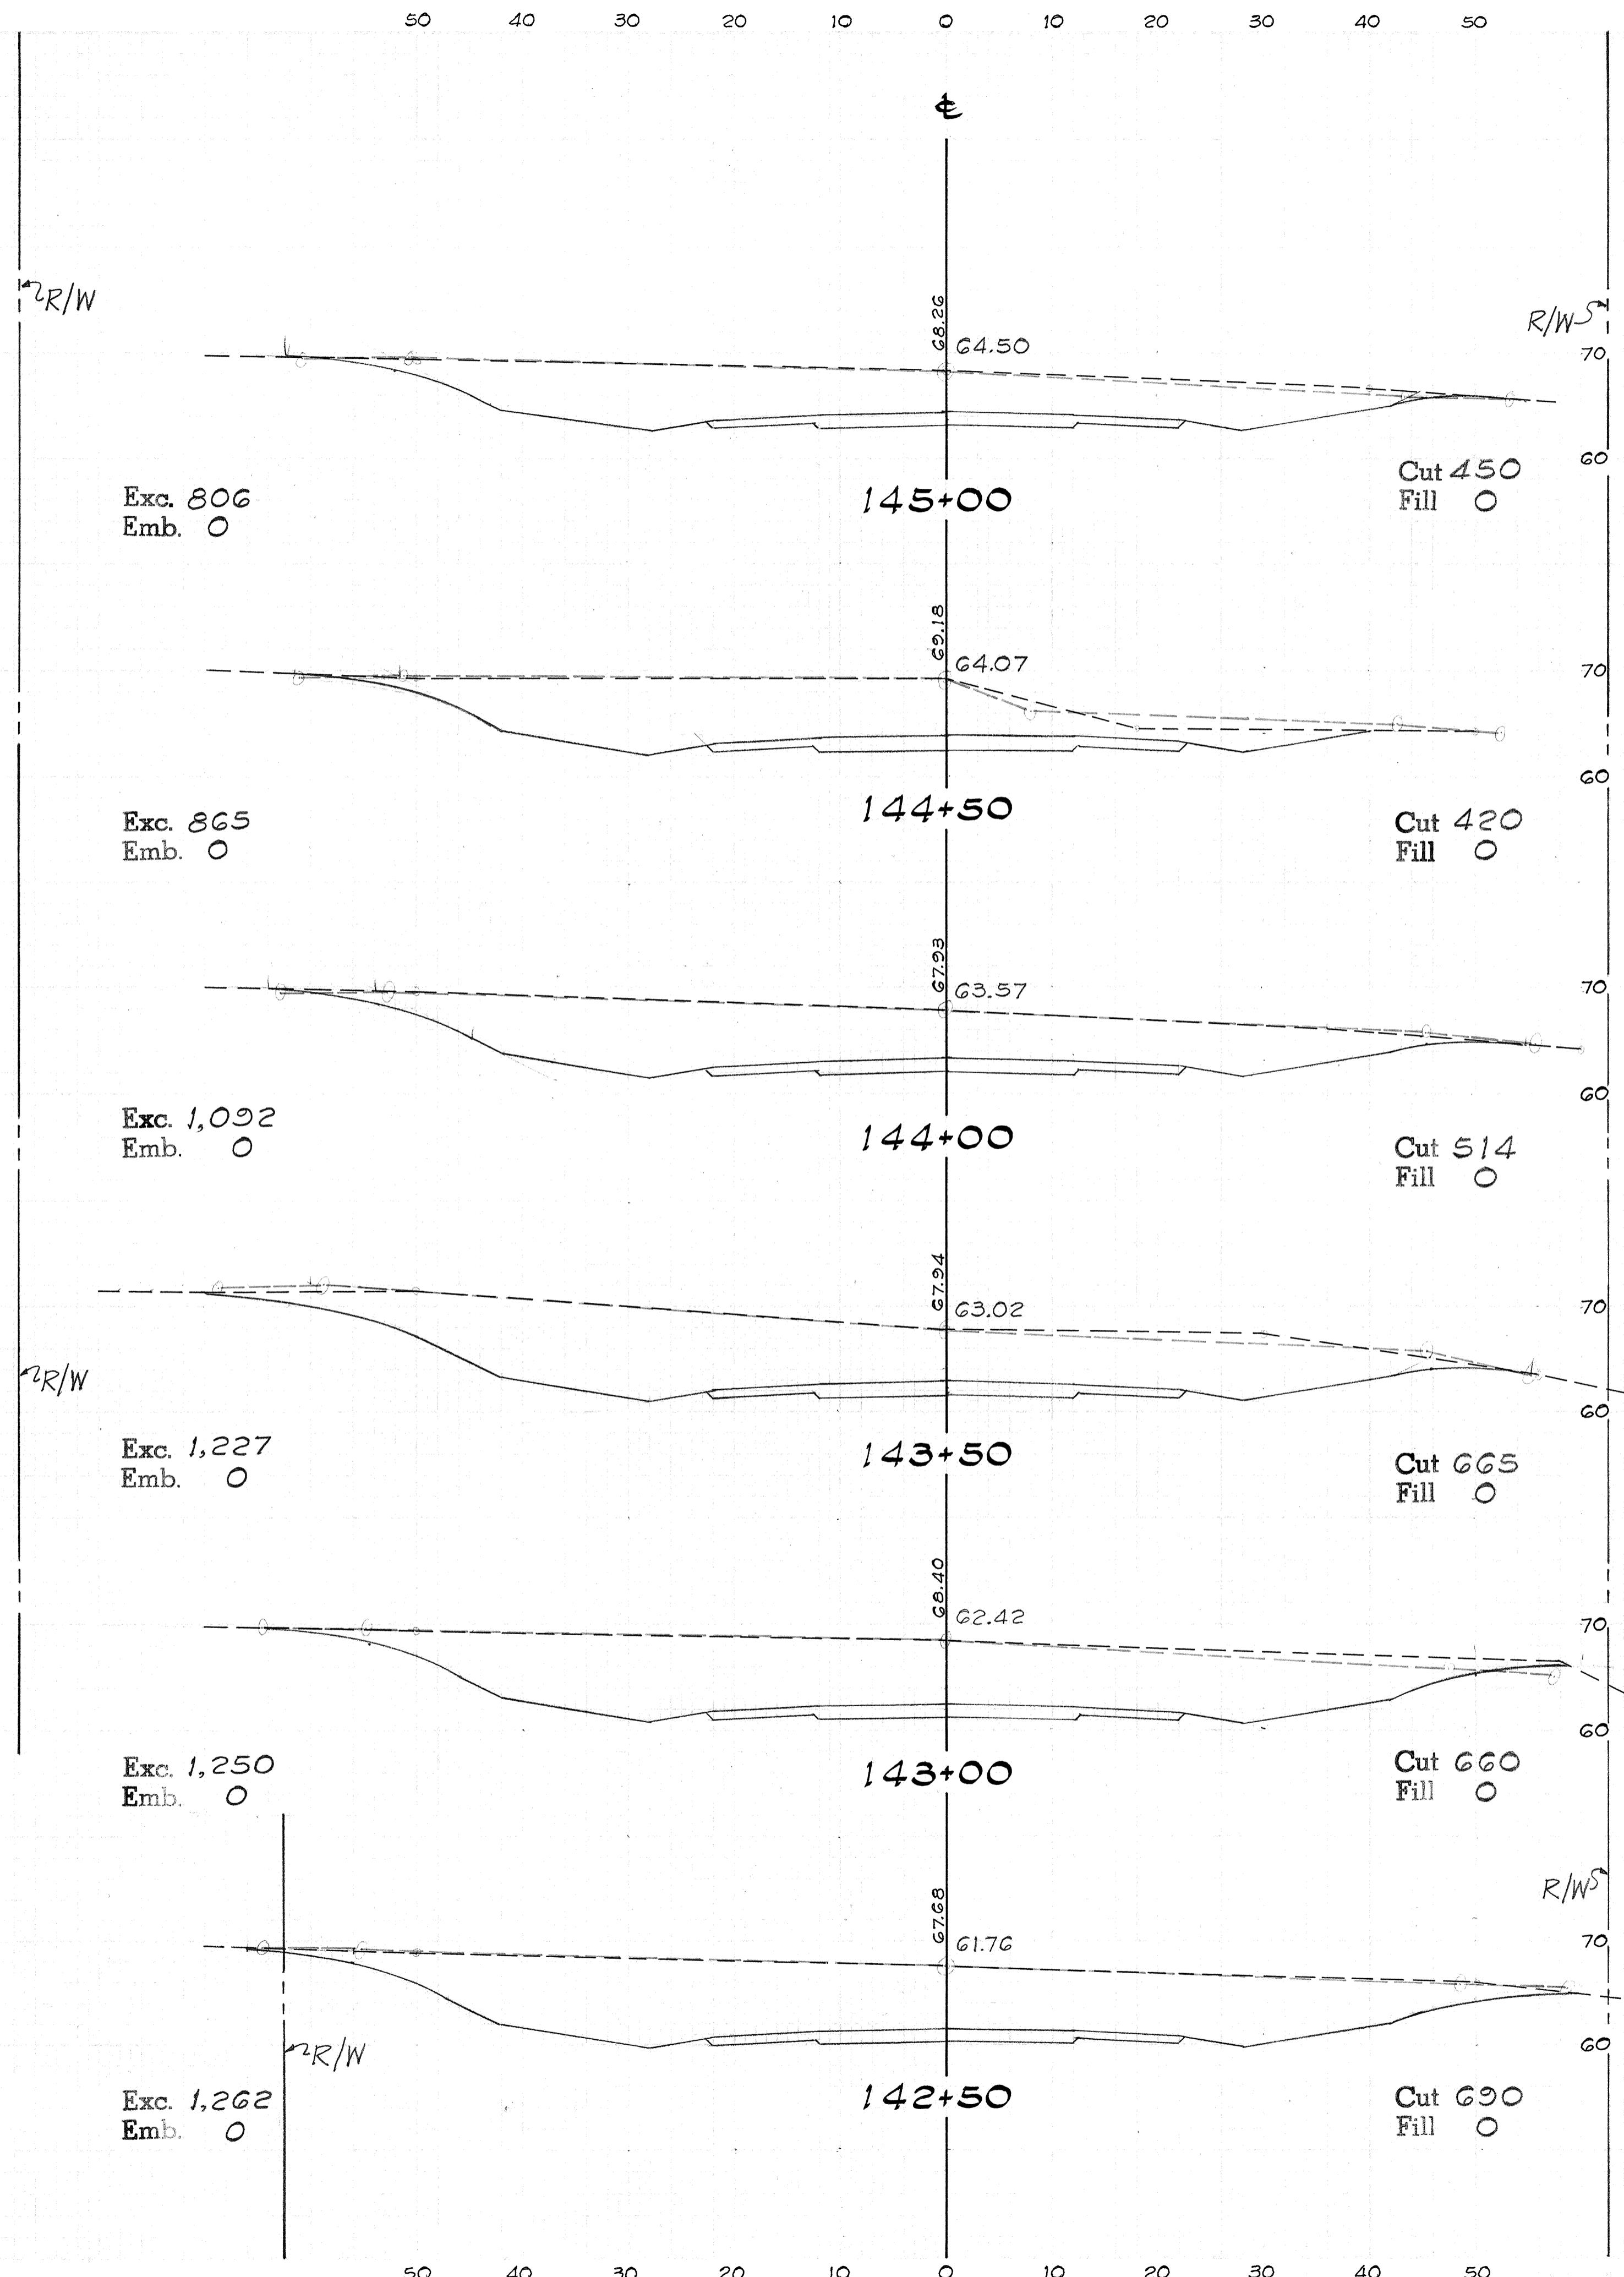



FED. ROAD DIST. NO.	STATE	FED. AID PROJ. NO.	FISCAL YEAR	SHEET NO.	TOTAL SHEETS
HAWAII	HAWAII	ER-9(3)	'79	42	80

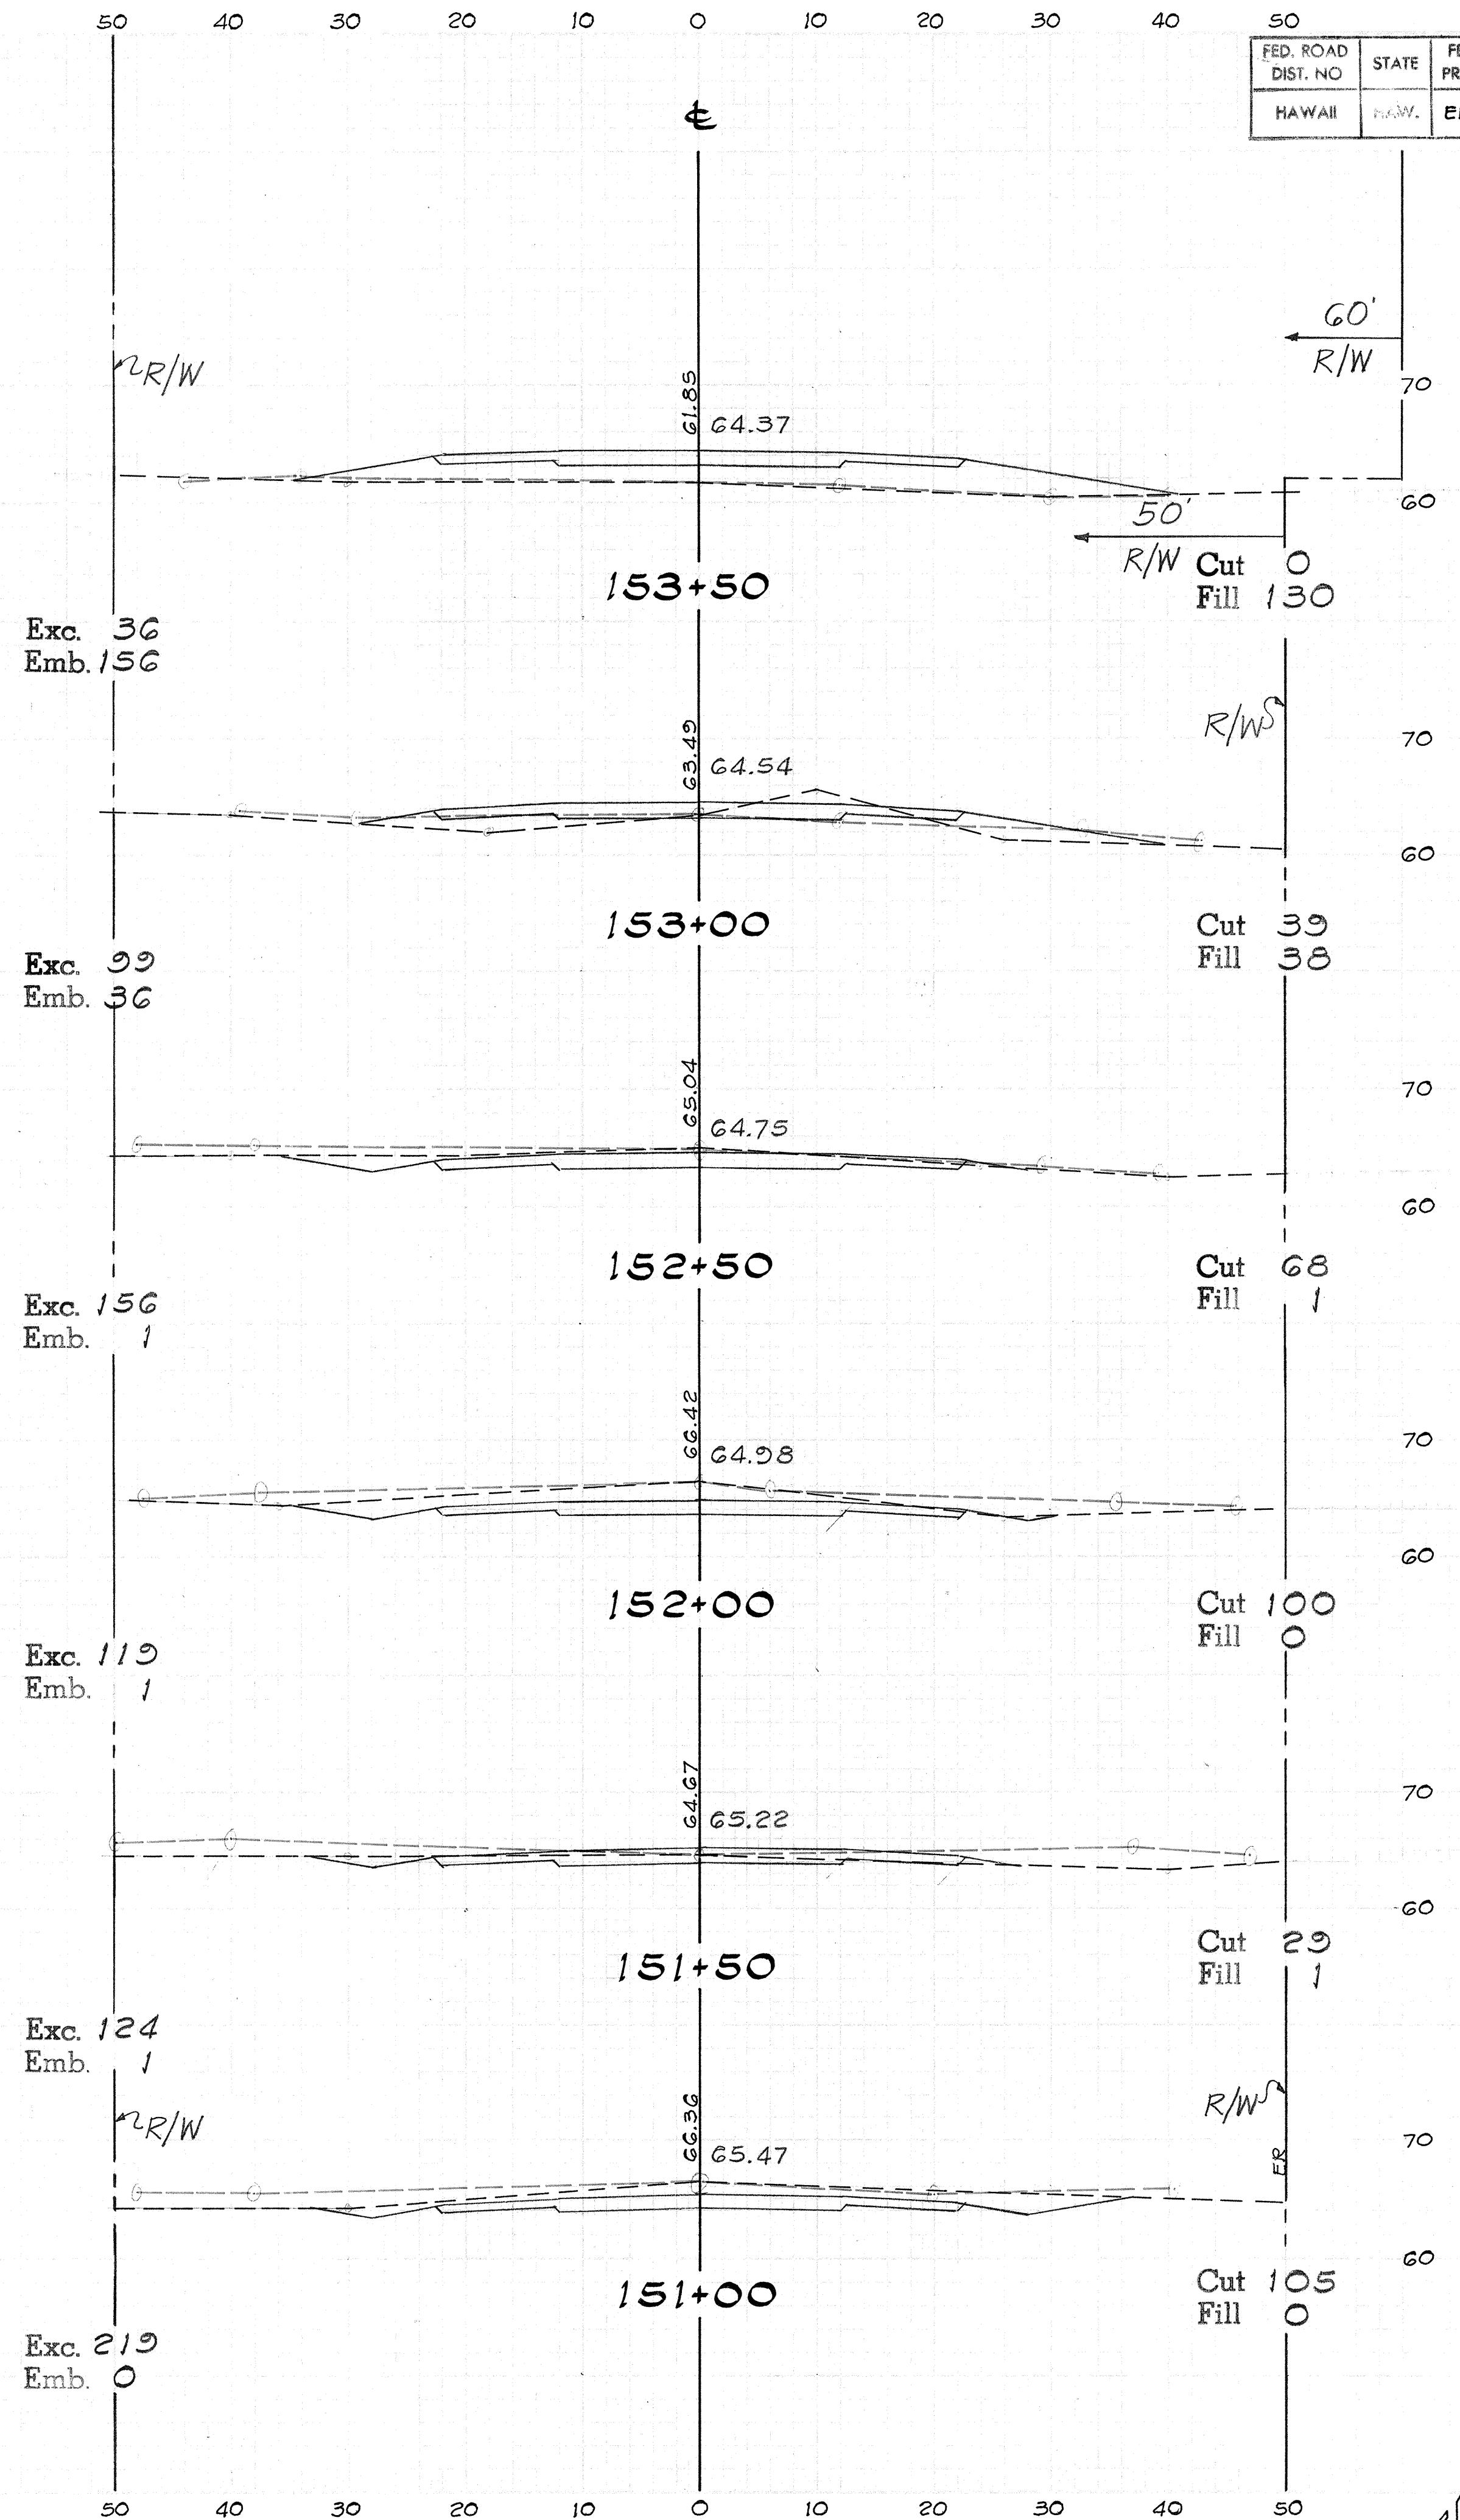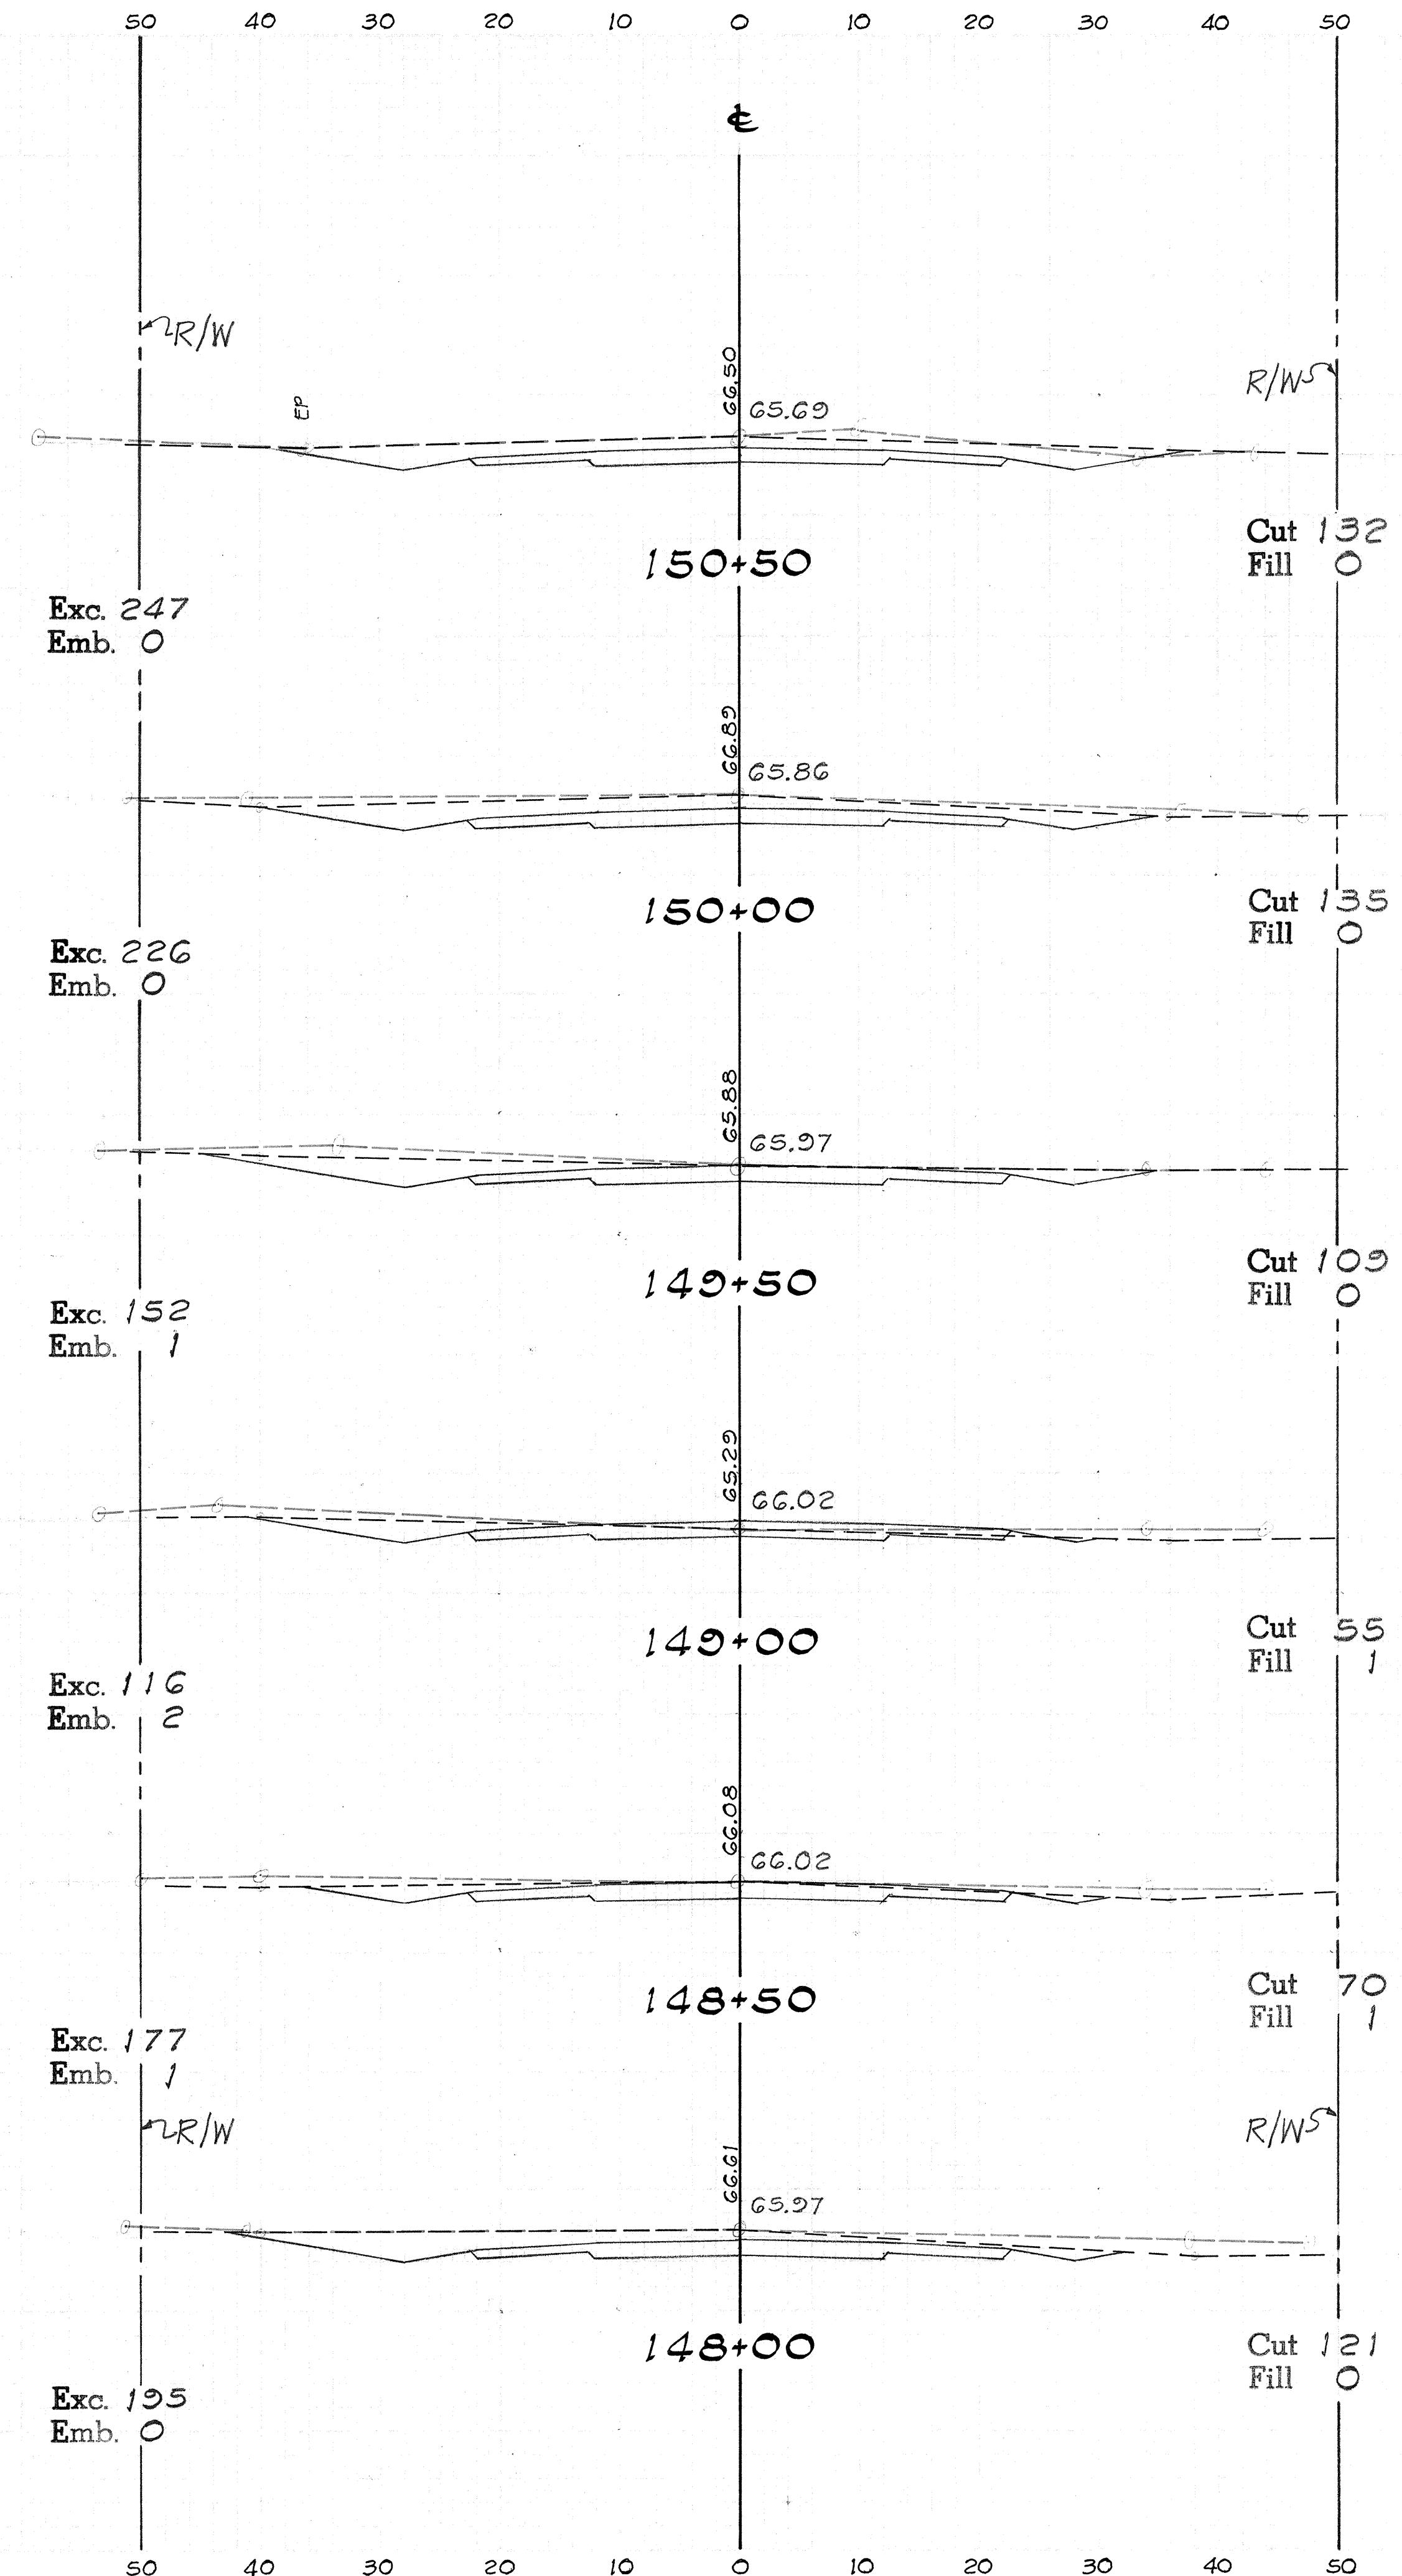



FED. ROAD DIST. NO.	STATE	FED. AID PROJ. NO.	FISCAL YEAR	SHEET NO.	TOTAL SHEETS
HAWAII	R/W	ER-9(3)	'79	43	89

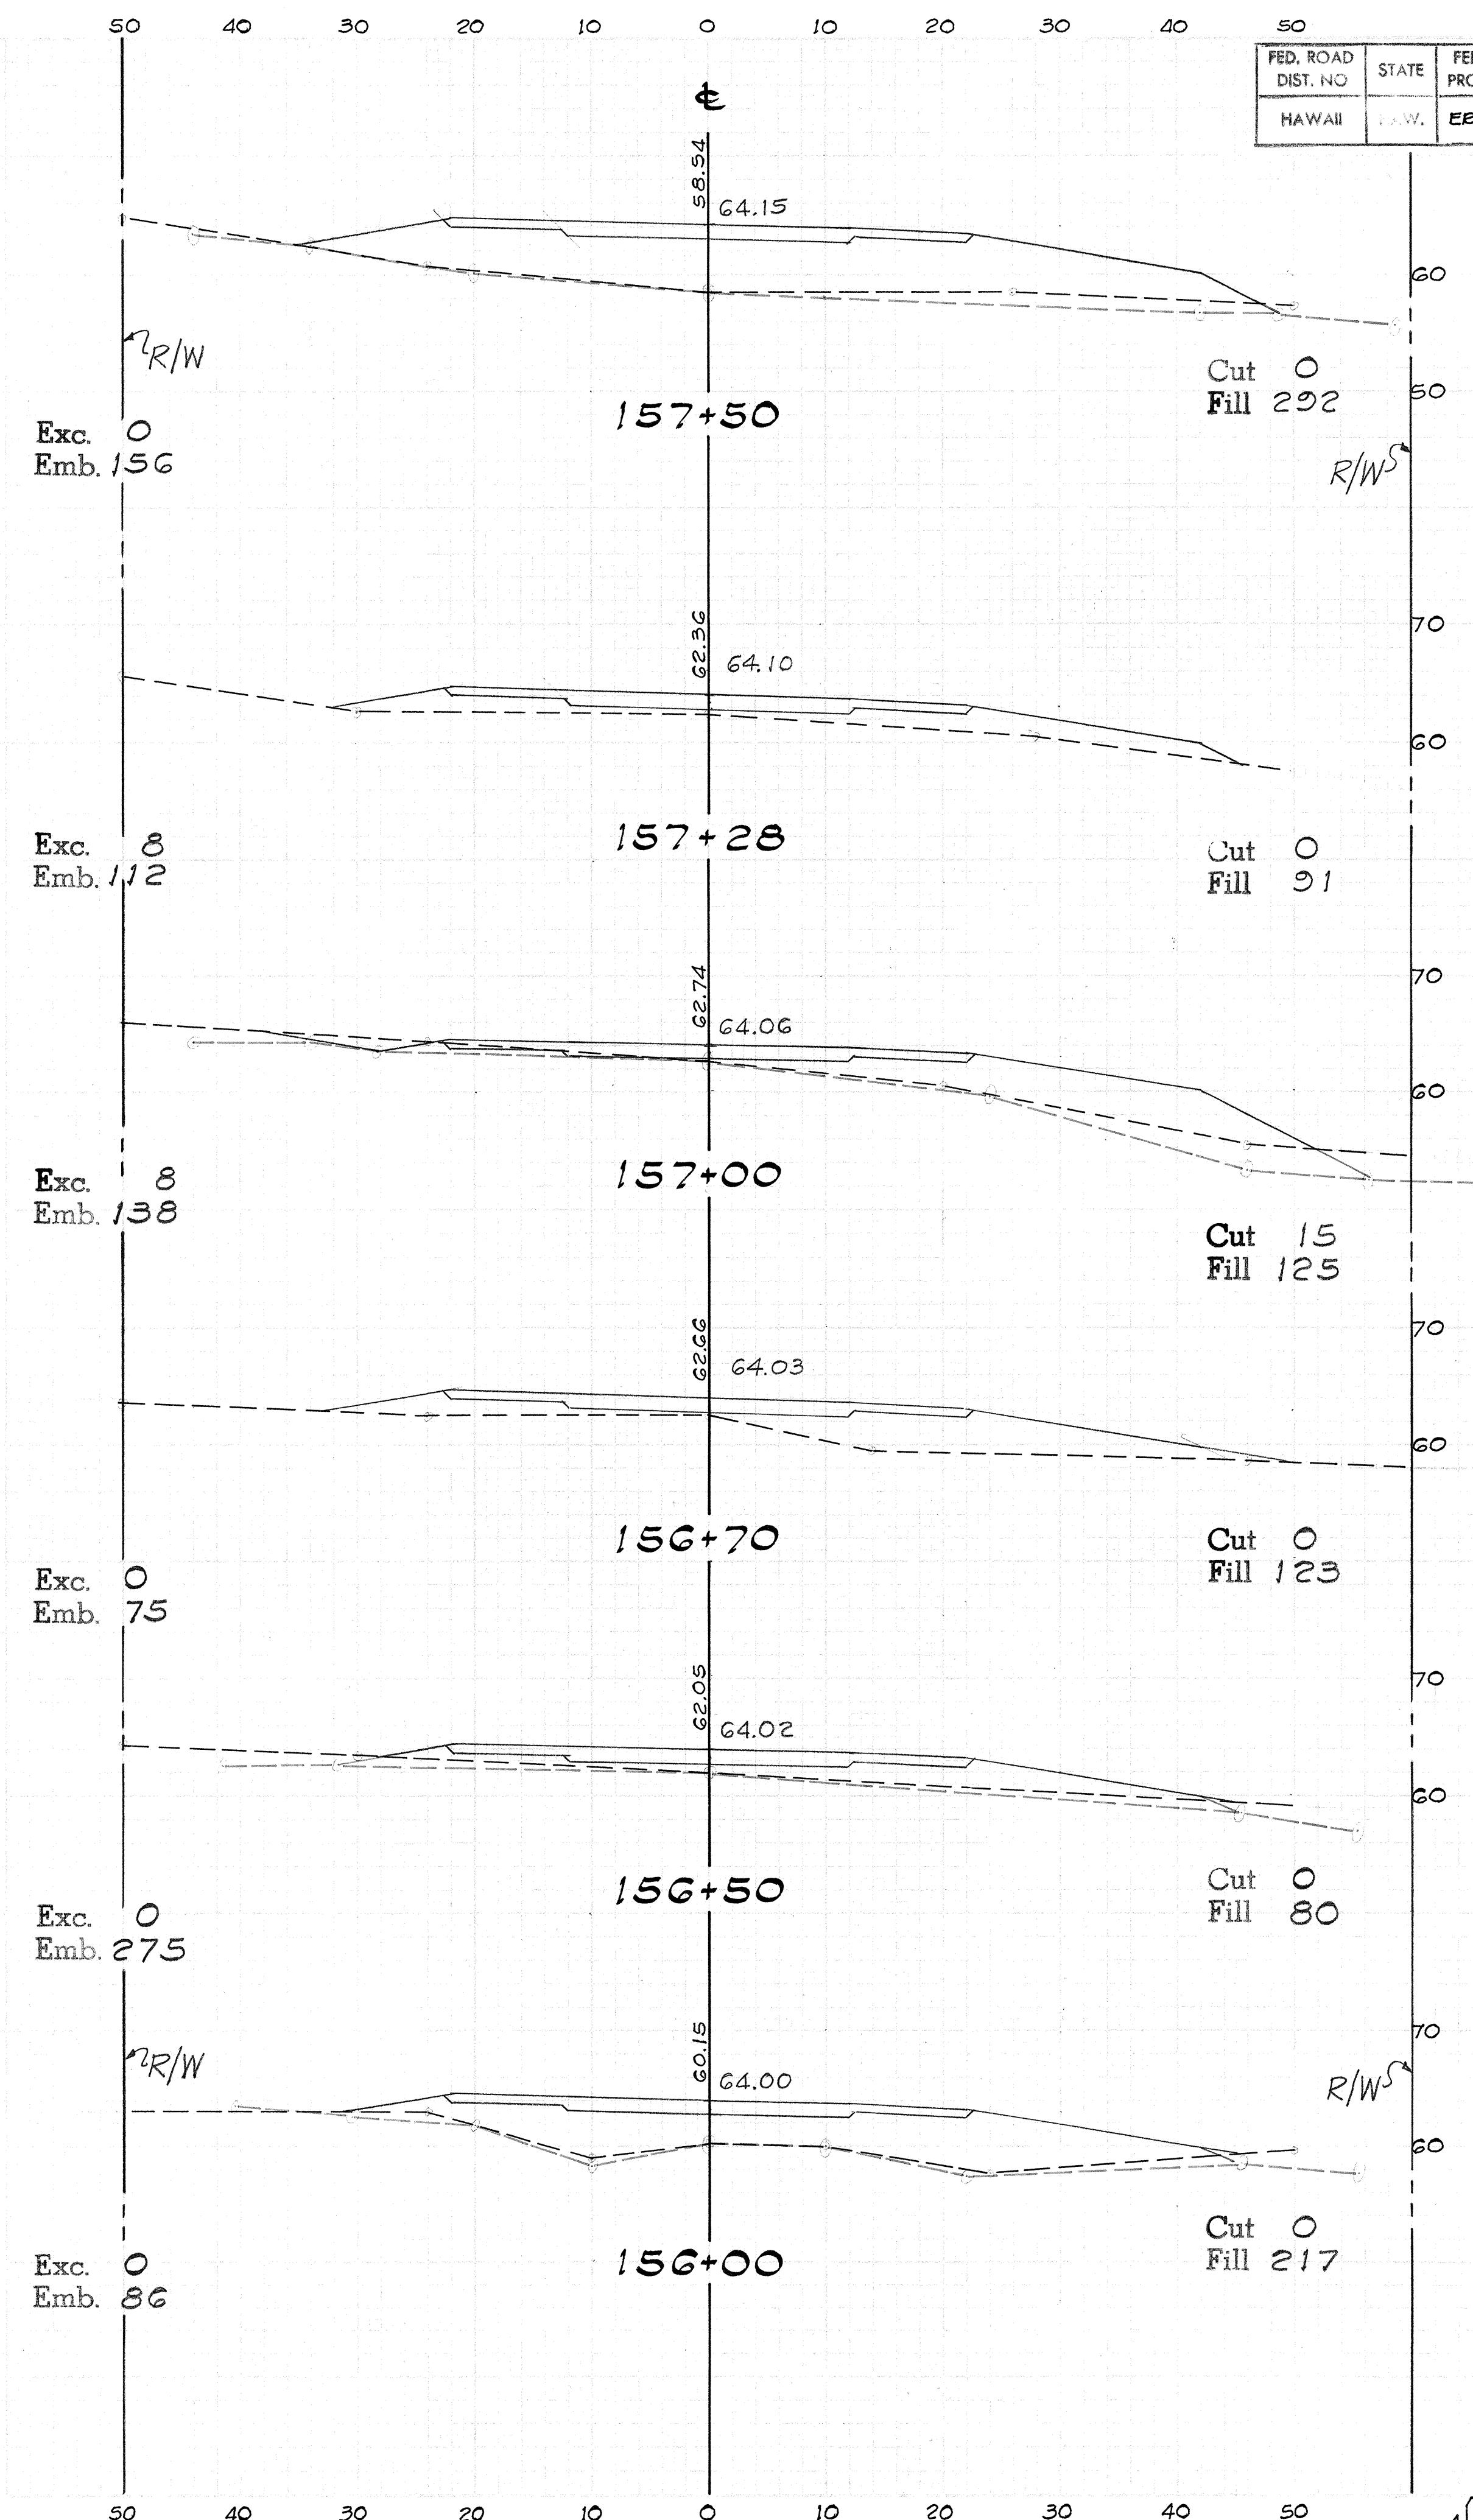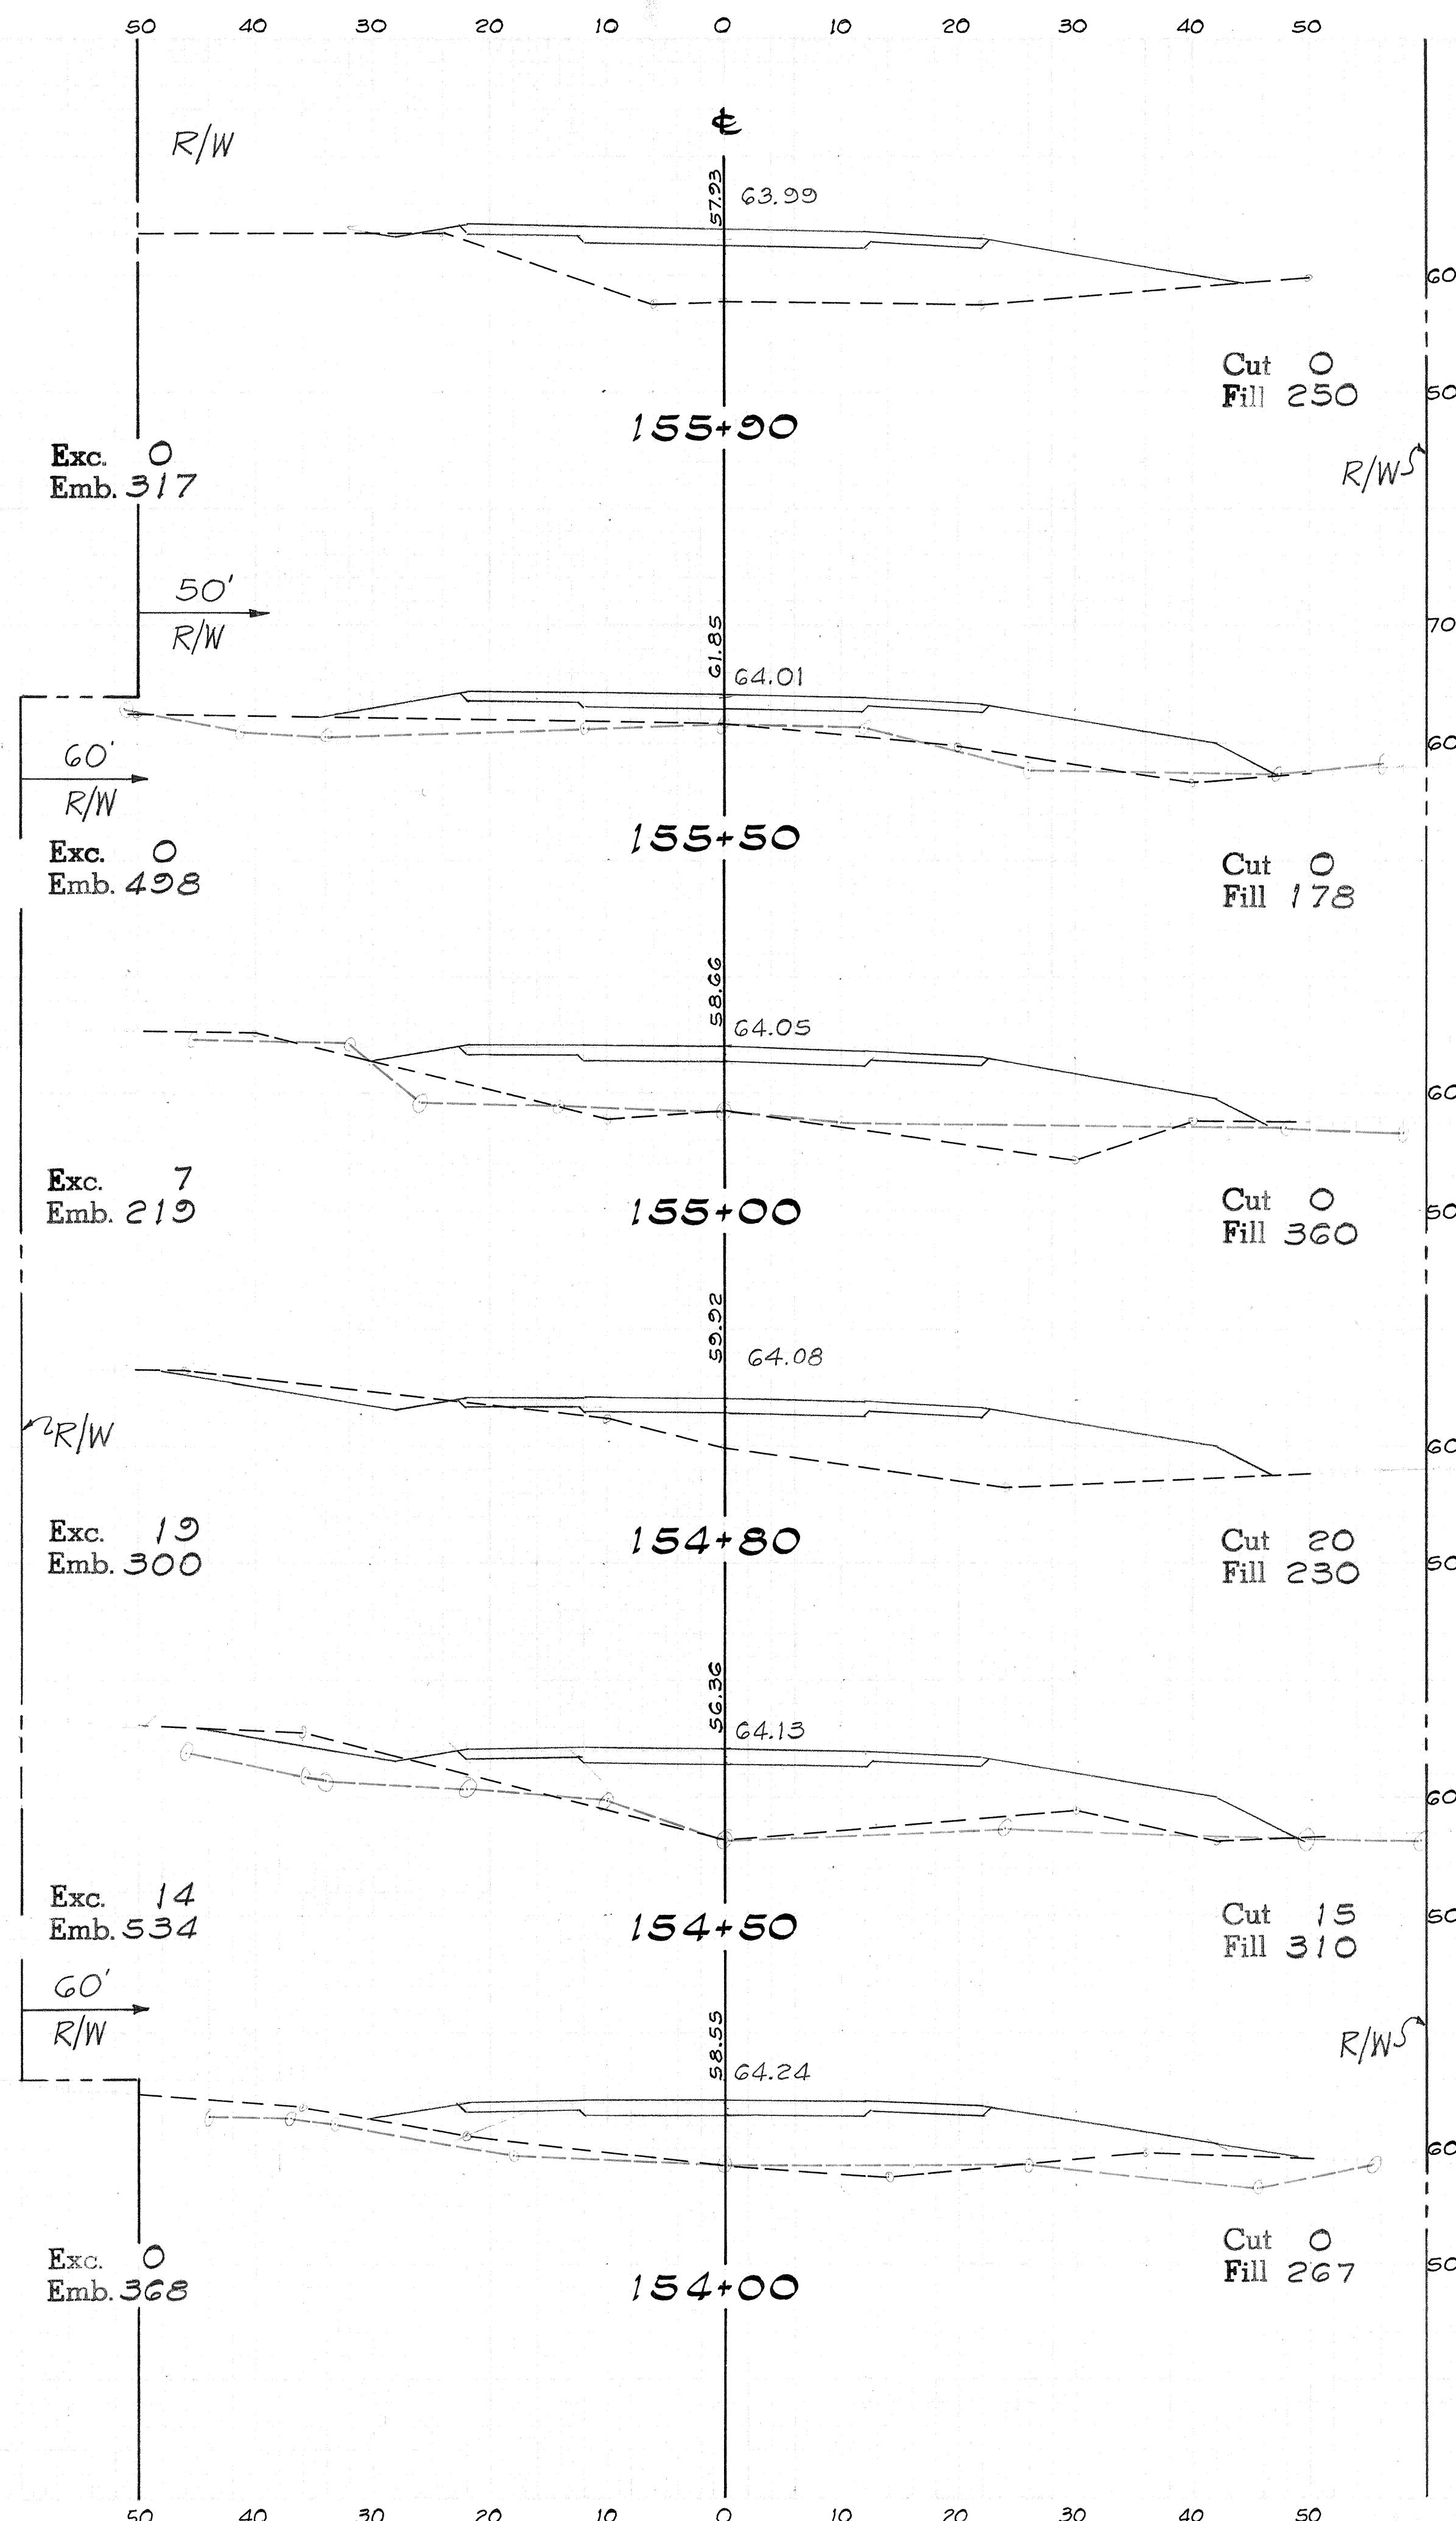



FED. ROAD DIST. NO.	STATE	FED. AID PROJ. NO.	FISCAL YEAR	HEET NO.	TOTAL SHEETS
HAWAII	HAW.	ER-9(3)	'79	44	80

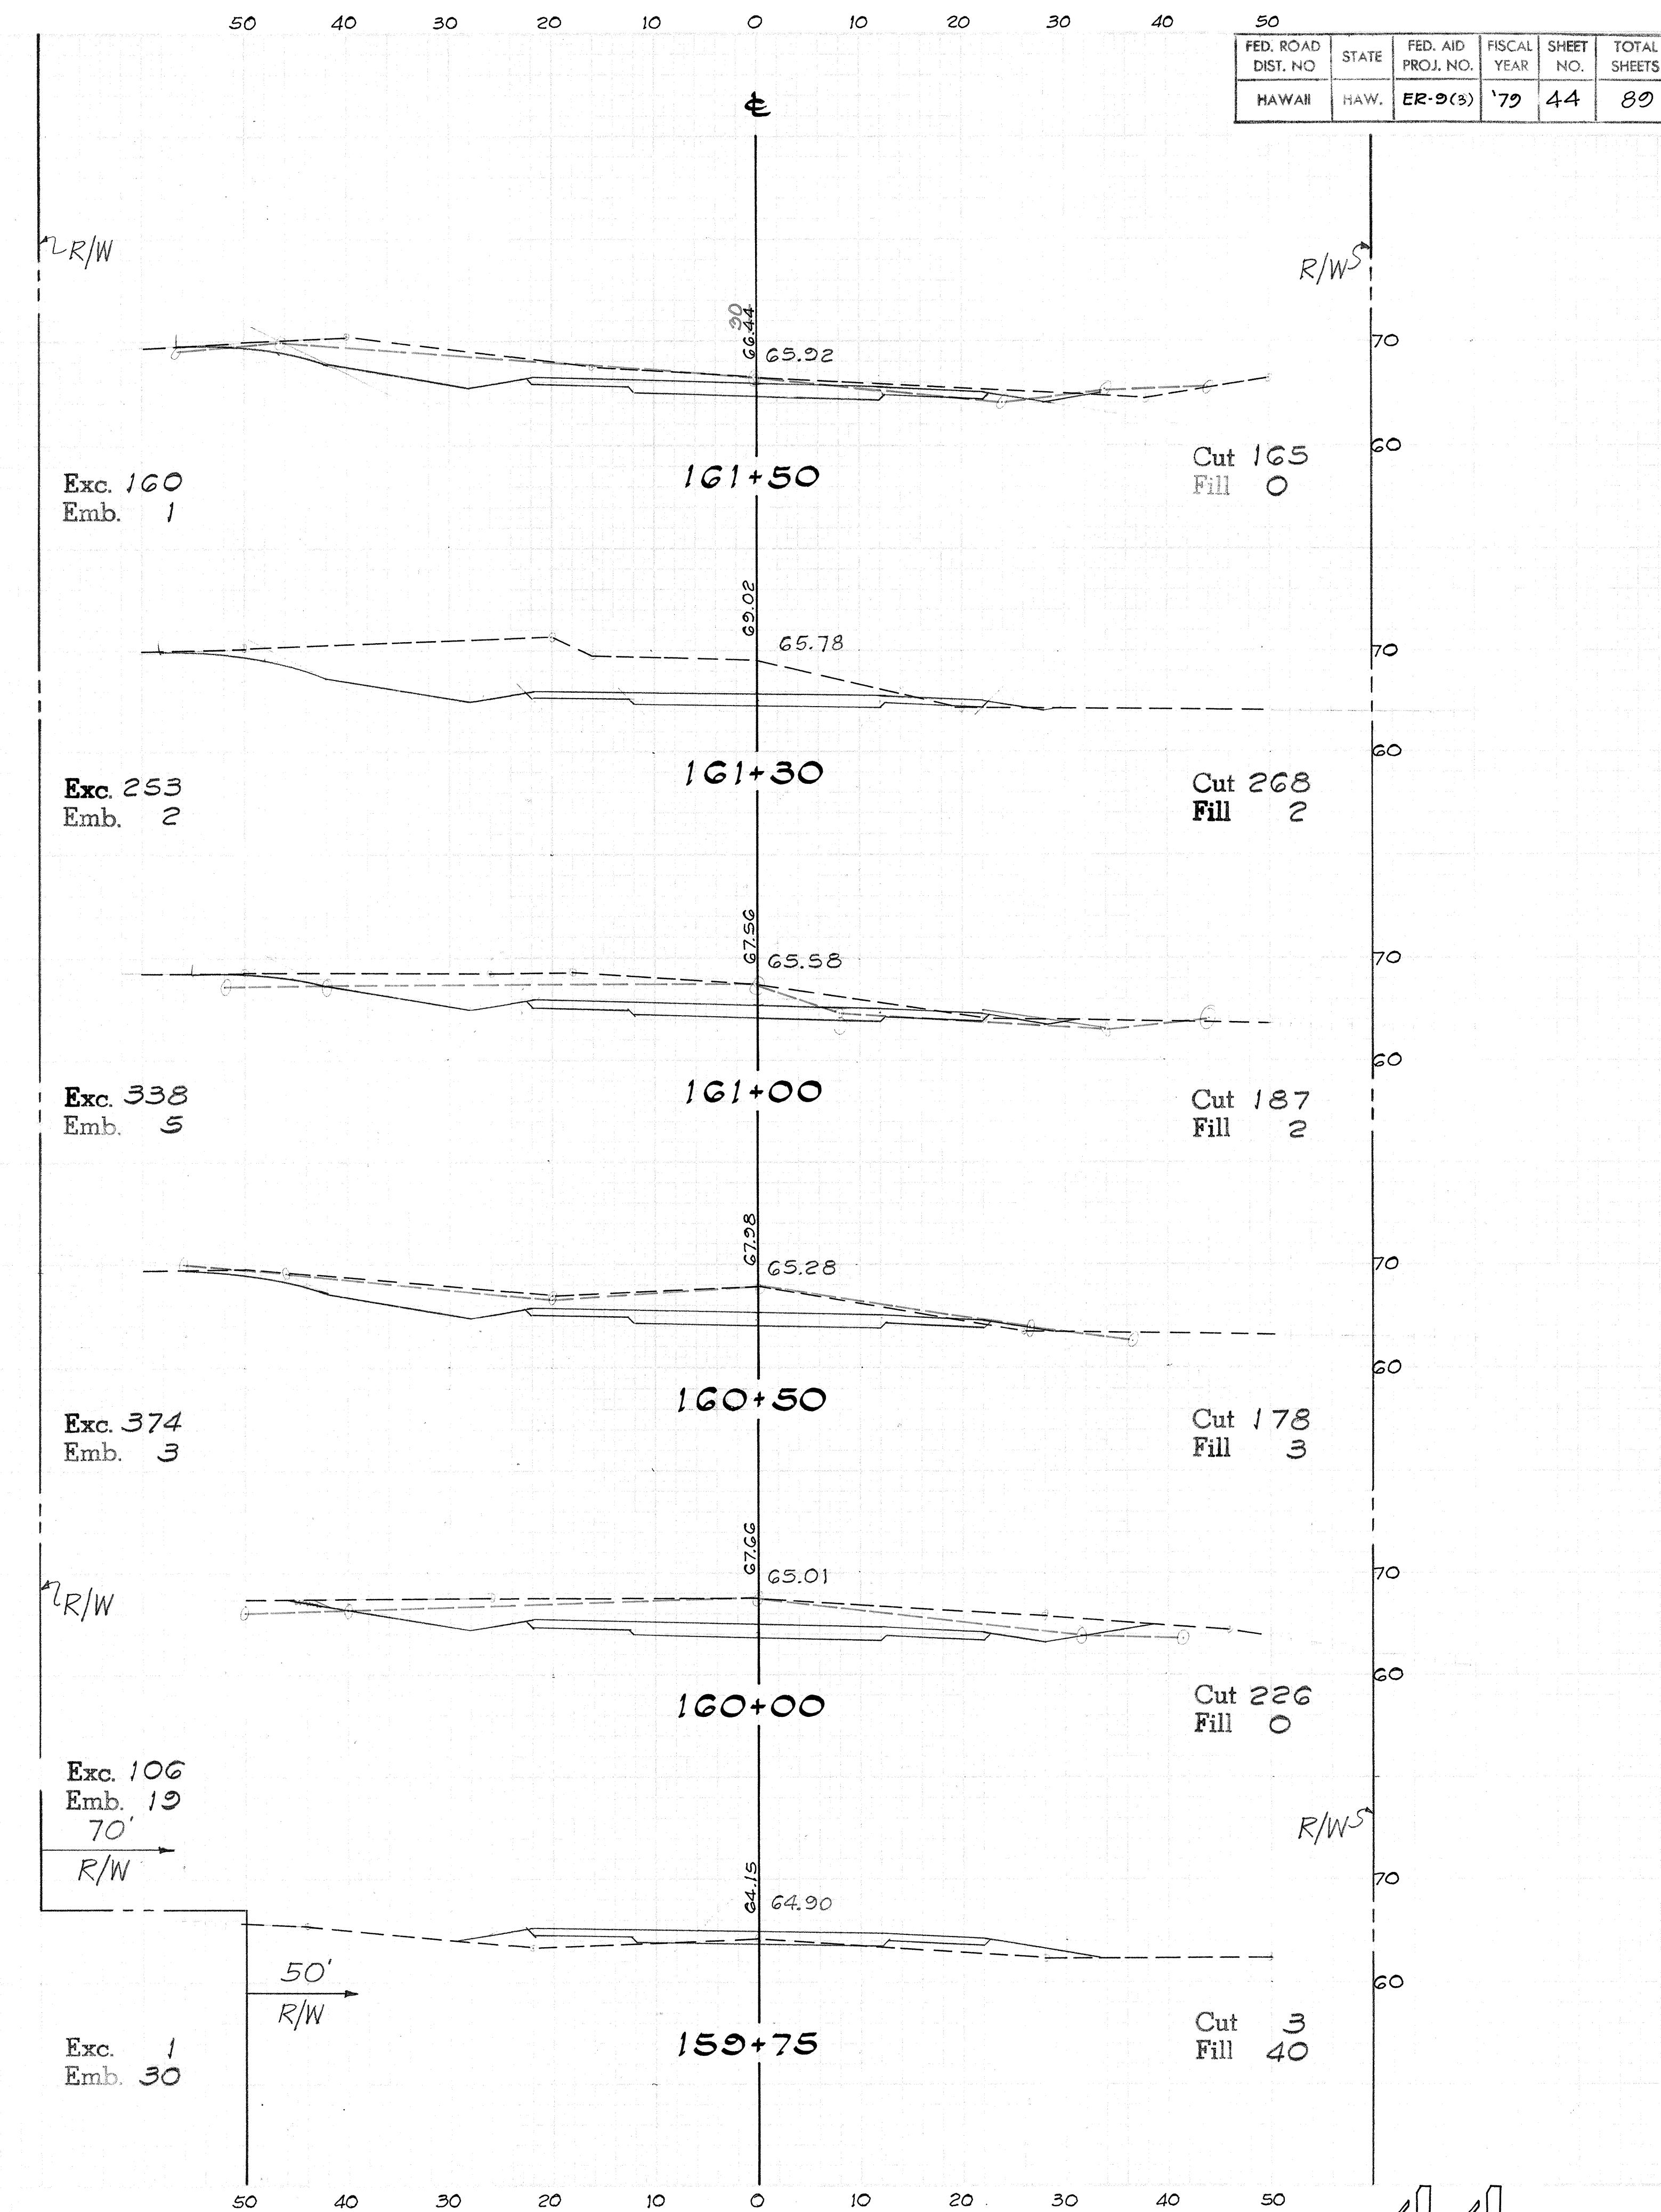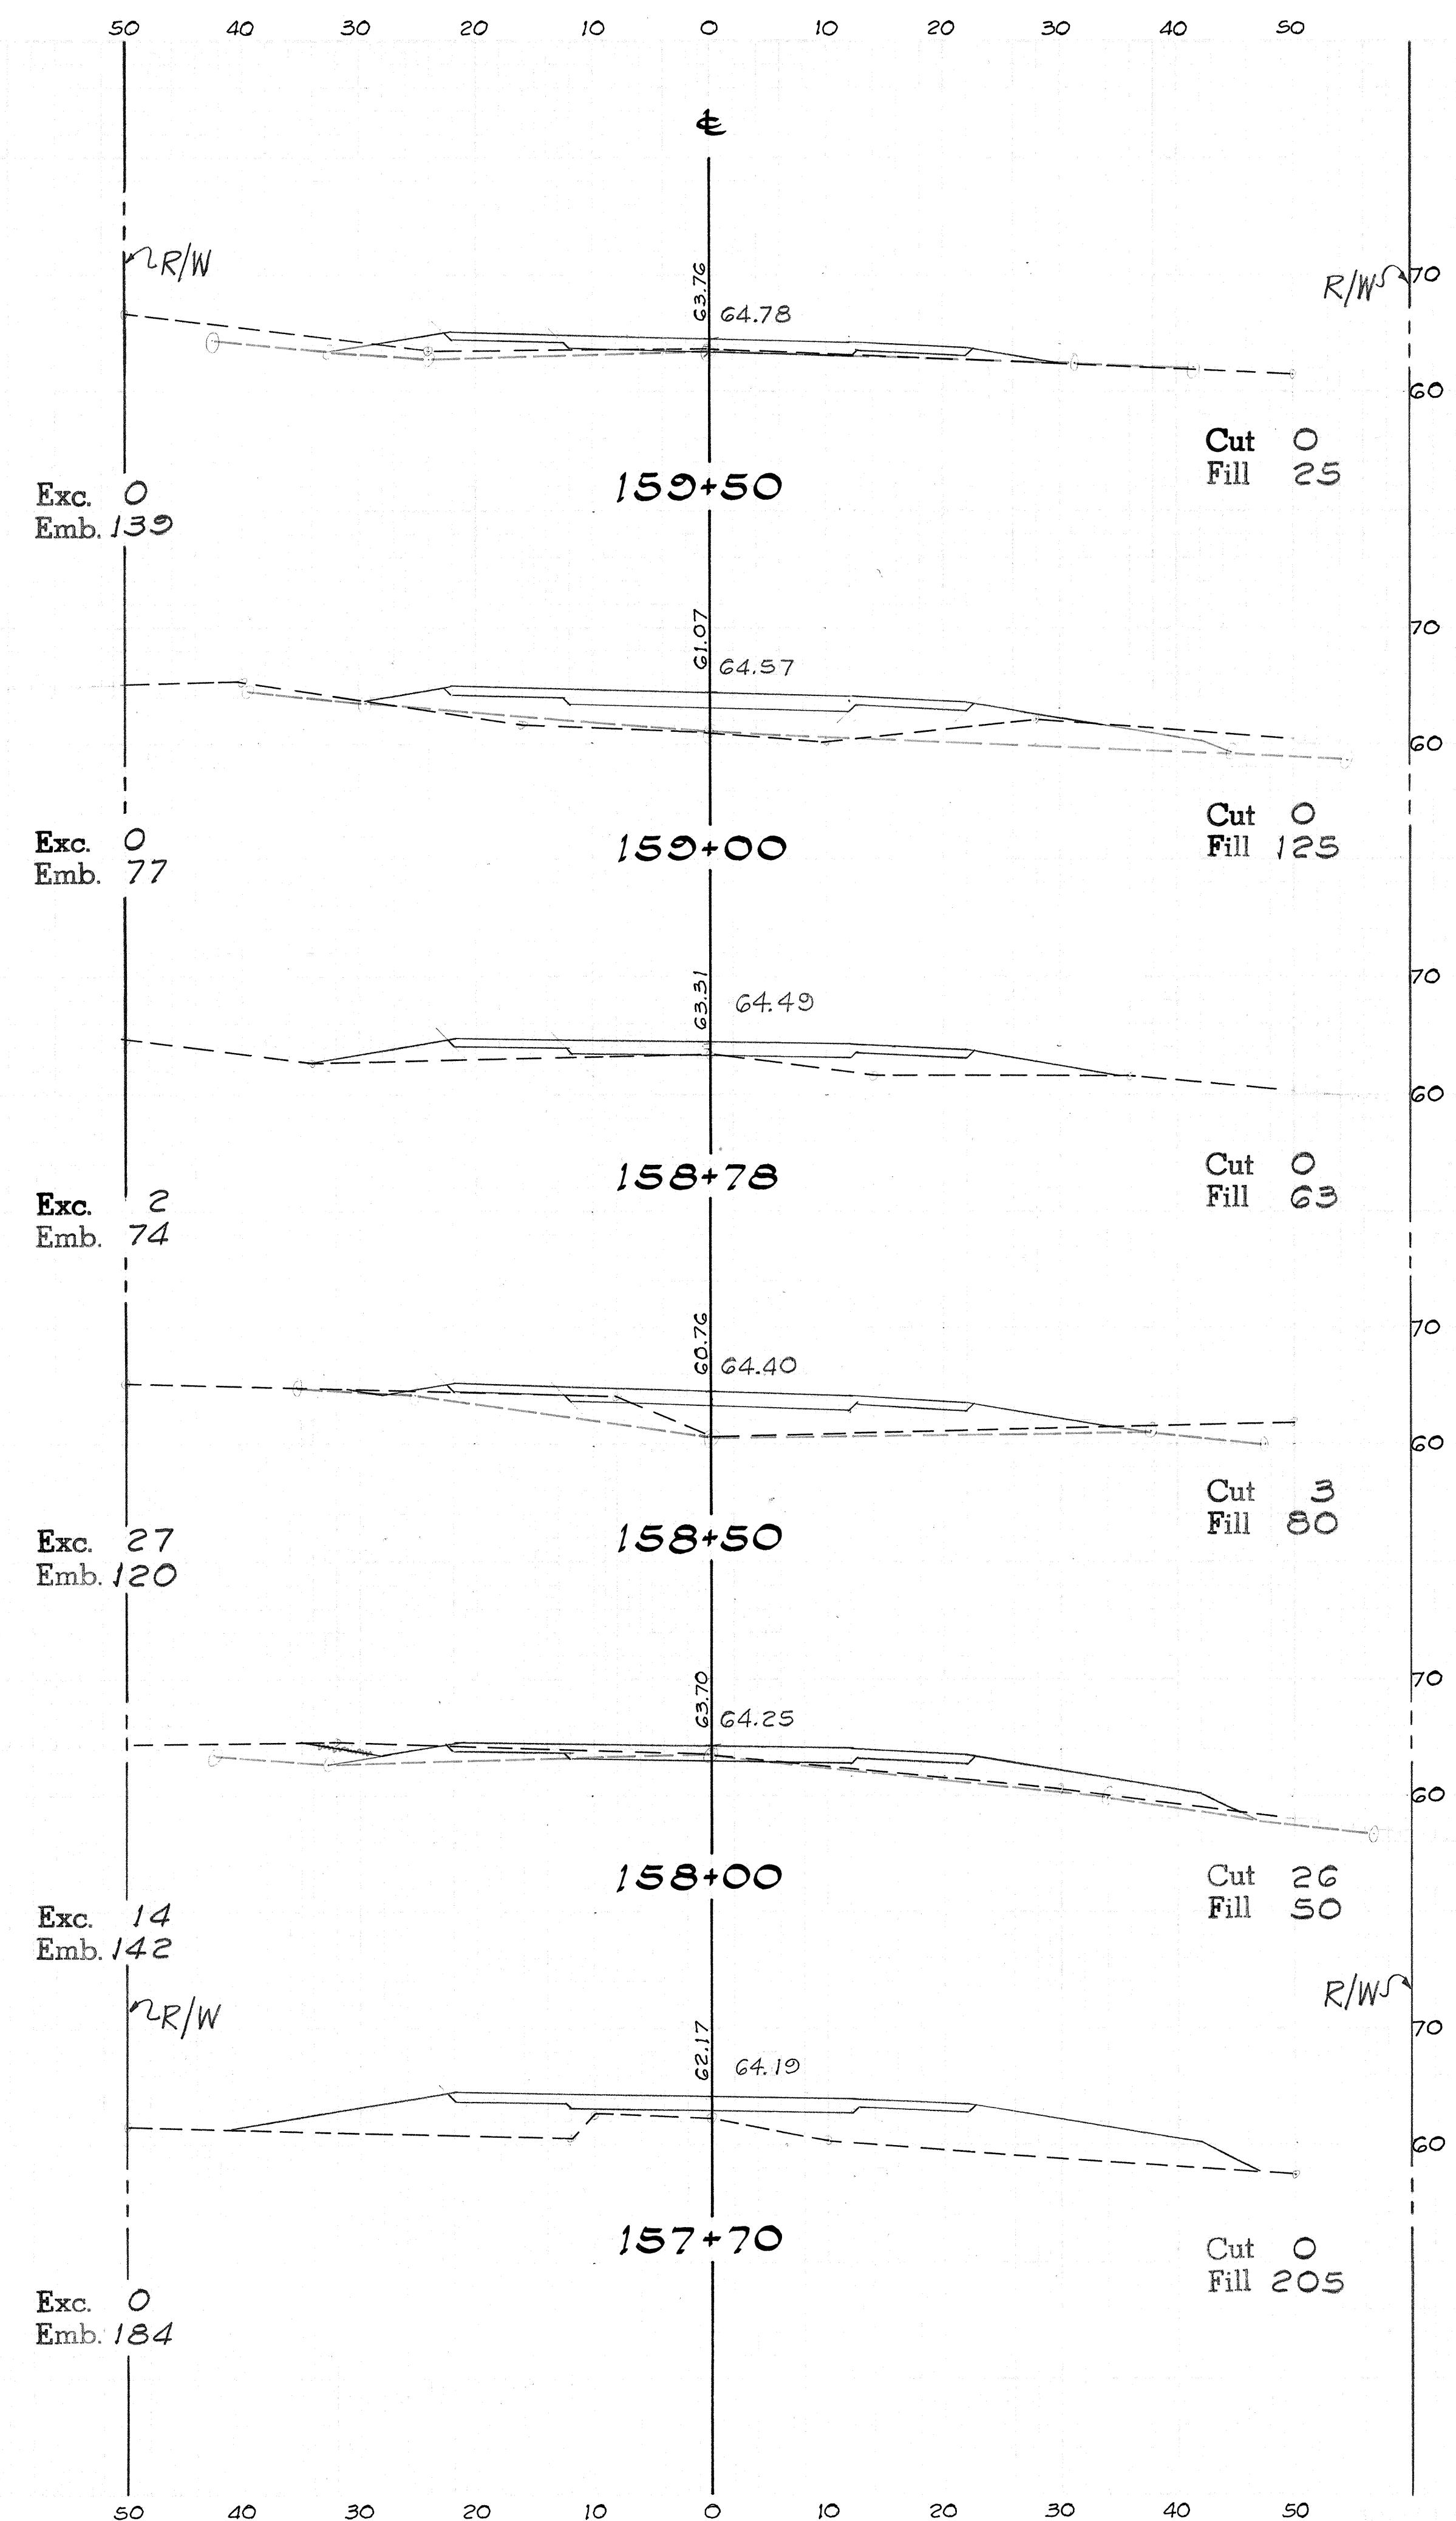



FED. ROAD DIST. NO.	STATE	FED. AID PROJ. NO.	FISCAL YEAR	HEET NO.	TOTAL SHEETS
HAWAII	HAW.	ER-9(3)	'70	45	89

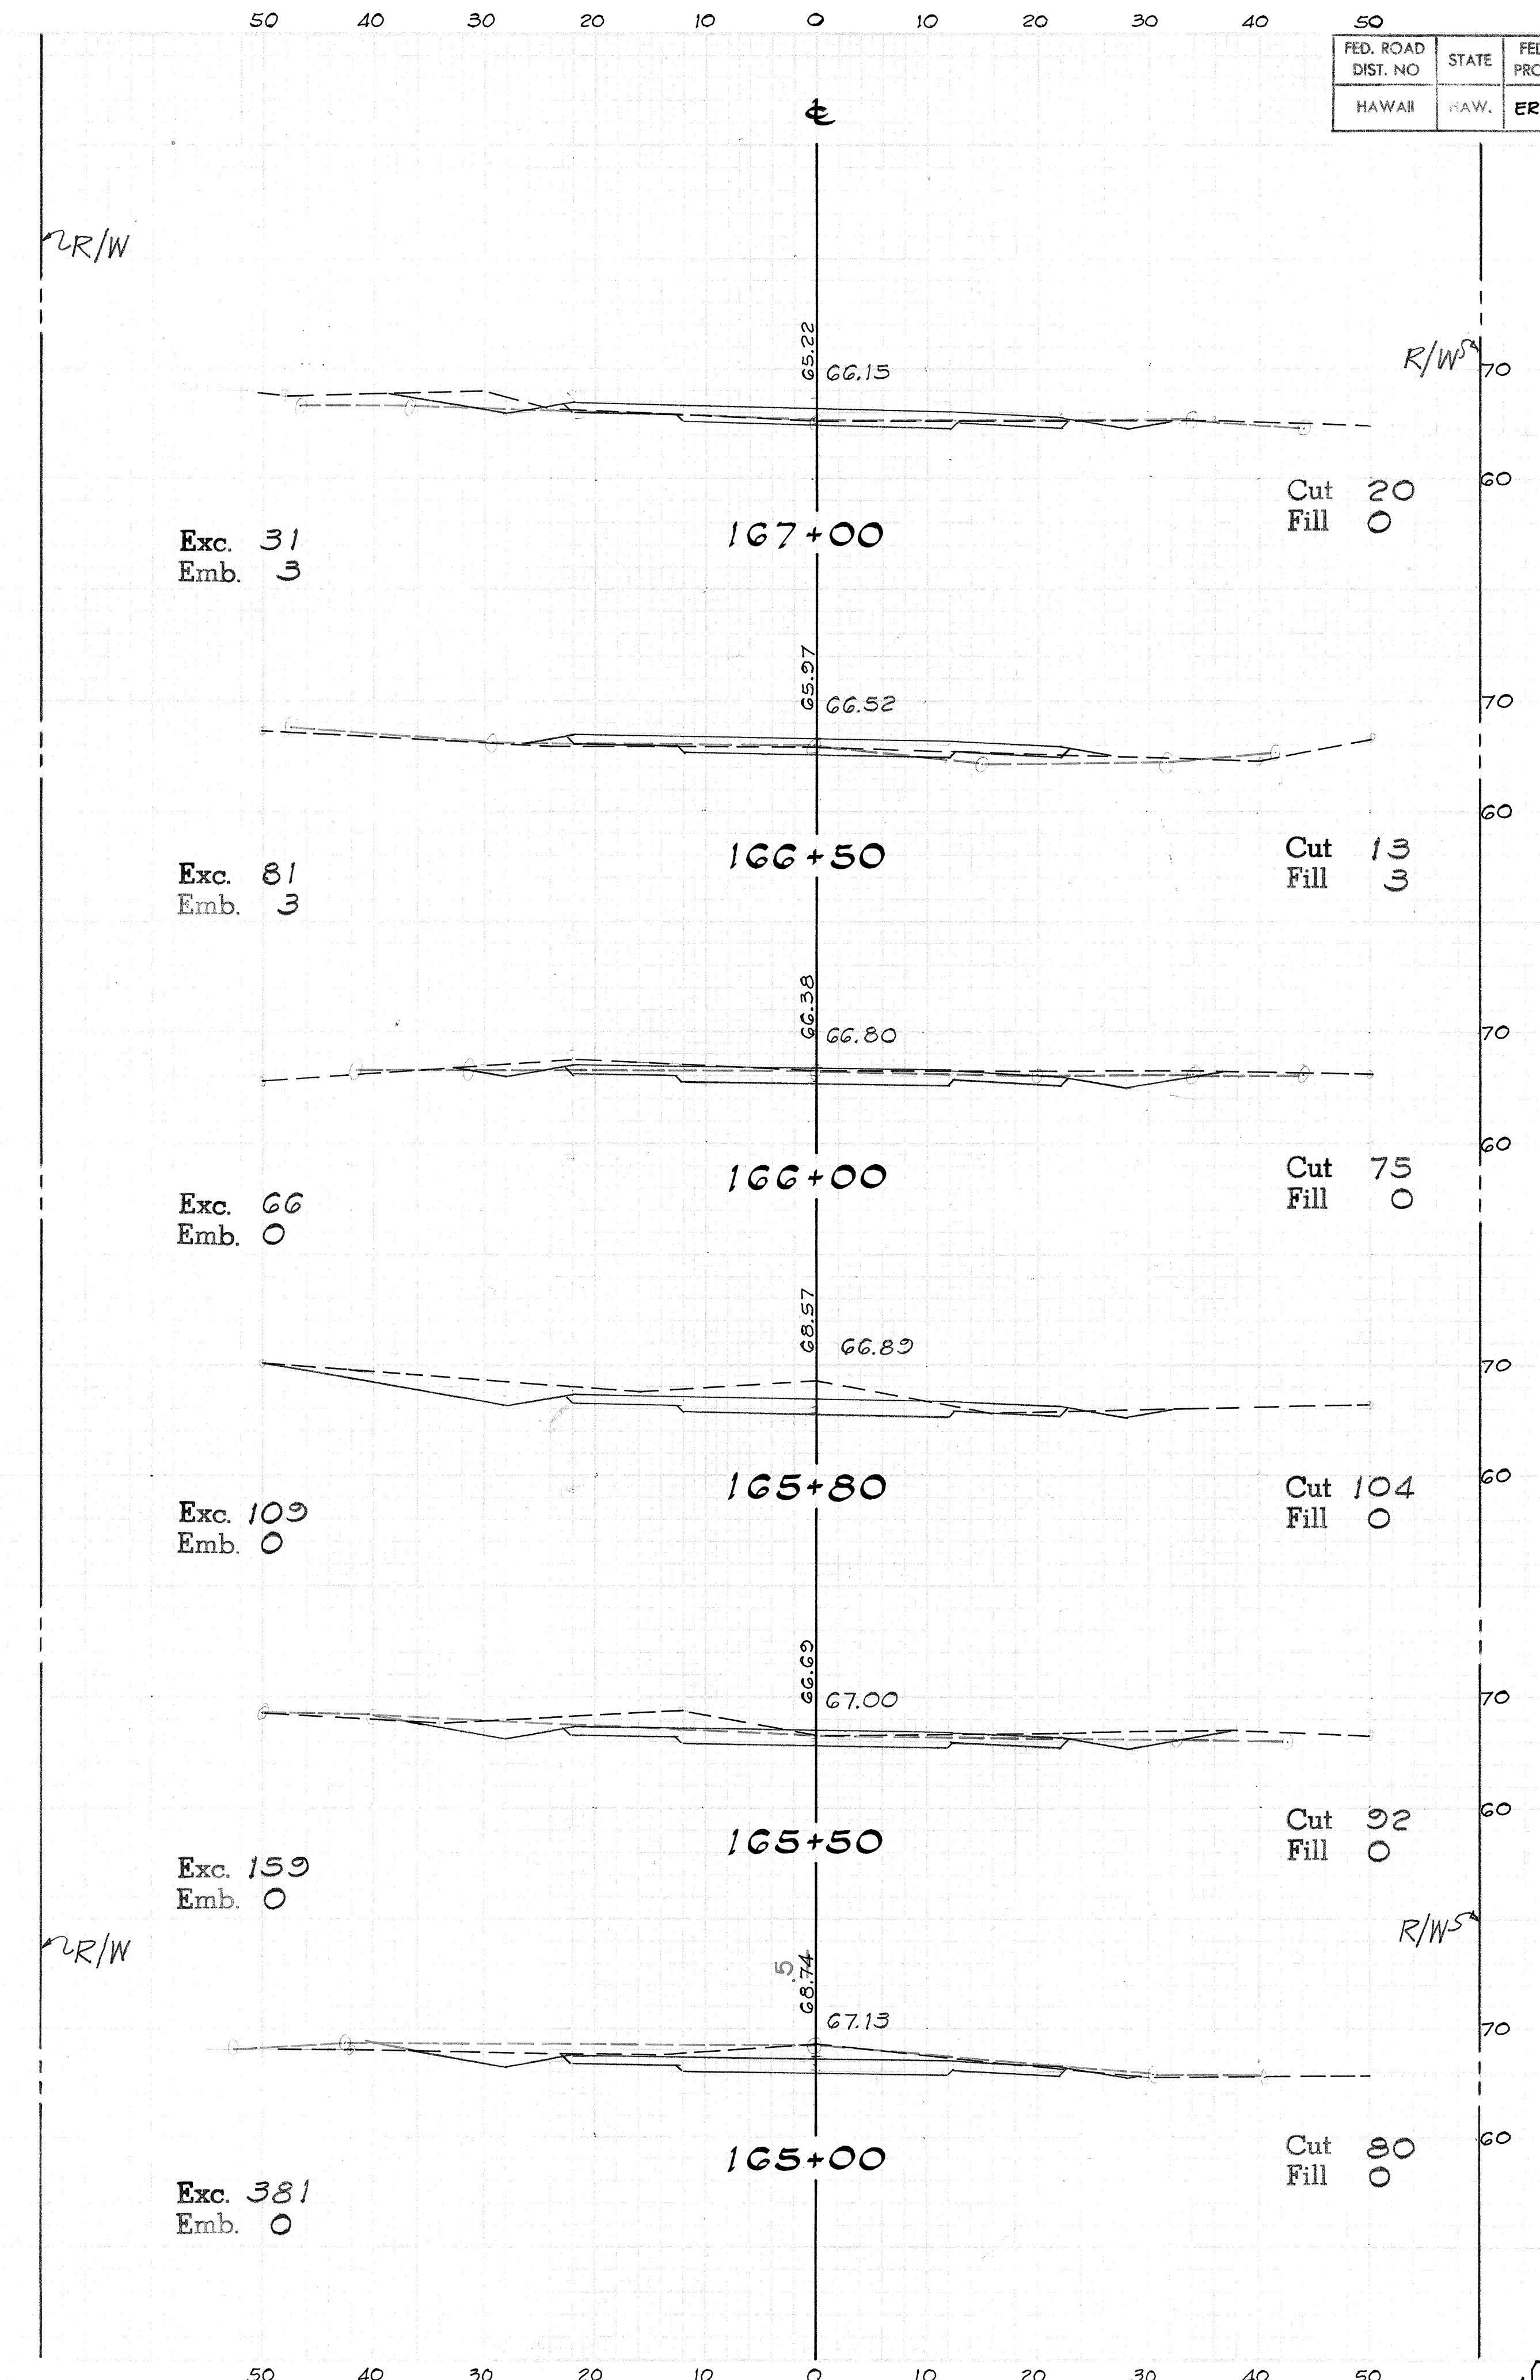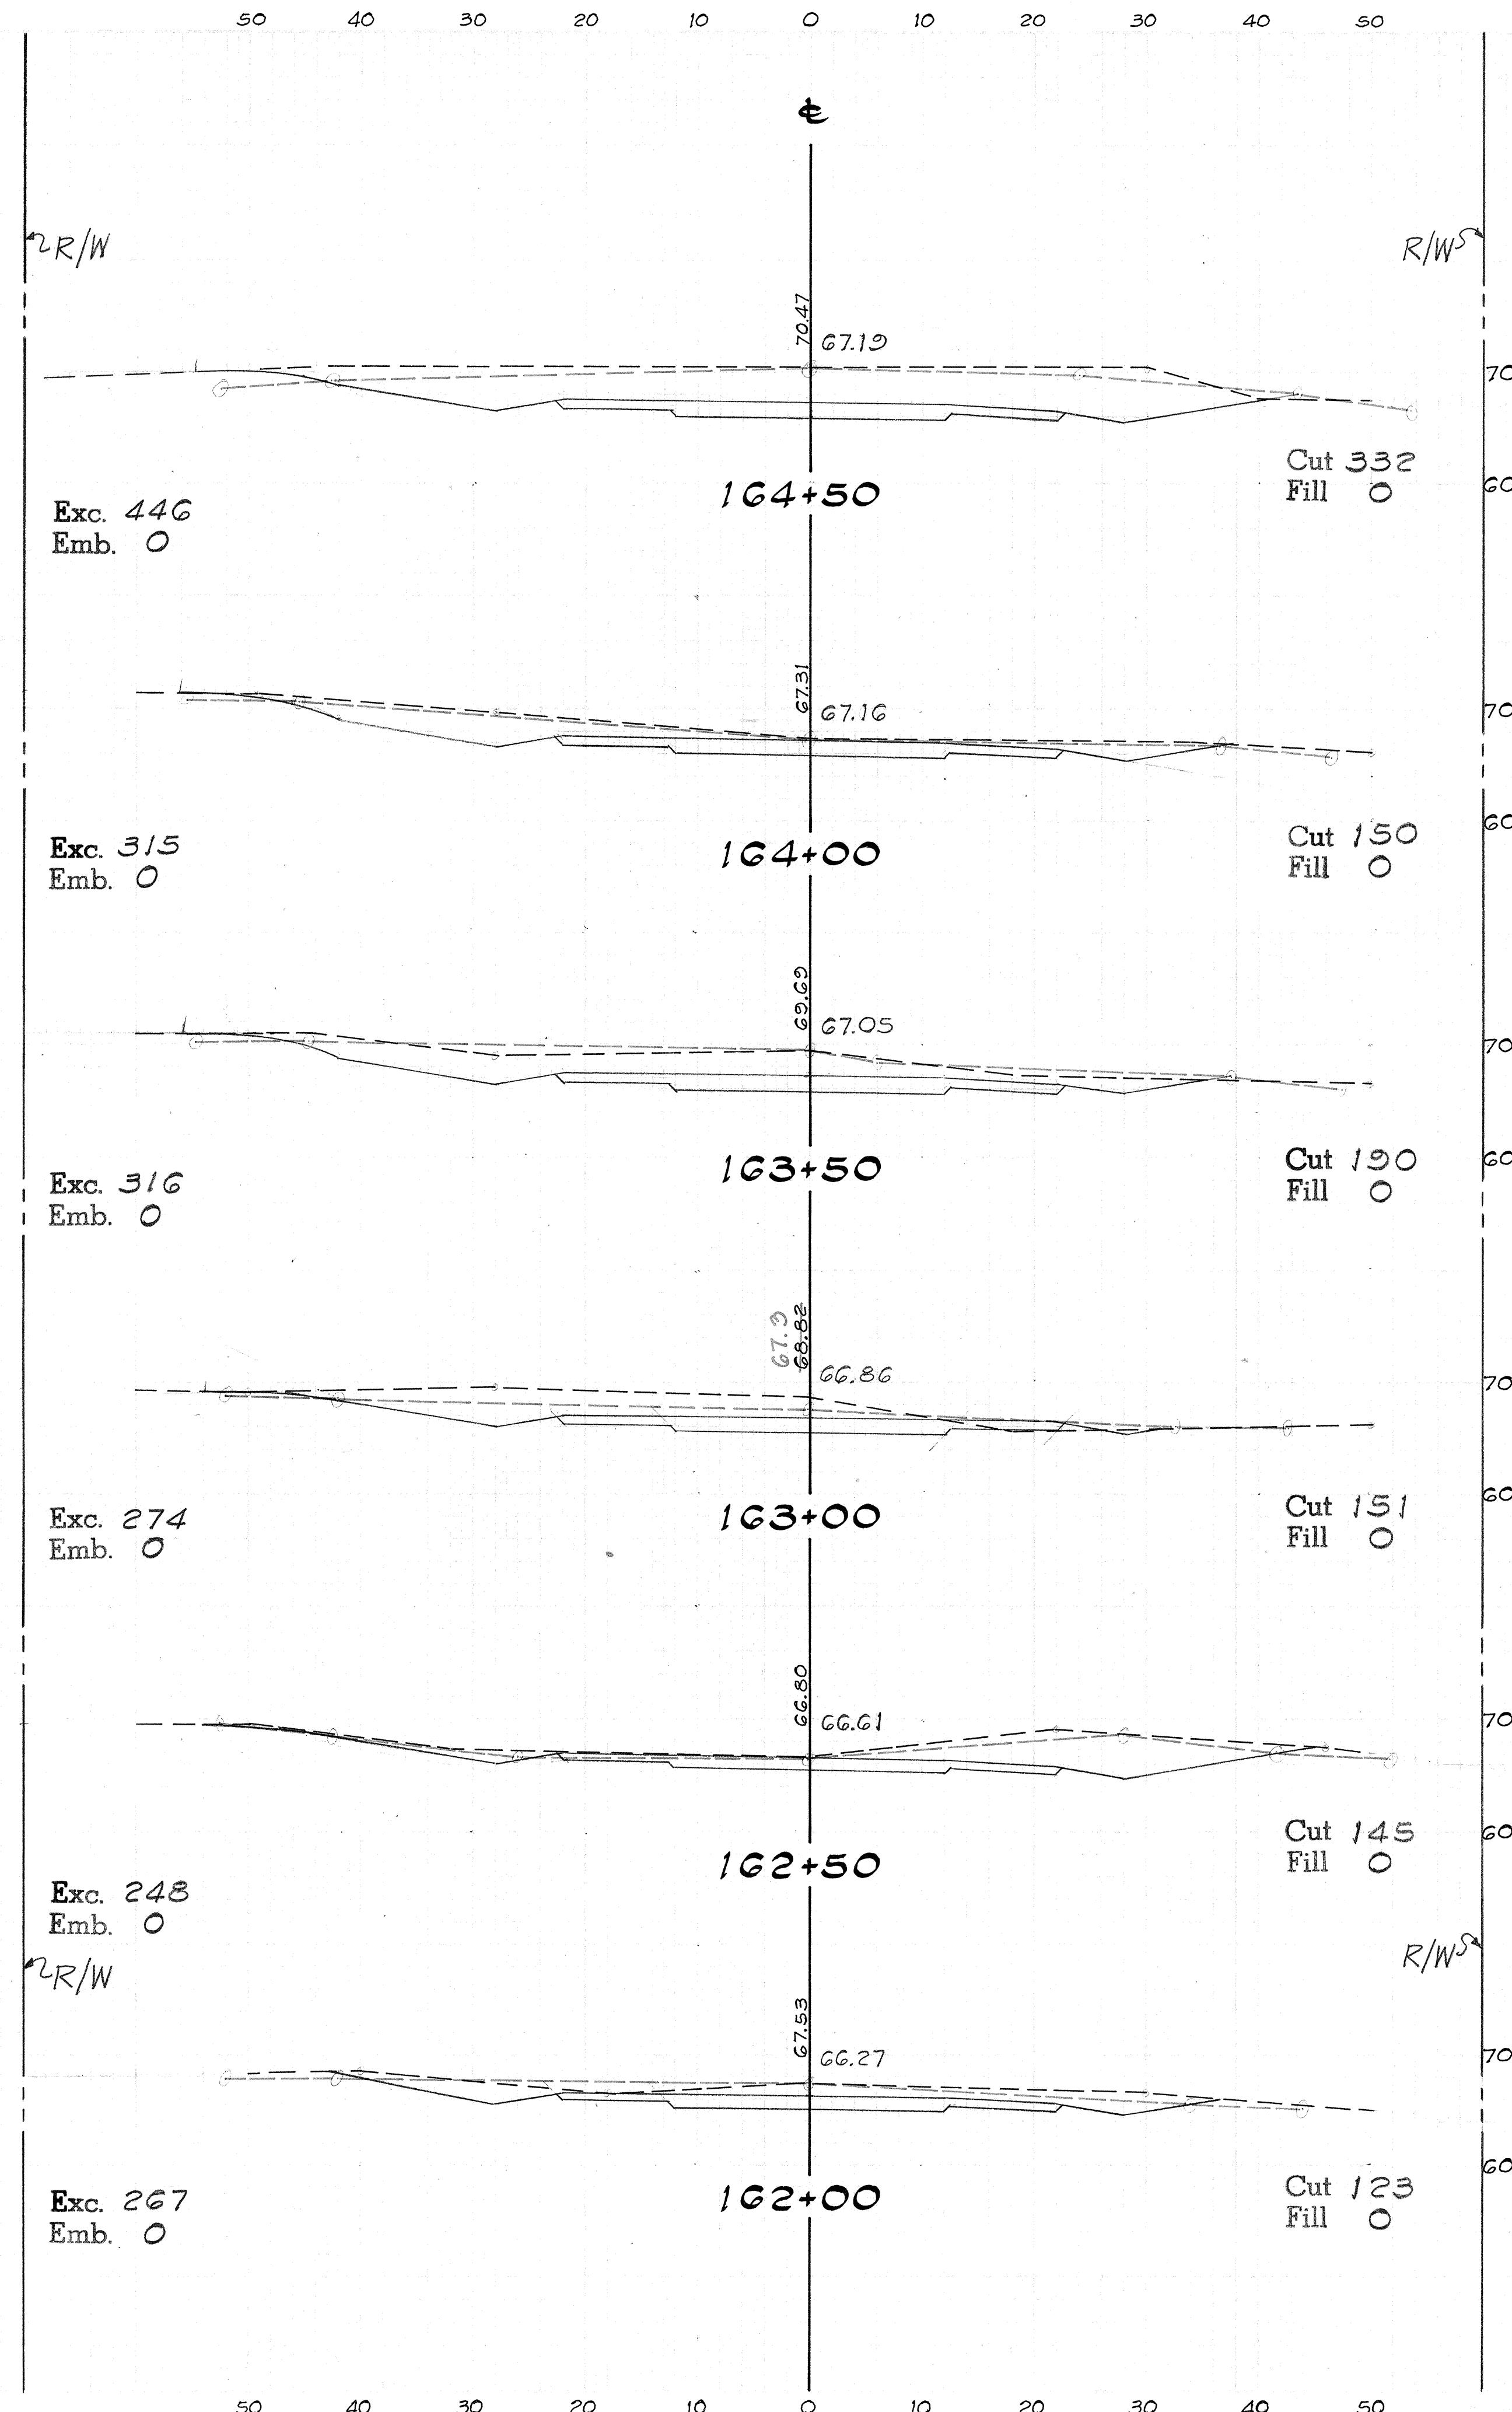



FED. ROAD DIST. NO.	STATE	FED. AID PROJ. NO.	FISCAL YEAR	SHEET NO.	TOTAL SHEETS
HAWAII	HAW.	ER-9(3)	'79	46	89

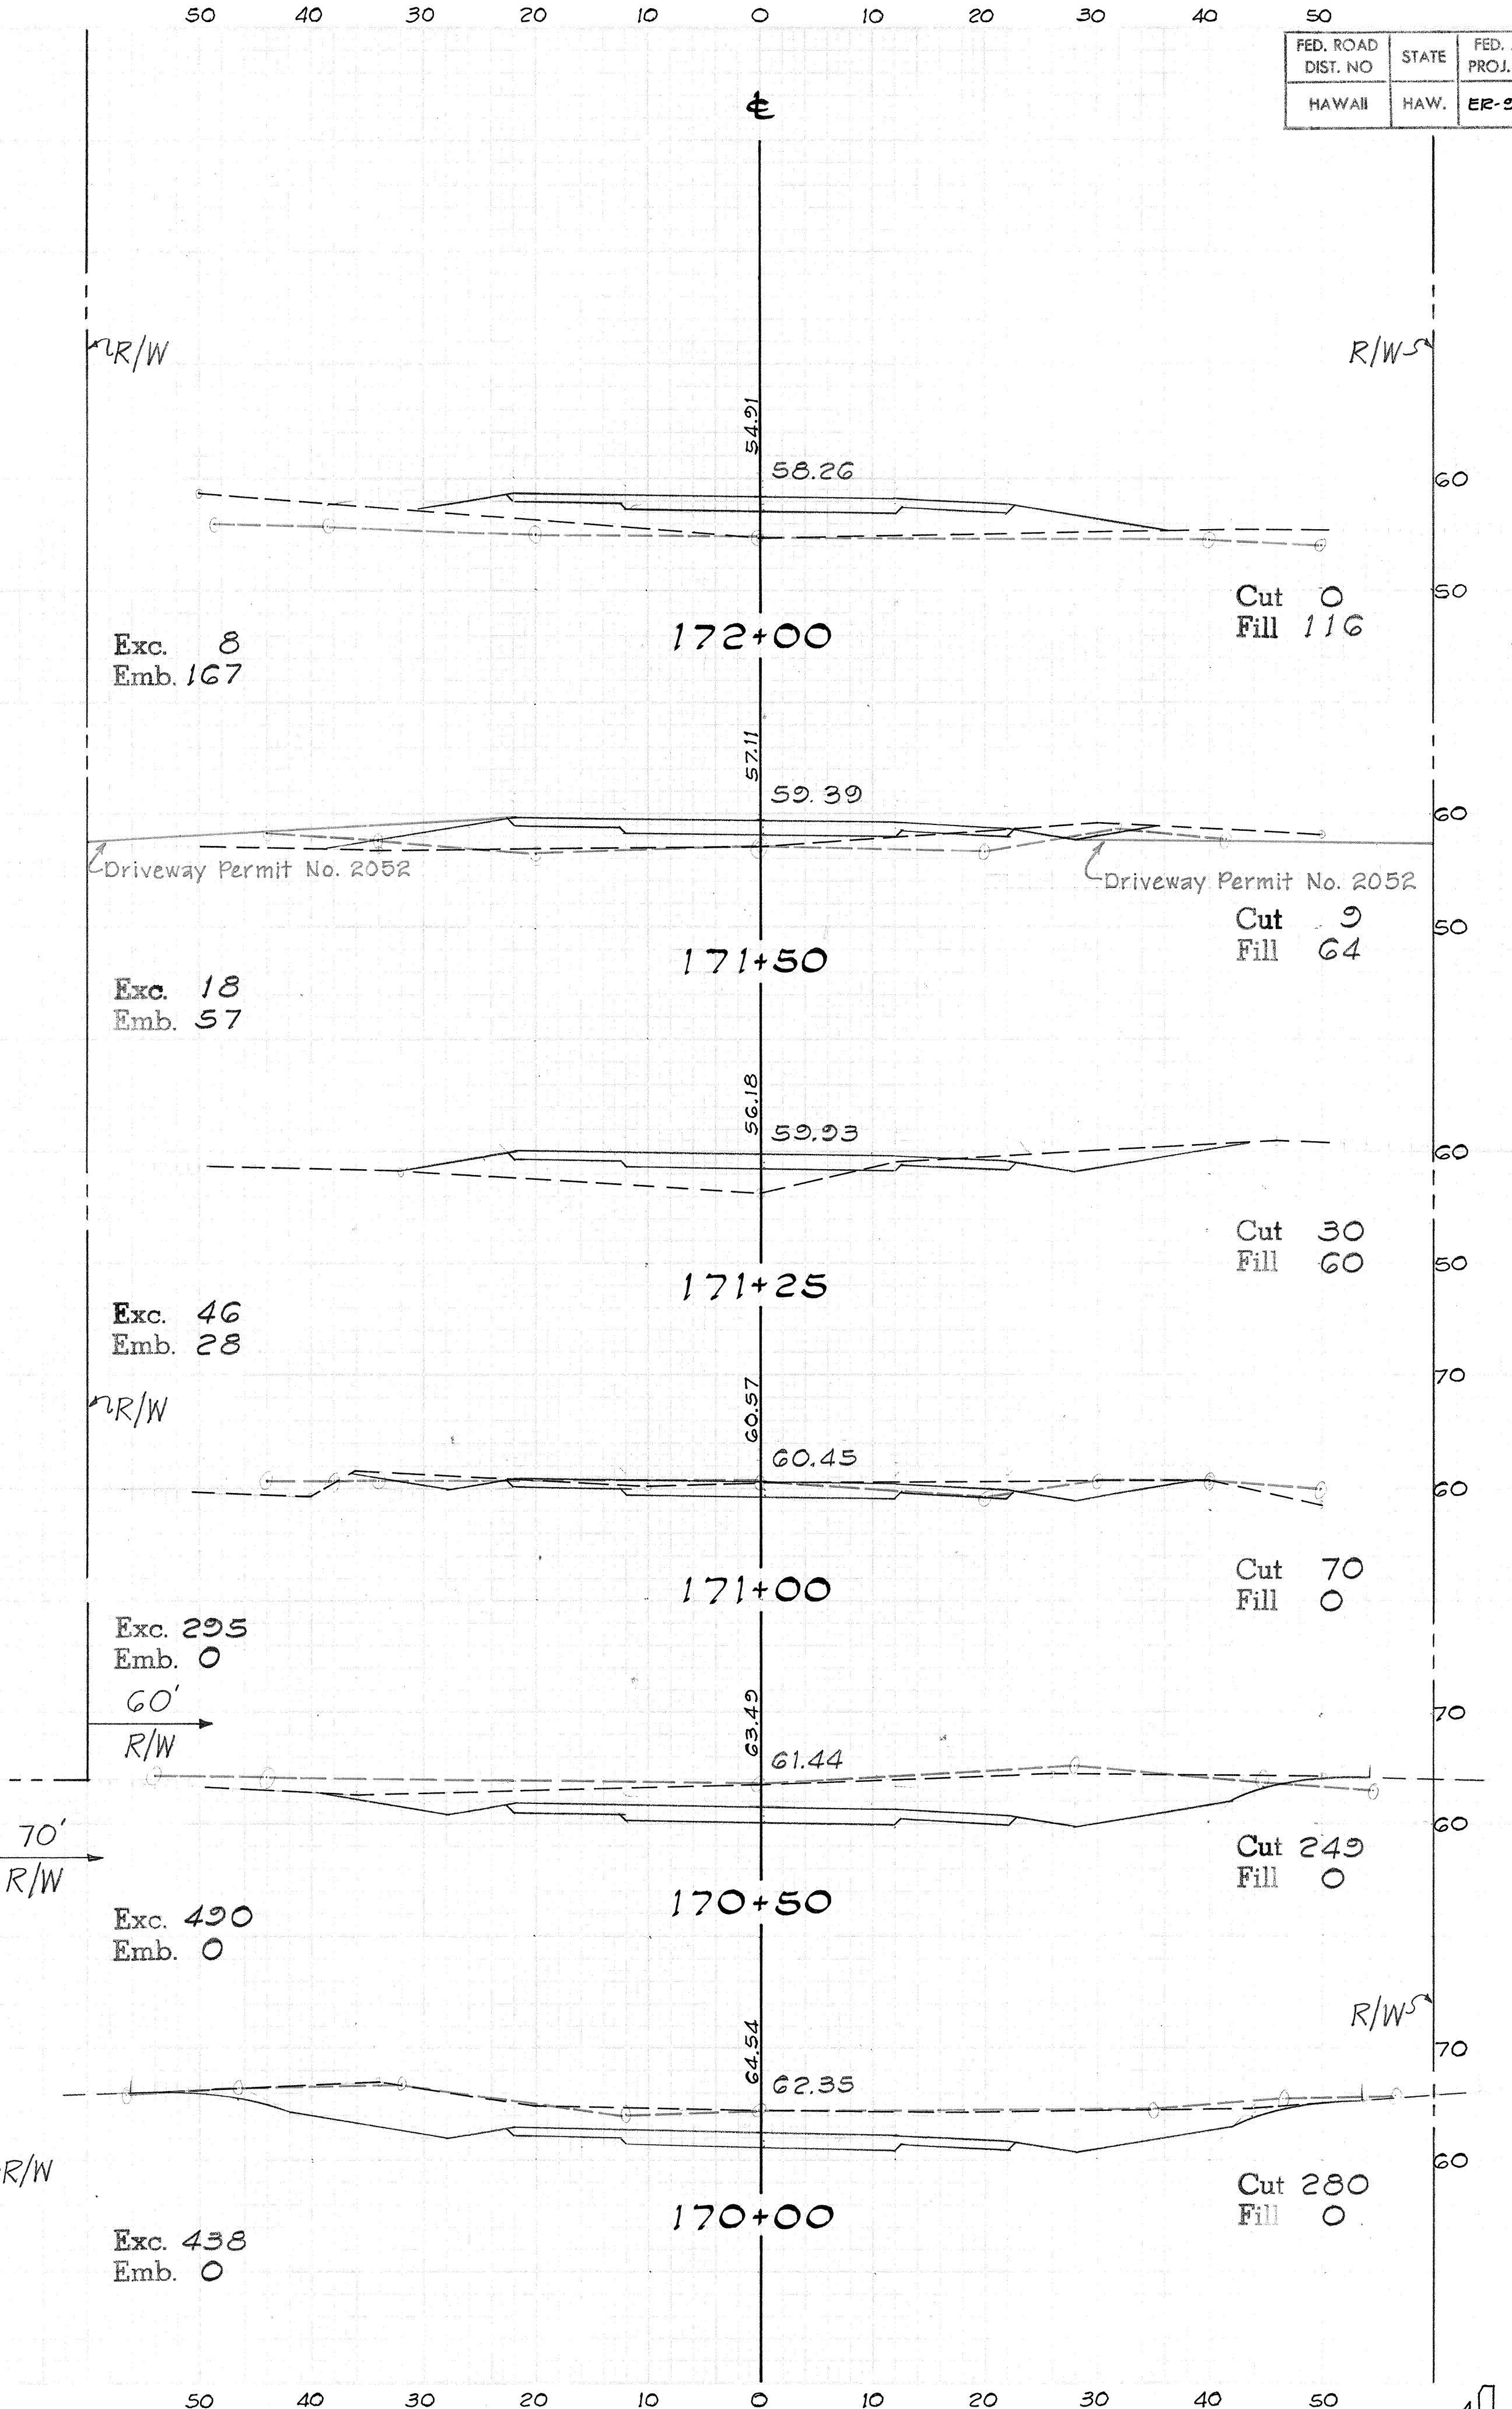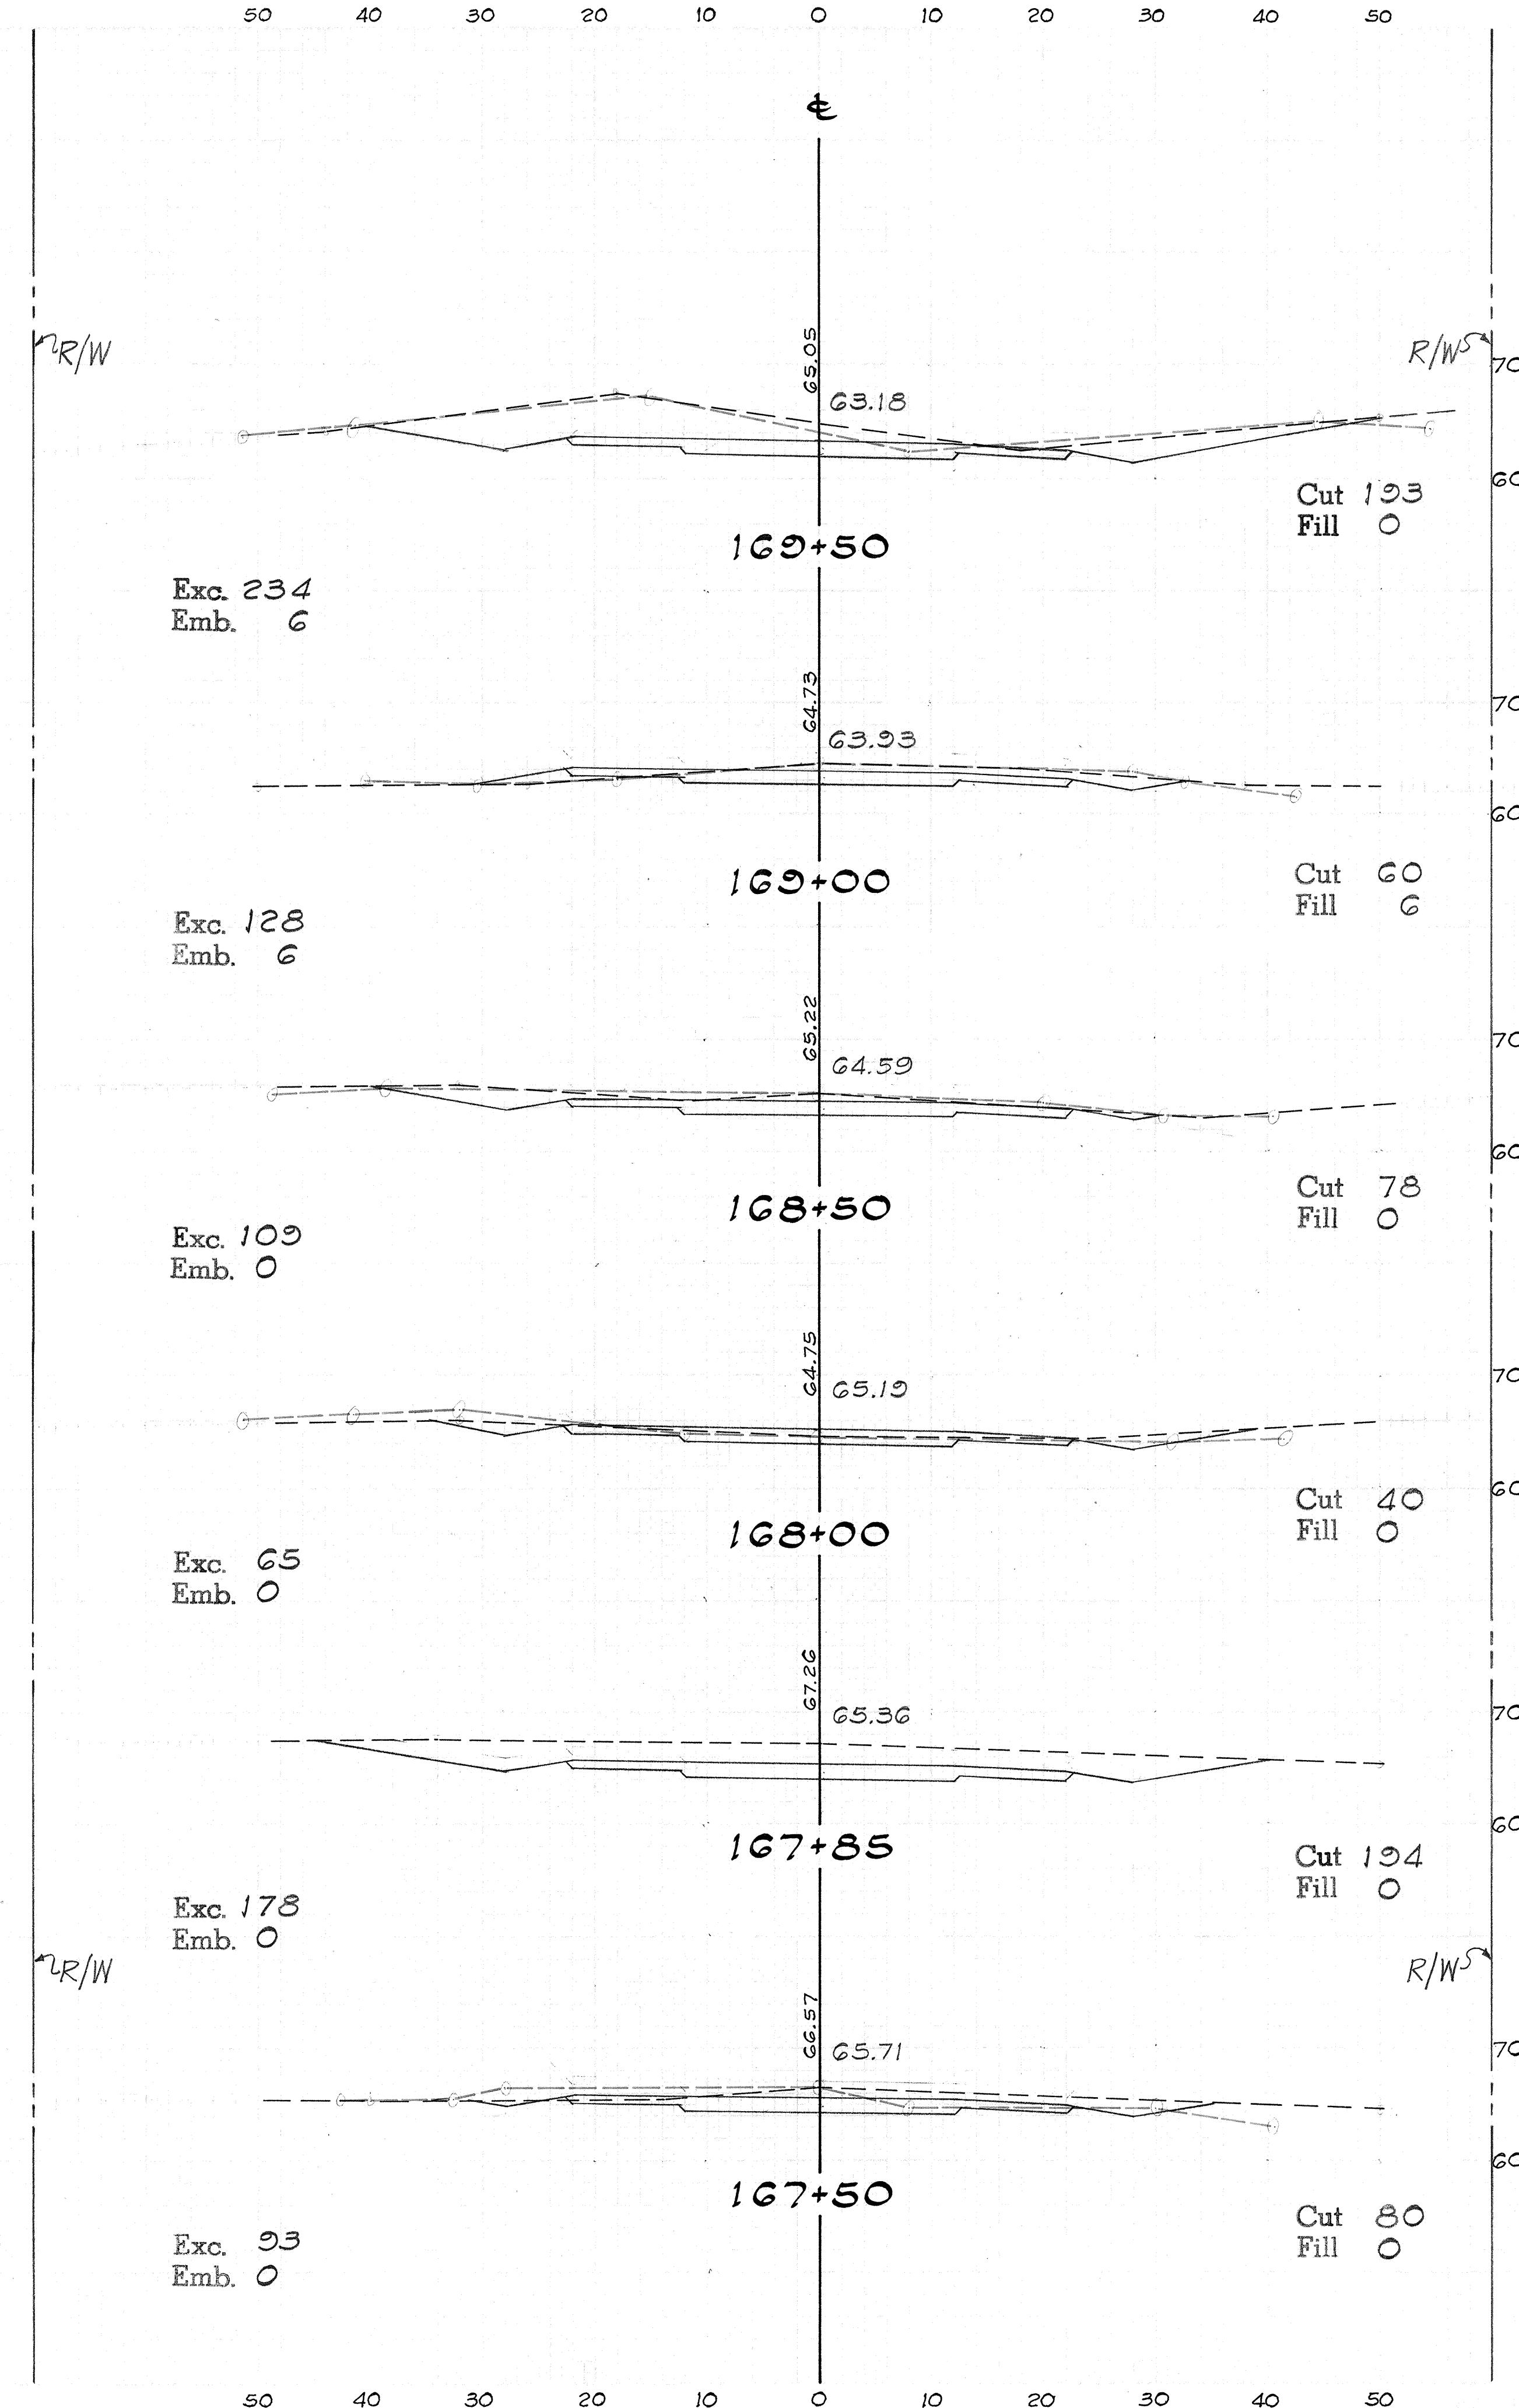

FED. ROAD DIST. NO.	STATE	FED. AID PROJ. NO.	FISCAL YEAR	HEET NO.	TOTAL SHEETS
HAWAII	HAW.	ER-9(3)	'79	47	89

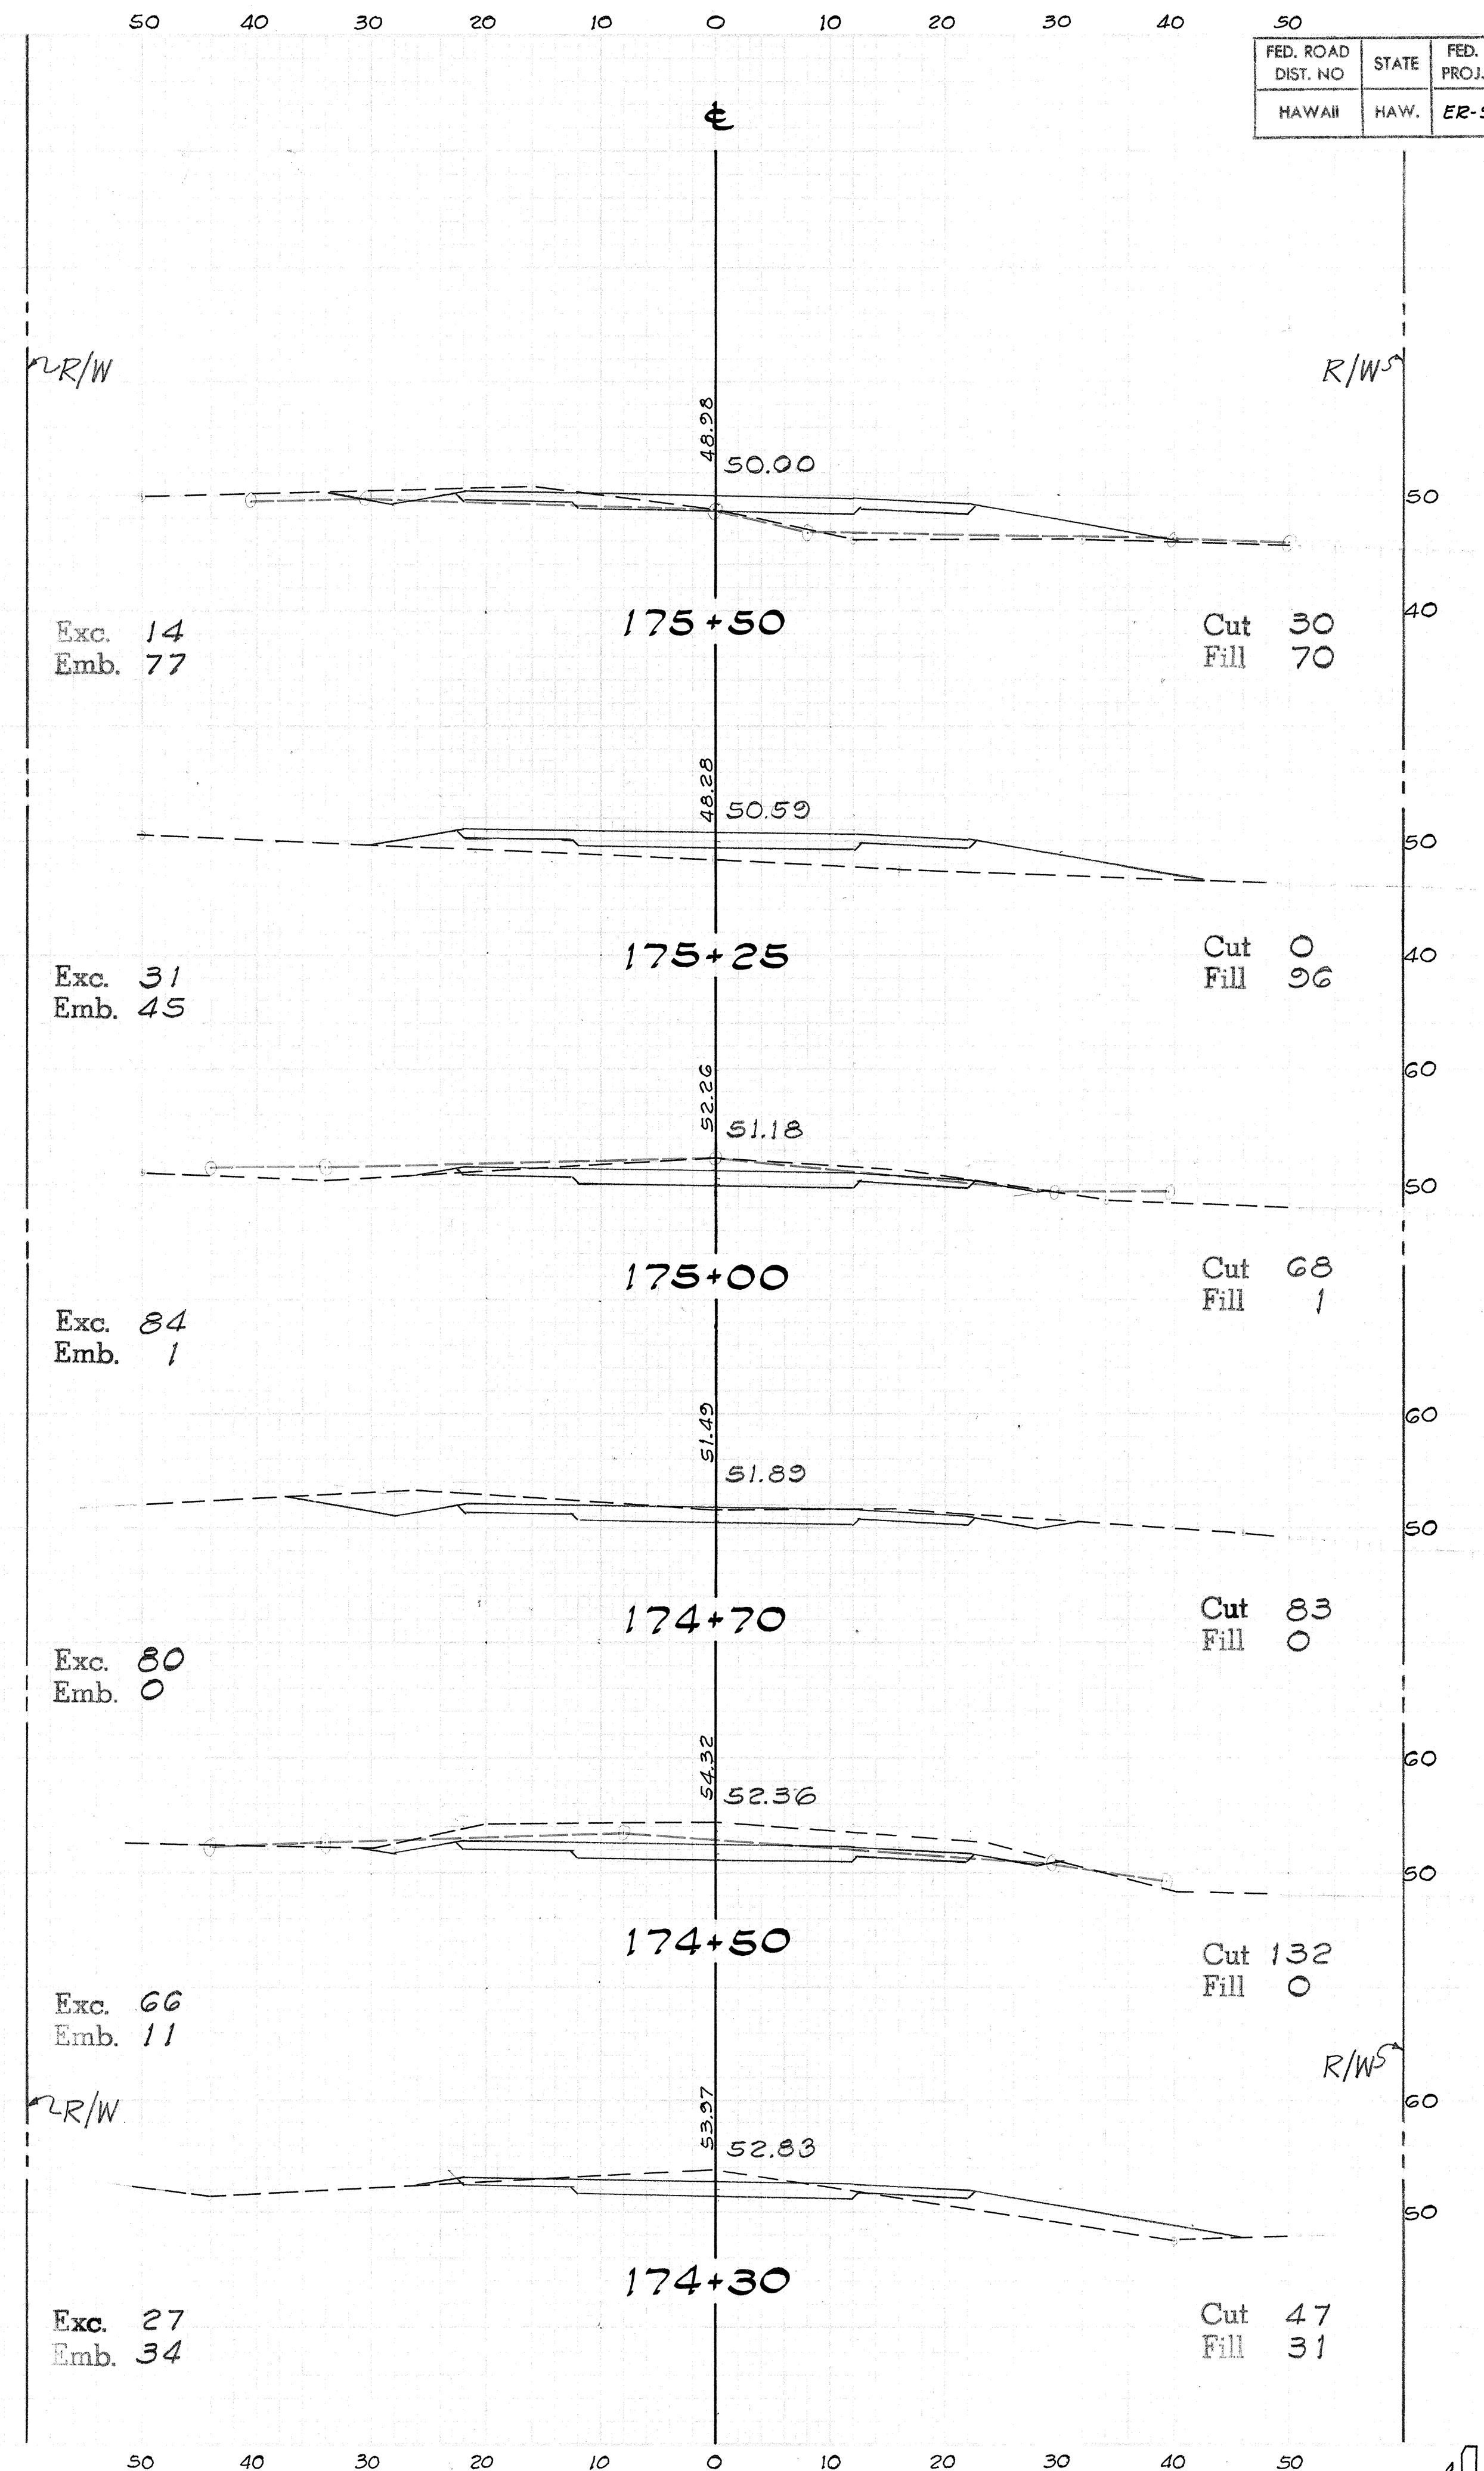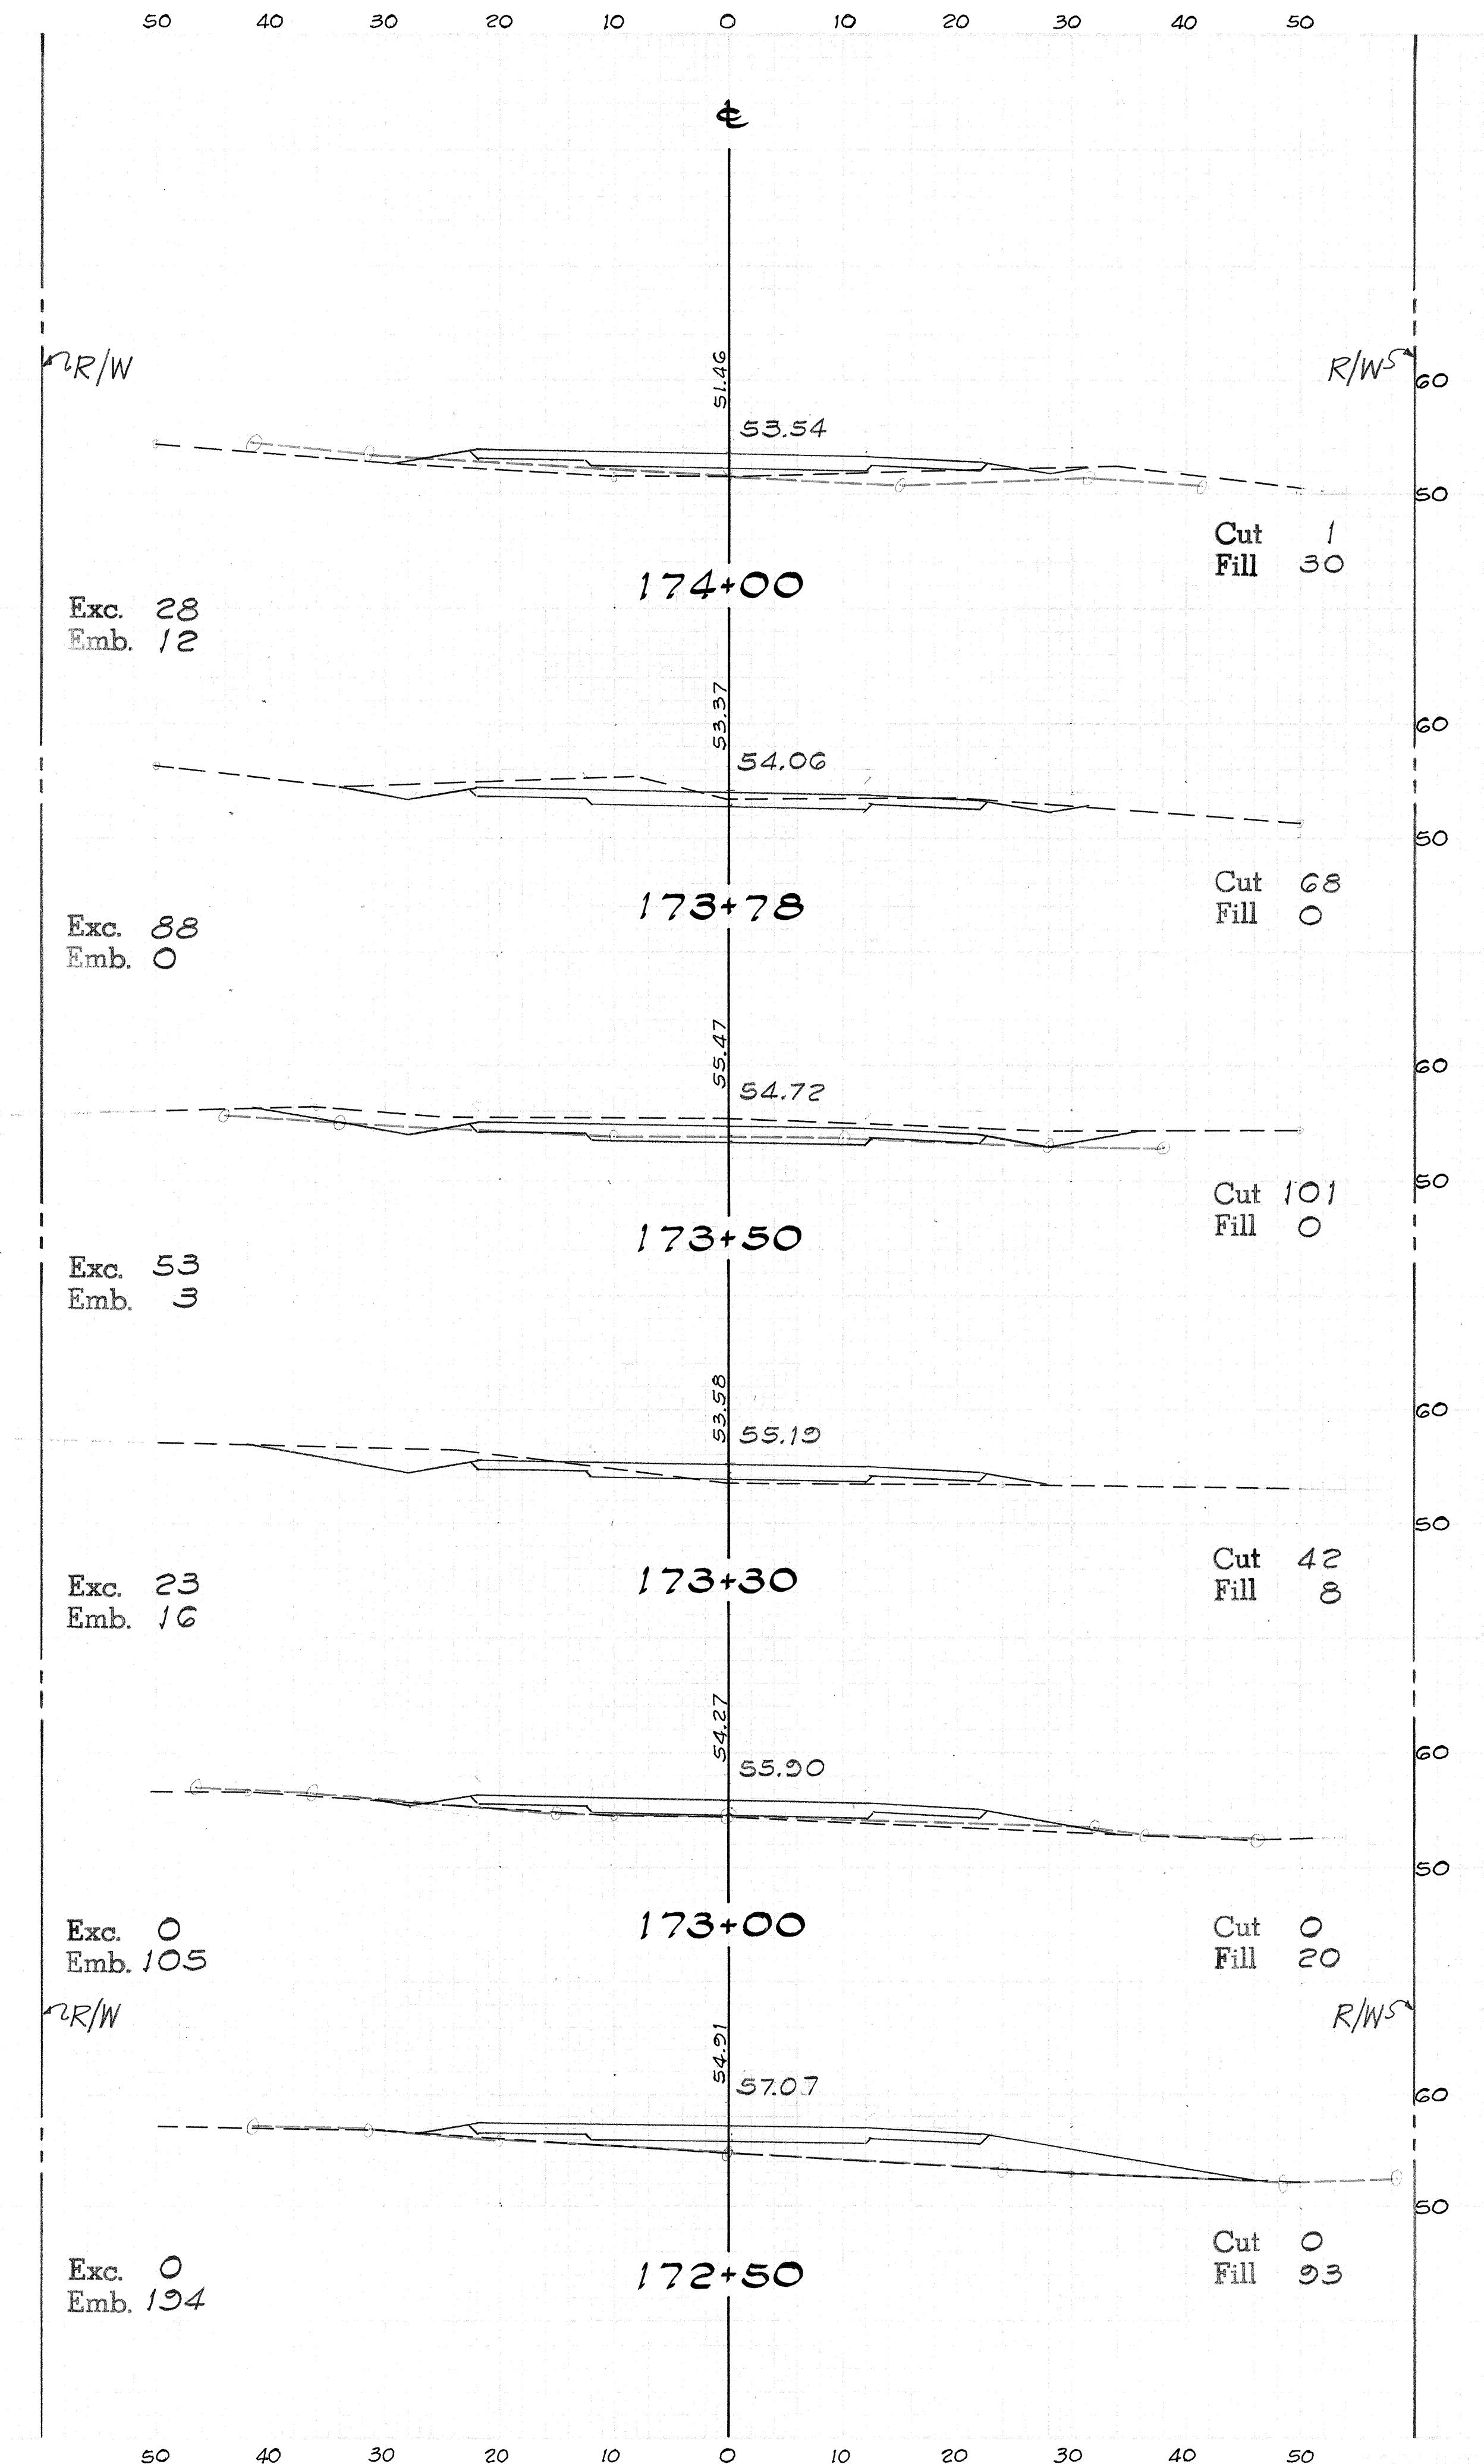



FED. ROAD DIST. PROJ.	STATE	FED. AID PROJ. NO.	FISCAL YEAR	SHEET NO.	TOTAL SHEETS
HAWAII	NAW.	ER-9(3)	'79	48	89

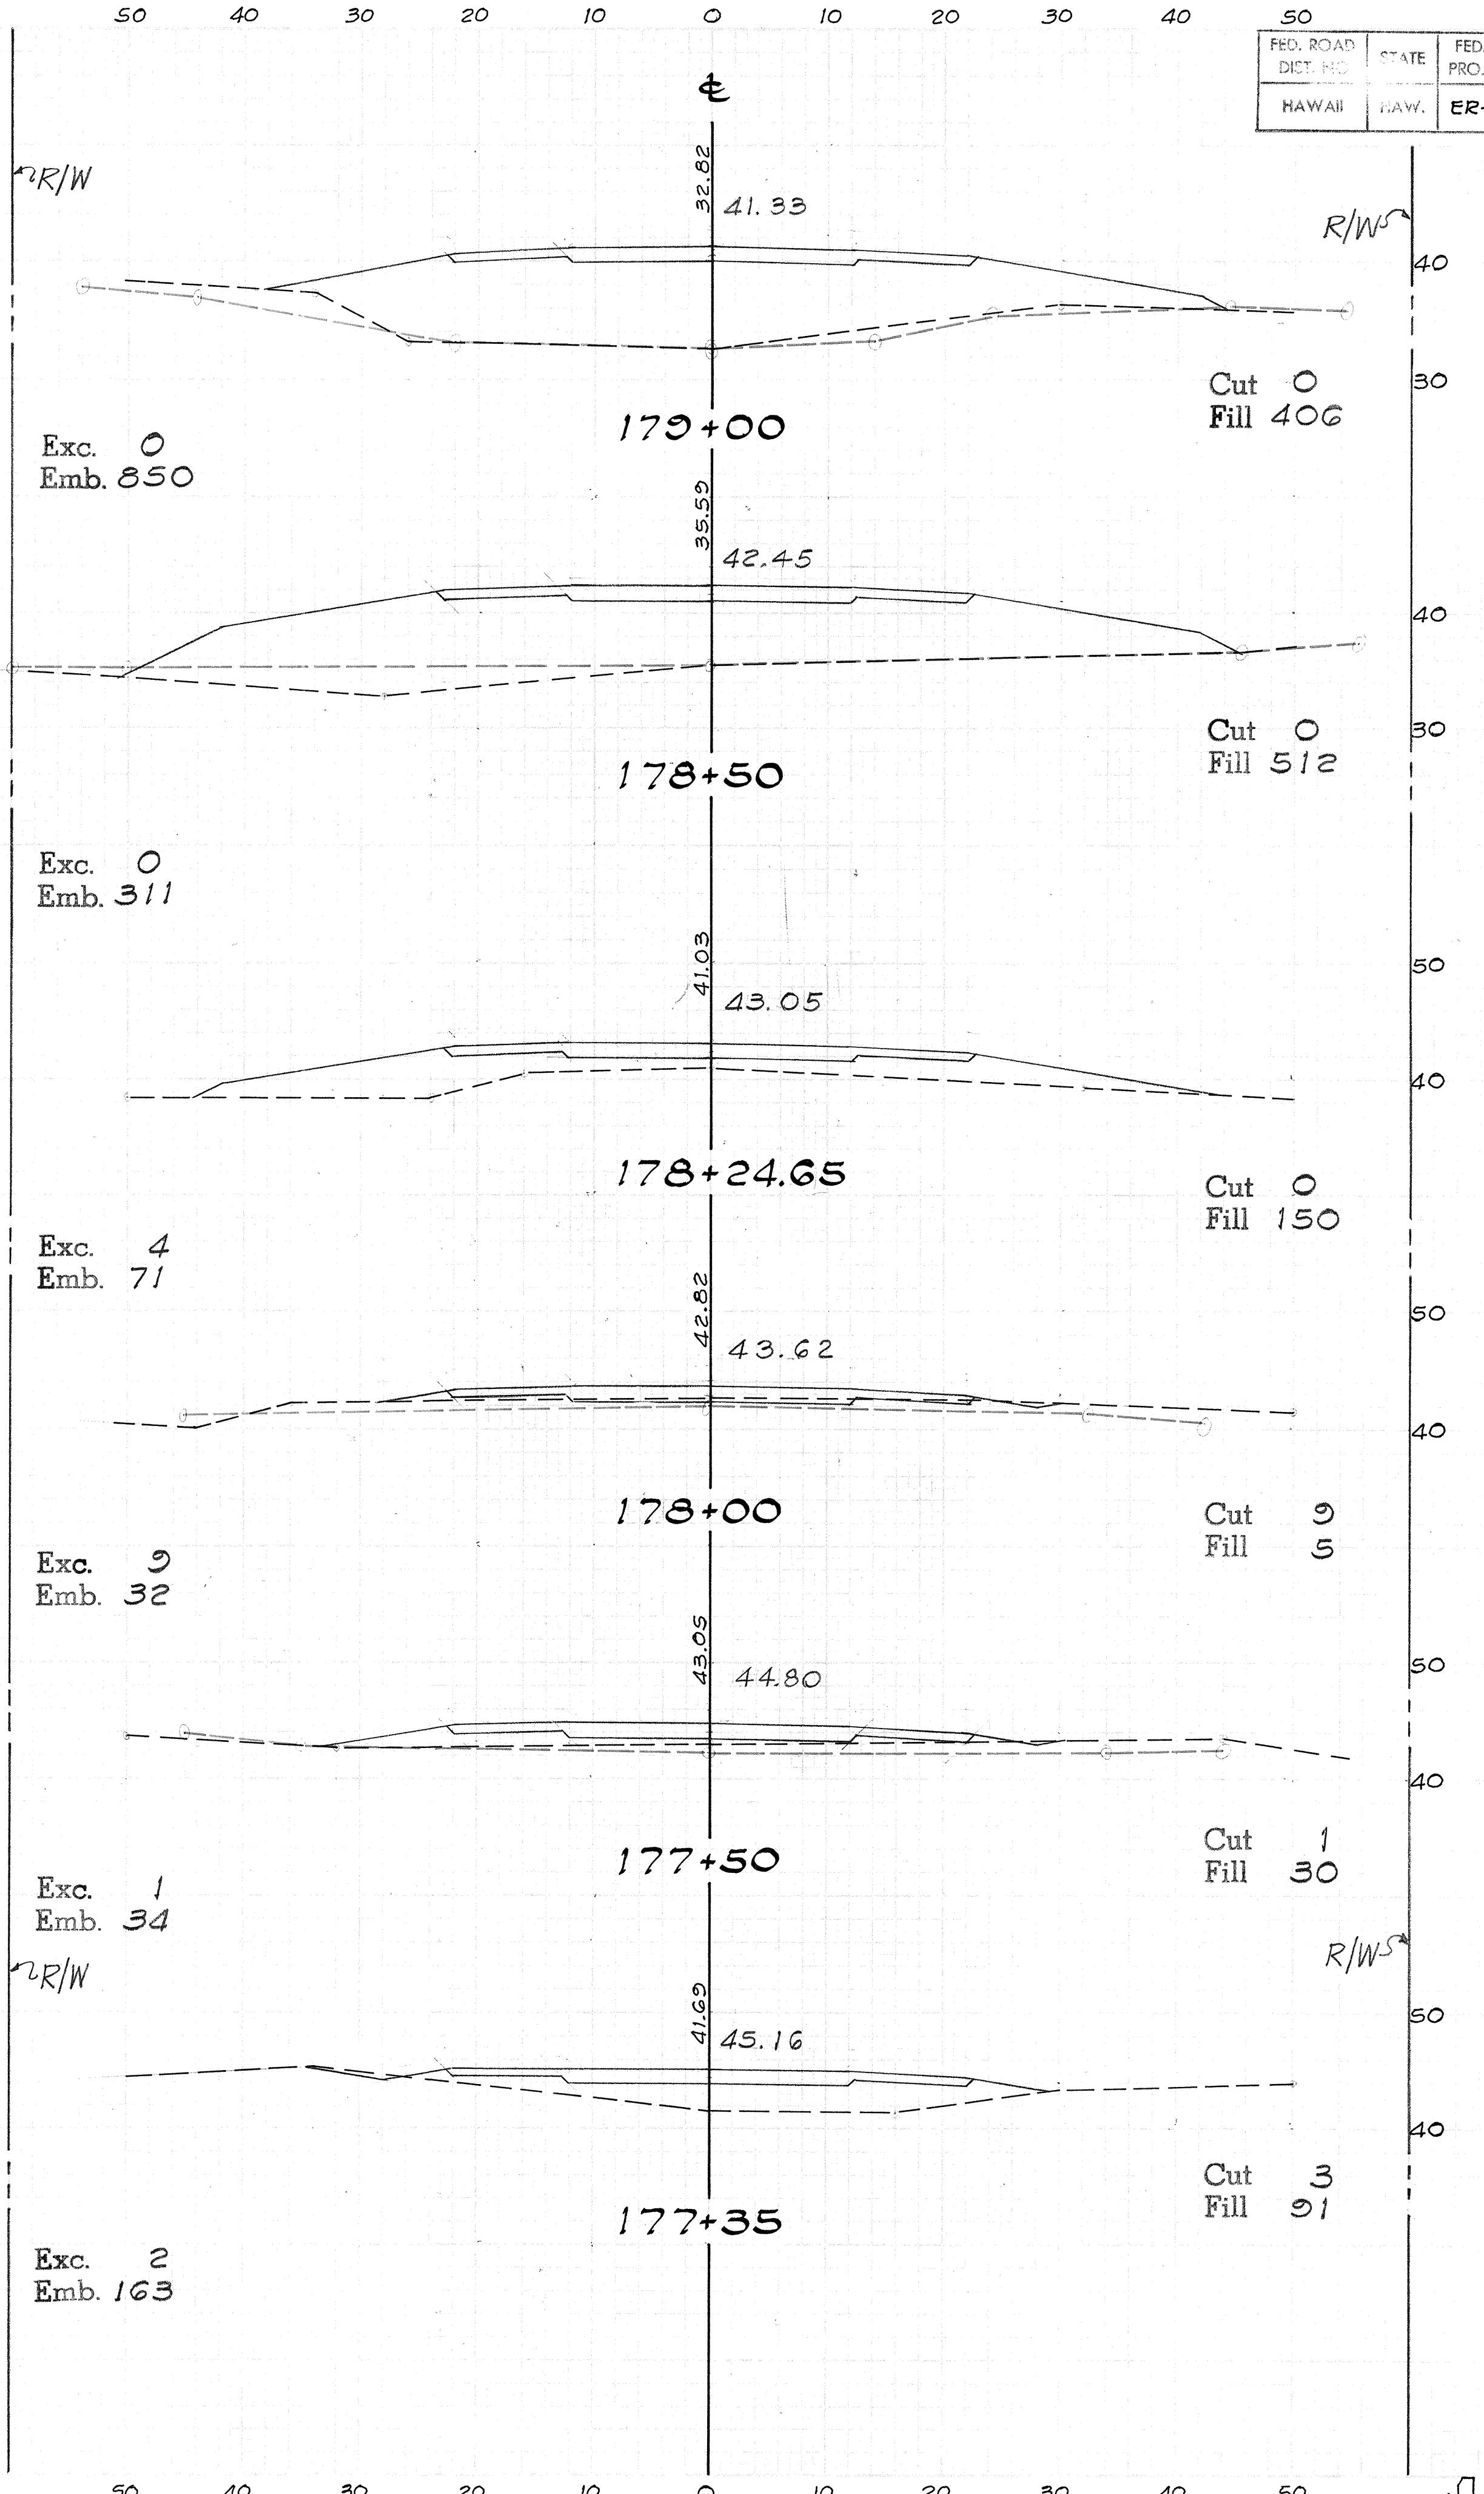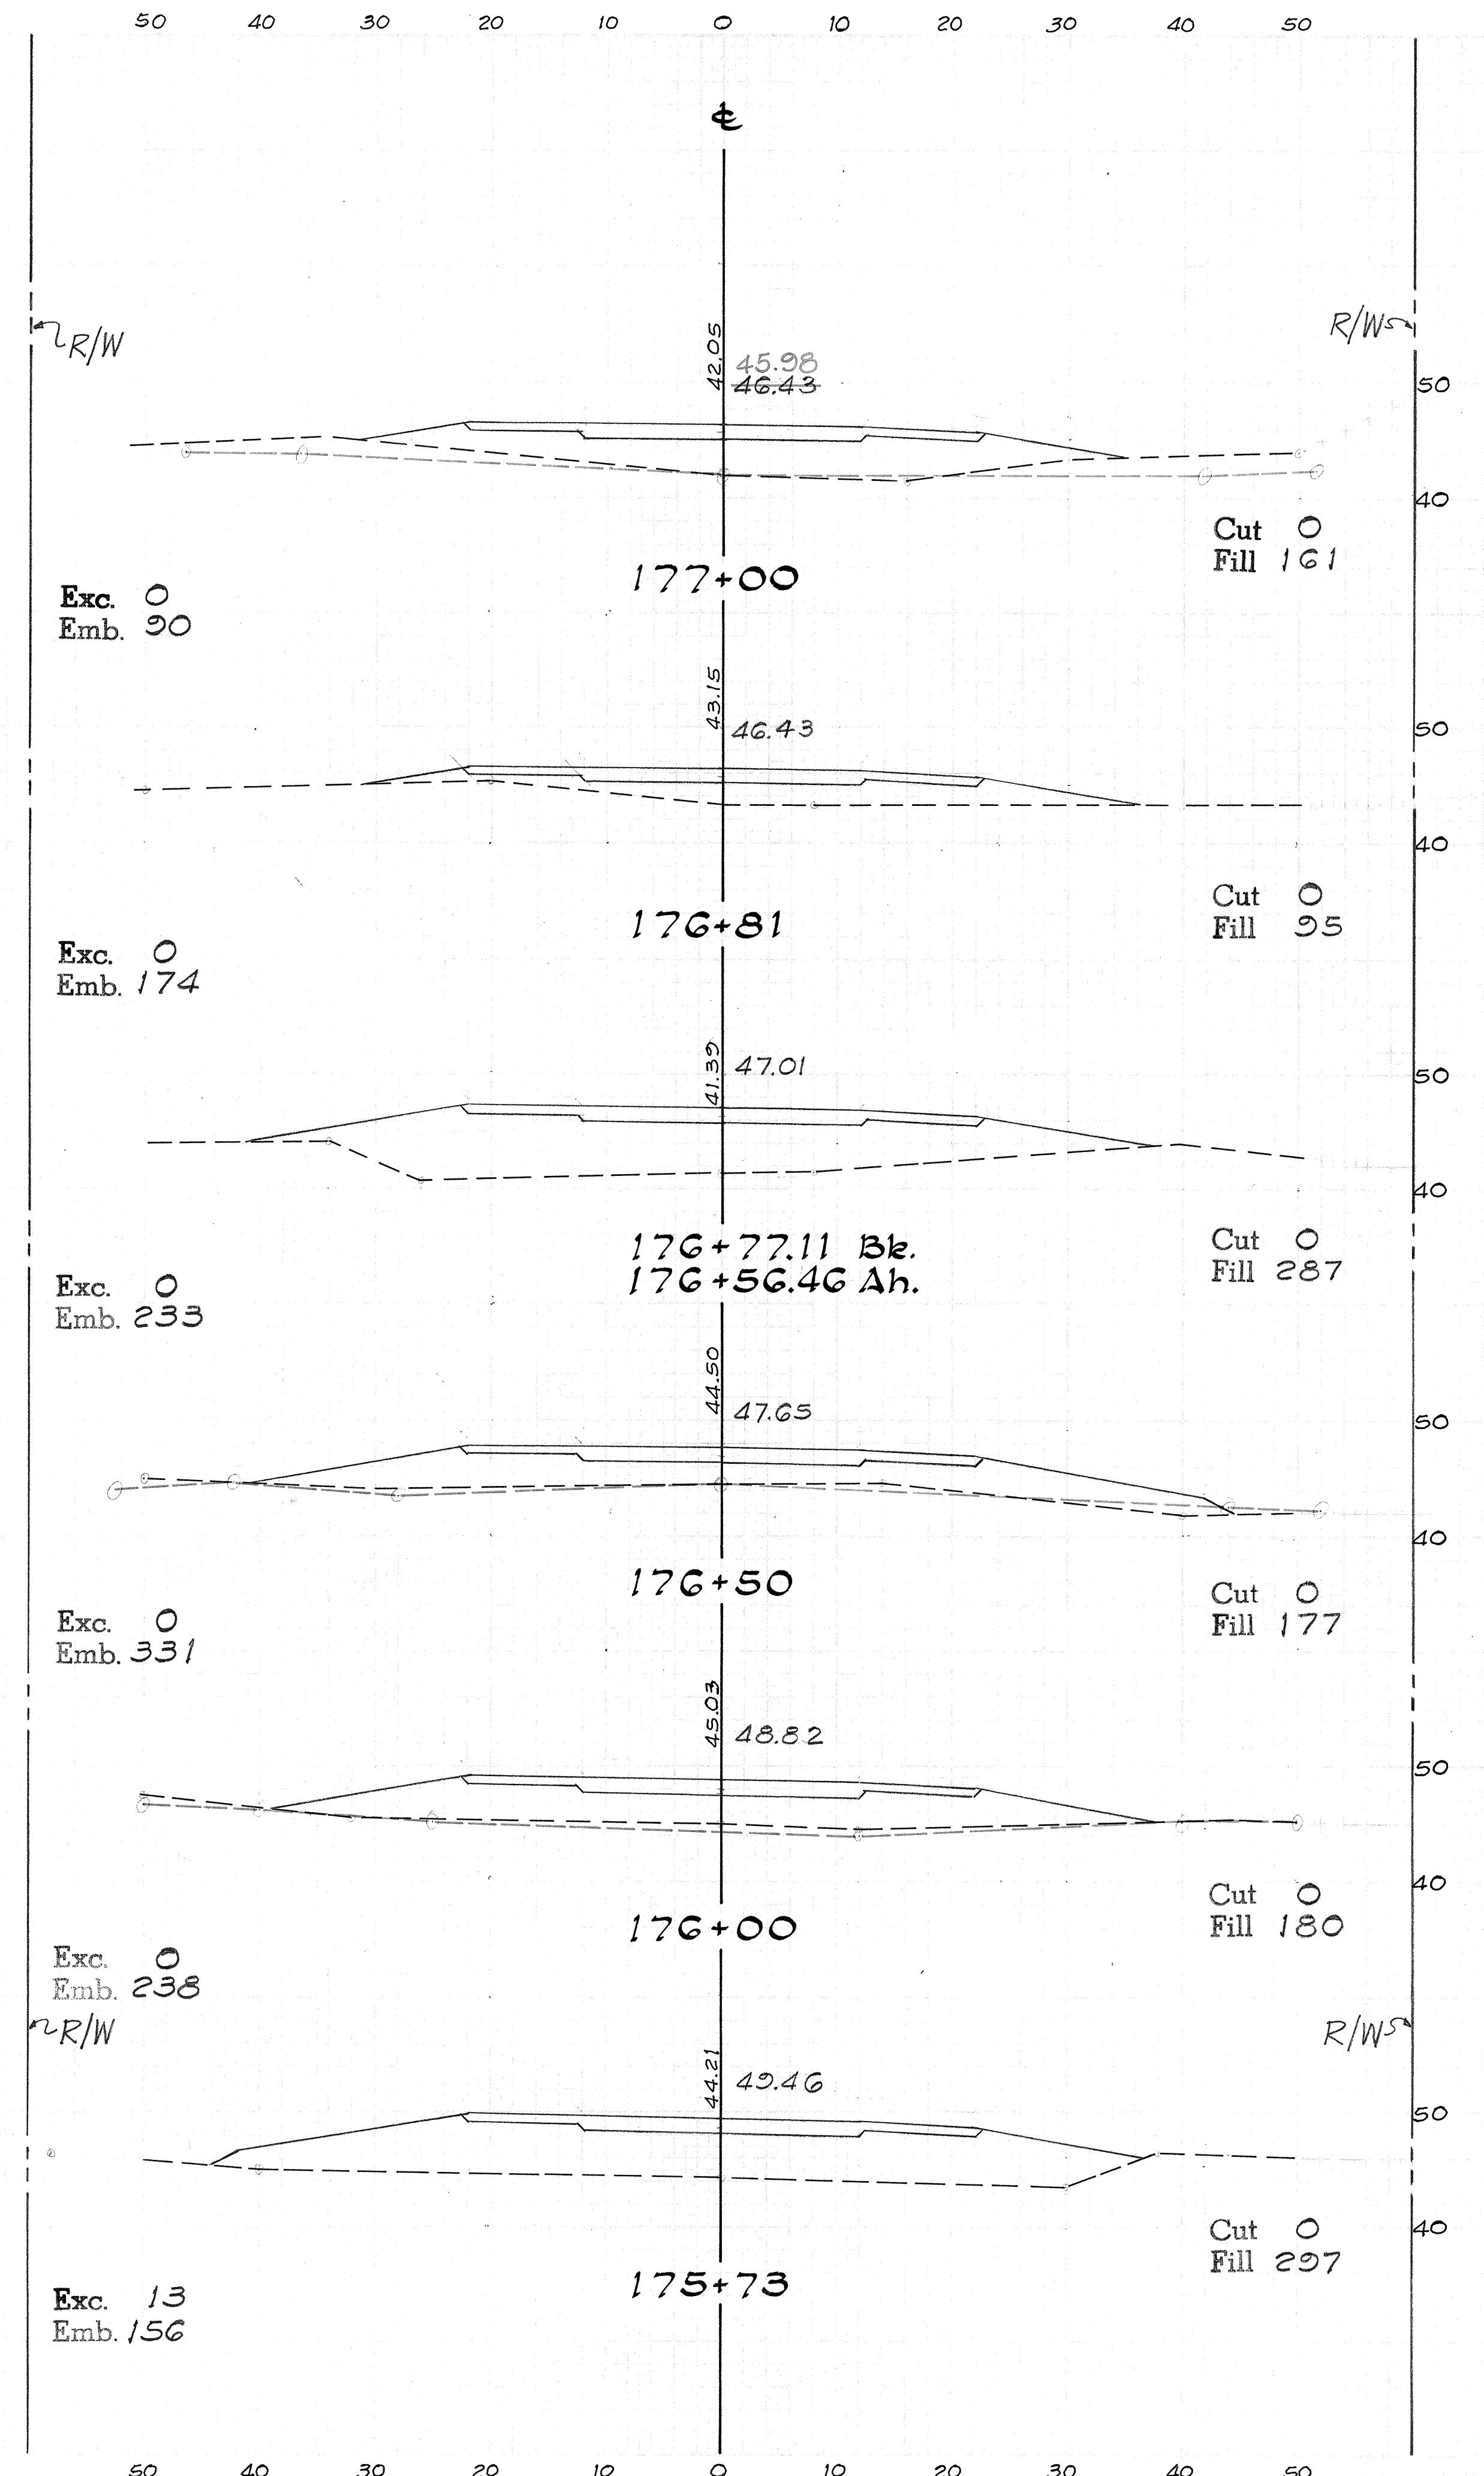


FED. ROAD DIST. NO.	STATE	FED. AID PROJ. NO.	FISCAL YEAR	SHEET NO.	TOTAL SHEETS
HAWAII	HAW.	ER-9(3)	'79	47	89

FINAL SURVEYED  
PLOTTED  
NOTE BOOK NUMBER  
AREAS CHECKED

ORIGINAL SURVEYED  
SURVEYED  
BORED & PLOTTED  
AREAS CHECKED

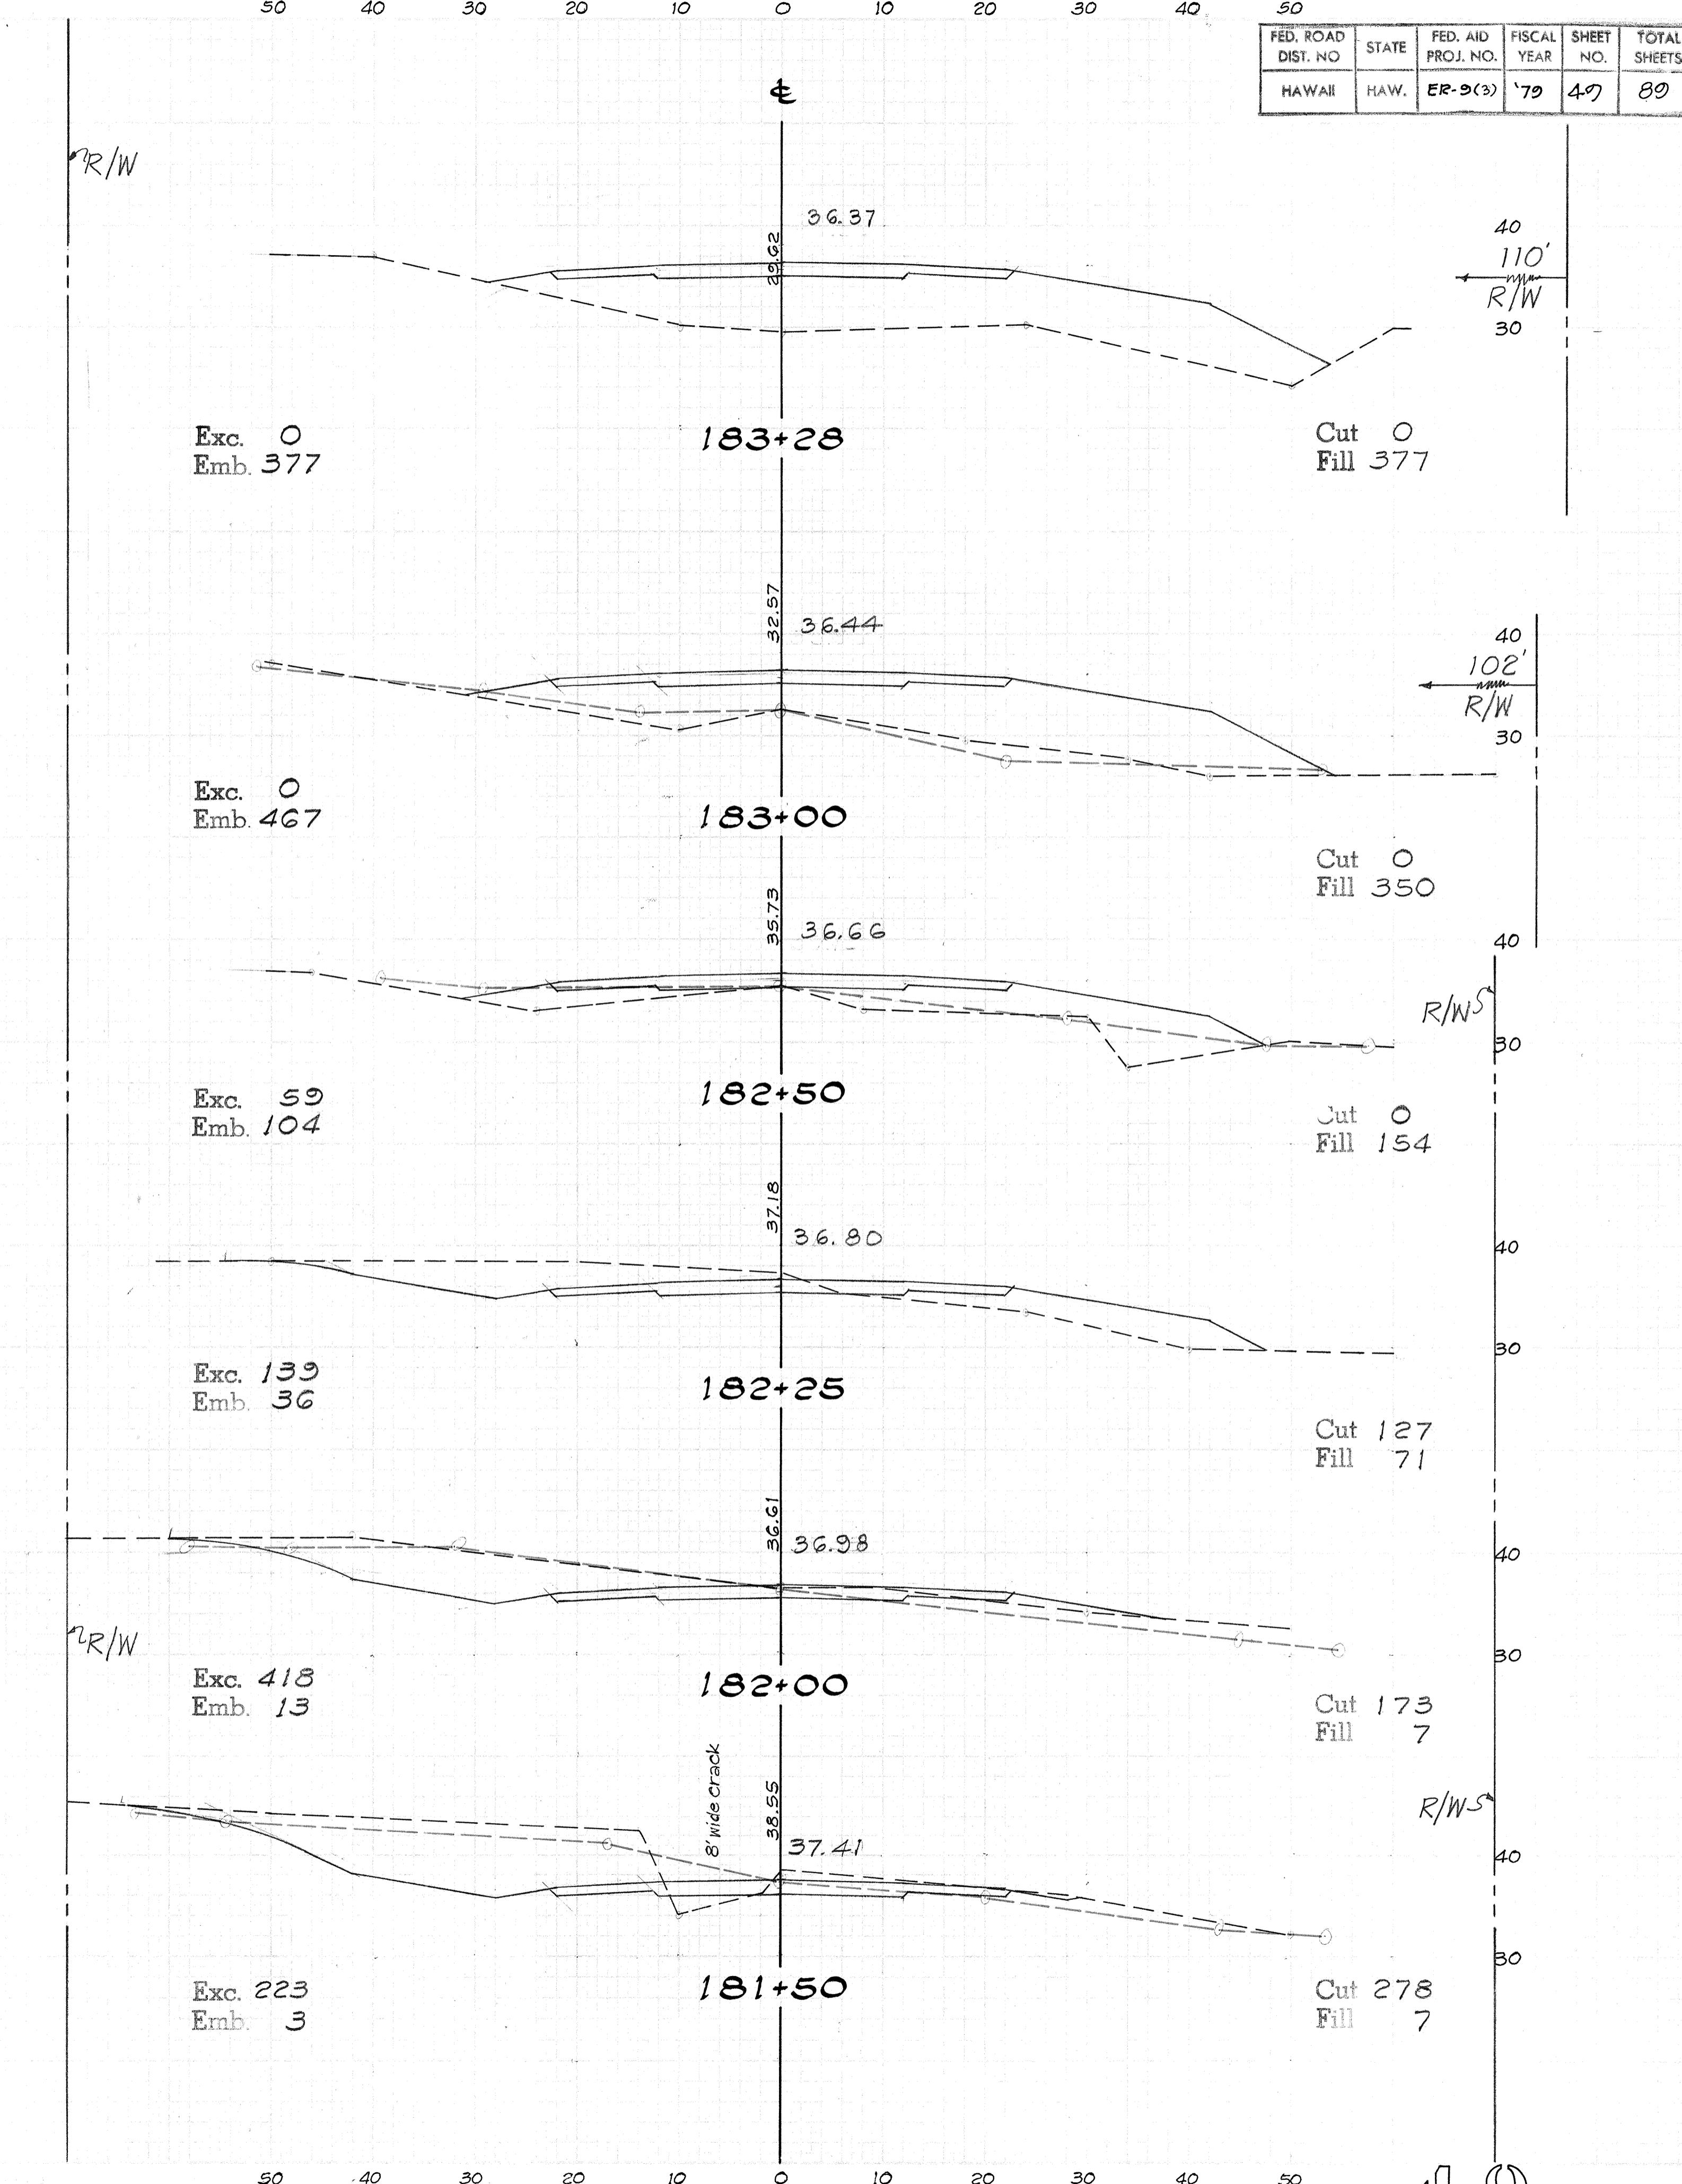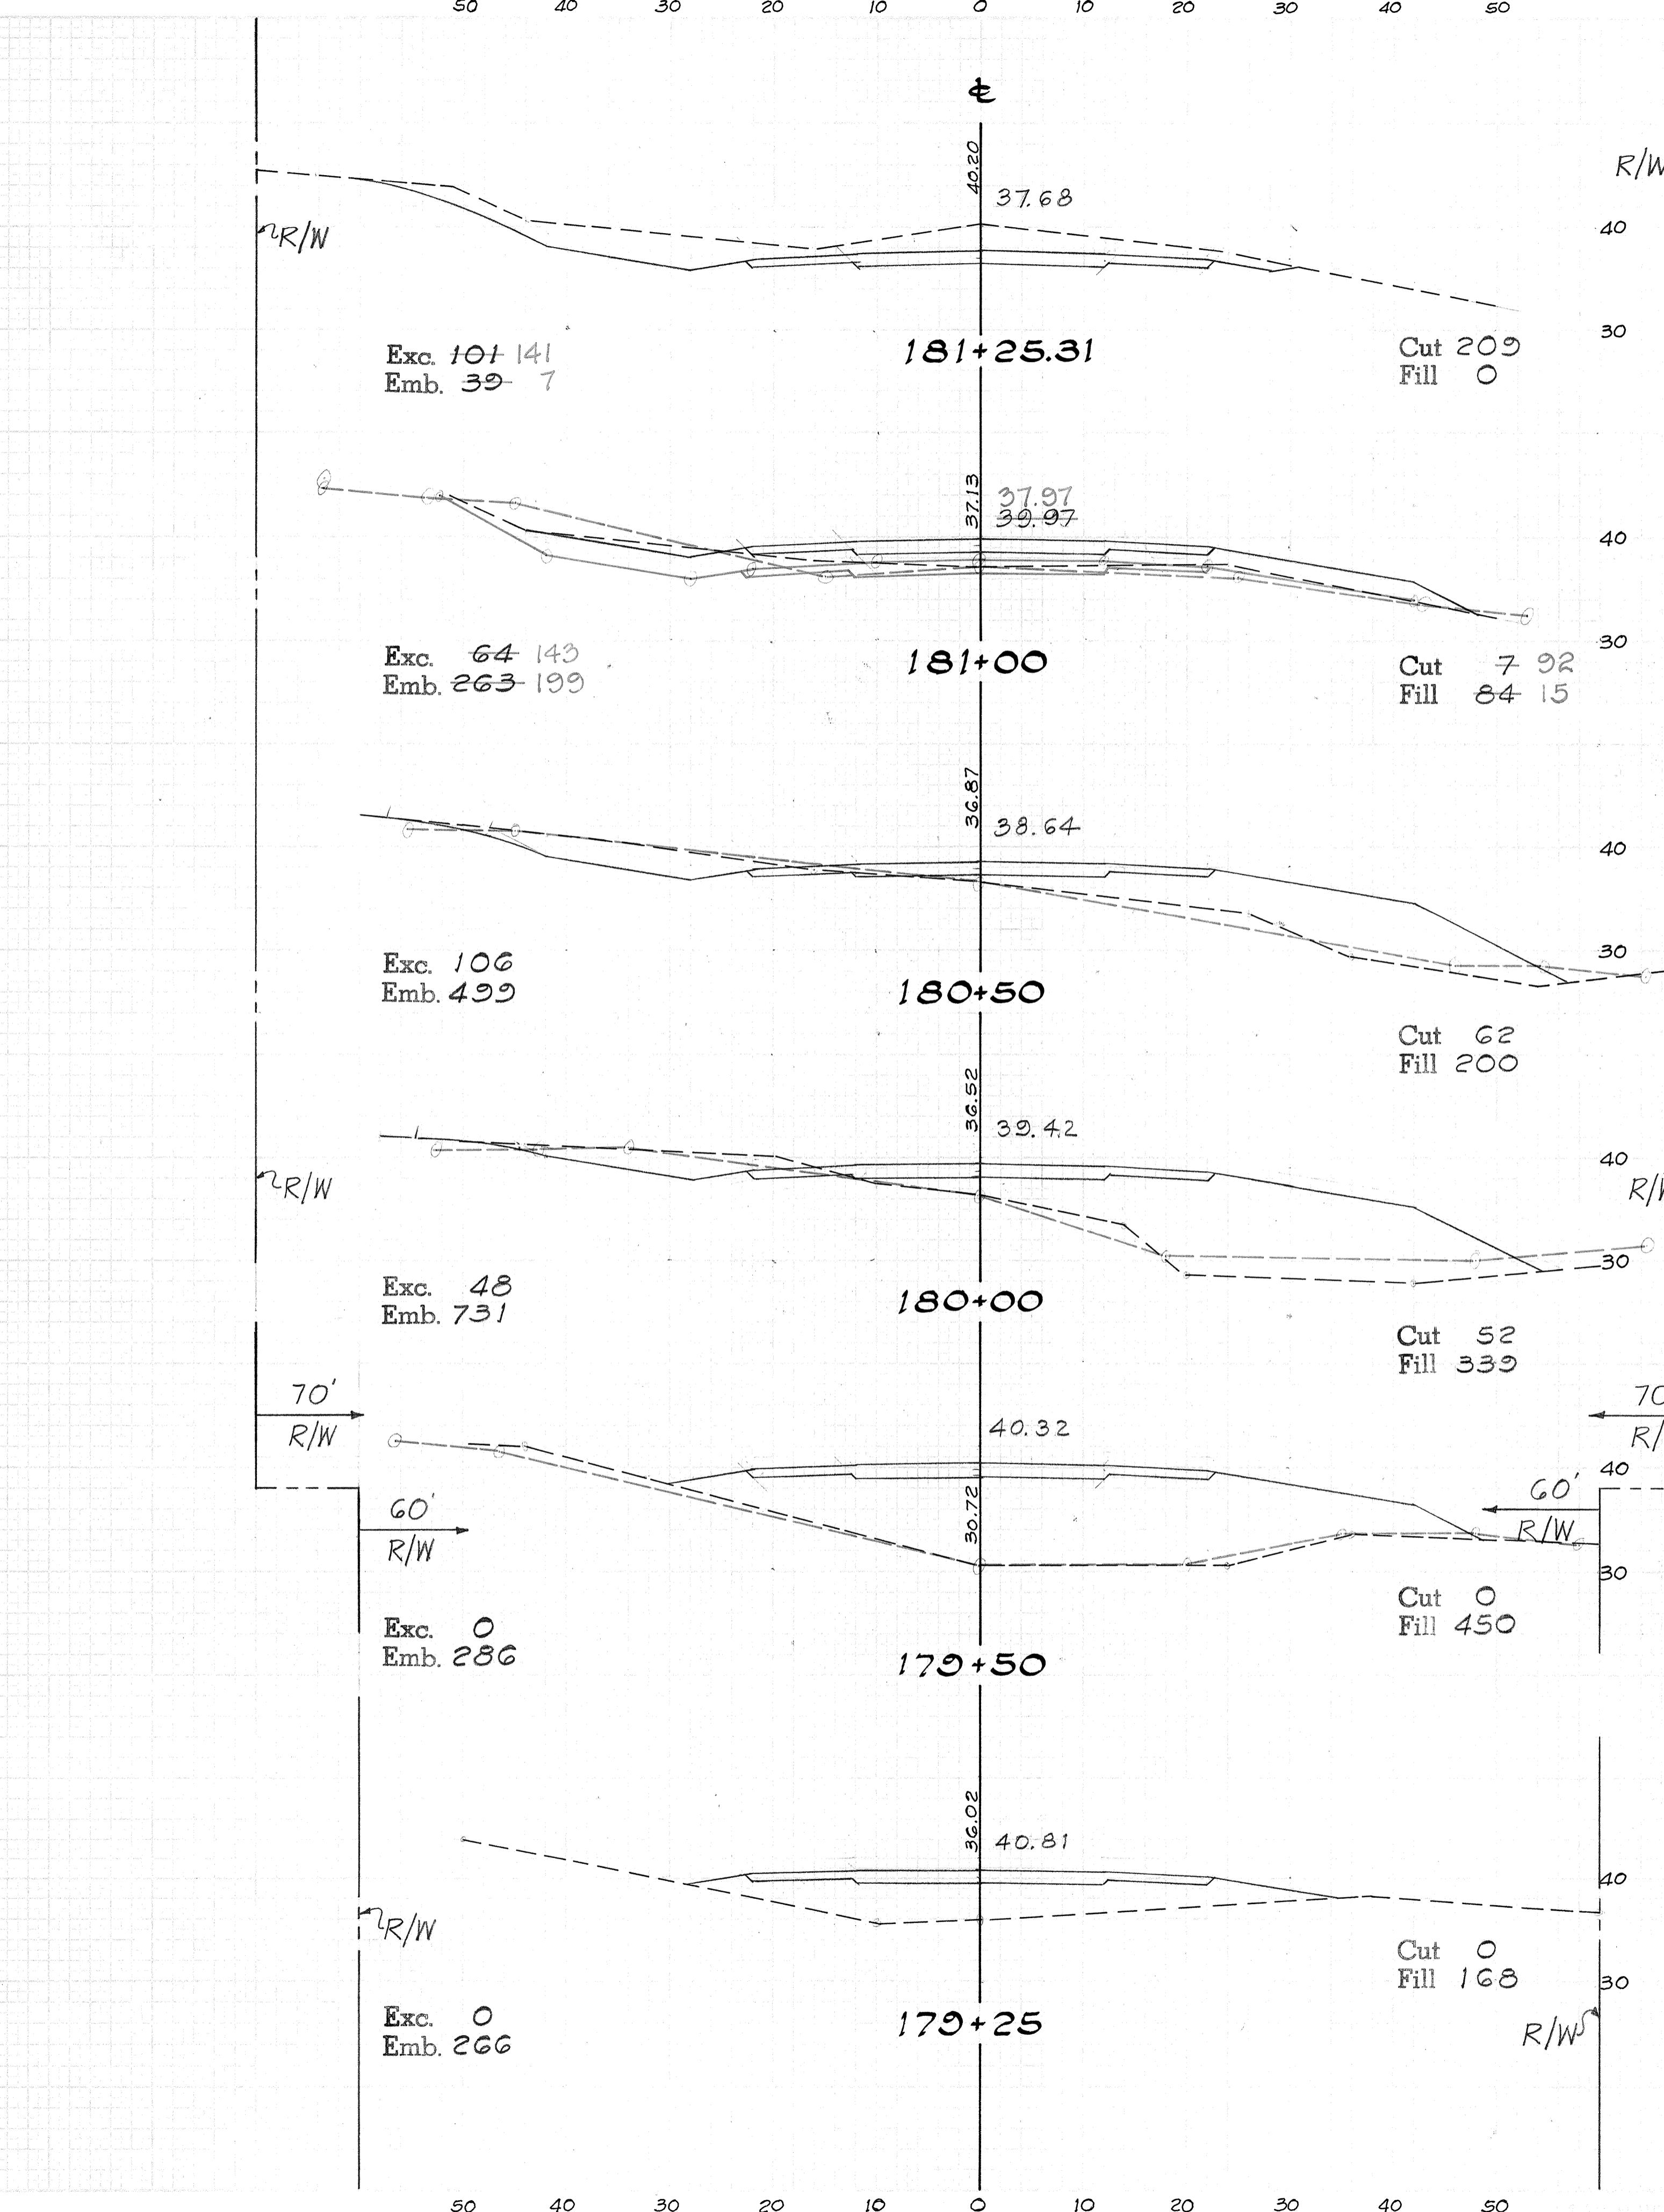


FED. ROAD DIST. NO.	STATE	FED. AID PROJ. NO.	FISCAL YEAR	SPMBT NO.	TOTAL SHEETS
HAWAII	HAW.	ER-9(3)	'79	50	89

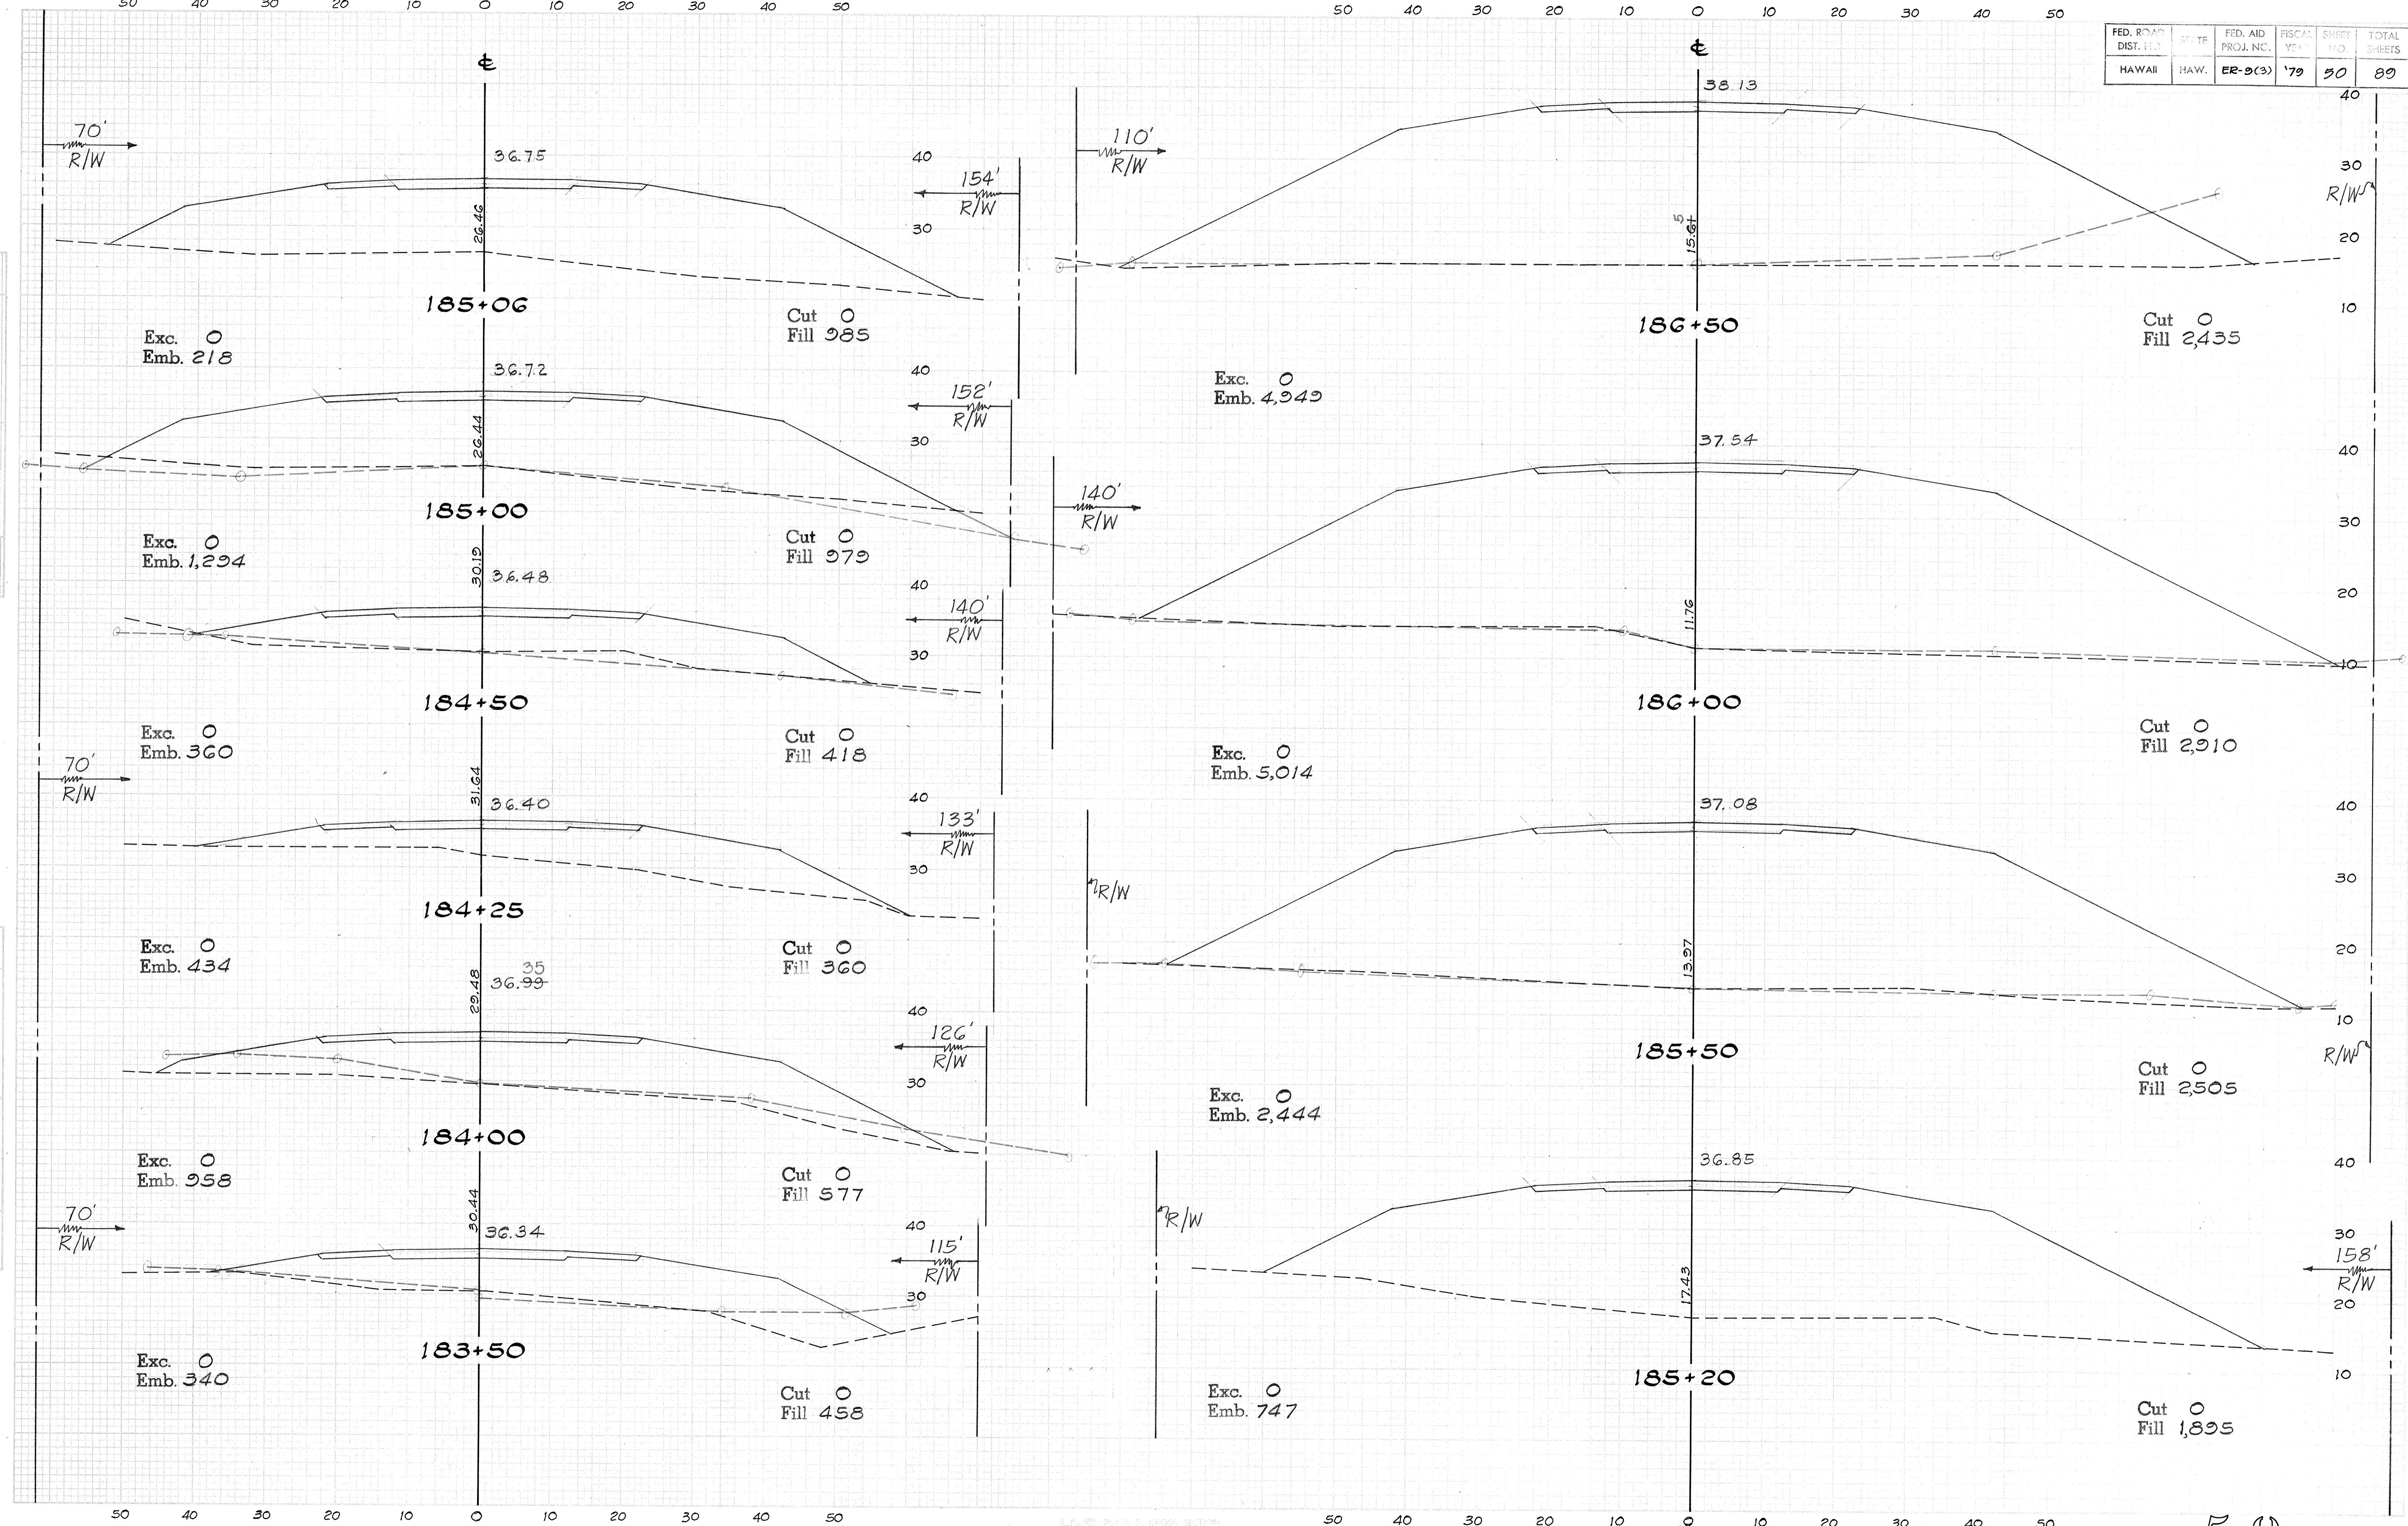


FED. ROAD DIST. NO	STATE	FED. AID PROJ. NO.	FISCAL YEAR	SHEET NO.	TOTAL SHEETS
HAWAII	HAW.	ER-9(3)	'79	51	89

FINAL SURVEYED SURVEY PLOTTED NOTE BOOK READING AREA DRAWN


ORIGINAL SURVEYED SURVEY PLOTTED NOTE BOOK READING AREA DRAWN

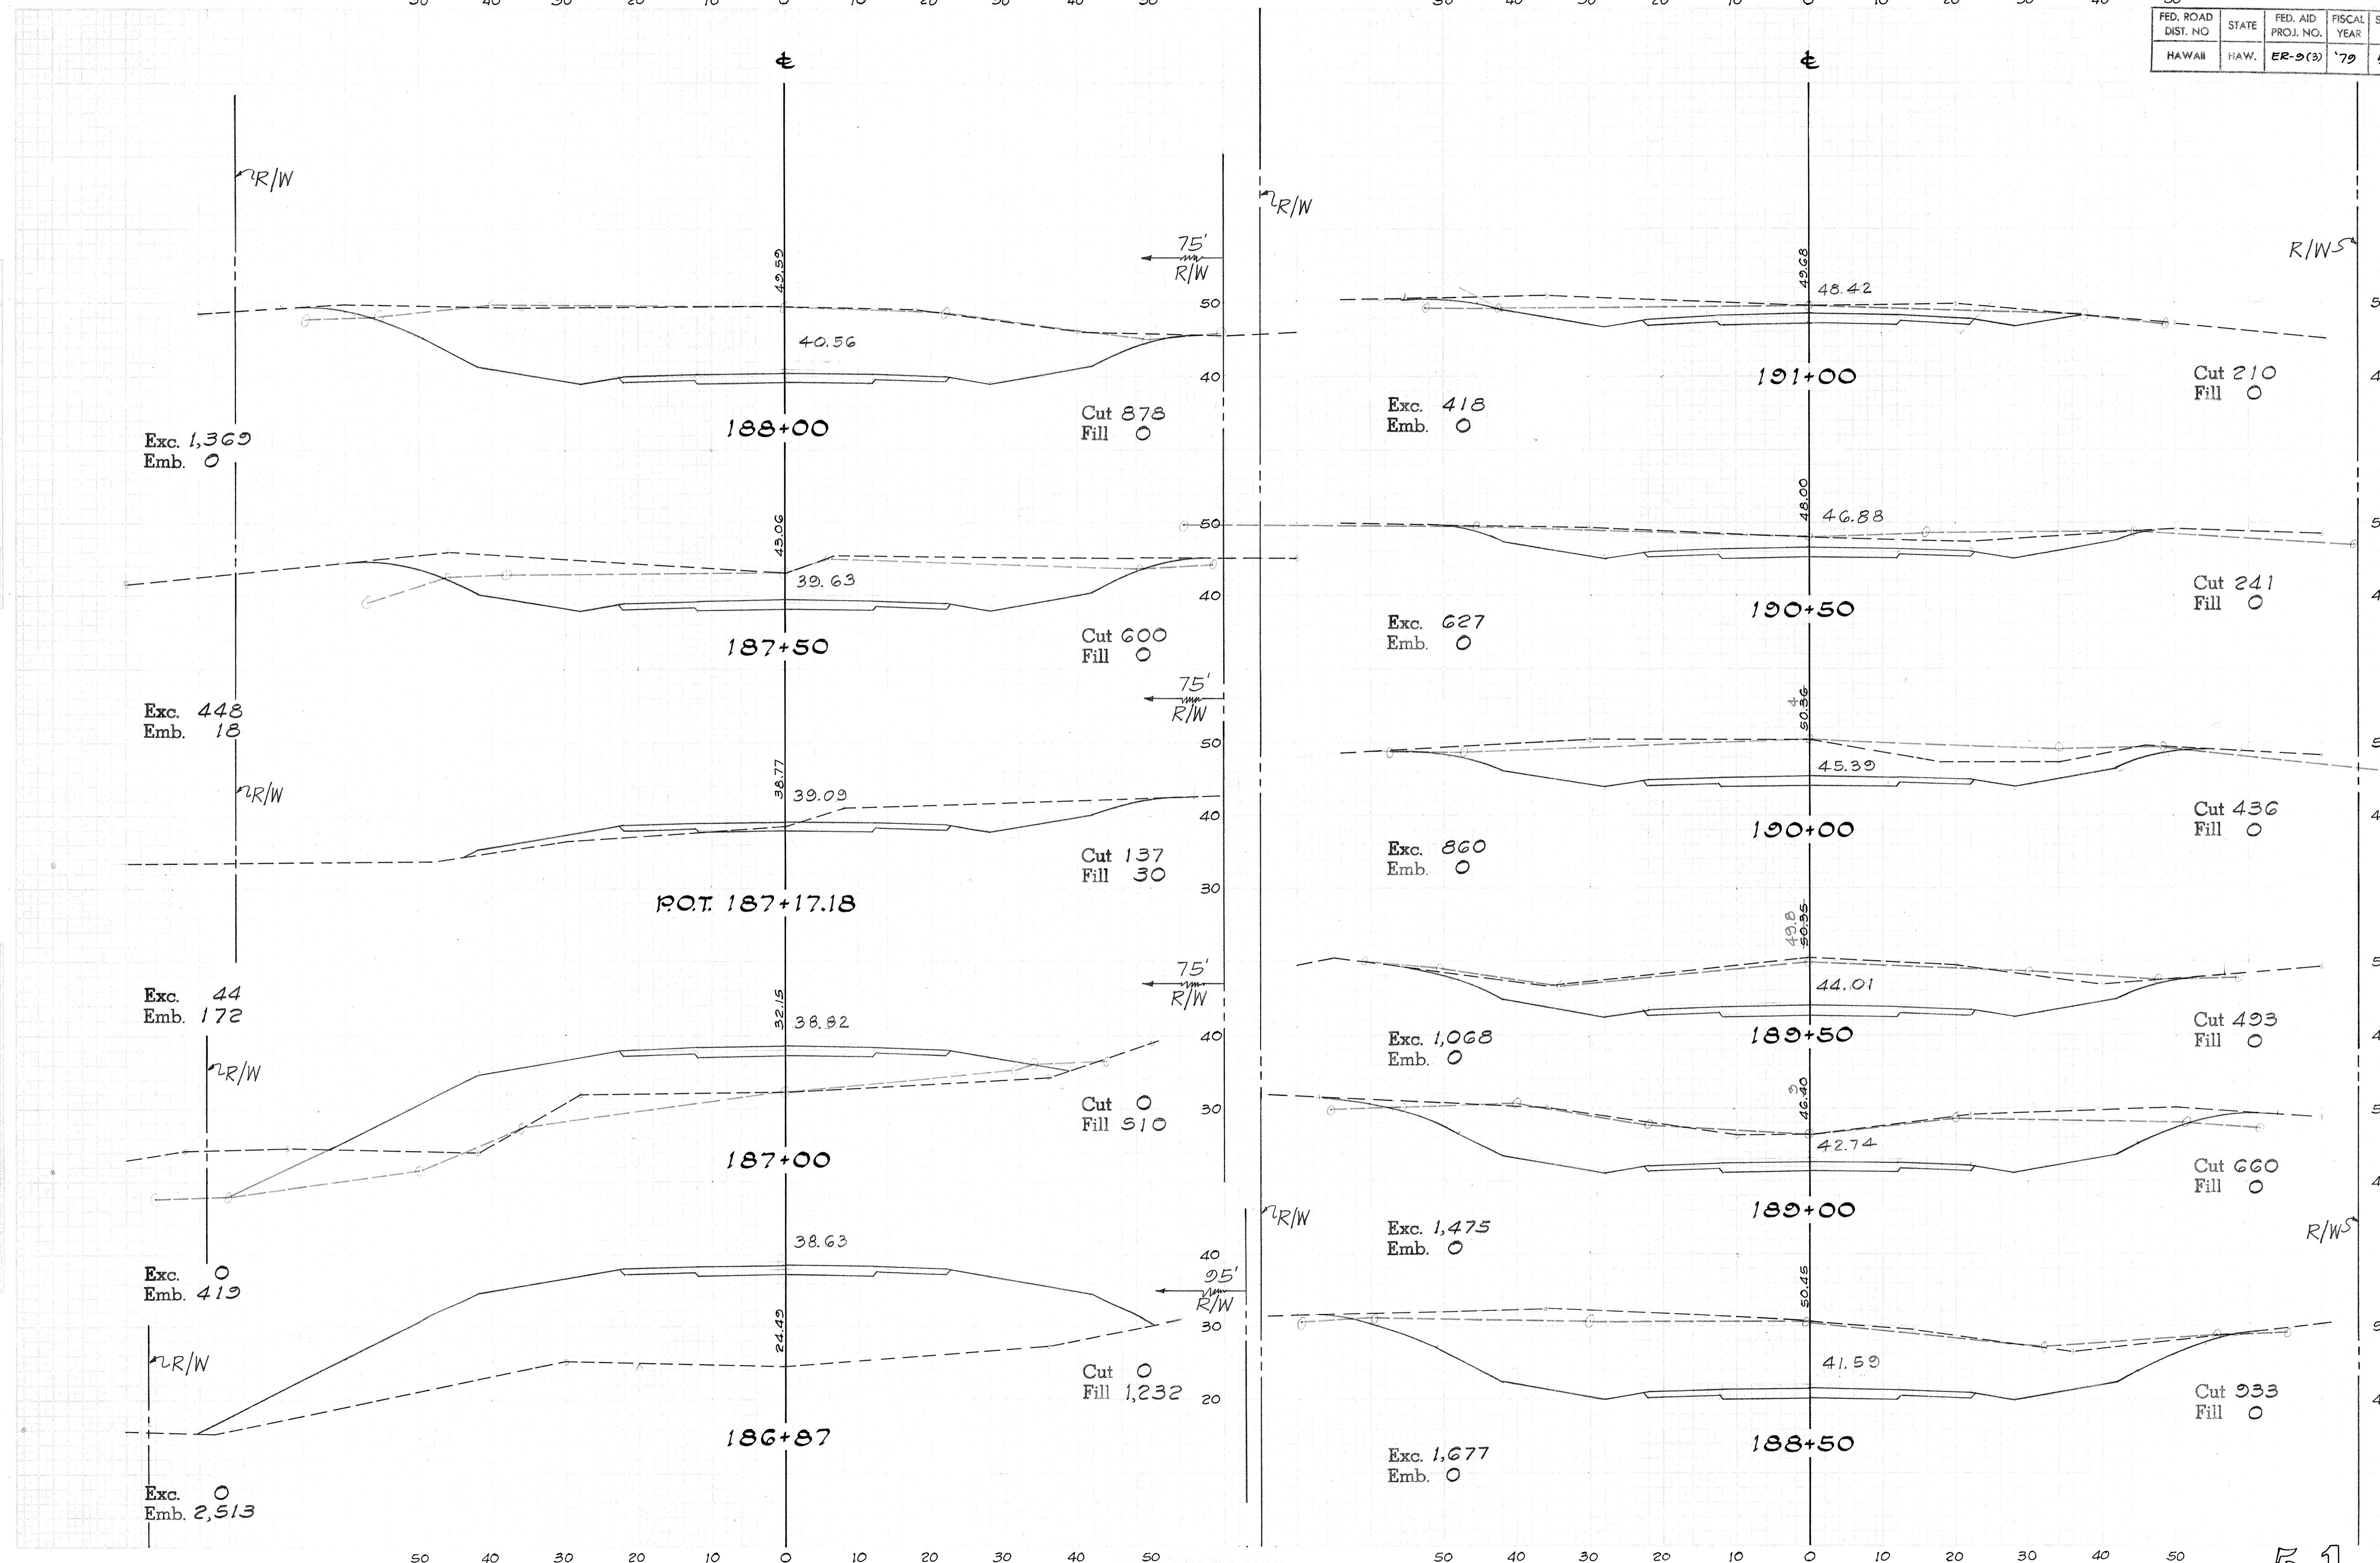



FED. ROAD DIST. NO	STATE	FED. AID PROJ. NO.	FISCAL YEAR	SHEET NO.	TOTAL SHEETS
HAWAII	HAW.	ER-9(3)	'79	52	89

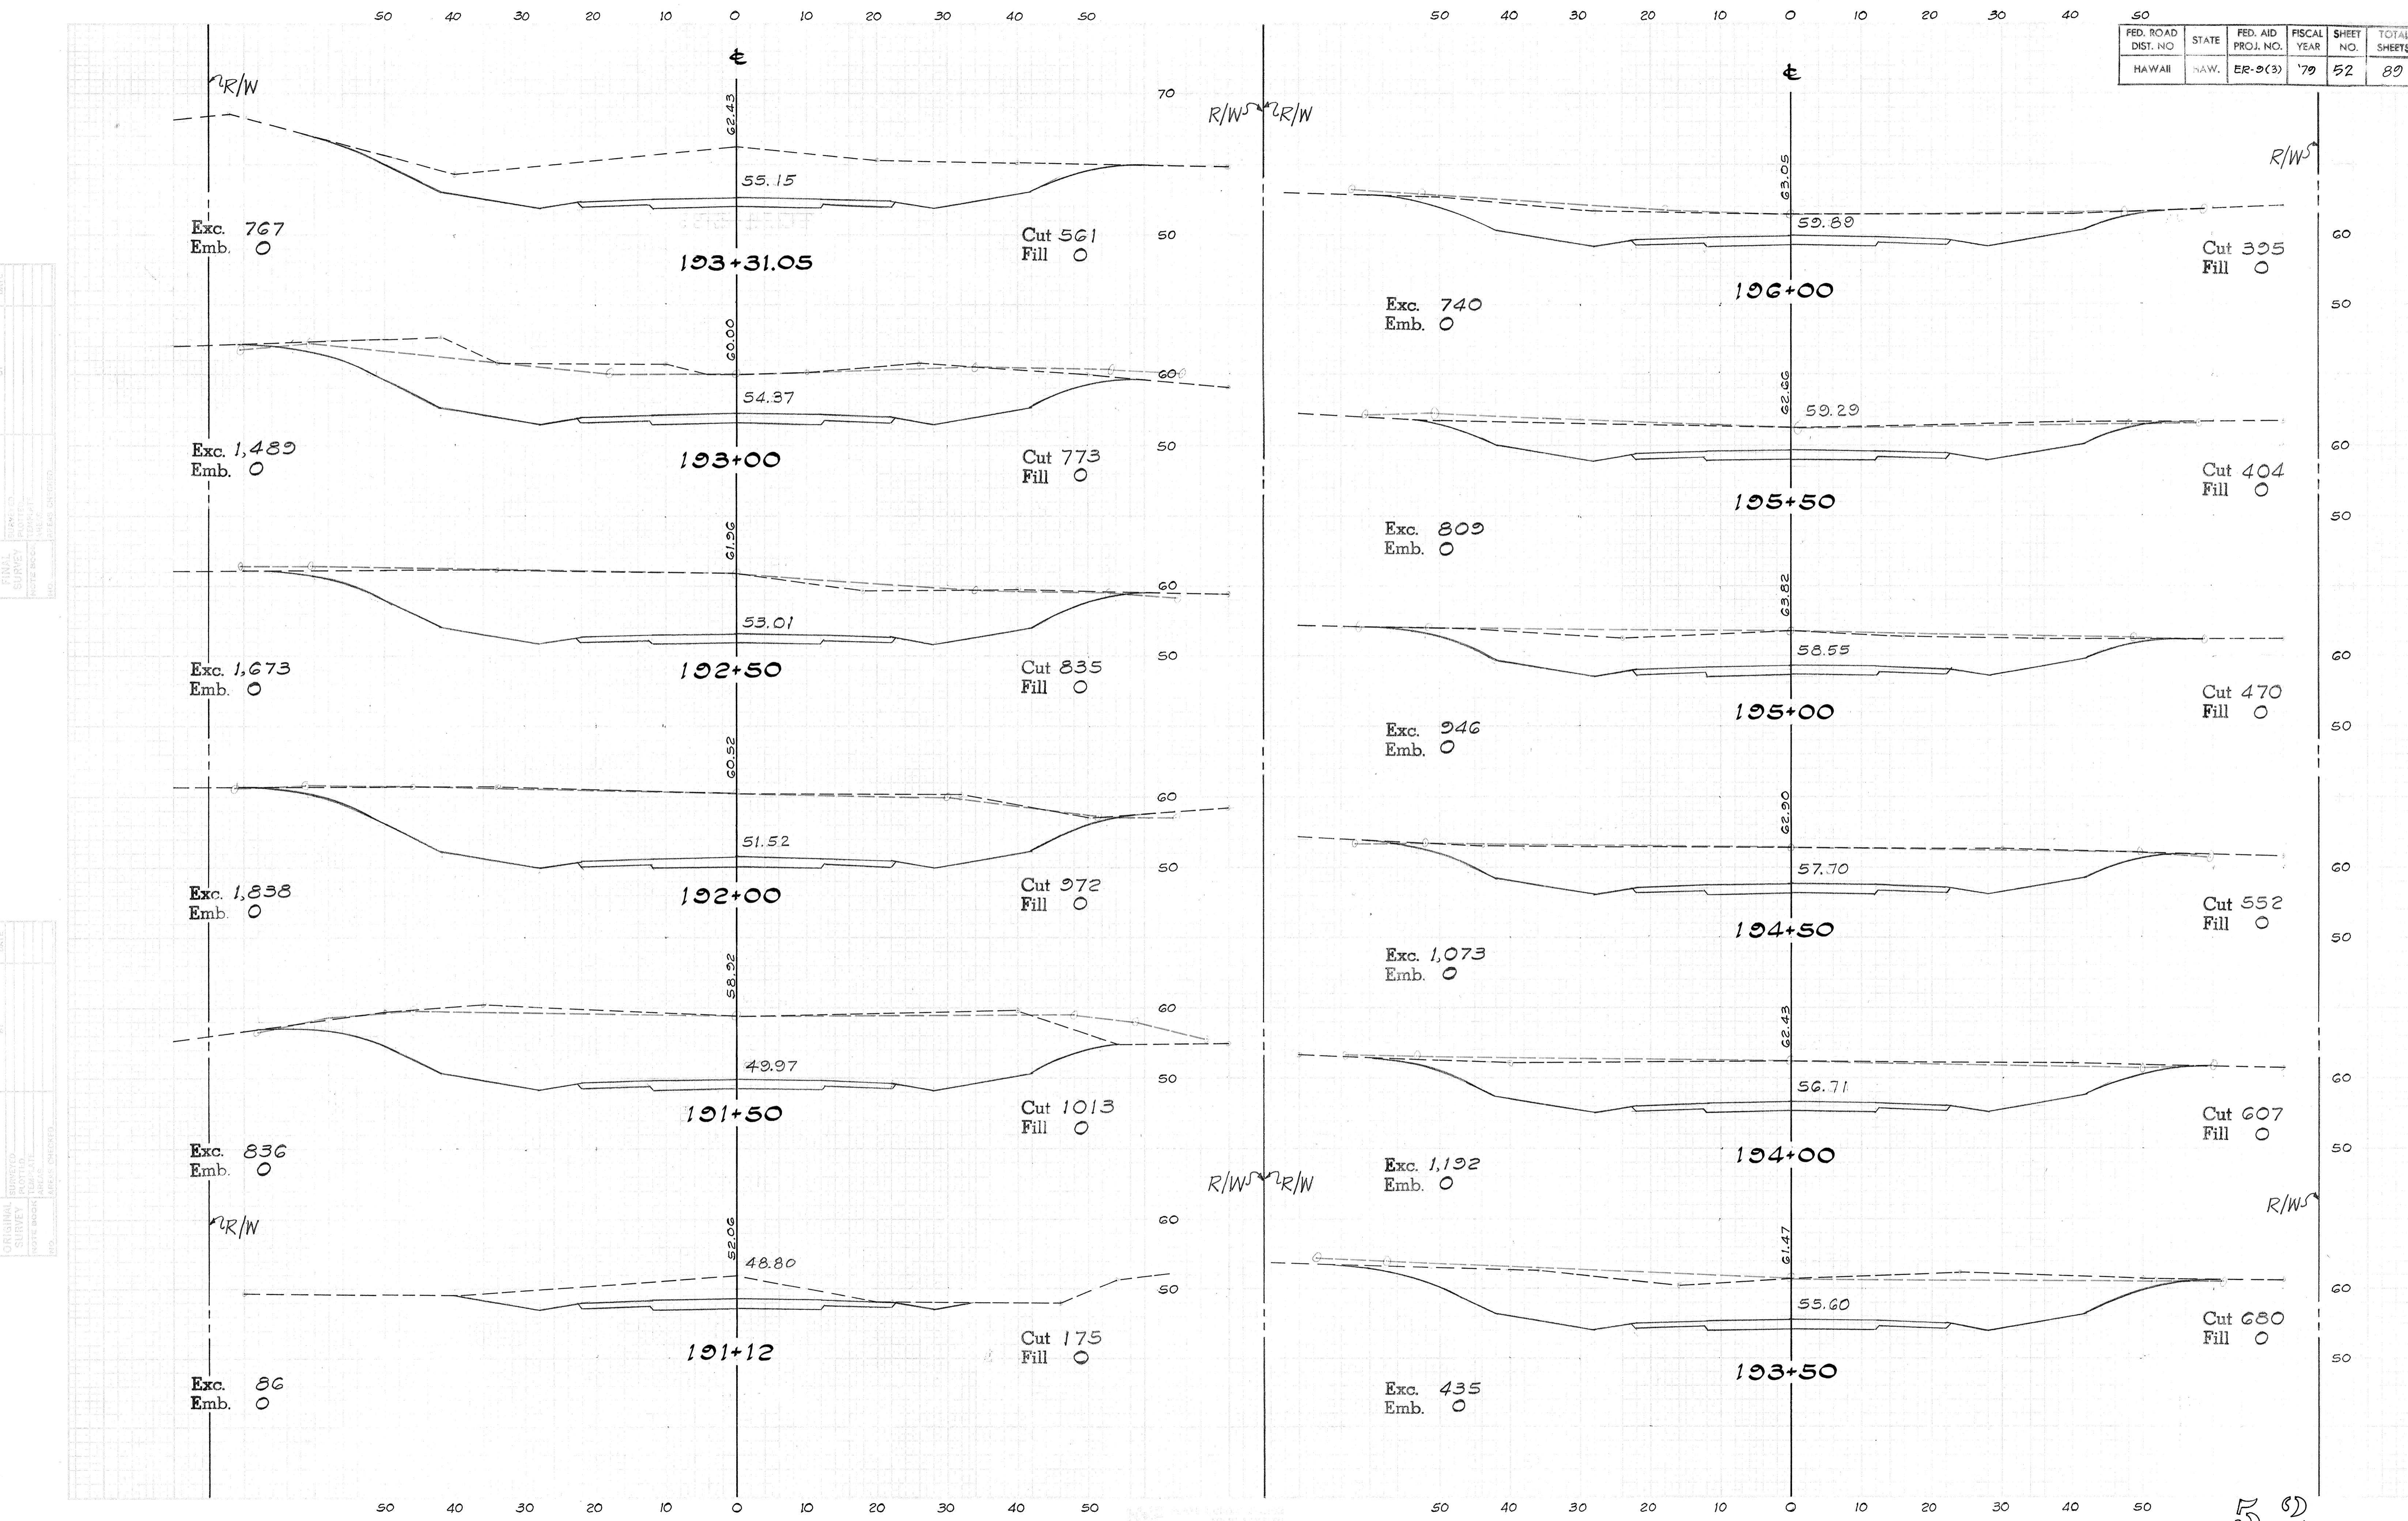


FED. ROAD DIST. NO	STATE	FED. AID PROJ. NO.	FISCAL YEAR	SHEET NO.	TOTAL SHEETS
HAWAII	HAW.	ER-9(3)	'79	53	89

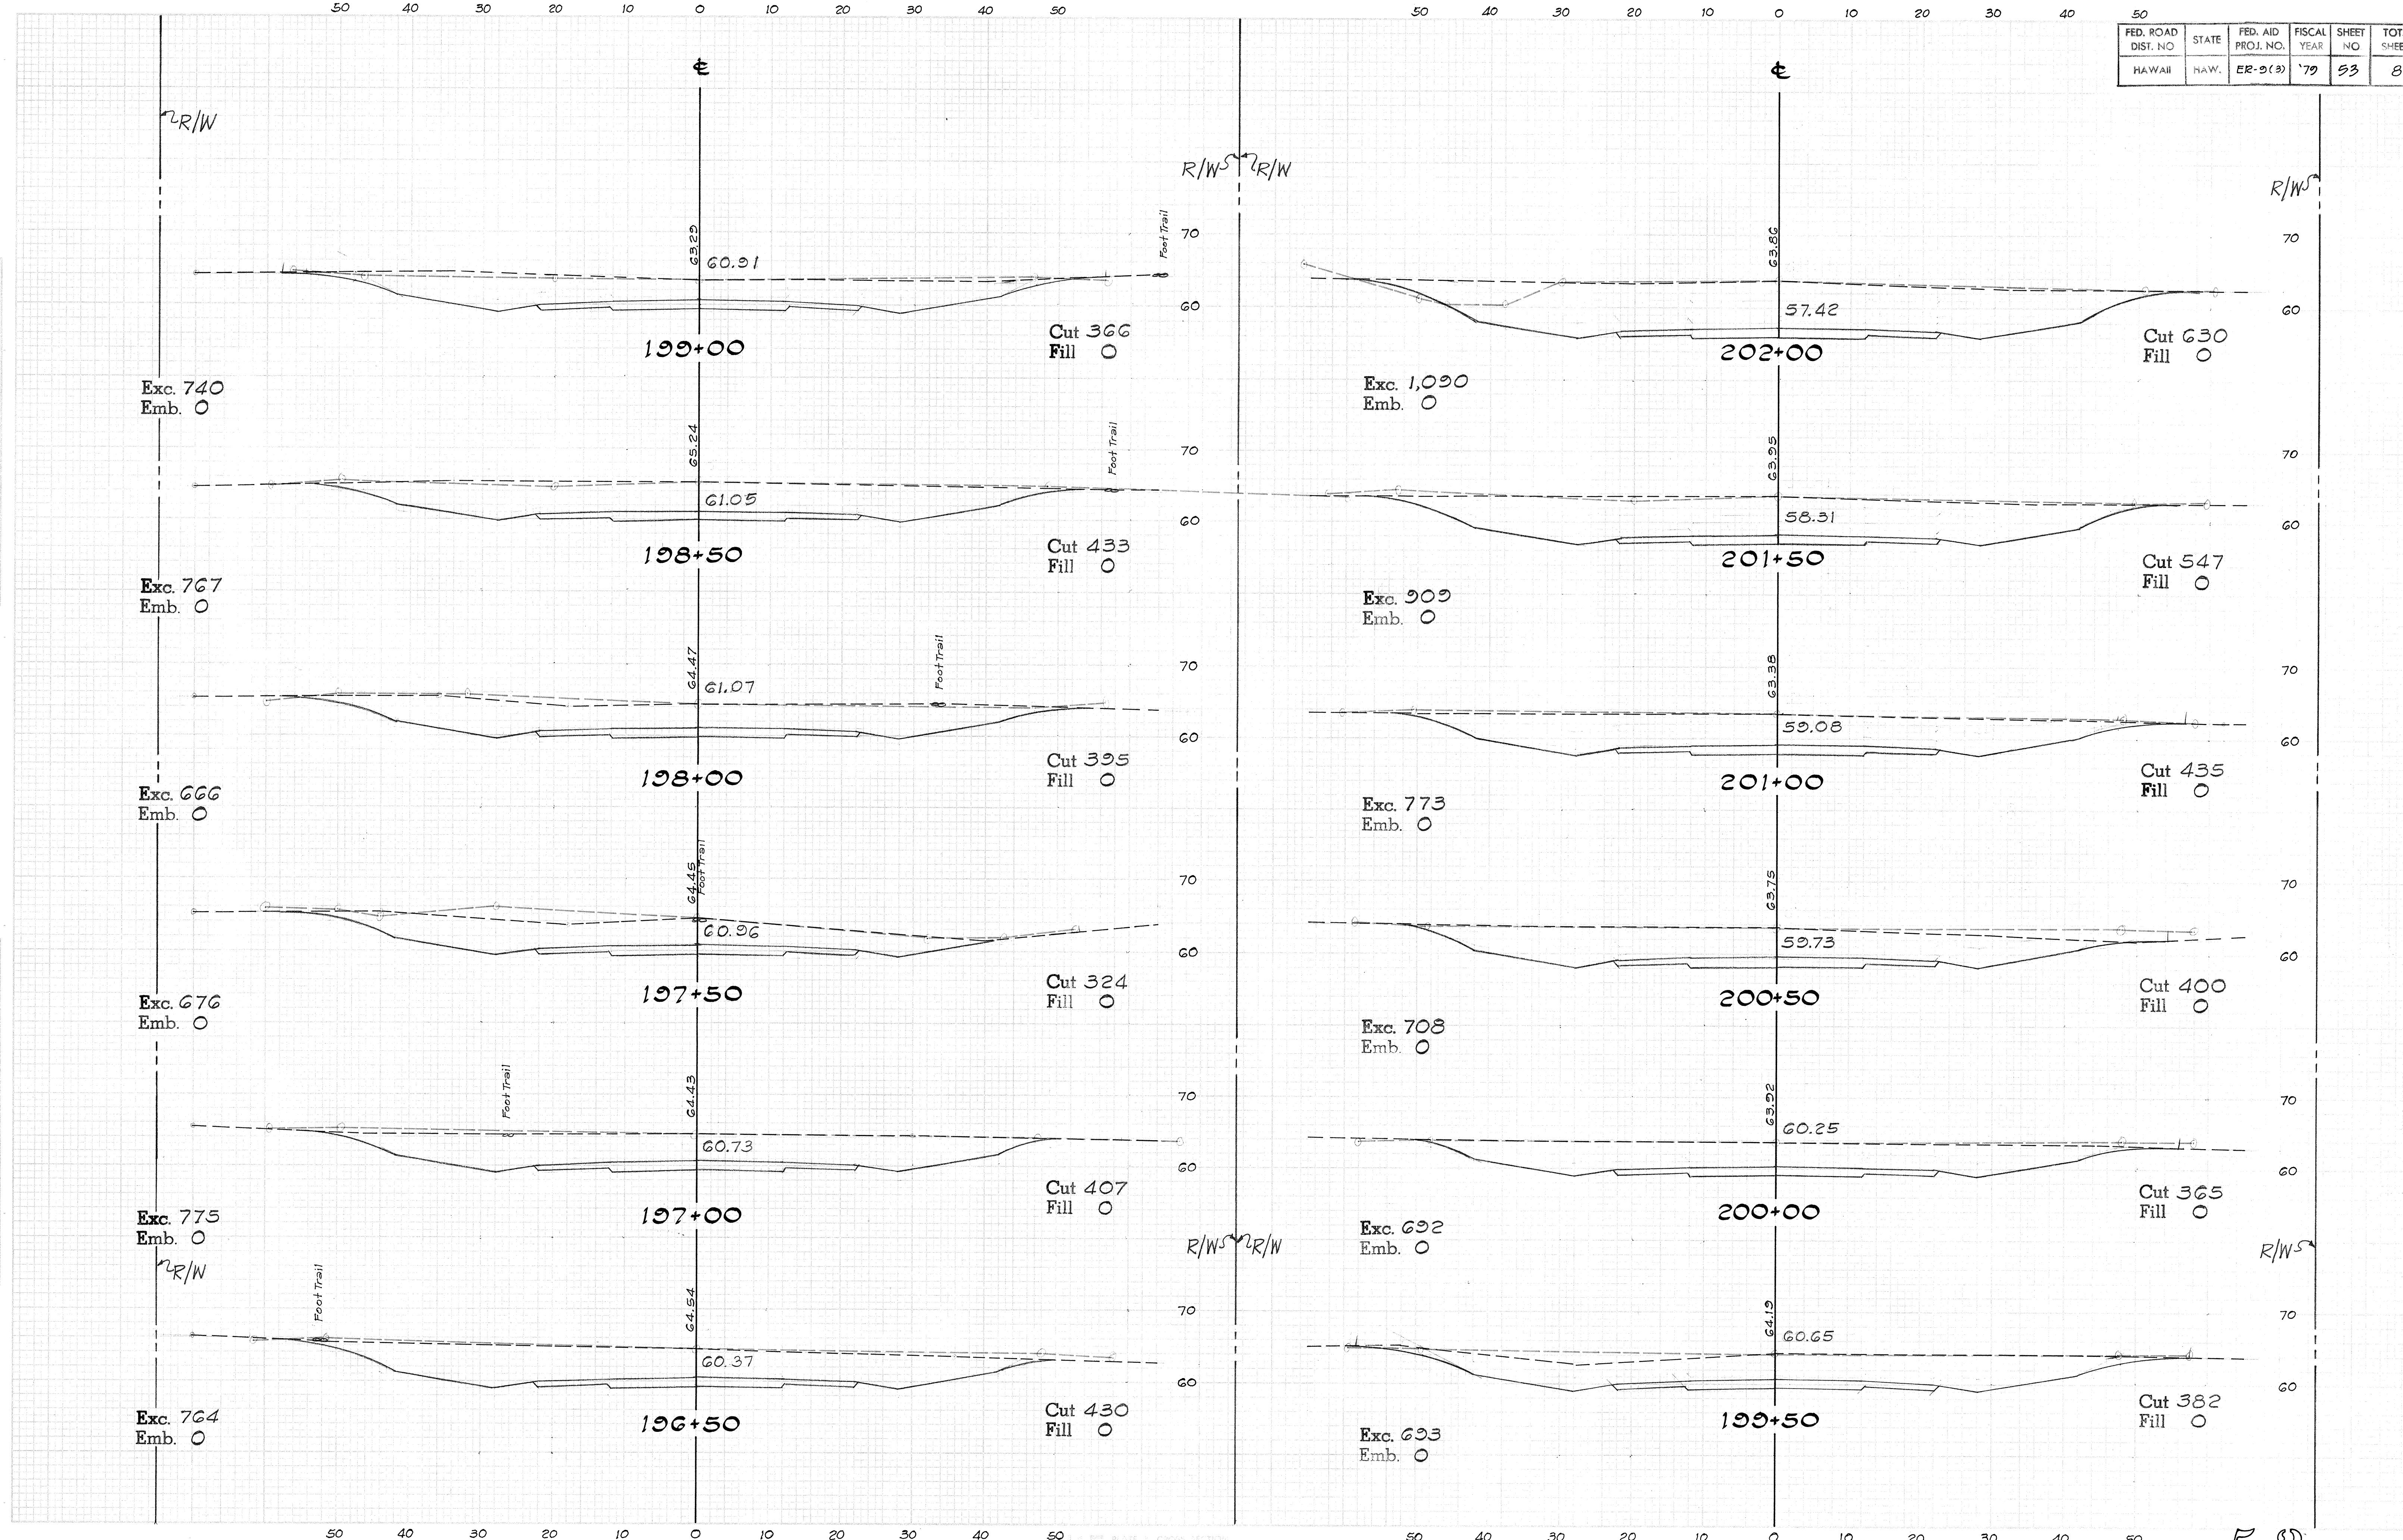



FED. ROAD DIST. NO.	STATE	FED. AID PROJ. NO.	FISCAL YEAR	SHEET NO.	TOTAL SHEETS
HAWAII	HAW.	ER-9(3)	'79	54	89

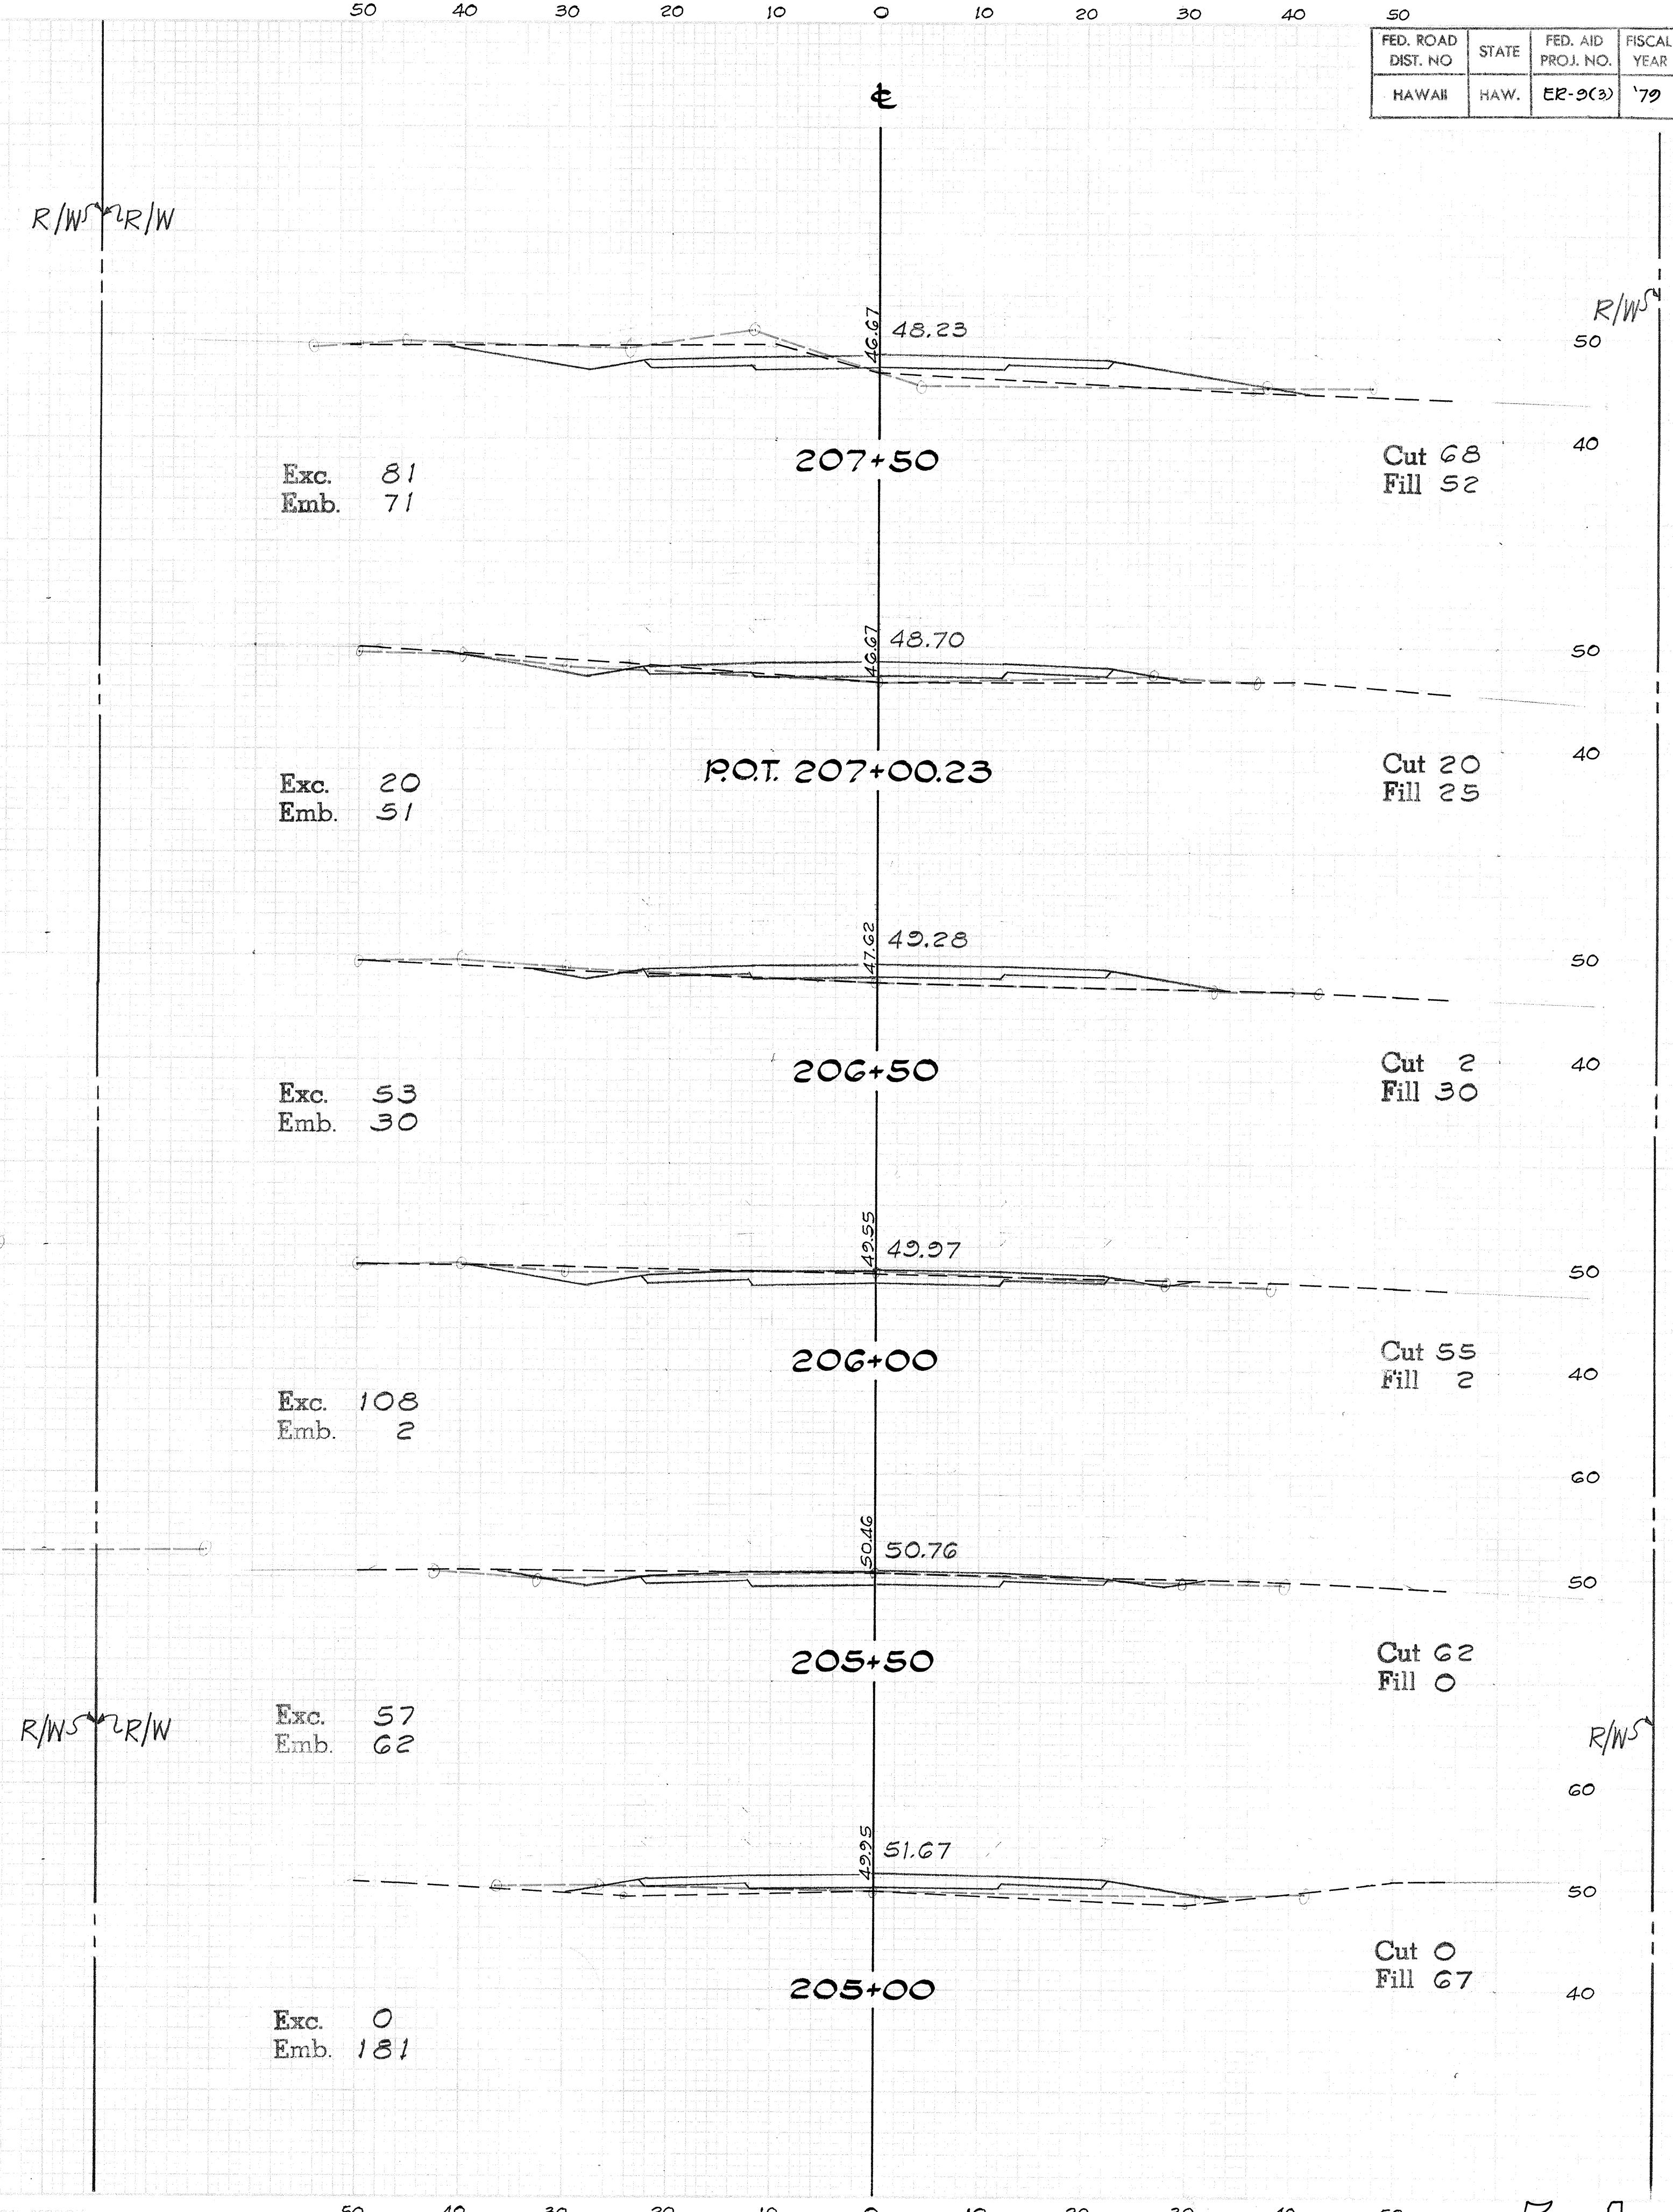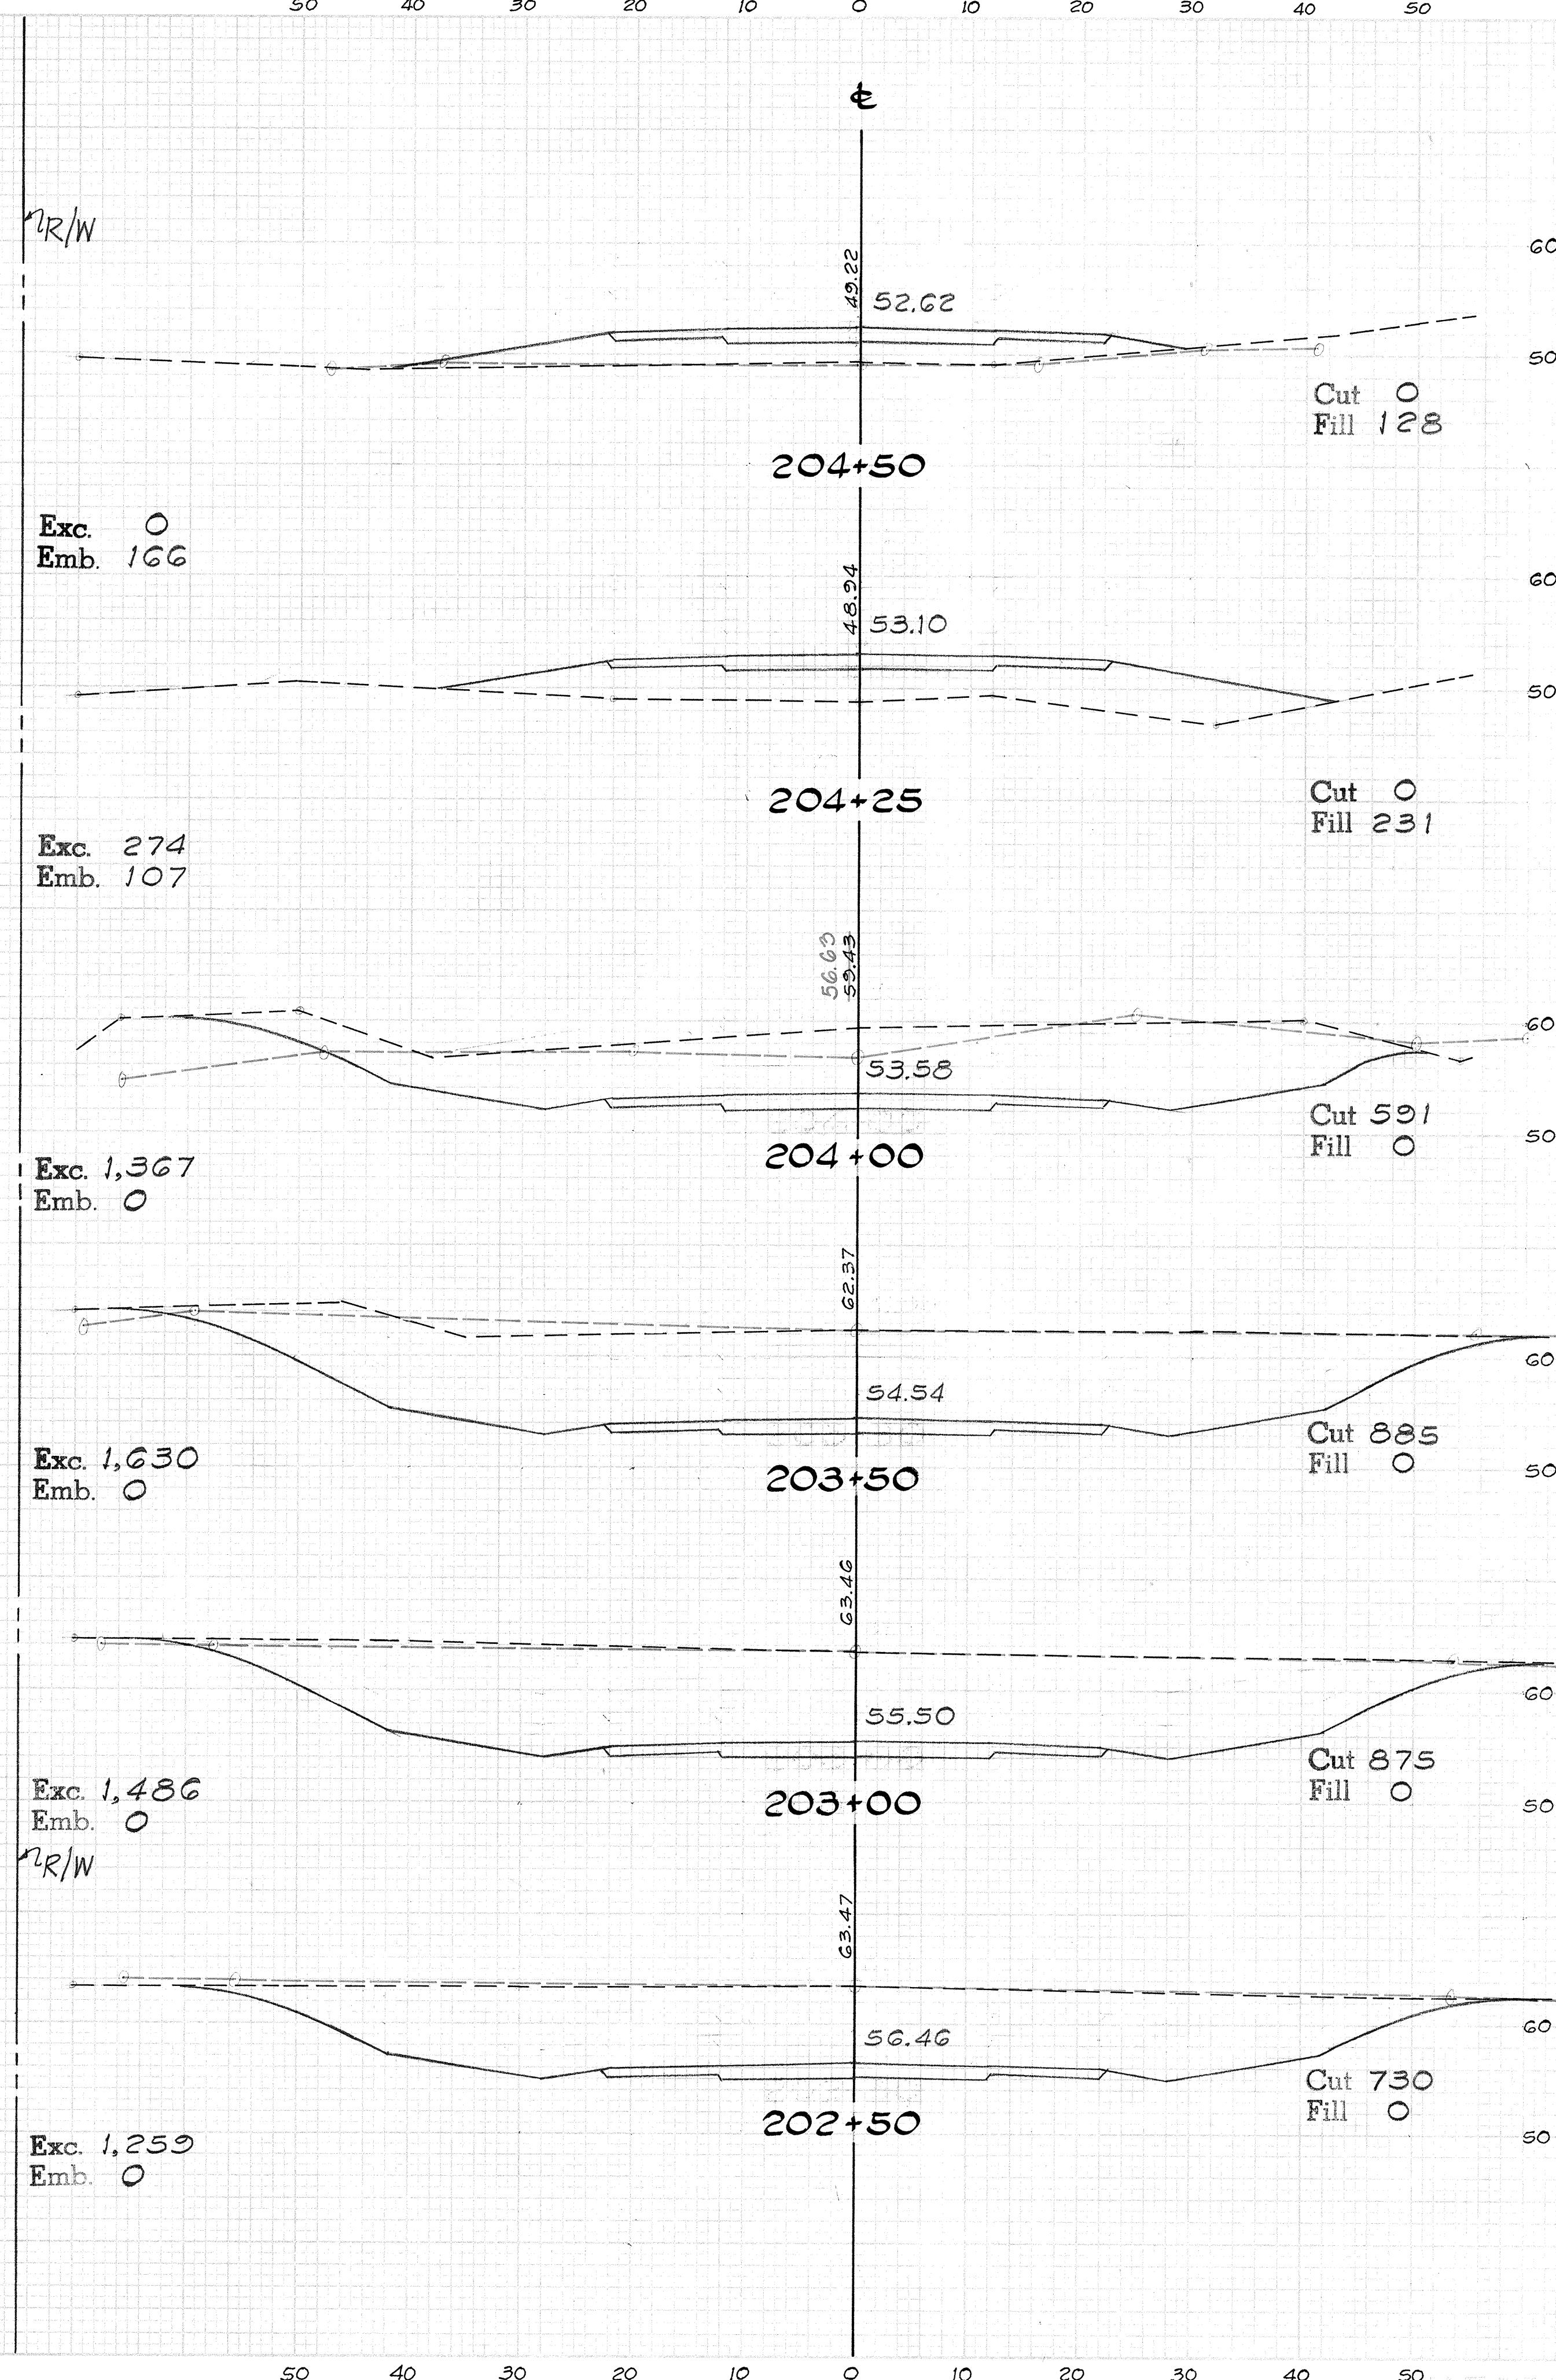



FED. ROAD DIST. NO.	STATE	FED. AID PROJ. NO.	FISCAL YEAR	SHEET NO.	TOTAL SHEETS
HAWAII	HAW.	ER-9(3)	'79	55	89

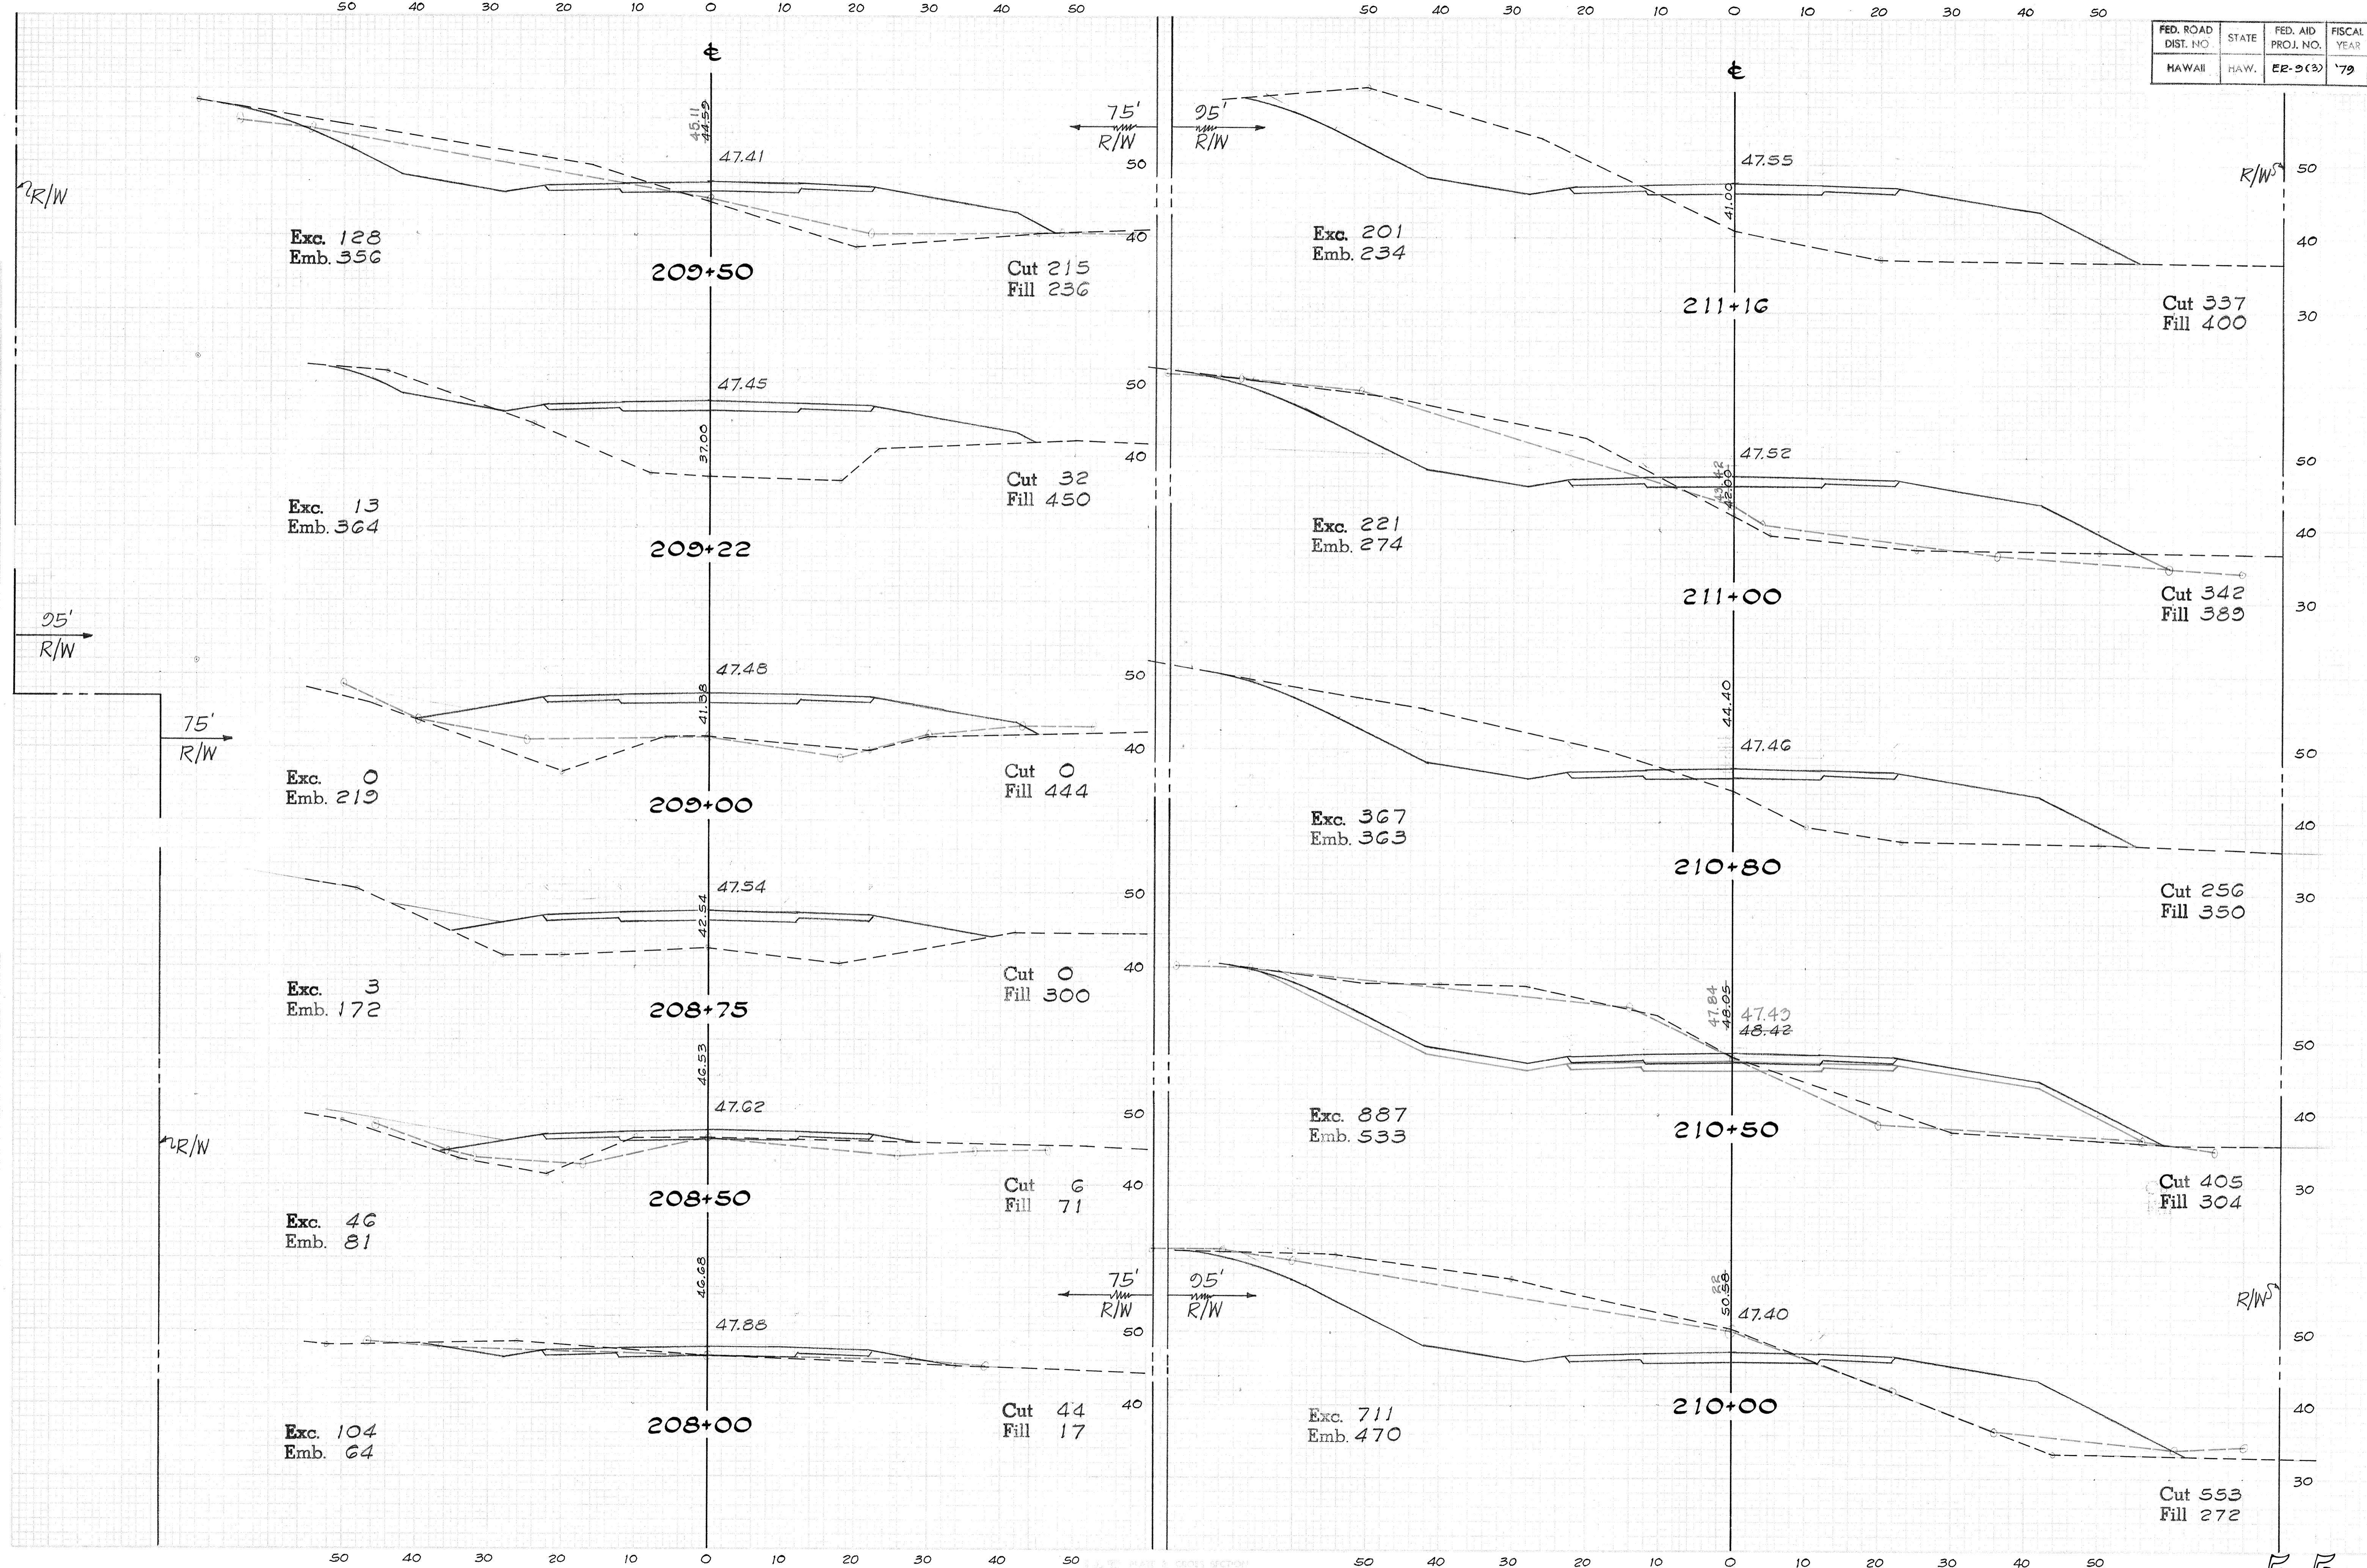



FED. ROAD DIST. NO	STATE	FED. AID PROJ. NO.	FISCAL YEAR	SHEET NO.	TOTAL SHEETS
HAWAII	HAW.	ER-9(3)	'79	56	89

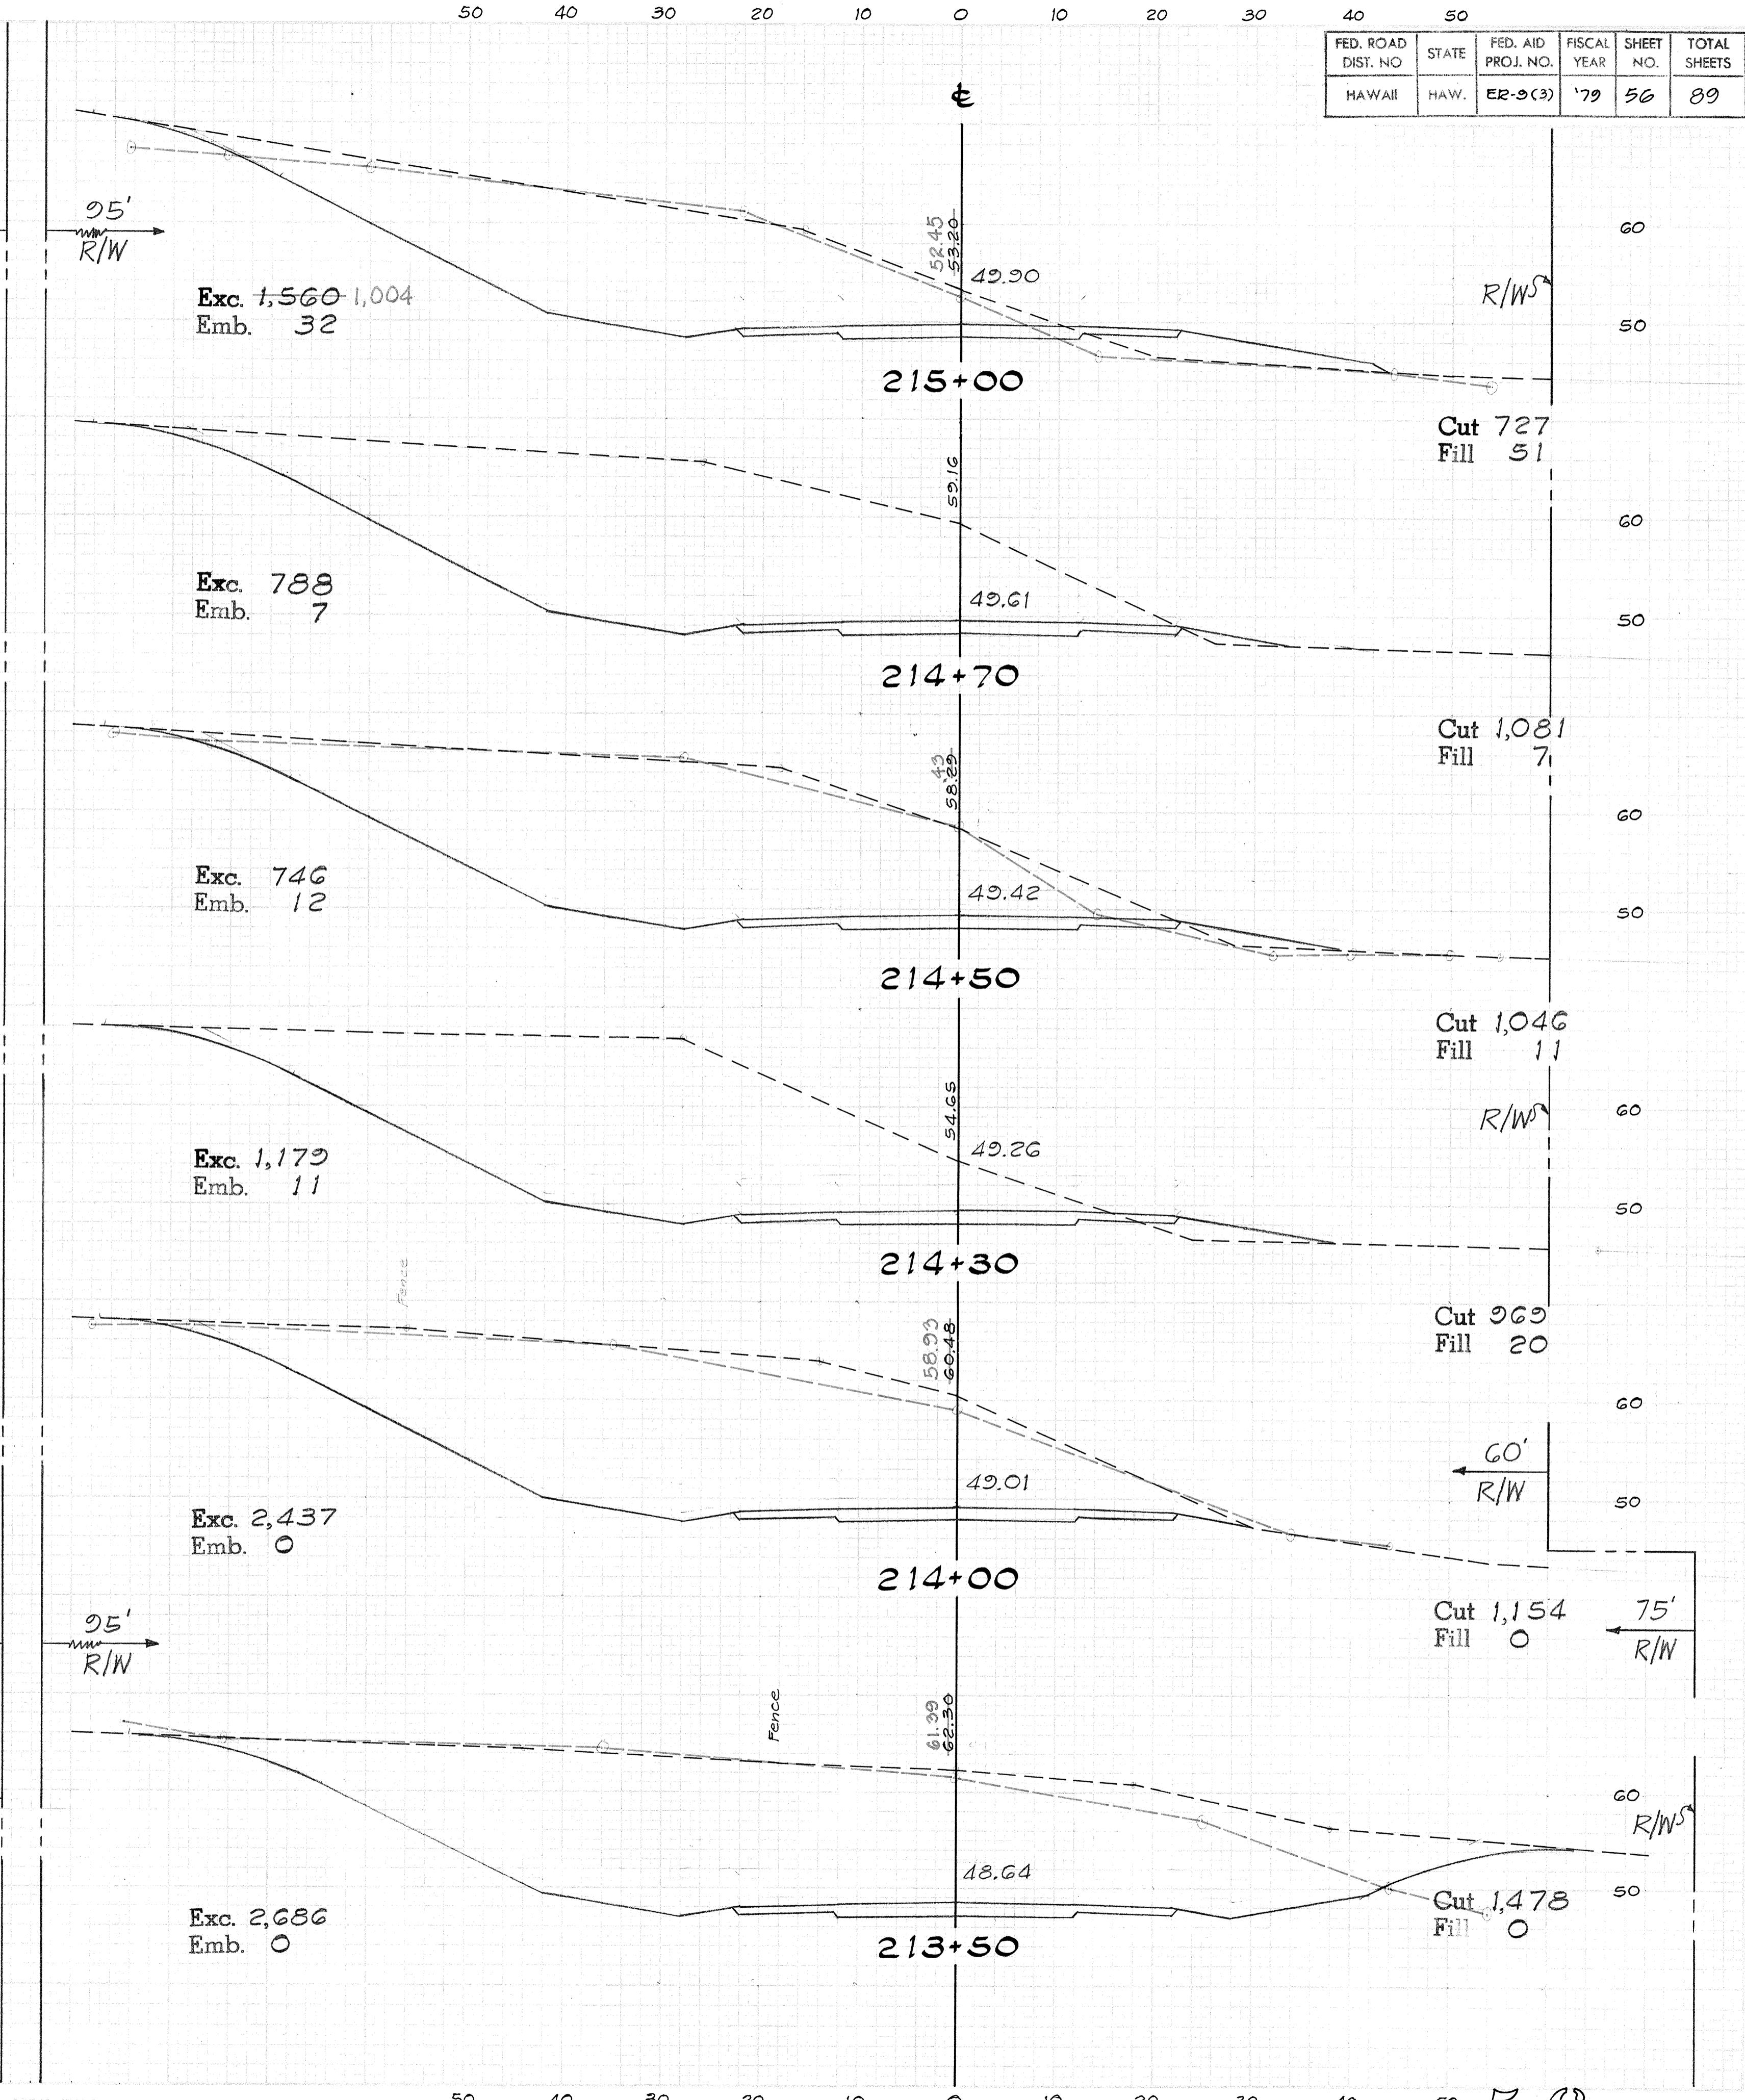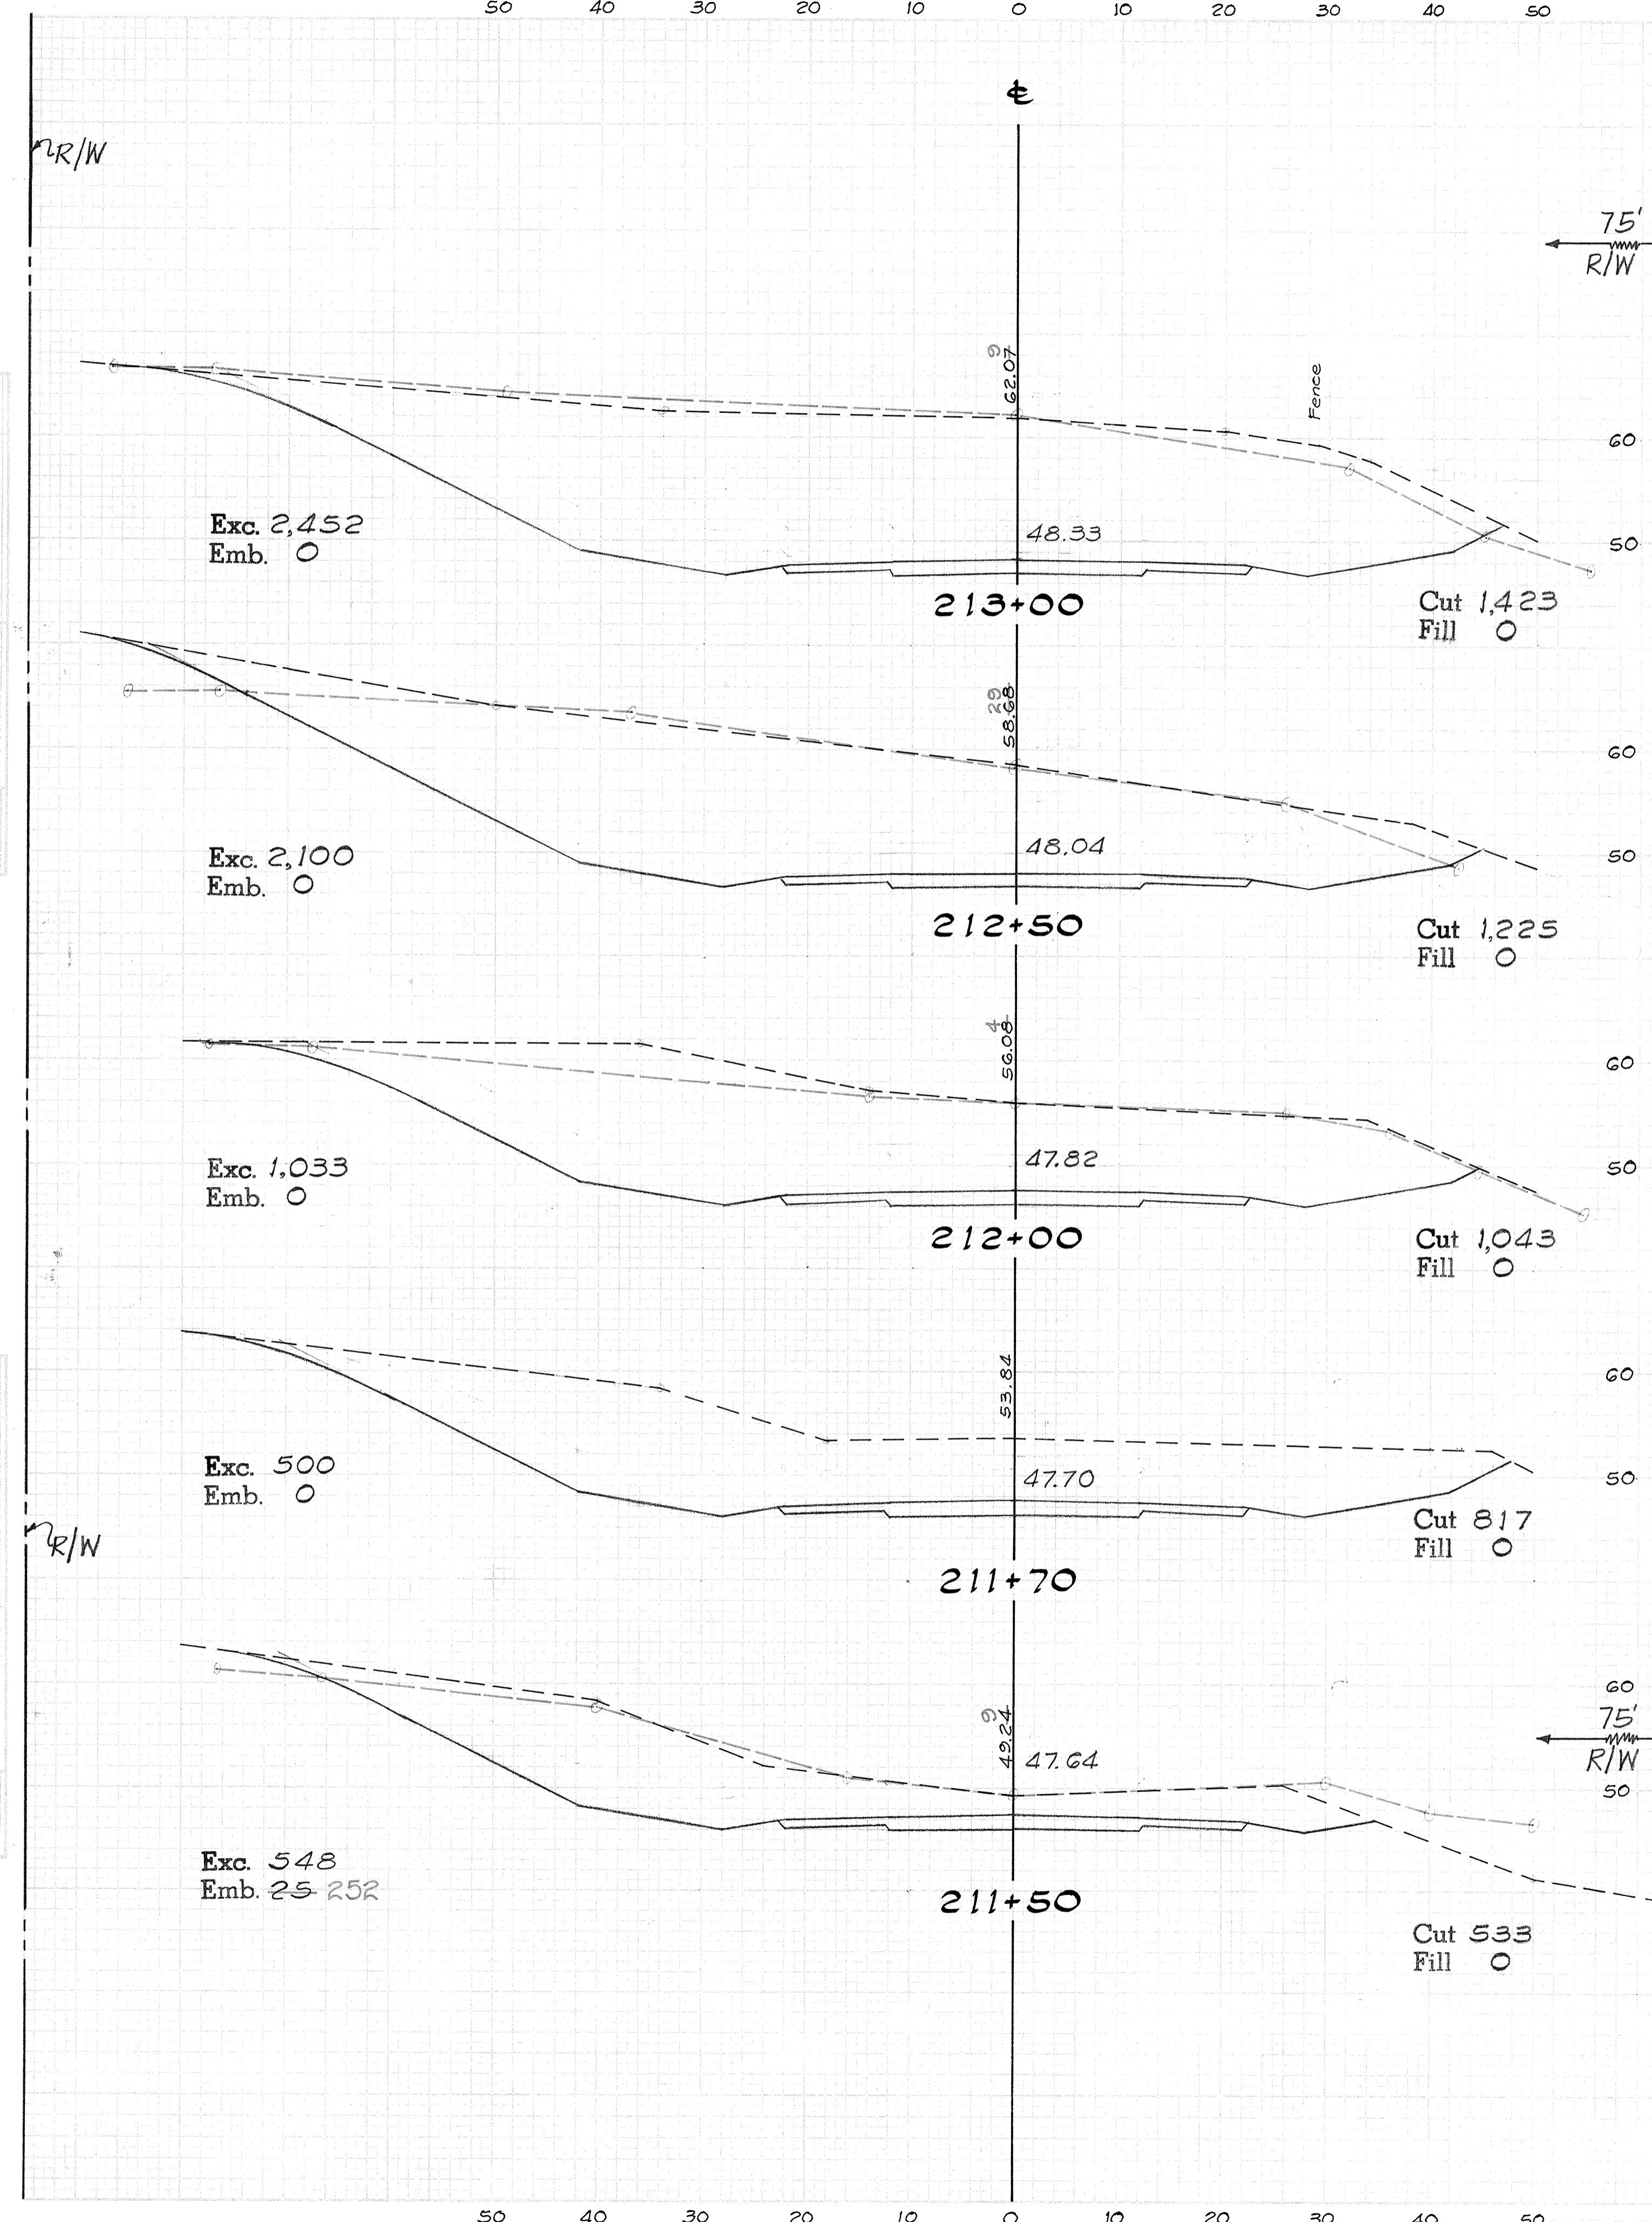


FED. ROAD DIST. NO	STATE	FED. AID PROJ. NO.	FISCAL YEAR	SHEET NO.	TOTAL SHEETS
HAWAII	HAW.	ER-9(3)	'79	57	89

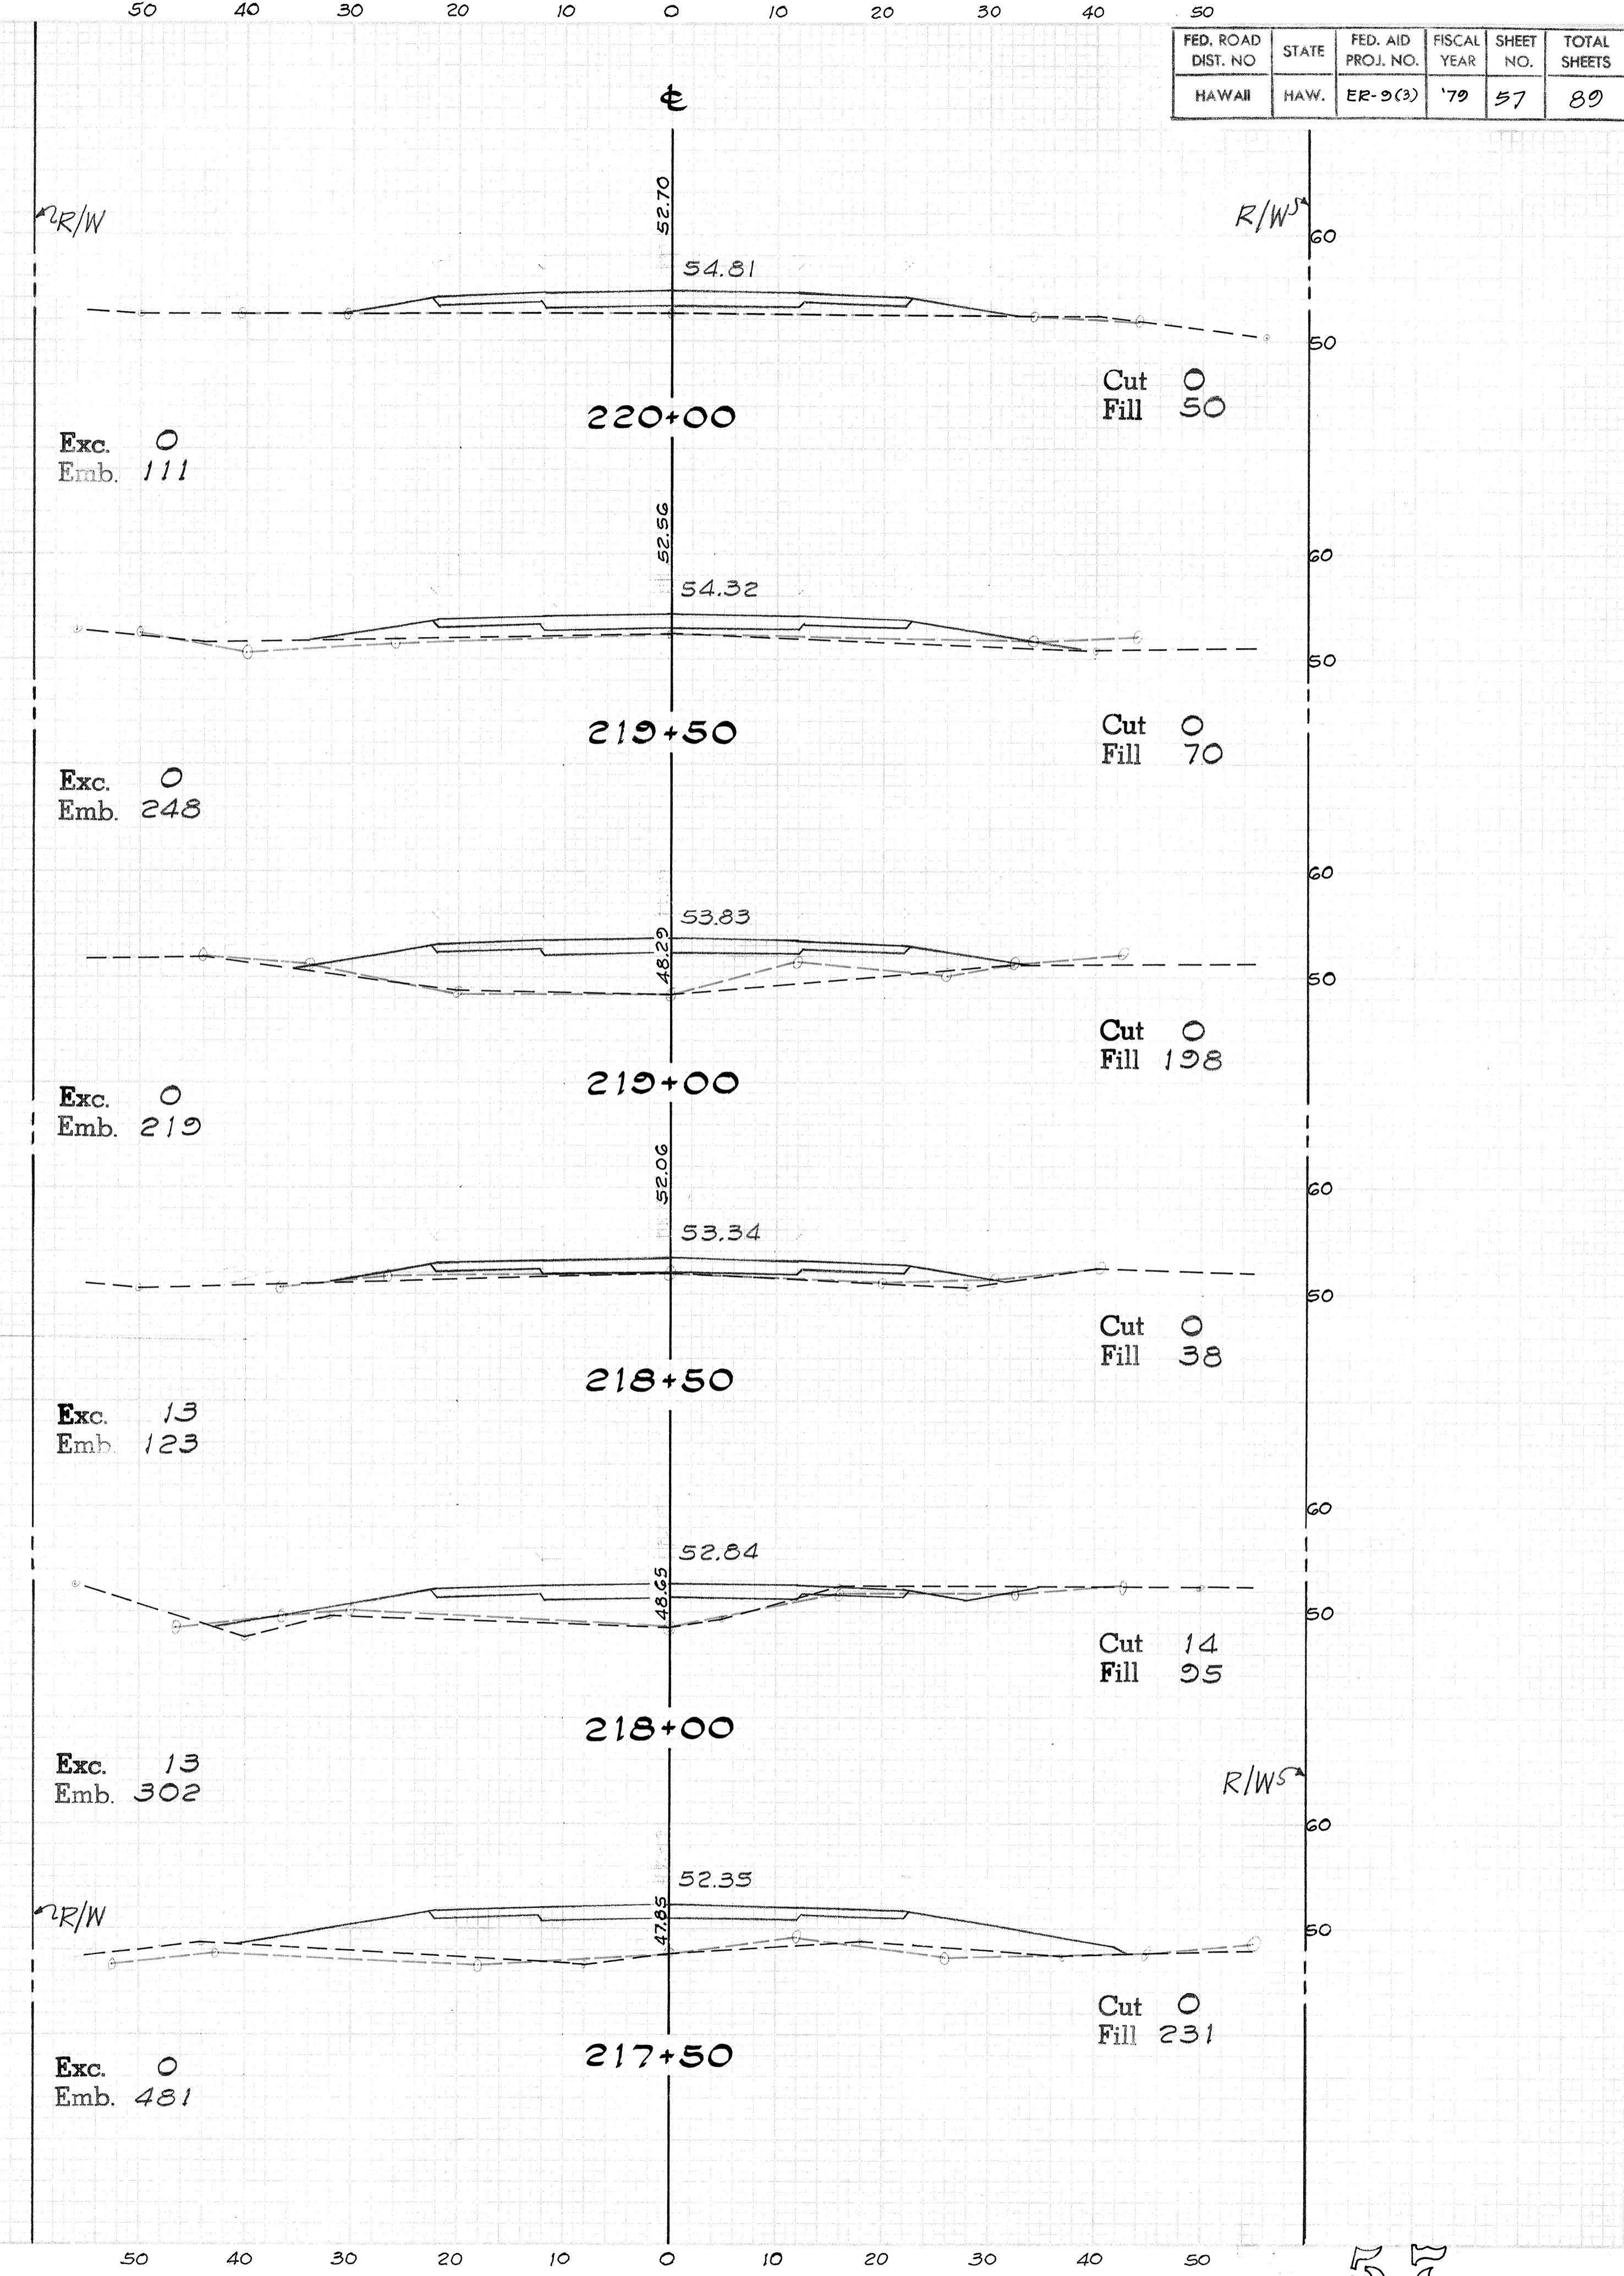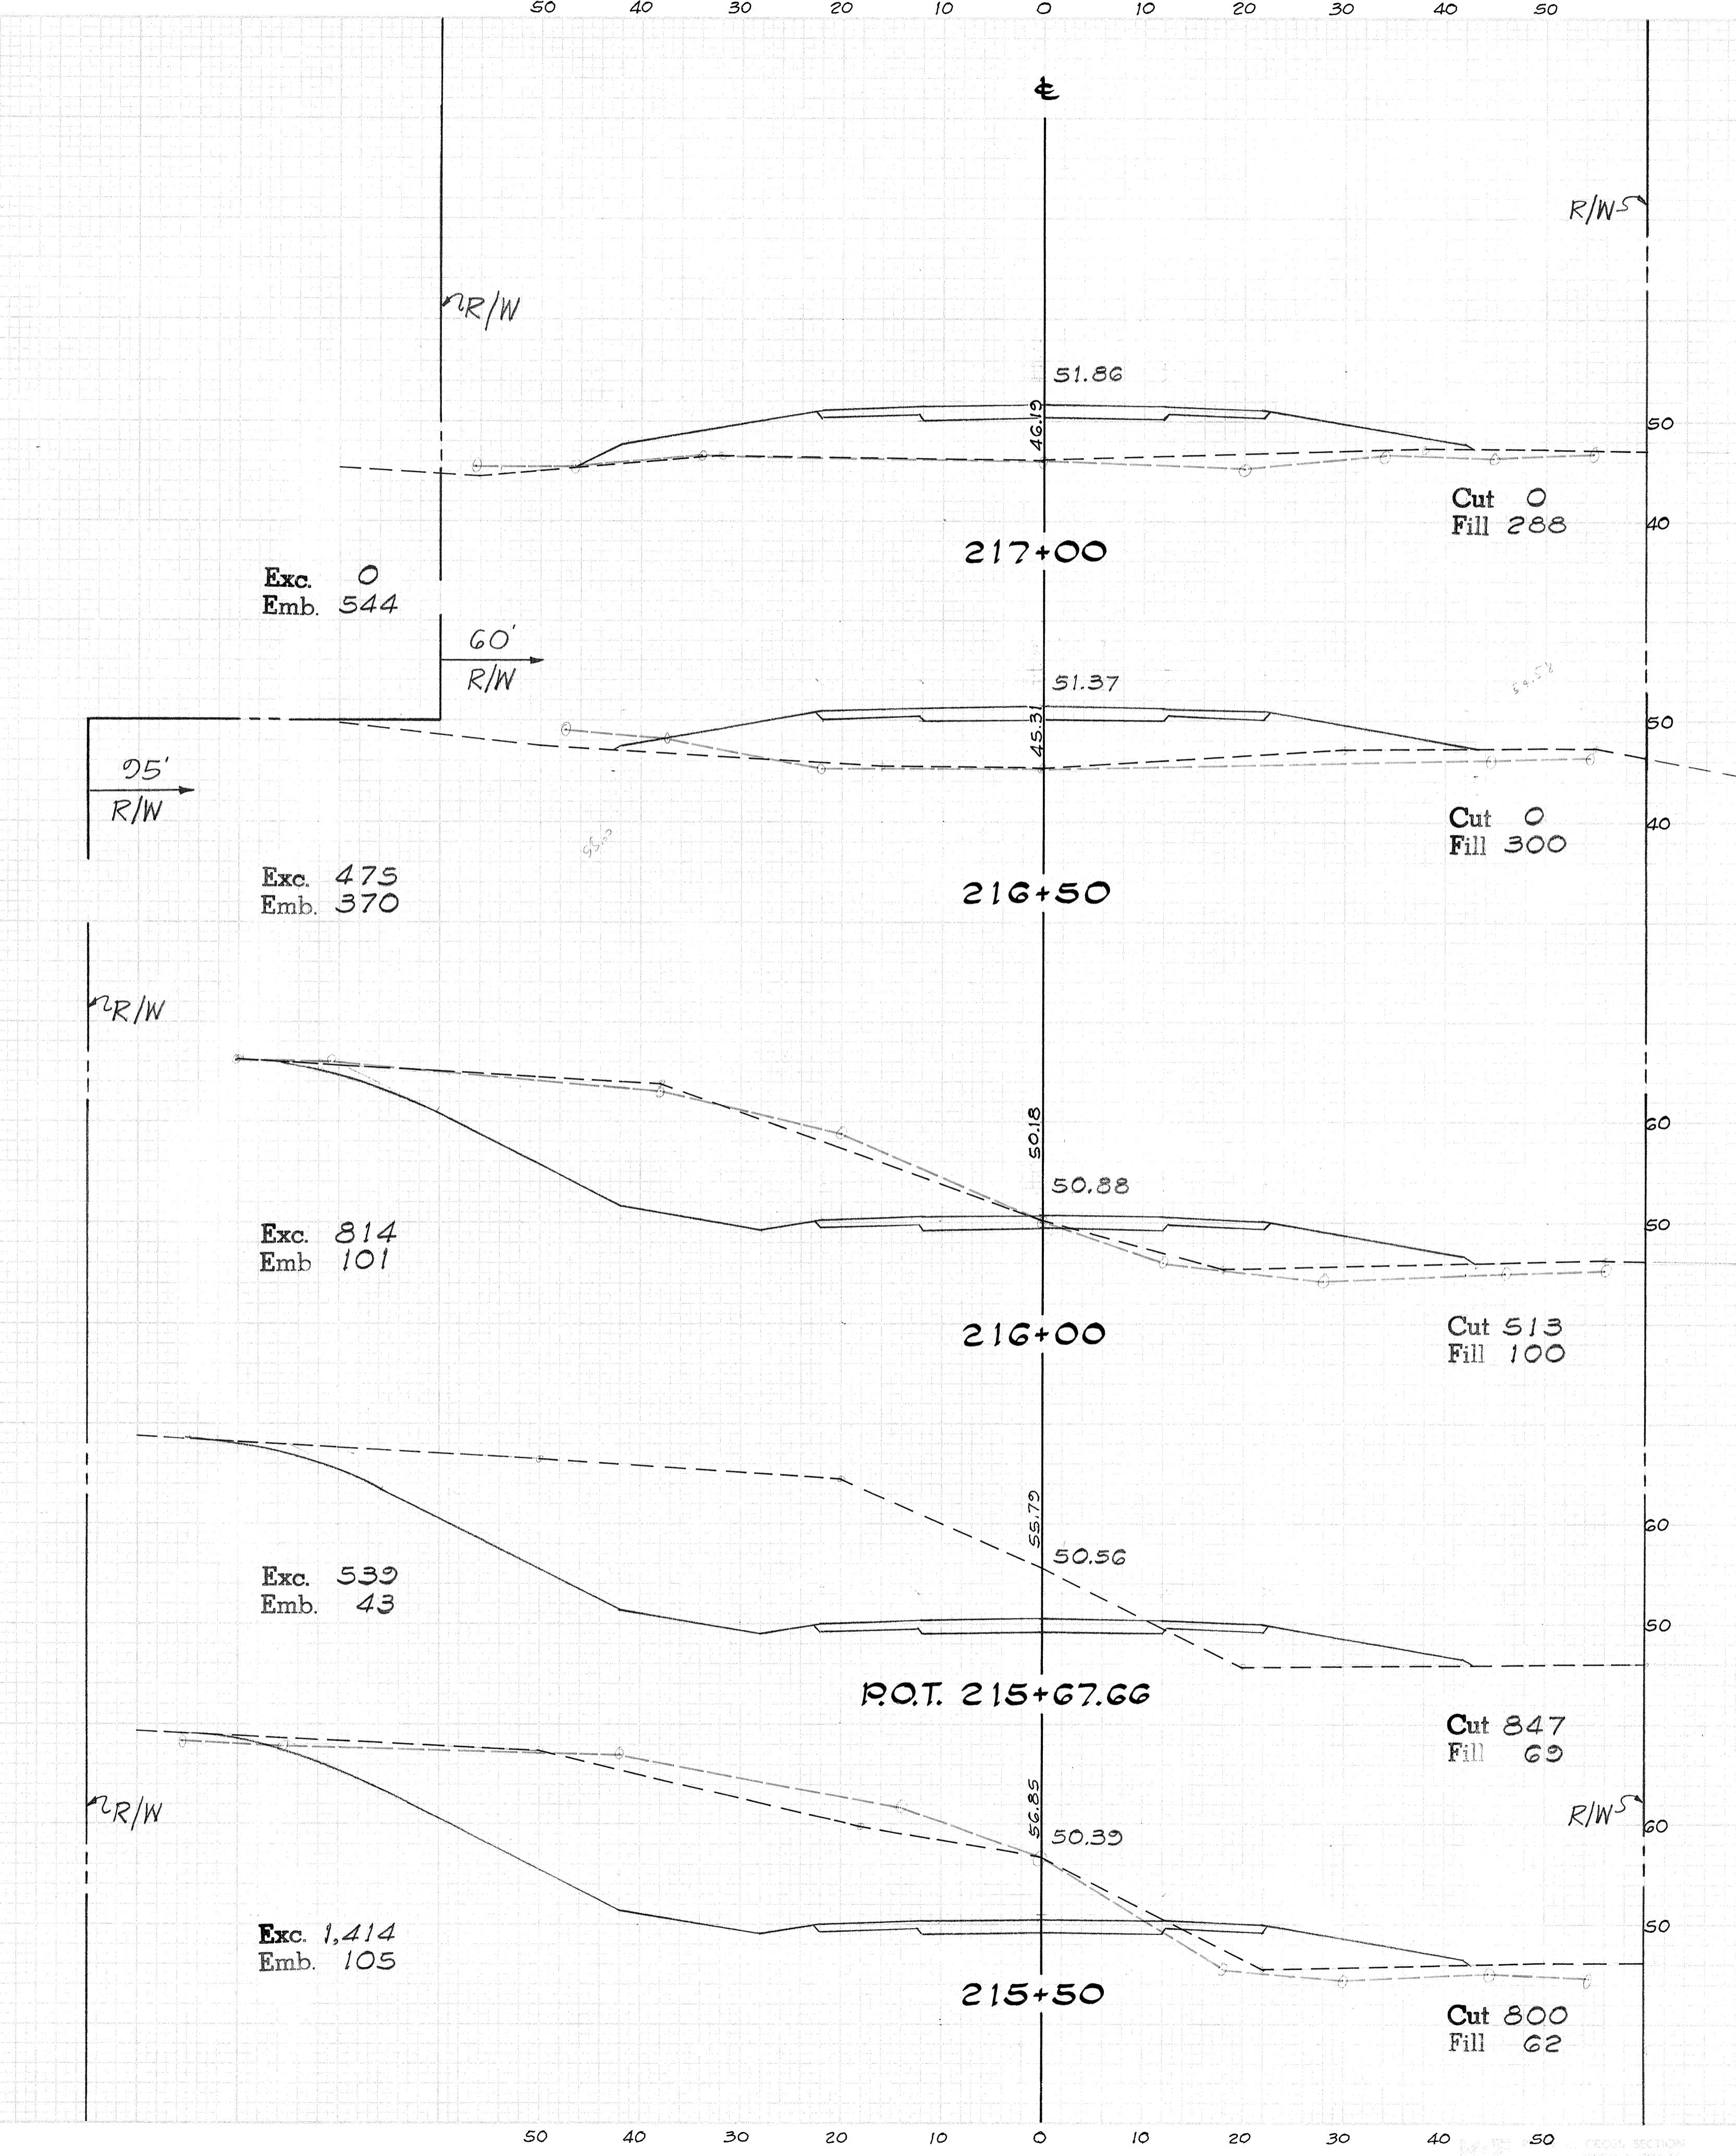



FED. ROAD DIST. NO.	STATE	FED. AID PROJ. NO.	FISCAL YEAR	SHEET NO.	TOTAL SHEETS
HAWAII	HAW.	ER-5(3)	'79	58	89

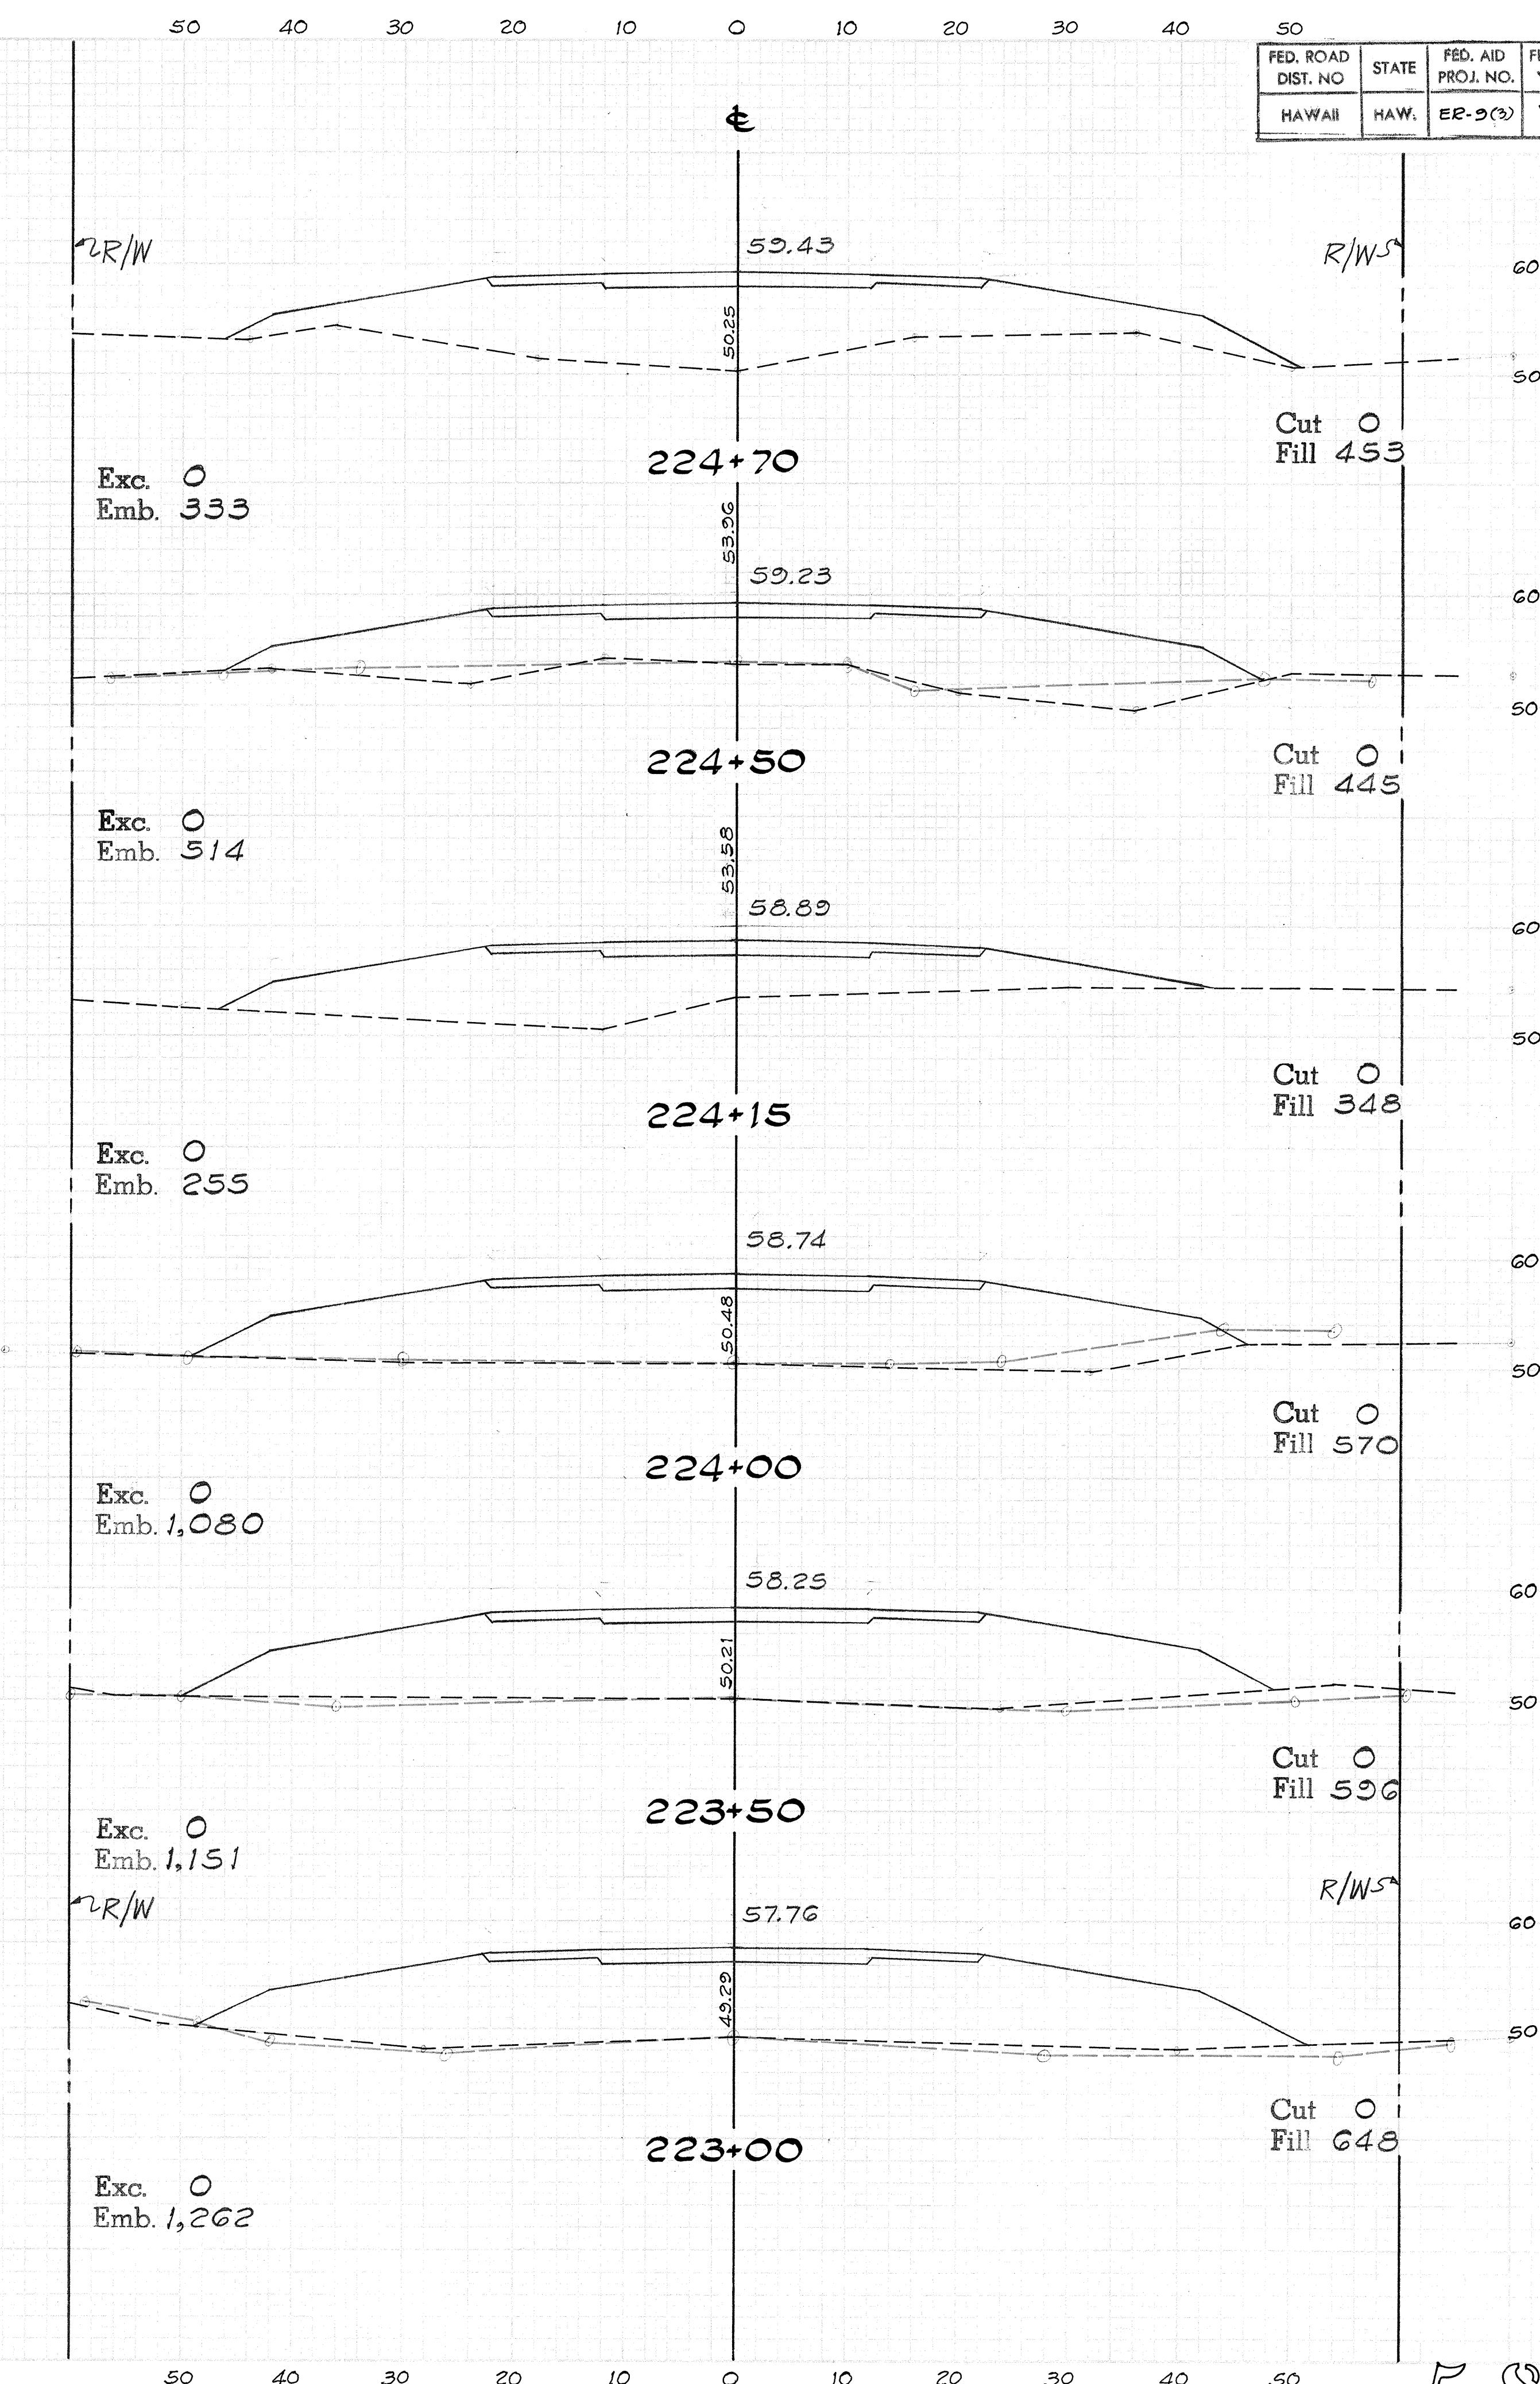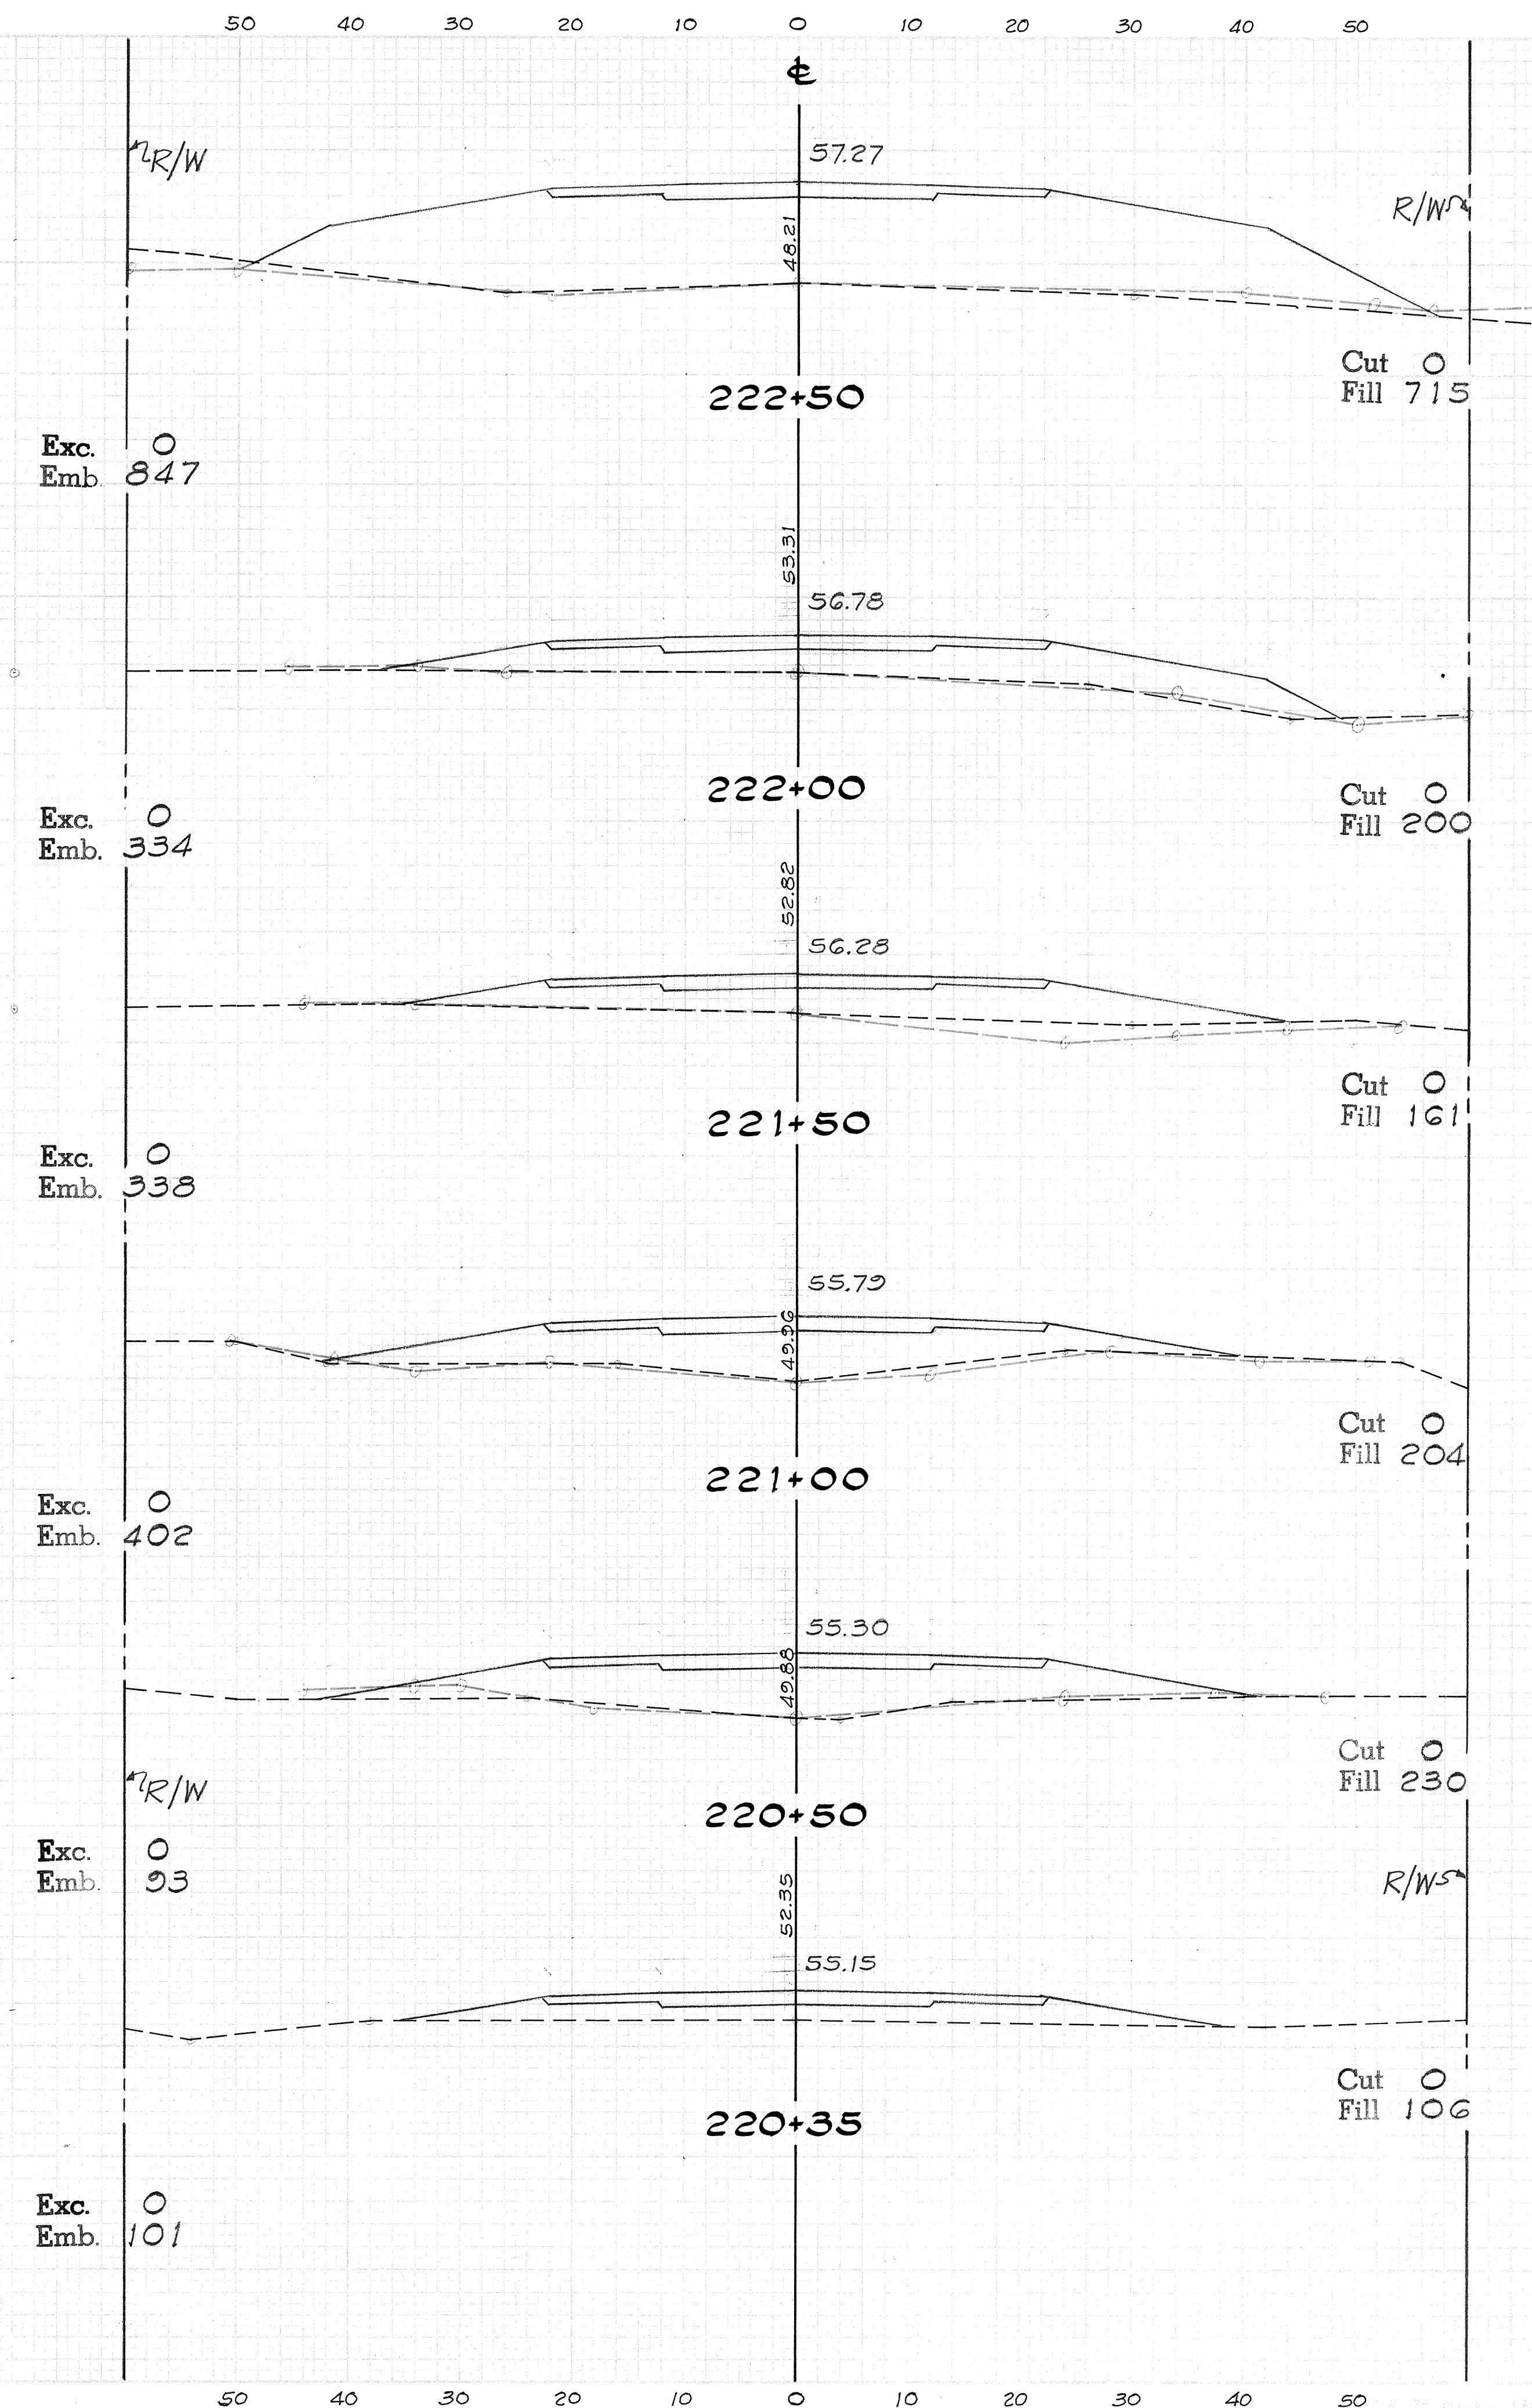

FED. ROAD DIST. NO.	STATE	FED. AID PROJ. NO.	FISCAL YEAR	SHEET NO.	TOTAL SHEETS
HAWAII	HAW.	ER-9(3)	'79	59	89

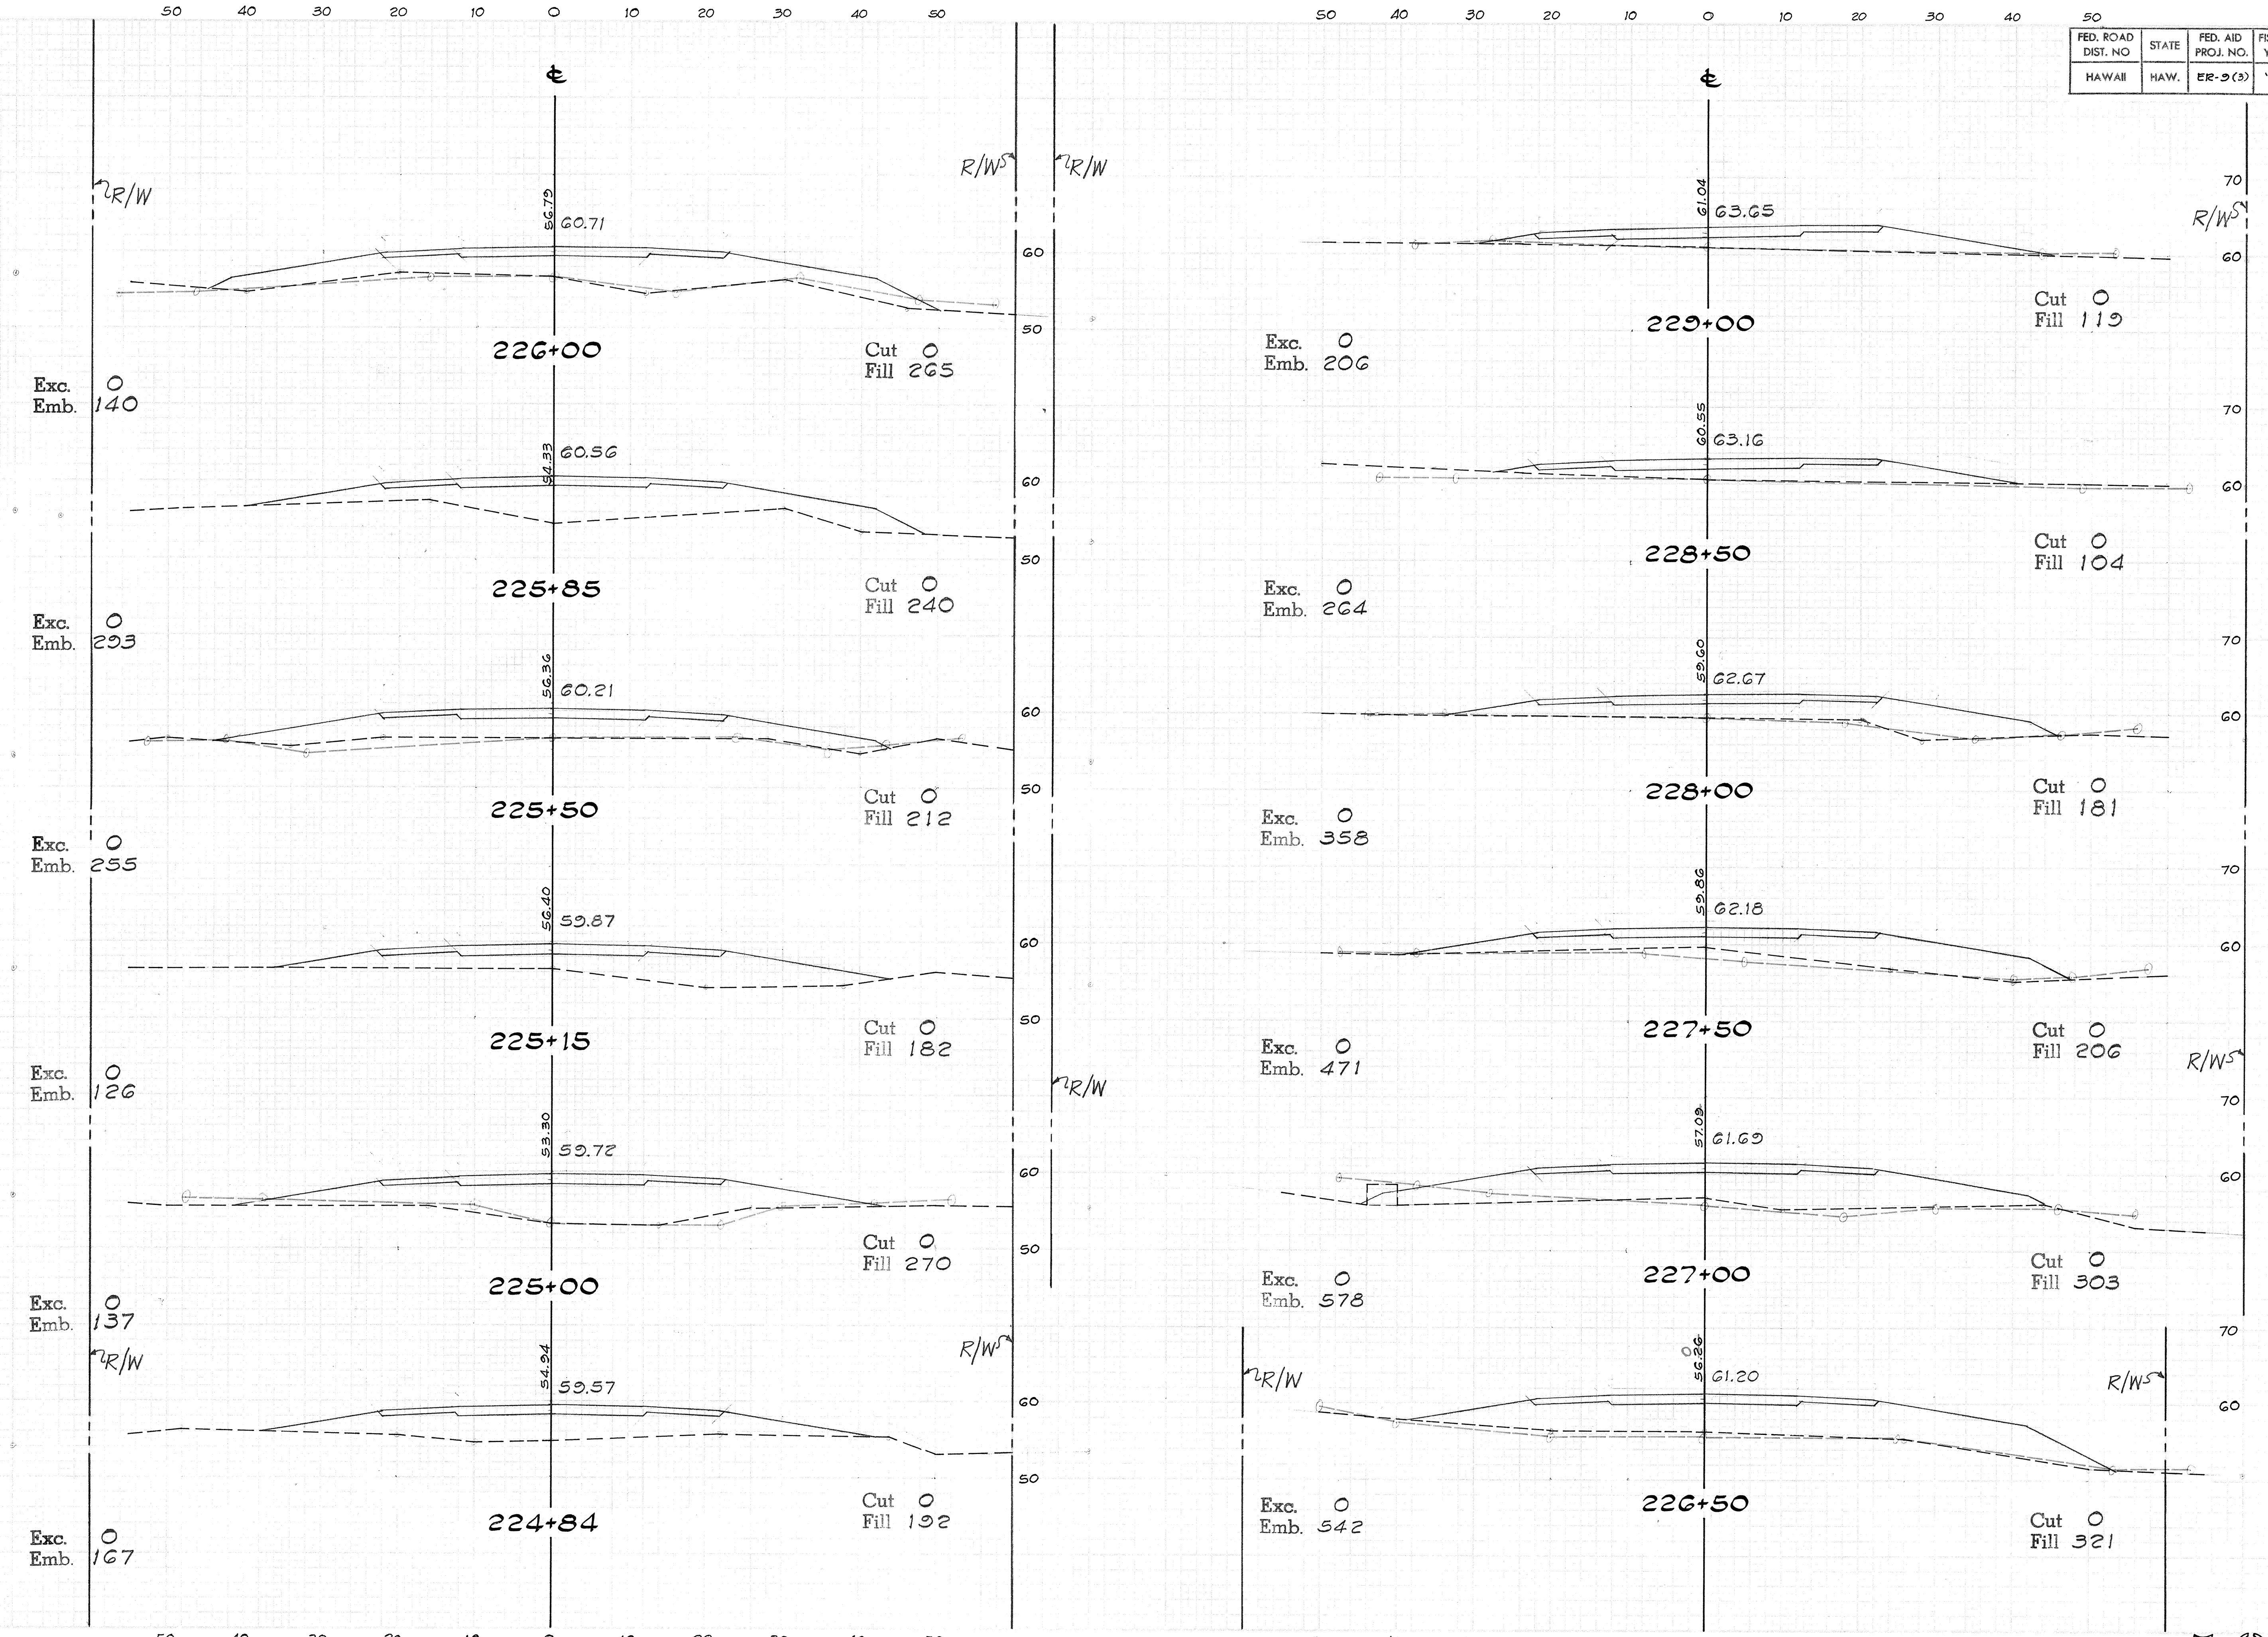

FED. ROAD DIST. NO.	STATE	FED. AID PROJ. NO.	FISCAL YEAR	SHEET NO.	TOTAL SHEETS
HAWAII	HAW.	ER-9(3)	'79	60	89

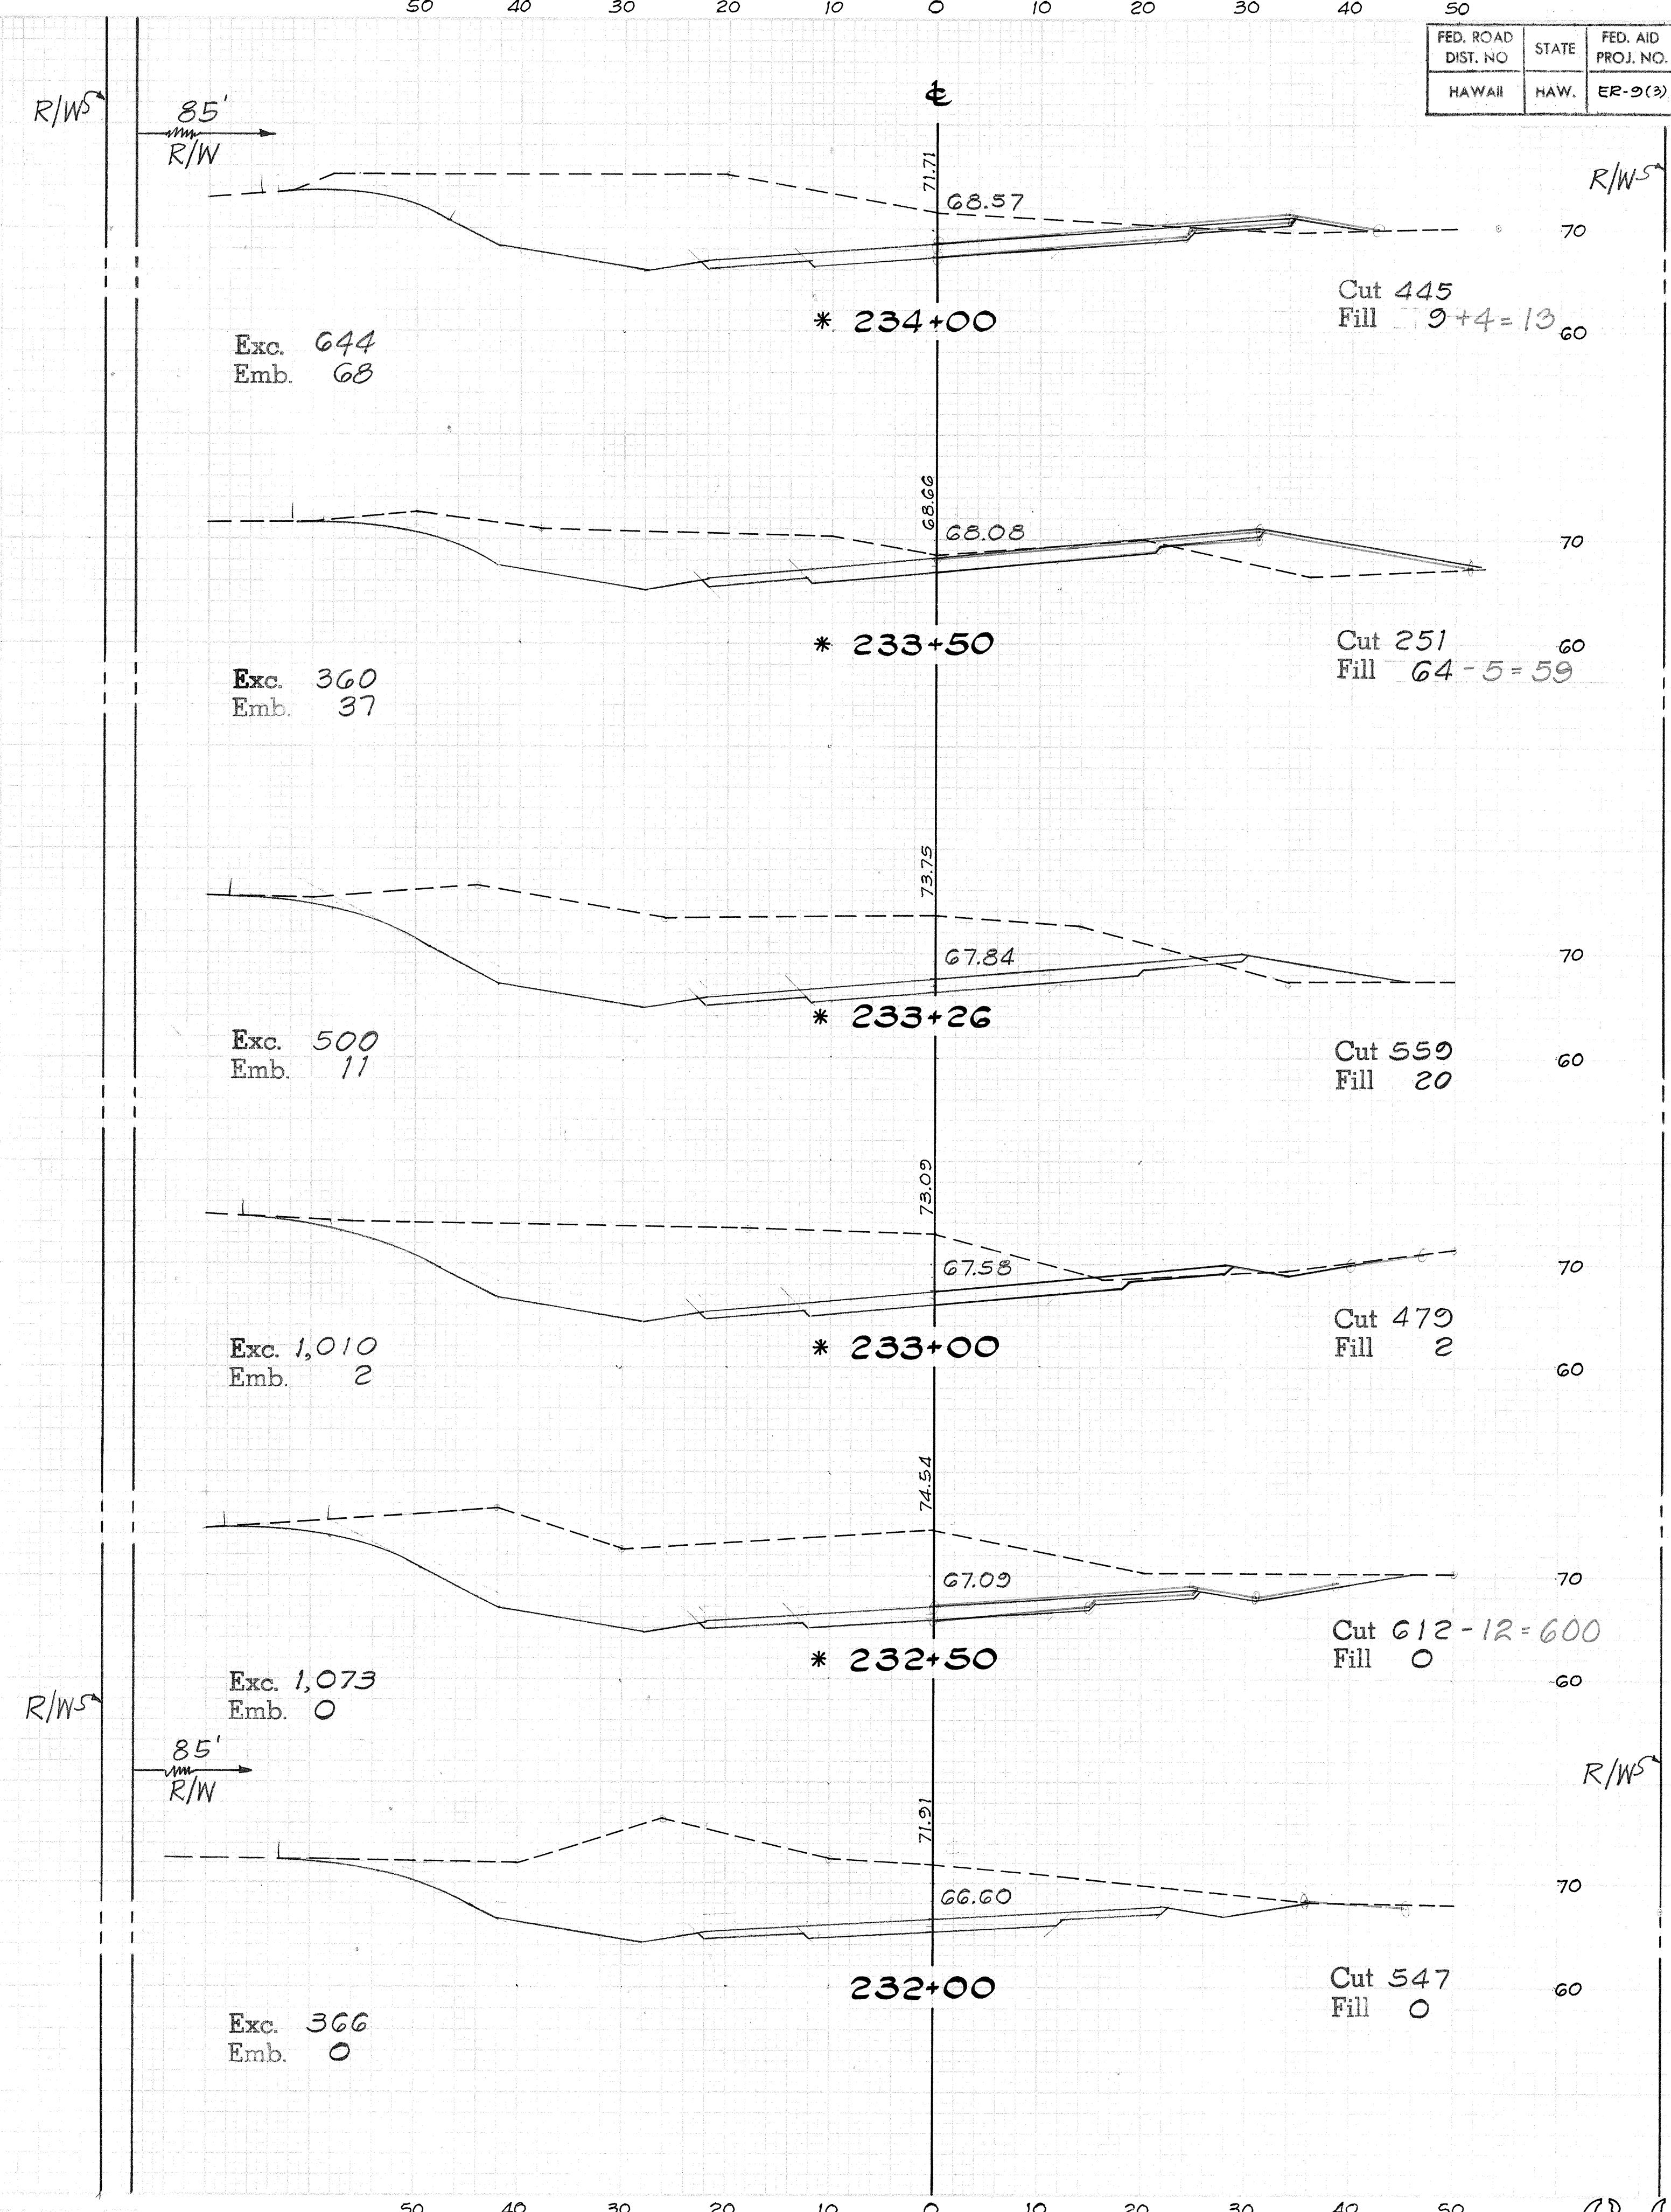
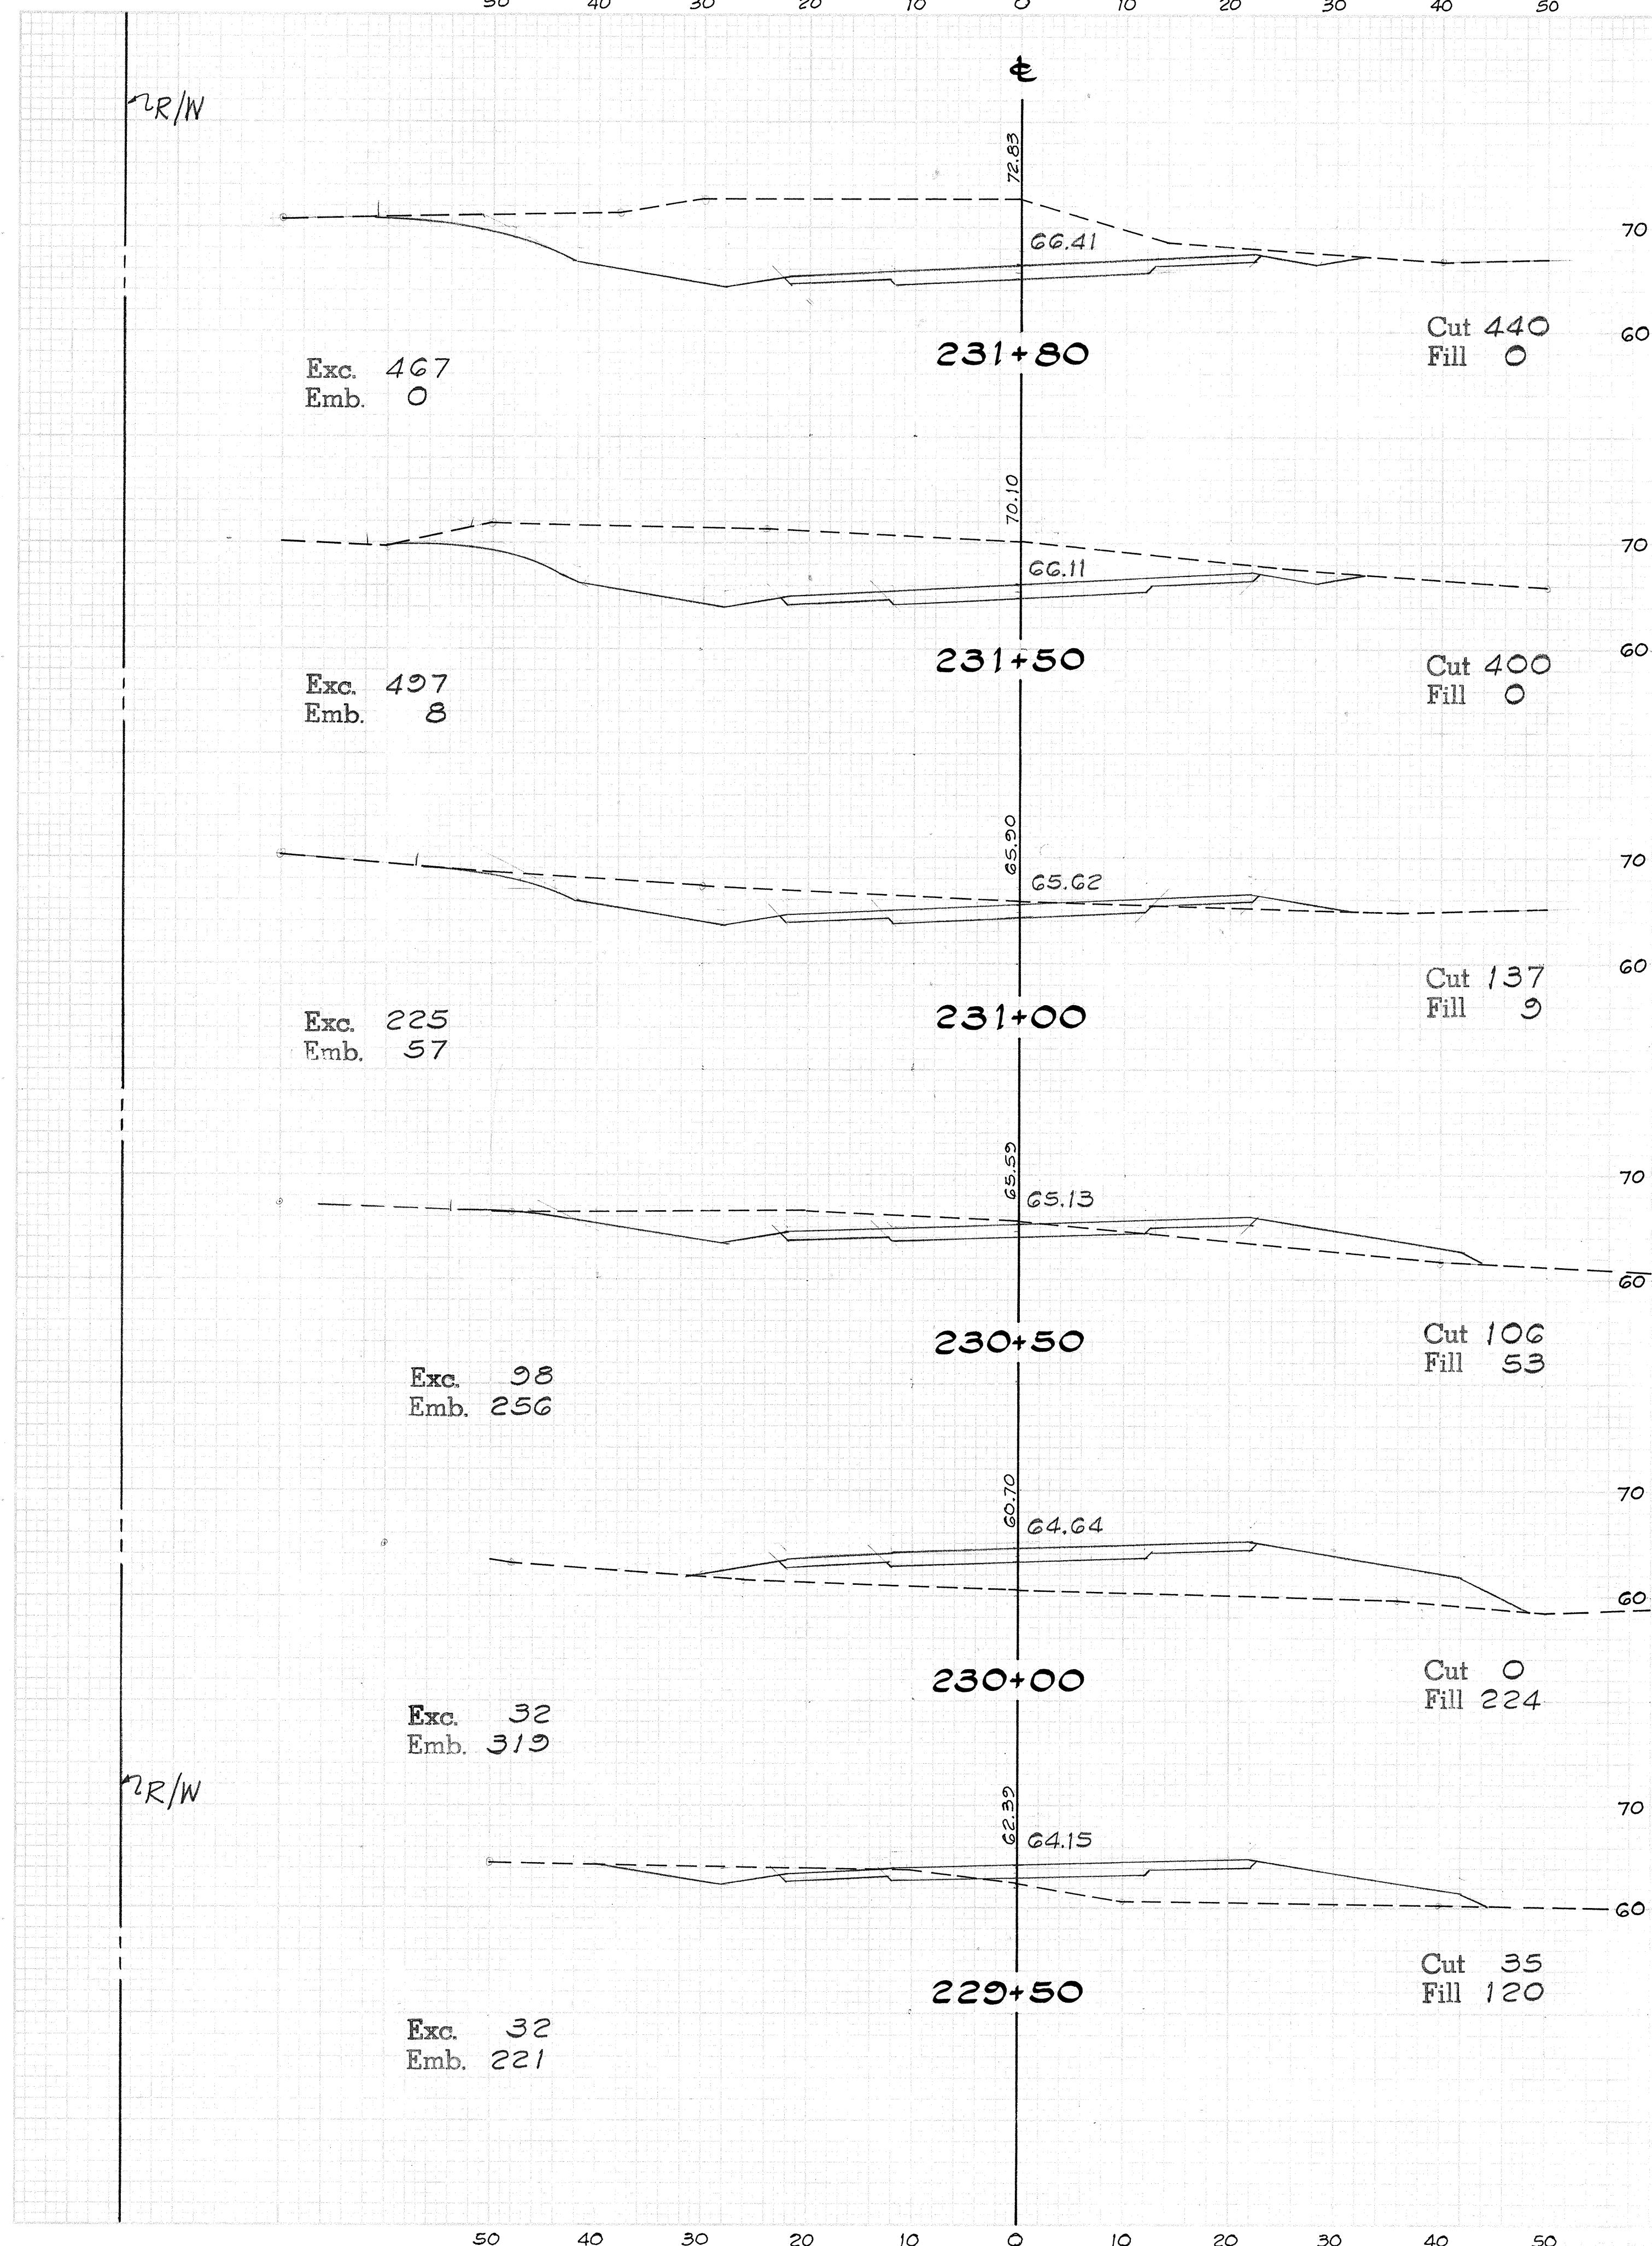



\* = Notes Revisions

REVISED BY C.C.O. # 4

(D) (1)



FED. ROAD DIST. NO.	STATE	FED. AID PROJ. NO.	FISCAL YEAR	SHEET NO.	TOTAL SHEETS
HAWAII	HAW.	ER-9(3)	'79	61	89

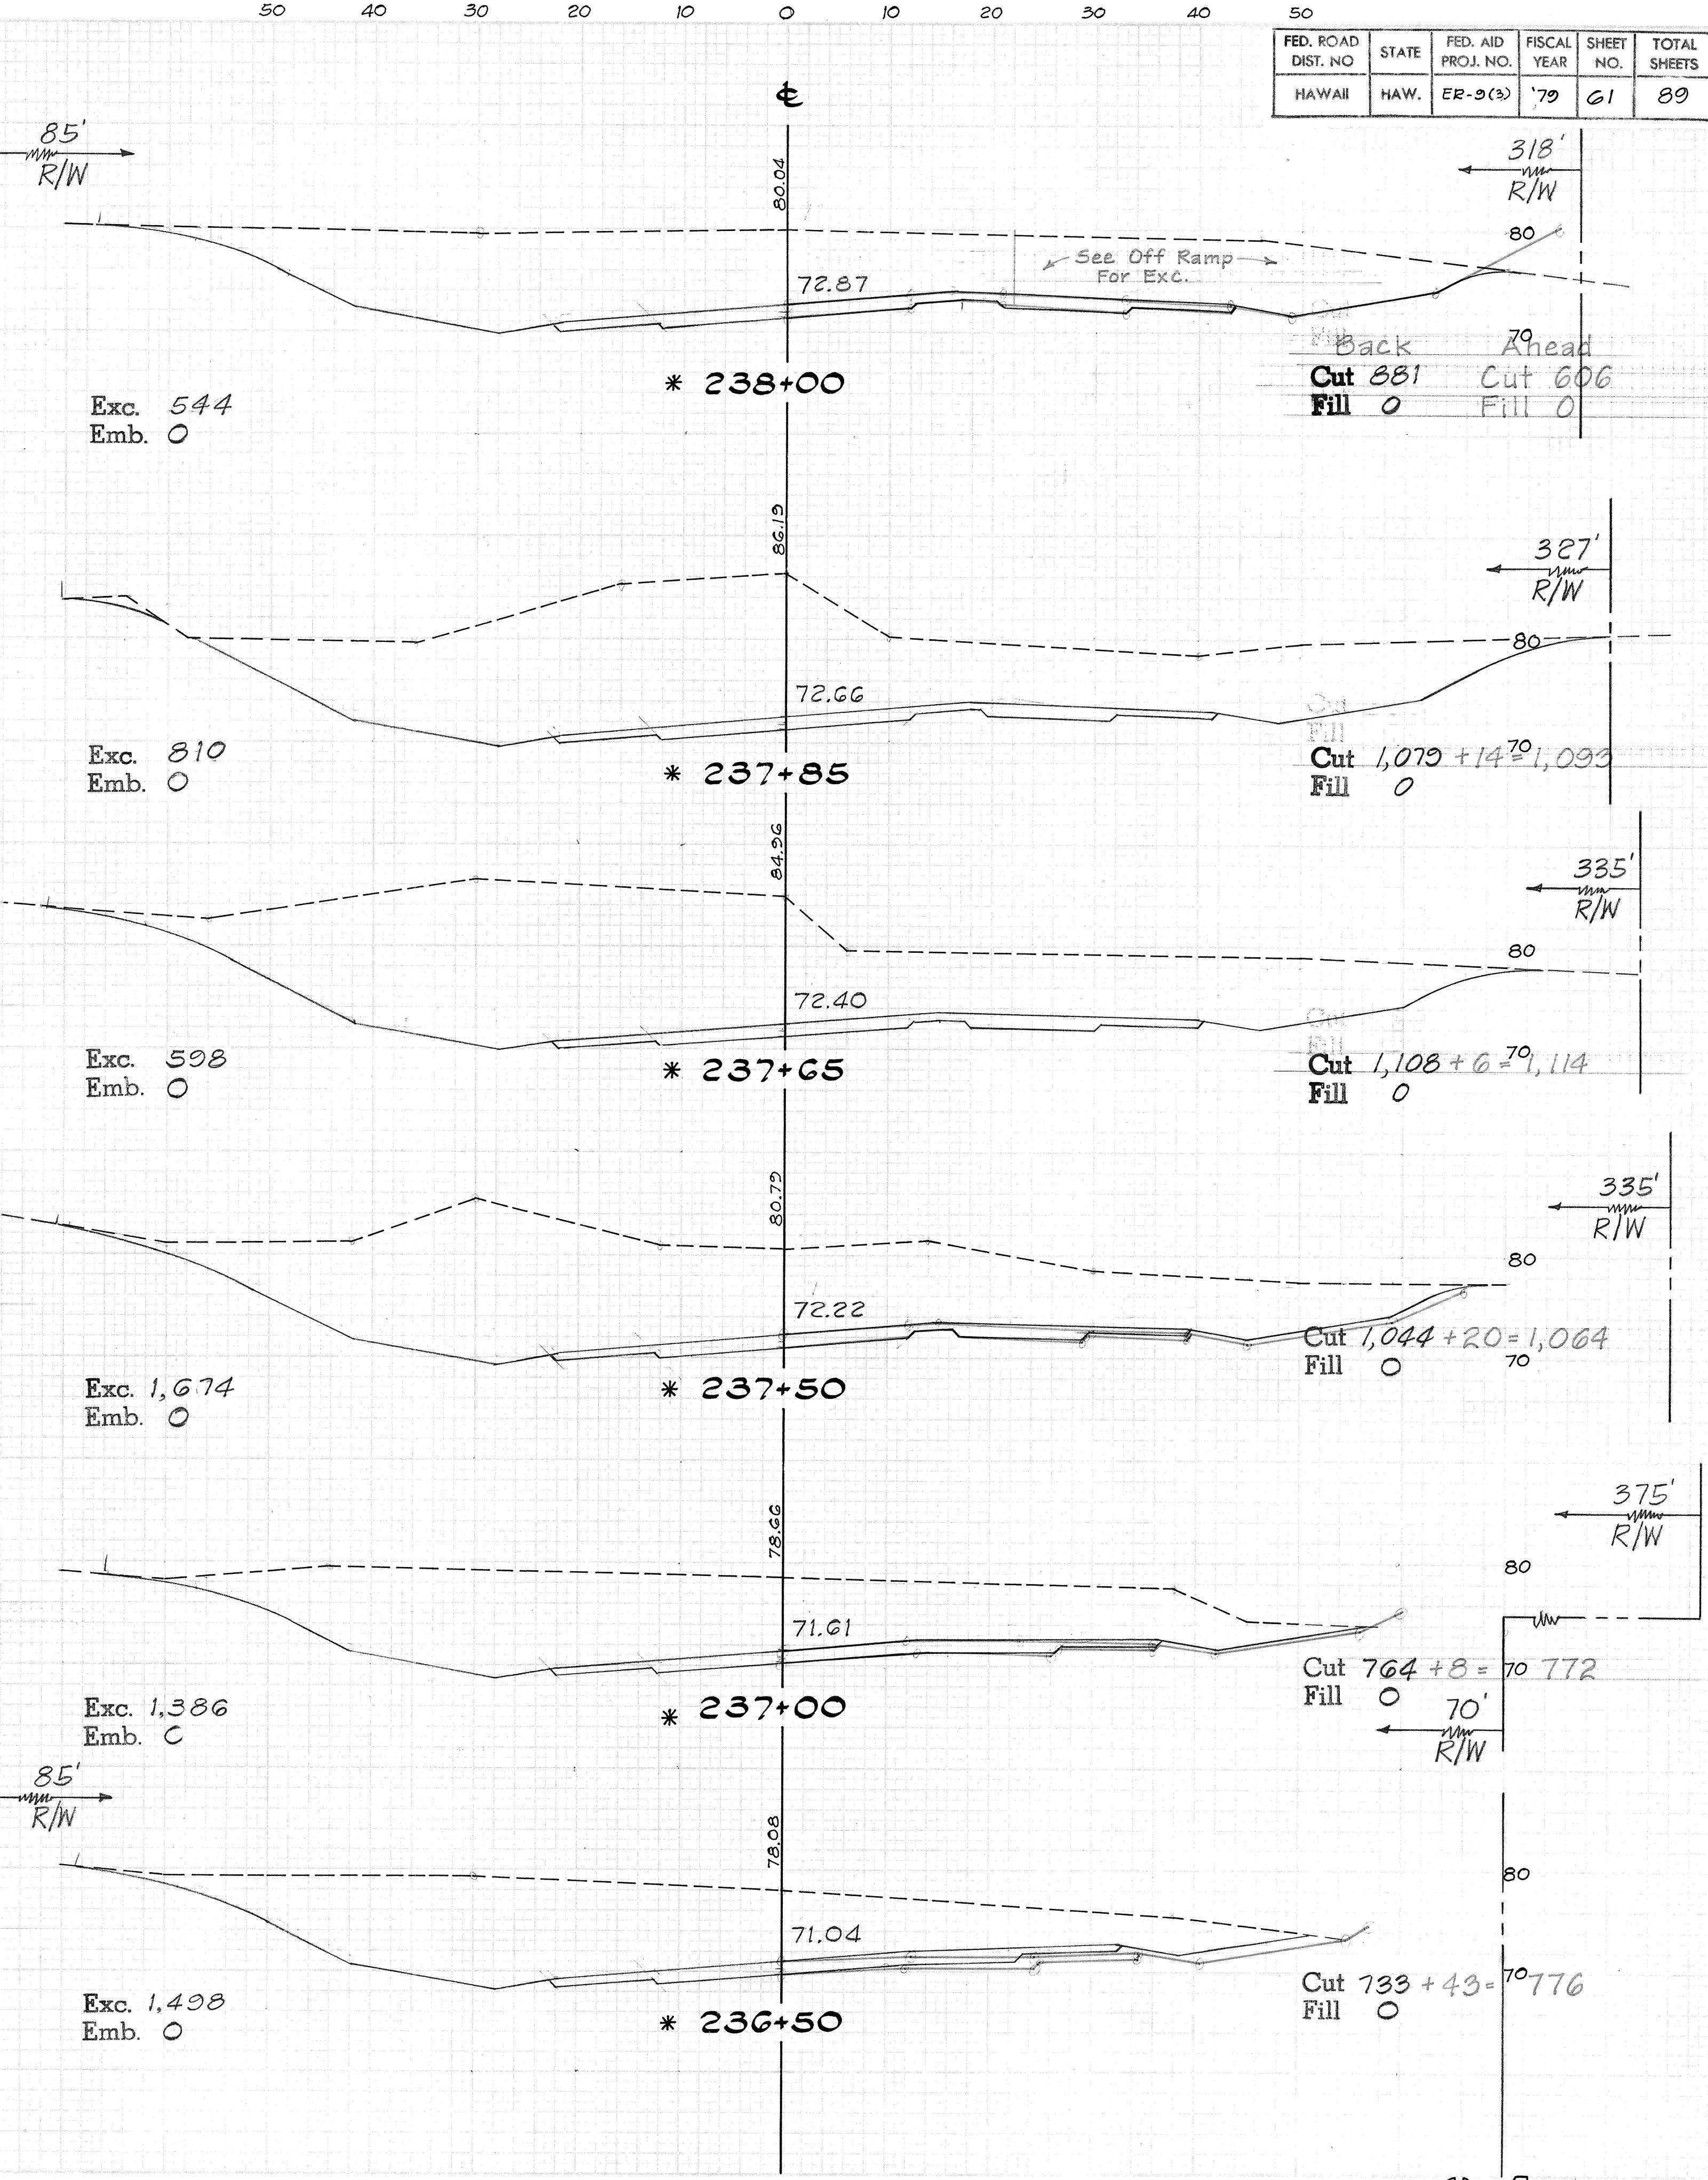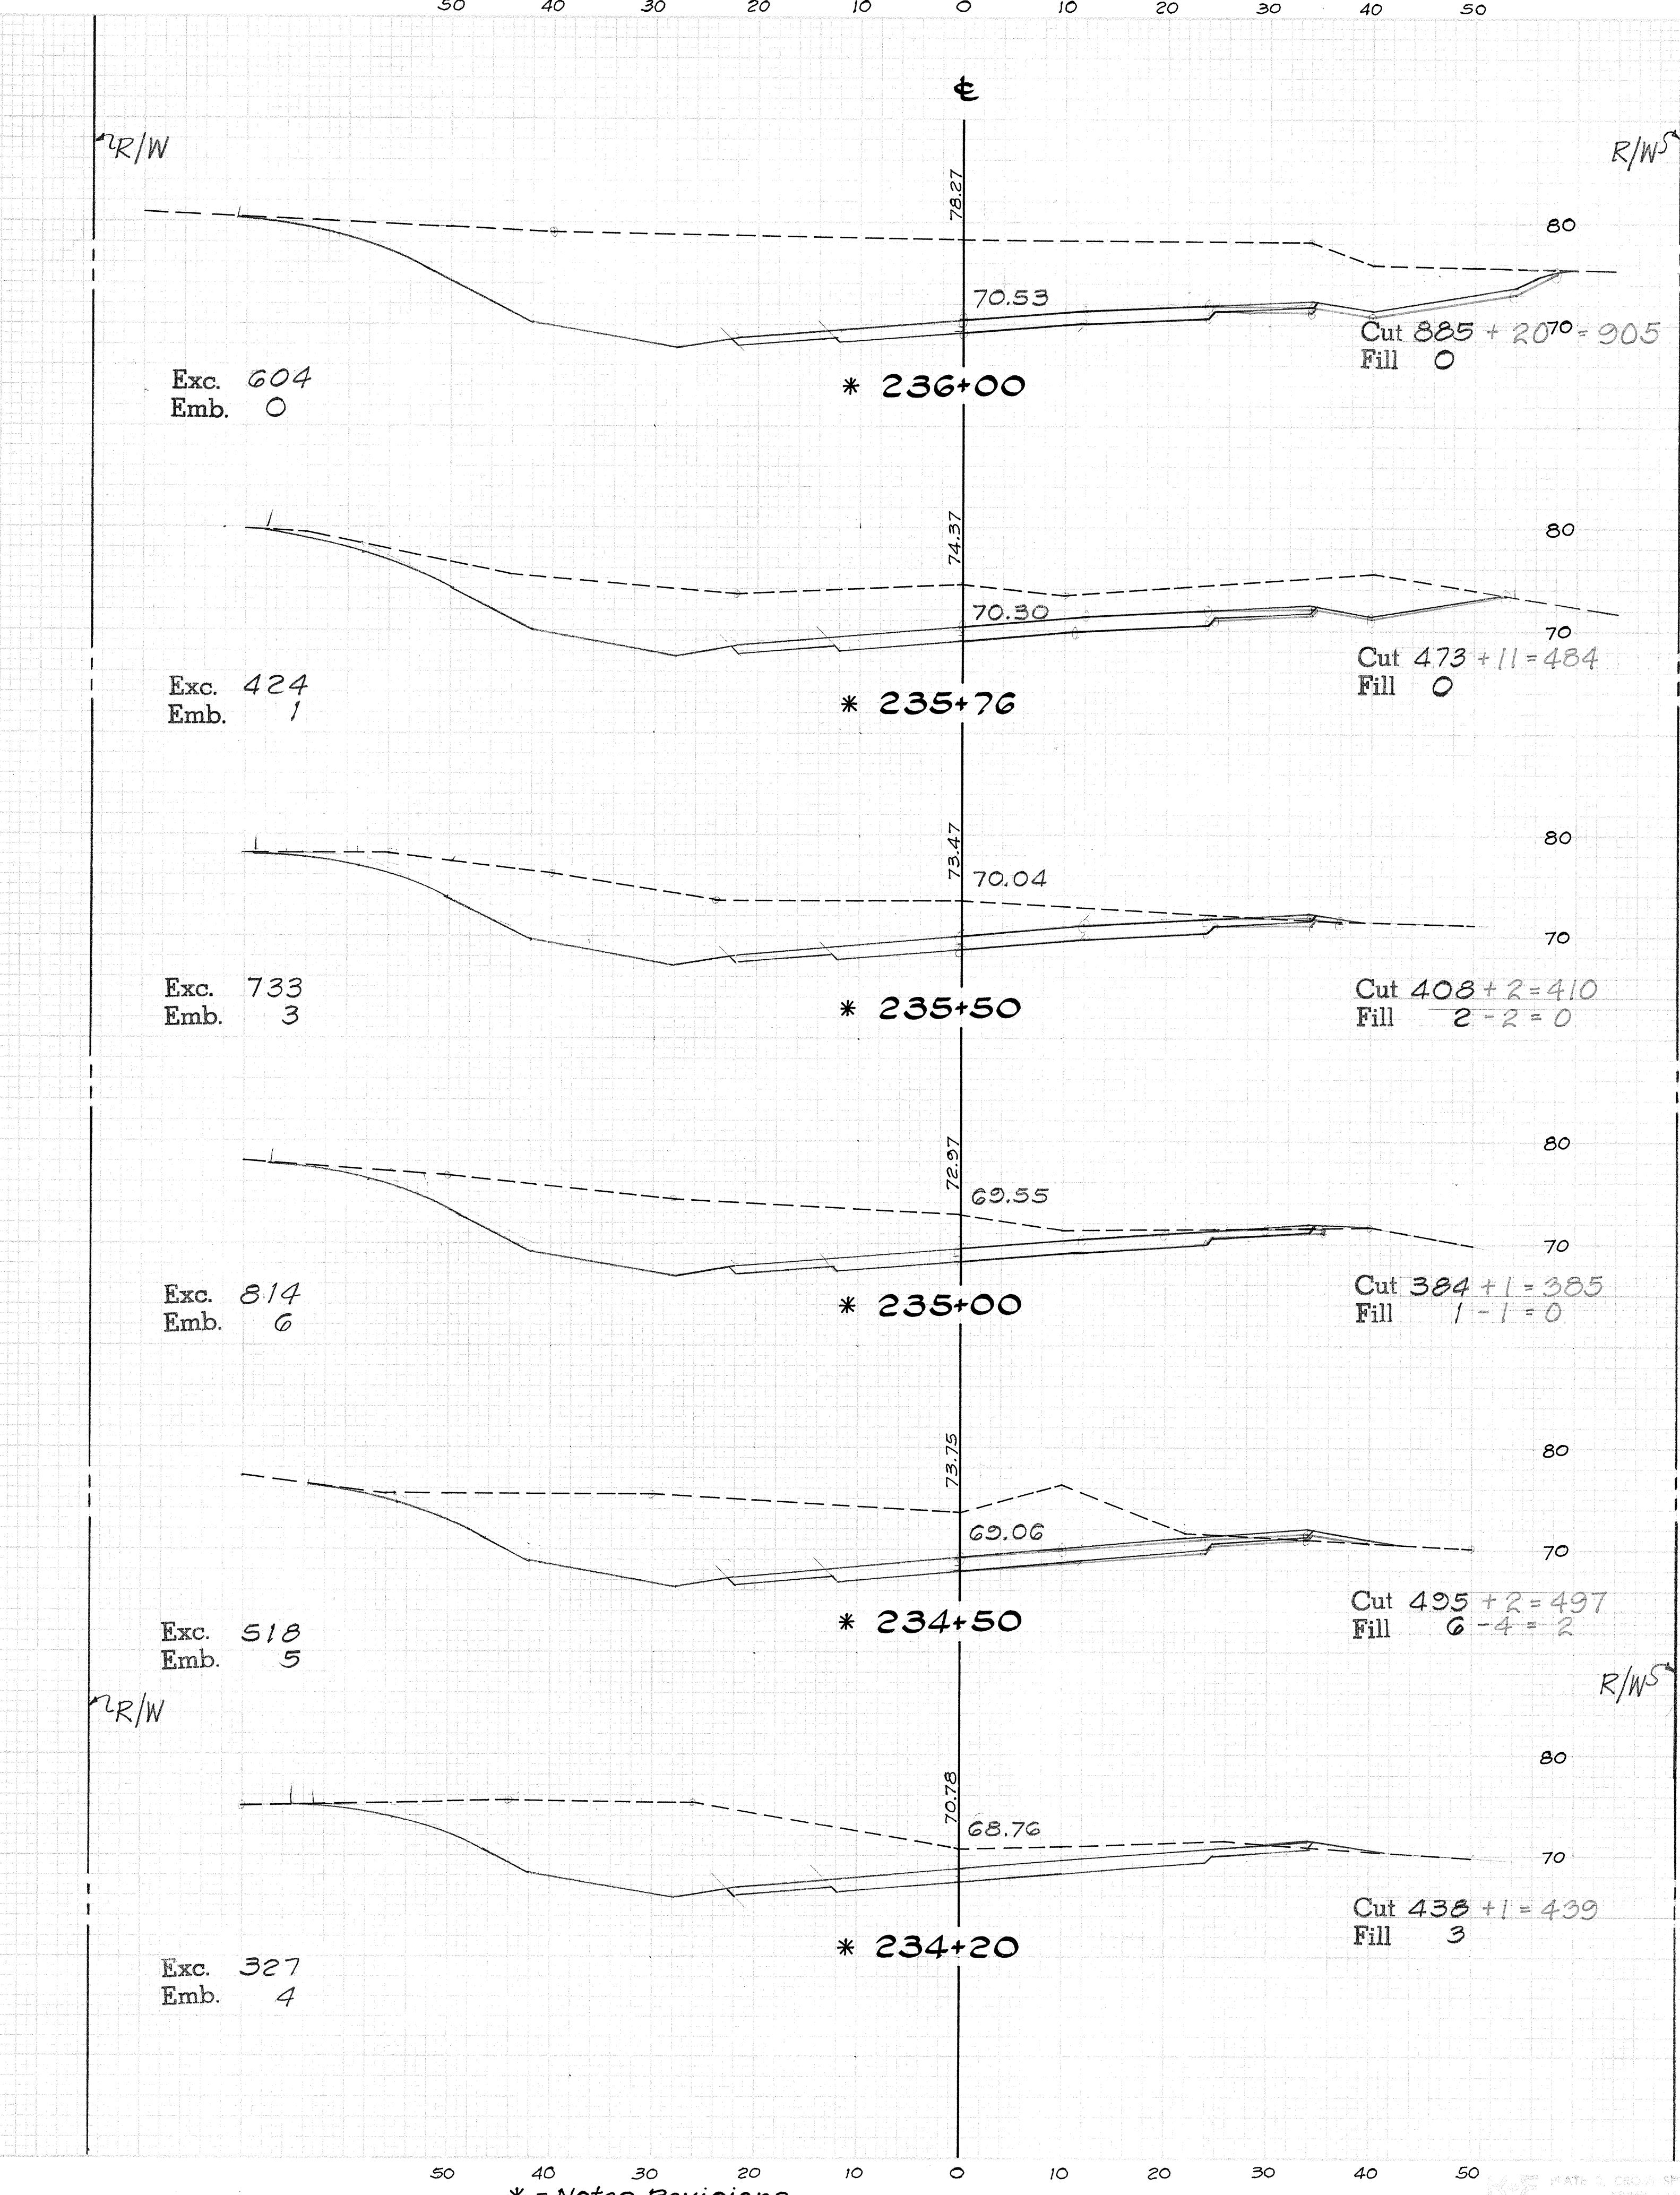

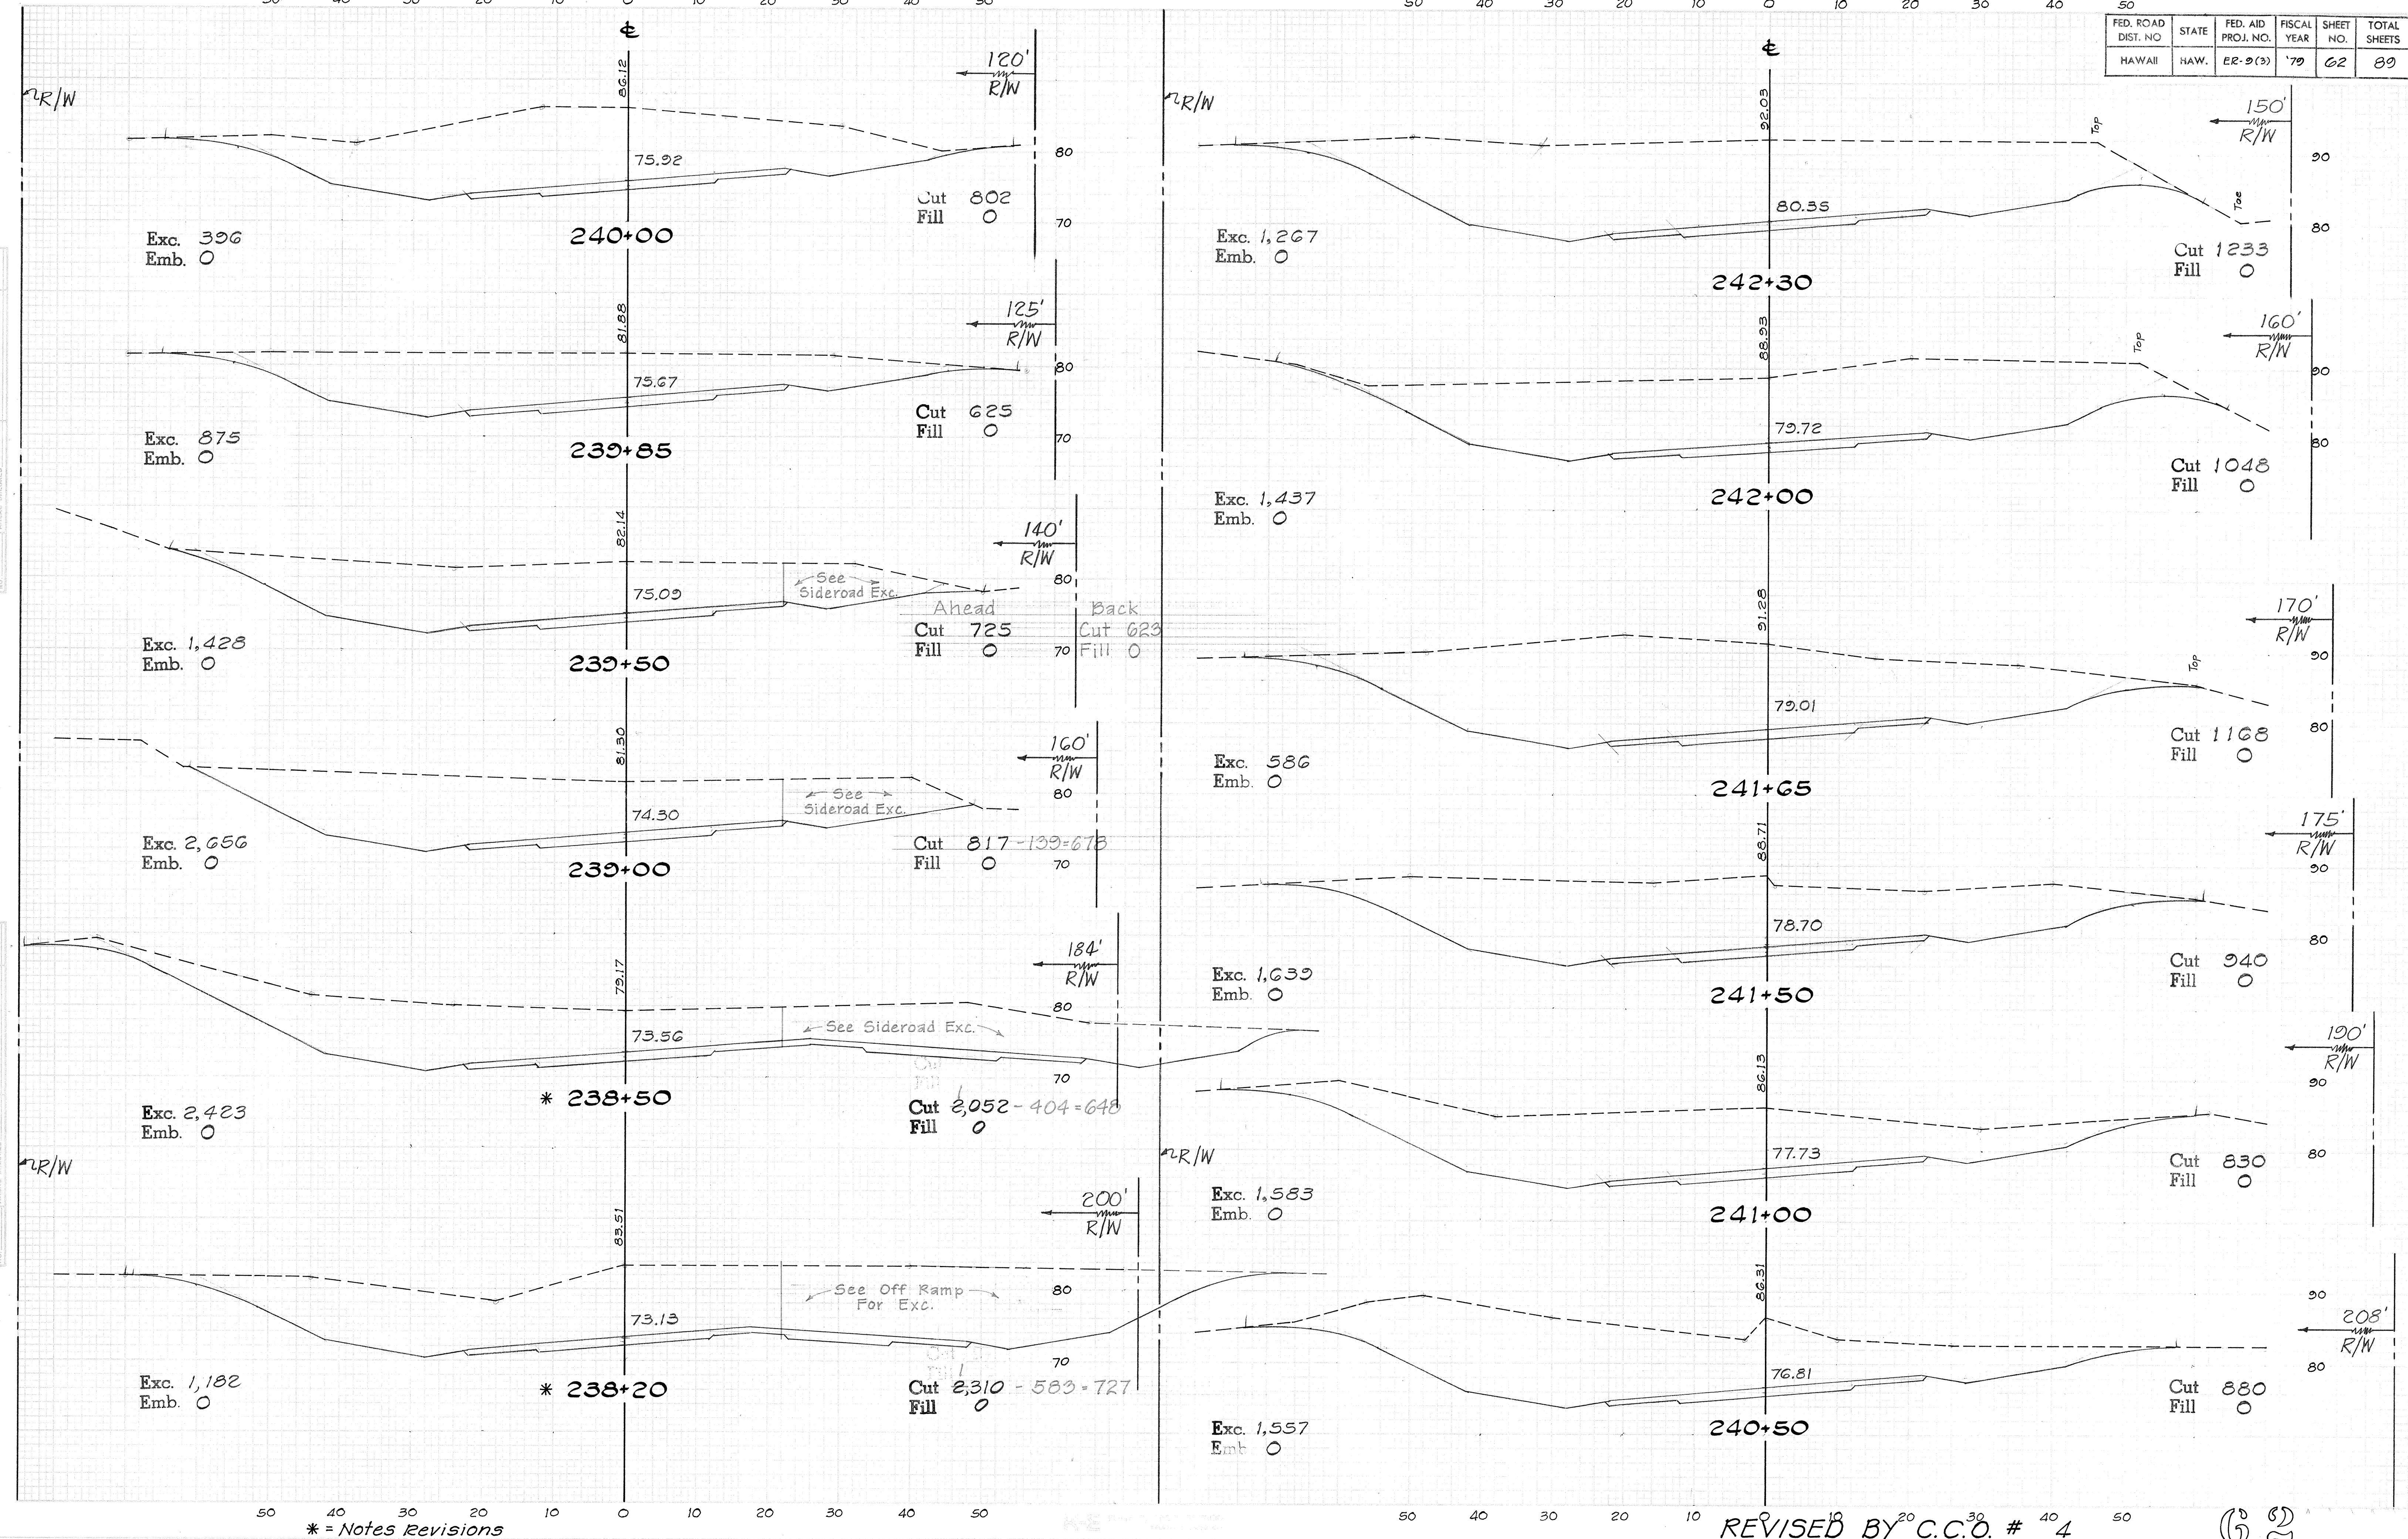

\* = Notes Revisions

FED. ROAD DIST. NO	STATE	FED. AID PROJ. NO.	FISCAL YEAR	SHEET NO.	TOTAL SHEETS
HAWAII	HAW.	ER-9(3)	'79	63	89

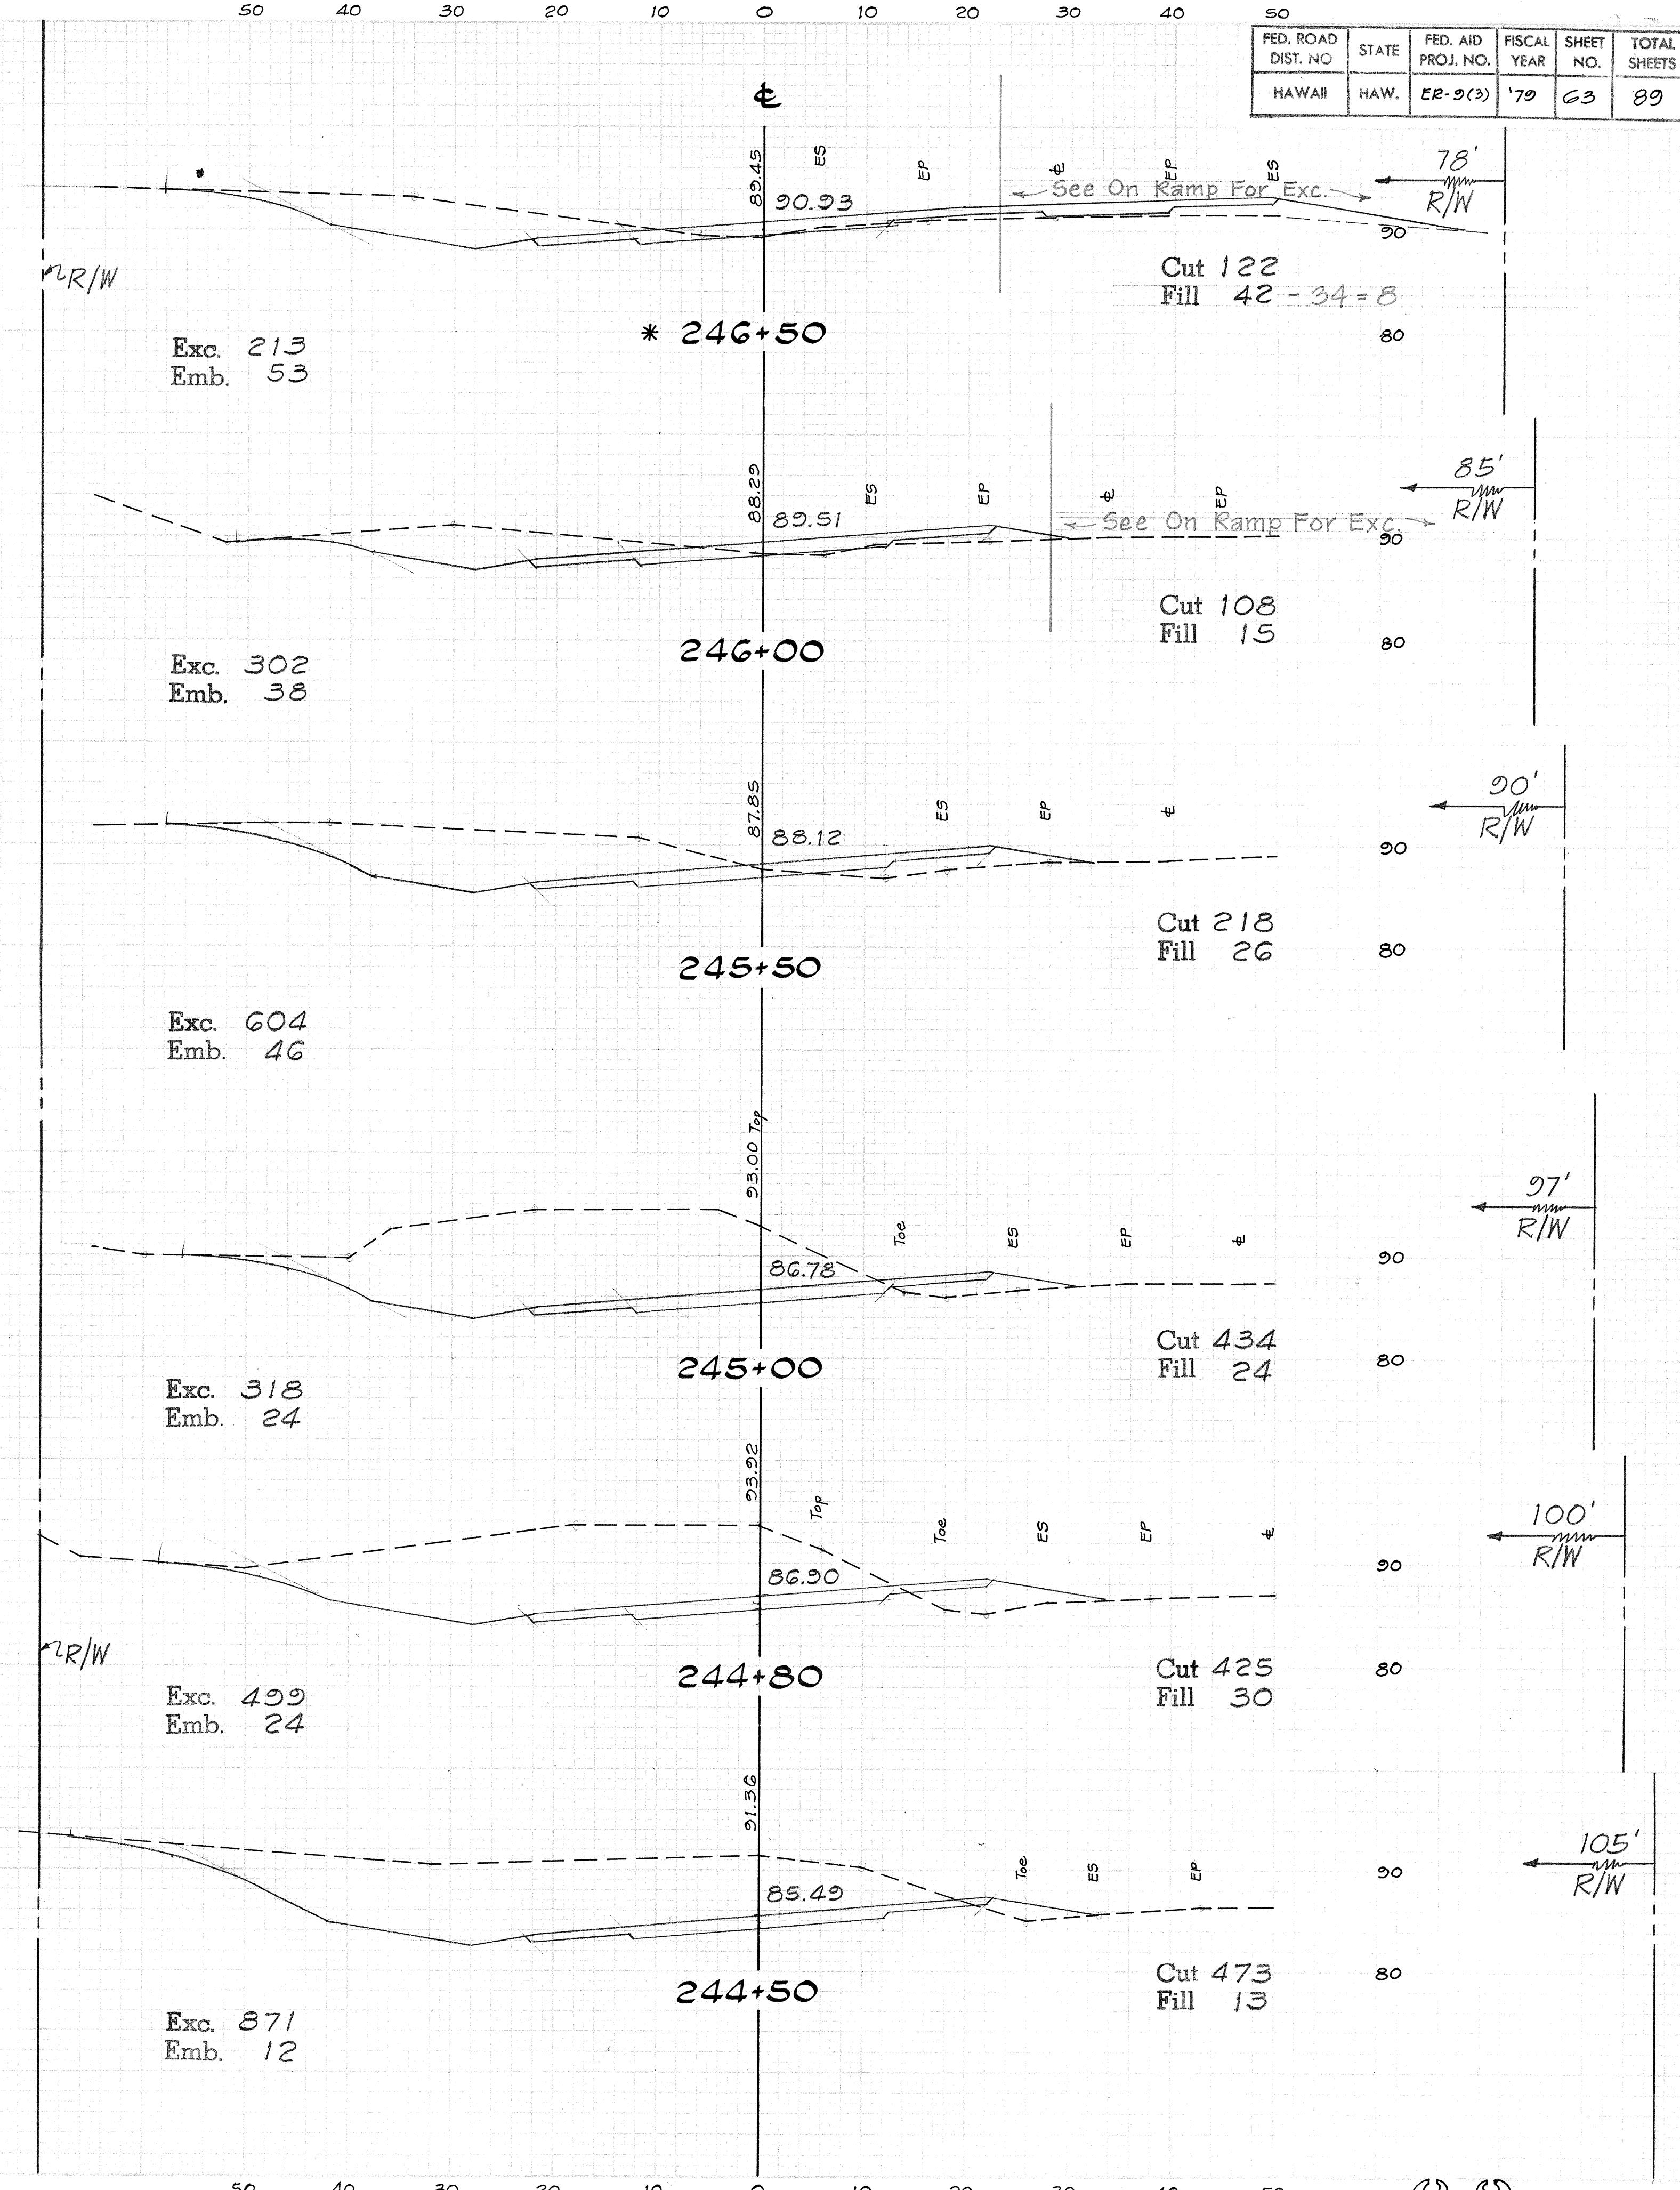
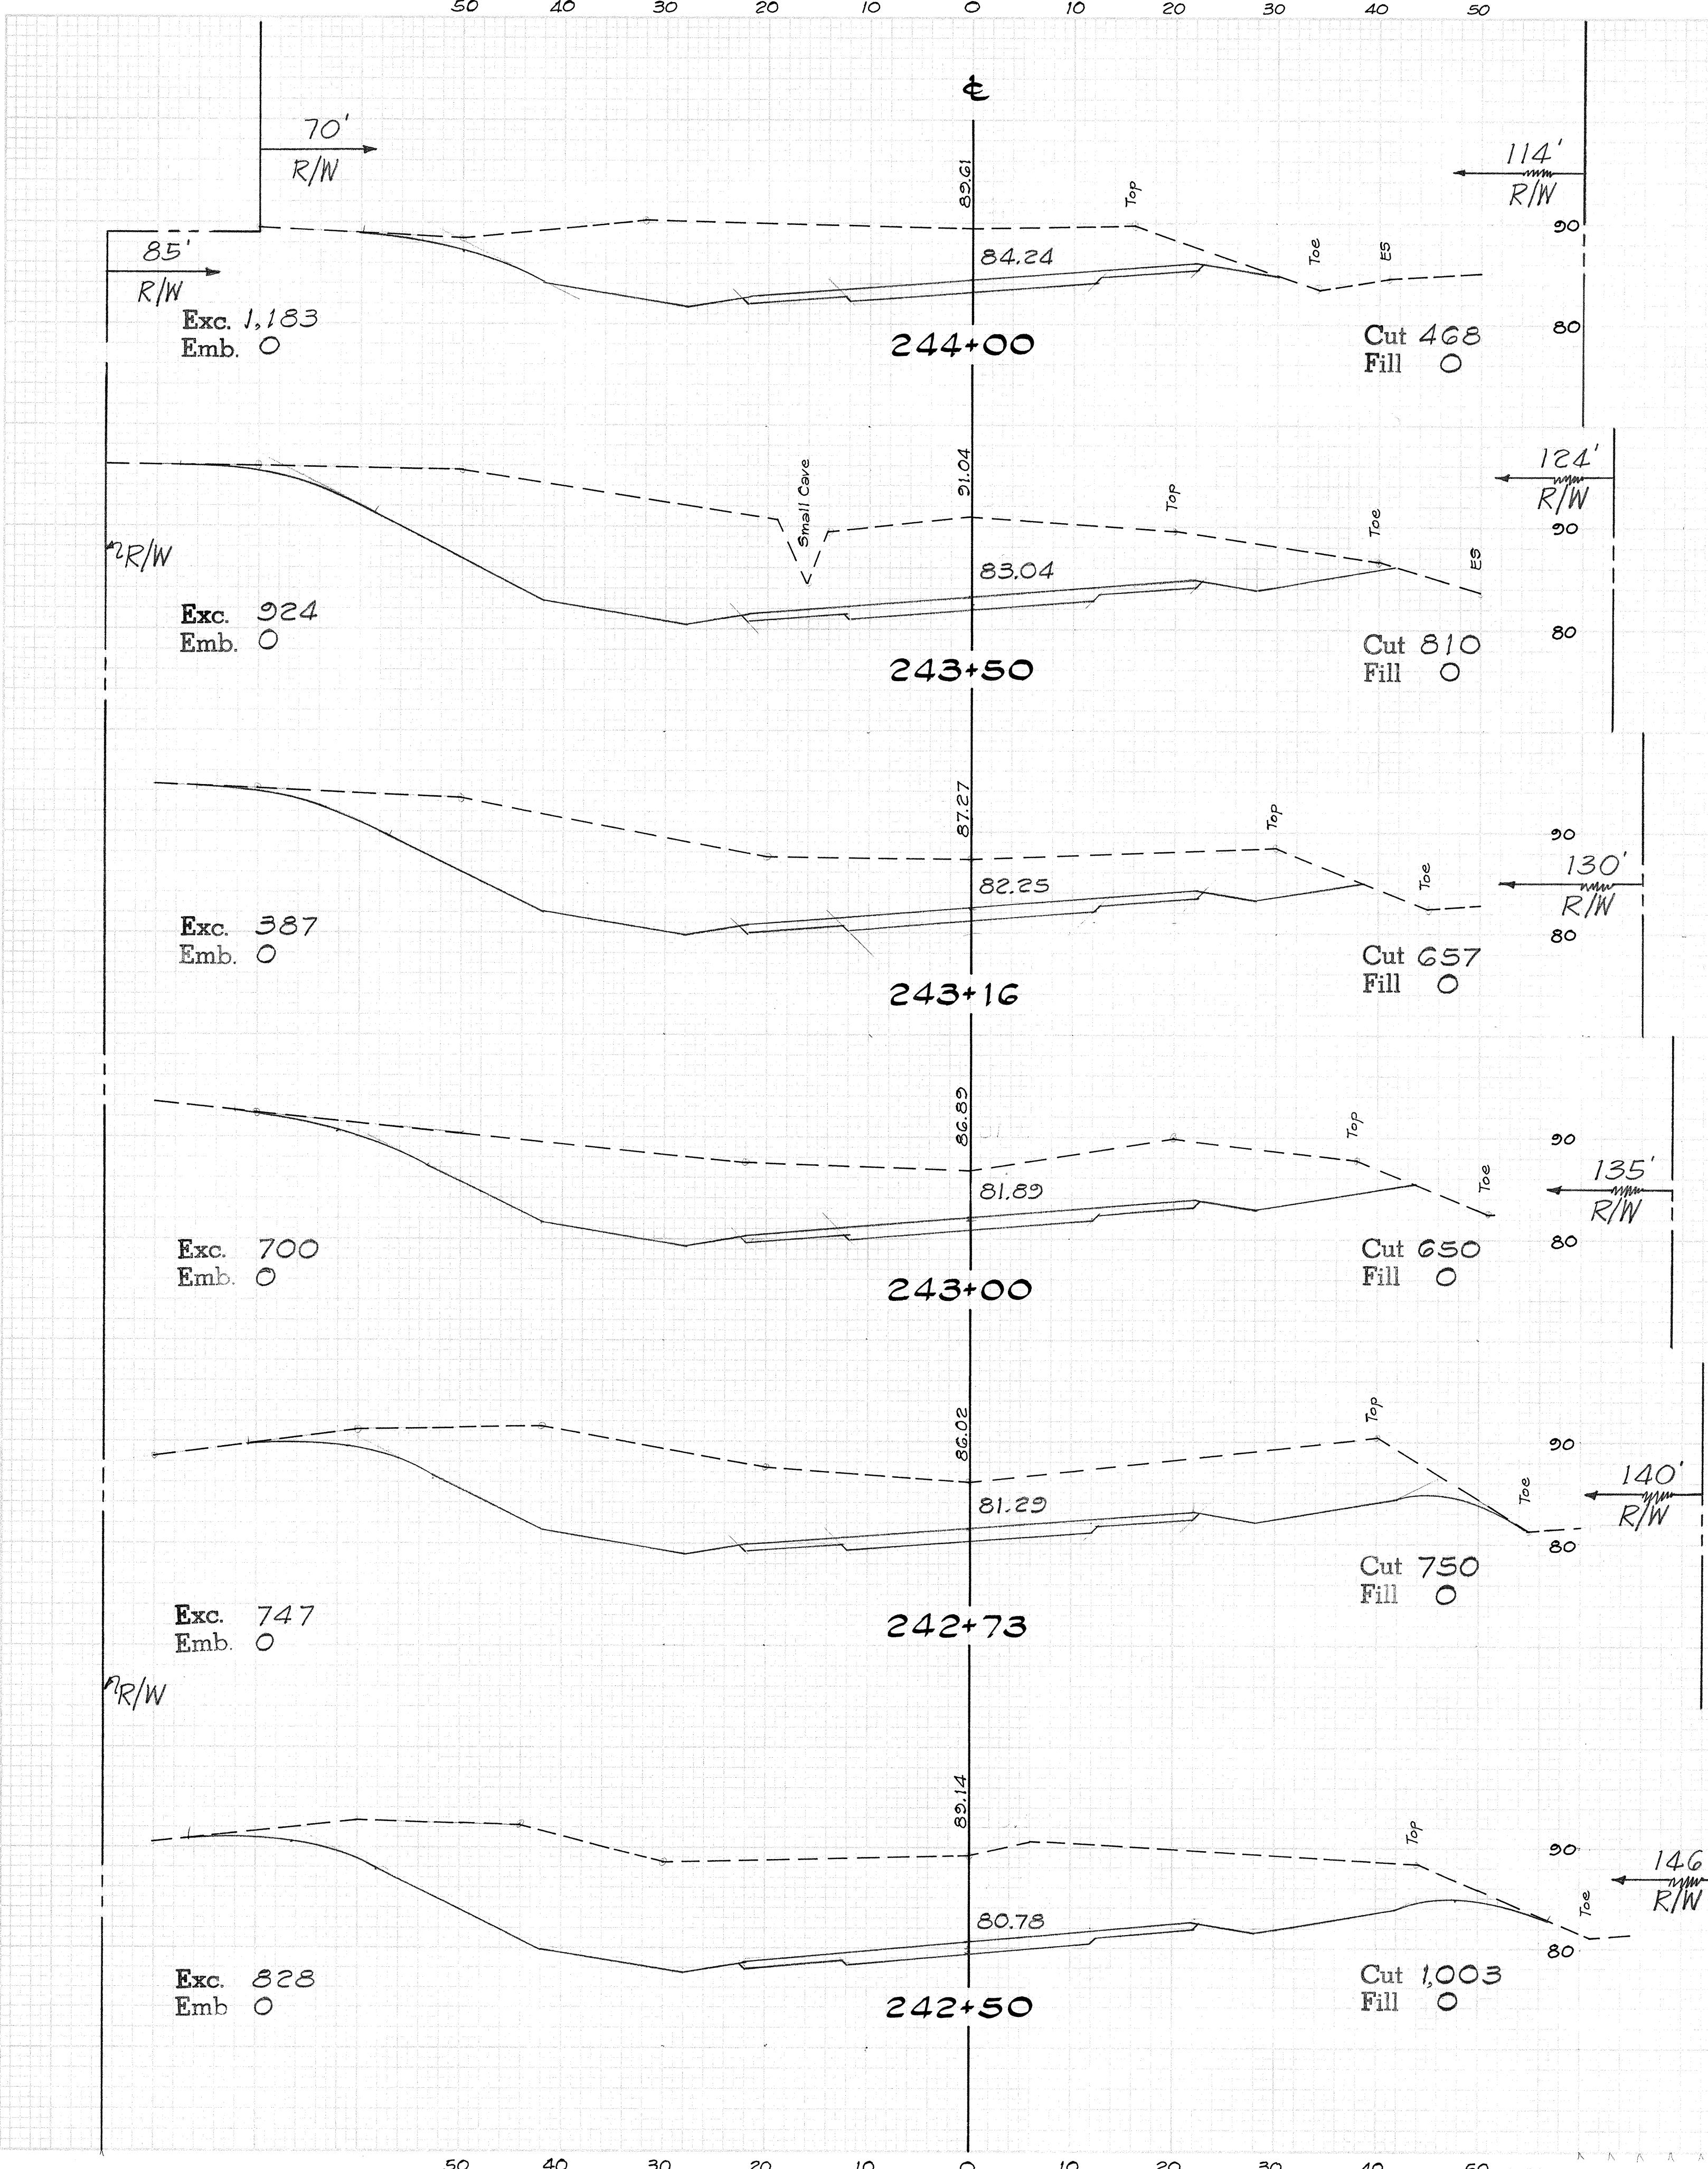


\* = Notes Revisions


REVISED<sup>10</sup> BY<sup>20</sup> C.C.O.<sup>30</sup> #<sup>40</sup> 4<sup>50</sup>

63

FED. ROAD DIST. NO	STATE	FED. AID PROJ. NO.	FISCAL YEAR	SHEET NO.	TOTAL SHEETS
HAWAII	HAW.	ER-9(3)	'79	64	89

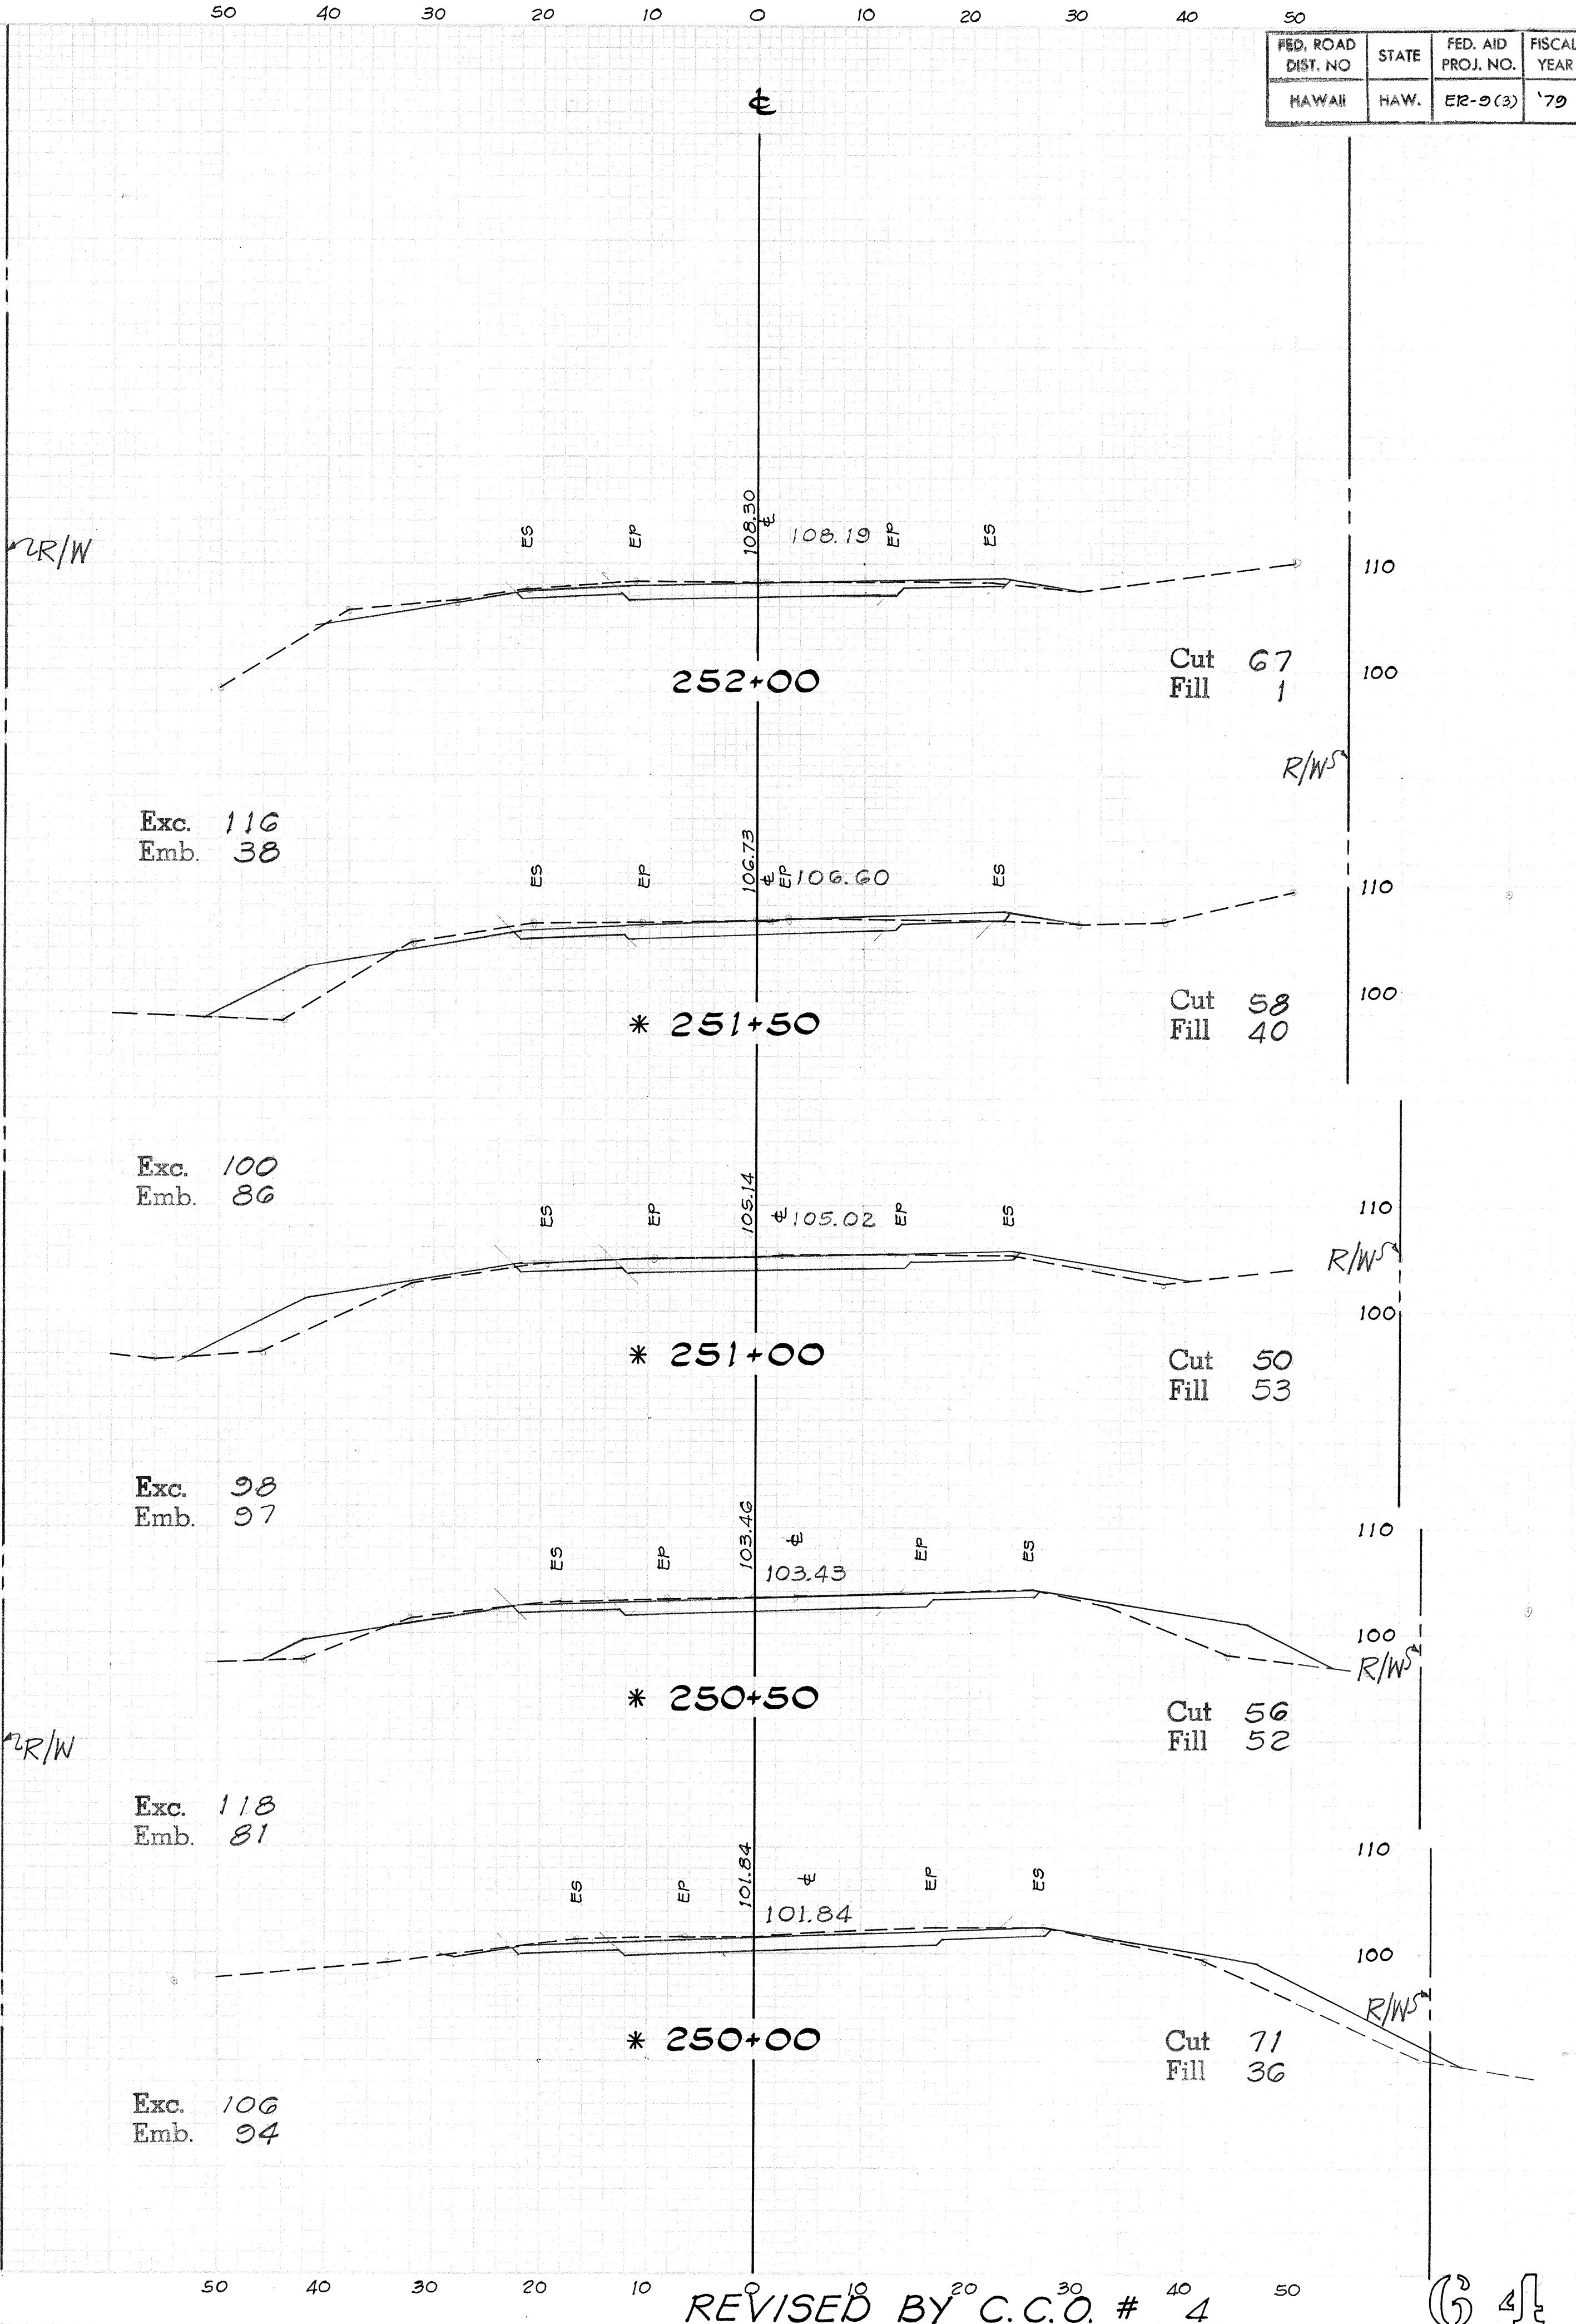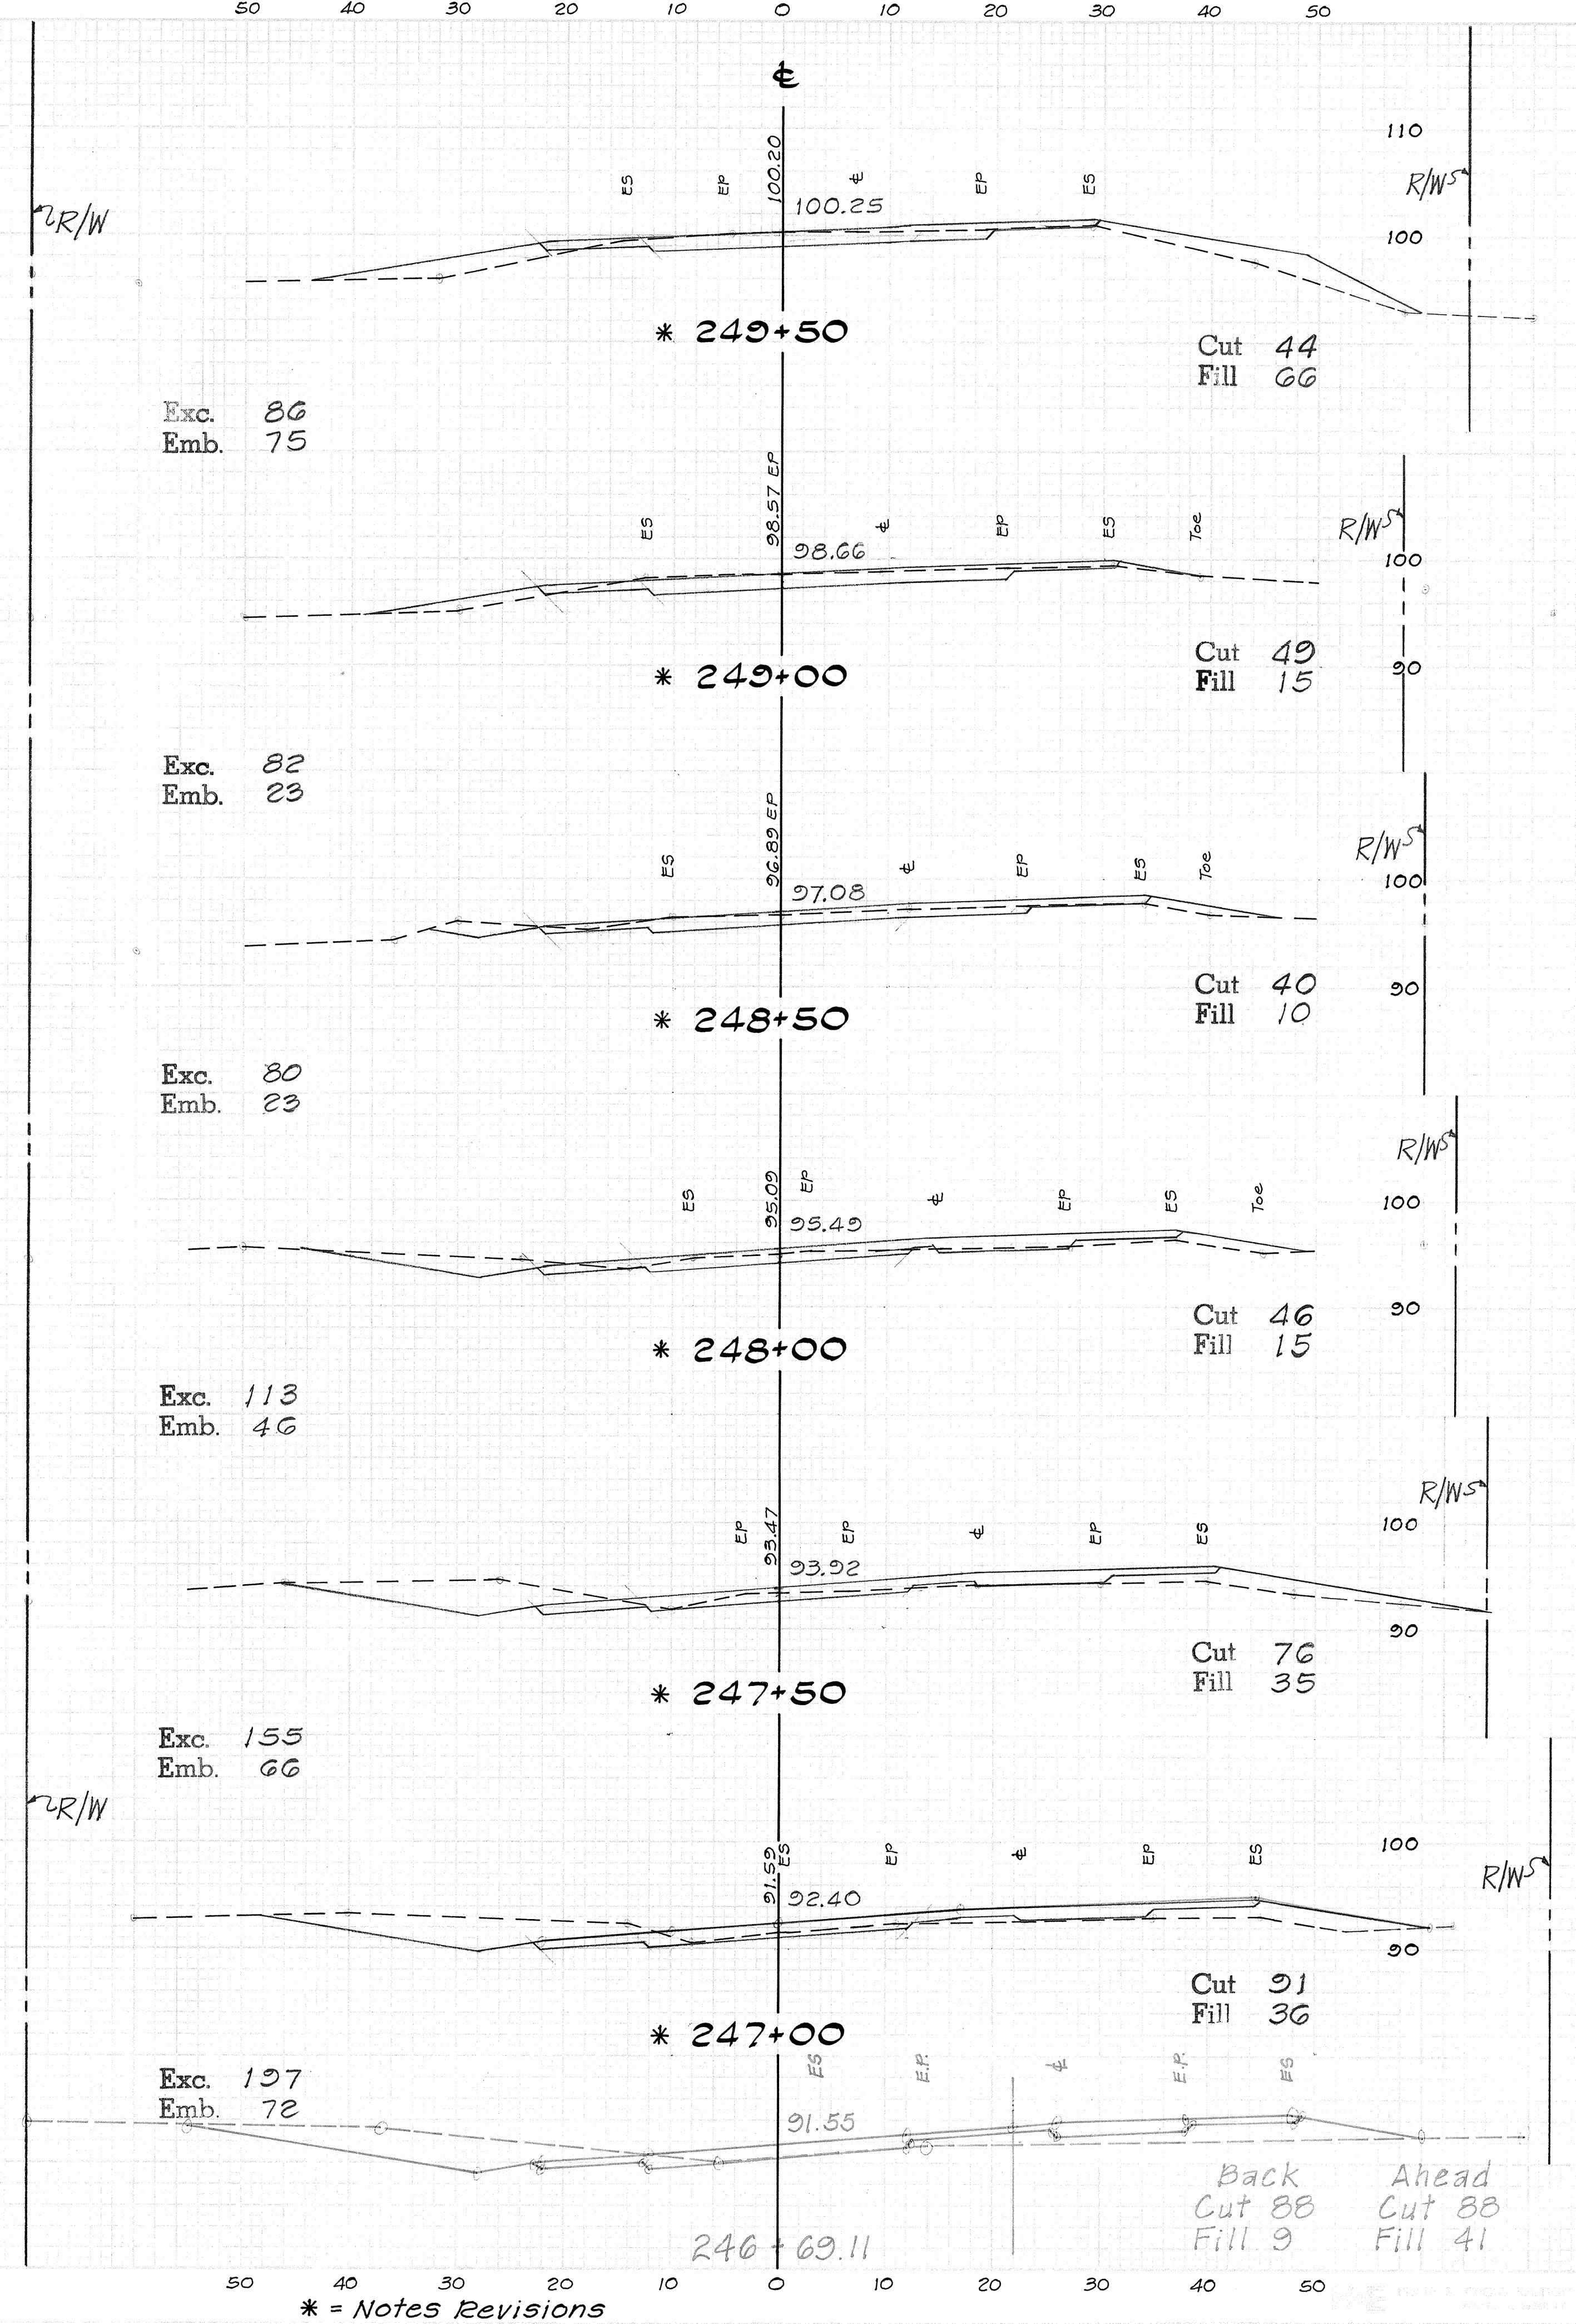

FED. ROAD DIST. NO.	STATE HAW.	FED. AID PROJ. NO.	FISCAL YEAR	SHEET NO.	TOTAL SHEETS
HAWAII	HAW.	ER-9(3)	'70	65	89

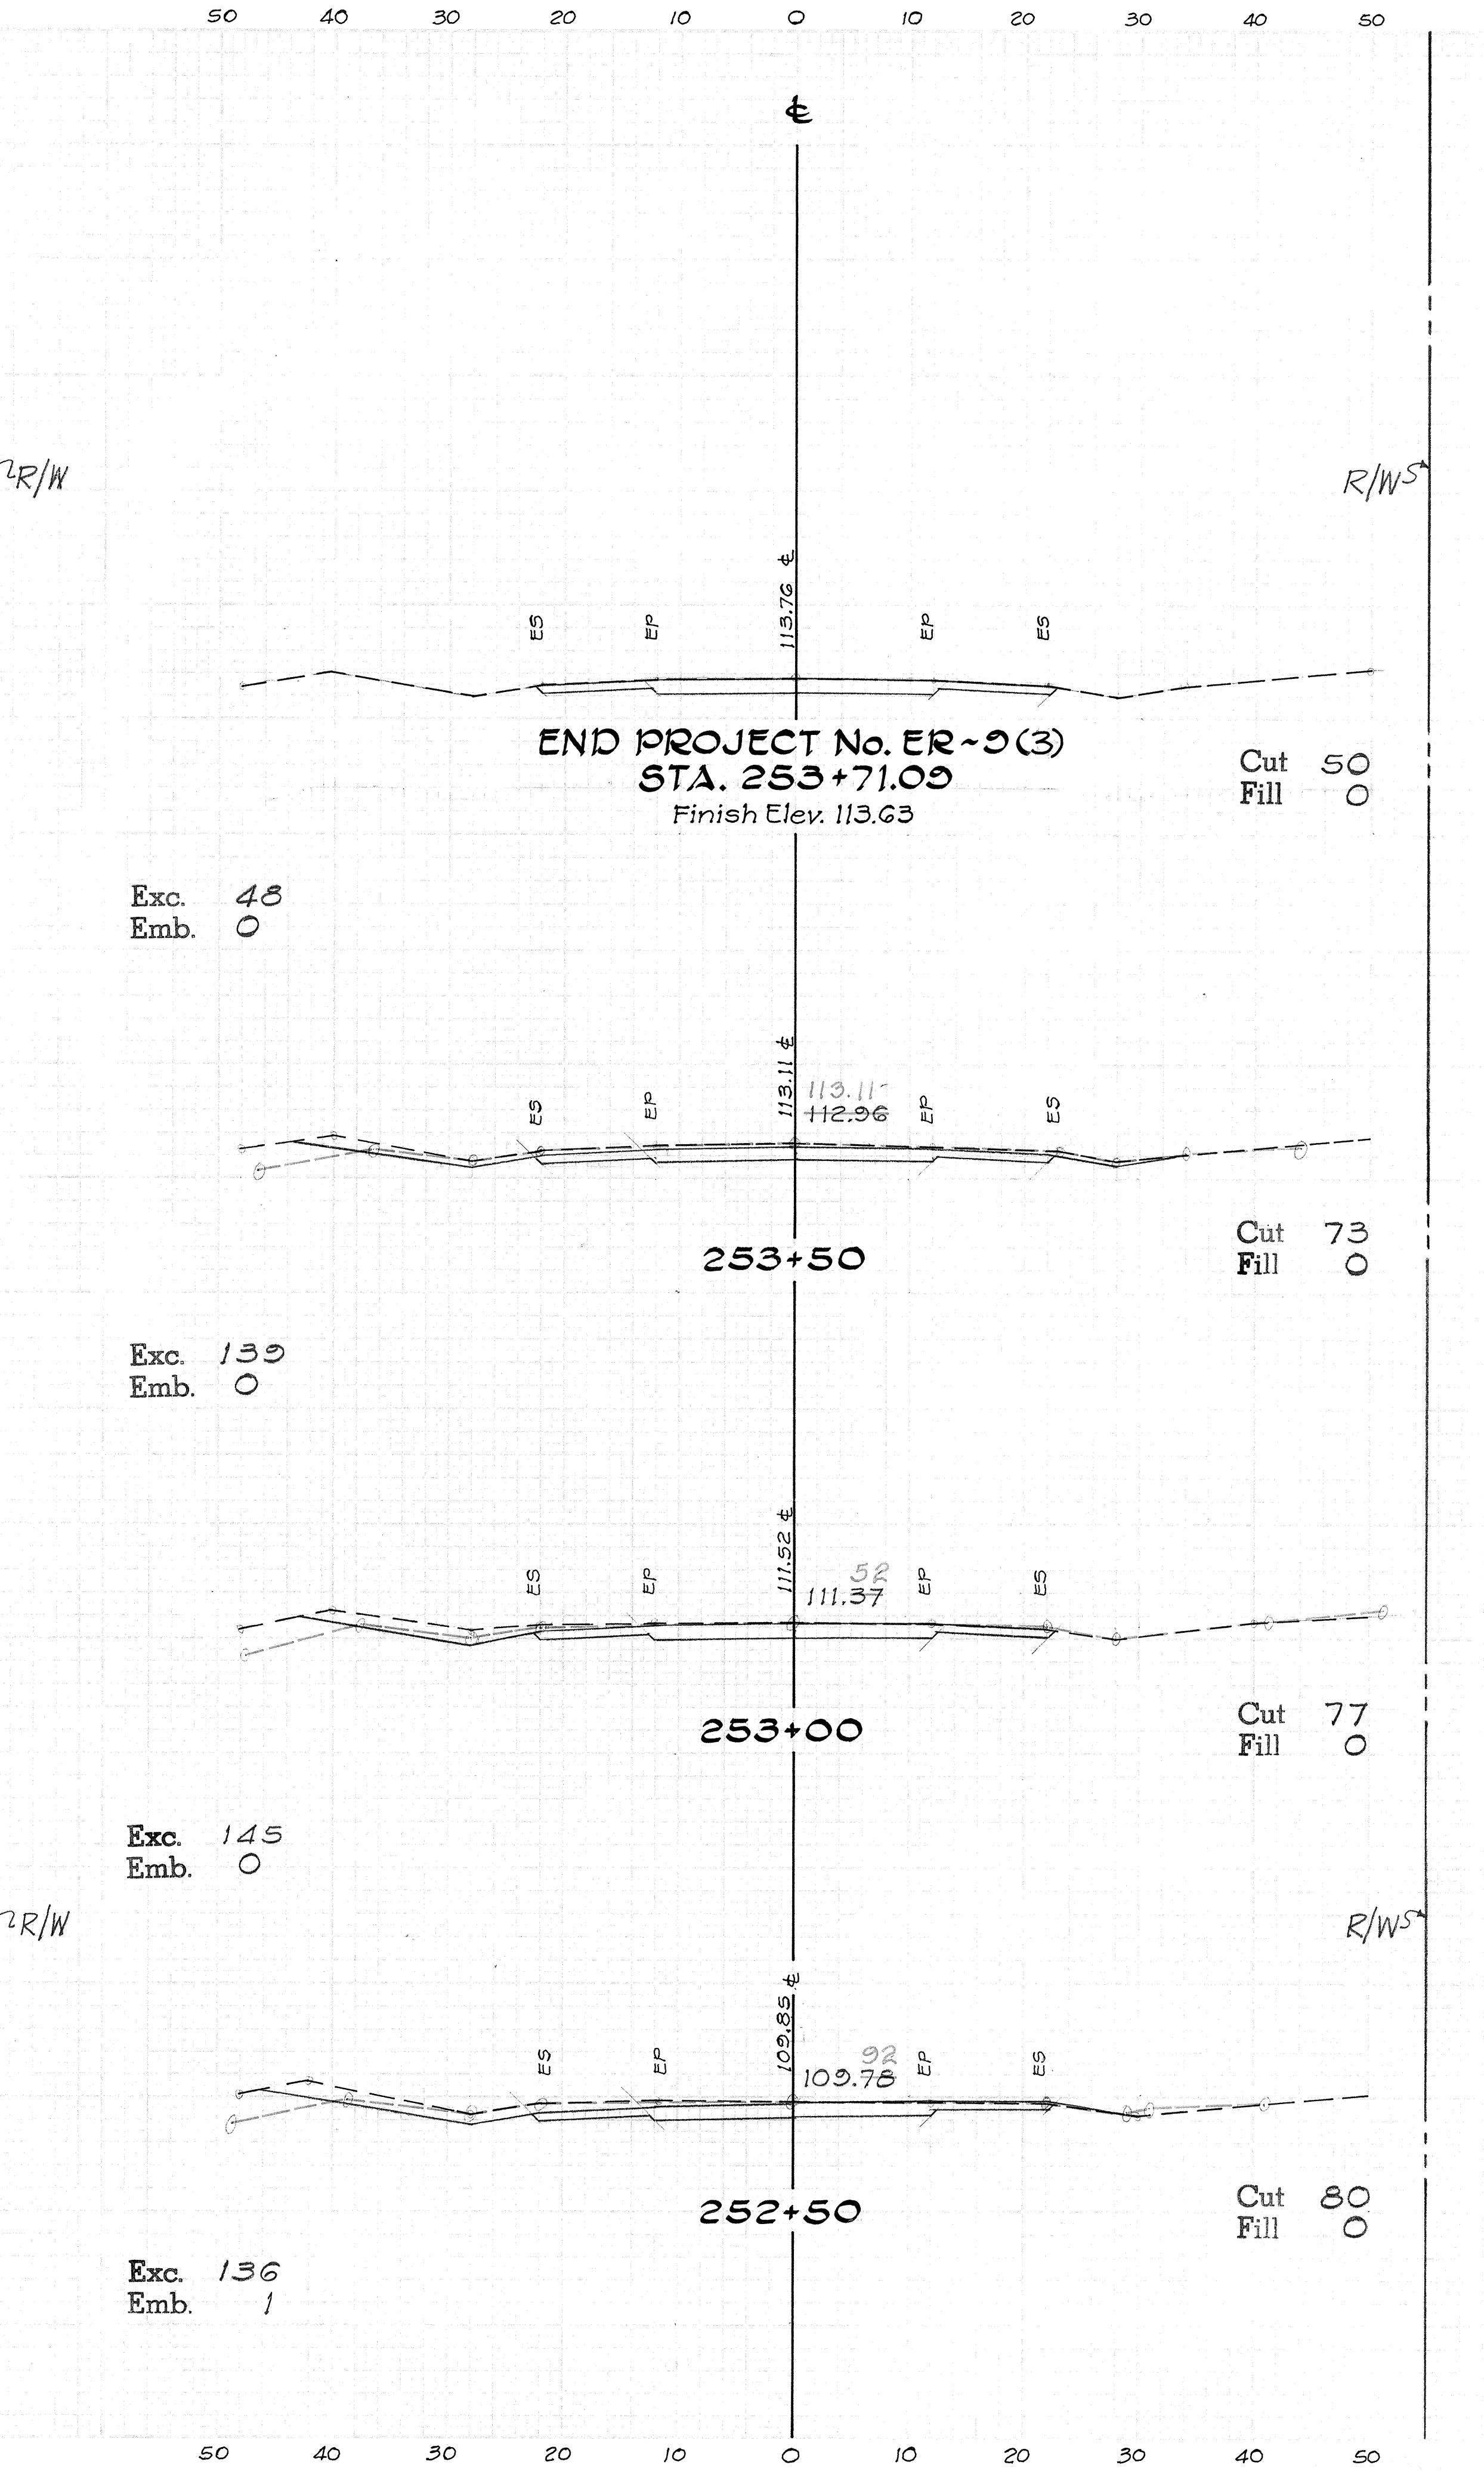

FED. ROAD DIST. NO.	STATE	FED. AID PROJ. NO.	FISCAL YEAR	SHEET NO.	TOTAL SHEETS
HAWAII	HAW.	ER 9(3)	1979	65A	

FINAL SURVEY  
SURVEYED  
NOTED  
ADJUSTED  
NOTES  
ADDED  
AREAS ENCLOSED

