




FED. ROAD DIST. NO.	STATE	FED. AID PROJ. NO.	FISCAL YEAR	SHEET NO.	TOTAL SHEETS
HAWAII	HAW.	RS-0130(23)	1987	4	5

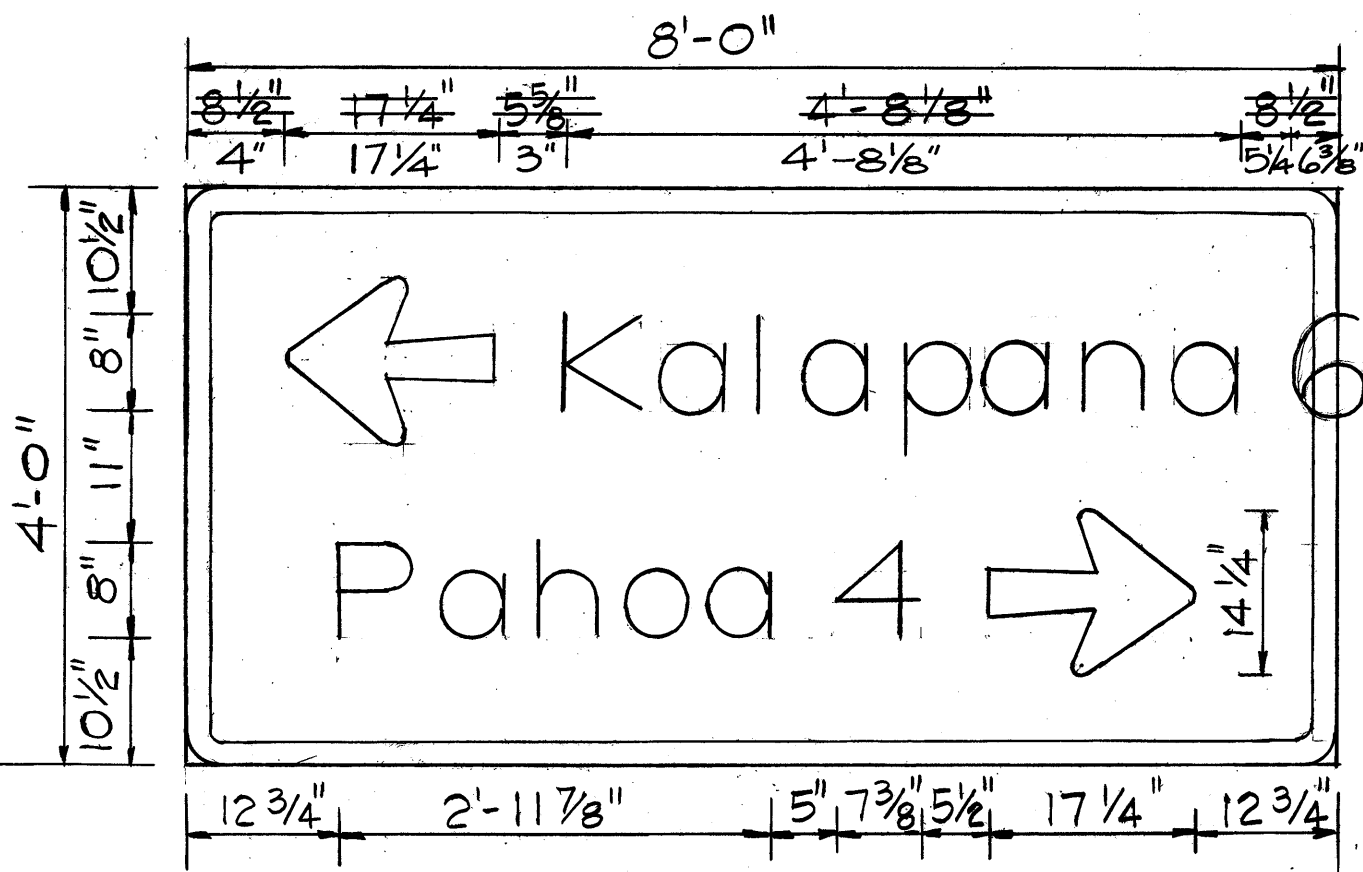


D-3

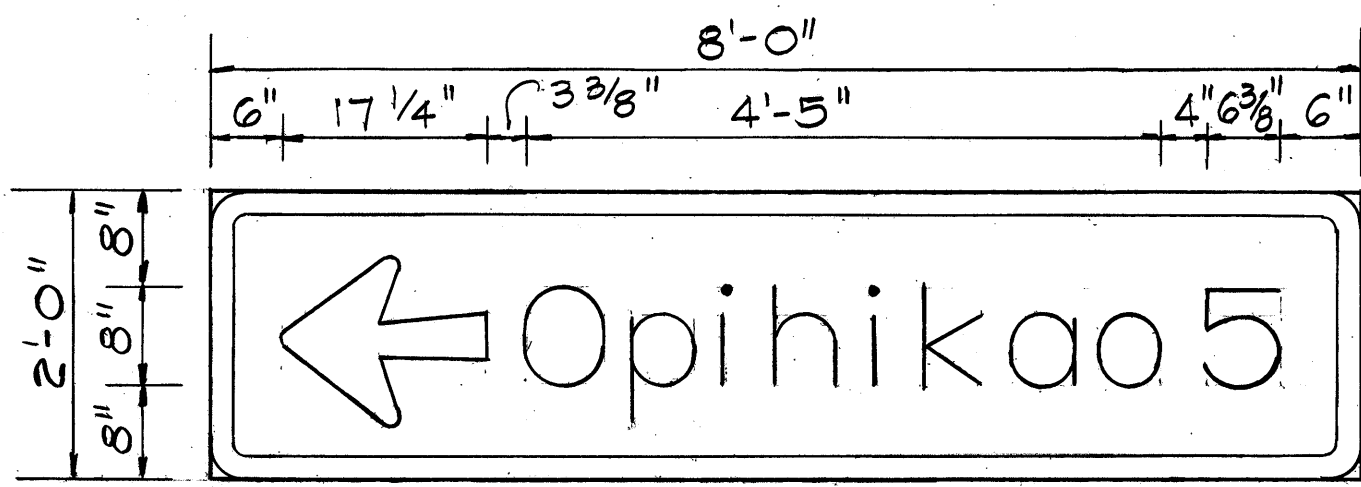


D-2

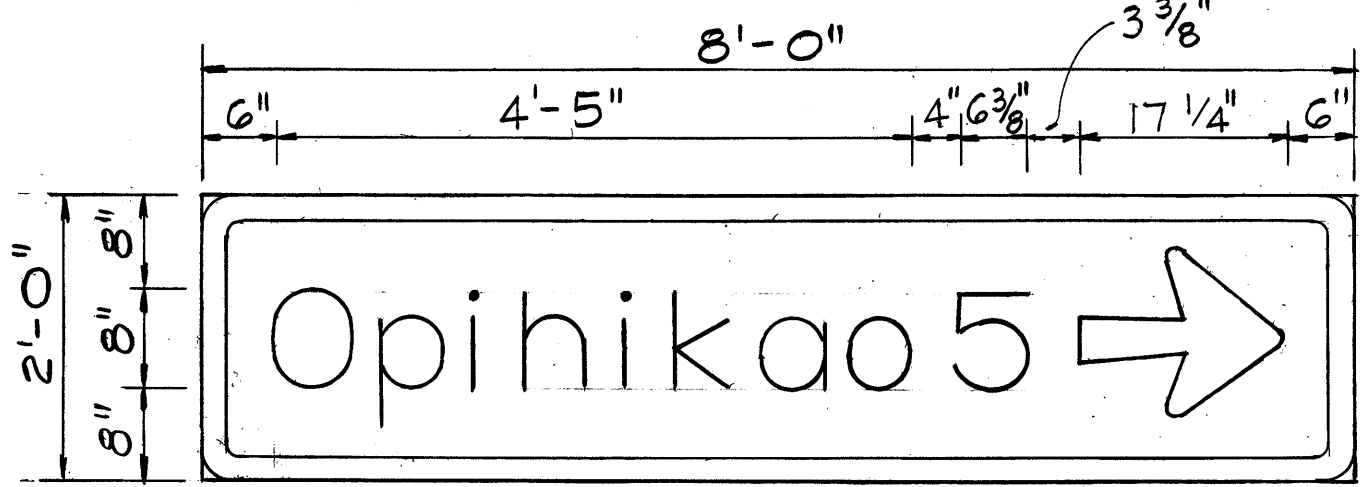



D-1

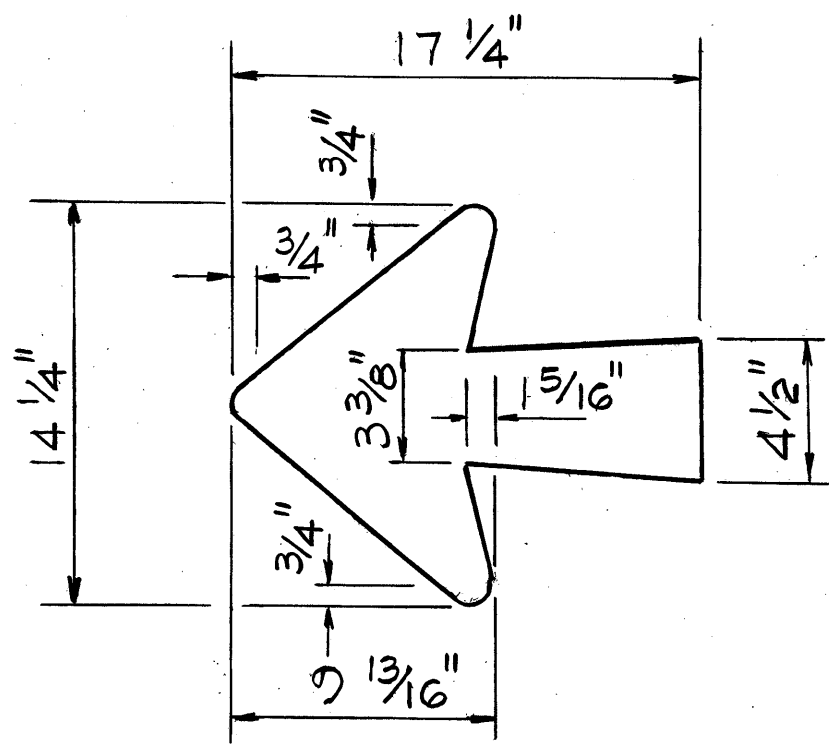

ARROW DETAIL
Not to scale

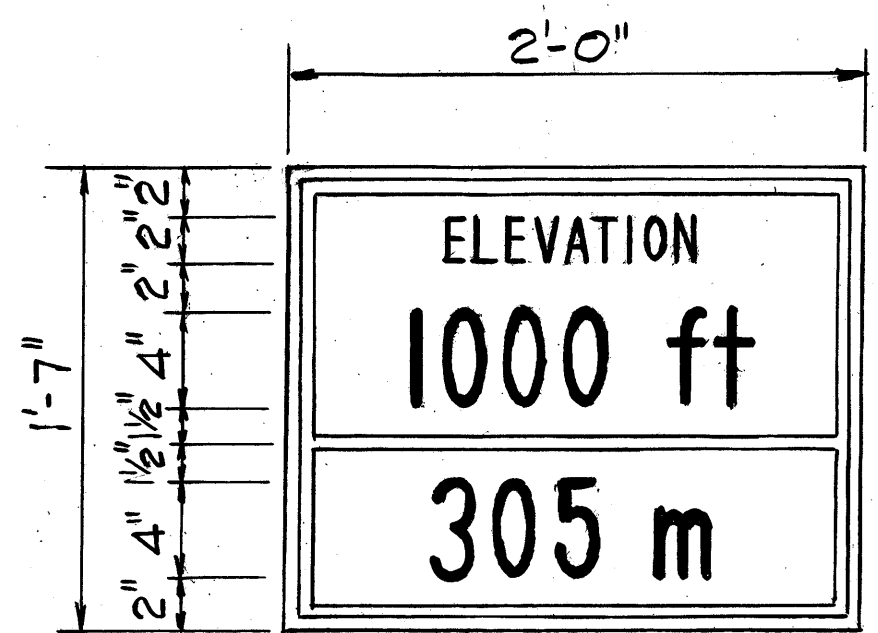

ELEVATION SIGN (I-1) (2 EA)
Scale: 1 1/2" = 1'-0"

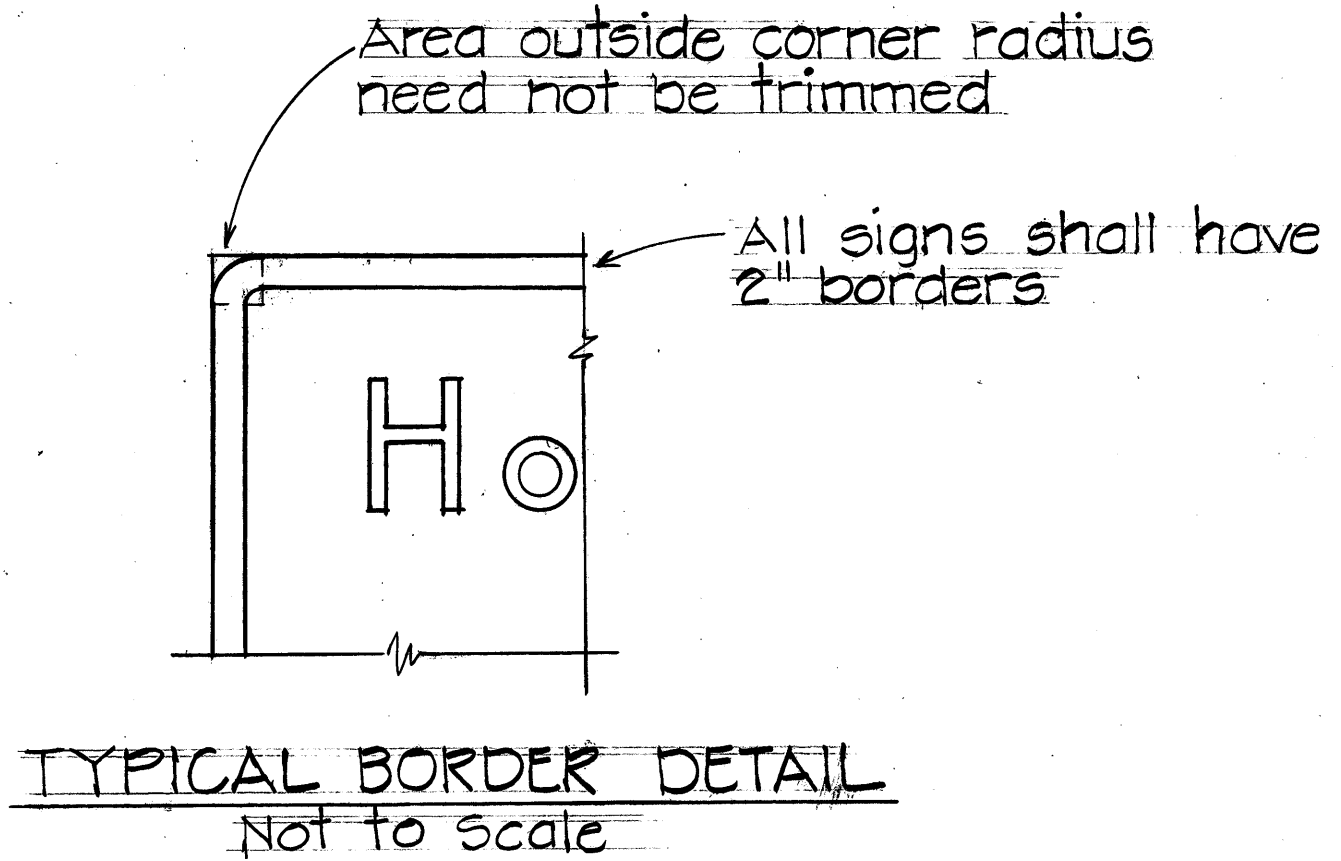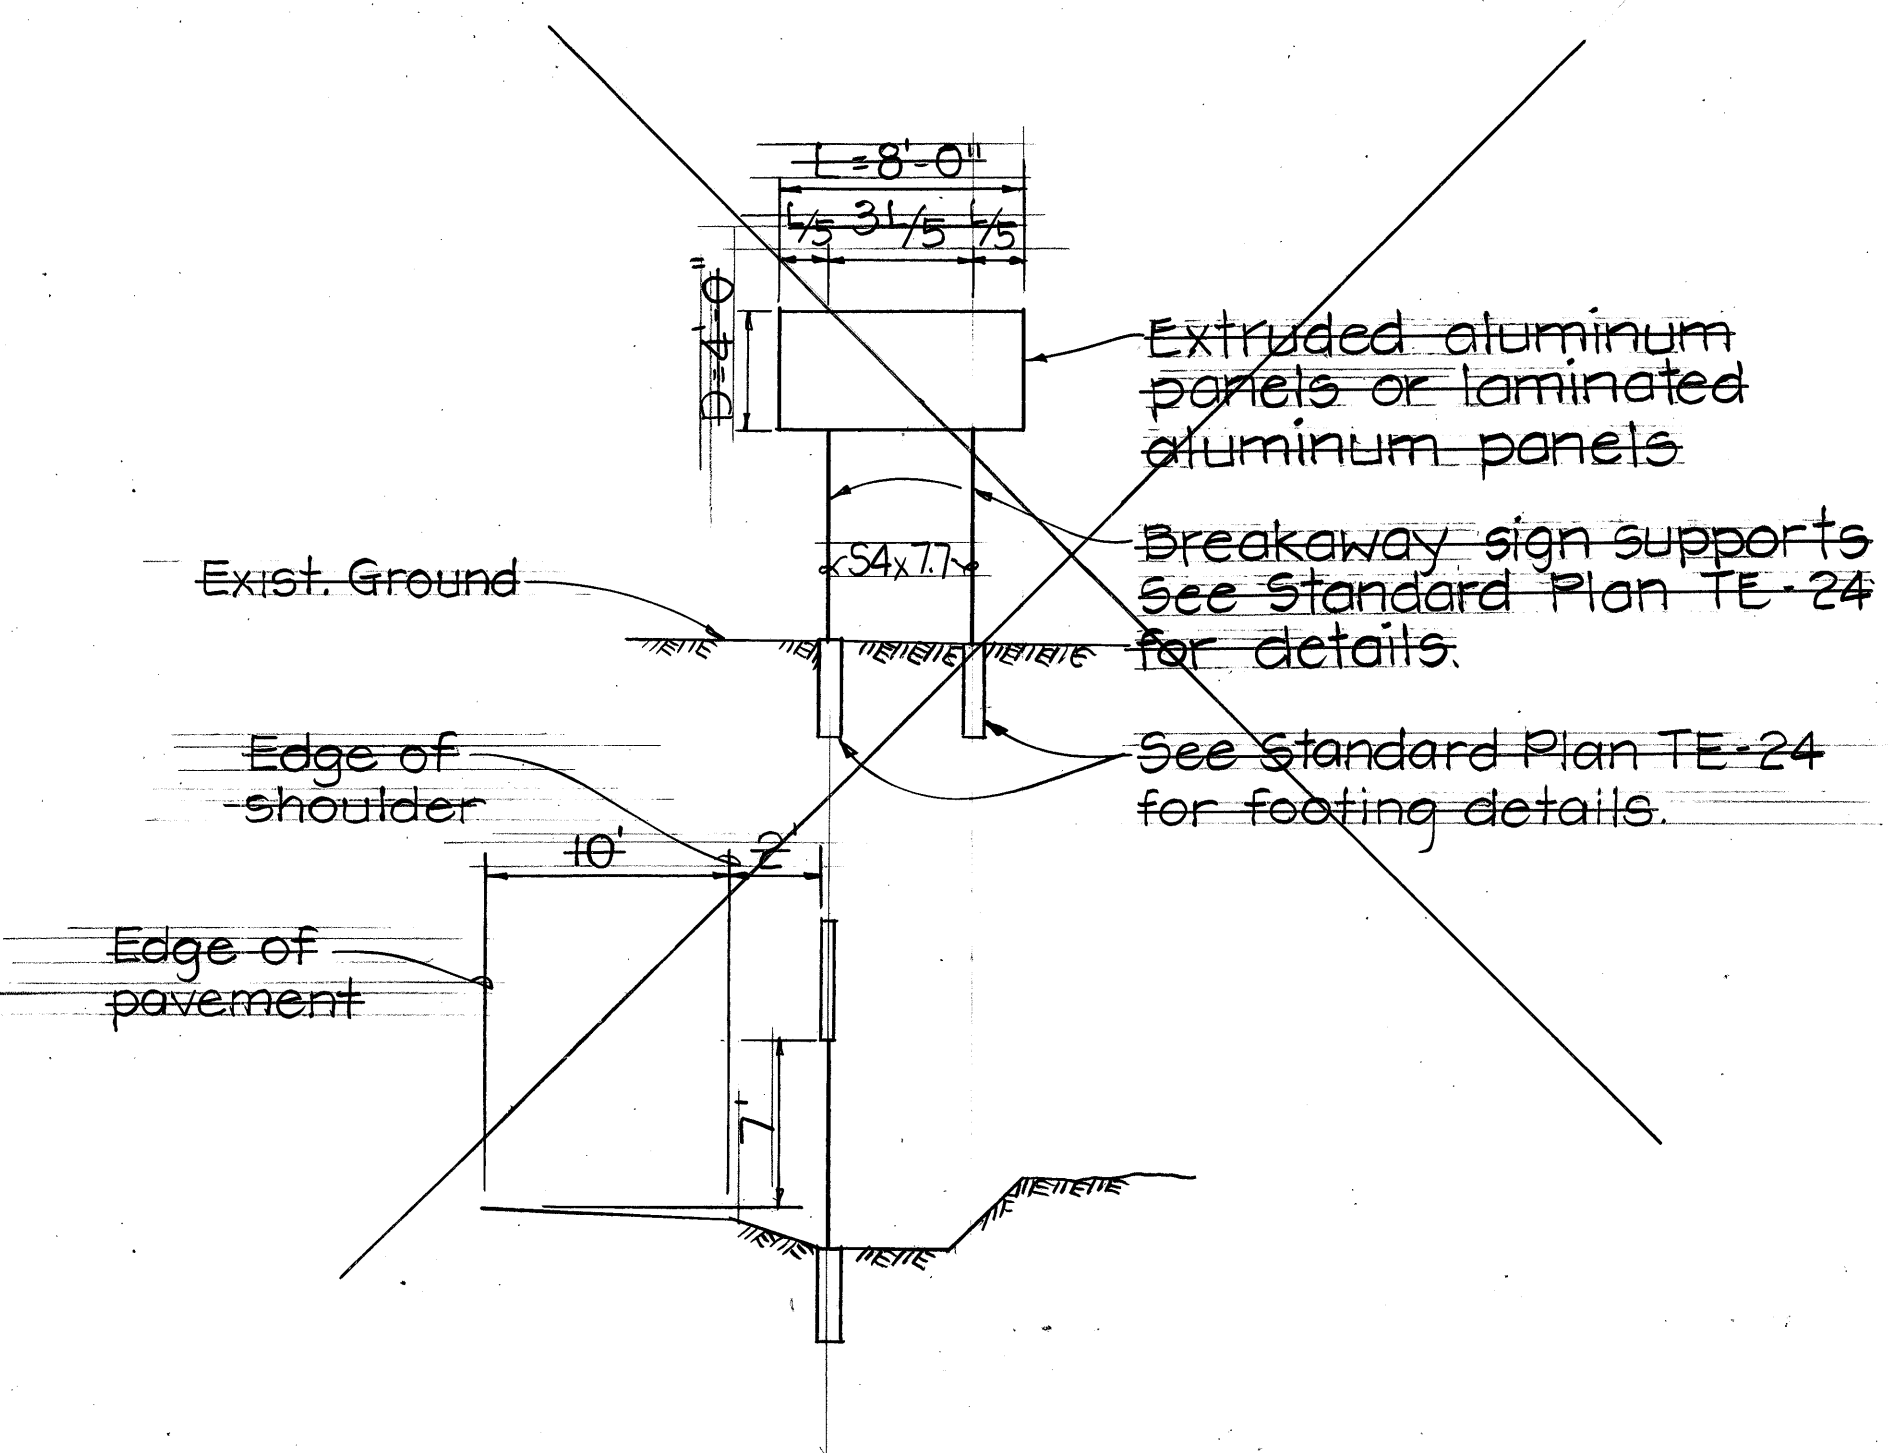

TYPICAL BORDER DETAIL
Not to scale

STATE OF HAWAII
DEPARTMENT OF TRANSPORTATION
HIGHWAYS DIVISION

PANEL AND FRAME LAYOUT
PAHOA-KALAPANA ROAD
SAFETY IMPROVEMENTS AT
KAMAII ROAD
F.A.S. PROJ. NO. RS-0130(23)
Scale: As shown Date:

SHEET NO. OF SHEETS
4

SURVEY PLOTTED BY	DATE
DRAWN BY	
TRACED BY	
NOTE BOOK	
QUANTITIES BY	
CHECKED BY	
No.	