


FED. ROAD DIST. NO.	STATE	FED. AID PROJ. NO.	FISCAL YEAR	SHEET NO.	TOTAL SHEETS
HAWAII	HAW.	RS-0130(16)	1988	10	25

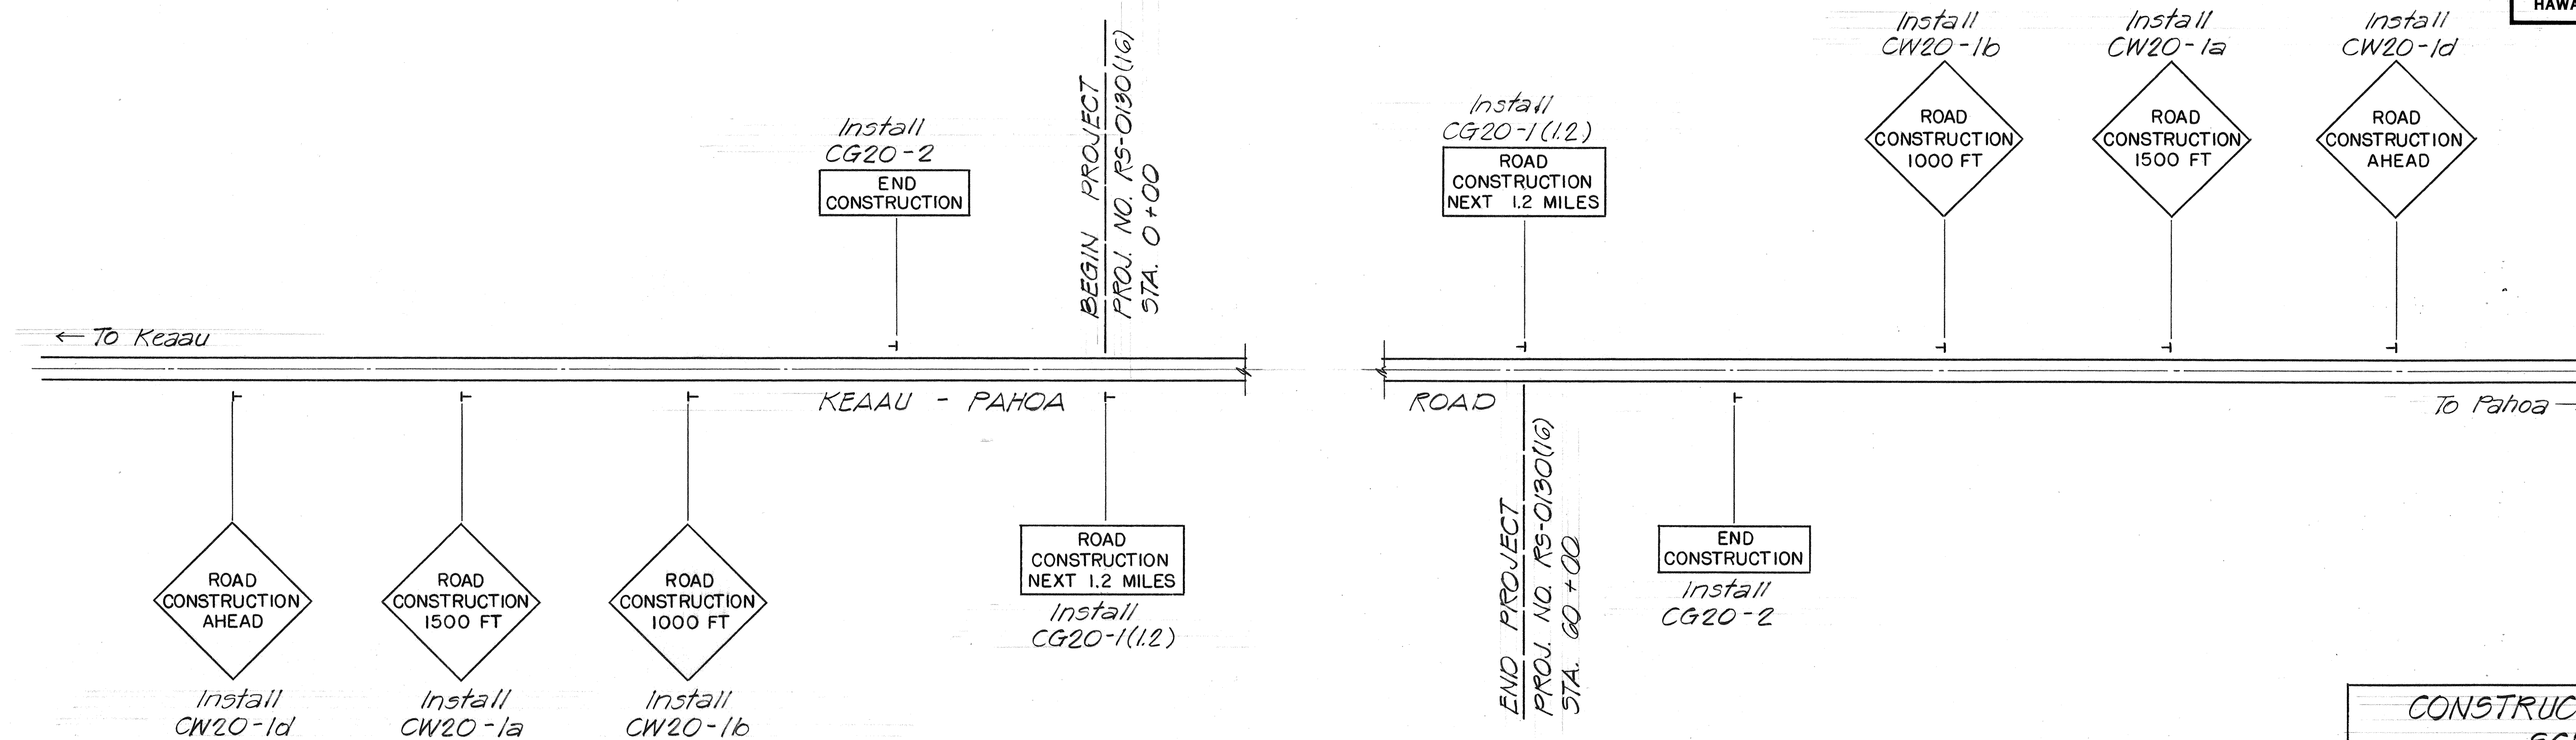

CONSTRUCTION SIGN PLAN

Not to Scale

CONSTRUCTION SIGN SCHEDULE		
PROJ. NO.	STATION	TYPE
S-0130(7)	227 + 50 R	CW20-1d
	232 + 50 R	CW20-1a
	237 + 50 R	CW20-1b
	242 + 50 L	CG20-2
	0 + 00 R	CG20-1(1,2)
S-23(11)		
	60 + 00 L	CG20-1(1,2)
	65 + 00 70 + 00 R	CG20-2
	75 + 00 75 + 00 L	CW20-1b
	80 + 00 80 + 00 L	CW20-1a
	85 + 00 L	CW20-1d
TOTAL		10 - Ea.

ORIGINAL PLAN	SURVEY PLOTTED BY _____ DATE _____
NOTE BOOK	DRAWN BY _____
	TRACED BY _____
	DESIGNED BY _____
	QUANTITIES BY _____
No. _____	CHECKED BY _____

STATE OF HAWAII
DEPARTMENT OF TRANSPORTATION
HIGHWAYS DIVISION

CONSTRUCTION SIGN DETAILS

KEAAU-PAHOA ROAD
Paradise Park Section - Phase I
Fed. Aid Proj. no. RS-0130 (16)

Not to Scale Date: April 1988

SHEET No. / OF / SHEETS