



60 50 40 30 20 10 0 10 20 30 40 50 60

60 50 40 30 20 10 0 10 20 30 40 50 60

FED. ROAD DIST. NO.	STATE	FED. AID PROJ. NO.	FISCAL YEAR	SHEET NO.	TOTAL SHEETS
HAWAII	HAW.	RS-0130(16)	1988	17	25

DATE	BY	SURVEYED	PLOTTED	NOTED	AREAS CHECKED



DATE	BY	SURVEYED	PLOTTED	NOTED	AREAS CHECKED
Oct. 78	J				

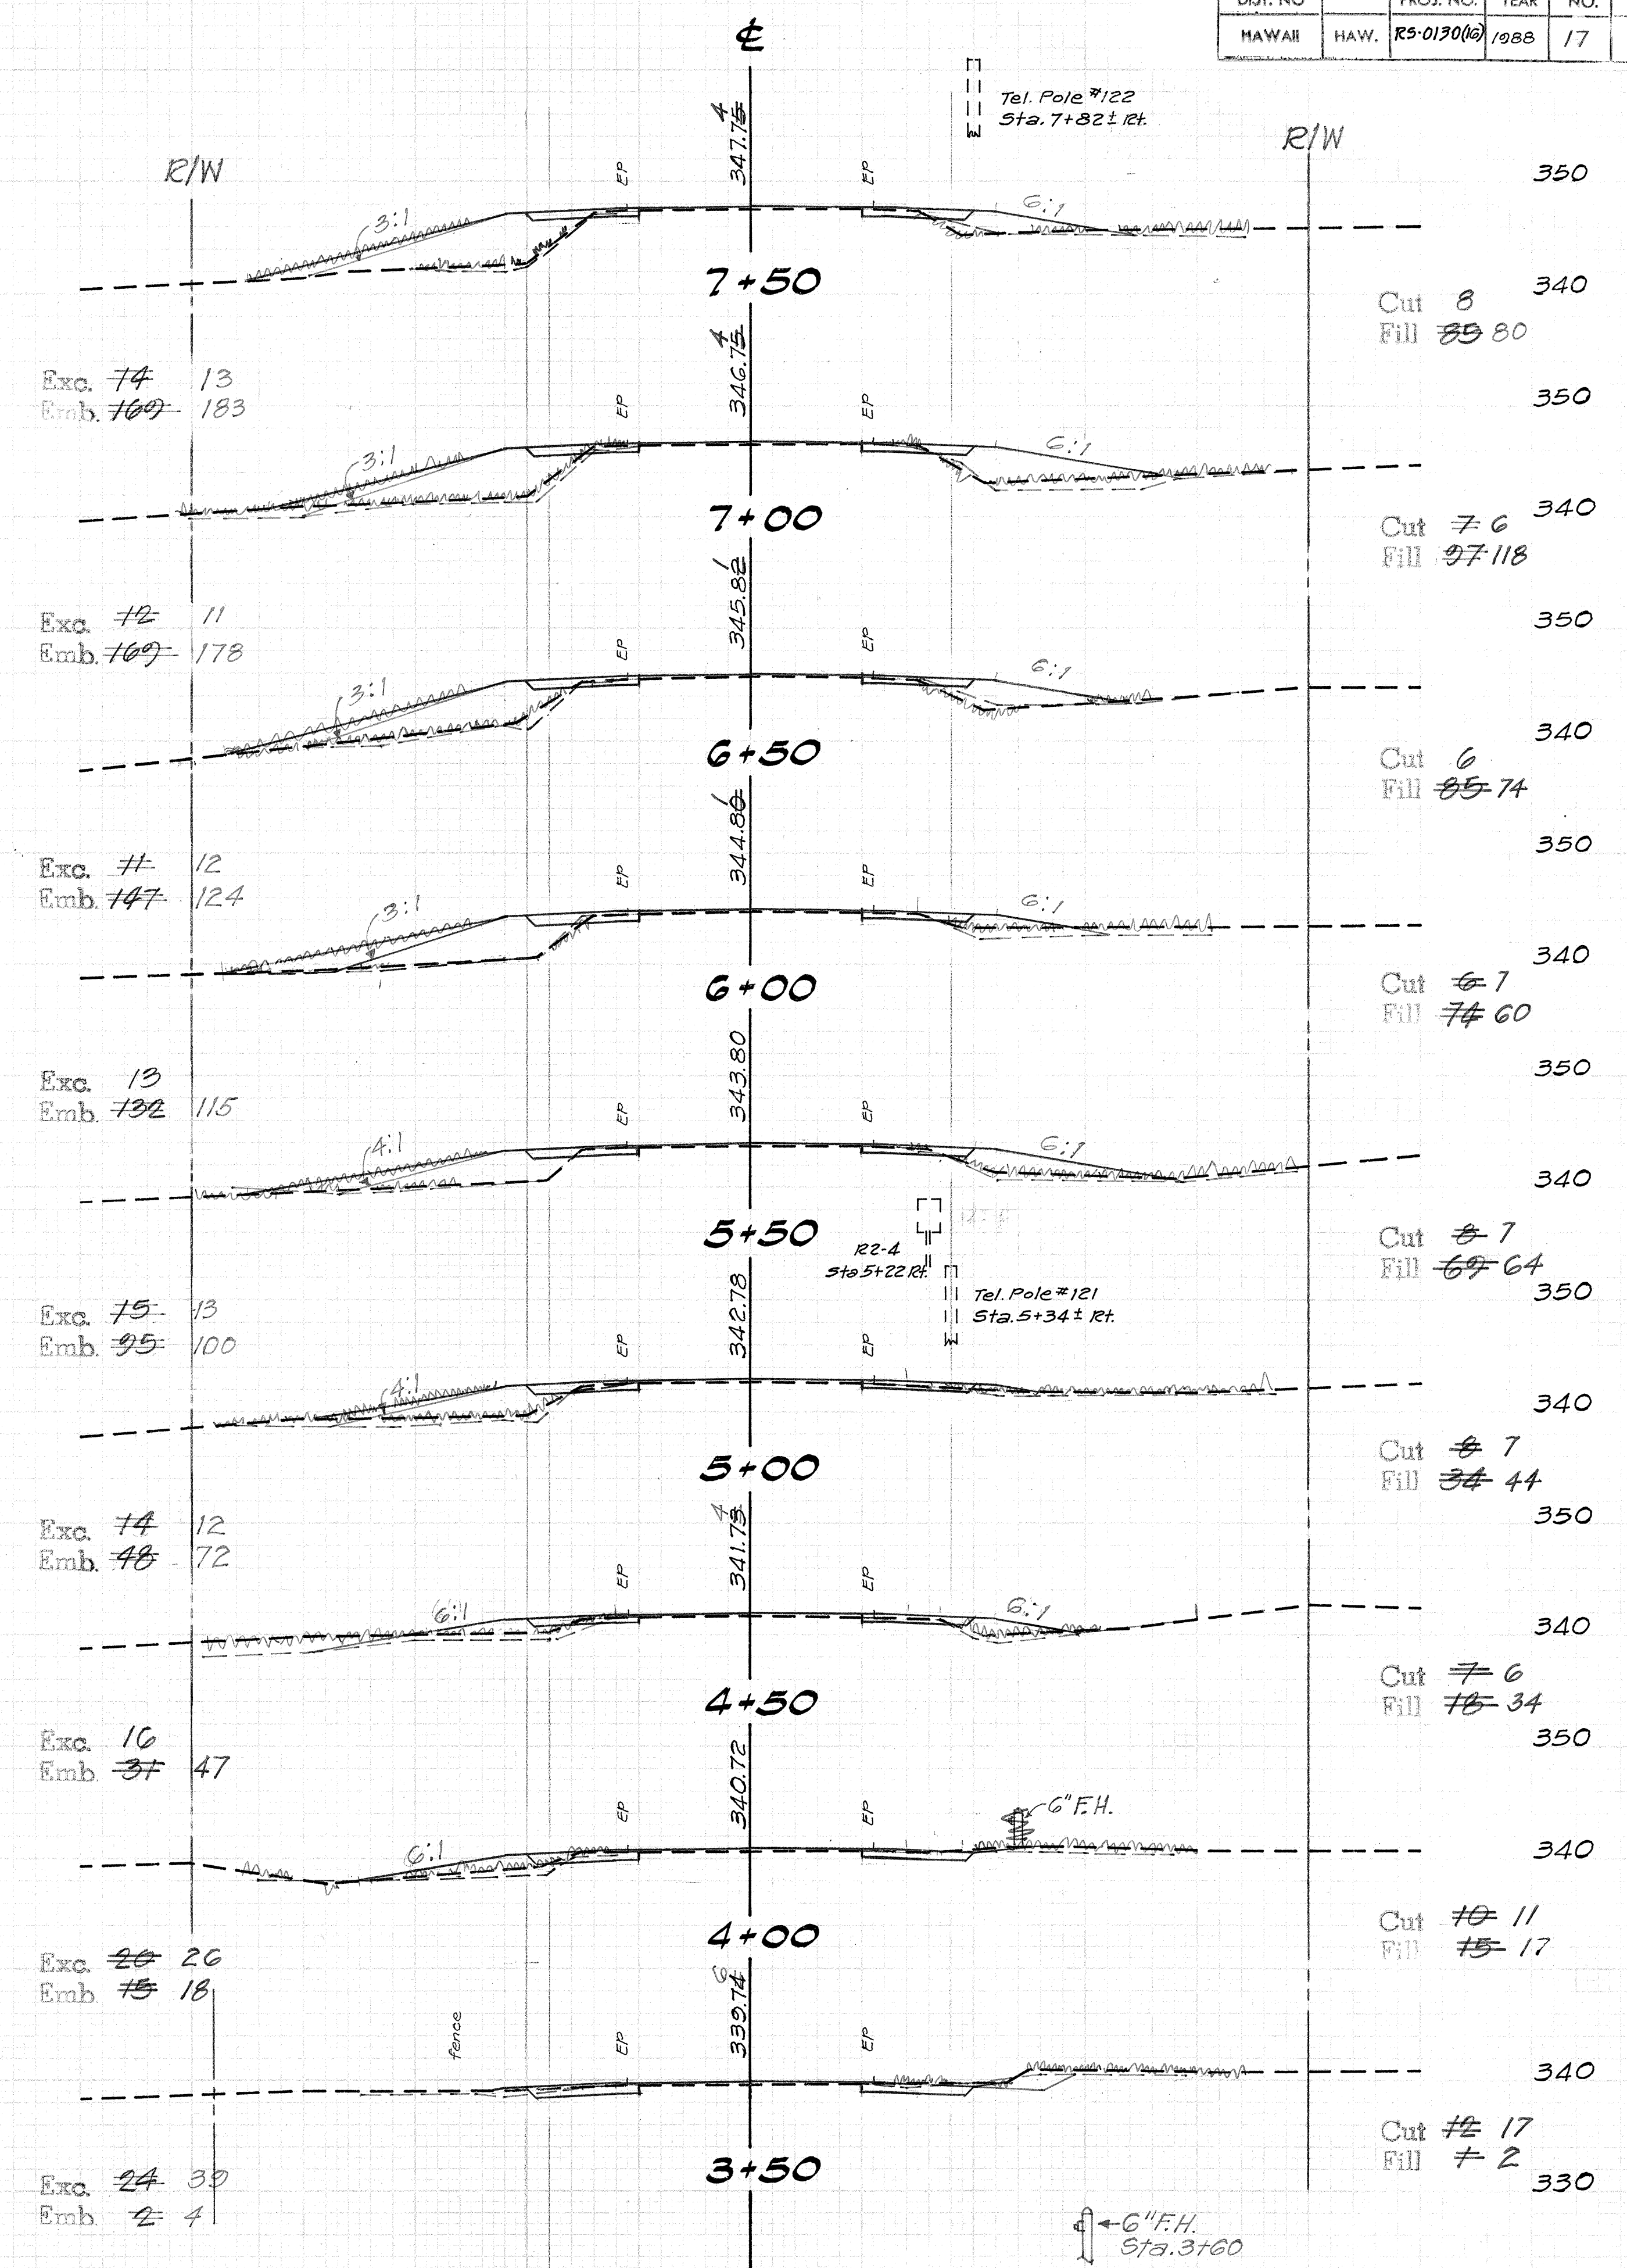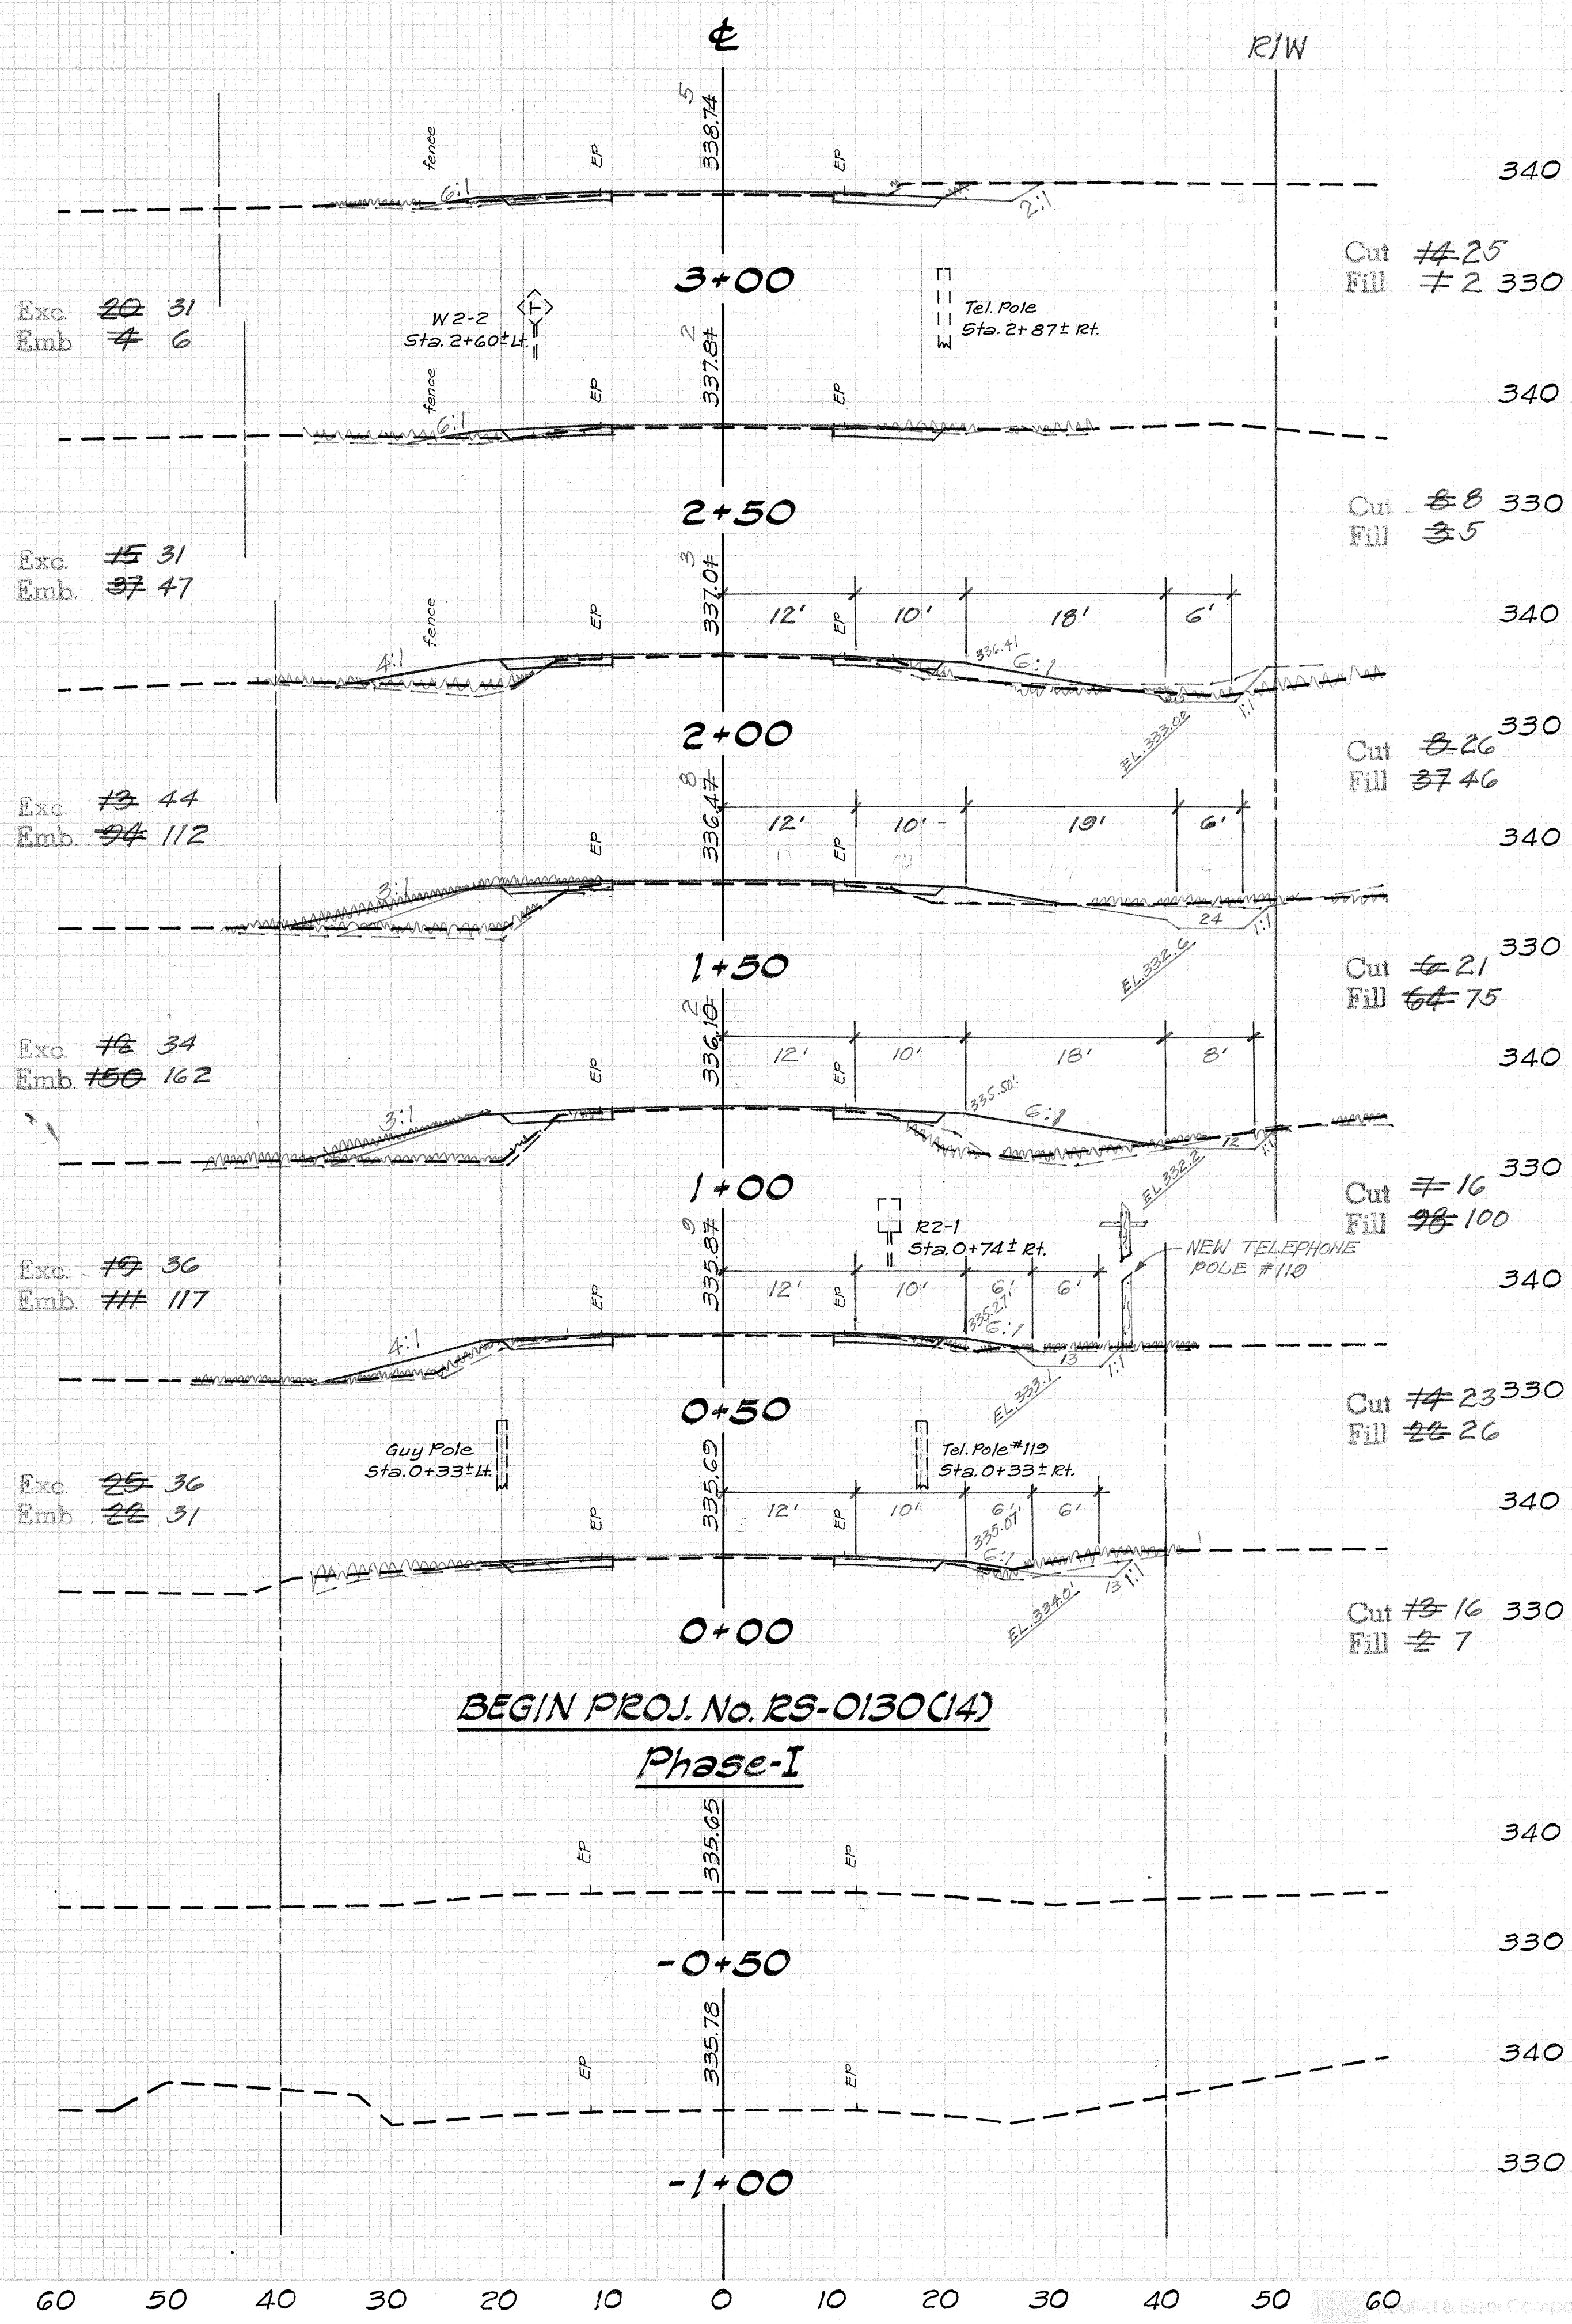

DATE	BY	ORIGINAL SURVEY	PLANNED	DATE
		11/29/78		
NOTE BOOK		11/29/78		
AREAS CHECKED		AREAS CHECKED		

DATE	BY	ORIGINAL SURVEY	PLANNED	DATE
11/29/78	J.D.	11/29/78		
NOTE BOOK		11/29/78		
AREAS CHECKED		AREAS CHECKED		

FED. ROAD DIST. NO.	STATE	FED. AID PROJ. NO.	FISCAL YEAR	SHEET NO.	TOTAL SHEETS
HAWAII	HAW.	RS-0130(16)	1988	18	25

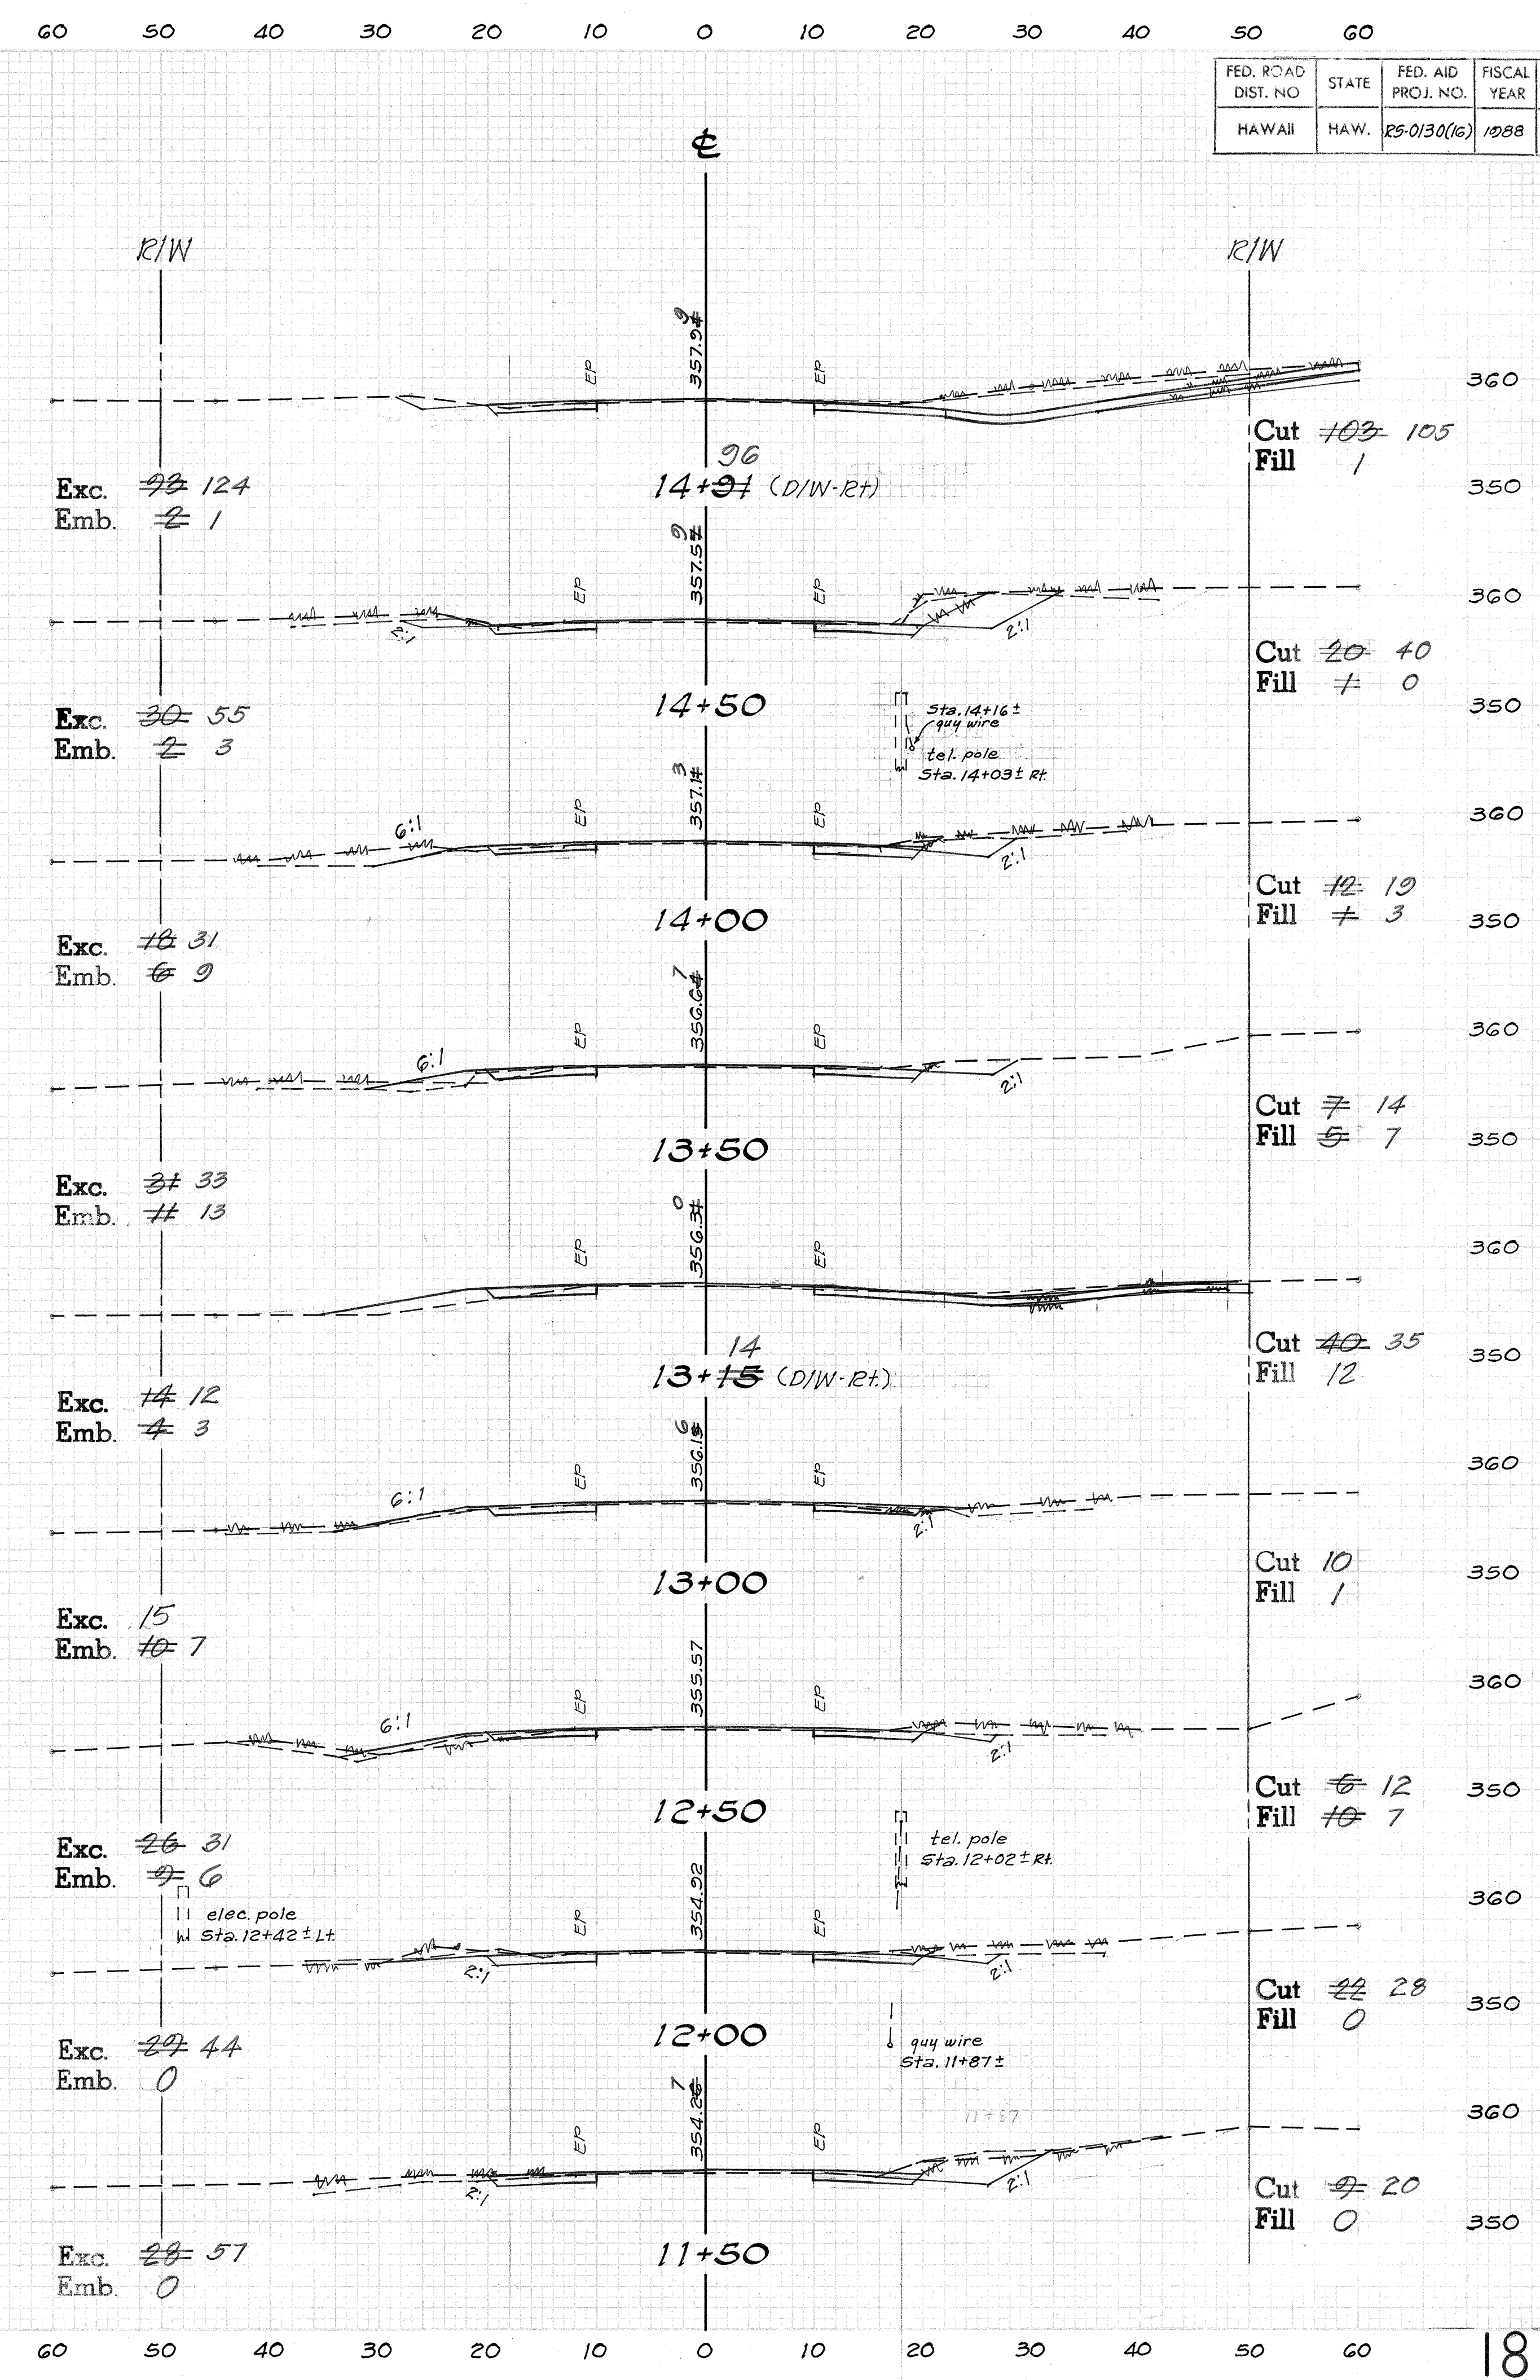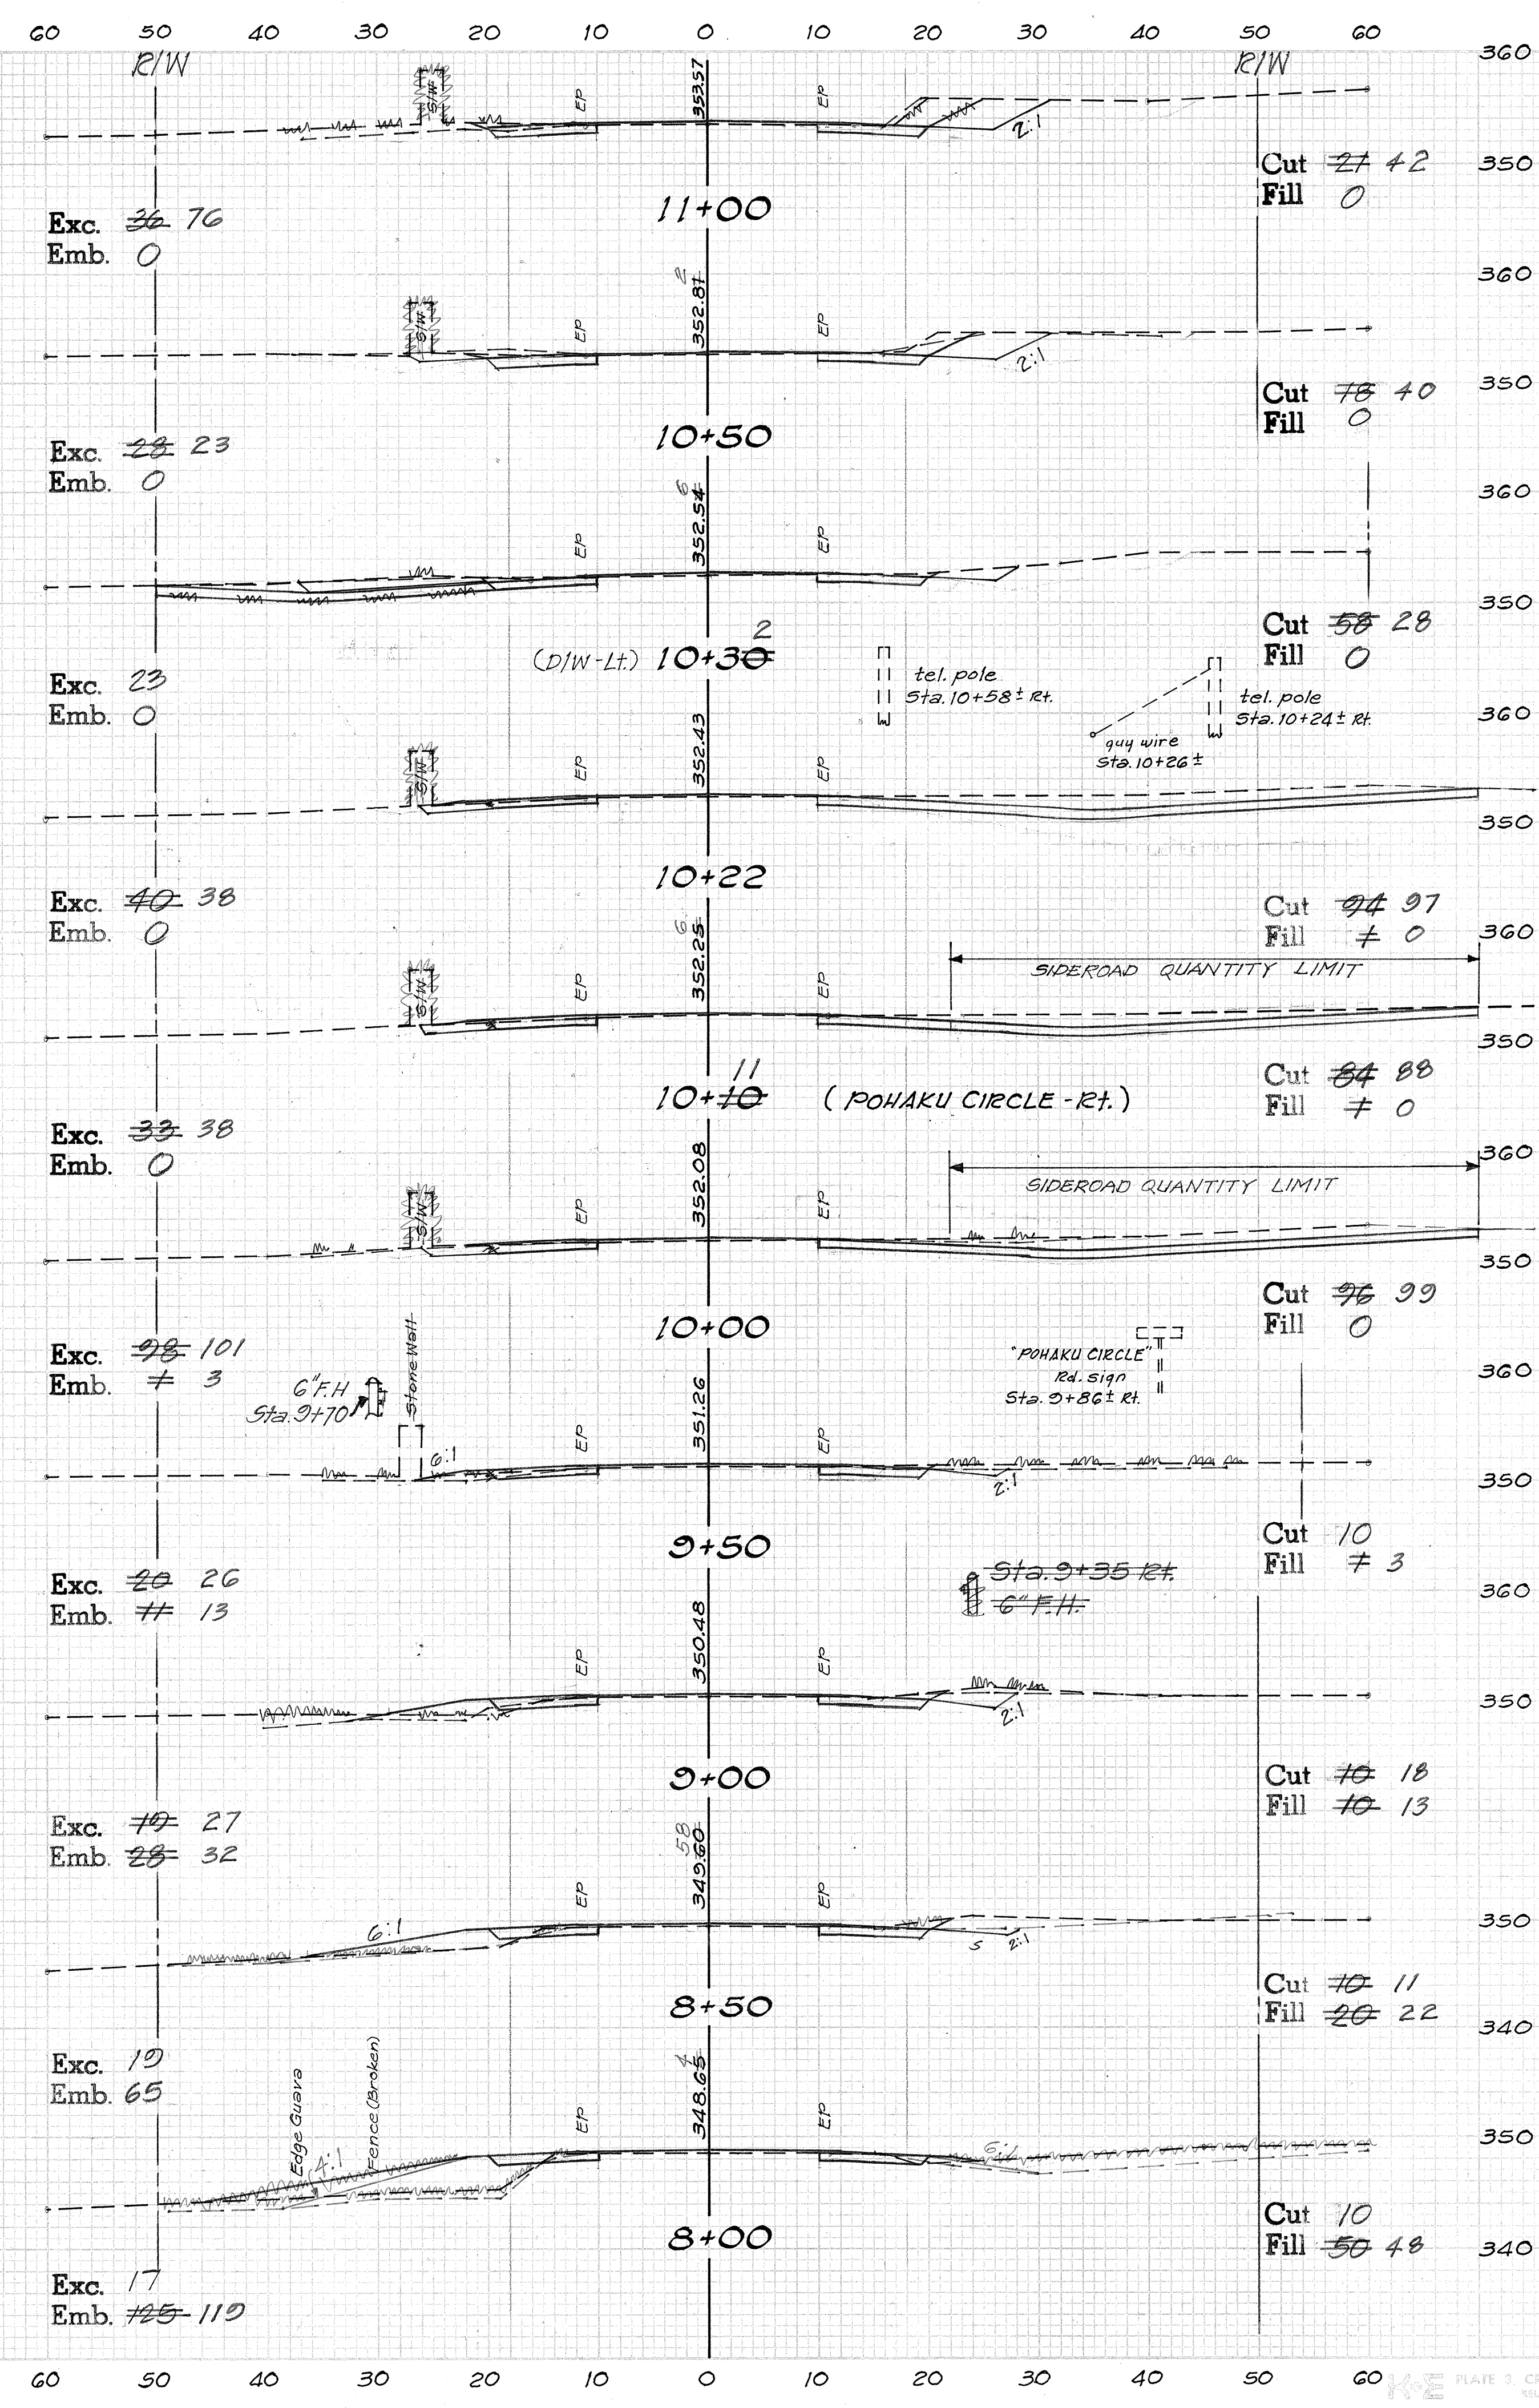



60 50 40 30 20 10 0 10 20 30 40 50 60

60 50 40 30 20 10 0 10 20 30 40 50 60


FED. ROAD DIST. NO.	STATE	FED. AID PROJ. NO.	FISCAL YEAR	SHEET NO.	TOTAL SHEETS
HAWAII	HAW.	28-0130(19)	1988	21	25

DATE	BY	FINAL SURVEY	PLOTTED	DATE	AREAS CHECKED
NOTE BOOK					
NO.					


DATE	BY	ORIGINAL SURVEY	PLOTTED	DATE	AREAS CHECKED
10/78	J. O.				
NOTE BOOK					
1149; MC 22-26					

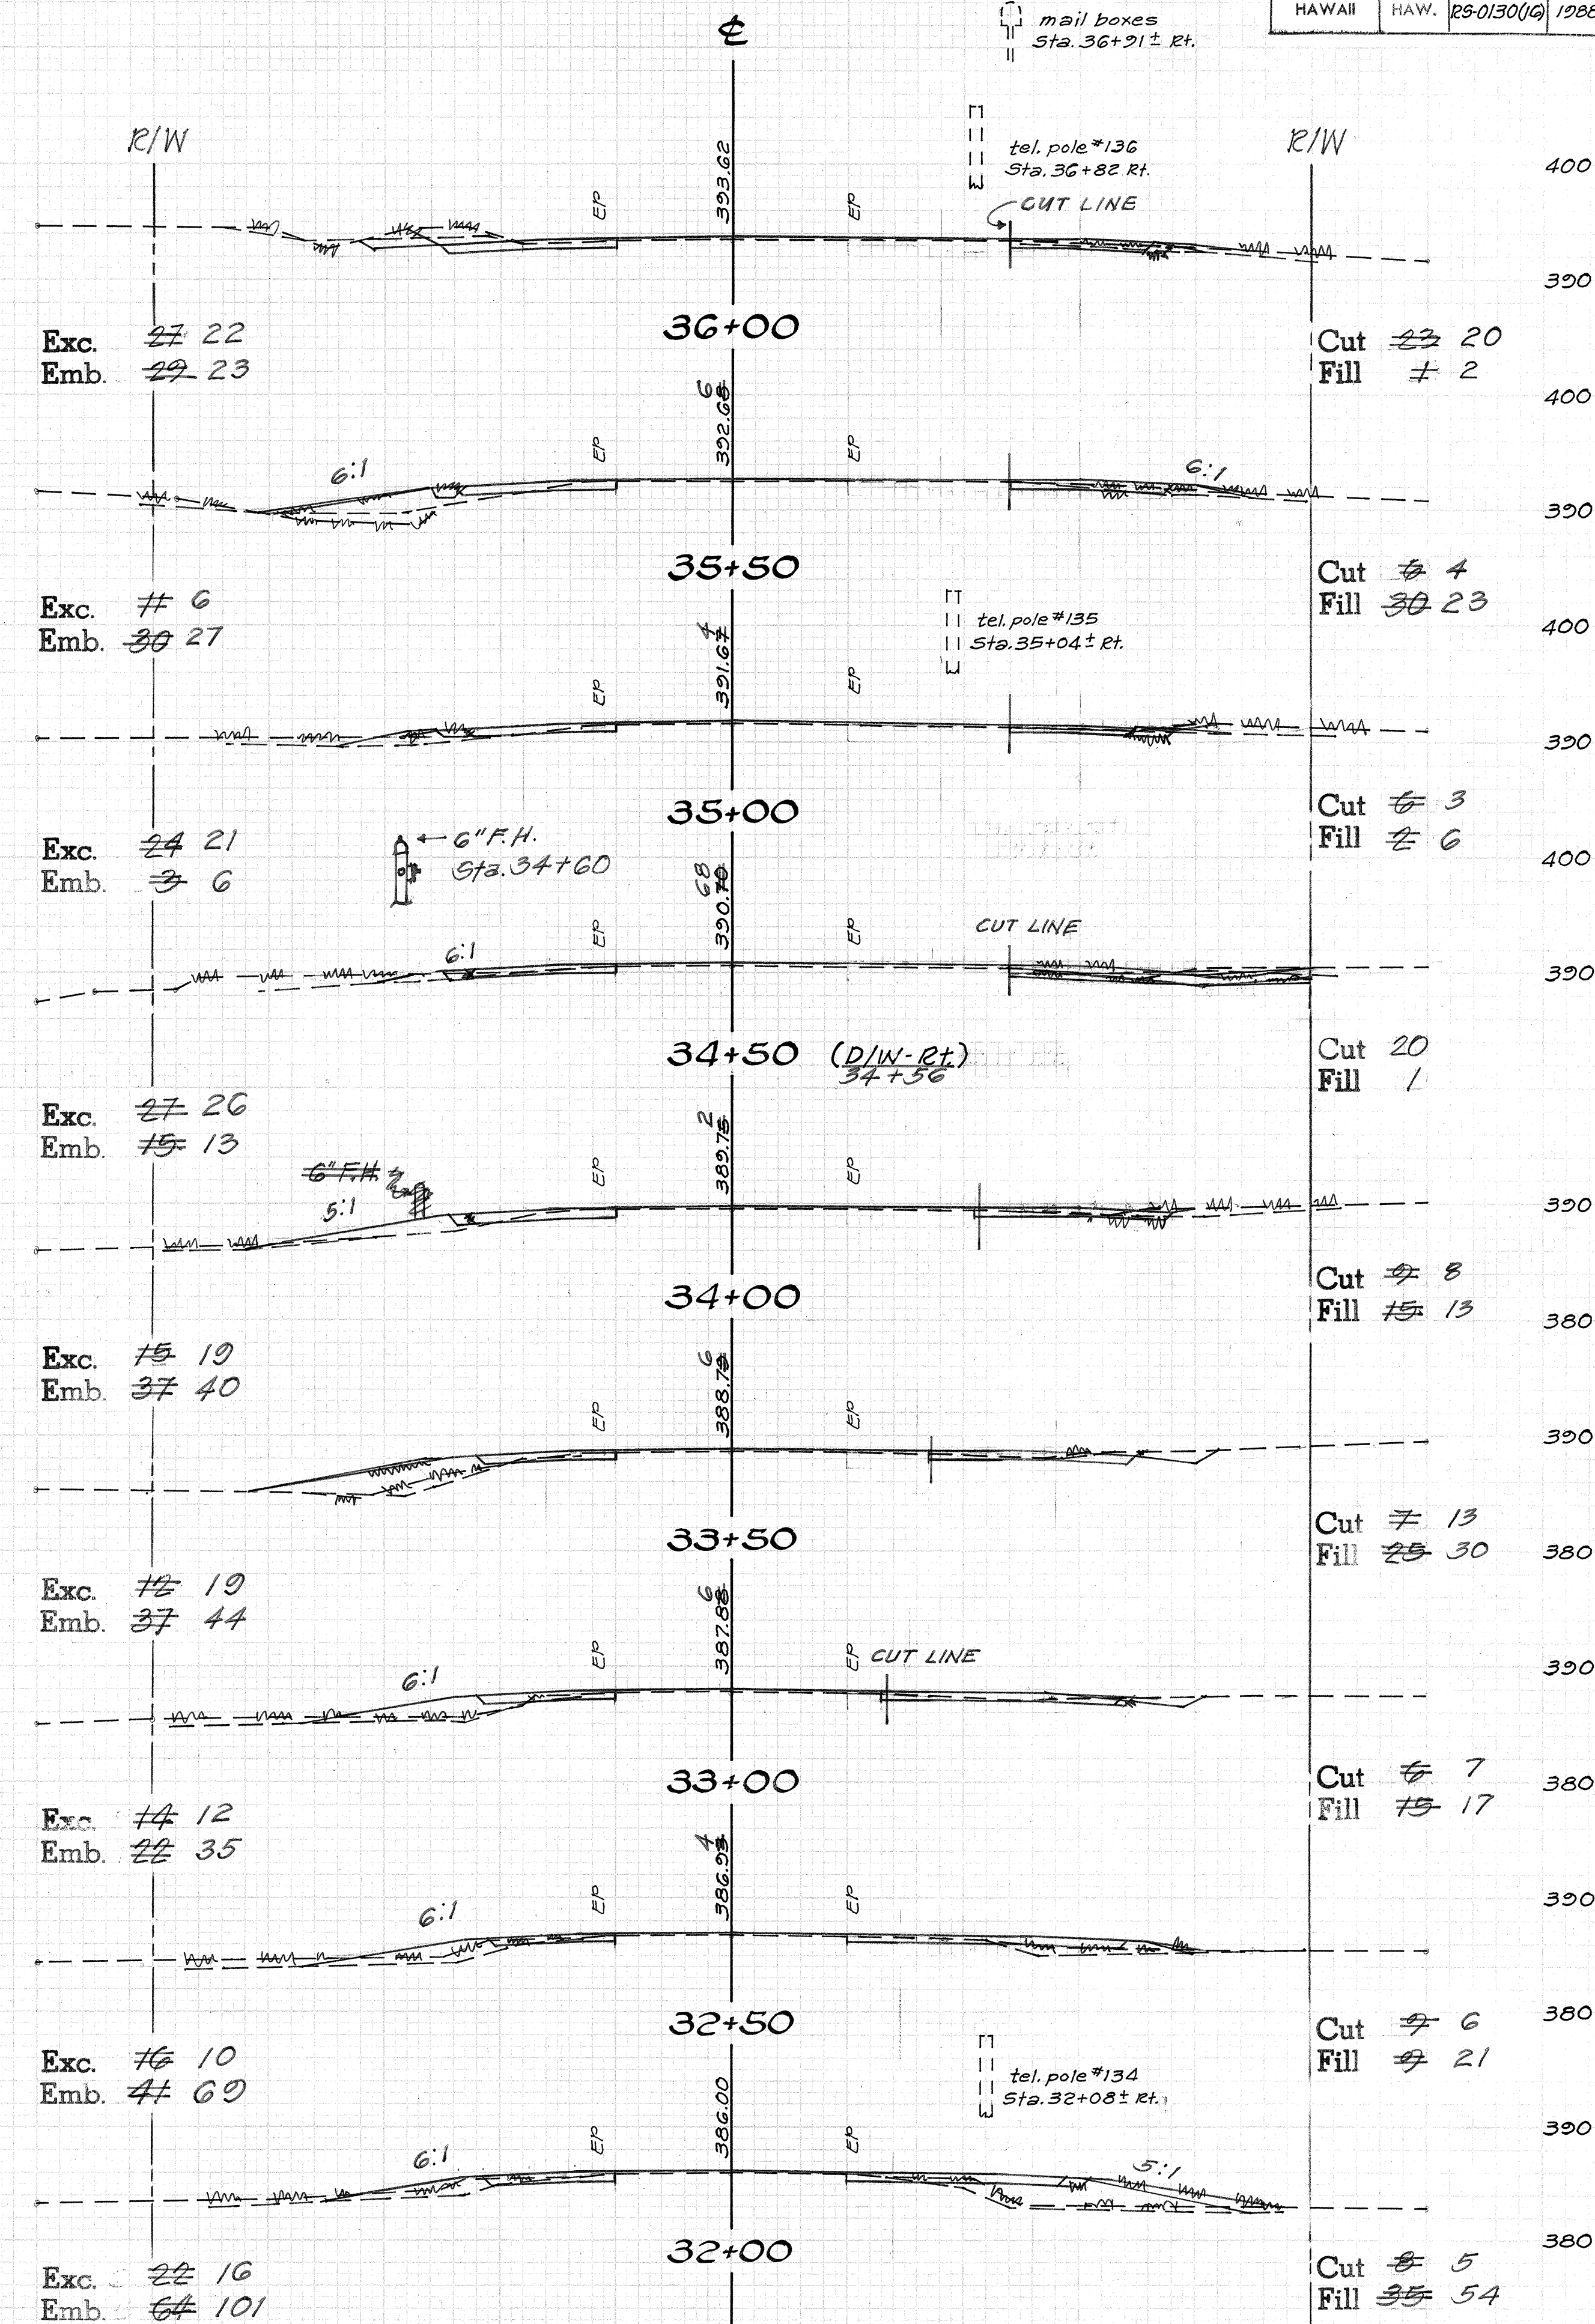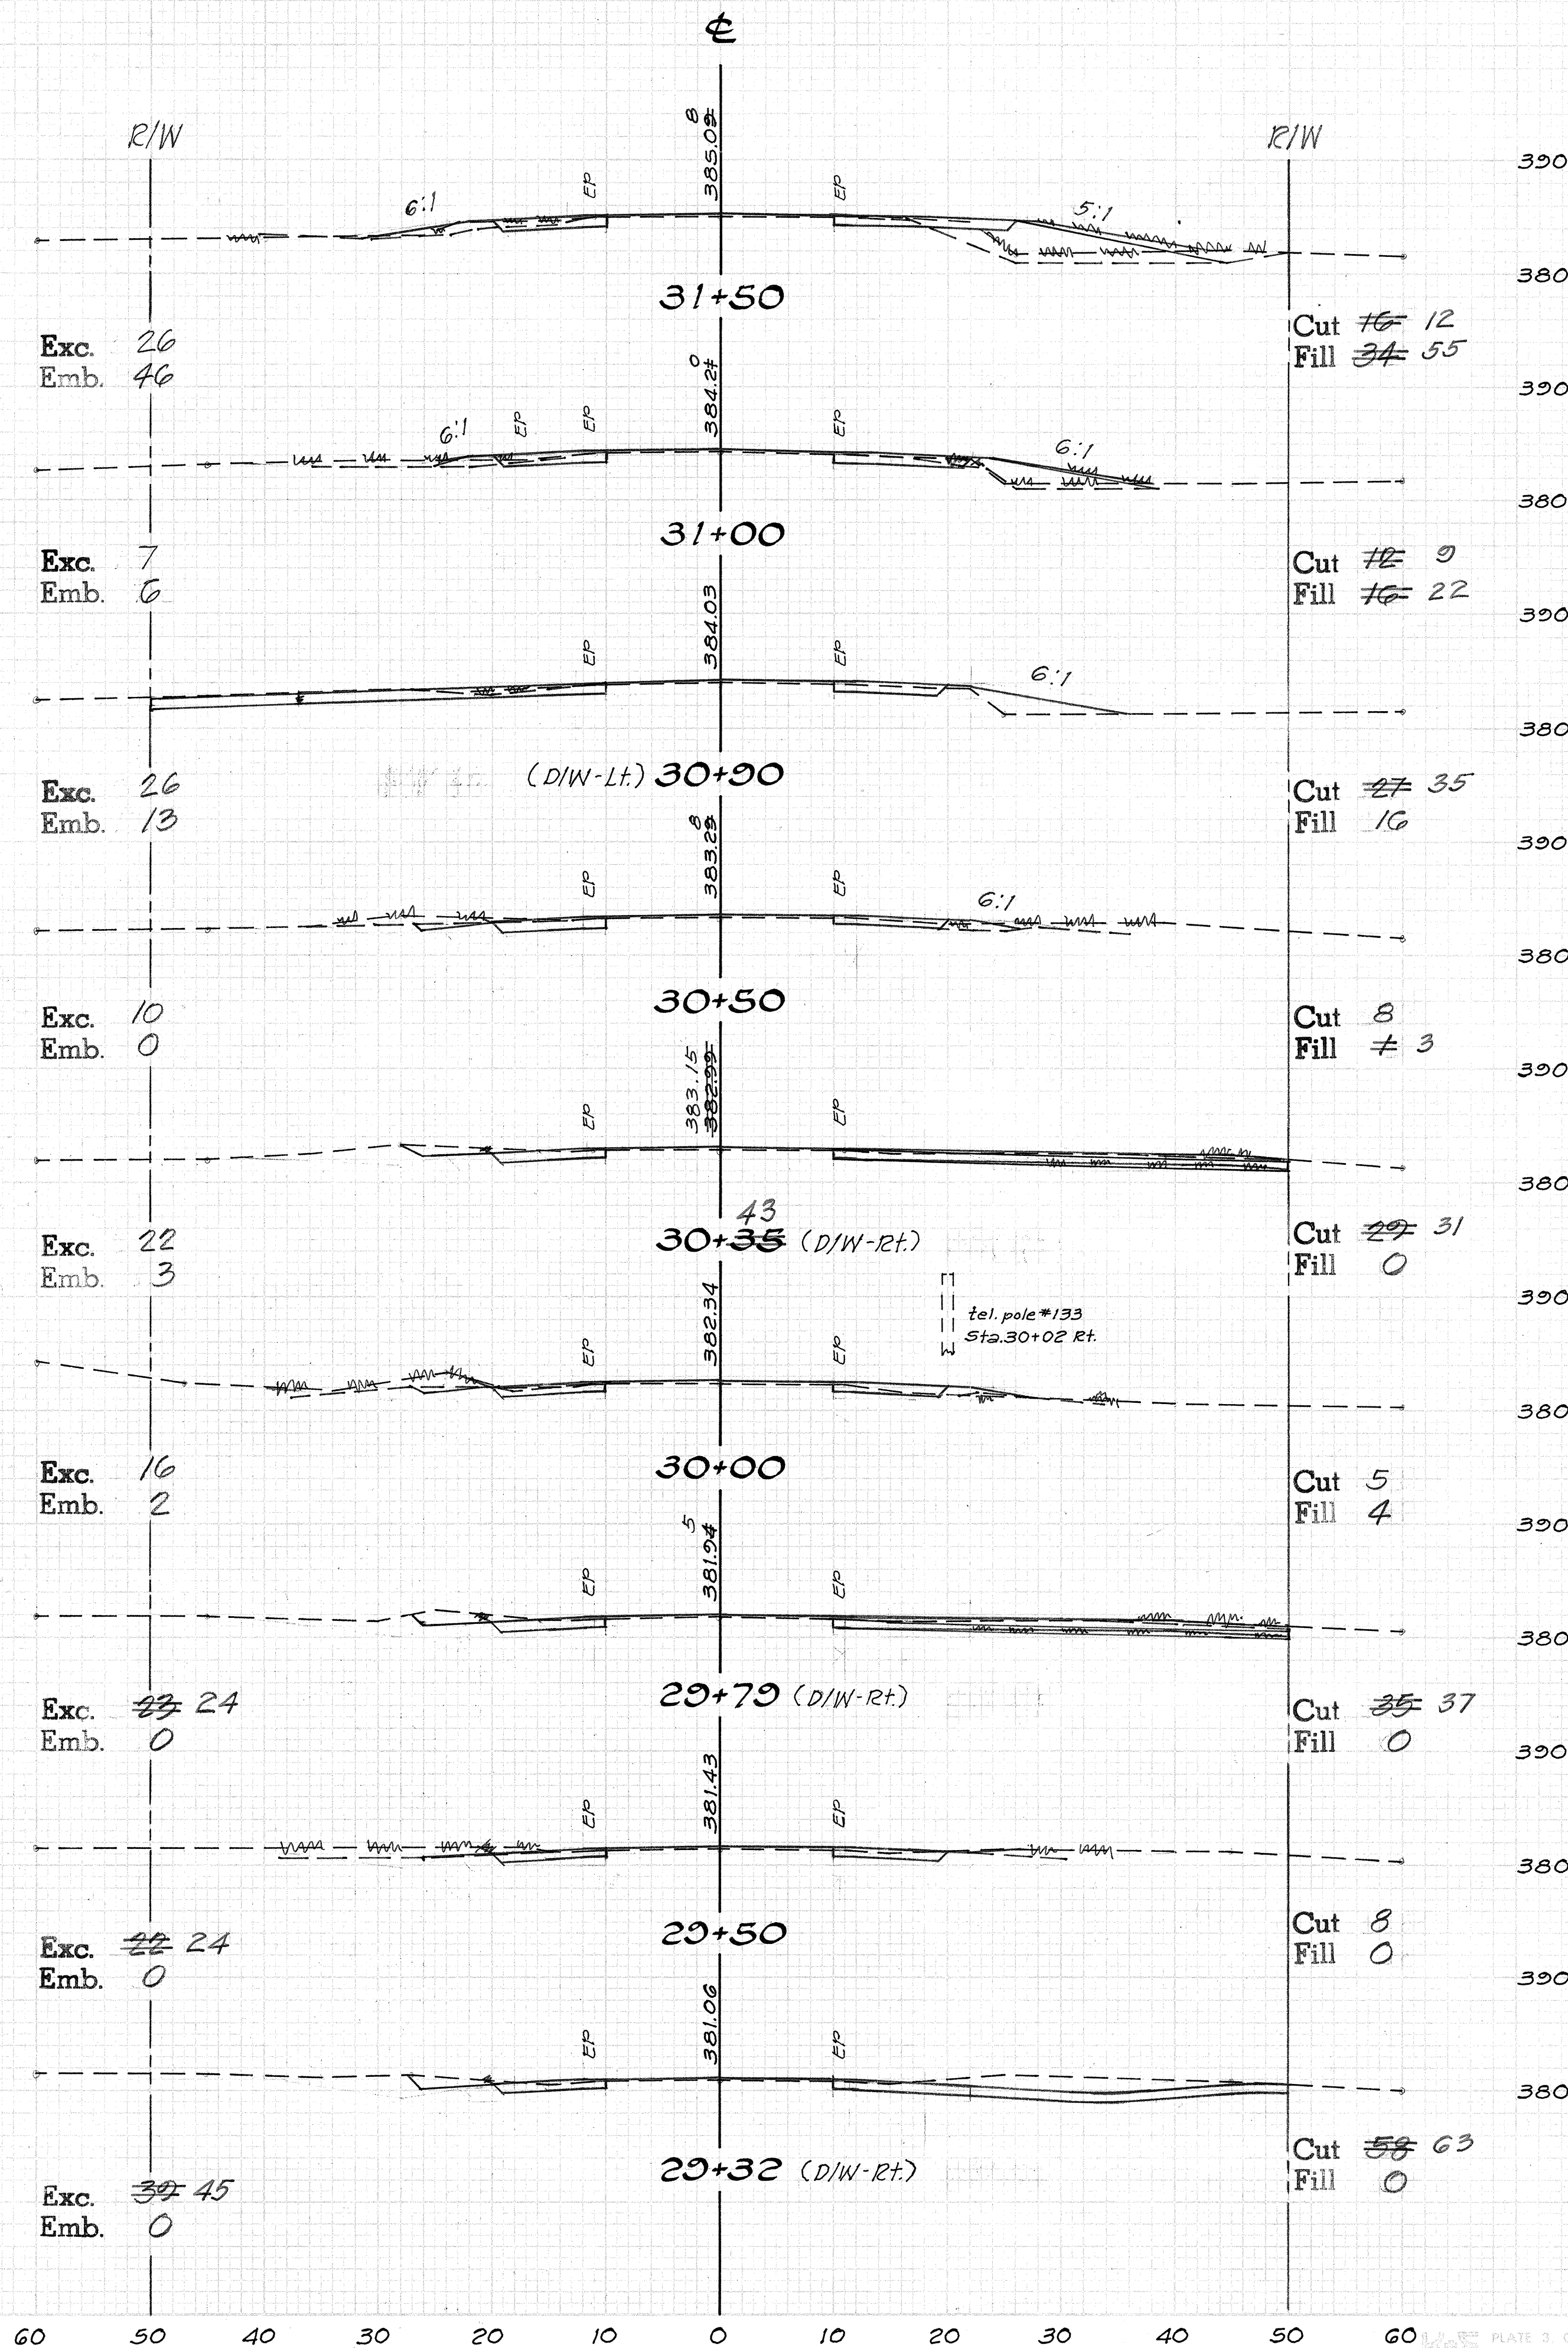

60 50 40 30 20 10 0 10 20 30 40 50 60

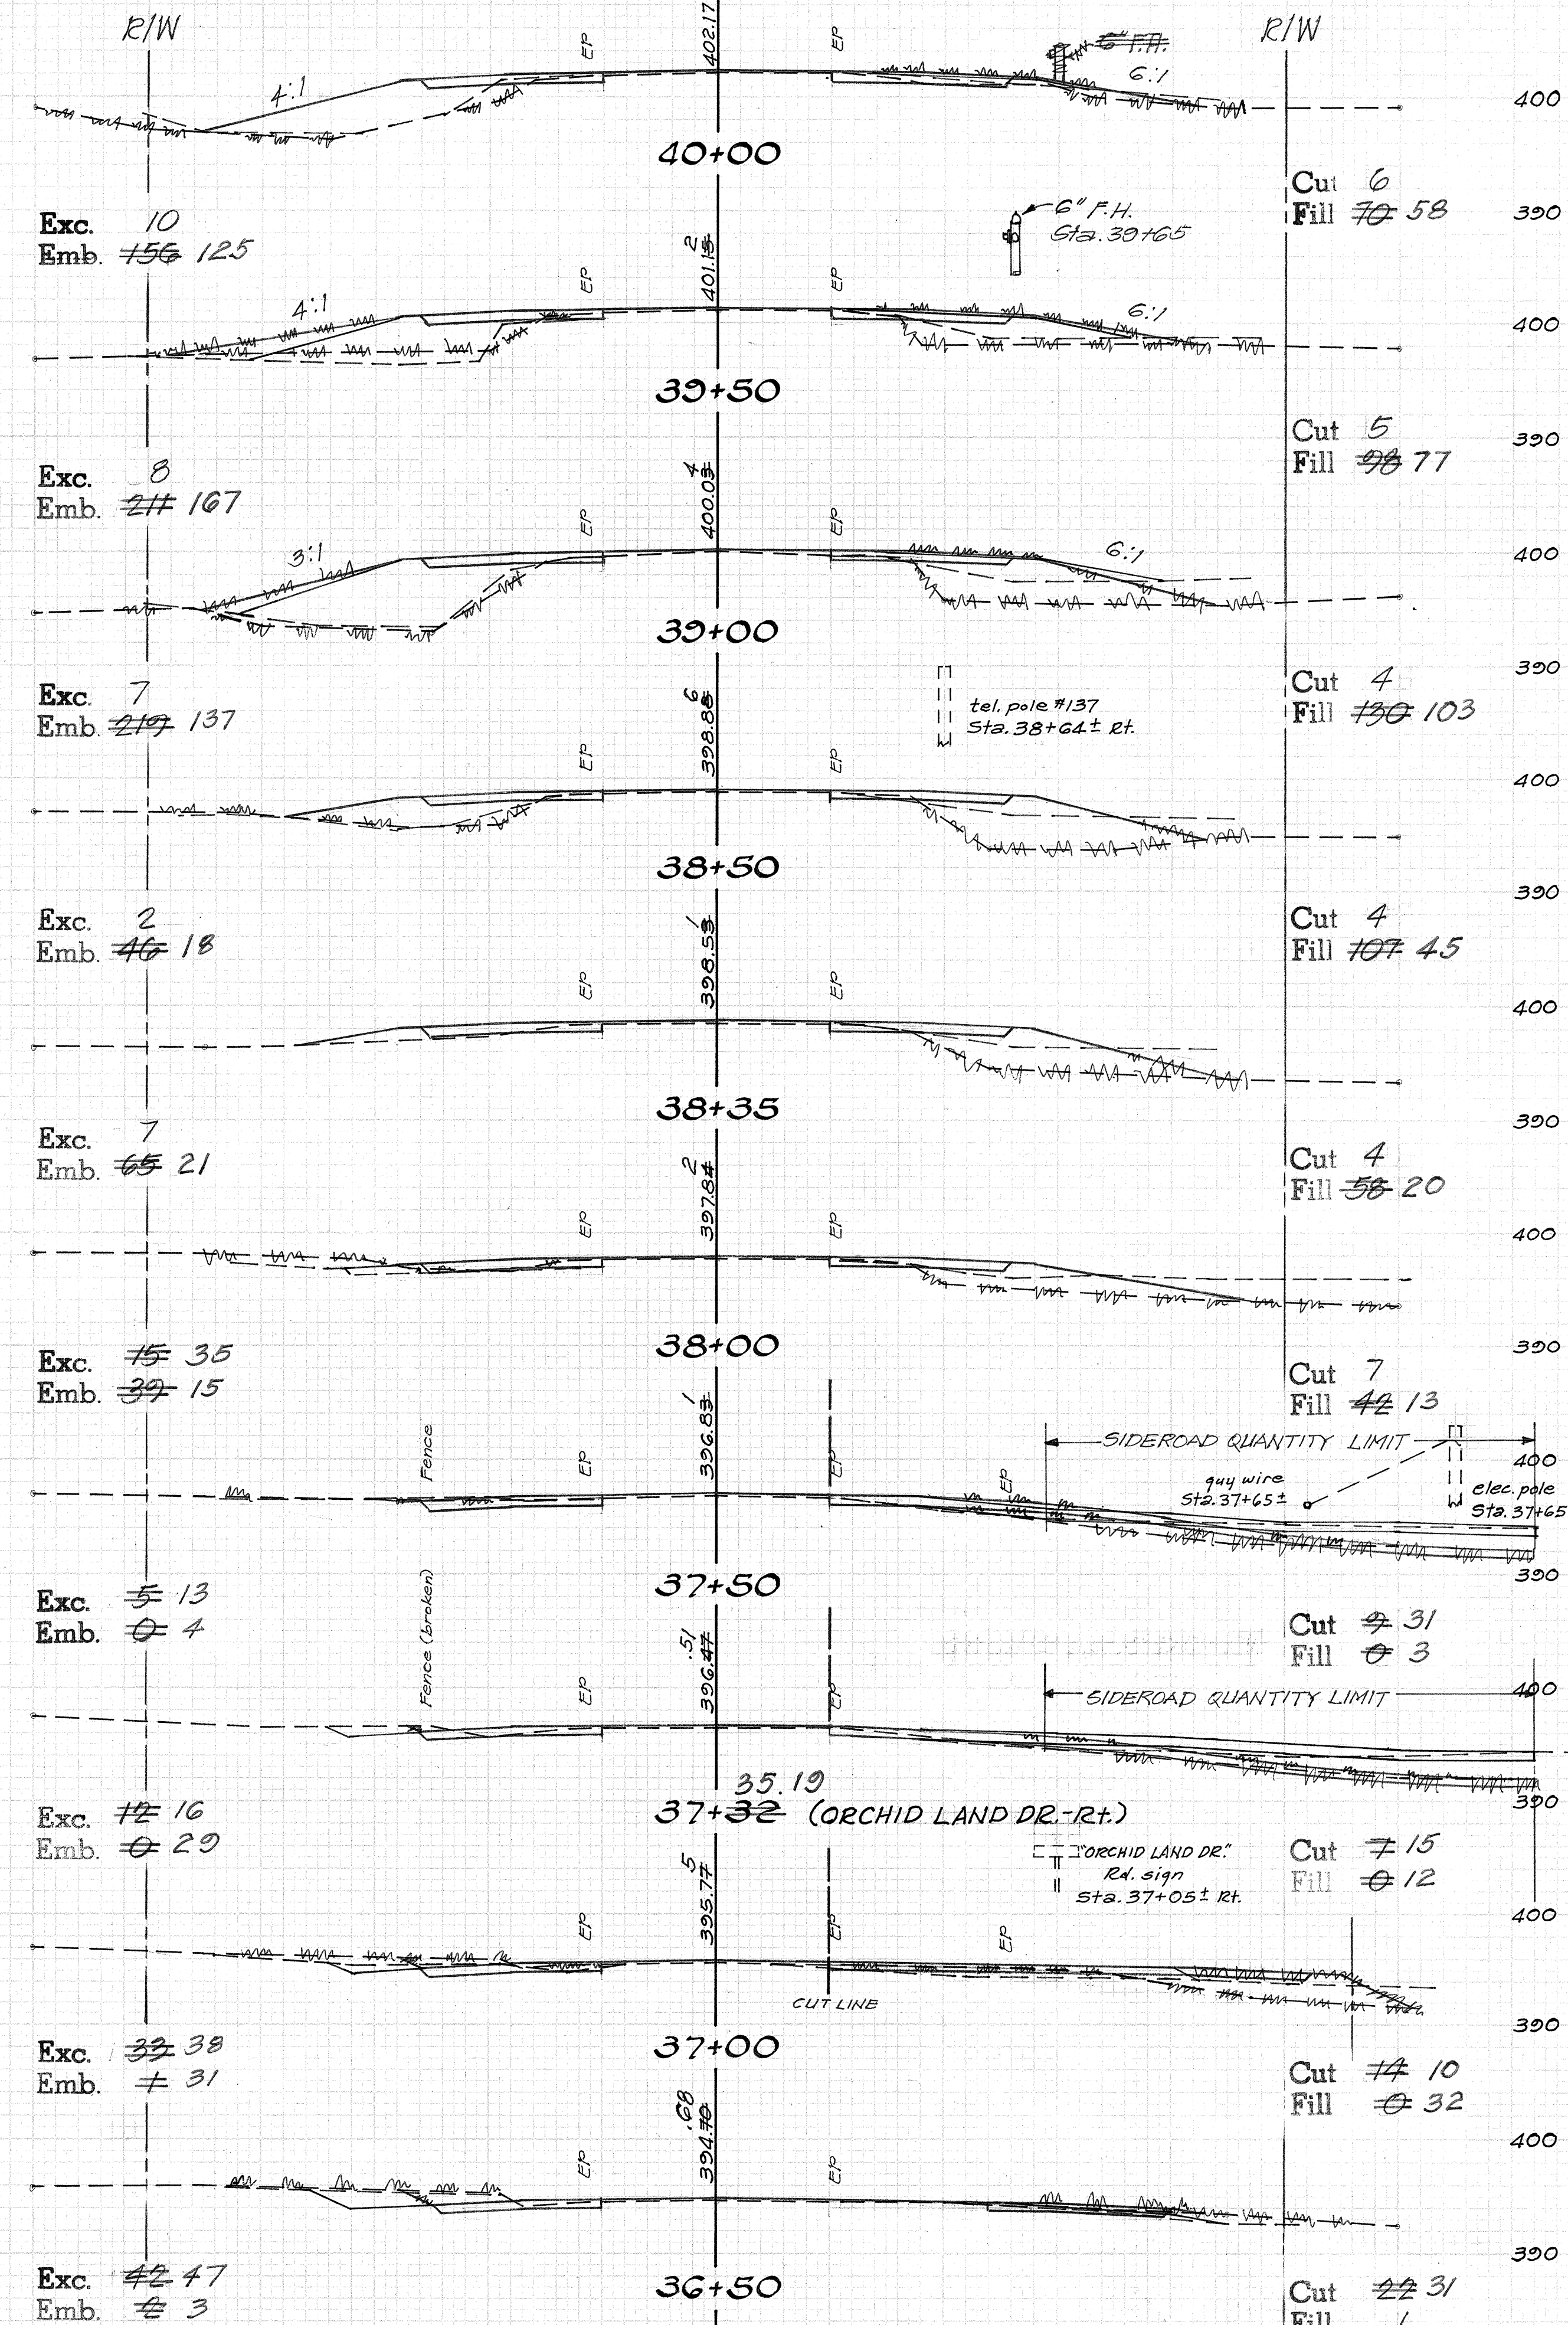

60 50 40 30 20 10 0 10 20 30 40 50 60

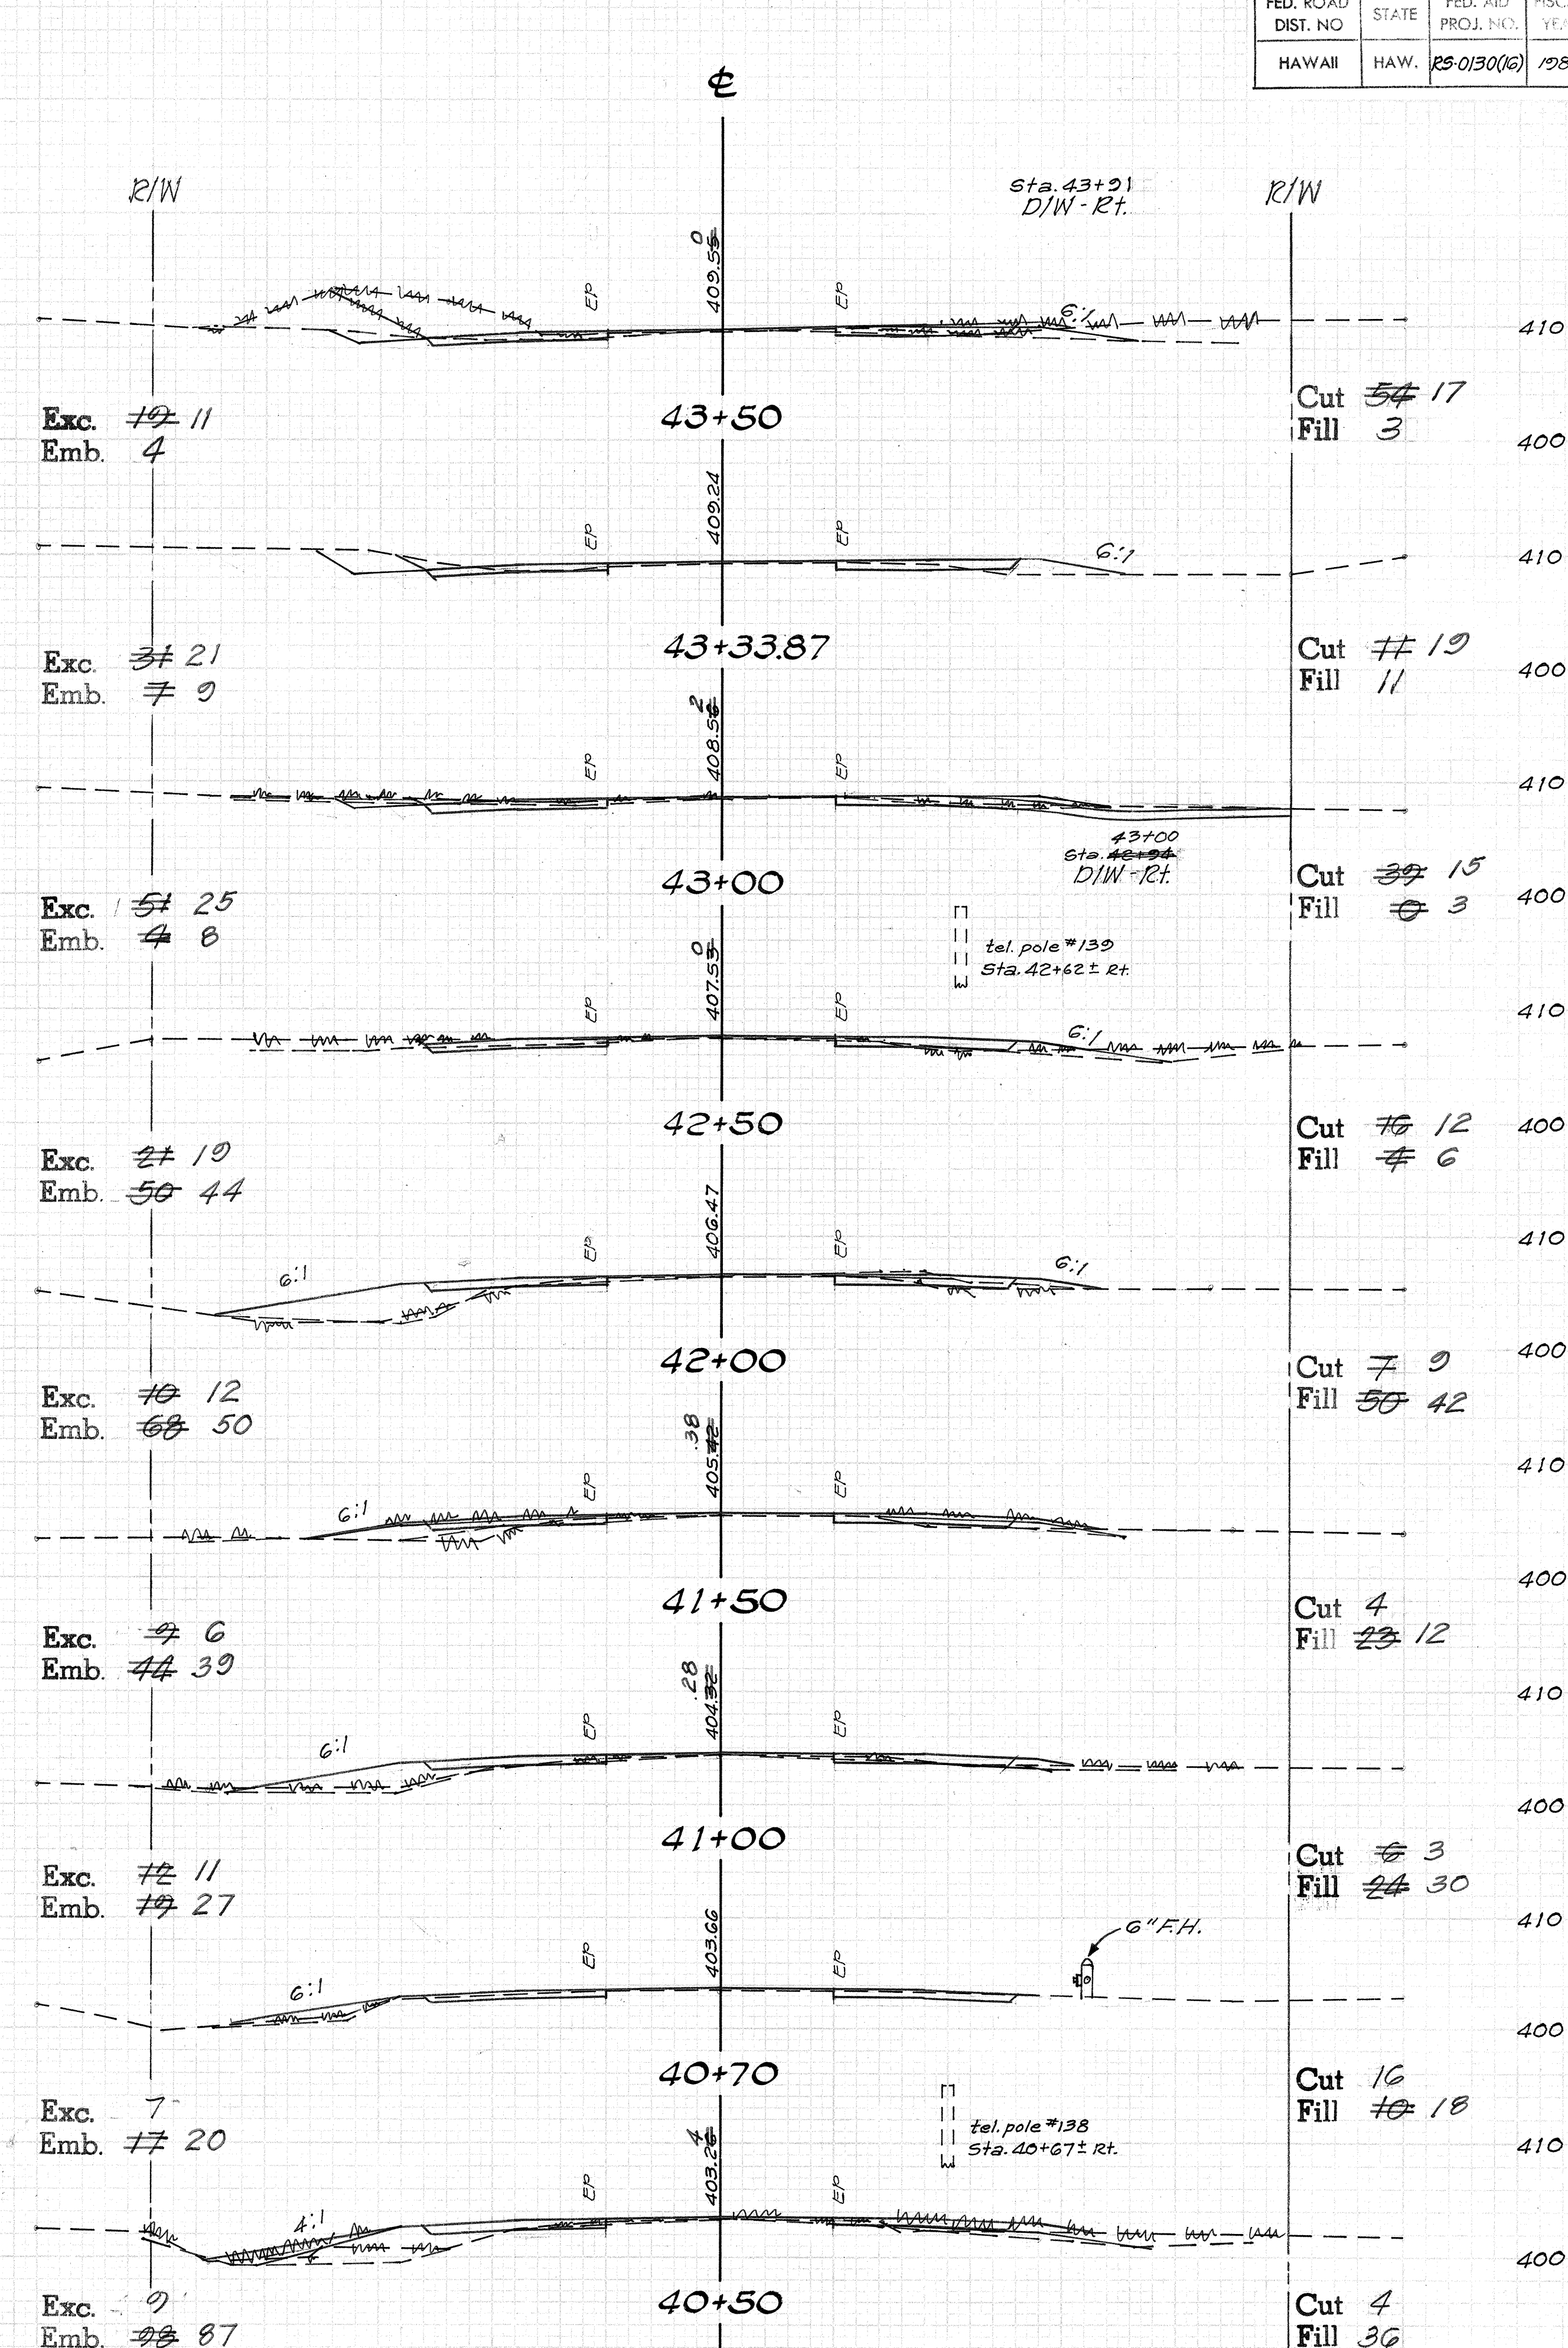


FED. ROAD DIST. NO.	STATE	FED. AID PROJ. NO.	FISCAL YEAR	SHEET NO.	TOTAL SHEETS
HAWAII	HAW.	PS-0130(16)	1988	22	25

DATE	BY	REVISION
11/49	16/72	1

DATE	BY	REVISION
11/49	16/72	1

60 50 40 30 20 10 0 10 20 30 40 50 60

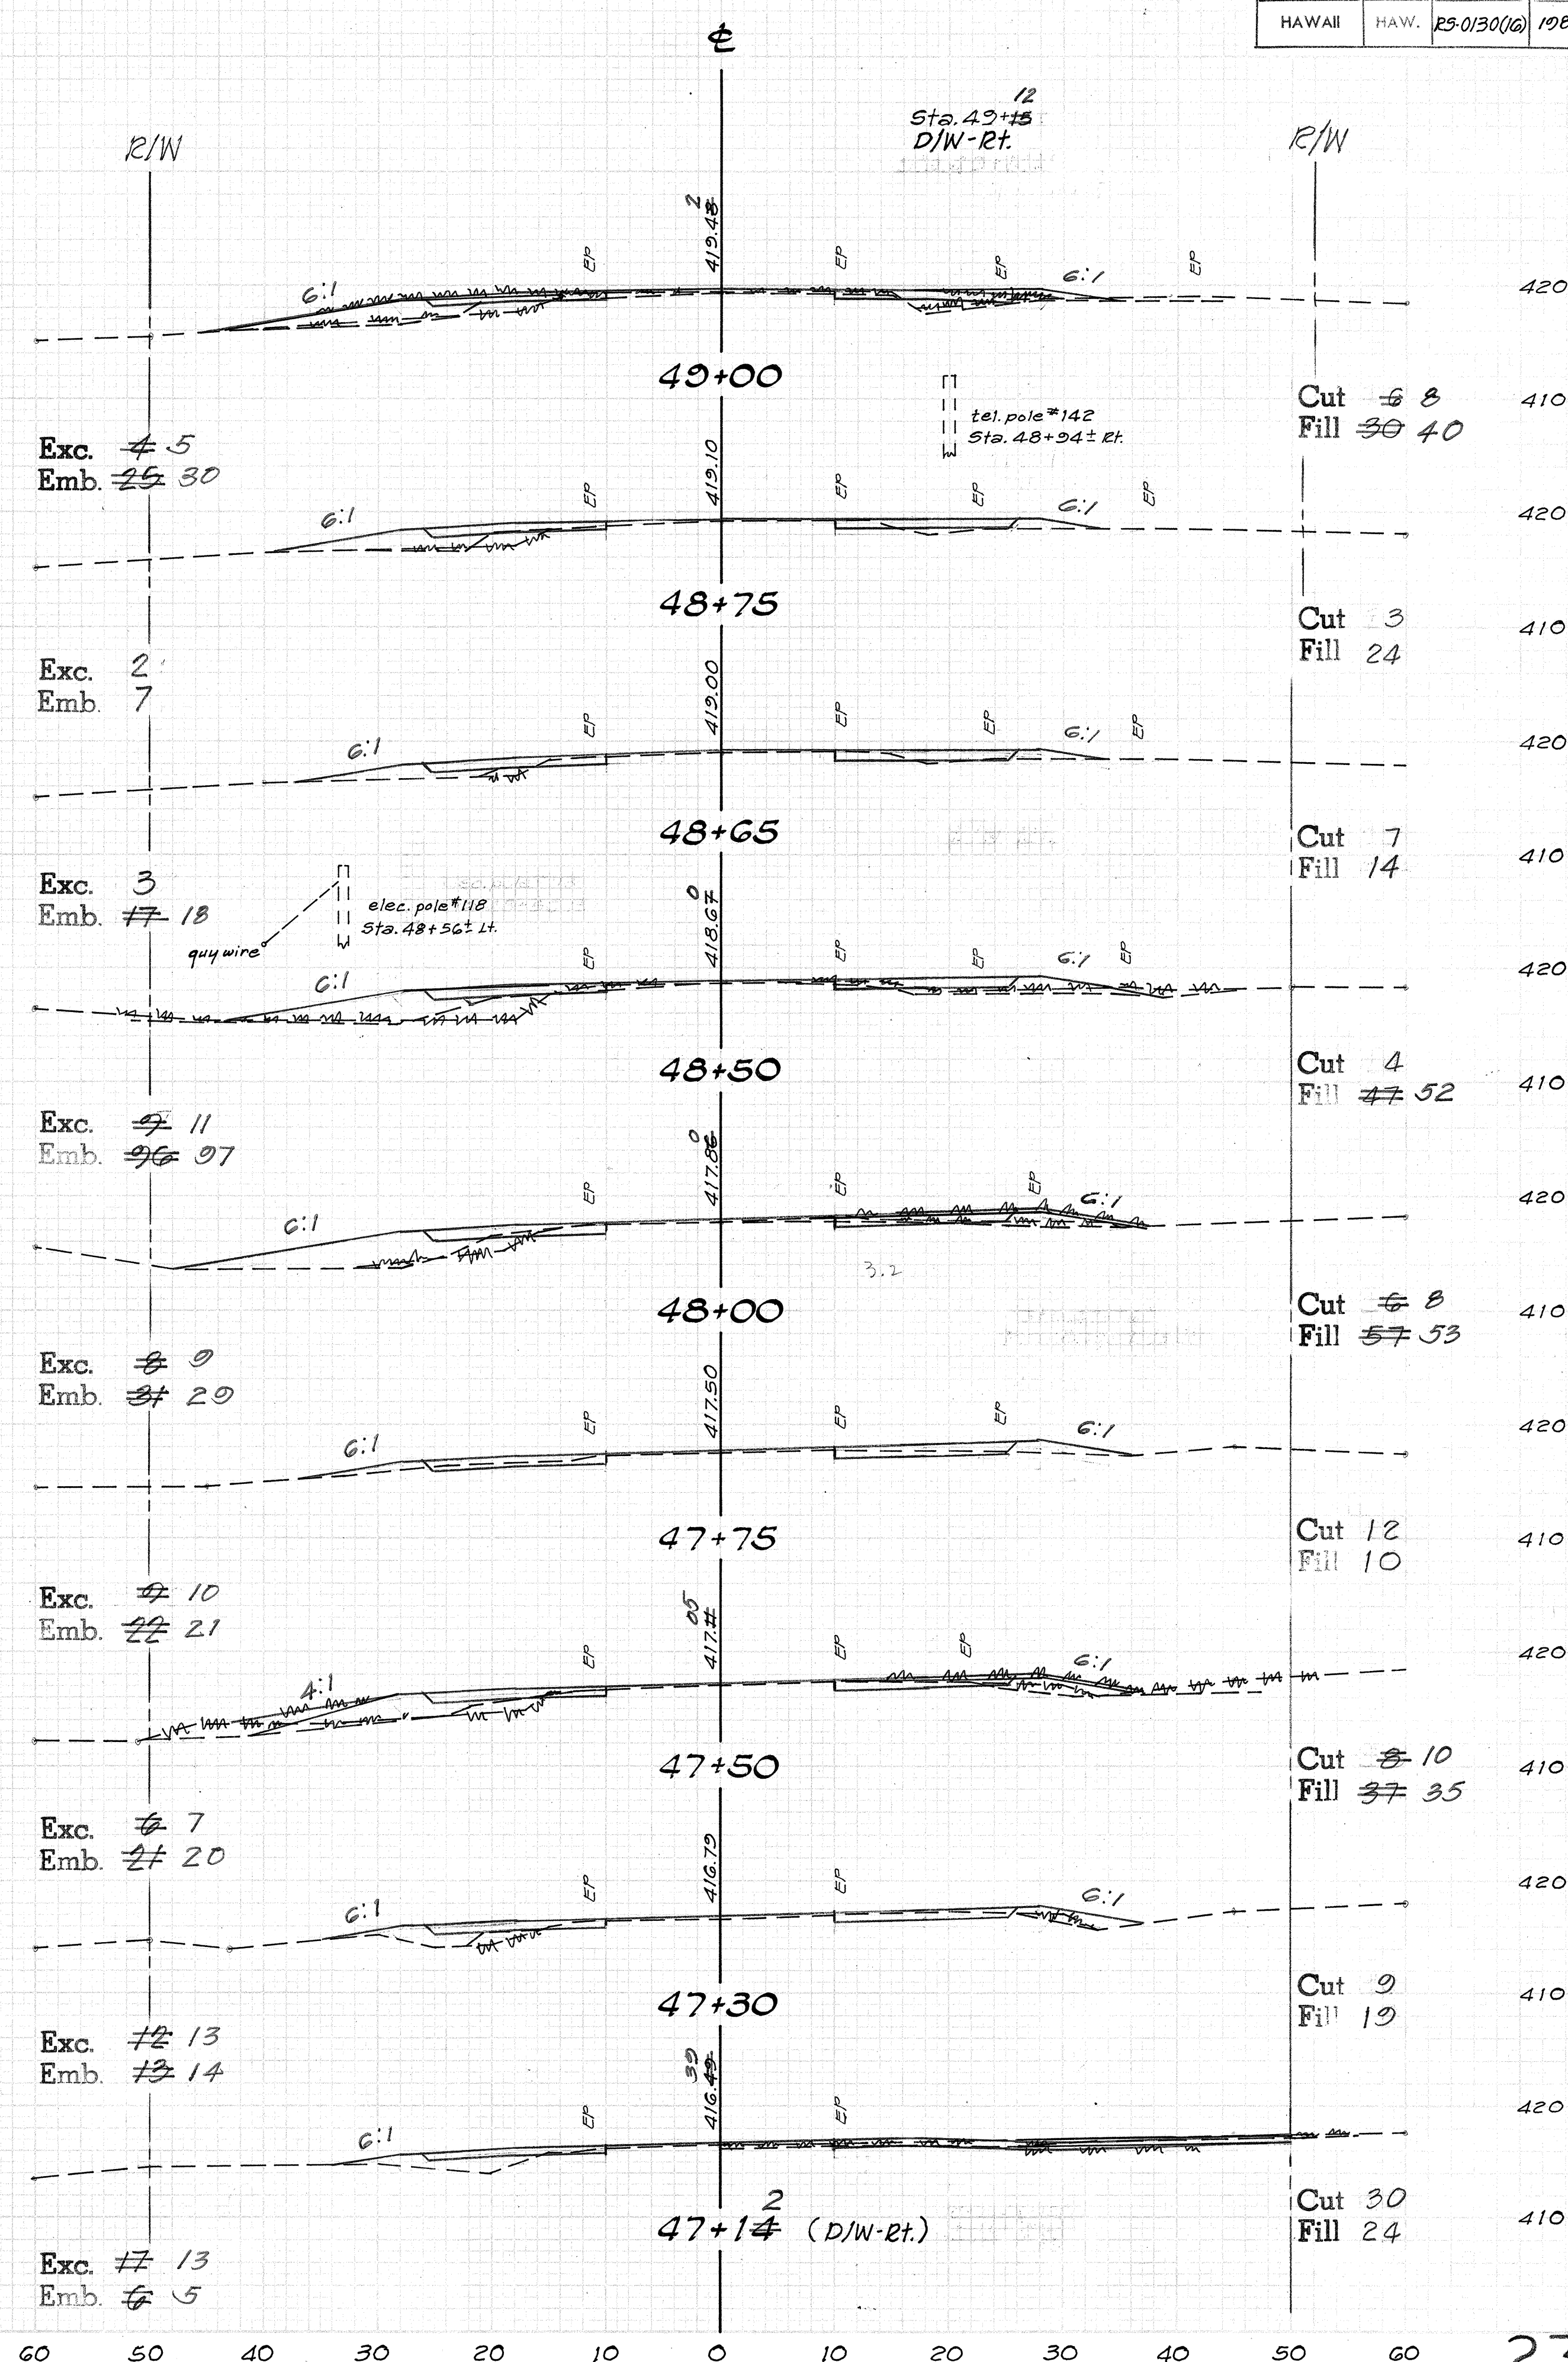



60 50 40 30 20 10 0 10 20 30 40 50 60

60 50 40 30 20 10 0 10 20 30 40

FED. ROAD DIST. NO.	STATE	FED. AID PROJ. NO.	FISCAL YEAR	SHEET NO.	TOTAL SHEETS
HAWAII	HAW.	RS-0130(G)	1988	24	25

DATE	
BY	
FINAL SURVEY	
PLOTTED	
DATE	
NOTE BOOK	
NO.	

DATE	10/72
BY	J.O.
ORIGINAL SURVEY	
PLOTTED	
DATE	
NOTE BOOK	1/25
NO.	45-39

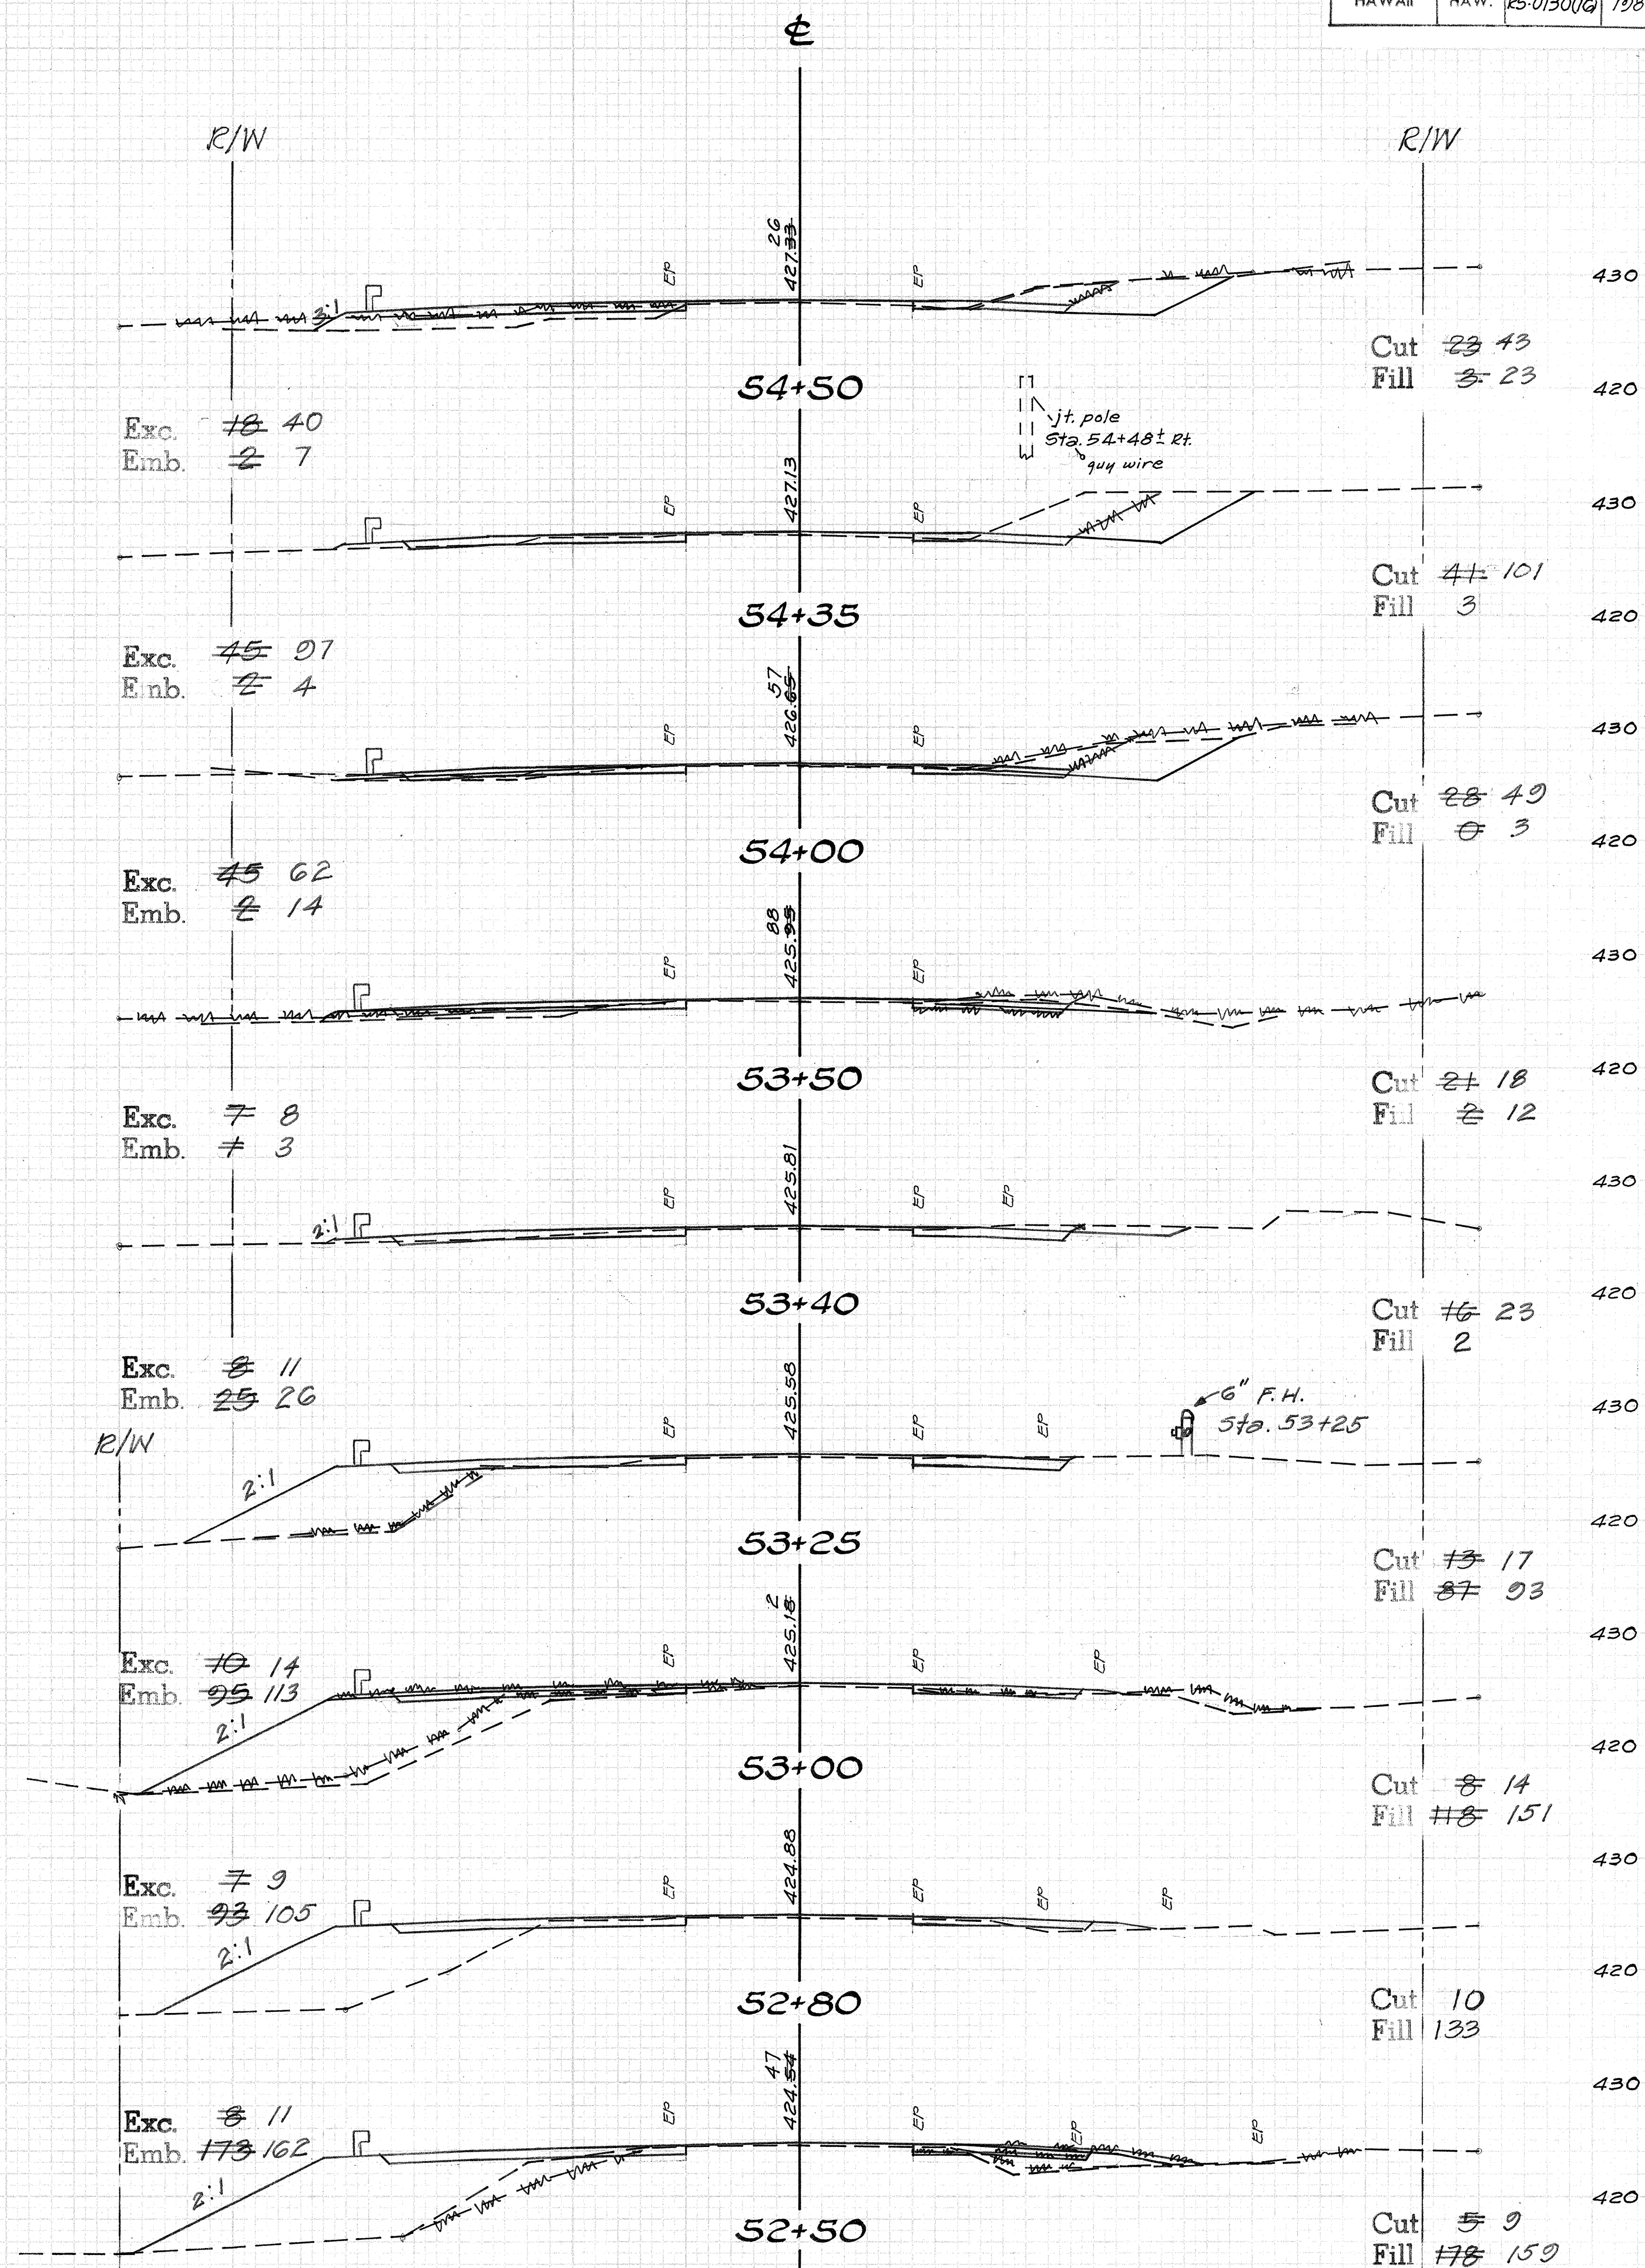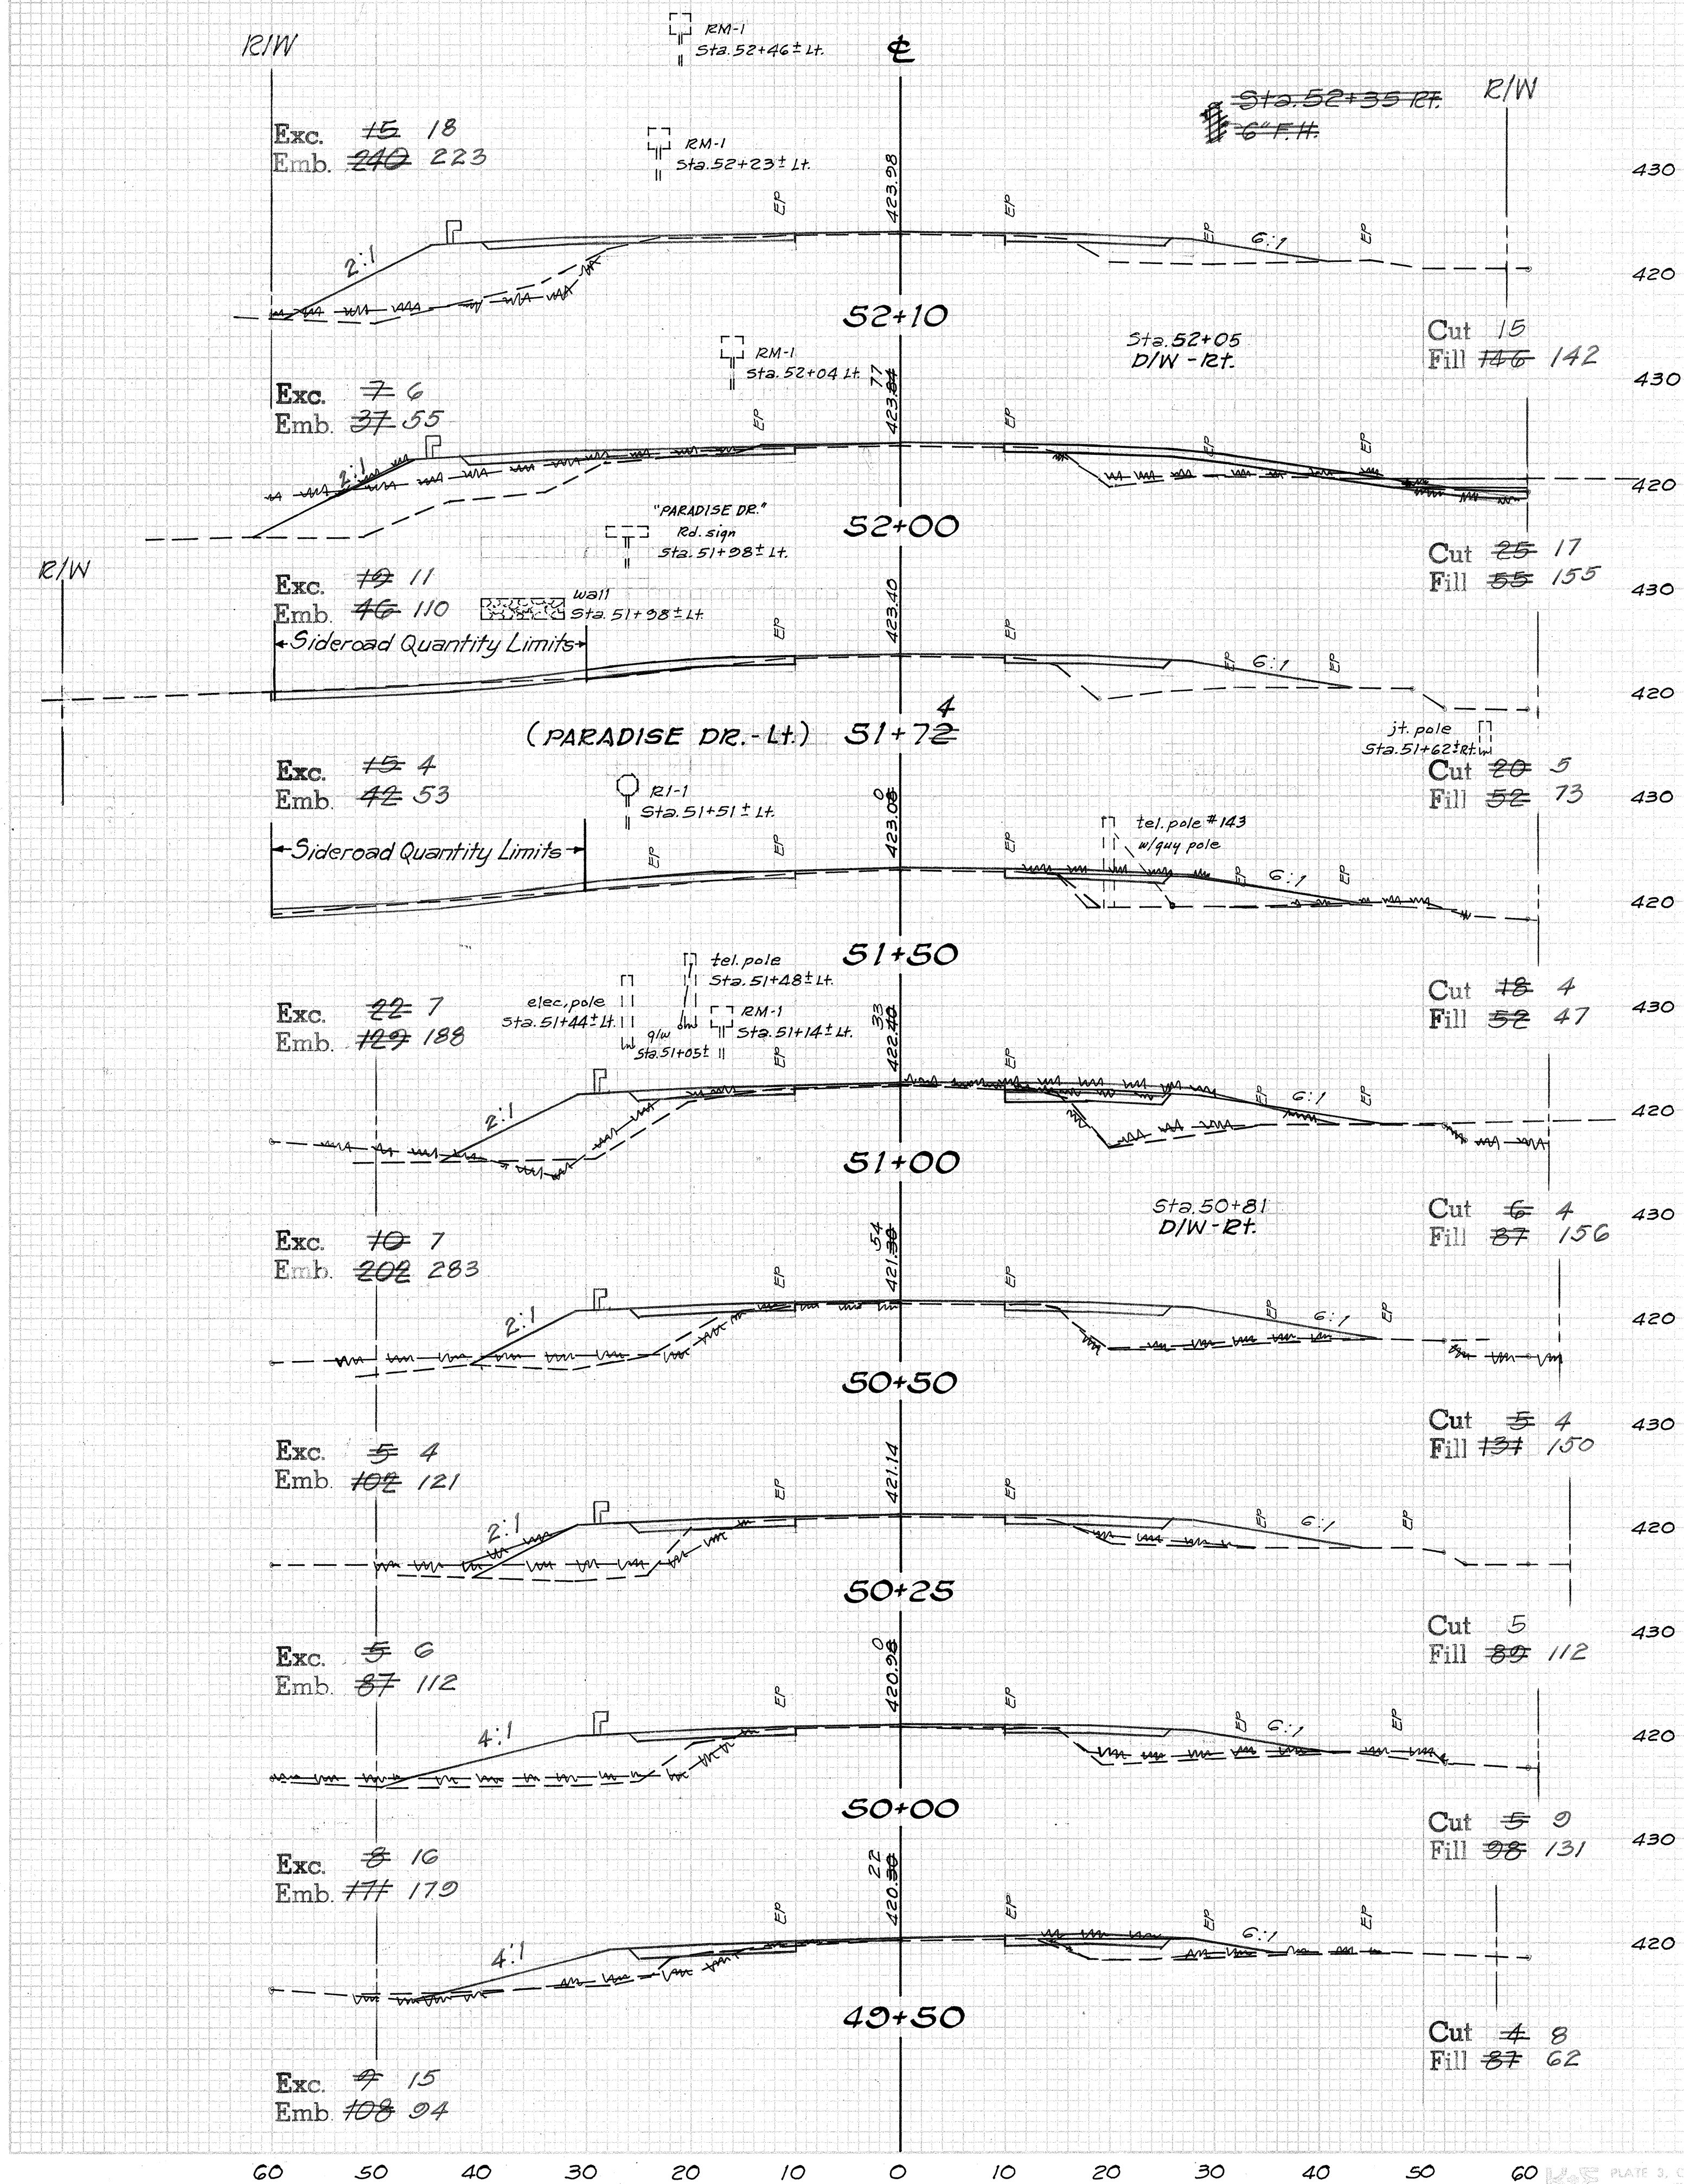

60 50 40 30 20 10 0 10 20 30 40 50 60

60 50 40 30 20 10 0 10 20 30 40 50 60

FED. ROAD DIST. NO.	STATE	FED. AID PROJ. NO.	FISCAL YEAR	SHEET NO.	TOTAL SHEETS
HAWAII	HAW.	RS-0130(16)	1988	25	25

DATE	
BY	
FINAL SURVEY	
PLOTTED	
DATE	
NOTE BOOK	
AREAS CHECKED	
NO	

DATE	10/78
BY	J.O.
ORIGINAL SURVEY	
PLOTTED	
REPLATE	
DATE	1/49
NO	30-44

1143:55.56 (side road profile)

