


FED. ROAD DIST. NO.	STATE	FED. AID PROJ. NO.	FISCAL YEAR	SHEET NO.	TOTAL SHEETS
HAWAII	HAW.	RS-0130 (16)	1988	8	25

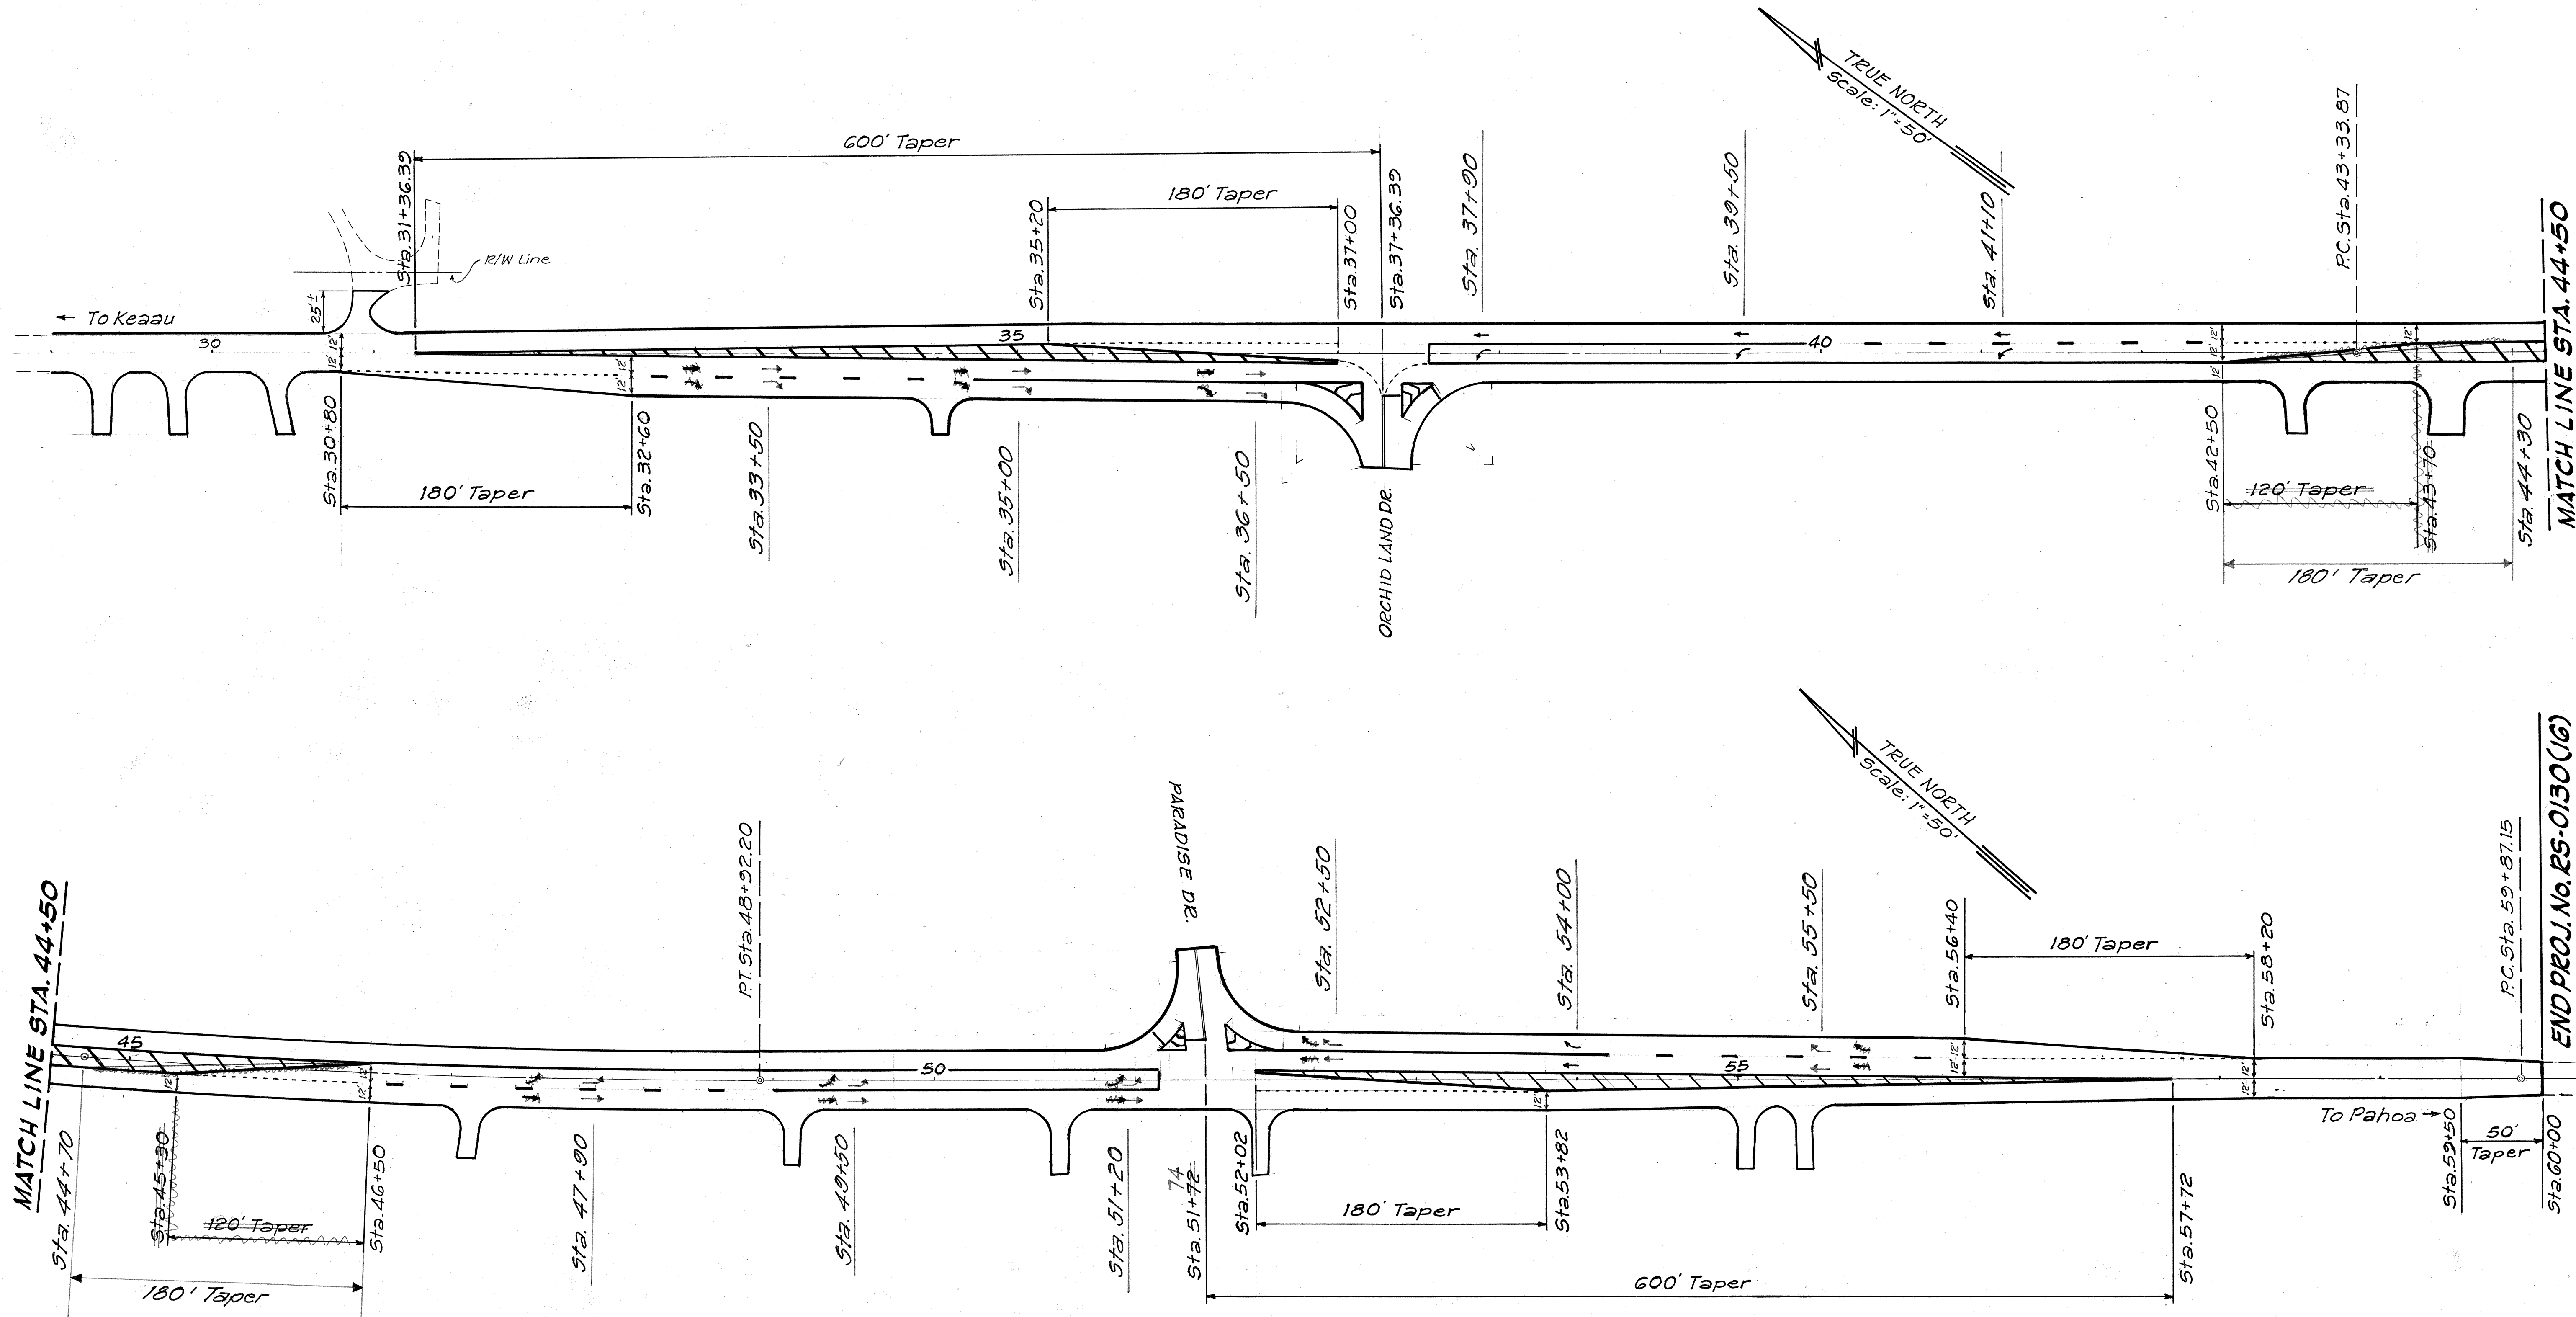

ORIGINAL PLAN	SURVEY PLOTTED BY	DATE
DATE	DRAWN BY	2017-09-27
DESIGNED BY	CHECKED BY	
QUANTITIES BY		
CHECKED BY		

STATE OF HAWAII
DEPARTMENT OF TRANSPORTATION
HIGHWAYS DIVISION

CHANNELIZING DETAIL

KEAAU-PAHOA ROAD
PARADISE PARK SECTION - PHASE-I
PUNA, HAWAII

Scale: As Noted Date: April 1988

SHEET No. / OF / SHEETS