


FED. ROAD DIST. NO.	STATE	FED. AID PROJ. NO.	FISCAL YEAR	SHEET NO.	TOTAL SHEETS
HAWAII	HAW.	RS-0130(16)	1988	9	25

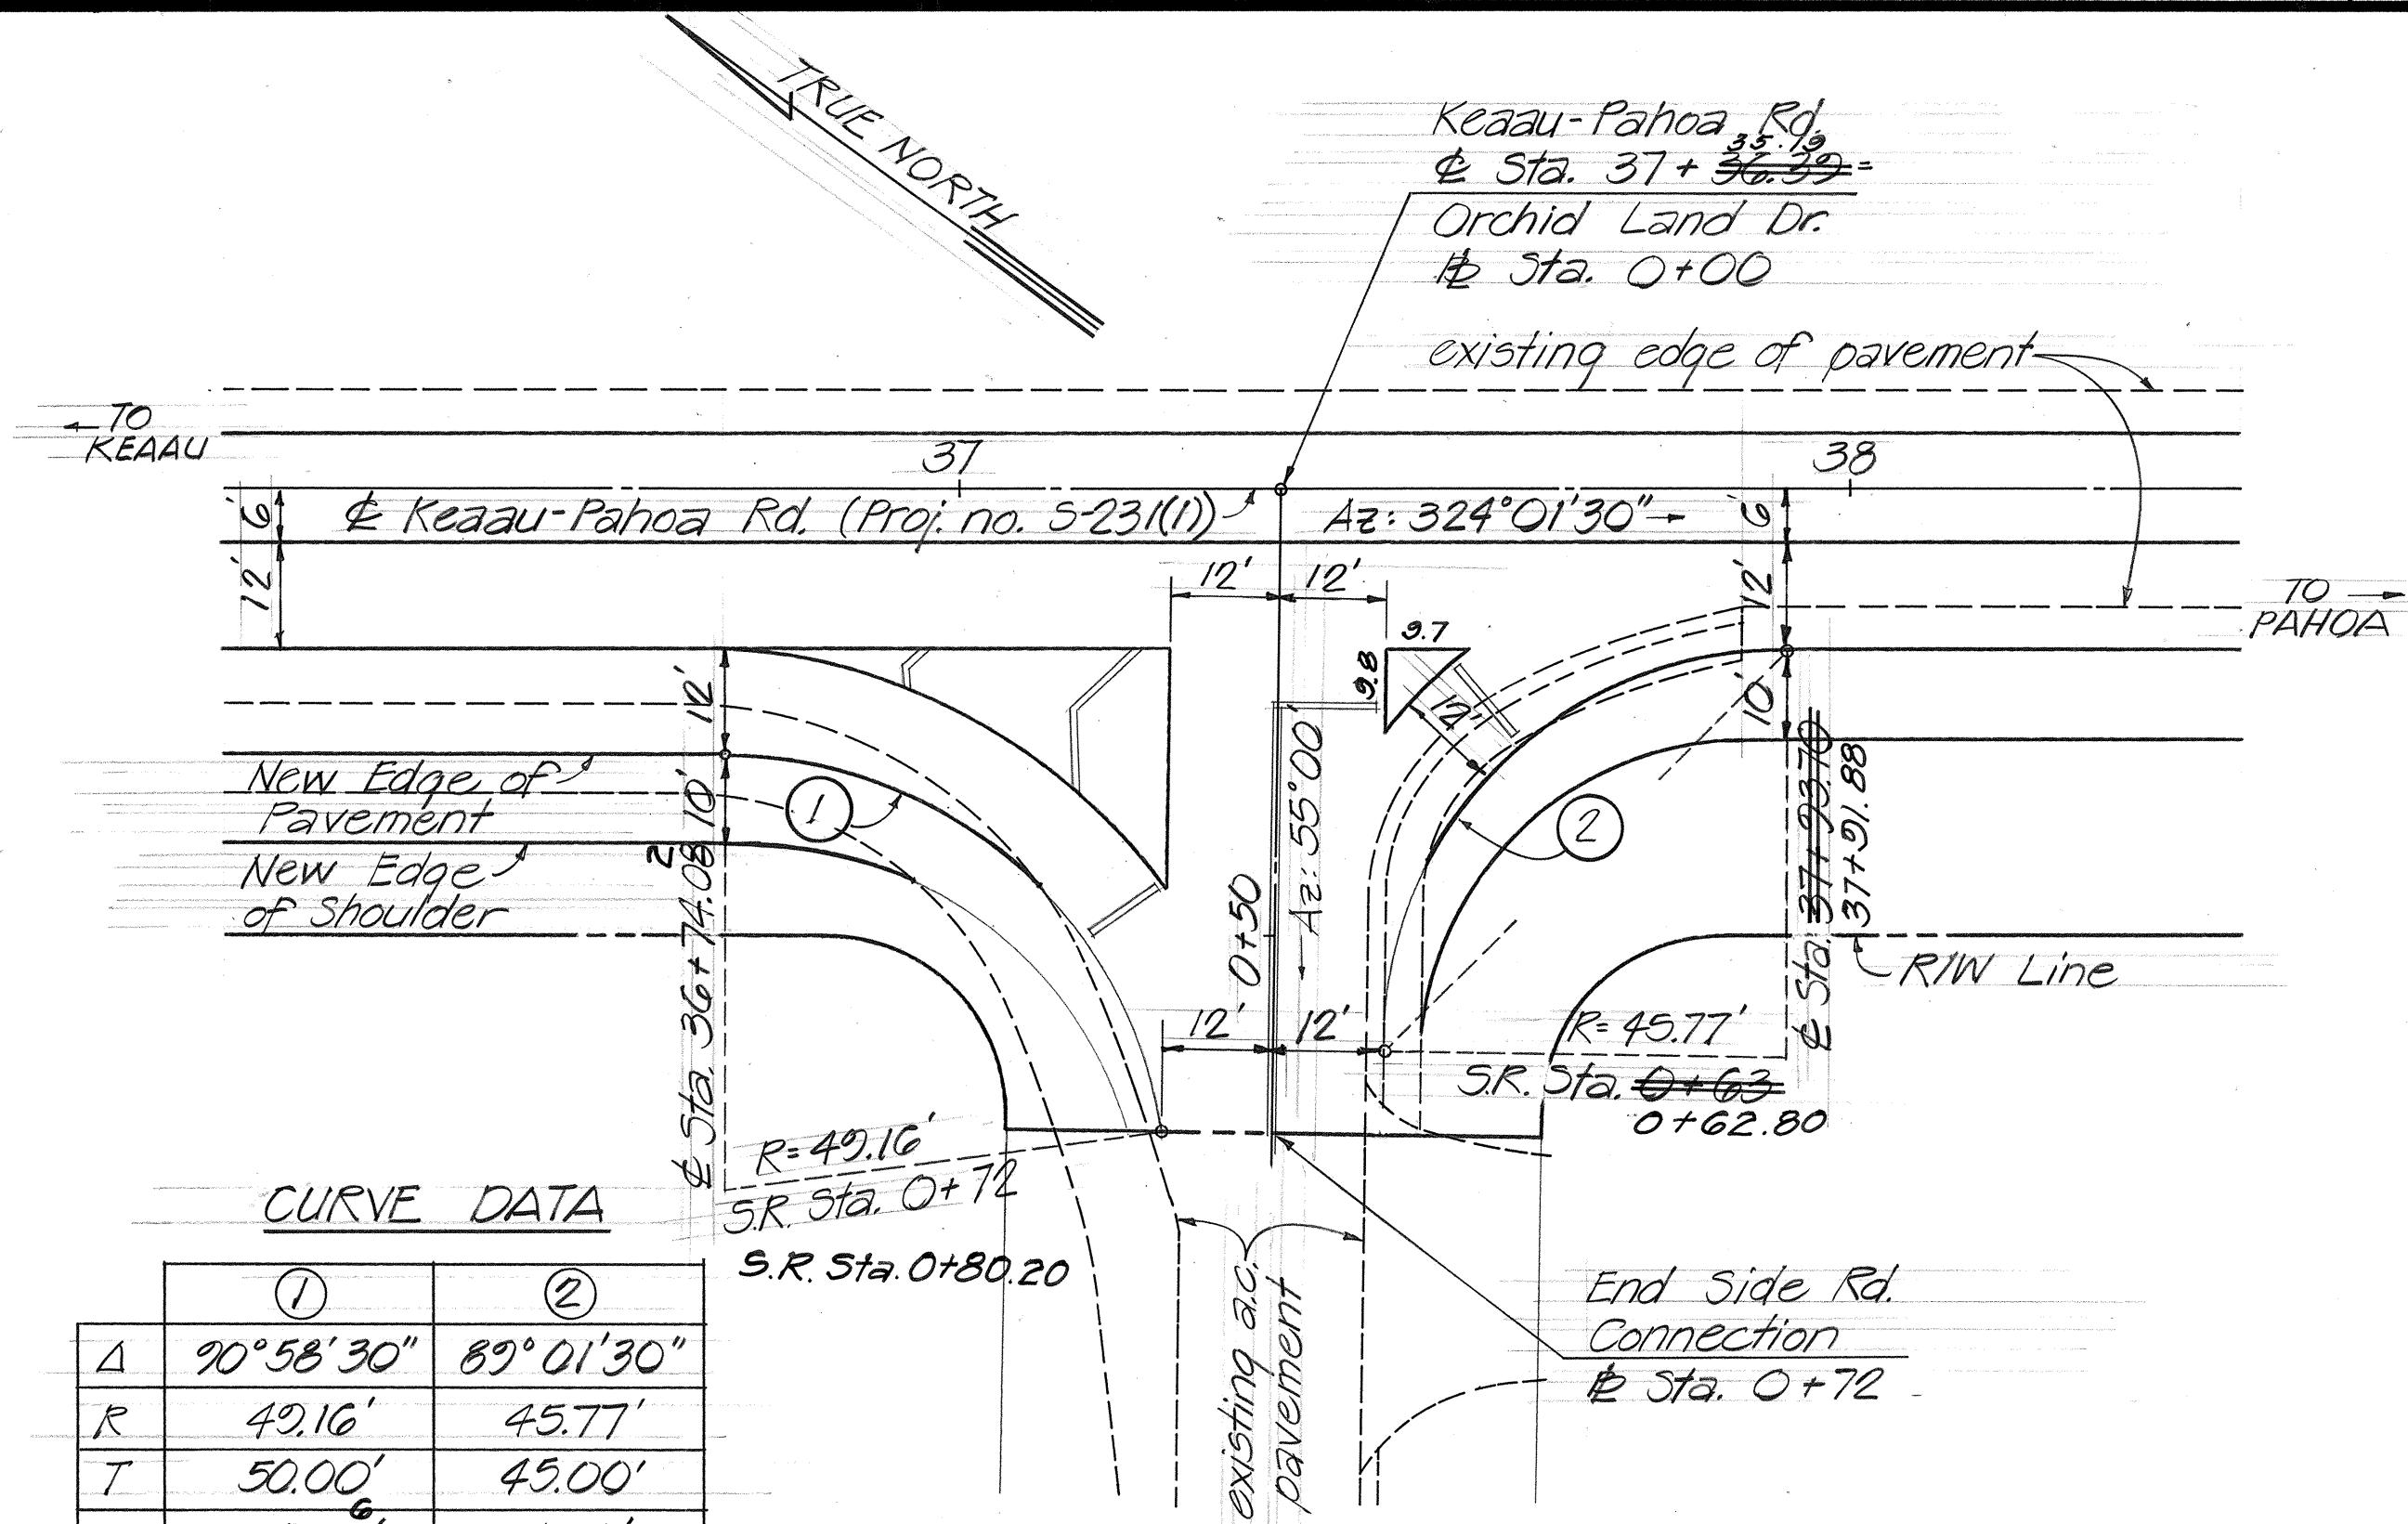

CURVE DATA


	①	②
Δ	90°58'30"	89°01'30"
R	49.16'	45.77'
T	50.00'	43.00'
L	78.05'	71.12'
C	70.11'	64.18'

SIDE ROAD PLAN

Scale: 1"=20'

ESTIMATED QUANTITIES


Excavation	28	C.Y.
Aggregate Base	116	C.Y.
A.C. Pavement, Mix III	67	C.Y.
A.C. Pavement, Mix V	107	Tons
Asphalt Concrete Base	85	Tons
	172	Tons

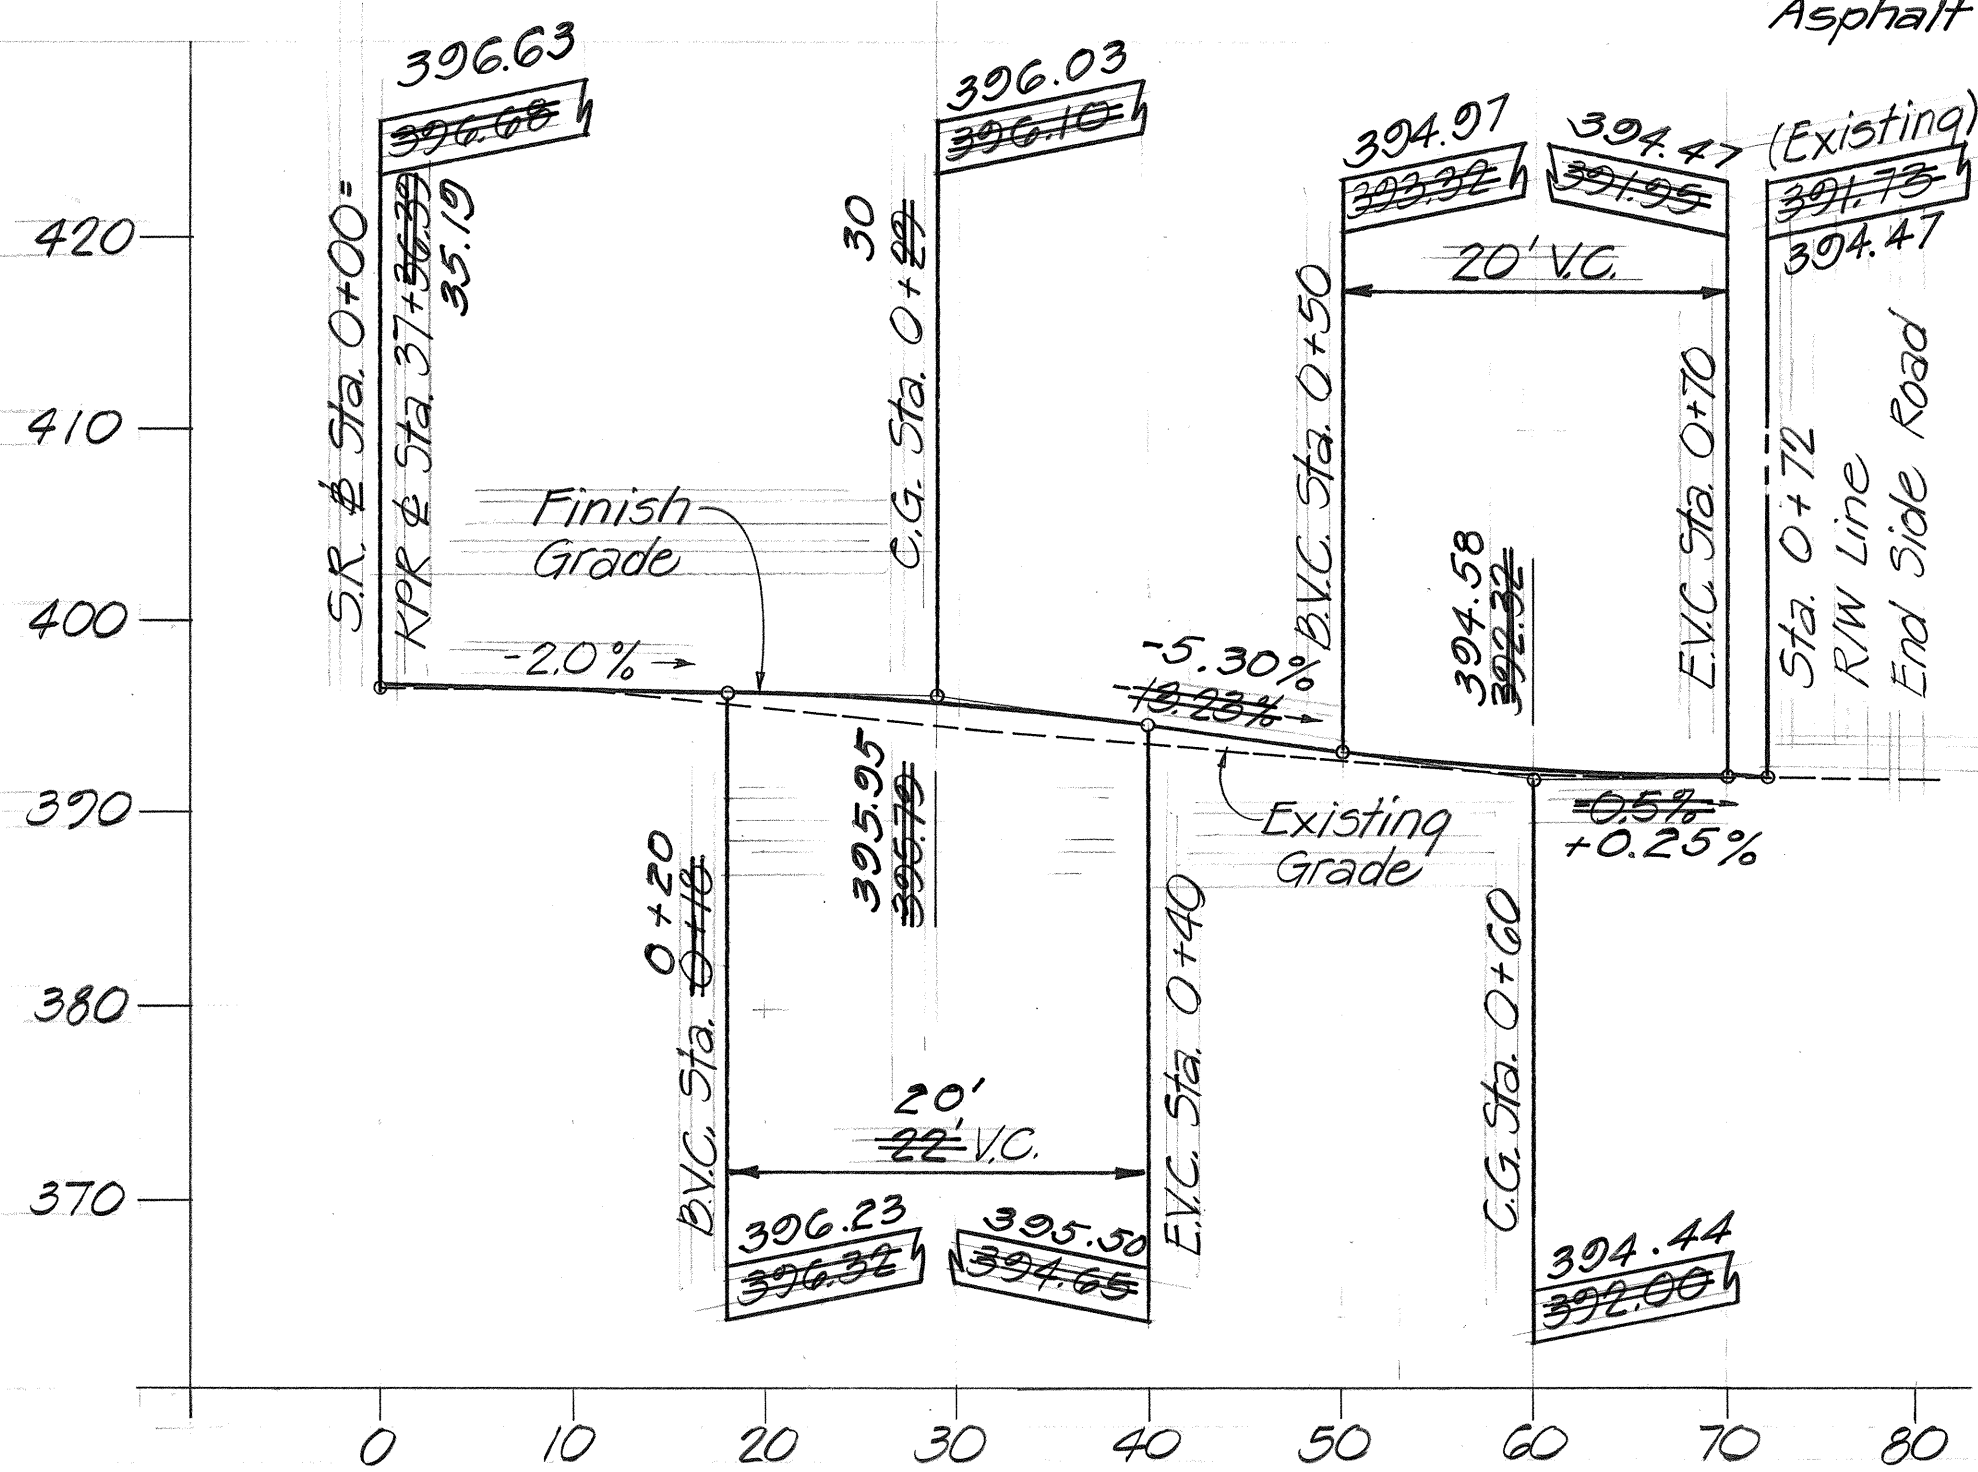

SIDE ROAD PROFILE

Scale: 1"=10'

ORCHID LAND DRIVE DETAILS

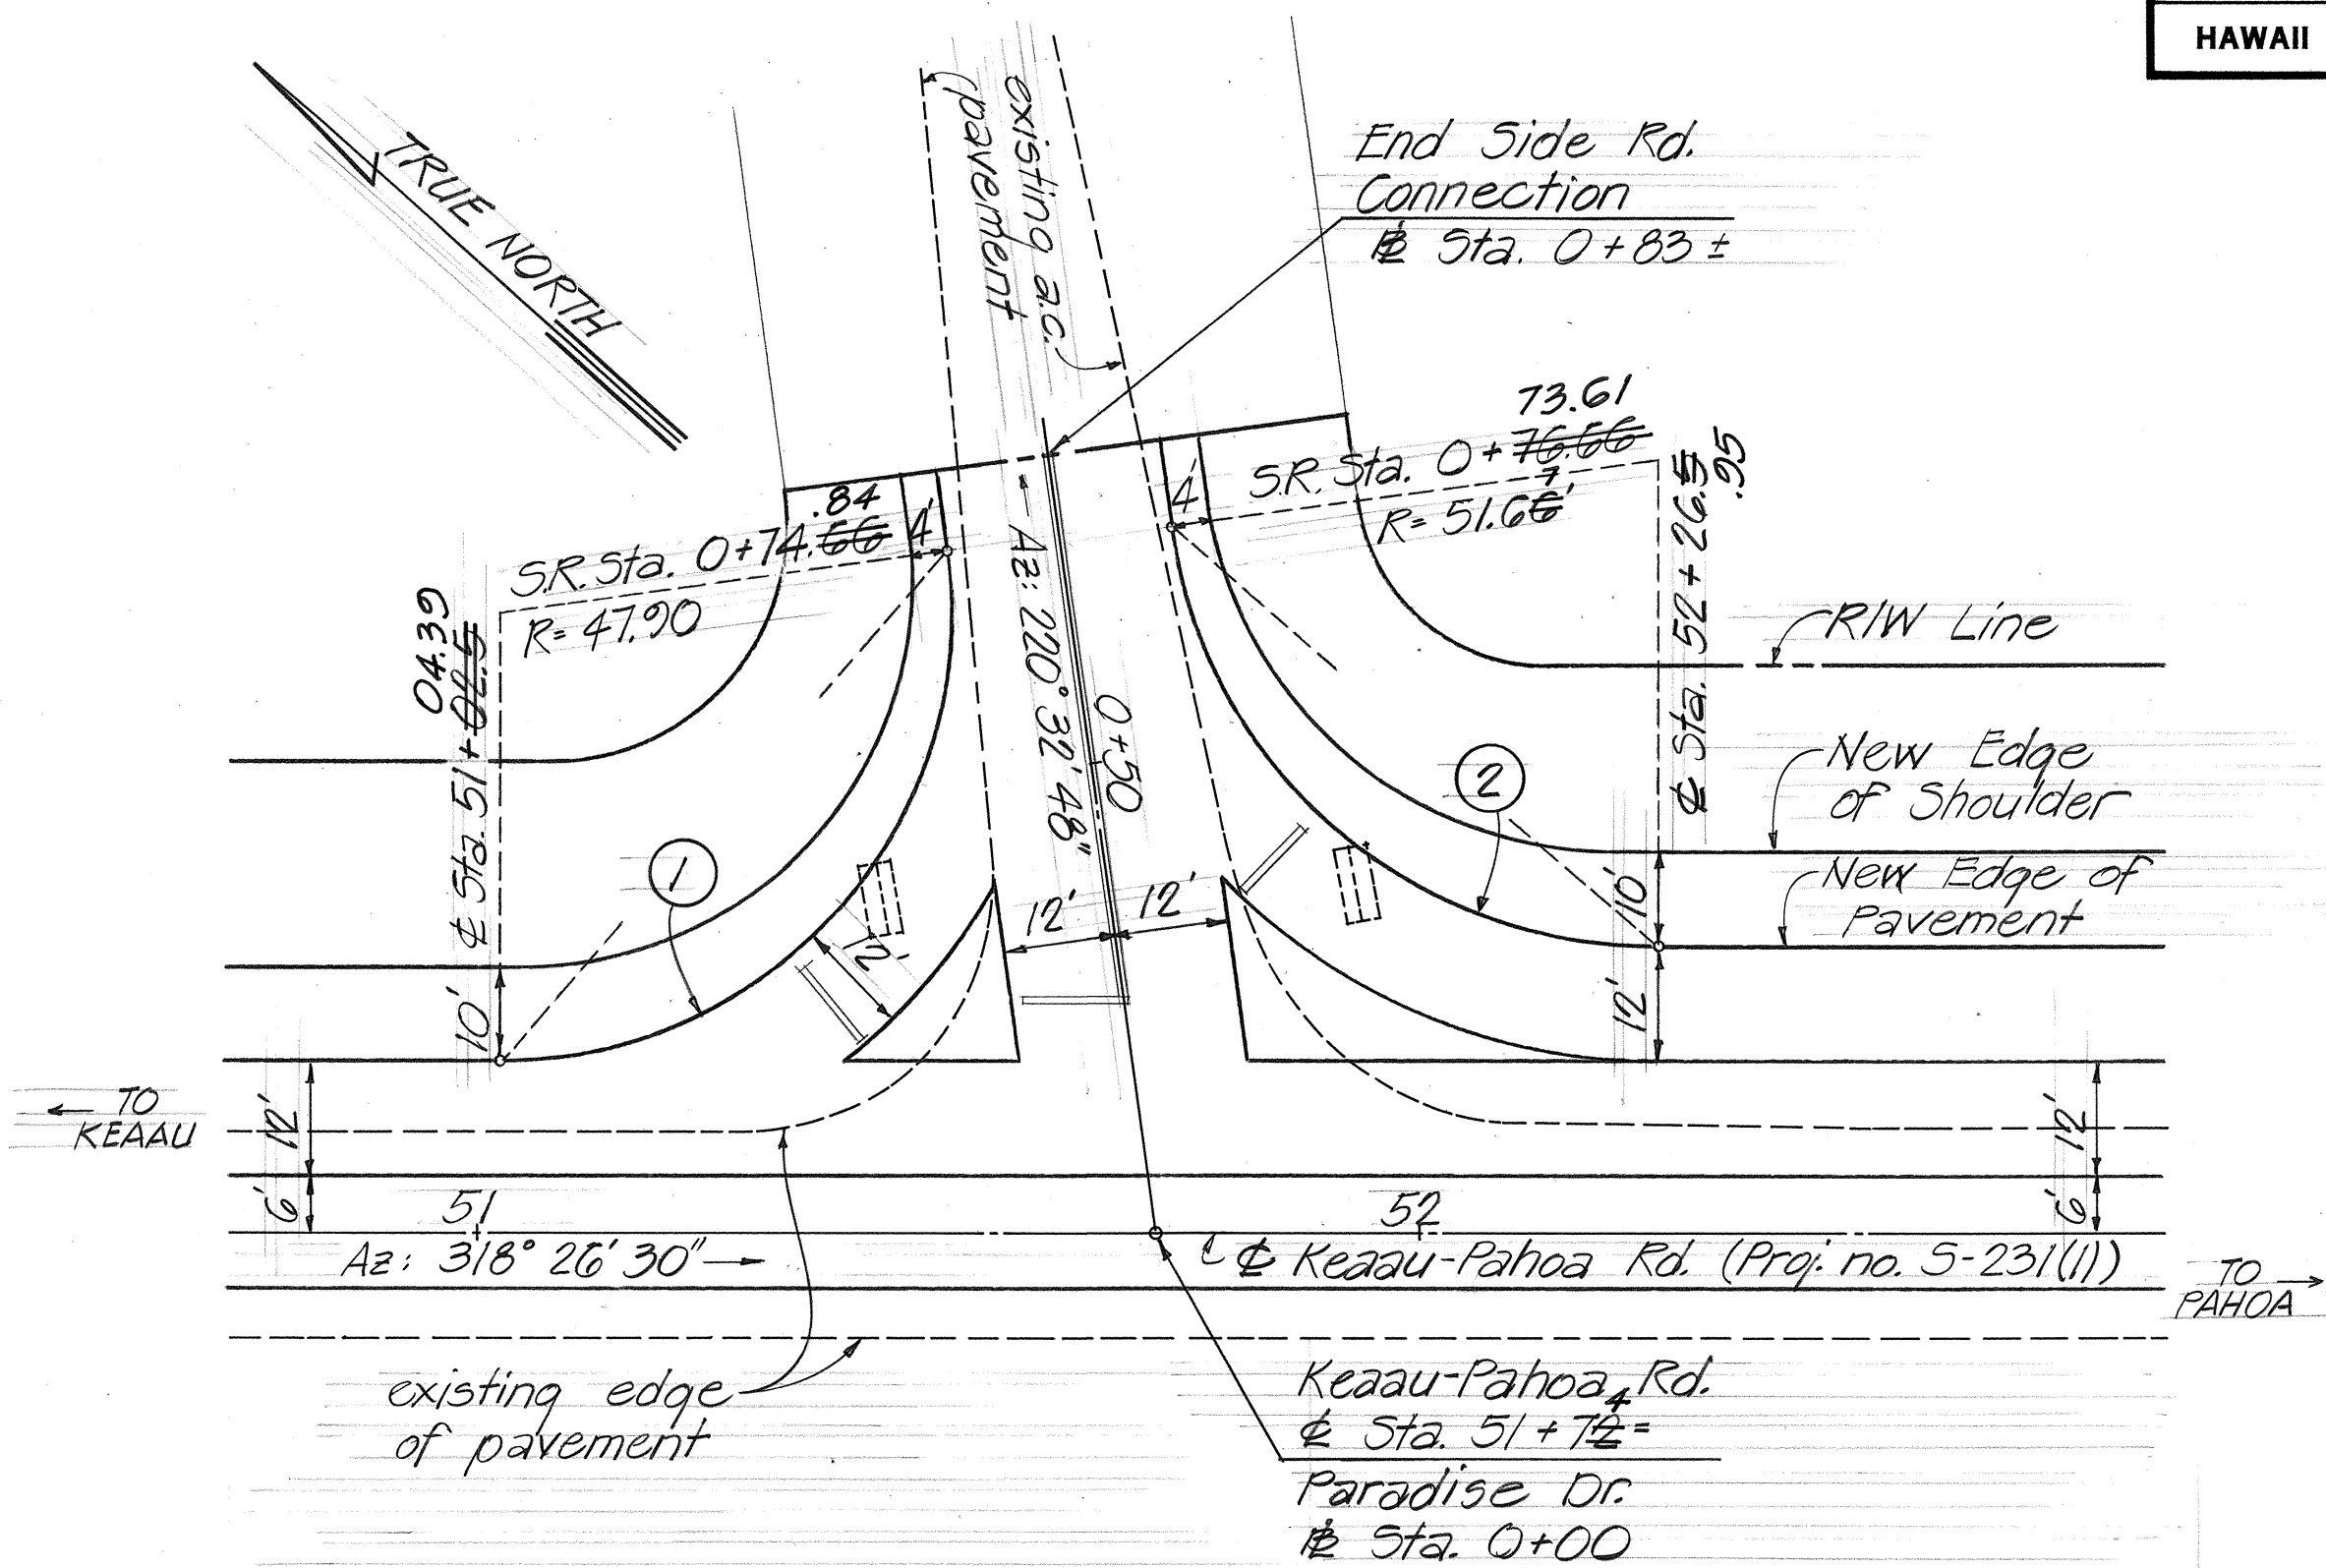

CURVE DATA


	①	②
Δ	97°53'42"	82°06'18"
R	47.90'	51.66'
T	55.00'	45.00'
L	81.84'	74.04'
C	72.24'	67.87'

SIDE ROAD PLAN

Scale: 1"=20'

ESTIMATED QUANTITIES

Excavation	11	C.Y.
Aggregate Base	140	C.Y.
A.C. Pavement, Mix III	80	C.Y.
A.C. Pavement, Mix V	127	Tons
Asphalt Concrete Base	107	Tons
	109	Tons

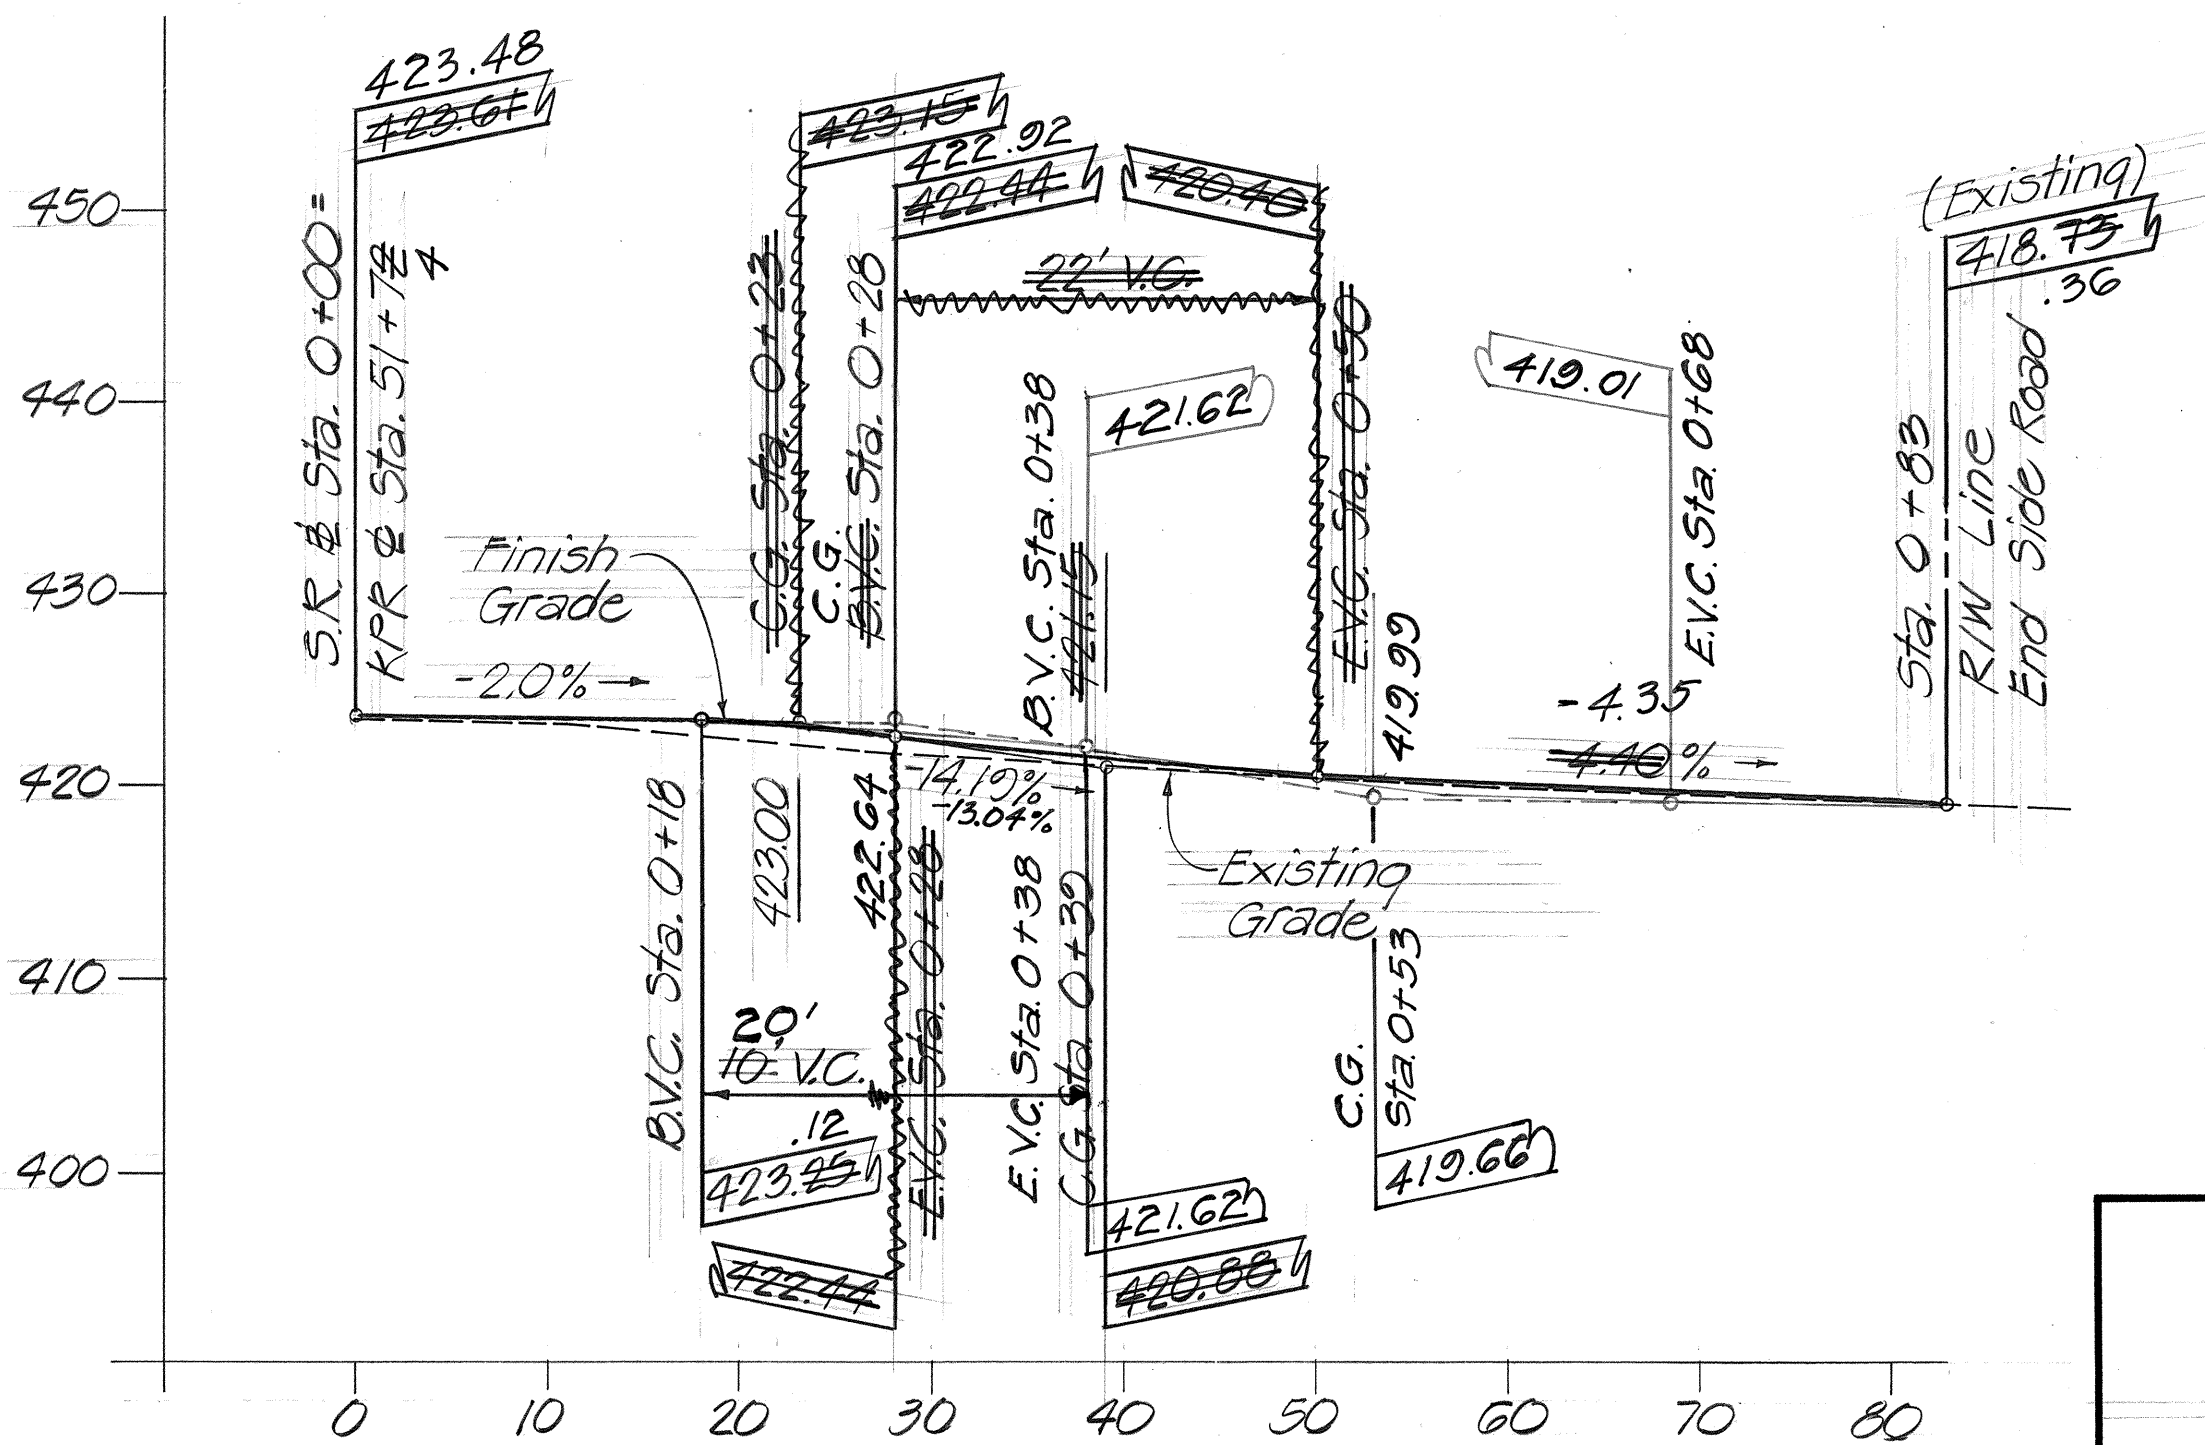

SIDE ROAD PROFILE

Scale: 1"=10'

PARADISE DRIVE DETAILS

STATE OF HAWAII
DEPARTMENT OF TRANSPORTATION
HIGHWAYS DIVISION

SIDE ROAD DETAILS

KEAAU-PAHOA ROAD
Paradise Park Section - Phase I
Fed. Aid Proj. no. RS-0130(16)

Scale: As Noted Date: April 1988

SHEET NO. 1 OF 1 SHEETS