

FED. ROAD DIST. NO.	STATE	FED. AID PROJ. NO.	FISCAL YEAR	SHEET NO.	TOTAL SHEETS
HAWAII	HAW.	RS-0130(16)	1988	13	25

TRAFFIC SIGN SUMMARY

STATION	REMOVE	RELOCATE	621.5100 REGULATORY & WARNING SIGNS (10 FT ² OR LESS) W/POST
0+40 0+75 R	R2-1	R2-1 (55 MPH)	
1+10 2+60 L&R		W2-2, W14-3 (2)	
2+60 5+05 L		W14-3, Kaloili Dr.	
5+17 5+10 L&R		R2-2, W14-3, R1-1	
6+00 9+70 R & L		R2-2, Pohaku Circle	
7+00 10+25 R		R4-2 (40 MPH) R1-1	
7+00 14+00 L	RM-3 (2-WAY)	W2-2	
9+25 15+60 L&R		R4-1, W14-3	
9+84 16+60 R		Mile Marker R1-2	
10+30 16+00 L&R		RM-3 (2) R1-1, Pohaku Circle (Street Name)	
10+50 19+50 L&R	RM-3 (2)	R4-2 Circle	
14+00 22+50 L&R		R4-2, Pohaku Circle	
15+20 29+00 L&R		W2-2, W14-3	
16+60 30+80 R		5 MILE Marker R3-6(R)	
17+10 31+00 L&R	W14-3, R4-1, RM-3		
18+10 37+10 L&R	R4-2, RM-3, RM-1		R1-2
18+04 37+50 L&R	R4-2, RM-3, RM-3	"Orchid Land Dr" Sign R1-1	
22+50 39+00 L&R	RM-3, RM-3 (2)		
29+00 42+60 L&R	R4-1, W14-3	W2-2, Orchid Land Dr.	
30+00 43+70 L		R4-2 R3-6(L)	
30+80 44+20 R		W2-2 R3-6(R)	
31+90 44+70 L&R	W14-3, R4-1	W2-2	
37+07 45+30 R & L		R1-2 R3-6(L)	
37+30 45+00 L&R	R4-1, W14-3		
37+80 50+50 L&R	RM-3, R1-1	RM-3 R1-1, Orchid Land Dr. (Street Name)	
39+00 51+10 L&R	R4-2, RM-3, RM-3		
42+65 51+35 L	R4-1	R1-1 w/ Paradise Dr. Sign	
42+75 51+50 L&R	W14-3	R1-1	
43+70 52+00 L		RM-1 (2) R1-2, R3-6(L)	
44+20 52+50 R	RM-3	W2-2, Paradise Dr.	
44+70 57+00 L		W2-2, Orchid Land Dr. IMPROVED HIGHWAY ENDS	
45+30 57+35 L&R	R4-1, W14-3	R3-6(L)	
45+00 58+10 L&R	RM-3, W14-3	RM-3	
51+30 58+20 L	R4-2	R3-6(R)	
51+35 59+30 L		W2-2 w/ Paradise Dr. Sign R1-1, Paradise Dr. (Street Name)	
51+50 L		R1-1	
51+03 R	R4-2		
52+00 L			R1-2
57+00 R			IMPROVED HIGHWAY ENDS
58+20 L			R3-6(R)
TOTALS	19	25	10
58+21 L&R	RM-3, RM-3		
59+30 L	W2-2	Paradise Dr. W2-2	
60+00 L&R		R4-1, W14-3	
TOTALS	23	22	11

PAVEMENT MARKER SCHEDULE


STATION		DESCRIPTION	TYPE				
FROM	TO		A	CL	DL	HL	J
0+75 1+10	0+90 1+10	No Passing - L Passing - R			14 3+15	13+60	
1+10 4+30	1+10 4+30	Passing - Both Sides			9+10	32+36	
4+30 9+90	4+30 9+90	Passing - L No Passing - R			13+14	14	56
9+90 10+30	9+90 10+30	Open		7	7+6		
10+30 15+40	10+30 15+40	No Passing - L Passing - R			13+14	14	56
15+40 29+00	15+40 29+00	Passing - Both Sides			36+37	140	143
29+00 31+35	29+00 31+35	No Passing - Both Sides			10+7		
31+35 37+05	31+35 37+05	No Passing - Both Sides	20 24	16 18		55+58	
37+05 37+55	37+05 37+55	Open			5+3		
37+55 42+50	37+55 42+50	No Passing - Both Sides	34 36	18 18	26		
42+50 46+50	42+50 46+50	No Passing - Both Sides	34 36	20 18	26	38+40	
46+50 51+50	46+50 51+50	No Passing - Both Sides	34 36	18 18	26		
51+50 52+00	51+50 52+00	Open			5+3		
52+00 57+70	52+00 57+70	No Passing - Both Sides	20 24	18 18		35+58	
57+70 60+00	57+70 60+00	No Passing - Both Sides			15+12		
60+00 71+20	60+00 71+20	No Passing - Both Sides			0+20		
TOTALS			88 112	110 96	168 200	170 199	297 356

PAVEMENT MARKING GENERAL NOTES (M.P. 4.6 to M.P. 6.0)

- The Contractor shall install all pavement markers.
- All Permanent Painted Striping shall be done by State Forces.
- Pavement areas where Striping is to be done by State Forces shall be broomed off by the Contractor. Brooming off shall be incidental to asphalt concrete pavement.

REFLECTOR MARKER SUMMARY

STATION	621.4000 Reflector Marker w/o Posts	621.4100 Reflector Marker w/ Posts
3+55 3+55 R		RM-3
4+05 4+05 R		RM-1
5+30 5+30 R		RM-3/1
6+40 6+40 R		RM-3
15+25 15+25 L		RM-1
18+05 18+05 L		RM-3
16+05 16+05 L	16+31 L	RM-1 RM-3
16+00 16+00 R		RM-1
21+35 21+35 L		RM-1
18+20 18+20 L		RM-3/1
27+35 27+35 L		RM-1
18+10 18+10 L		RM-3
33+35 33+35 L		RM-1
34+05 34+05 L		RM-3/1
35+30 35+30 L		RM-3
39+35 39+35 L		RM-1
40+05 40+05 L		RM-3
45+35 45+35 L		RM-3/1
46+05 46+05 L		RM-3
49+75 49+75 L	RM-1	RM-3
51+00 51+00 L&R		RM-3
52+30 52+30 R		RM-3/1
52+40 52+40 L		RM-1
55+00 55+00 L		RM-3
56+40 56+40 L		RM-1
57+30 57+30 L		RM-3/1
58+05 58+05 L		RM-3
58+20 58+20 L	RM-1	RM-1
58+25 58+25 L	RM-1	RM-1
TOTALS	3	26

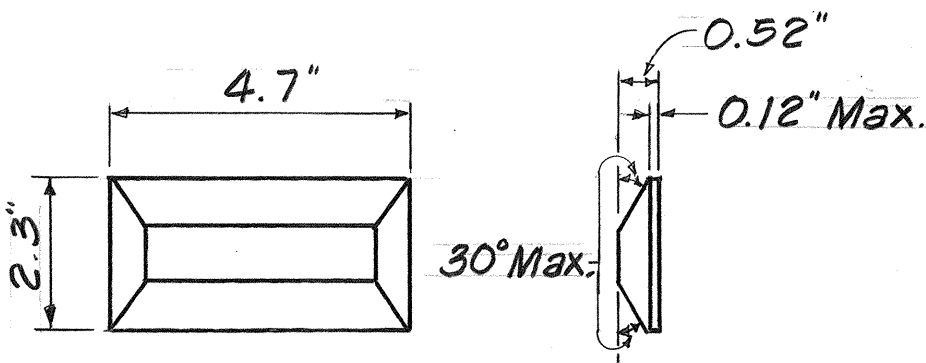

"L" SERIES PAVEMENT MARKER DETAIL

NOT TO SCALE

NOTE:
Details of Type "C", Type "D" and Type "H" Markers on Standard Plan TE-30 shall be deleted and replaced with Details of Type "CL", Type "DL" and Type "HL" Markers as shown on this Sheet.
All references to Type "C", Type "D" and Type "H" Markers in the Plans shall mean Type "CL", Type "DL" and Type "HL" Markers

TYPE "CL": Red-Clear Reflective Marker
TYPE "DL": Two-Way Yellow Reflective Marker
TYPE "HL": One-Way Yellow Reflective Marker

REFLECTOR MARKER SUMMARY		
STATION	621.4000 Reflector Marker w/o Posts	621.4100 Reflector Marker w/ Posts
53+20 R		RM-3
53+30 R		RM-1
53+44 L		RM-3
55+00 L		RM-1
56+40 L		RM-1
58+20 L	RM-1	
58+20 R		RM-3
58+30 R		RM-1
59+10 L		RM-1
58+56 L		3-RM-3
TOTALS	1	40