


FED. ROAD DIST. NO.	STATE	FED. AID PROJ. NO.	FISCAL YEAR	SHEET NO.	TOTAL SHEETS
HAWAII	HAW.	RS-0130(20)	1989	23	68


PC STA 10+00
KEAAU-PAHOA ROAD

TRUE NORTH
SCALE: 1"=20'

PC STA 15+00
KEAAU-PAHOA ROAD

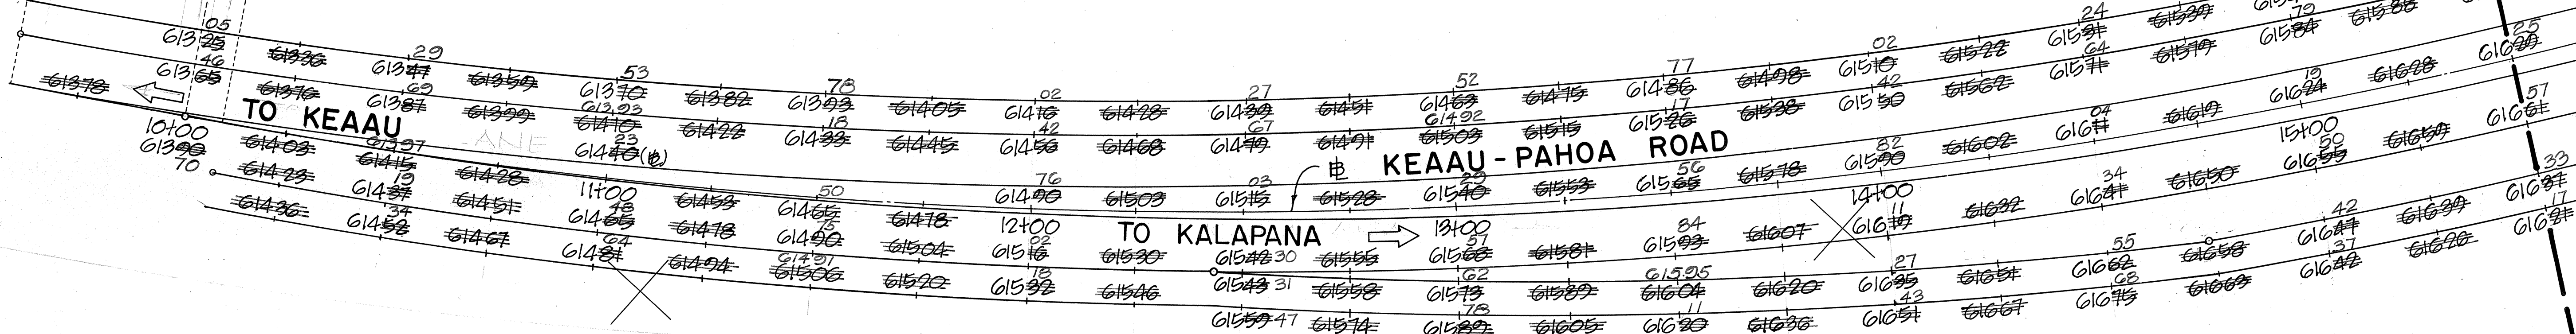

ORIGINAL PLAN	SURVEY PLOTTED BY	DATE
NOTE BOOK	DRAWN BY	
No.	DESIGNED BY	
	QUANTITIES BY	
	CHECKED BY	

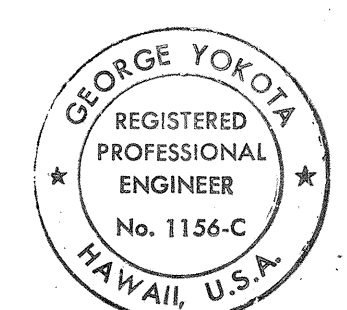

THIS WORK WAS PREPARED BY
ME OR UNDER MY SUPERVISION.
George Yokota
PARK ENGINEERING, INC.

STATE OF HAWAII
DEPARTMENT OF TRANSPORTATION
HIGHWAYS DIVISION

**FINISH PAVEMENT GRADES FOR
INTERSECTION AT $\pm 17+27.88$**

KEAAU-PAHOA ROAD
ROAD "A"


PROJECT NO. RS-0130 (20)
DISTRICT OF PUNA, ISLAND OF HAWAII

SHEET NO. 1 OF 5 SHEETS


PAVEMENT PLAN

FED. ROAD DIST. NO.	STATE	FED. AID PROJ. NO.	FISCAL YEAR	SHEET NO.	TOTAL SHEETS
HAWAII	HAW.	RS-0130(20)	1989	24	68

TRUE NORTH
SCALE: 1"=20'

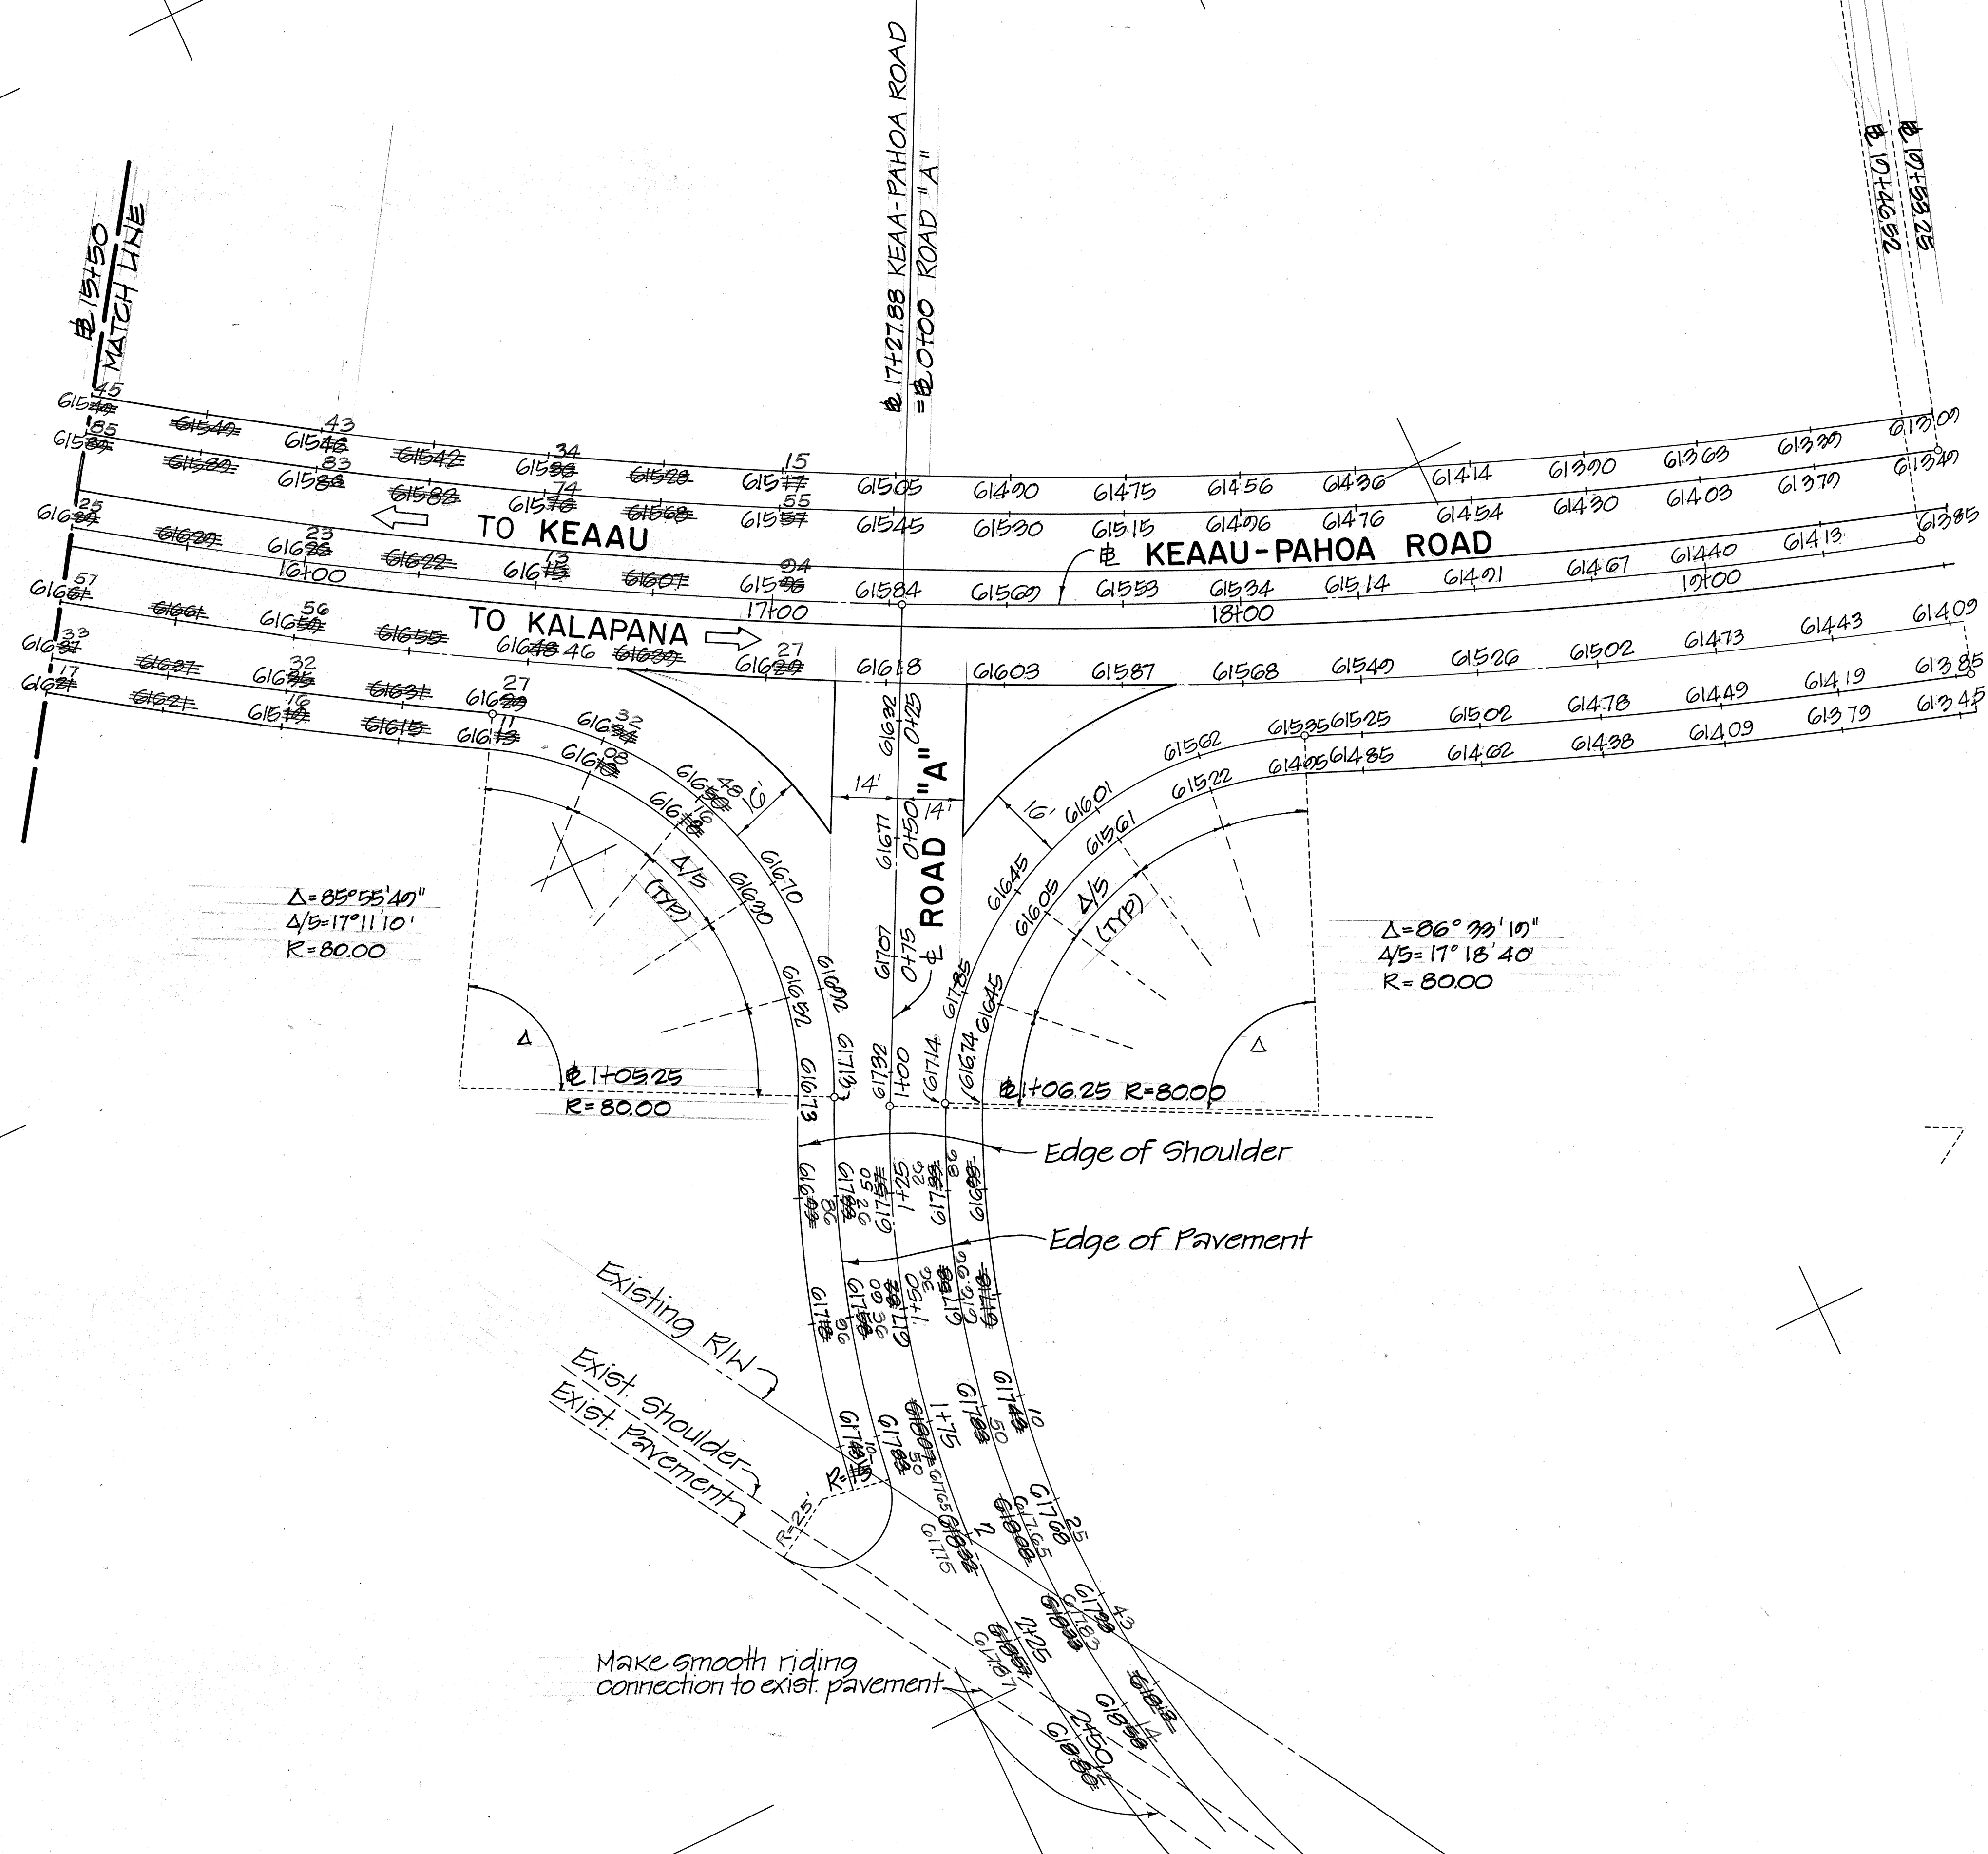

DATE	_____
SURVEY PLOTTED BY	_____
DRAWN BY	_____
DESIGNED BY	_____
CHECKED BY	_____
NOTE BOOK	_____
No.	_____

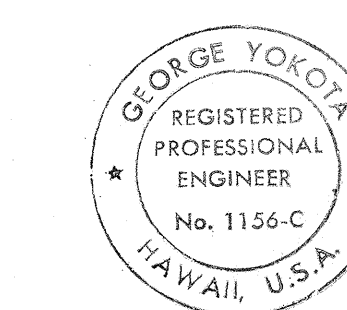

THIS WORK WAS PREPARED BY
ME OR UNDER MY SUPERVISION.
Dennis Yokota
PARK ENGINEERING, INC.

STATE OF HAWAII
DEPARTMENT OF TRANSPORTATION
HIGHWAYS DIVISION


**FINISH PAVEMENT GRADES FOR
INTERSECTION AT 17+27.88**

KEAAU-PAHOA ROAD
ROAD "A"
PROJECT NO. RS-0130(20)
DISTRICT OF PUNA, ISLAND OF HAWAII


SHEET NO. 2 OF 5 SHEETS

PAVEMENT GRADES

FED. ROAD DIST. NO.	STATE	FED. AID PROJ. NO.	FISCAL YEAR	SHEET NO.	TOTAL SHEETS
HAWAII	HAW.	RS-0130(20)	1989	25	68

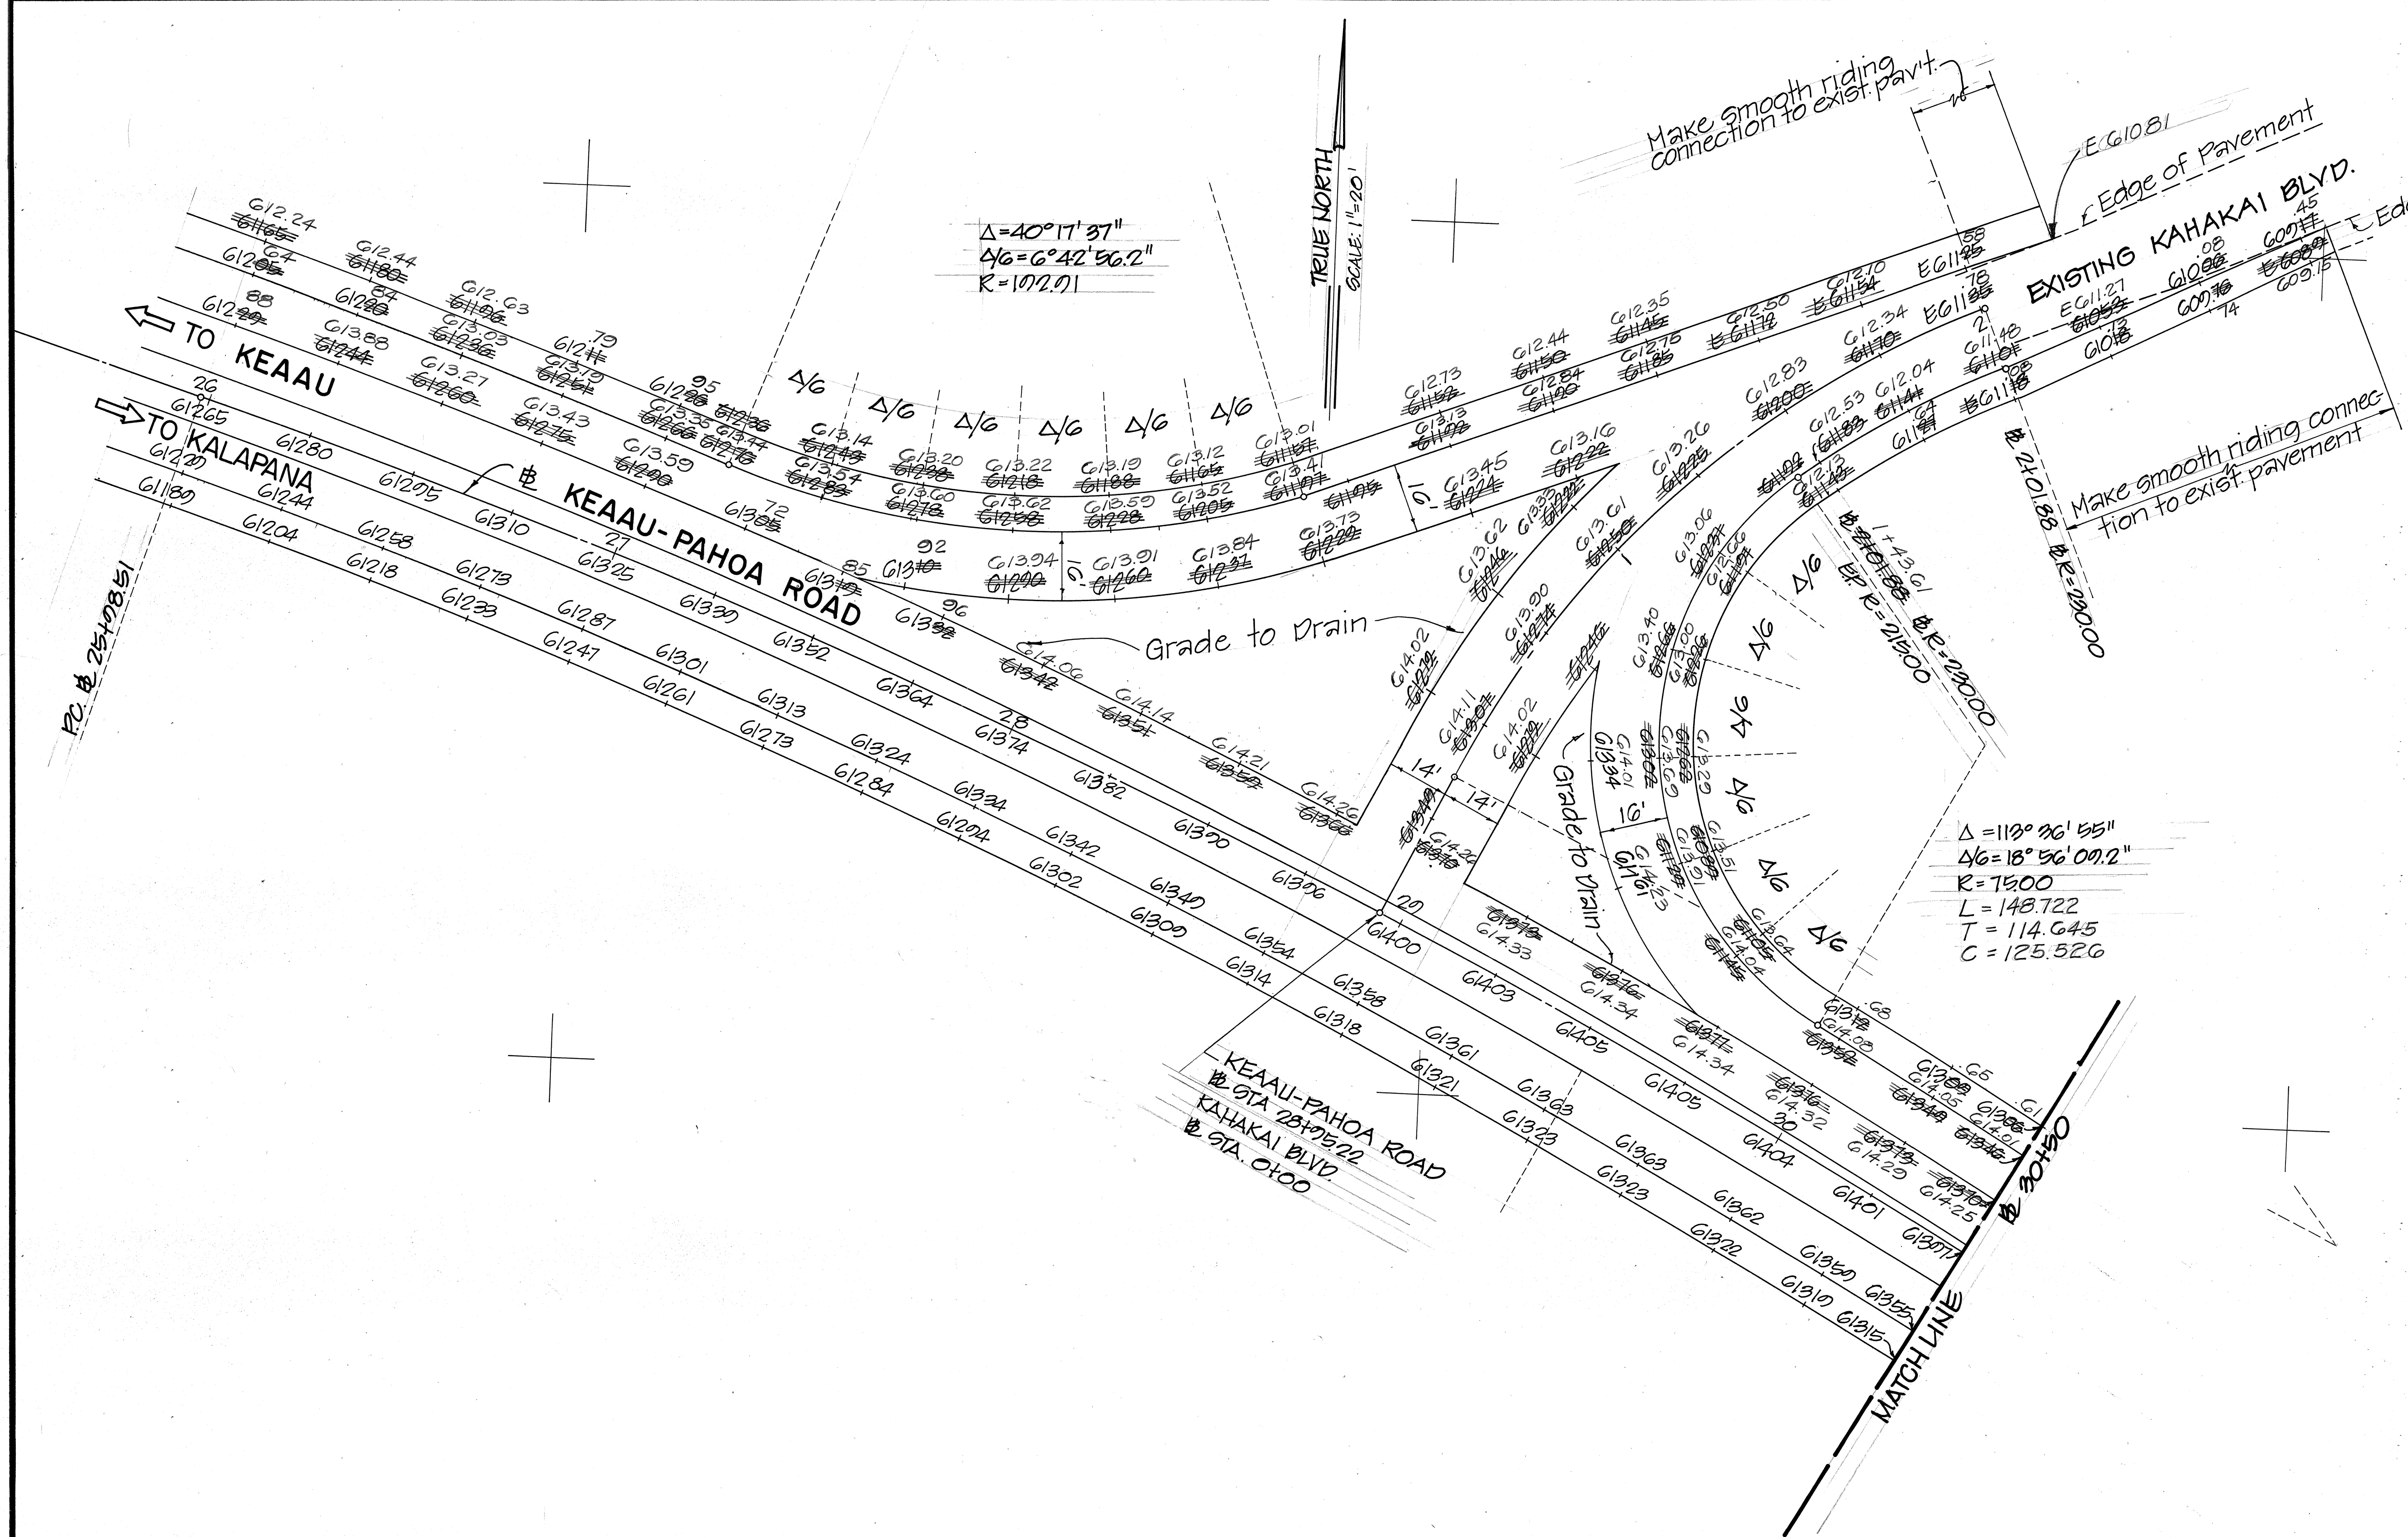


SURVEY PLOTTED BY	DATE
DRAWN BY	
DESIGNED BY	
CHECKED BY	
ORIGINAL PLAN	
NOTE BOOK	
NO.	

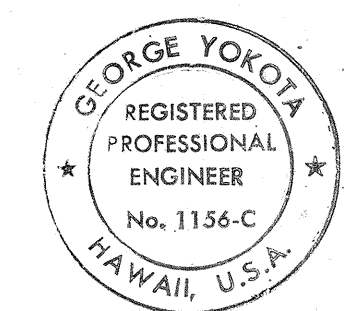

THIS WORK WAS PREPARED BY
ME OR UNDER MY SUPERVISION.
George Yokota
PARK ENGINEERING, INC.

STATE OF HAWAII
DEPARTMENT OF TRANSPORTATION
HIGHWAYS DIVISION
**FINISH PAVEMENT GRADES FOR
INTERSECTION AT # 28+05.22**
KEAAU-PAHOA ROAD
KAHAKAI BOULEVARD
PROJECT NO. RS-0130(20)
DISTRICT OF PUNA, ISLAND OF HAWAII
SHEET NO. 3 OF 5 SHEETS

FED. ROAD DIST. NO.	STATE	FED. AID PROJ. NO.	FISCAL YEAR	SHEET NO.	TOTAL SHEETS
HAWAII	HAW.	R6-0190 (20)	1989	26	68

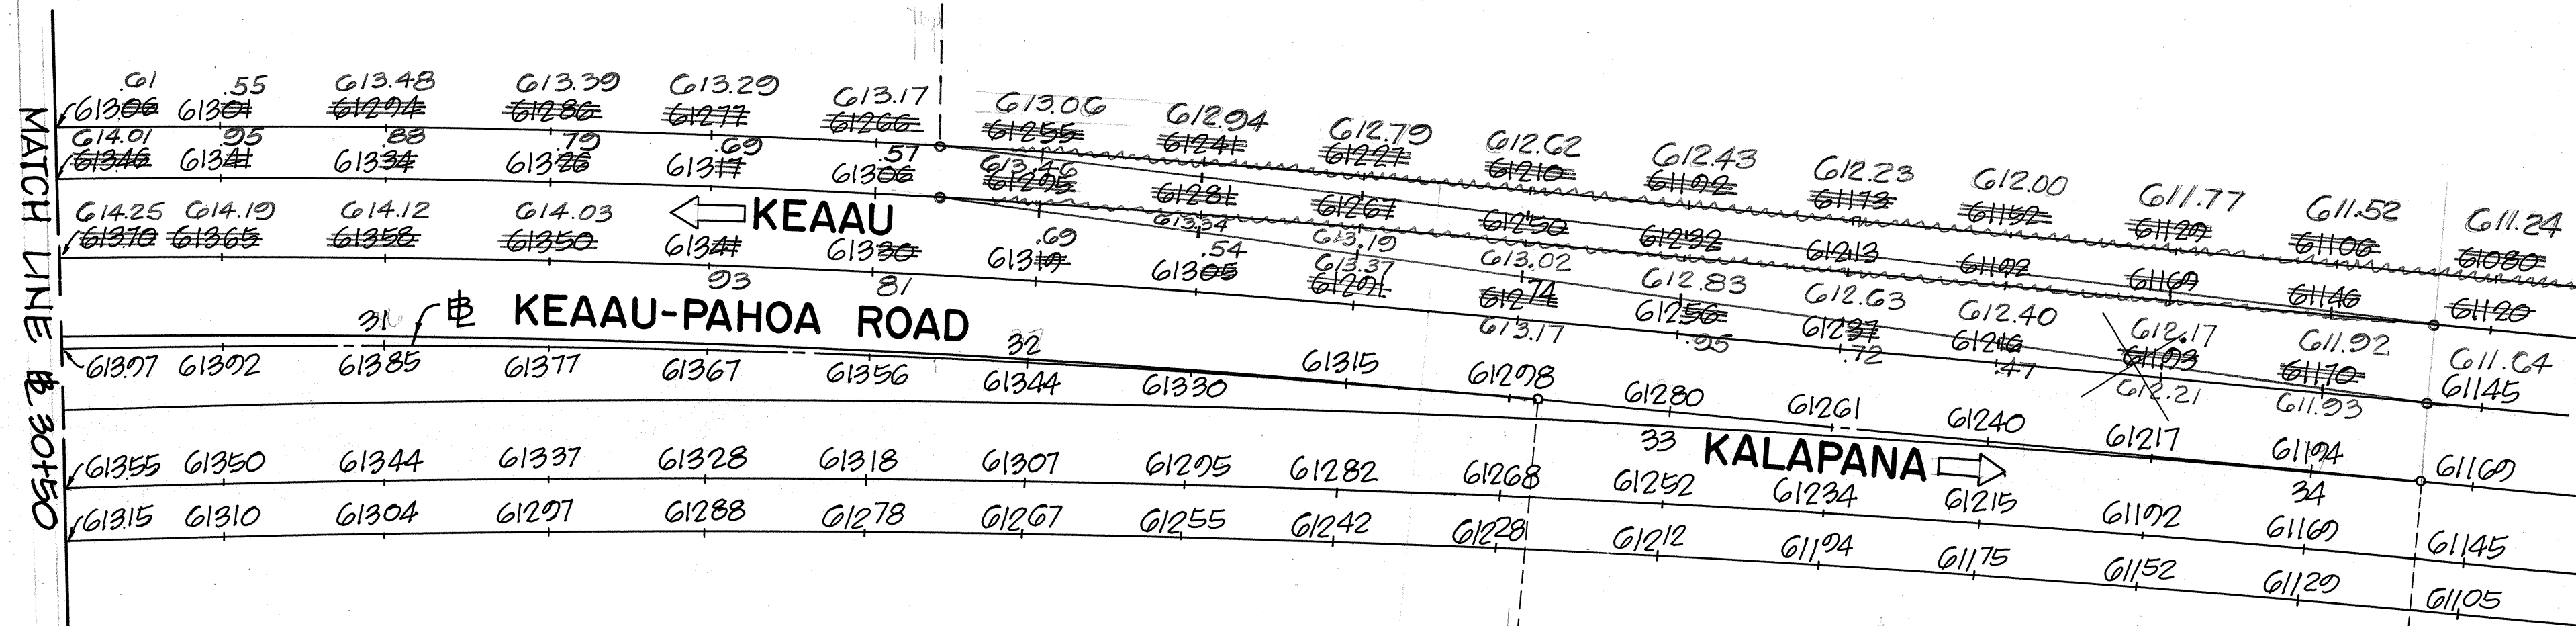

SURVEY PLOTTED BY	DATE
DRAWN BY	
TRACED BY	
DESIGNED BY	
QUANTITIES BY	
CHECKED BY	


STATE OF HAWAII
 DEPARTMENT OF TRANSPORTATION
 HIGHWAYS DIVISION
FINISH PAVEMENT GRADES FOR INTERSECTION AT 28+05.22
 KEAAU-PAHOA ROAD
 KAHAKAI BOULEVARD
 PROJECT NO. R6-0190 (20)
 DISTRICT OF PUNA, ISLAND OF HAWAII

THIS WORK WAS PREPARED BY ME OR UNDER MY SUPERVISION.


George Yokota
 PARK ENGINEERING, INC.

SHEET NO. 4 OF 5 SHEETS

FED. ROAD DIST. NO.	STATE	FED. AID PROJ. NO.	FISCAL YEAR	SHEET NO.	TOTAL SHEETS
HAWAII	HAW.	RS-0130(20)	1989	27	68

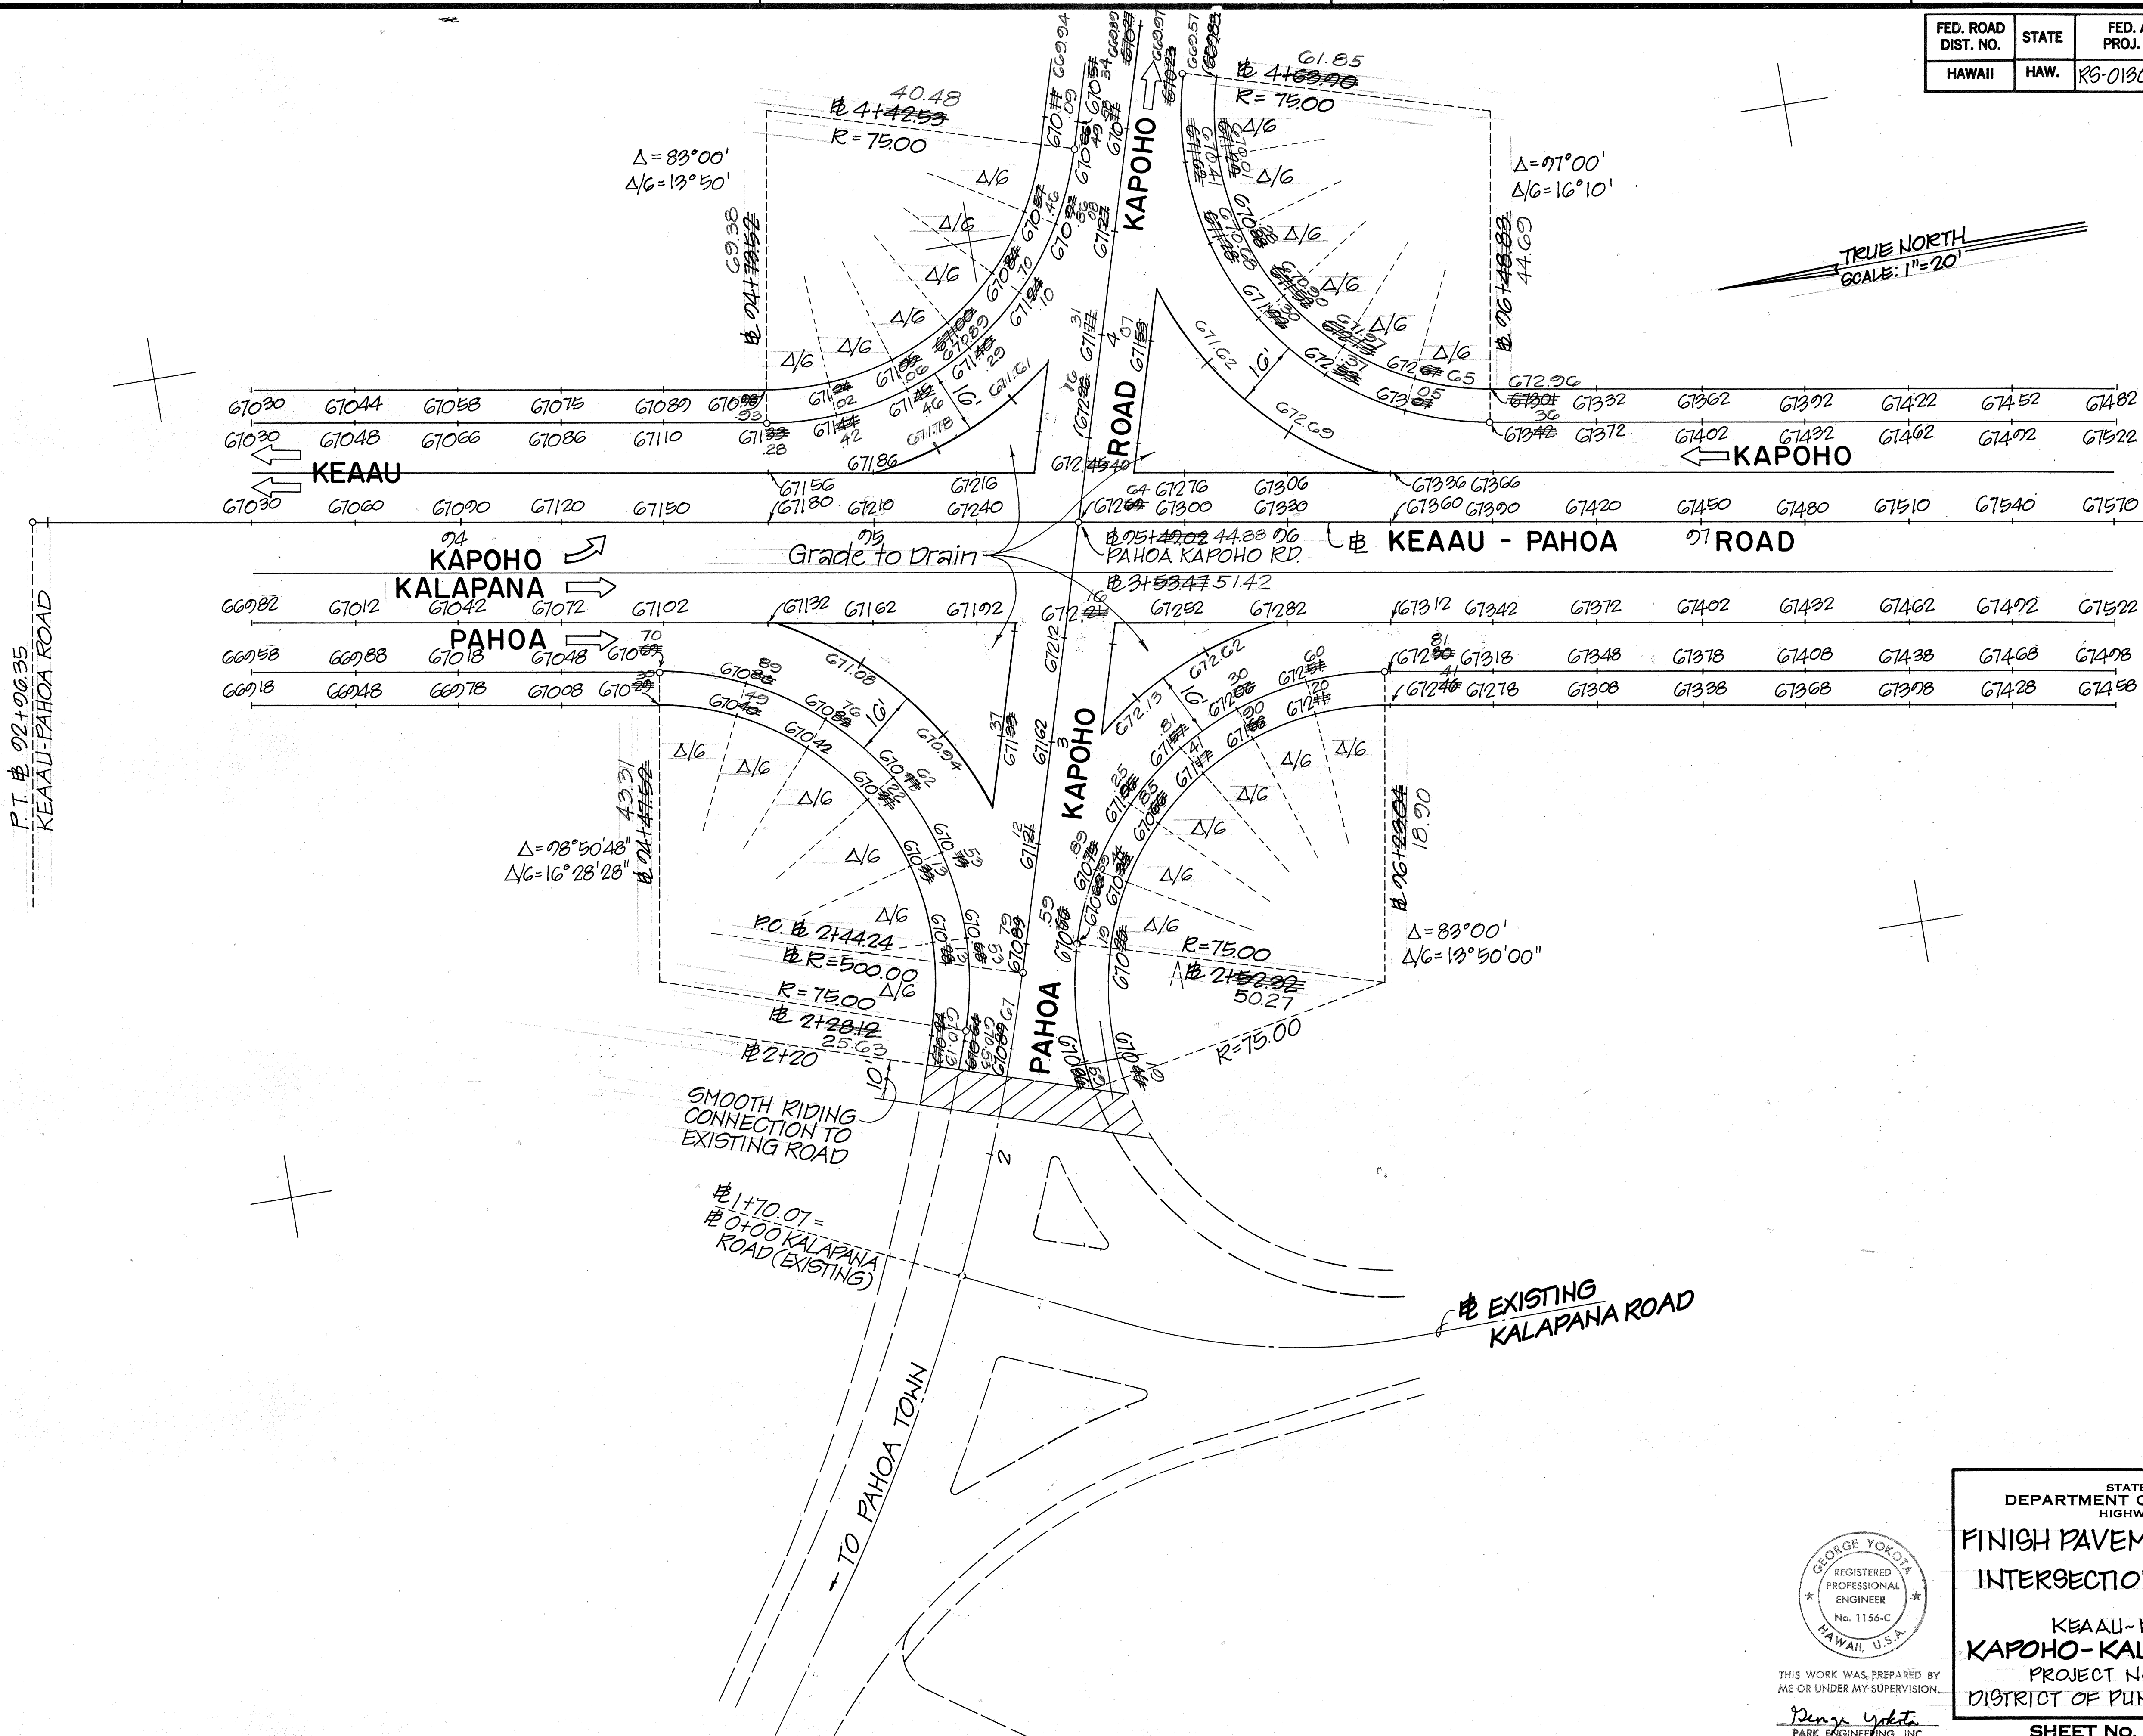

ORIGINAL PLAN	SURVEY PLOTTED BY	DATE
NOTE BOOK	DRAWN BY	
No.	DESIGNED BY	
	QUANTITIES BY	
	CHECKED BY	

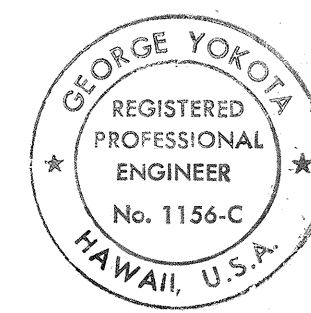

THIS WORK WAS PREPARED BY ME OR UNDER MY SUPERVISION.
George Yokota
PARK ENGINEERING, INC.

STATE OF HAWAII
DEPARTMENT OF TRANSPORTATION
HIGHWAYS DIVISION

FINISH PAVEMENT GRADES FOR
INTERSECTION AT ~~67540.02~~
44.88

KEAAU-PAHOA ROAD
KAPAHO-KALAPANA JUNCTION
PROJECT NO. RS-0130(20)
DISTRICT OF PUNA, ISLAND OF HAWAII

SHEET No. 5 OF 5 SHEETS