



FED. ROAD DIST. NO.	STATE	FED. AID PROJ. NO.	FISCAL YEAR	SHEET NO.	TOTAL SHEETS
HAWAII	HAW.	RS-0130(20)	1989	33	68

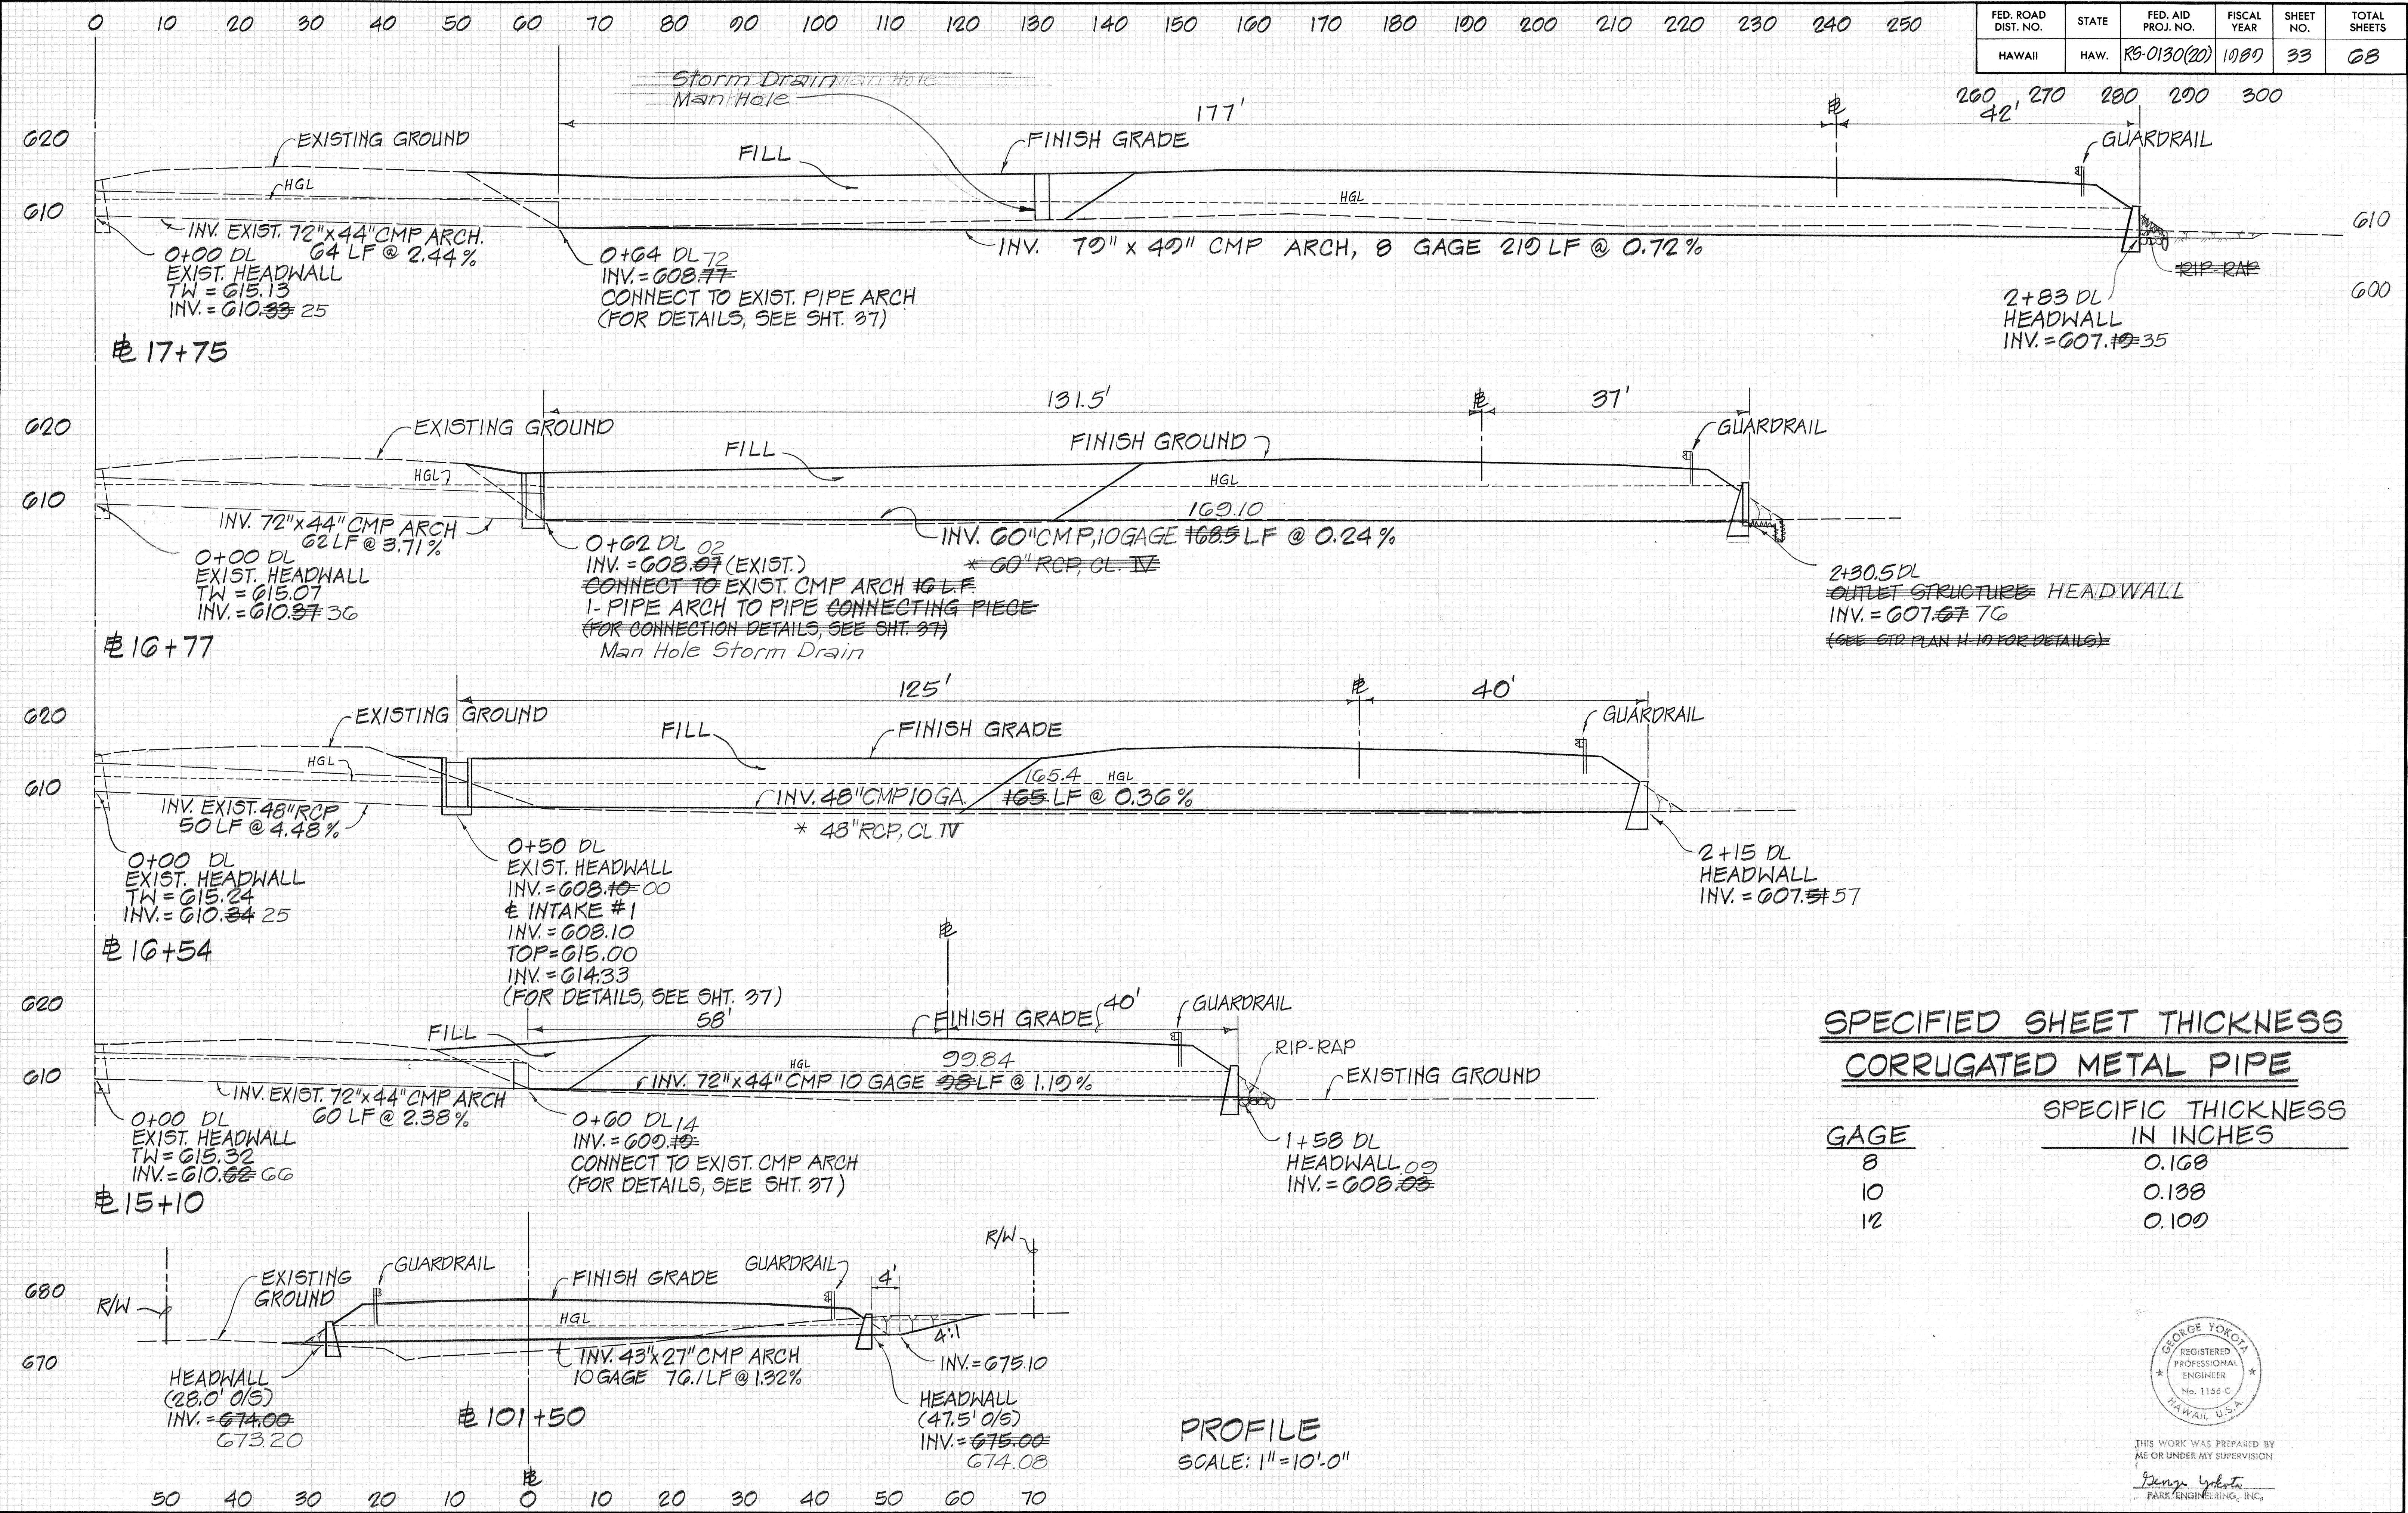

**SPECIFIED SHEET THICKNESS
CORRUGATED METAL PIPE**



GAGE	SPECIFIC THICKNESS IN INCHES
8	0.108
10	0.138
12	0.100

PROFILE
SCALE: 1" = 10'-0"

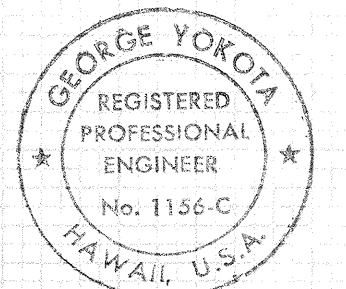

THIS WORK WAS PREPARED BY
ME OR UNDER MY SUPERVISION
George Yokota
PARK ENGINEERING, INC.



FED. ROAD DIST. NO.	STATE	FED. AID PROJ. NO.	FISCAL YEAR	SHEET NO.	TOTAL SHEETS
HAWAII	HAW.	RS-0180(20)	1080	34	68

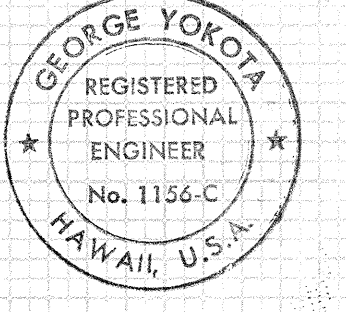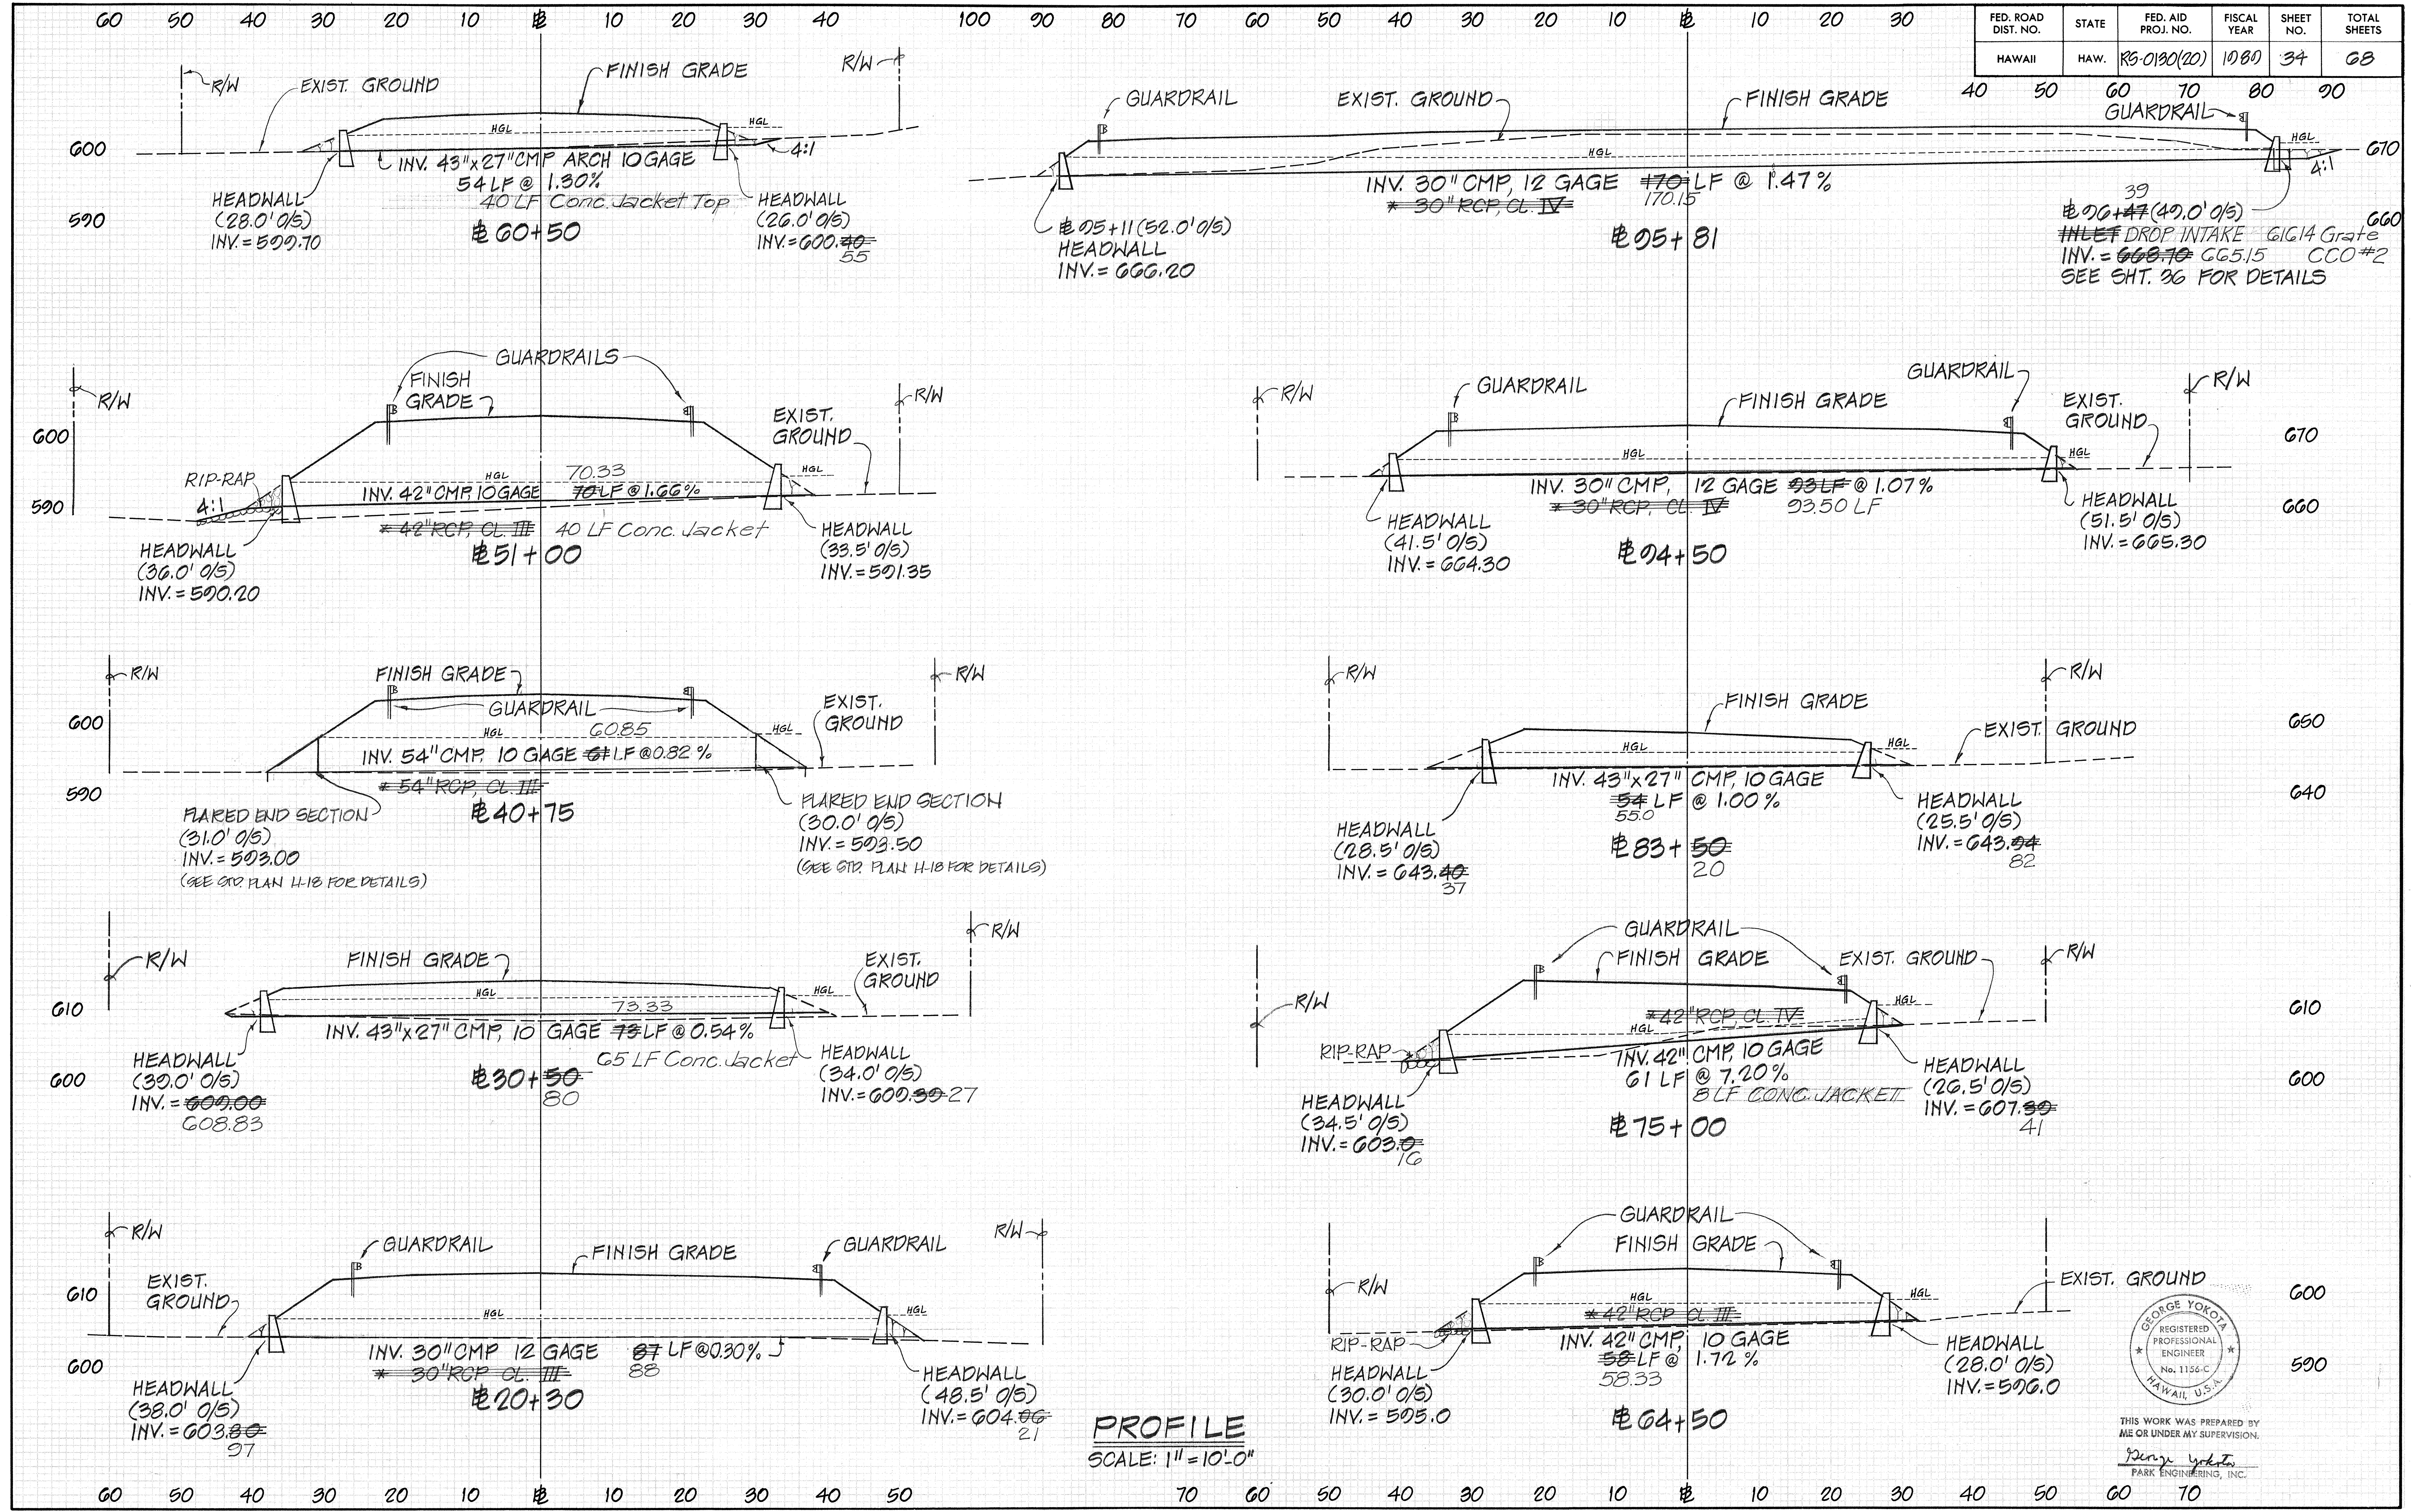

THIS WORK WAS PREPARED BY ME OR UNDER MY SUPERVISION.
 George Yokota
 PARK ENGINEERING, INC.




FED. ROAD DIST. NO.	STATE	FED. AID PROJ. NO.	FISCAL YEAR	SHEET NO.	TOTAL SHEETS
HAWAII	HAW.	RG-0130(20)	1980	35	68

NOTE: FOR PROFILES OF DRIVEWAYS SEE SHEET NO. 62

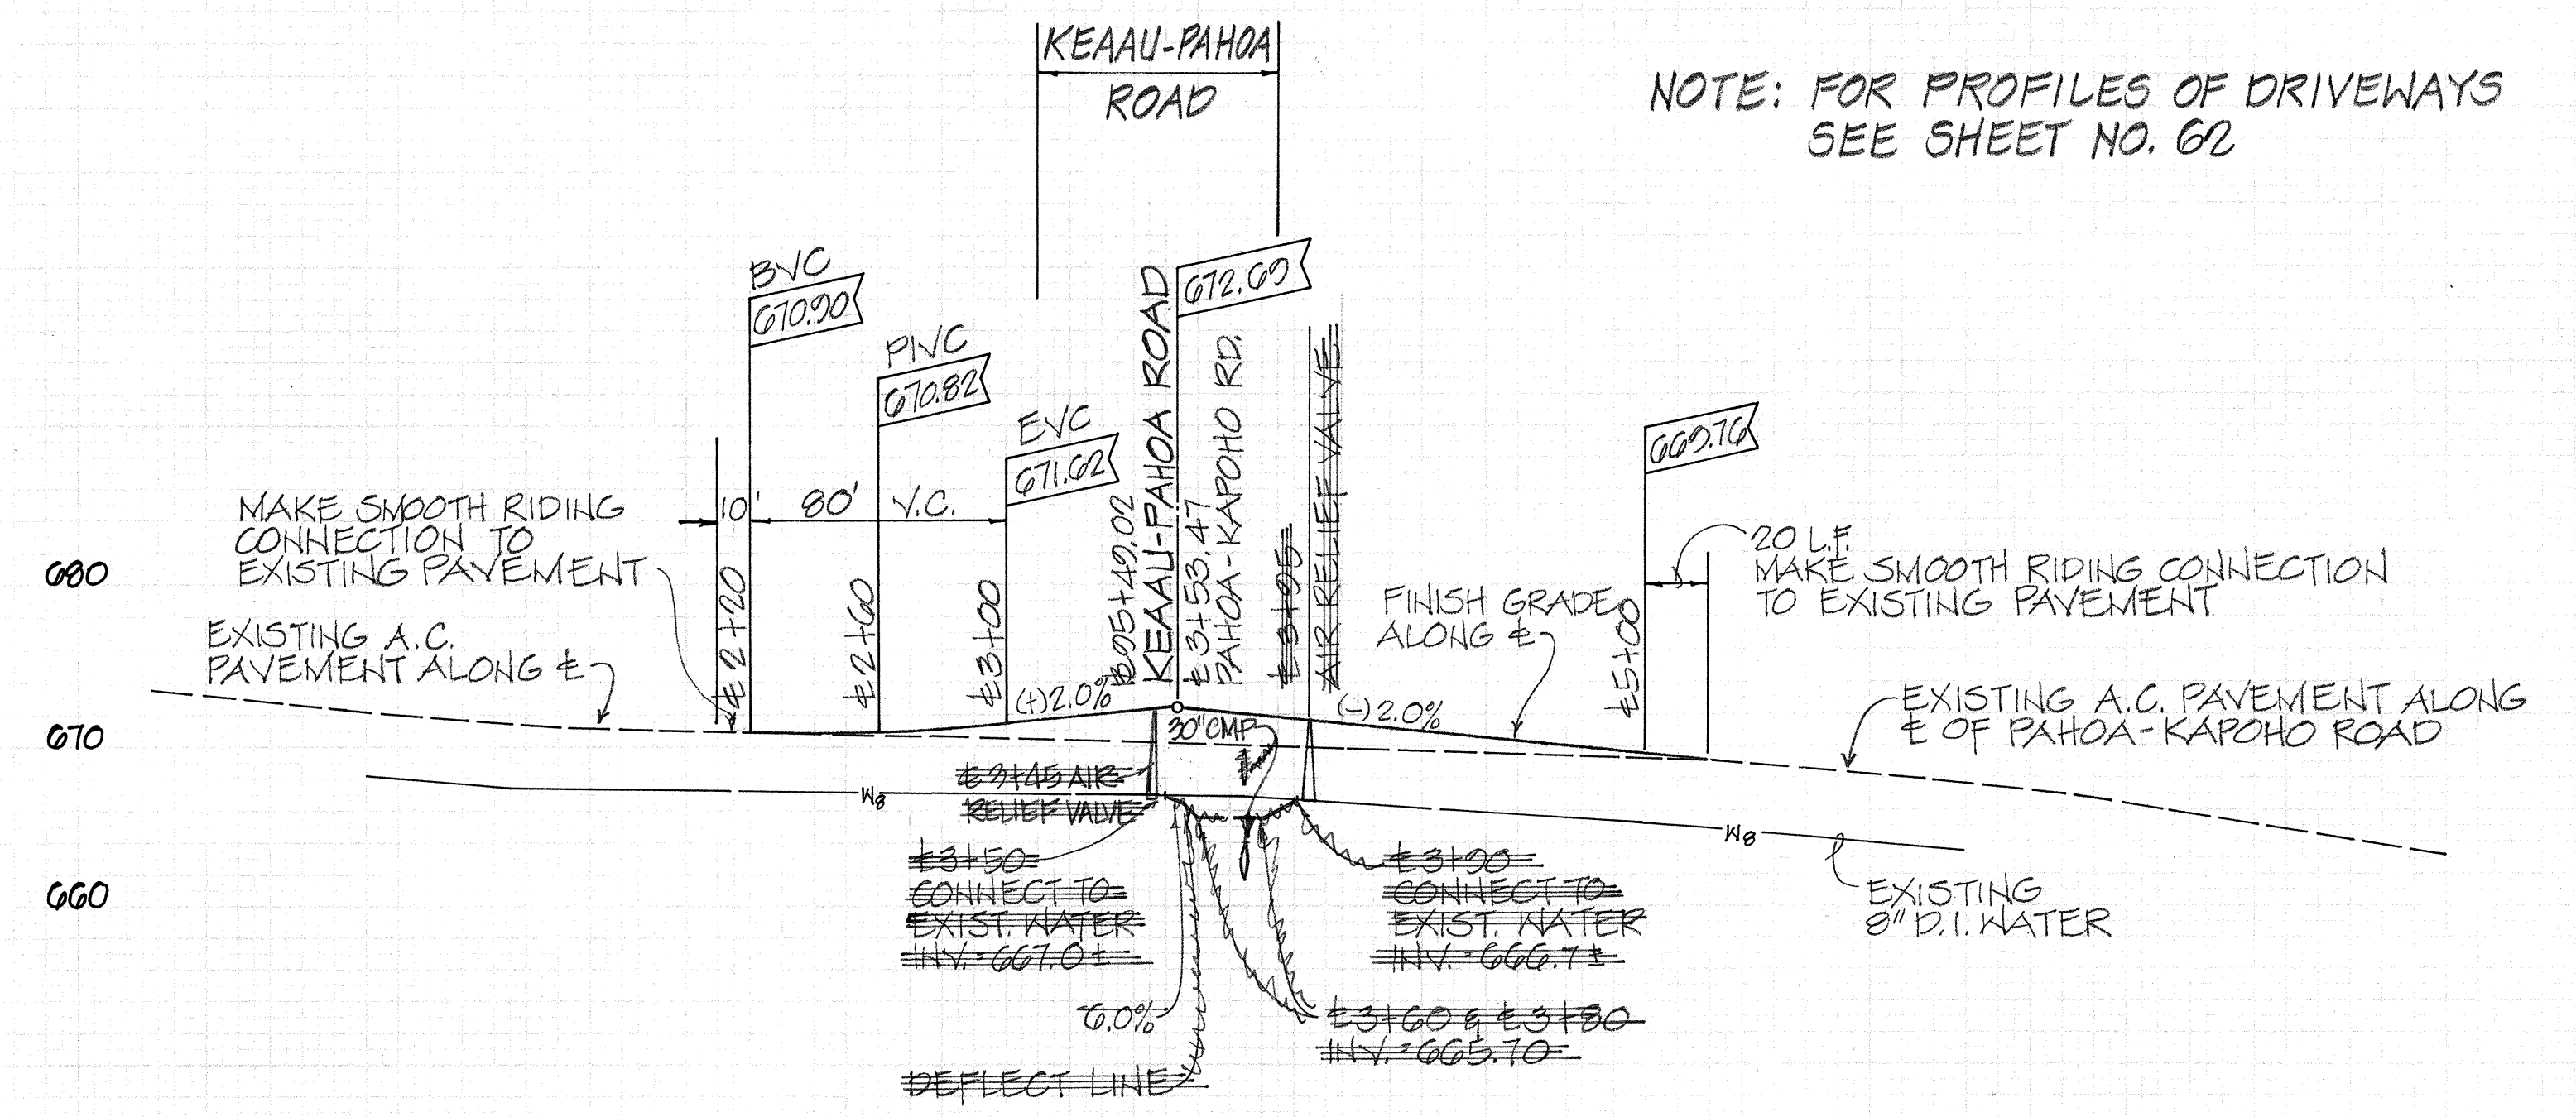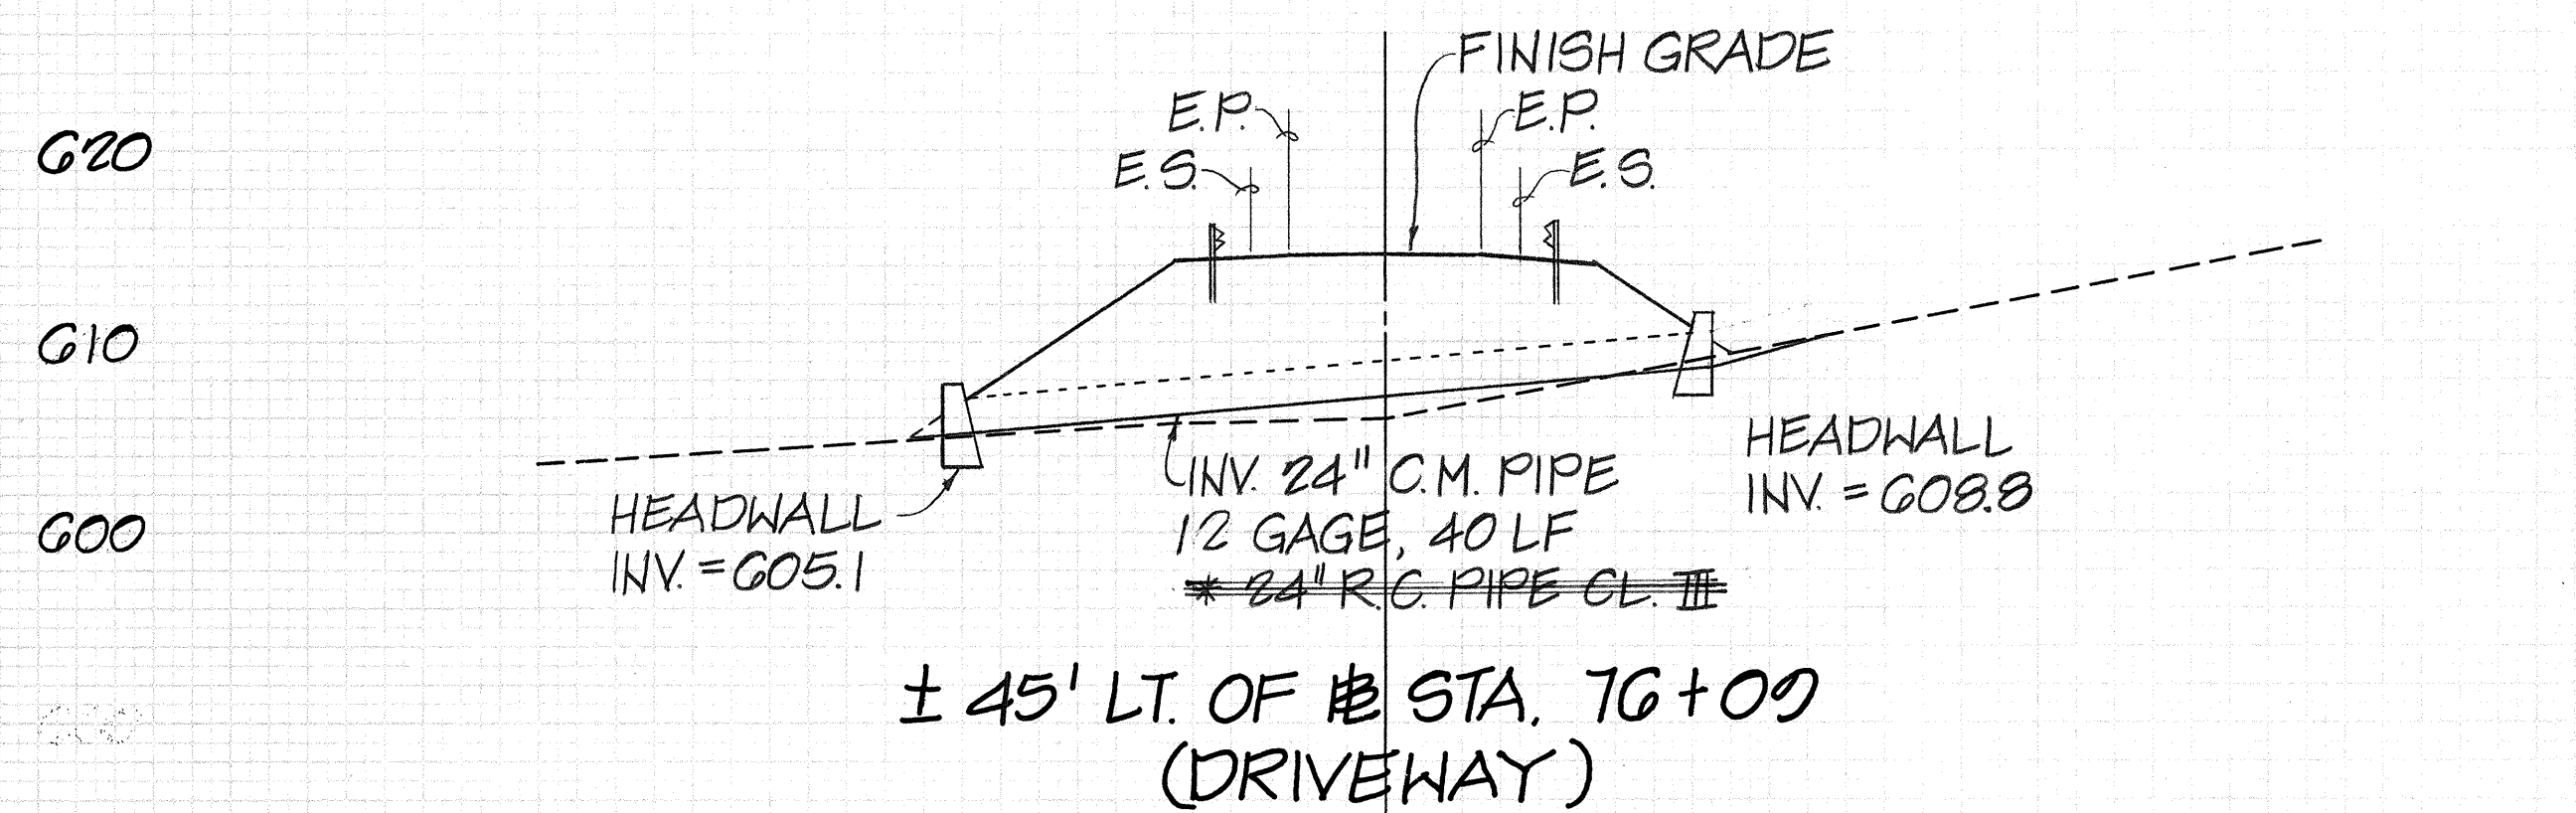

PROFILE ~ PAHOA-KAPOHO ROAD AT KEAAU-PAHOA ROAD JUNCTION


SCALE: HORIZ. 1"=50'
VERT. 1"=10'

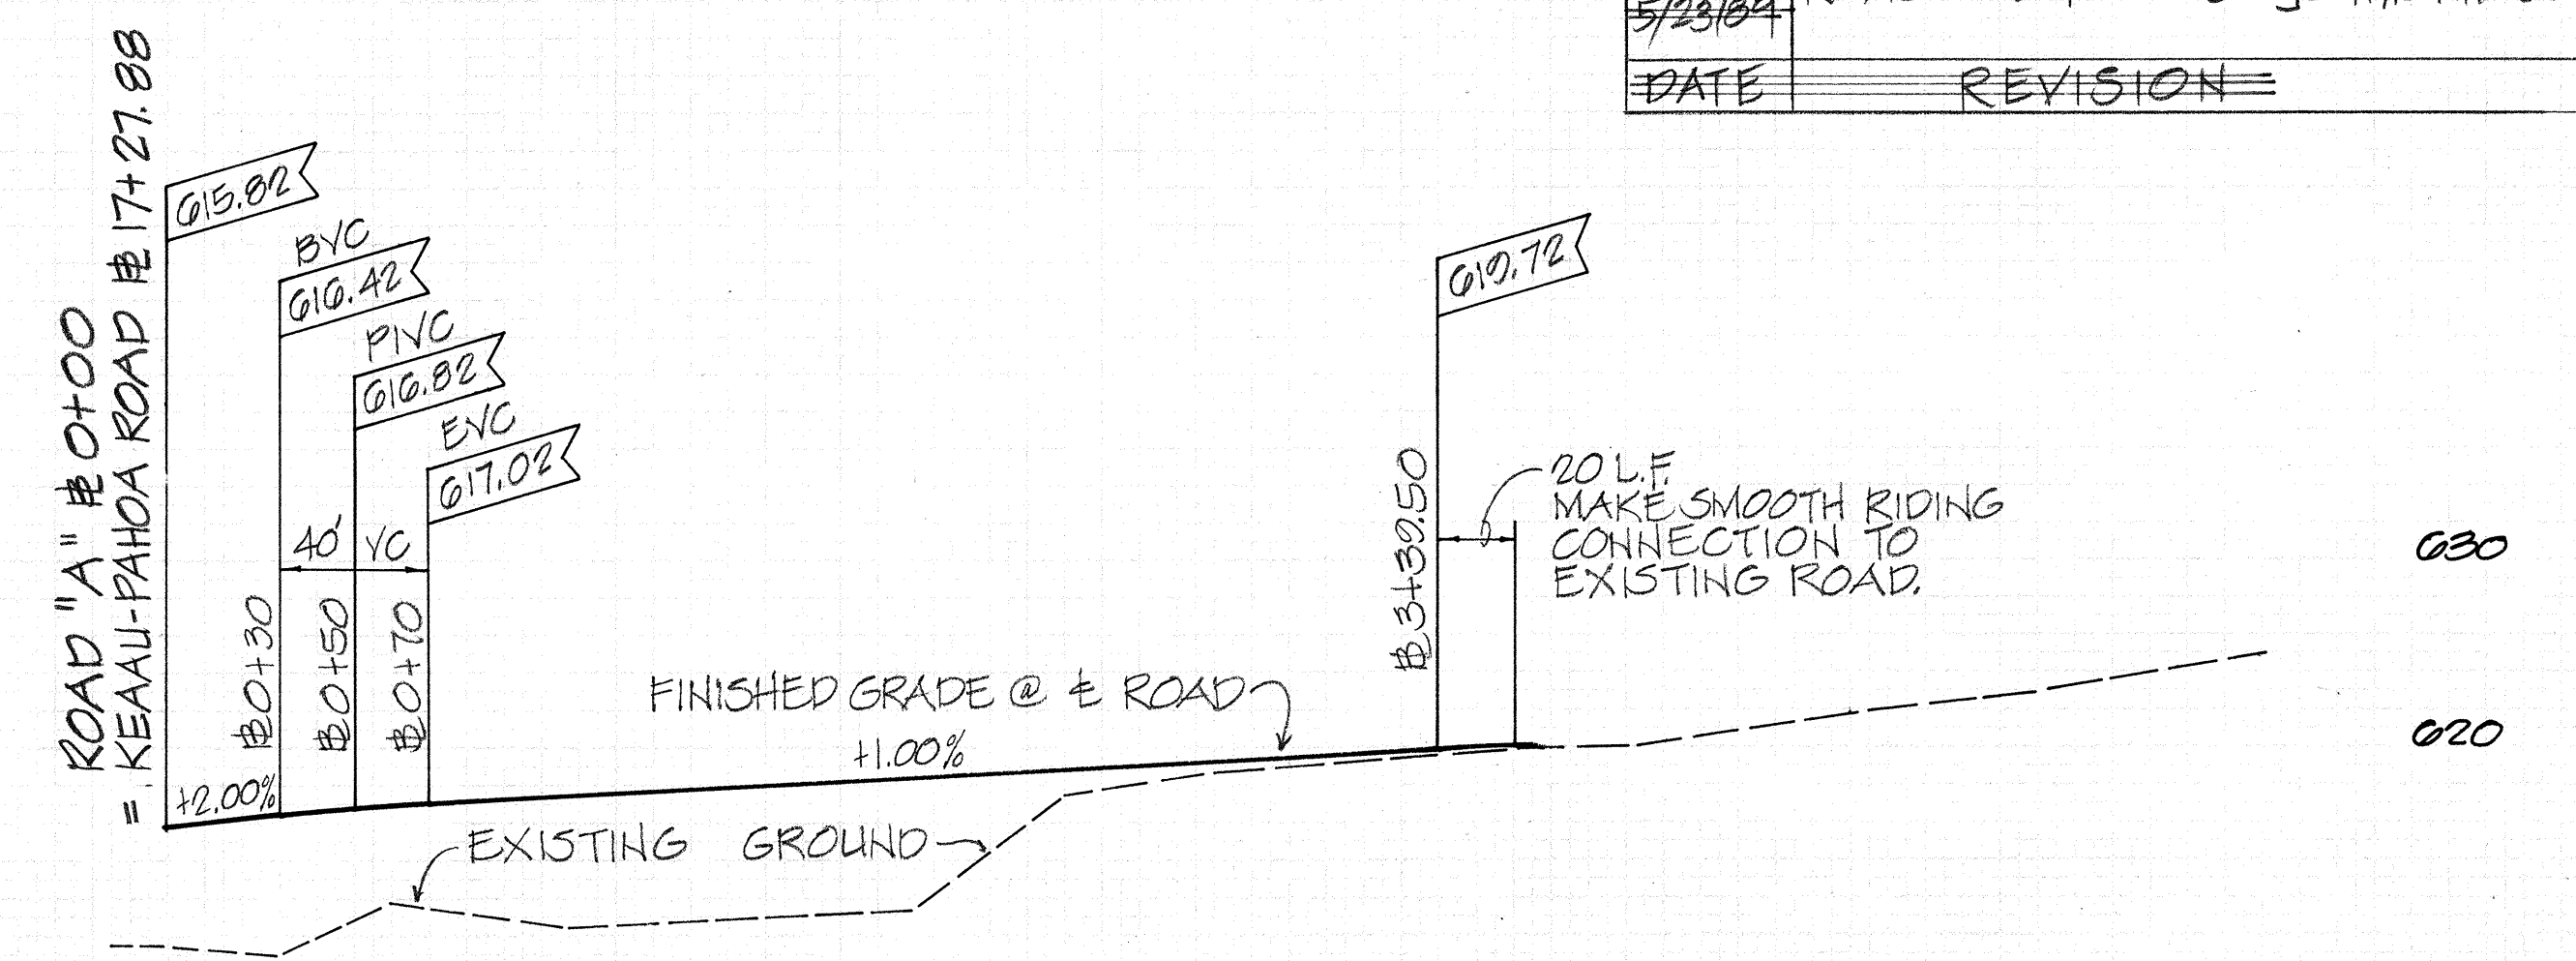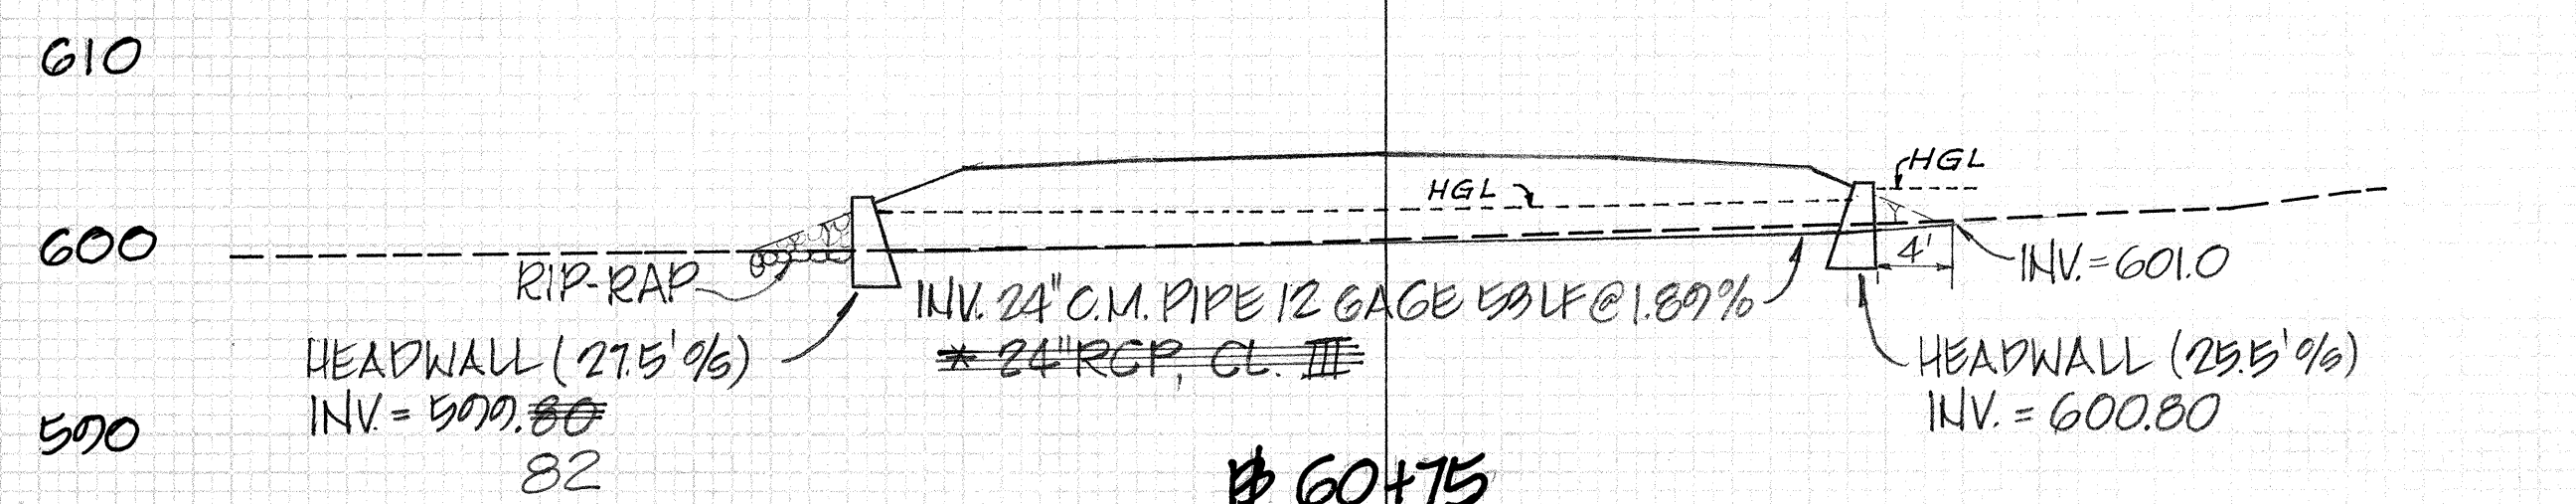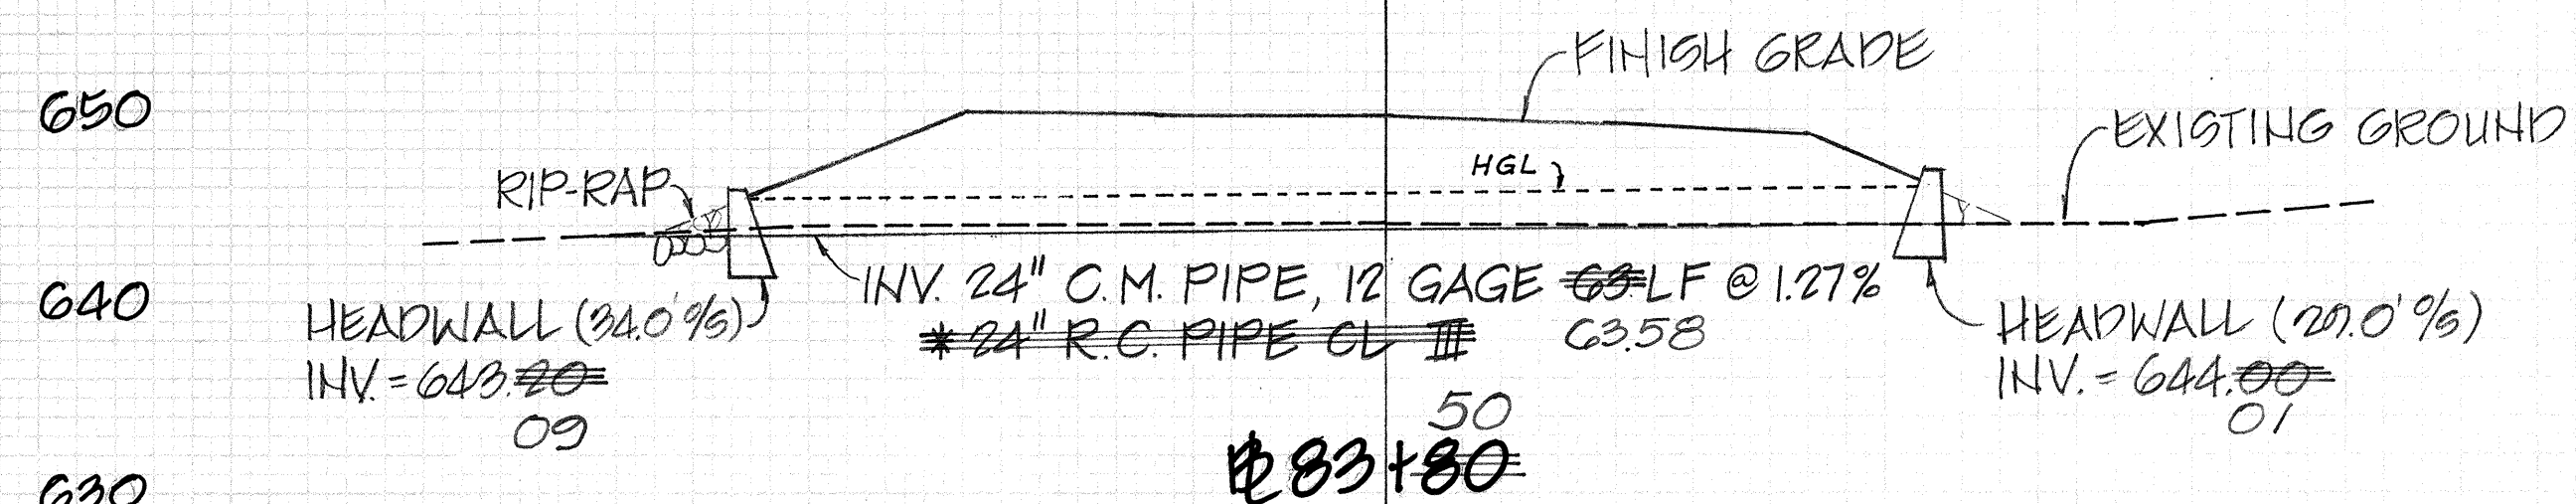

PROFILE ~ ROAD "A"

SCALE: HORIZ. 1"=50'
VERT. 1"=10'

5/23/84	Revised 24" CMP Gage Thickness
DATE	REVISION

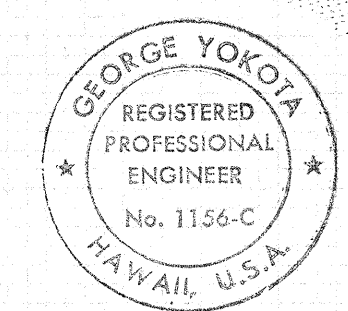

THIS WORK WAS PREPARED BY
ME OR UNDER MY SUPERVISION.
George Yokota
PARK ENGINEERING, INC.