

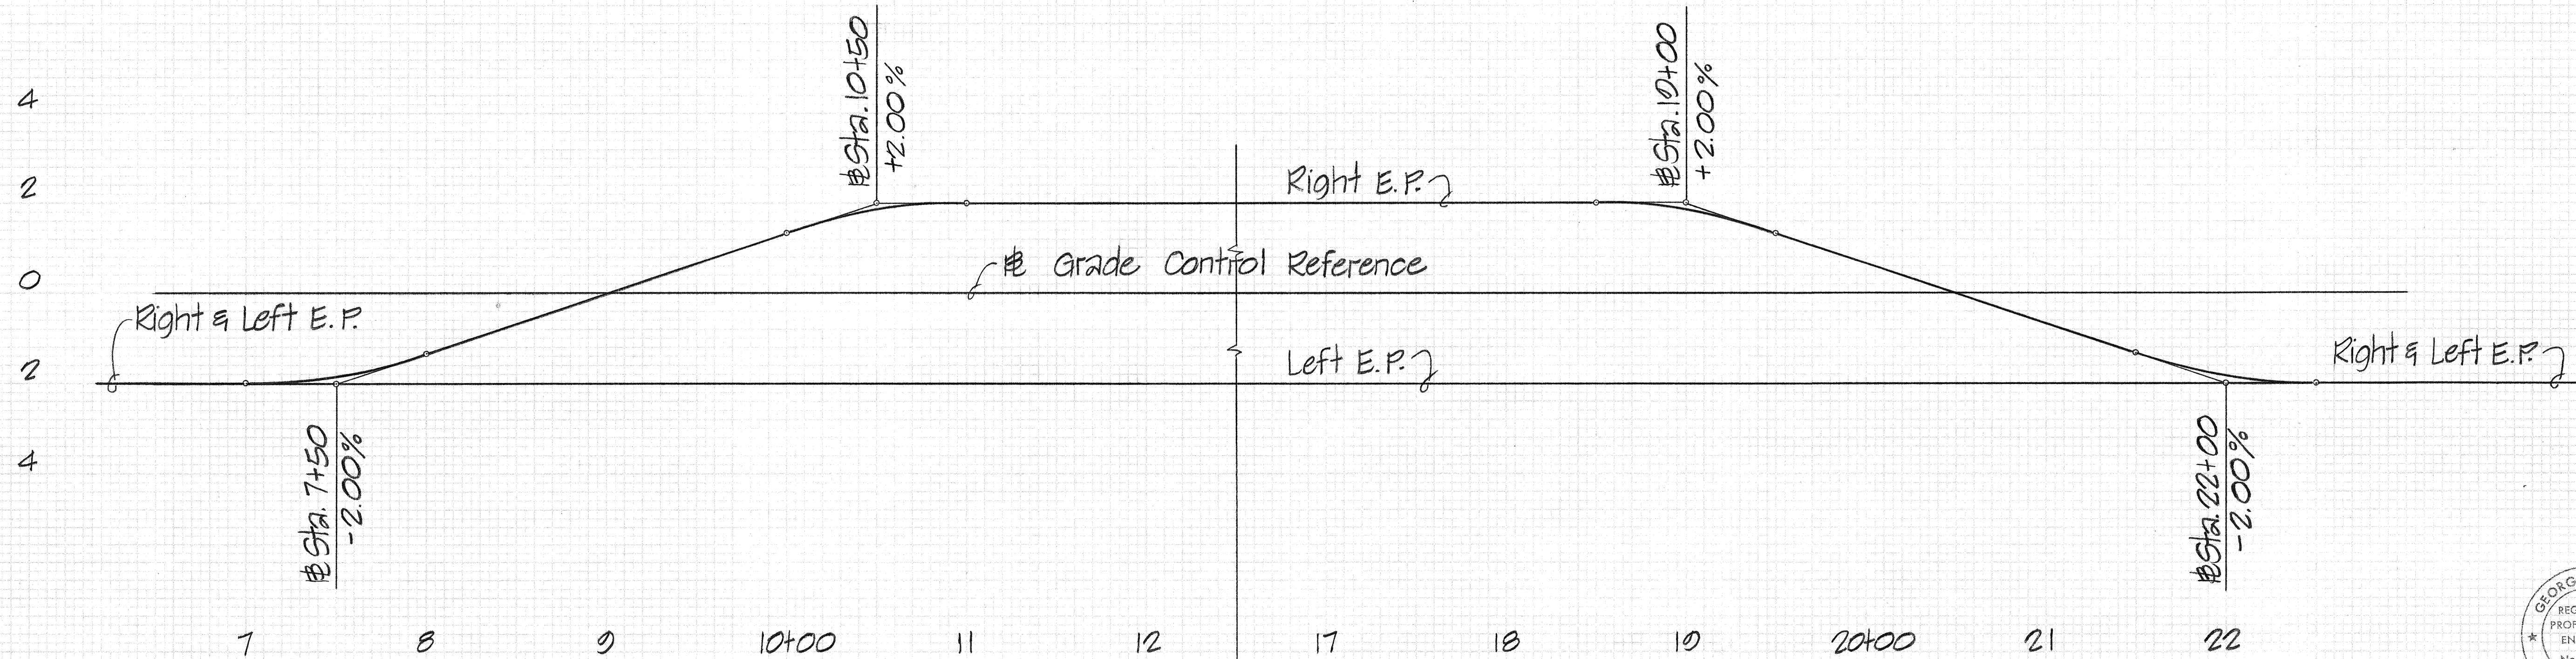


FED. ROAD DIST. NO.	STATE	FED. AID PROJ. NO.	FISCAL YEAR	SHEET NO.	TOTAL SHEETS
HAWAII	HAW.	RS-0130(20)	1989	17	68

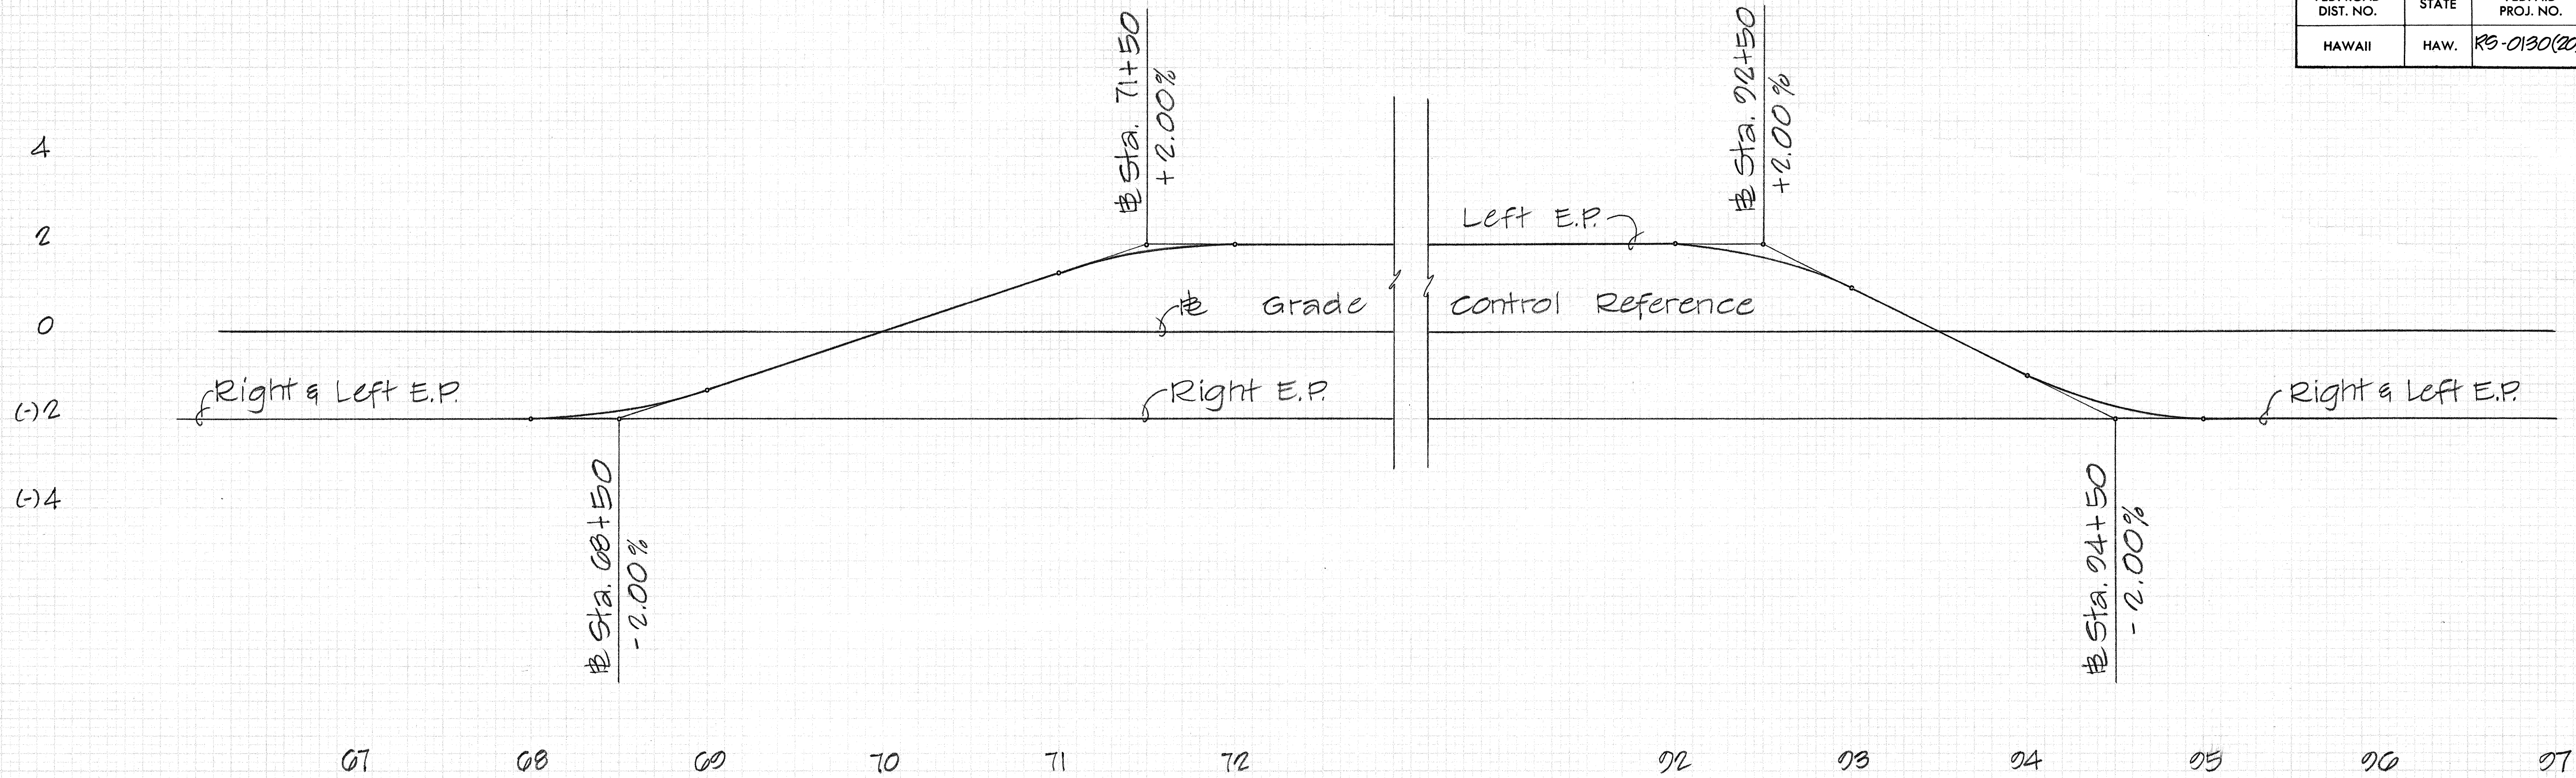


SUPER ELEVATION - TRANSITION DIAGRAM

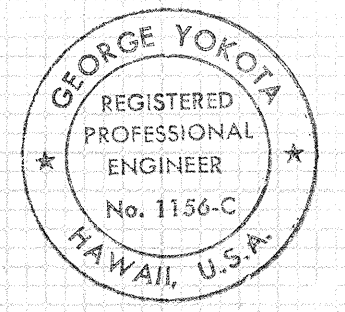


THIS WORK WAS PREPARED BY
ME OR UNDER MY SUPERVISION.
George Yokota
PARK ENGINEERING, INC.

FED. ROAD DIST. NO.	STATE	FED. AID PROJ. NO.	FISCAL YEAR	SHEET NO.	TOTAL SHEETS
HAWAII	HAW.	RS-0130(20)	1989	175-1	68

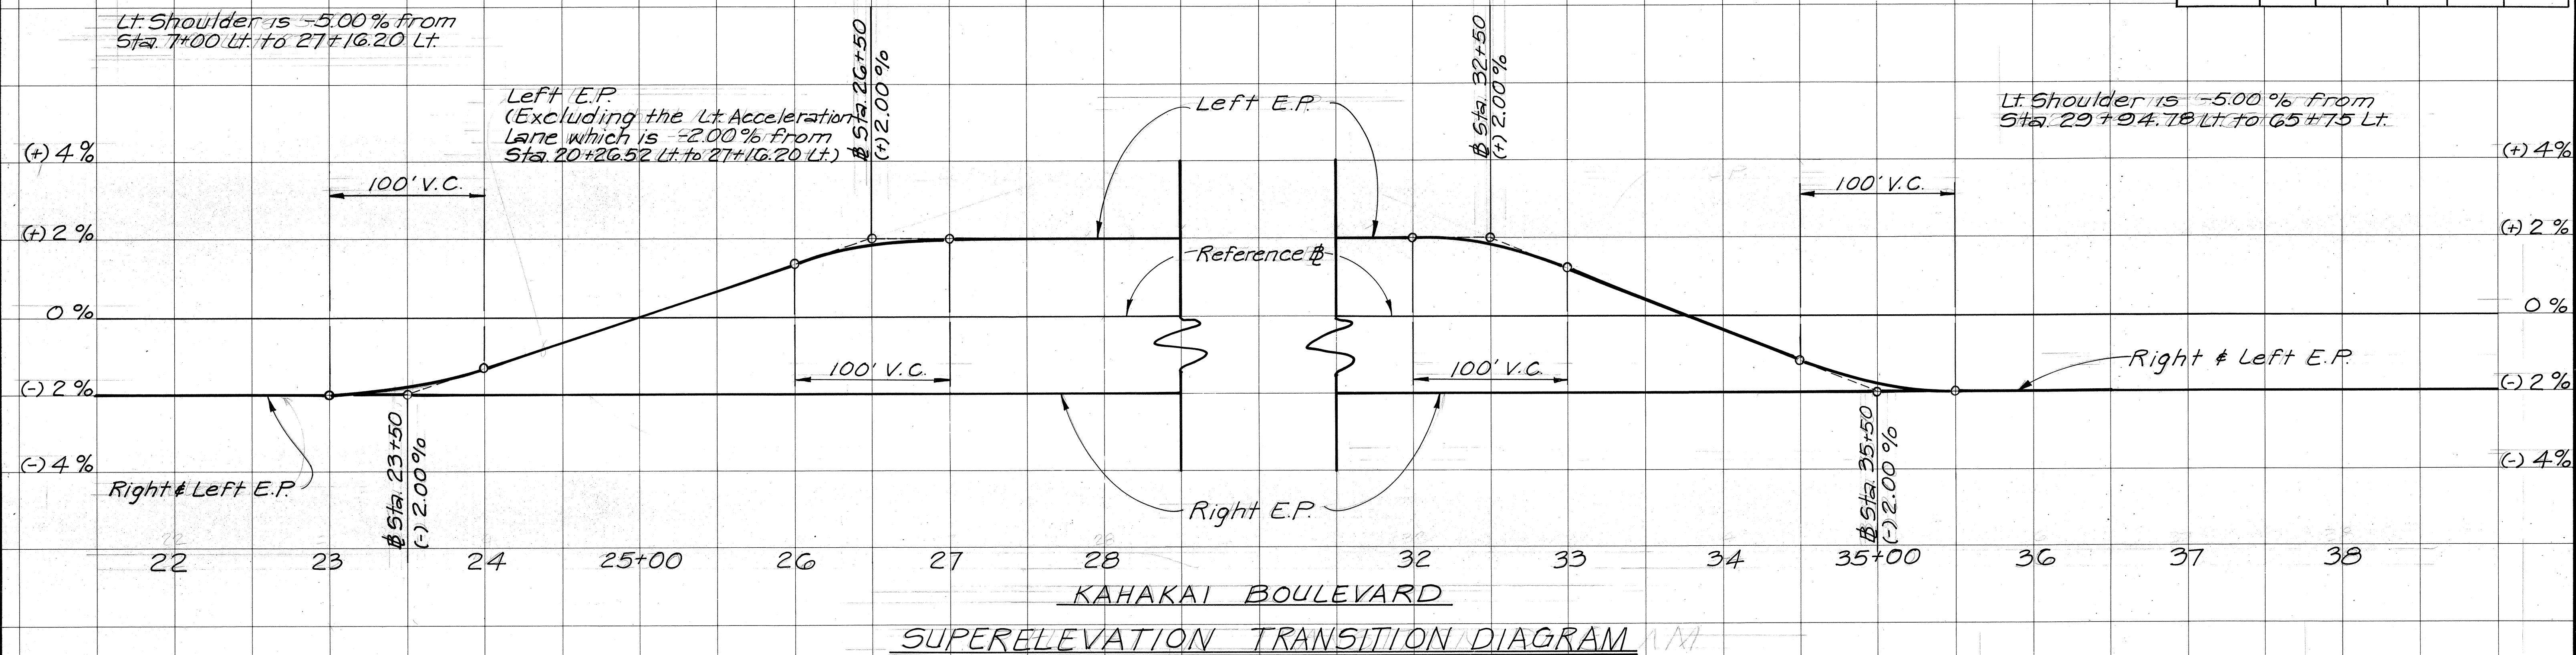

THIS SHEET IS
"AS-BUILT" POSTED

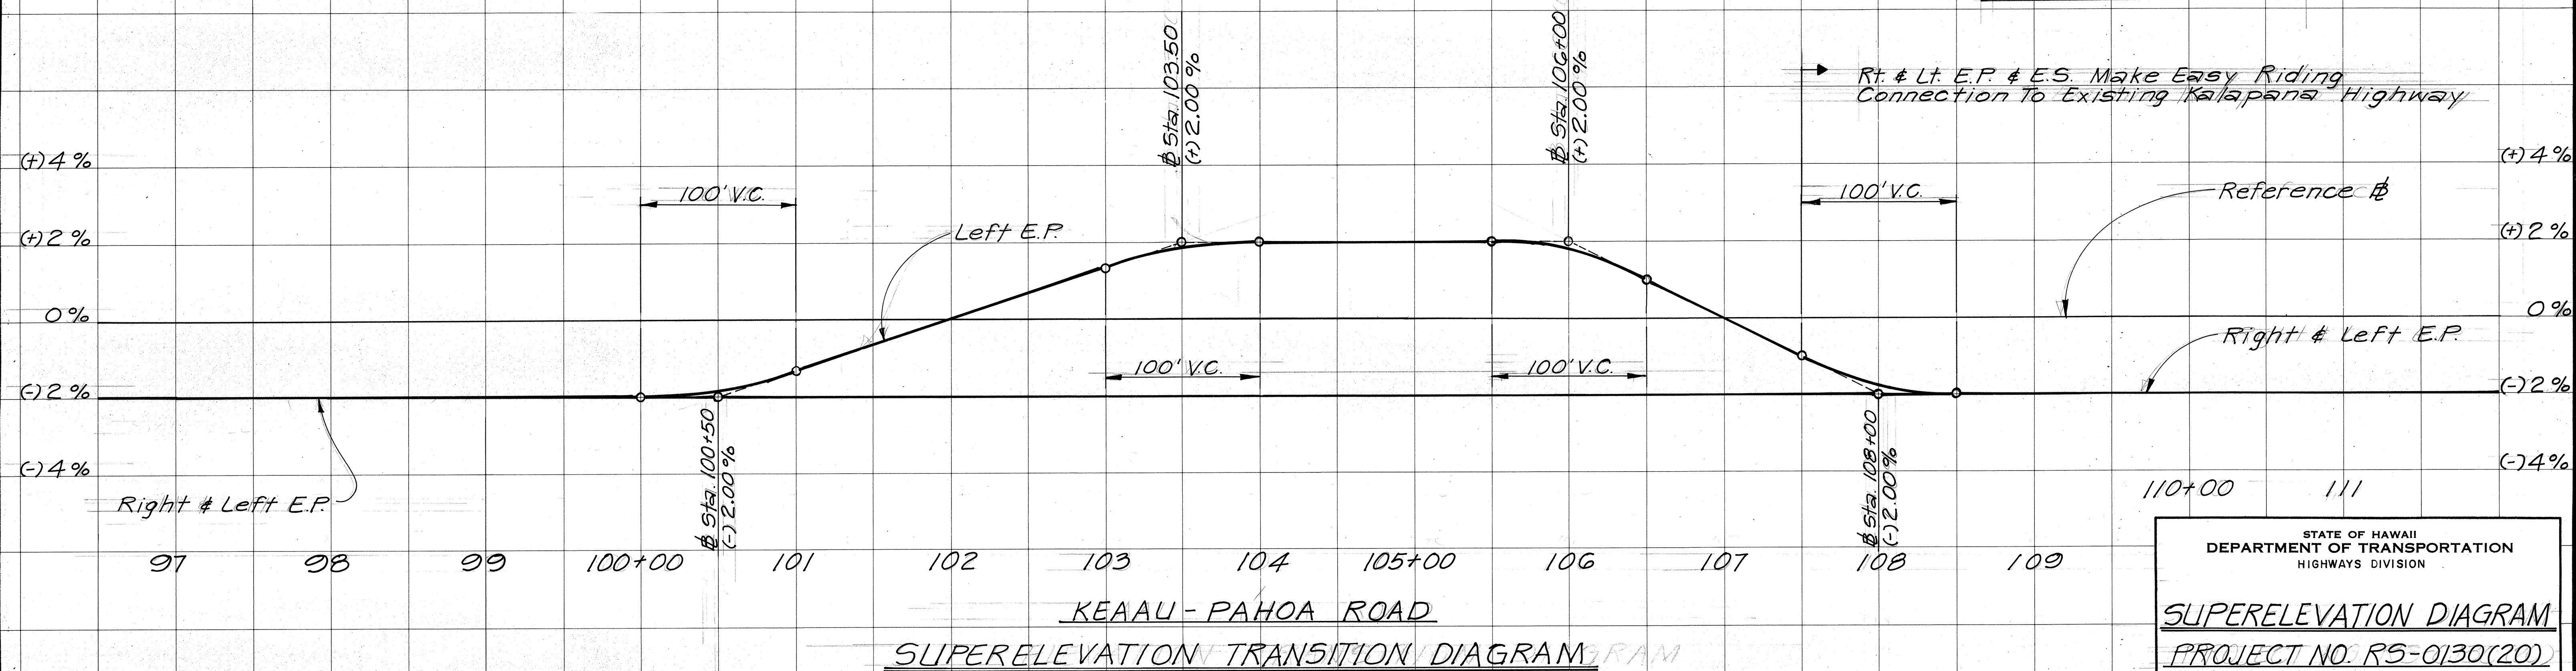

Rt. & Lt. E.P. & E.S. Make Easy Riding
Connection To Existing Kalapana Highway

STATE OF HAWAII
DEPARTMENT OF TRANSPORTATION
HIGHWAYS DIVISION

SUPERELEVATION DIAGRAM
PROJECT NO. RS-0130(20)

Scale: Horiz. 1" = 50'
Vert. 1" = 2% Date: May, 1991

SHEET No. OF SHEETS

17 S-1

ORIGINAL PLAN	SURVEY PLOTTED BY _____	DATE _____
	DRAWN BY _____	" _____
	TRACED BY _____	" _____
NOTE BOOK	DESIGNED BY _____	" _____
	QUANTITIES BY _____	" _____
No. _____	CHECKED BY _____	" _____