




FED. ROAD DIST. NO.	STATE	PROJ. NO.	FISCAL YEAR	SHEET NO.	TOTAL SHEETS
HAWAII	HAW.	HWY-H-01-89	1990	6	6

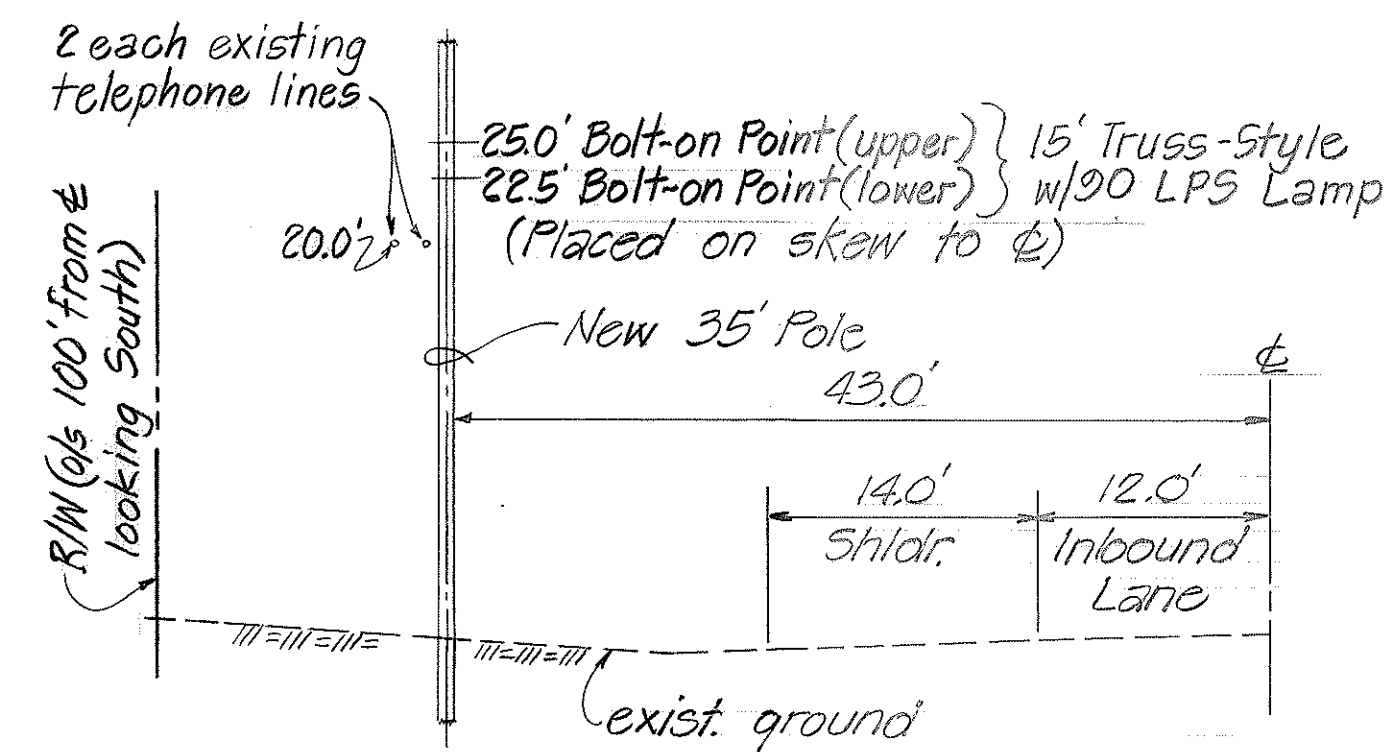


LOCATION NO. 1
VOLCANO ROAD AT JADE AVE

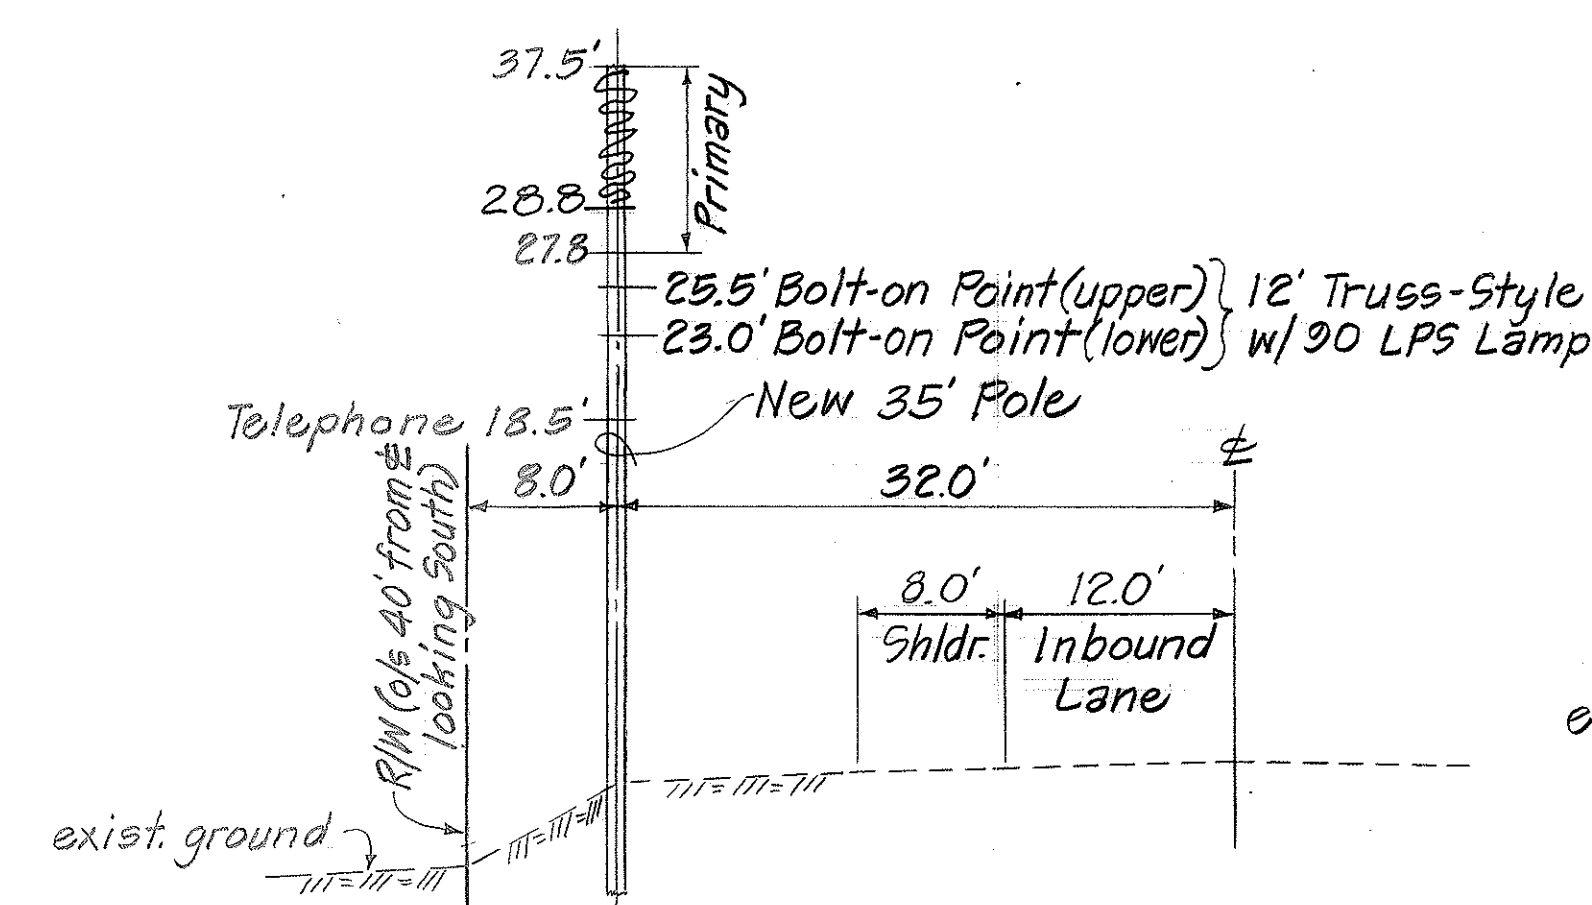


LOCATION NO. 2
VOLCANO ROAD AT ALII KANE ST

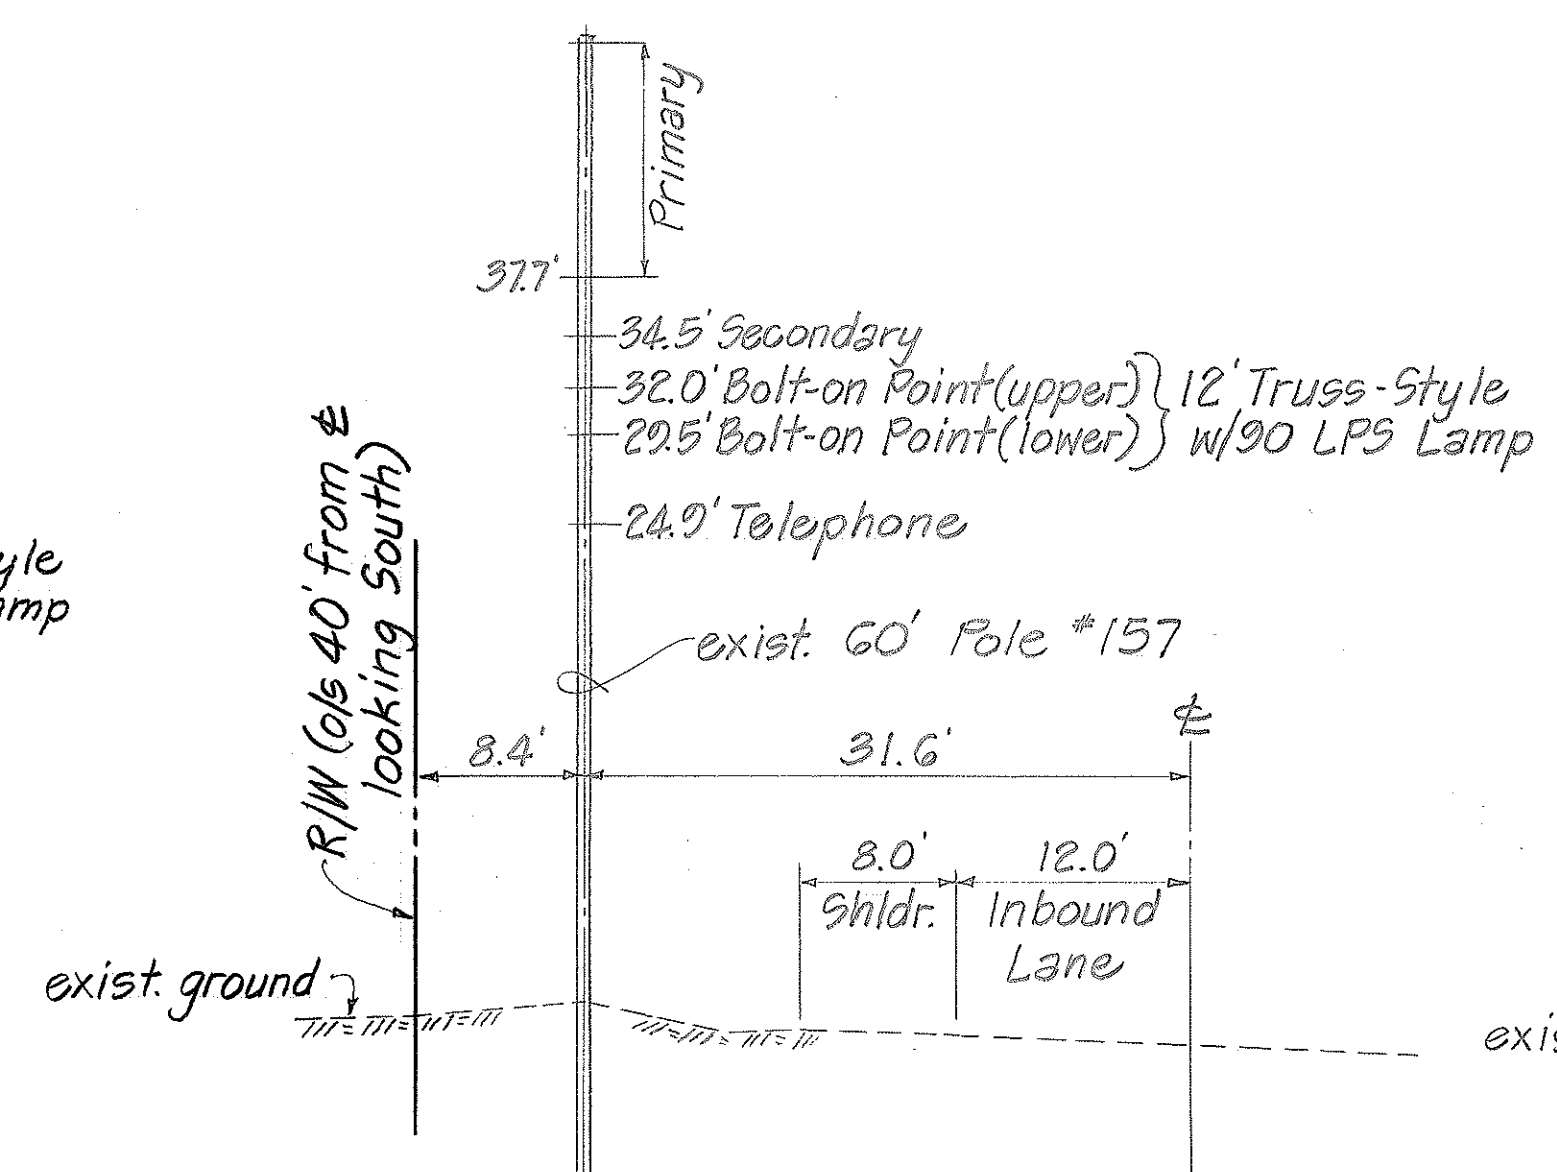


LOCATION NO. 3
VOLCANO ROAD AT THE 22 1/2 MILE MARKER
NEXT TO AKATSUKA ORCHIDS

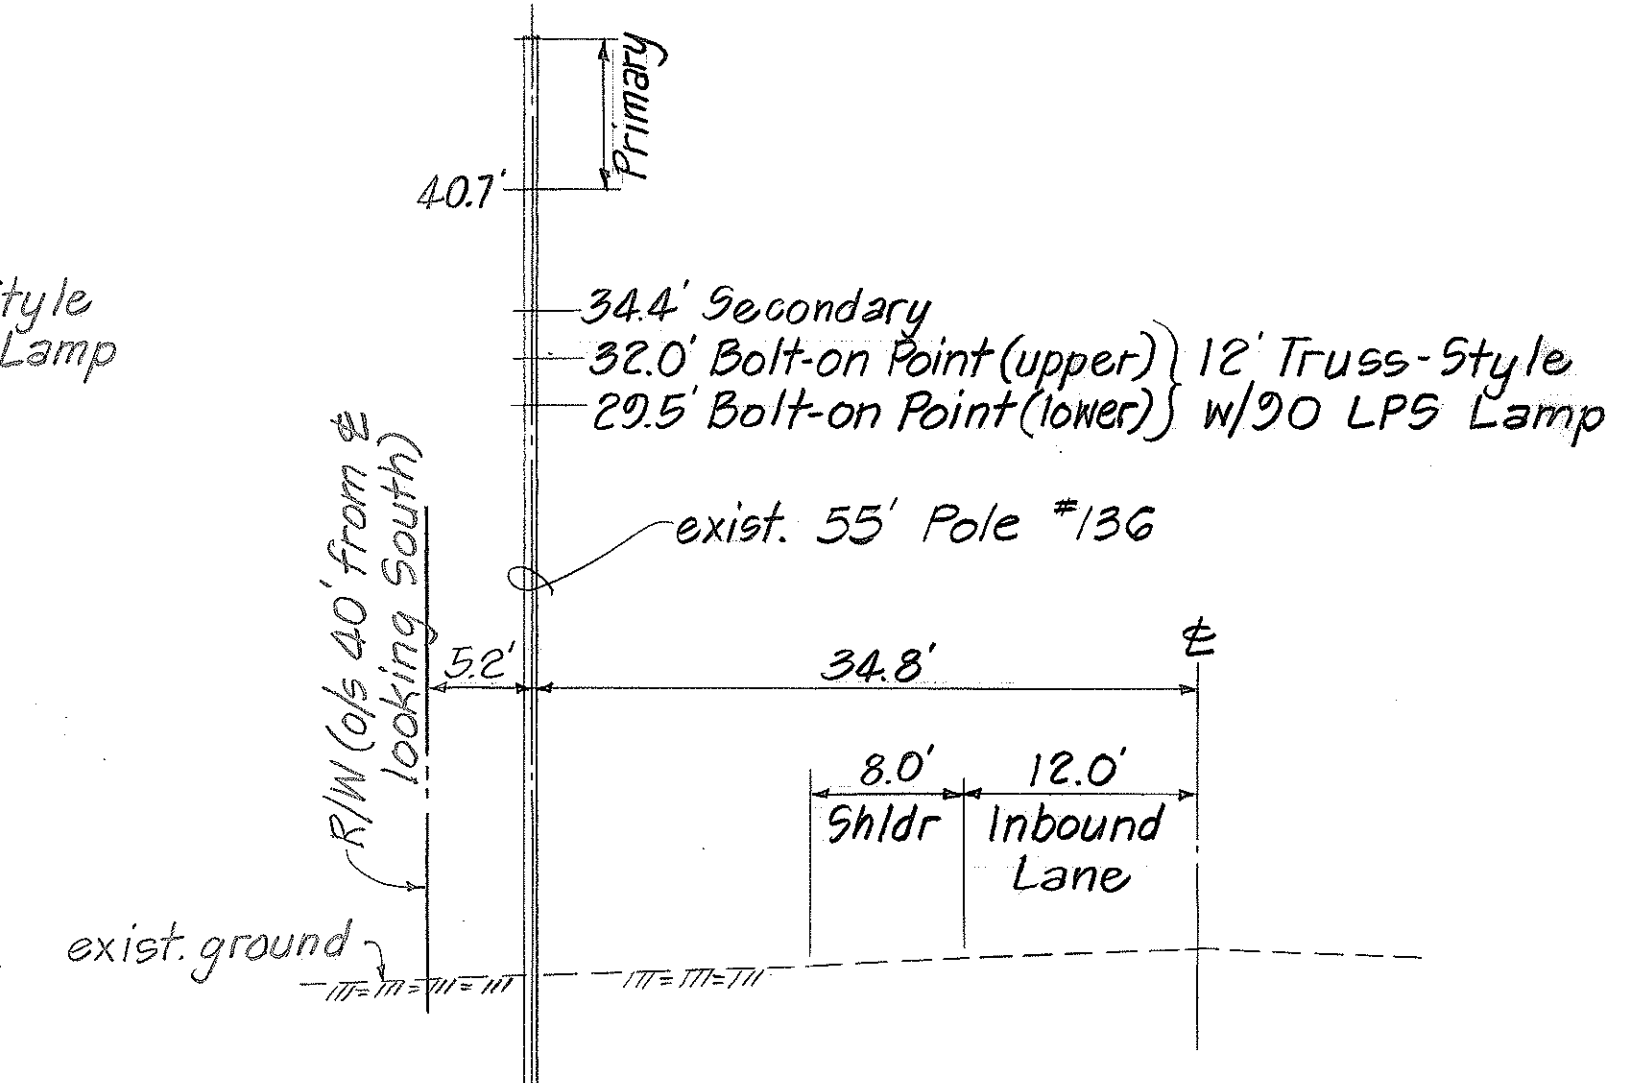


LOCATION NO. 5
VOLCANO ROAD AT ALA LOOP RD

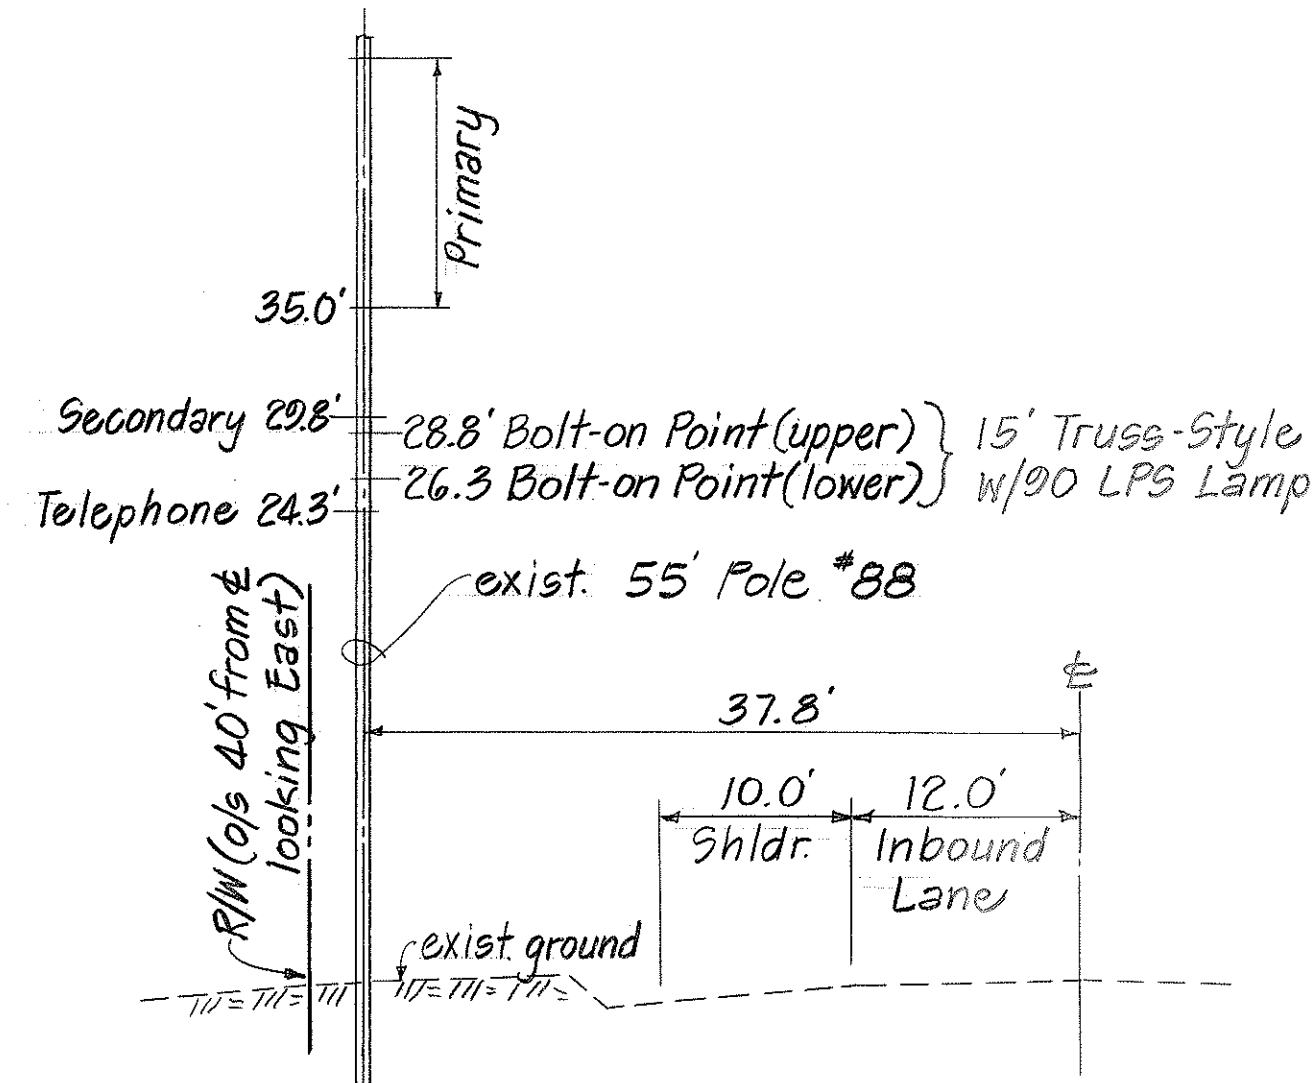


LOCATION NO. 6
KEAAU-PAHOA ROAD AT PUAKALO ST.

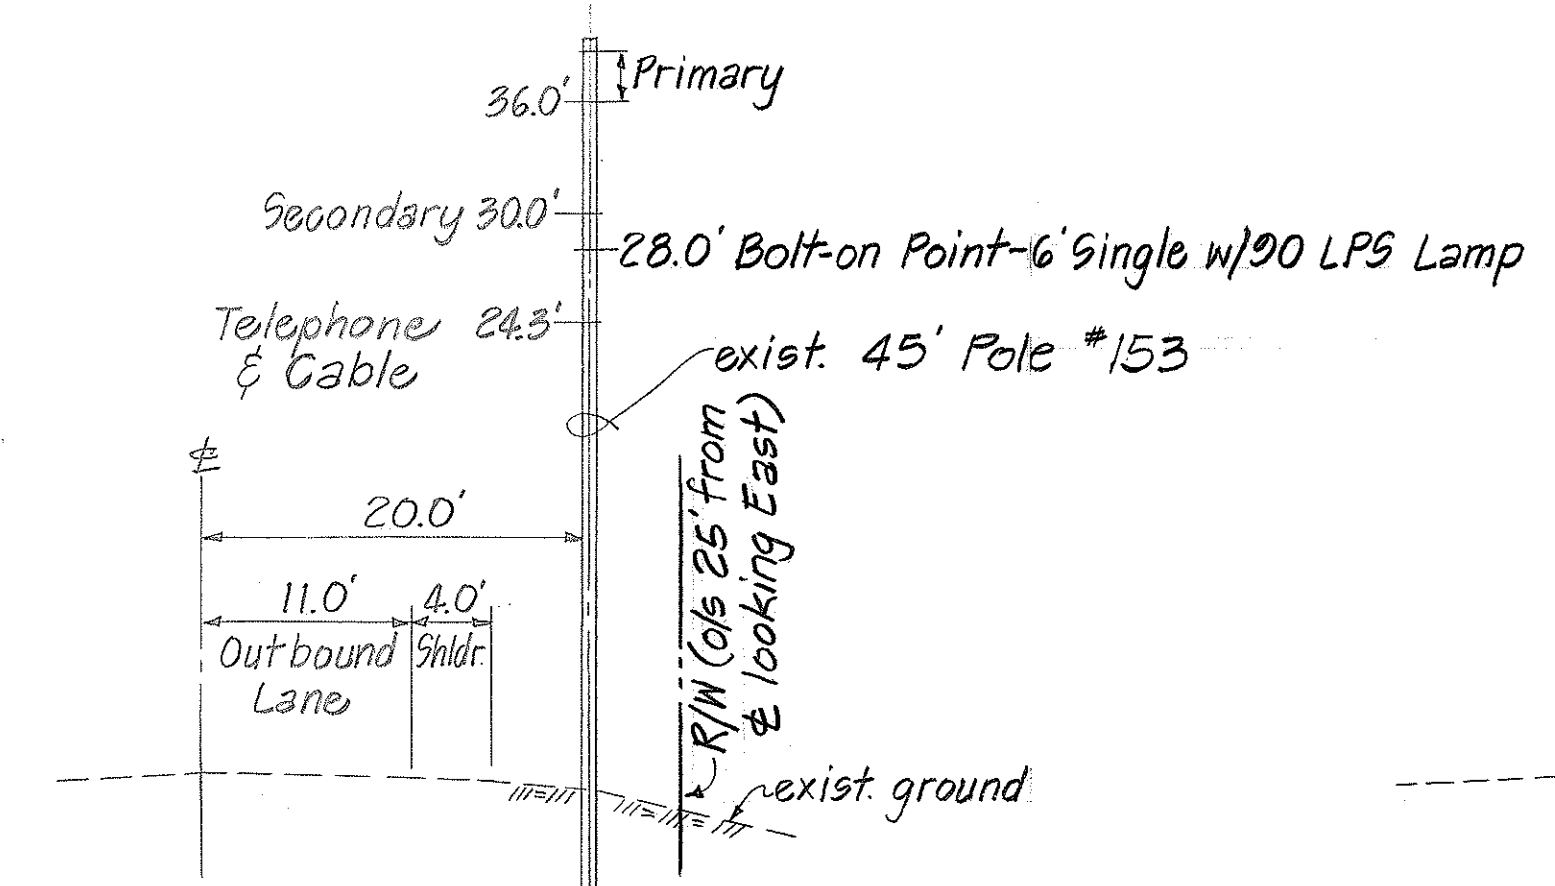


LOCATION NO. 7
KEAAU-PAHOA ROAD AT AULII ST.

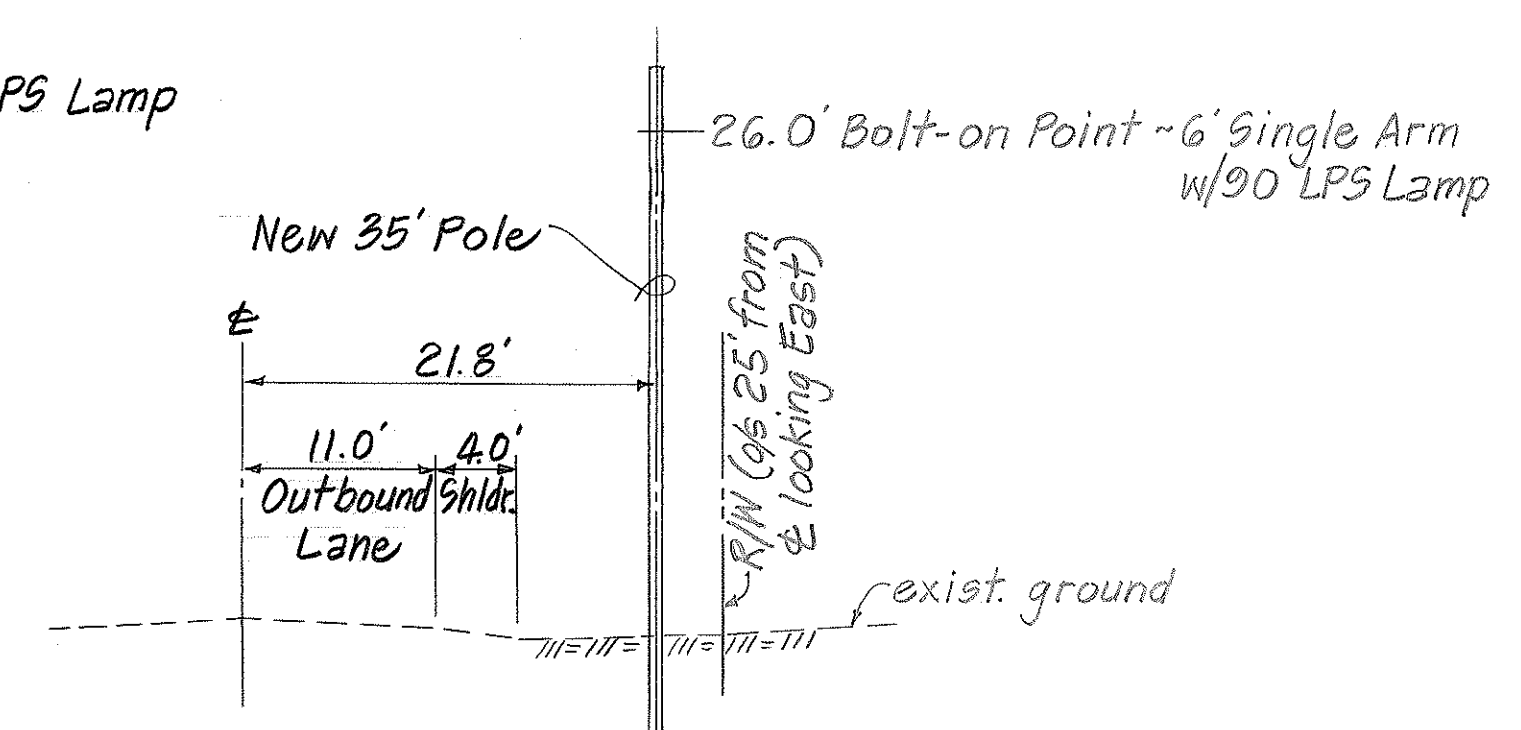

LOCATION NO. 8
KEAAU-PAHOA ROAD AT ILIMA ST

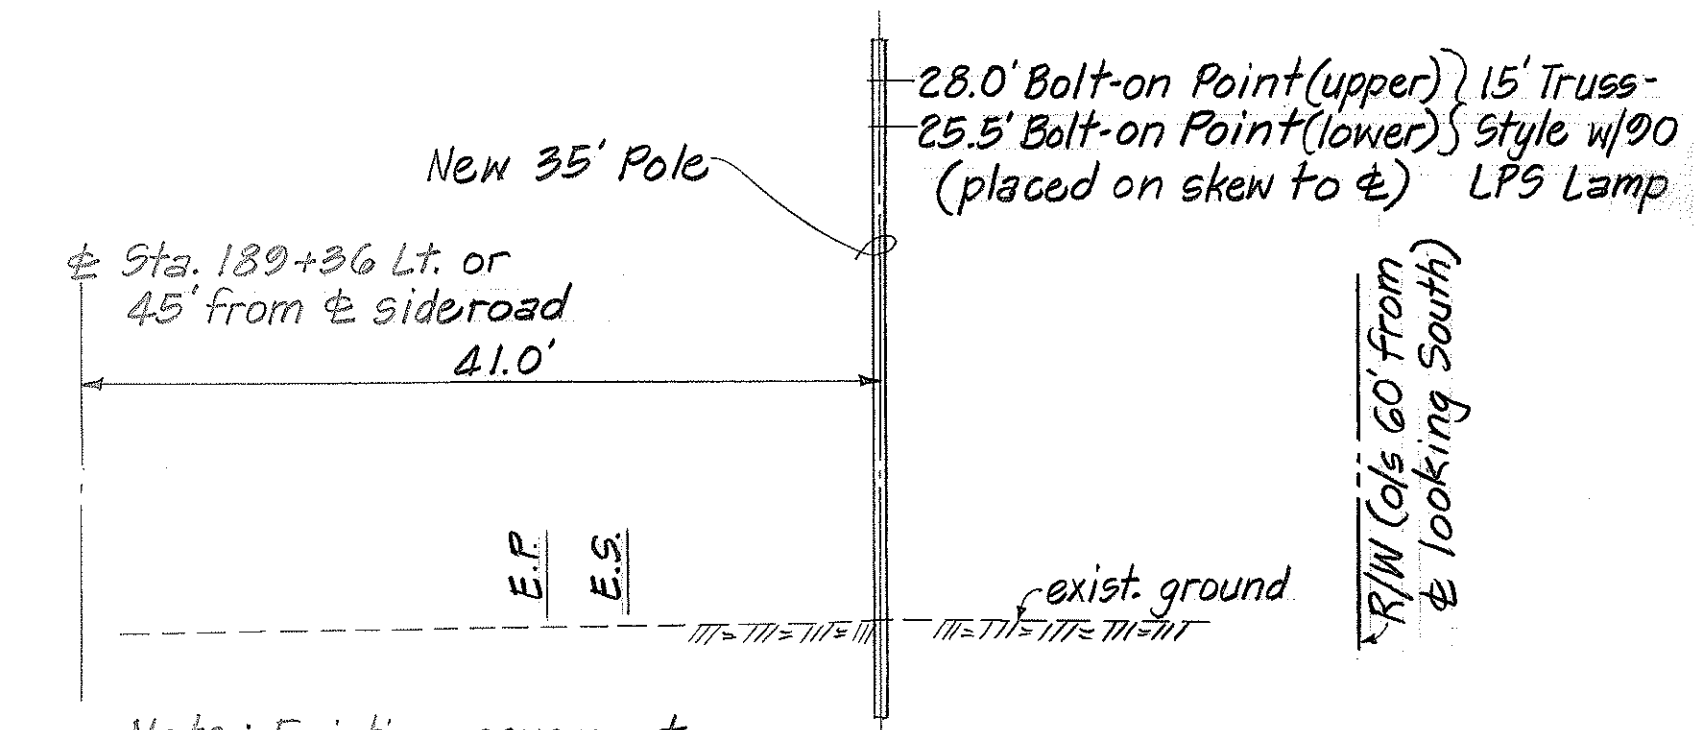

LOCATION NO. 9
PAHOA-KALAPANA ROAD AT ENTRANCE
TO BLACK SAND SUBDIVISION

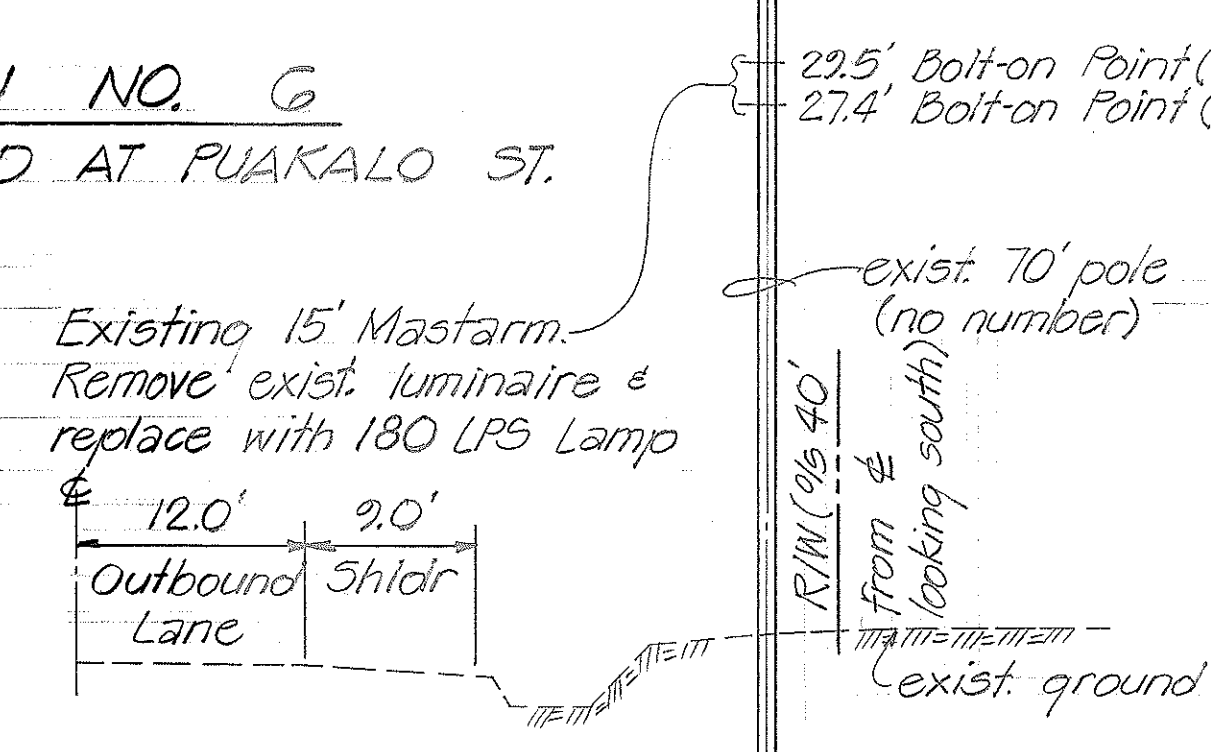

LOCATION NO. 4
VOLCANO ROAD AT KULANI ROAD

Note: Existing pavement on skew to centerline.

STATE OF HAWAII
DEPARTMENT OF TRANSPORTATION
HIGHWAYS DIVISION

SECTION DETAIL
HIGHWAY LIGHTING, VARIOUS
LOCATIONS IN THE
PUNA DISTRICT

PROJECT N2 HWY-H-01-89
Scale: Hor. 1"=10'
Ver. 1"=10' Date: Mar. 1989

SHEET NO. 1 OF 1 SHEETS

ORIGINAL PLAN	DATE
SURVEY PLOTTED BY	
DRAWN BY	
DESIGNED BY	
QUANTITIES BY	
CHECKED BY	
NO.	