	INDEX TO DRAWINGS
SHEET NO.	DESCRIPTION
l	TITLE SHEET
2	STANDARD PLANS SUMMARY
3	TYPICAL LIGHTING DETAILS
4-5	LOCATION PLANS
6	SECTION DETAILS
·	

STATE OF HAWAII


DEPARTMENT OF TRANSPORTATION


HIGHWAYS DIVISION HONOLULU, HAWAII "AS-BUILT" PLANS FOR

HIGHWAY LIGHTING

VARIOUS LOCATIONS IN THE PUNA DISTRICT PROJECT NO. HWY-H-01-89

> DISTRICT OF PUNA ISLAND OF HAWAII

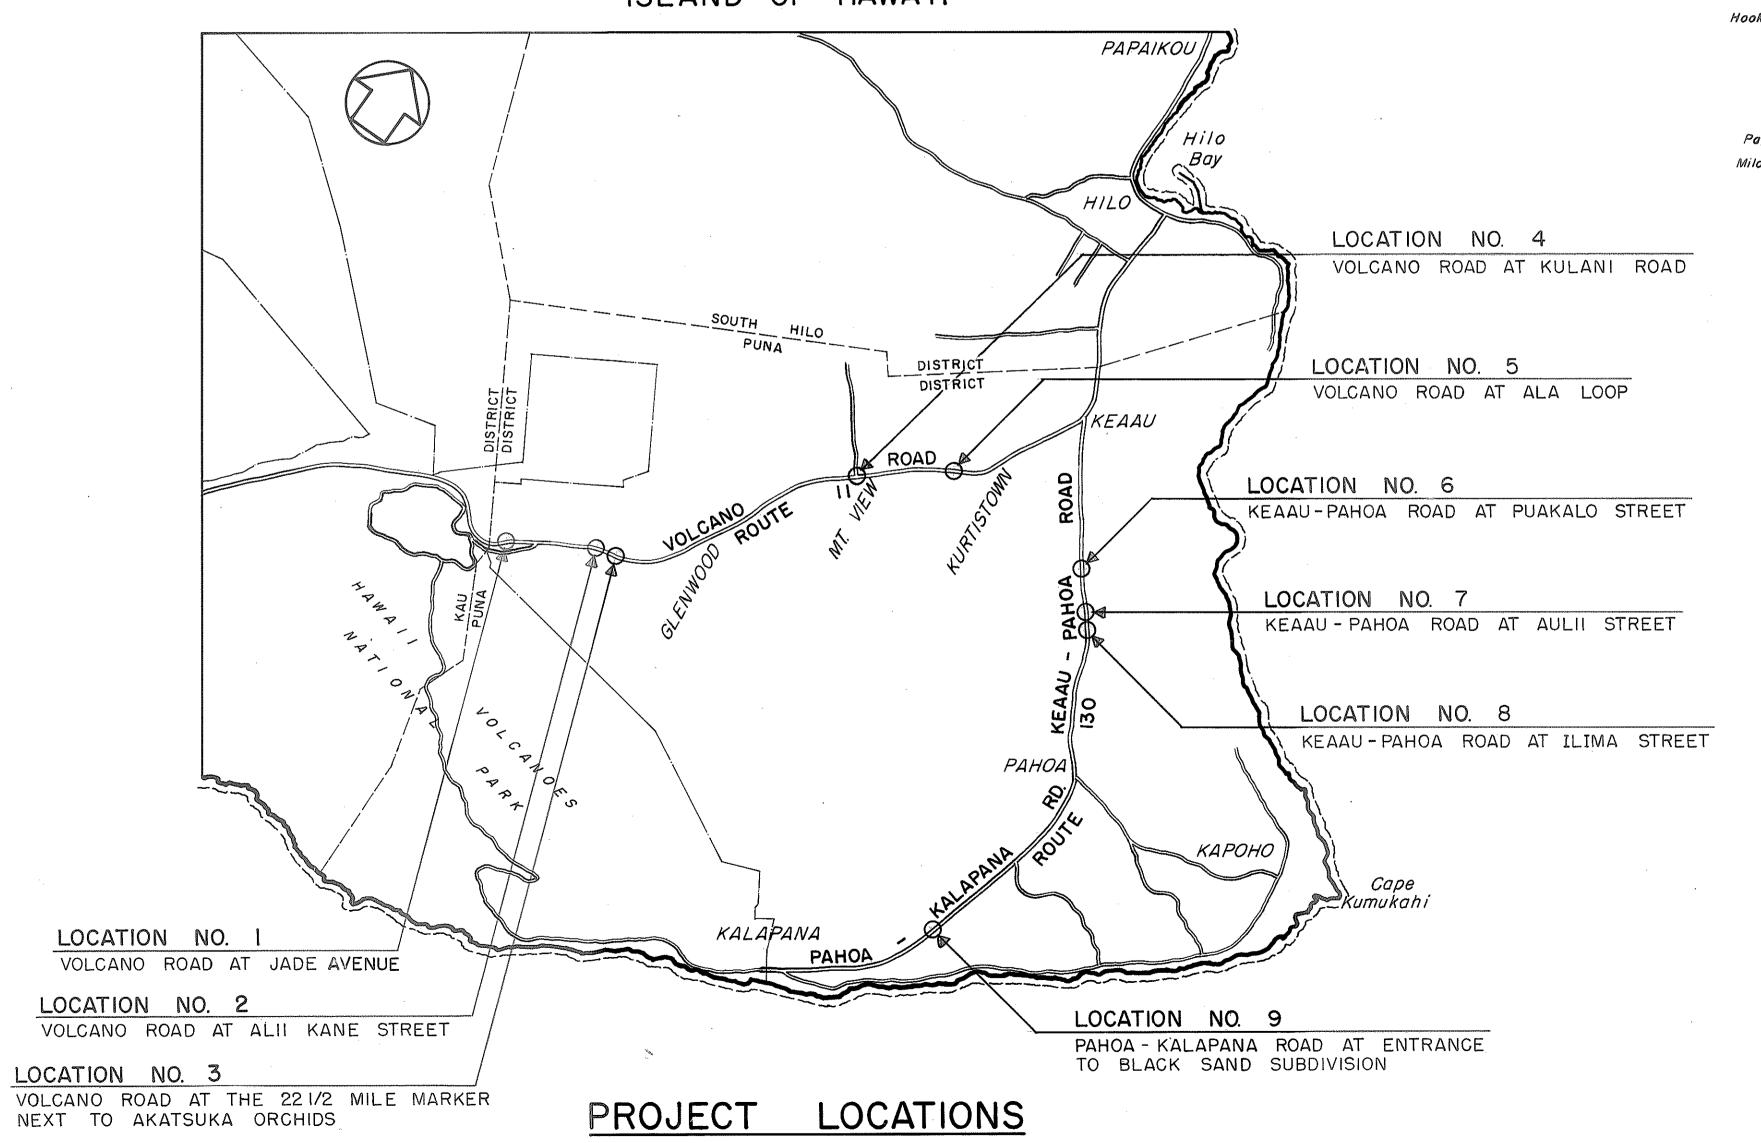

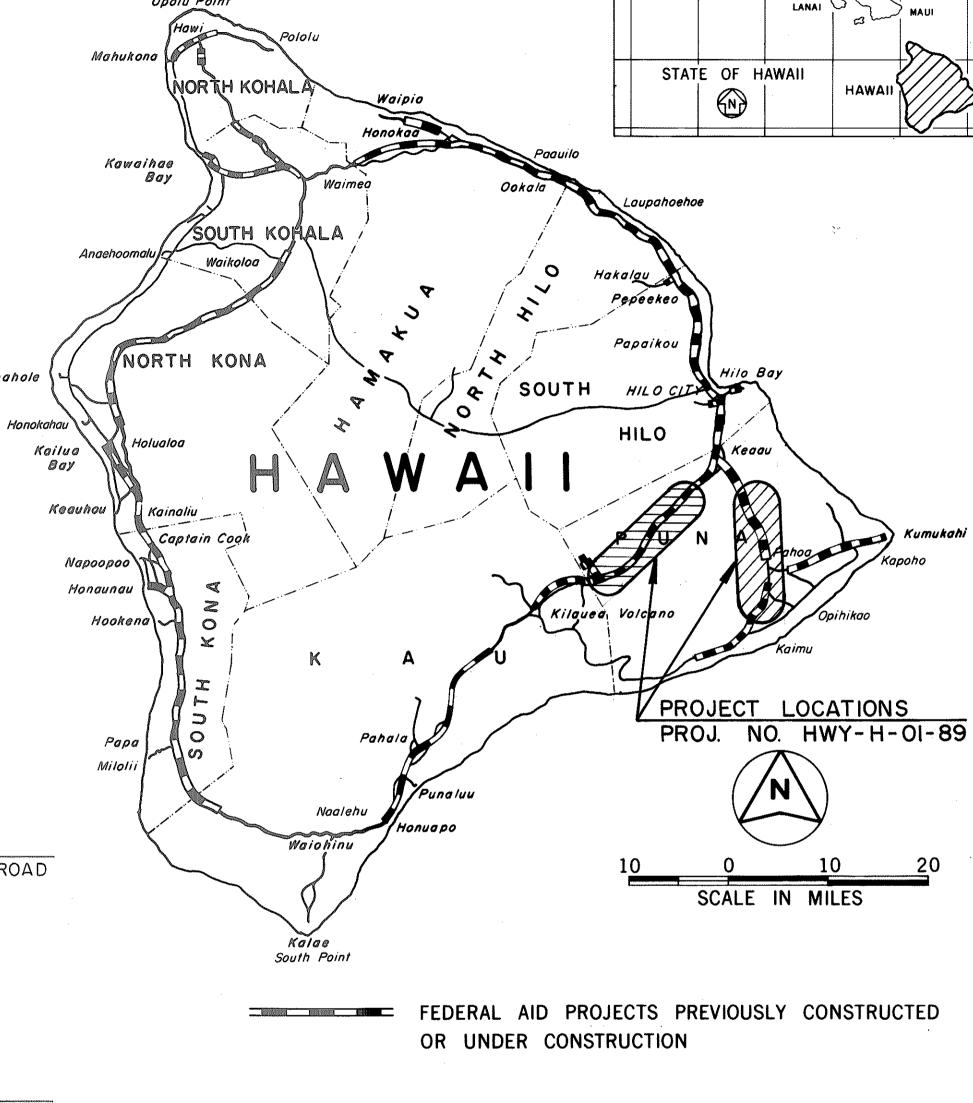

FED. ROAD STATE

HAWAII

PROJ. NO.

HWY-H-01-89 | 1990

CHANGES MADE DURING CONSTRUCTION HAVE BEEN NOTED ON THESE PLANS.

Robert y.W. Su An RESIDENT ENGINEER

12/19/90 DATE

FISCAL SHEET TOTAL YEAR NO. SHEETS

DEPARTMENT OF TRANSPORTATION STATE OF HAWAII APPROVED:

DIR. OF TRANSPORTATION

LOCATION NO. 3

JULY, 1989 DATE

548-7537 PHONE

HAWAII DISTRICT DESIGNED BY