


FED. ROAD DIST. NO.	STATE	PROJ. NO.	FISCAL YEAR	SHEET NO.	TOTAL SHEETS
HAWAII	HAW.	130A-01-92M	1992	5	10

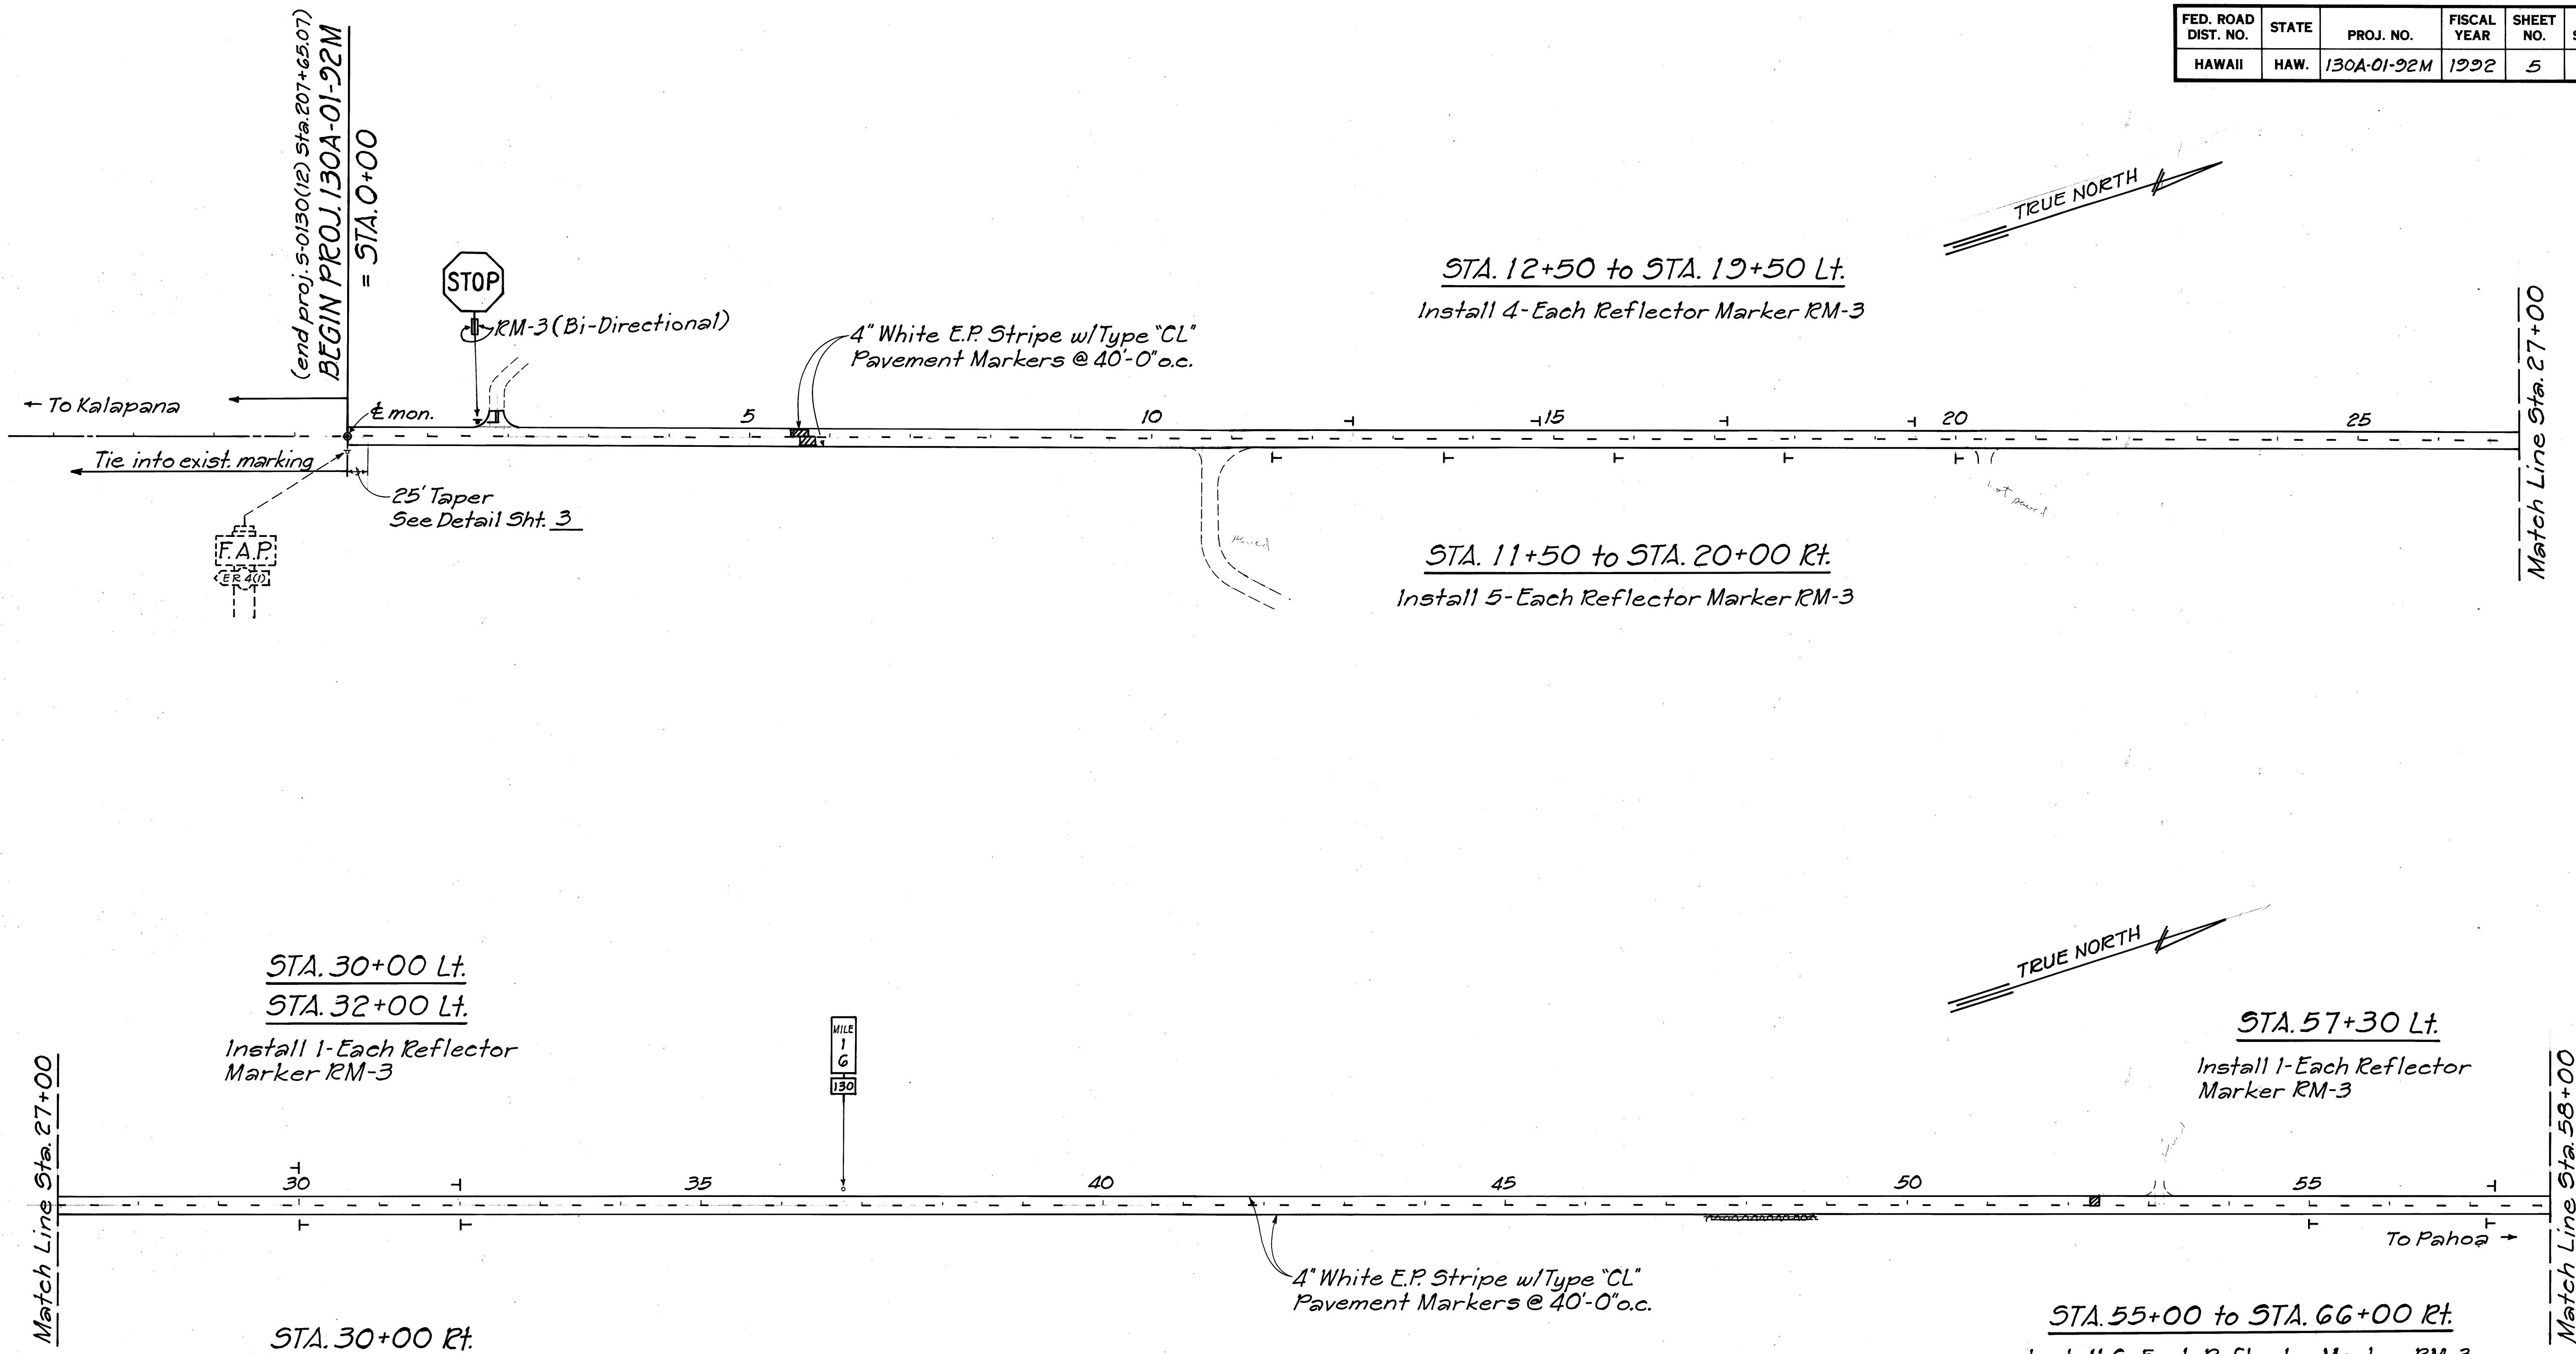

DATE	
DESIGNED BY	
DRAWN BY	
CHECKED BY	
NOTED BY	
ORIGINAL PLAN	
NOTE BOOK	
No.	

STATE OF HAWAII
DEPARTMENT OF TRANSPORTATION
HIGHWAYS DIVISION

ROADWAY, STRIPING AND
TRAFFIC SIGNS PLAN

PAHOA-KALAPANA ROAD RESURFACING
PROJ. No. 130A-01-92M
PUNA, HAWAII
Scale: 1" = 100' Date: _____
SHEET No. 1 OF 4 SHEETS

FED. ROAD DIST. NO.	STATE	PROJ. NO.	FISCAL YEAR	SHEET NO.	TOTAL SHEETS
HAWAII	HAW.	130A-01-92M	1992	6	10

Note: Exist. Destination and Elev. Signs to Remain.

STA. 75+81 to STA. 78+60 Lt.

Exist. Reflector Marker RM-1 (white) to Remain.

STA. 75+81 to STA. 79+48 Lt.

Construct 8' Shoulder Taper

STA. 85+50 Lt.

Install 1-Each Reflector Marker RM-3

4" White (Thermo-plastic) Guidelines.

STA. 85+00 Rt.

STA. 87+00 Rt.

Install 1-Each Reflector Marker RM-3

STA. 75+50 to STA. 80+12 Rt.

Exist. Reflector Marker RM-1 (white) to Remain.

STA. 73+54 to STA. 80+40 Rt.

Construct 8' Shoulder Taper

STA. 89+00 Lt.

Install 1-Each Reflector Marker RM-3

STA. 89+72 to STA. 91+10 Rt.

Construct 17' Shoulder Taper

STA. 105+40 to STA. 110+00 Rt.

Install 3-Each Reflector Marker RM-3

STA. 112+50 Rt.

Install 1-Each Reflector Marker RM-3

STA. 114+50 to STA. 120+50 Rt.

Install 4-Each Reflector Marker RM-2 (white)

ROADWAY, STRIPING AND TRAFFIC SIGNS PLAN

PAHOA-KALAPANA ROAD RESURFACING


PROJ. No. 130A-01-92M

PUNA, HAWAII


Scale: 1"=100' Date:

SHEET No. 2 OF 4 SHEETS

ORIGINAL PLAN	SURVEY PLOTTED BY _____	DATE _____
NOTE BOOK	DRAWN BY _____	•
	TRACED BY _____	•
	DESIGNED BY _____	•
	QUANTITIES BY _____	•
No. _____	CHECKED BY _____	•

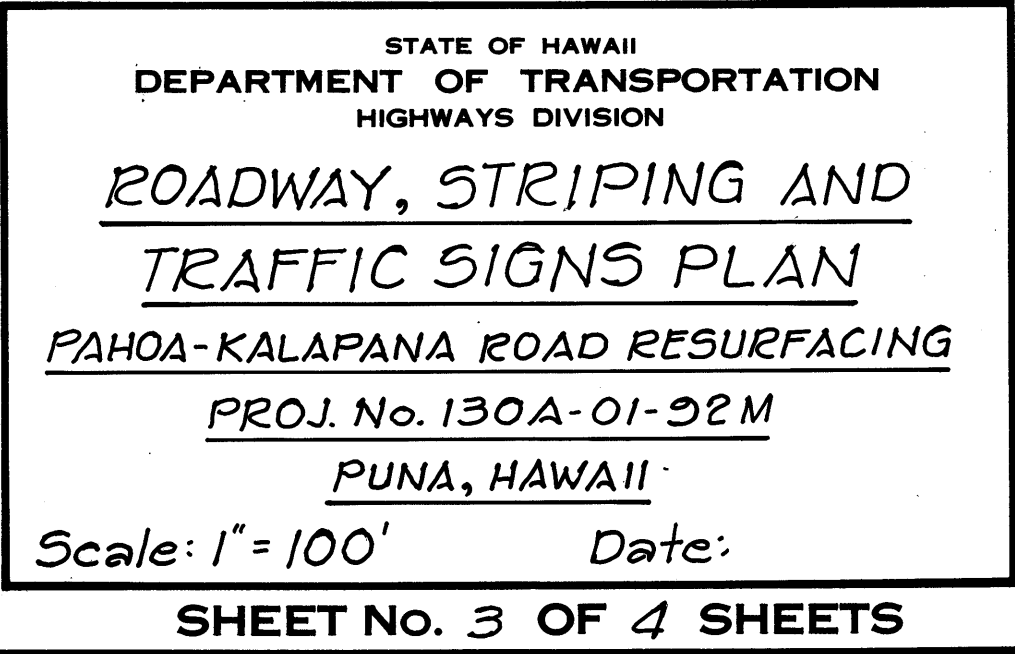

FED. ROAD DIST. NO.	STATE	PROJ. NO.	FISCAL YEAR	SHEET NO.	TOTAL SHEETS
HAWAII	HAW.	130A-01-92M	1992	8	10

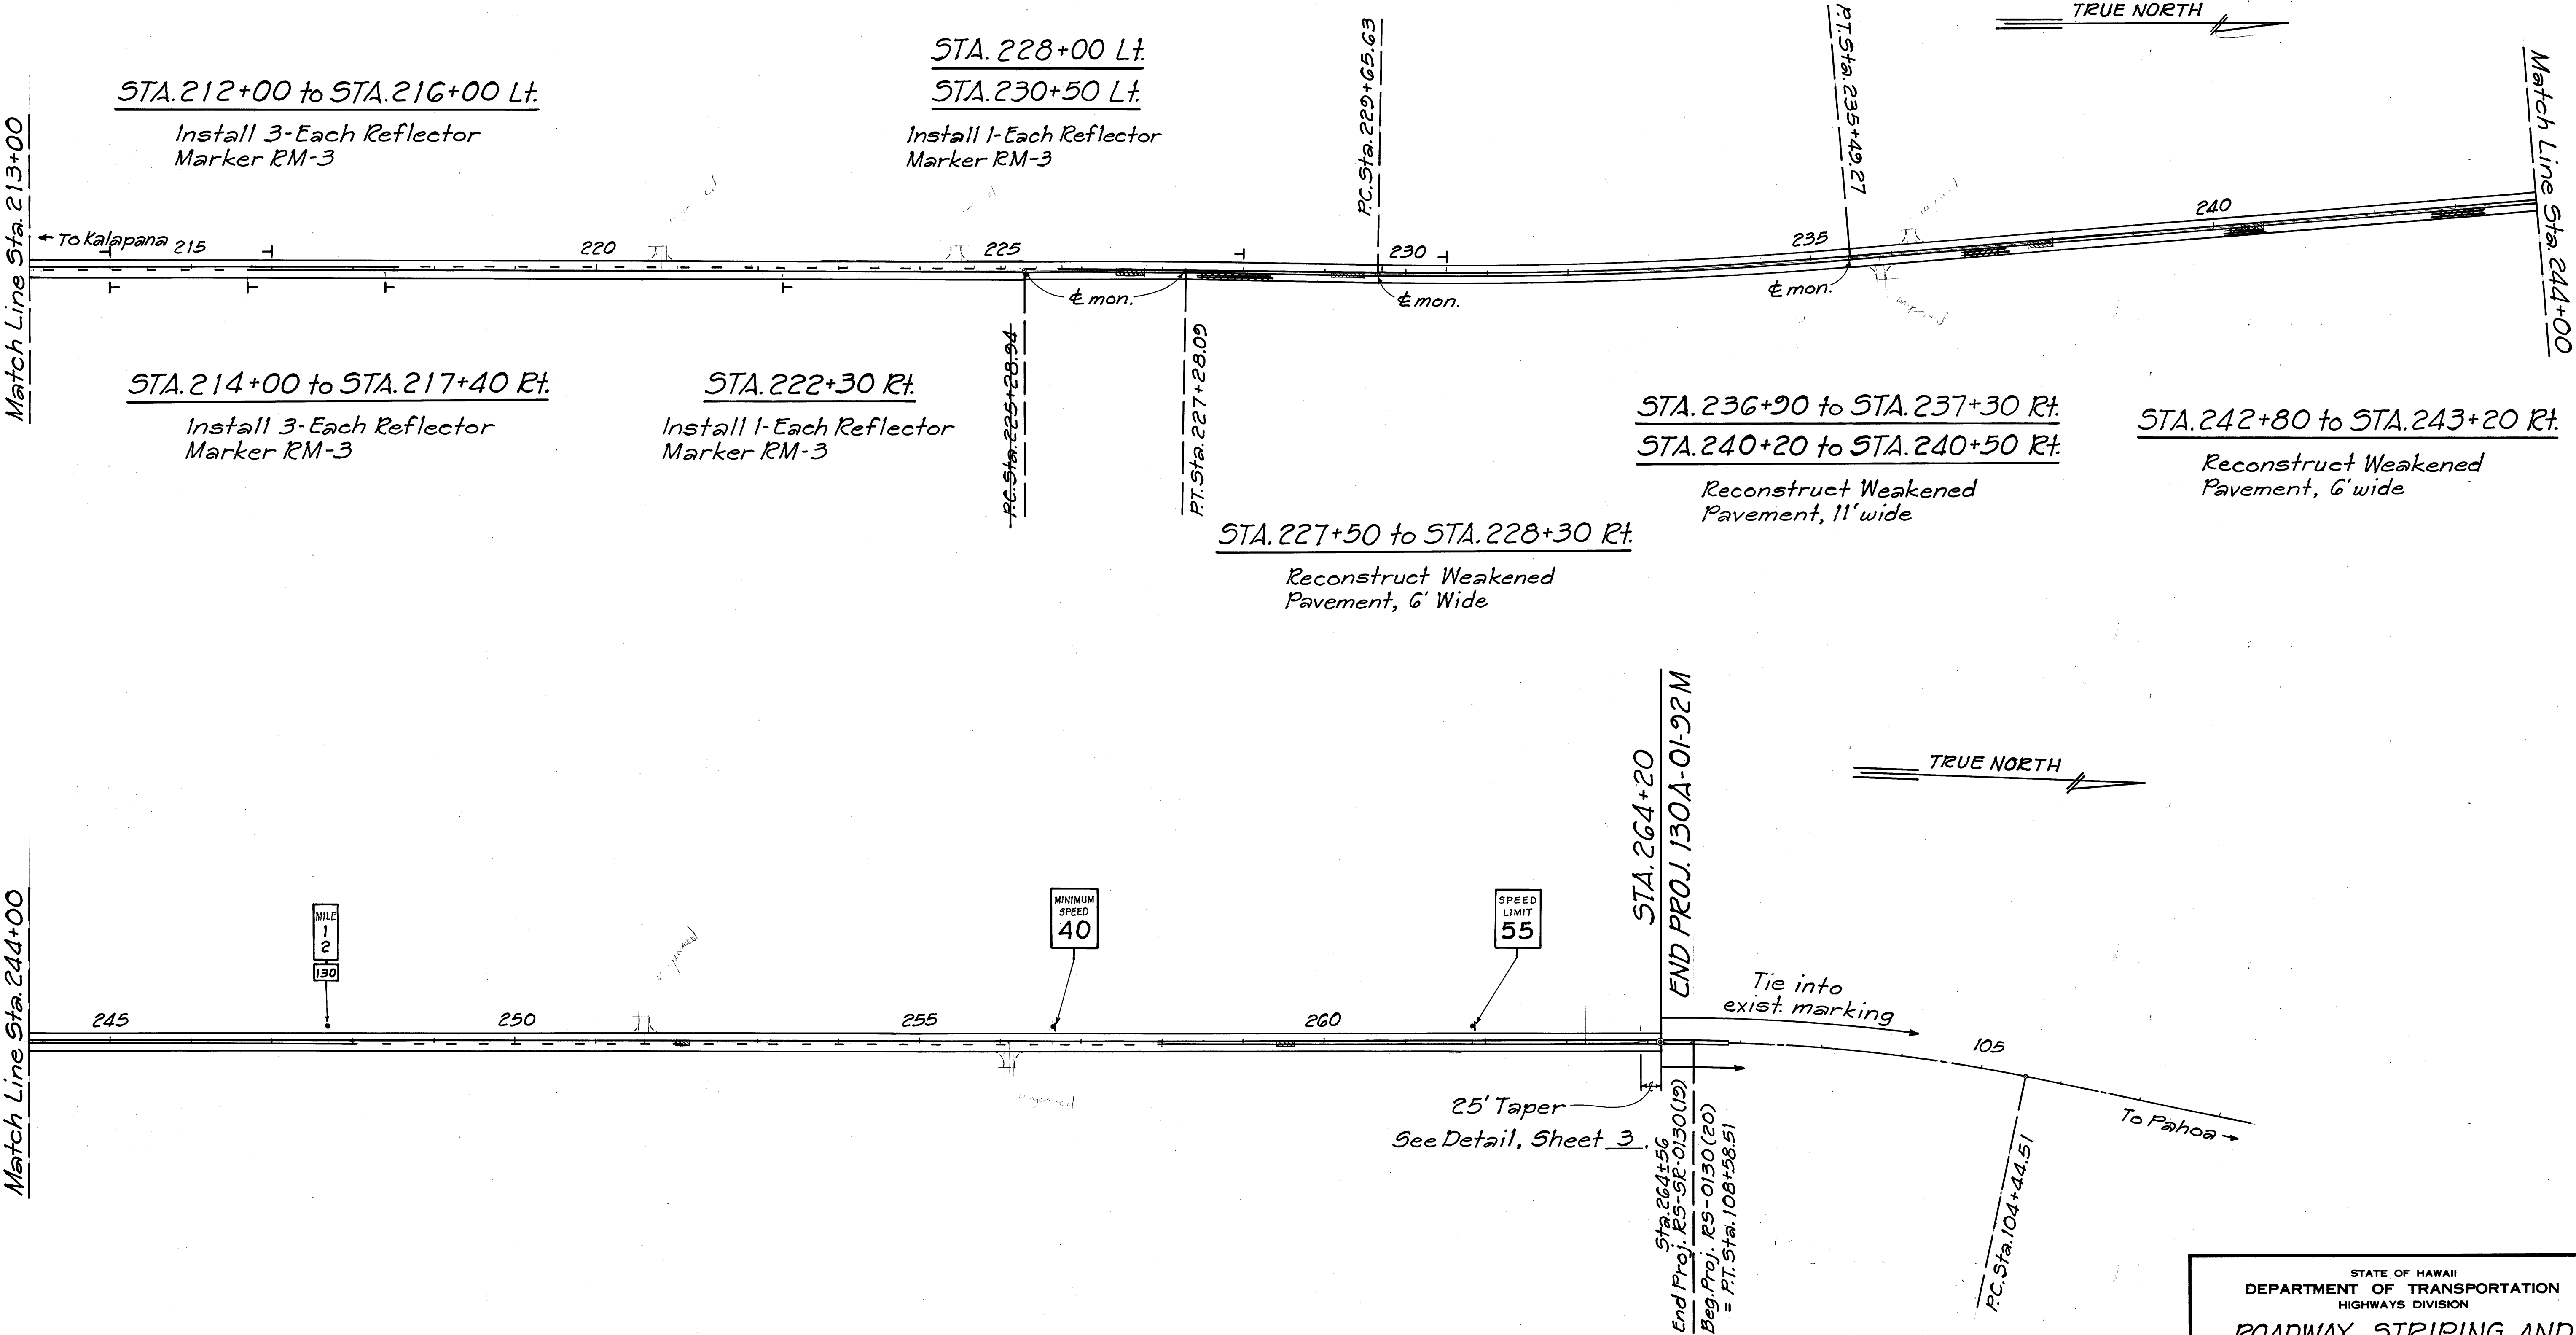

ORIGINAL PLAN	DATE
SURVEY PLOTTED BY	
DRAWN BY	
DESIGNED BY	
CHECKED BY	
NOTE BOOK	
No.	

STATE OF HAWAII
DEPARTMENT OF TRANSPORTATION
HIGHWAYS DIVISION

ROADWAY, STRIPING AND
TRAFFIC SIGNS PLAN

PAHOA-KALAPANA ROAD RESURFACING

PROJ. No. 130A-01-92M

PUNA, HAWAII

Scale: 1"=100' Date:

SHEET No. 4 OF 4 SHEETS