




FED. ROAD DIST. NO.	STATE	PROJ. NO.	FISCAL YEAR	SHEET NO.	TOTAL SHEETS
HAWAII	HAW.	130B-01-91	1991	5	26

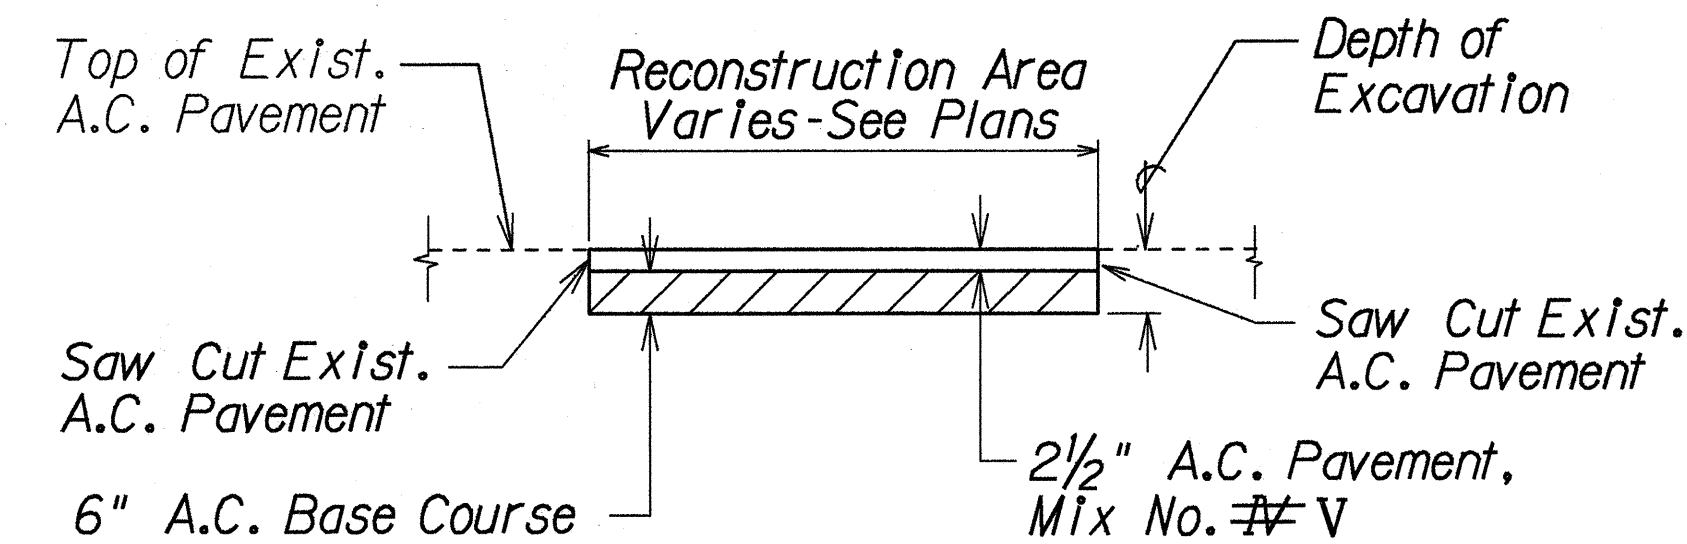


A.C. PAVEMENT RECONSTRUCTION DETAIL
Not To Scale

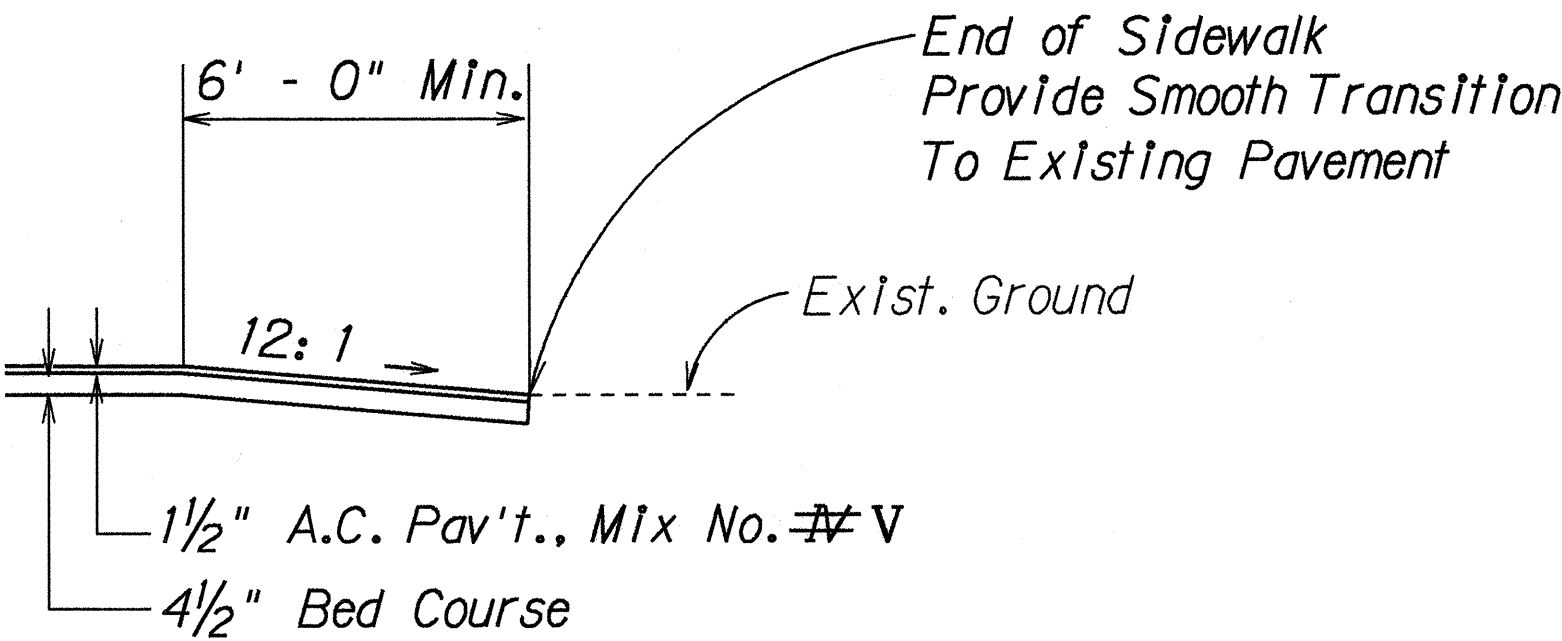

A.C. SIDEWALK TRANSITION DETAIL
Not To Scale

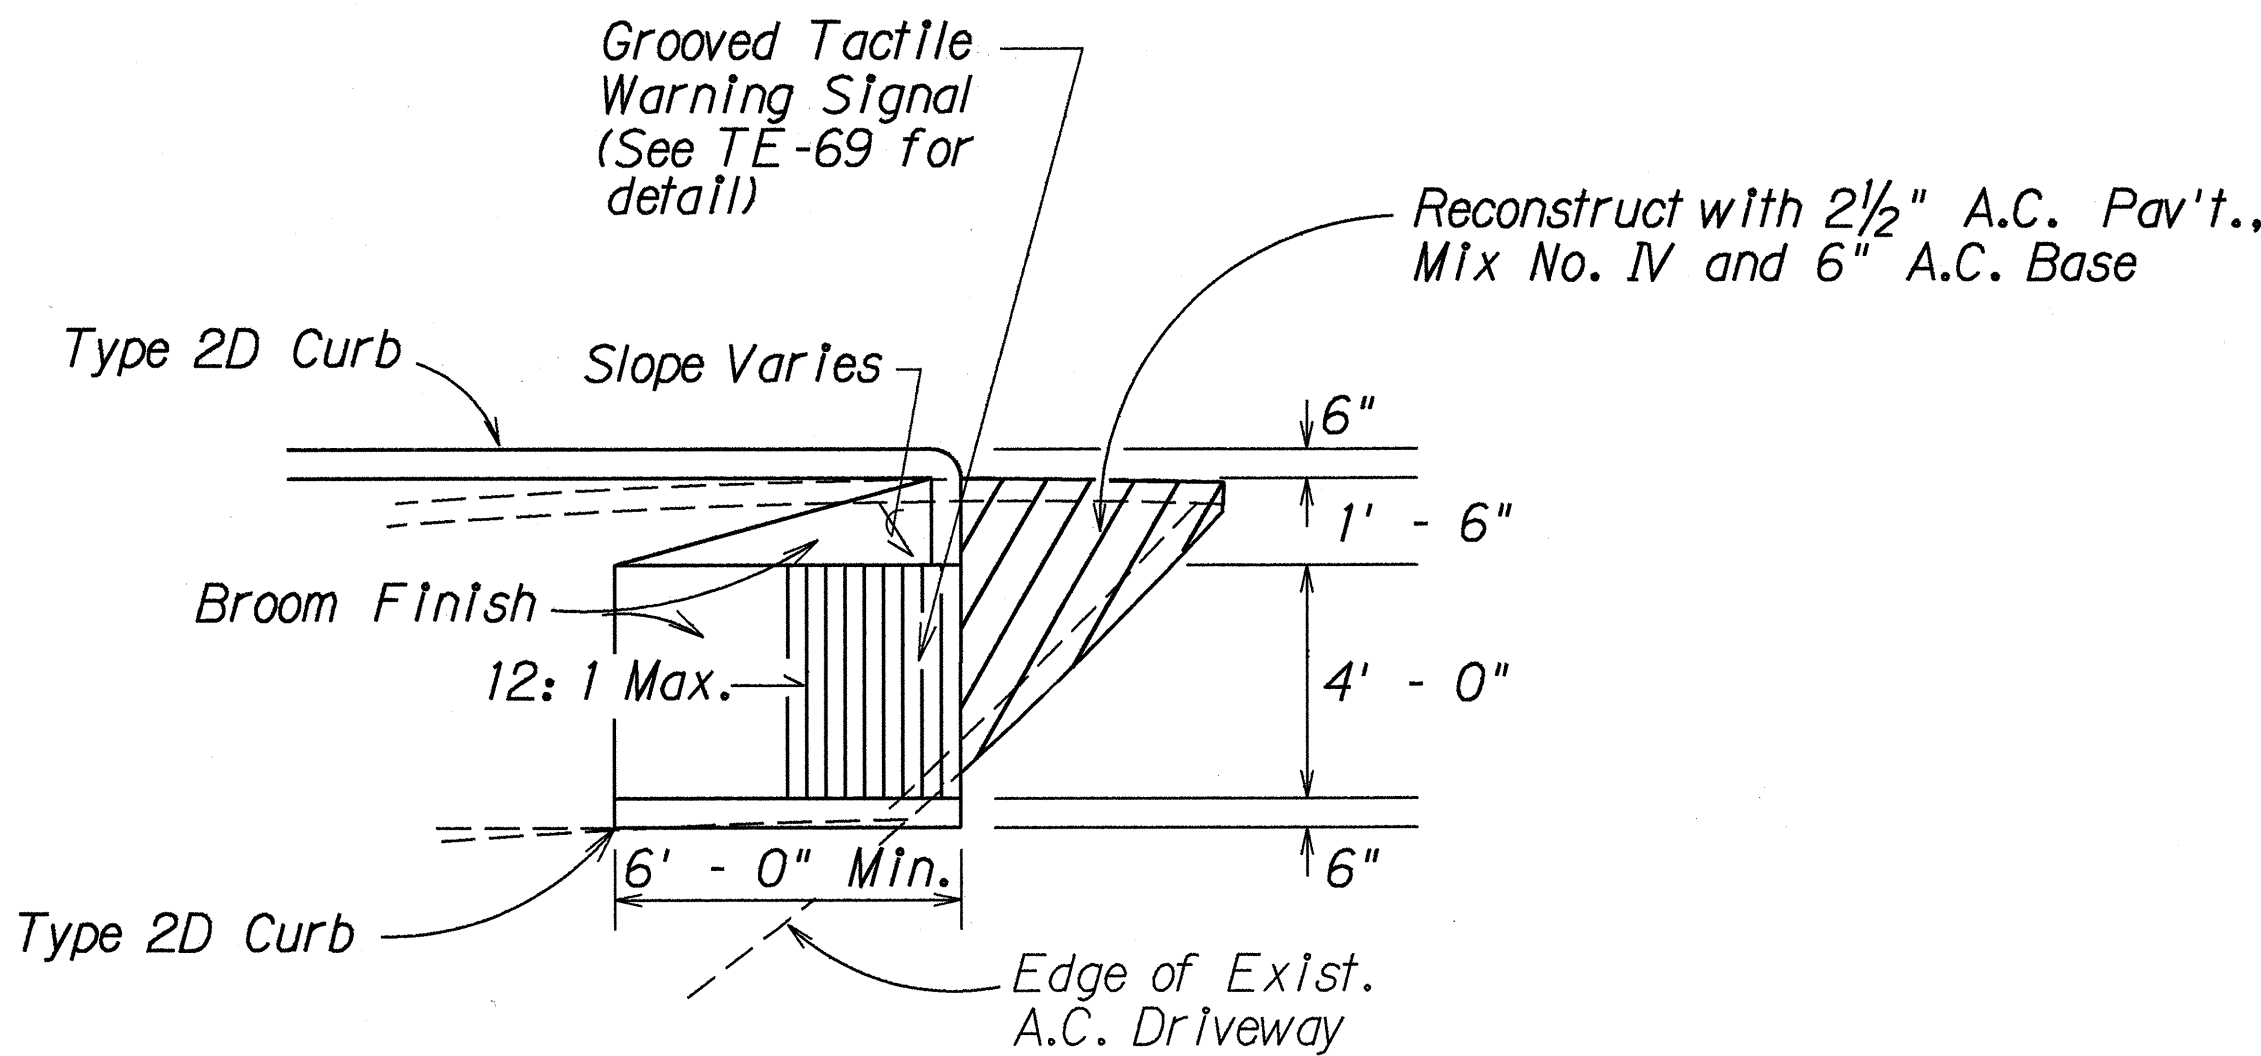

MODIFIED WHEELCHAIR RAMP - TYPE "E"
At Old Volcano Rd. Sta. 1+06± , o/s 25' Rt.
Not To Scale

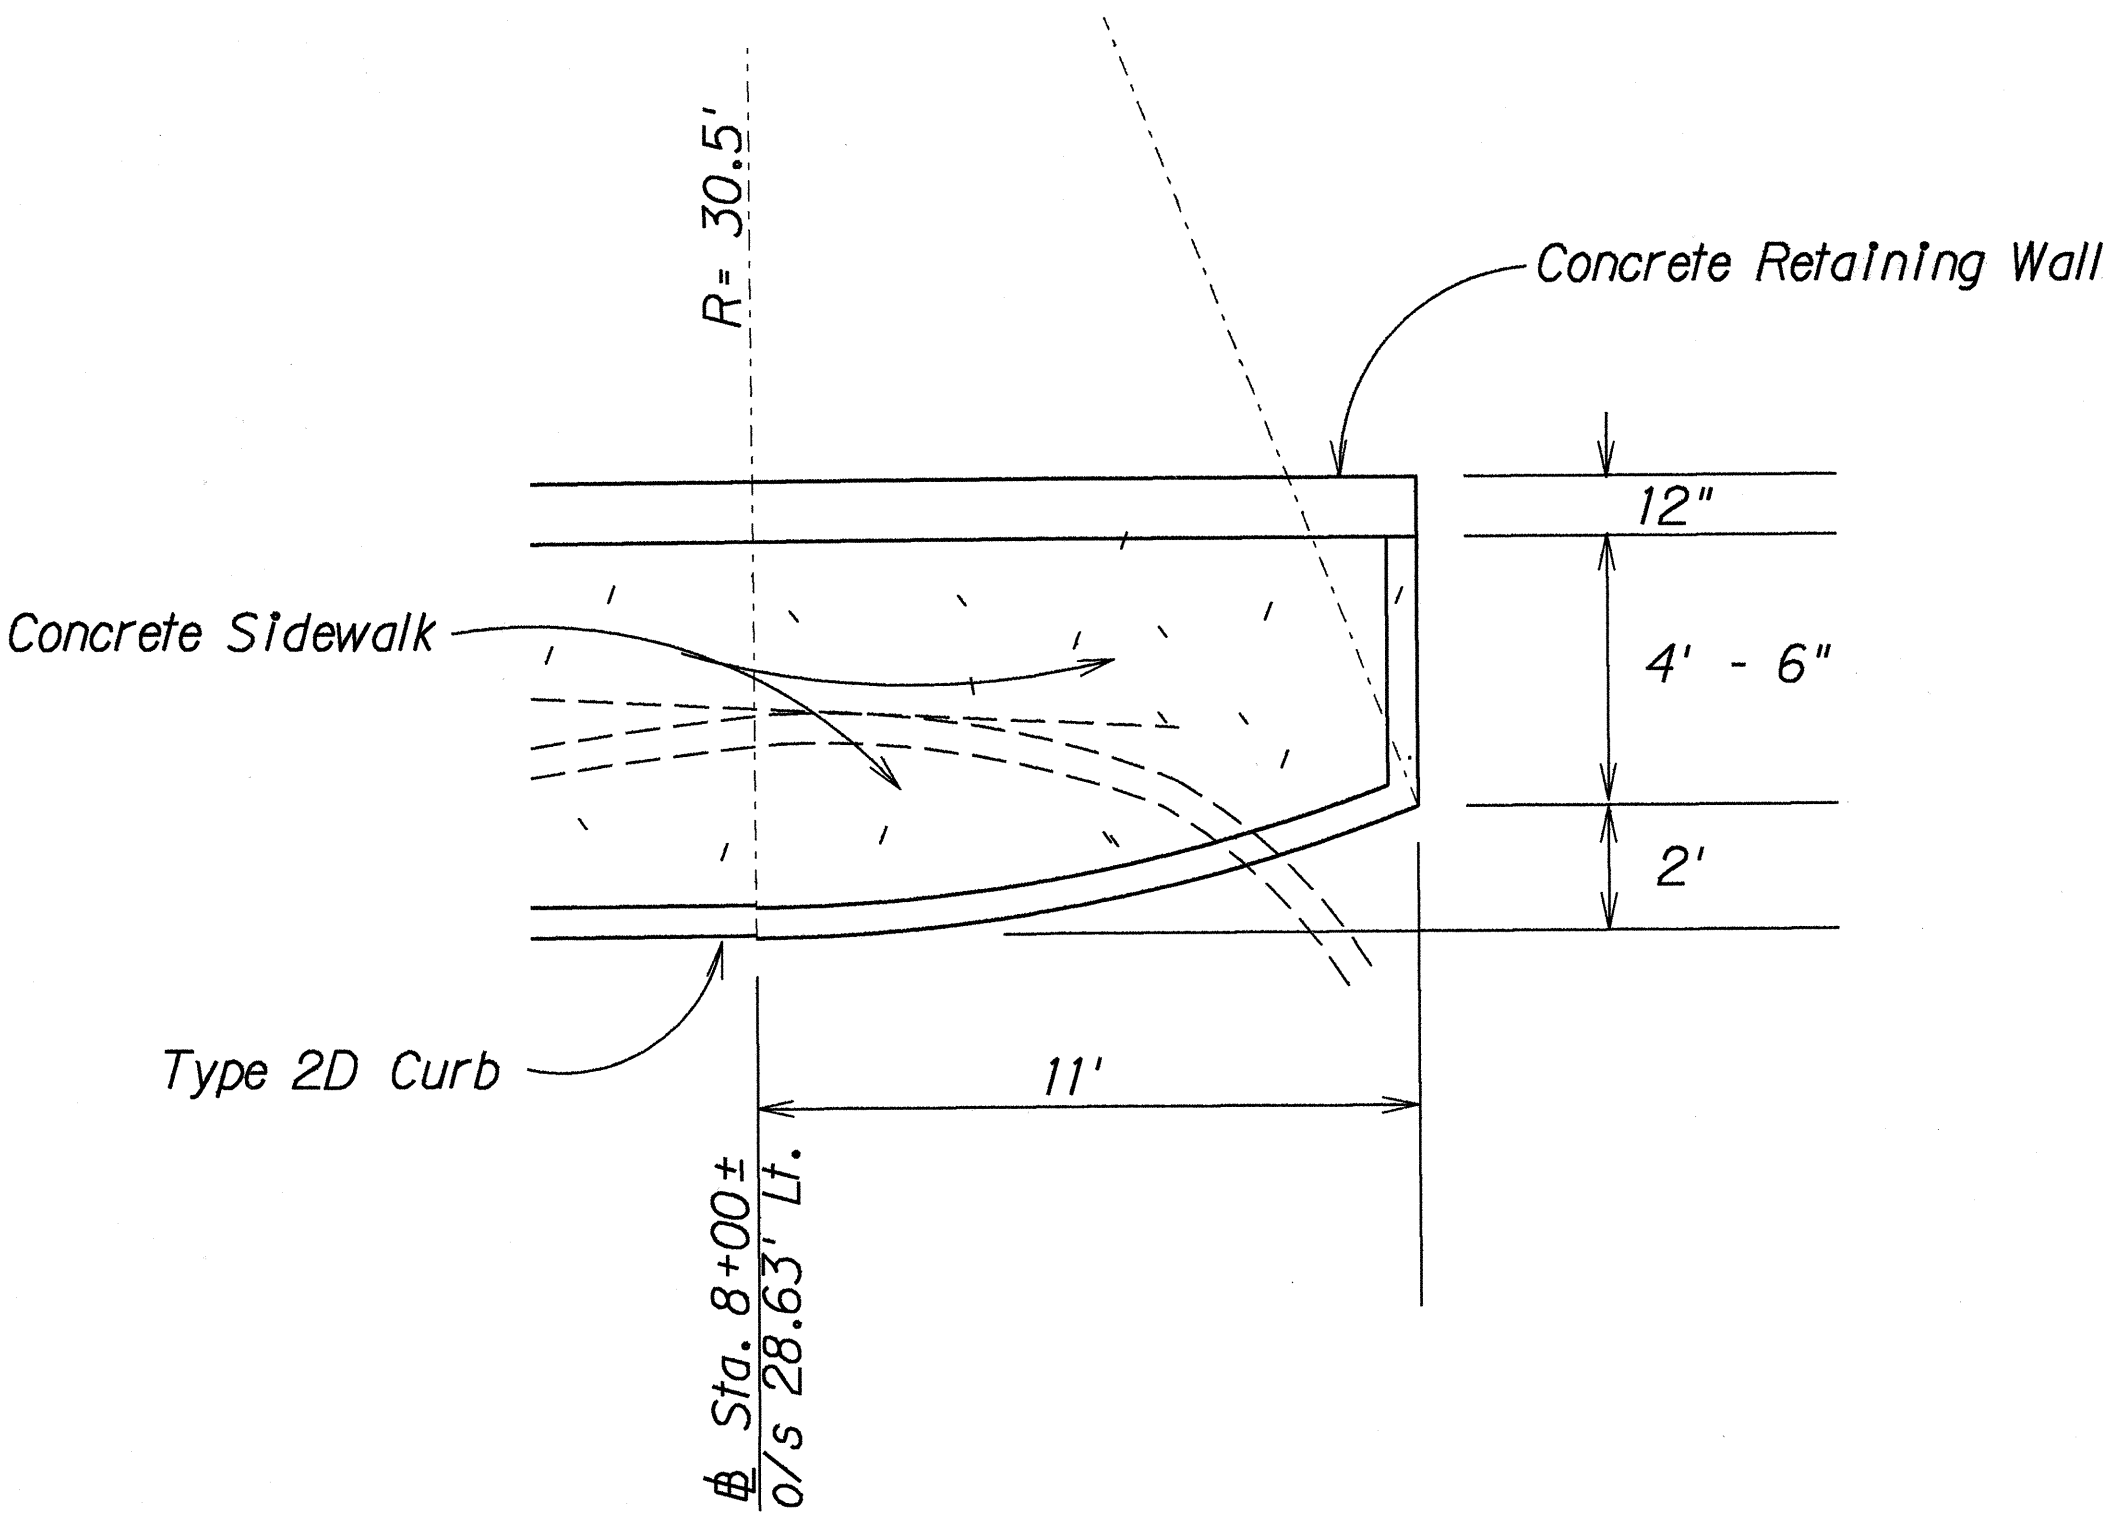

CURBING DETAIL
At Keaau-Pahoa Rd. Sta. 8+00±
Not To Scale

LEGEND FOR AS-BUILT POSTINGS	
	Squiggly line for as-built deletion
	Double line for as-built deletion
Roadway	Text for as-built posting

STATE OF HAWAII DEPARTMENT OF TRANSPORTATION HIGHWAYS DIVISION	
<u>TYPICAL DETAILS</u>	
KEAAU-PAHOA RD. IMPROVEMENTS Vicinity of Keaau School PROJECT NO. 130B-01-91	
Scale: As Noted	Date: May, 1991
SHEET No. 1 OF 1 SHEETS	

SURVEY PLOTTED BY	DATE
DRAWN BY	
TRACED BY	
NOTED BY	
CHECKED BY	
ORIGINAL PLAN	
NOTE BOOK	
DATE	