



FED. ROAD DIST. NO.	STATE	PROJ. NO.	FISCAL YEAR	SHEET NO.	TOTAL SHEETS
HAWAII	HAW.	130B-01-91	1991	4	26

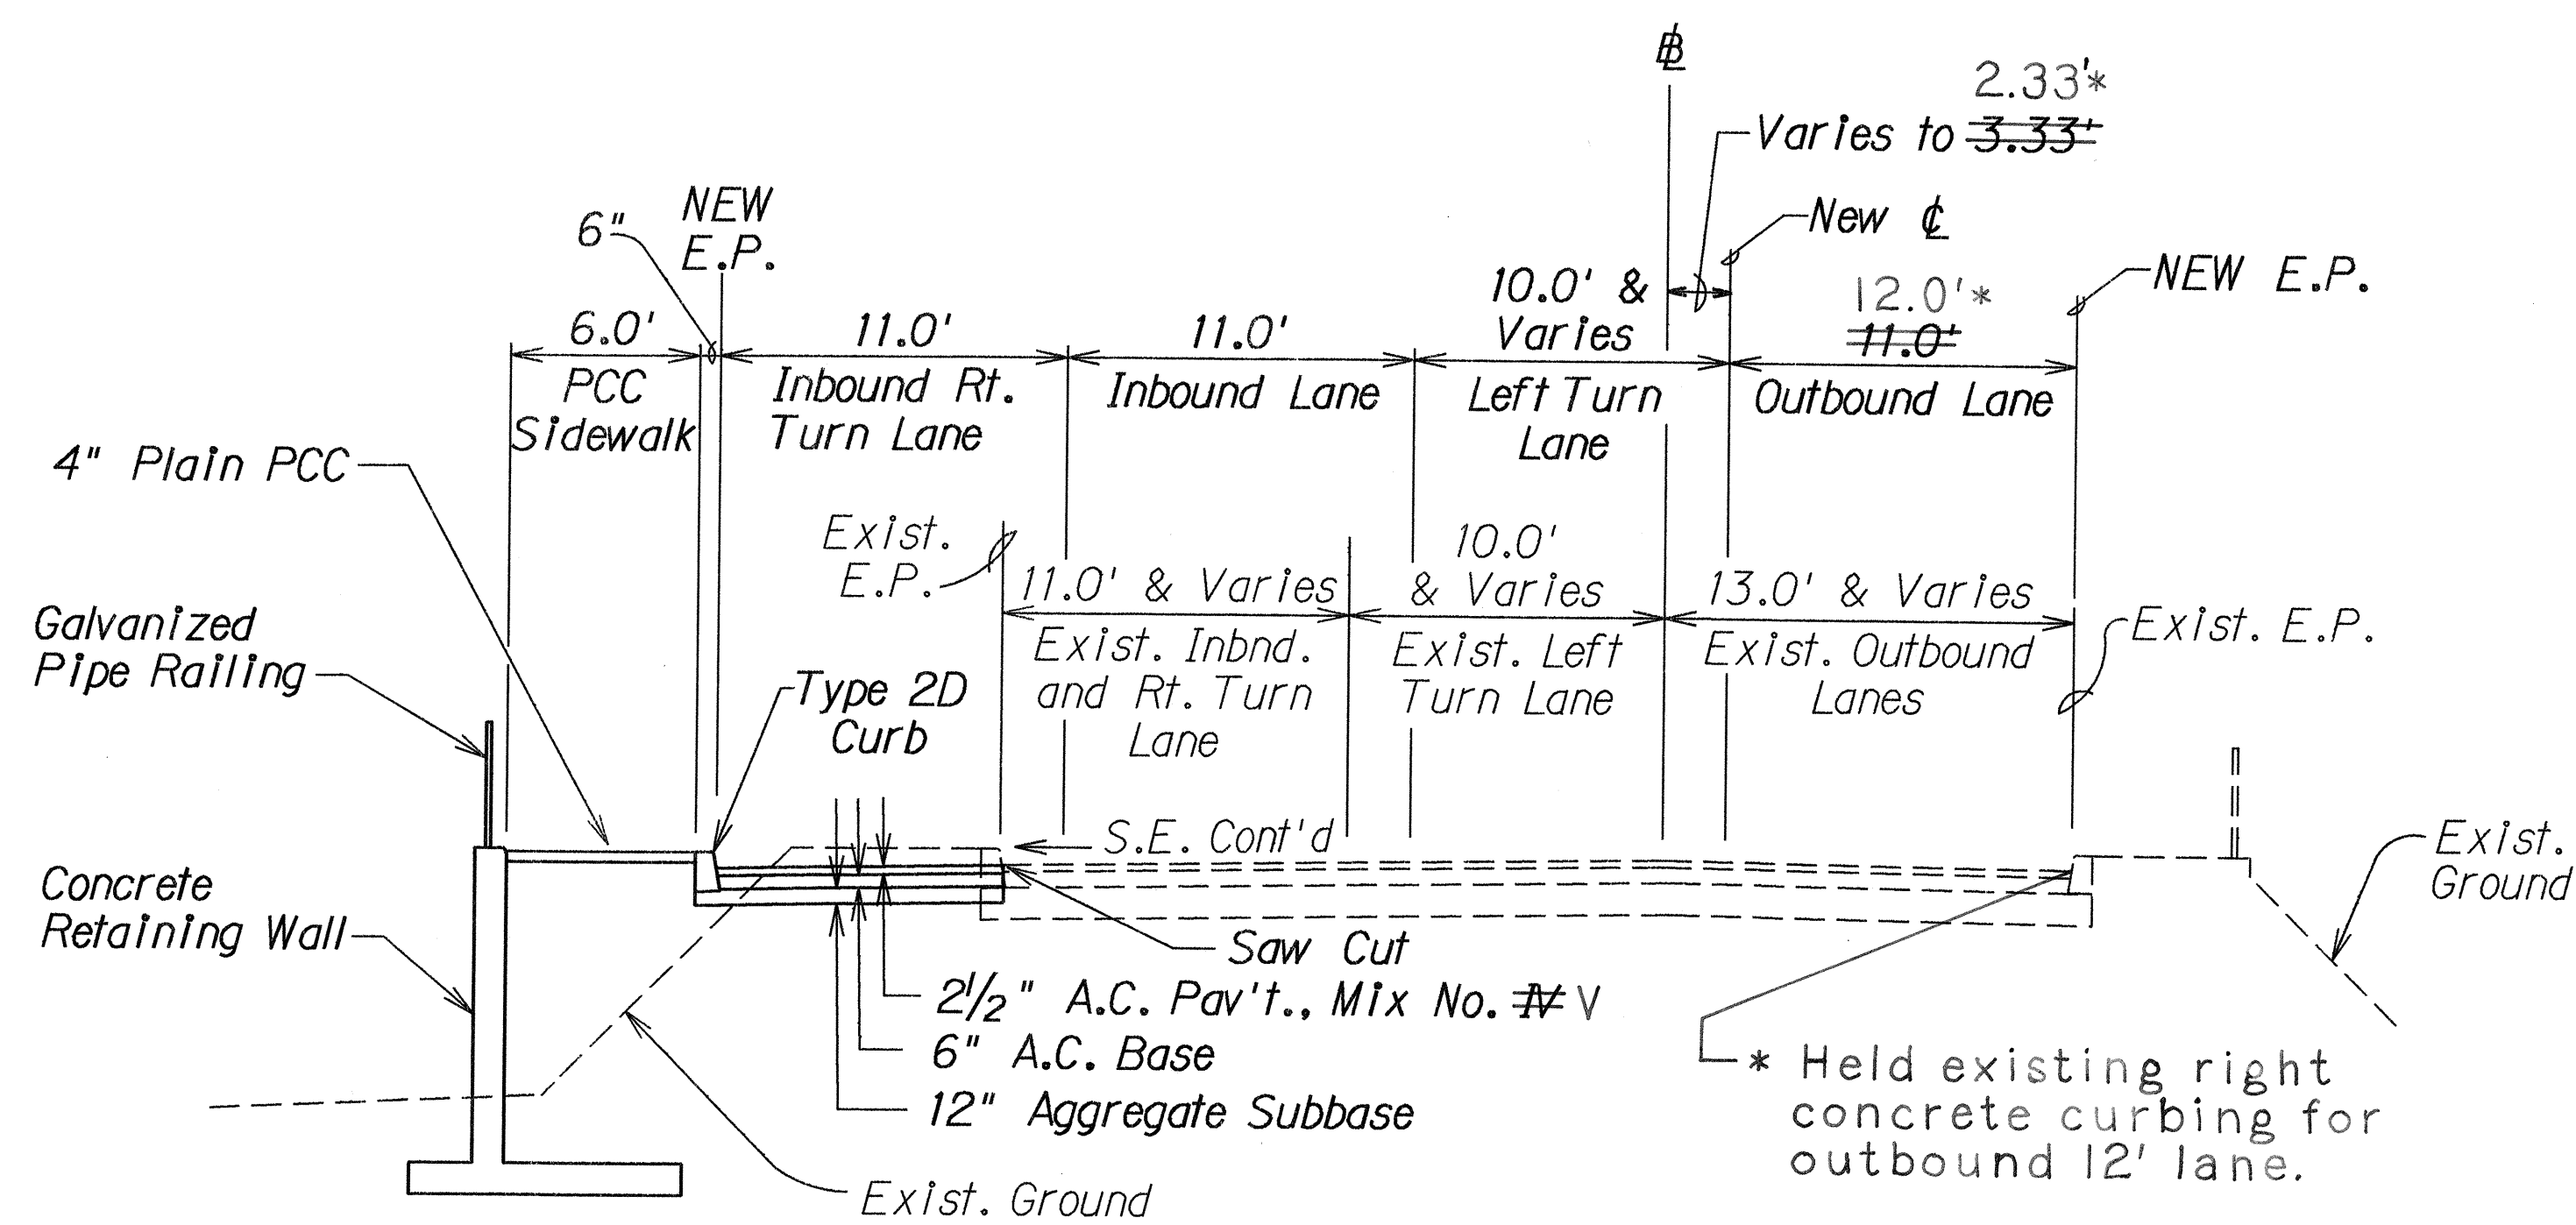


TYPICAL SECTION

Sta. 6+25± TO Sta. 8+25±

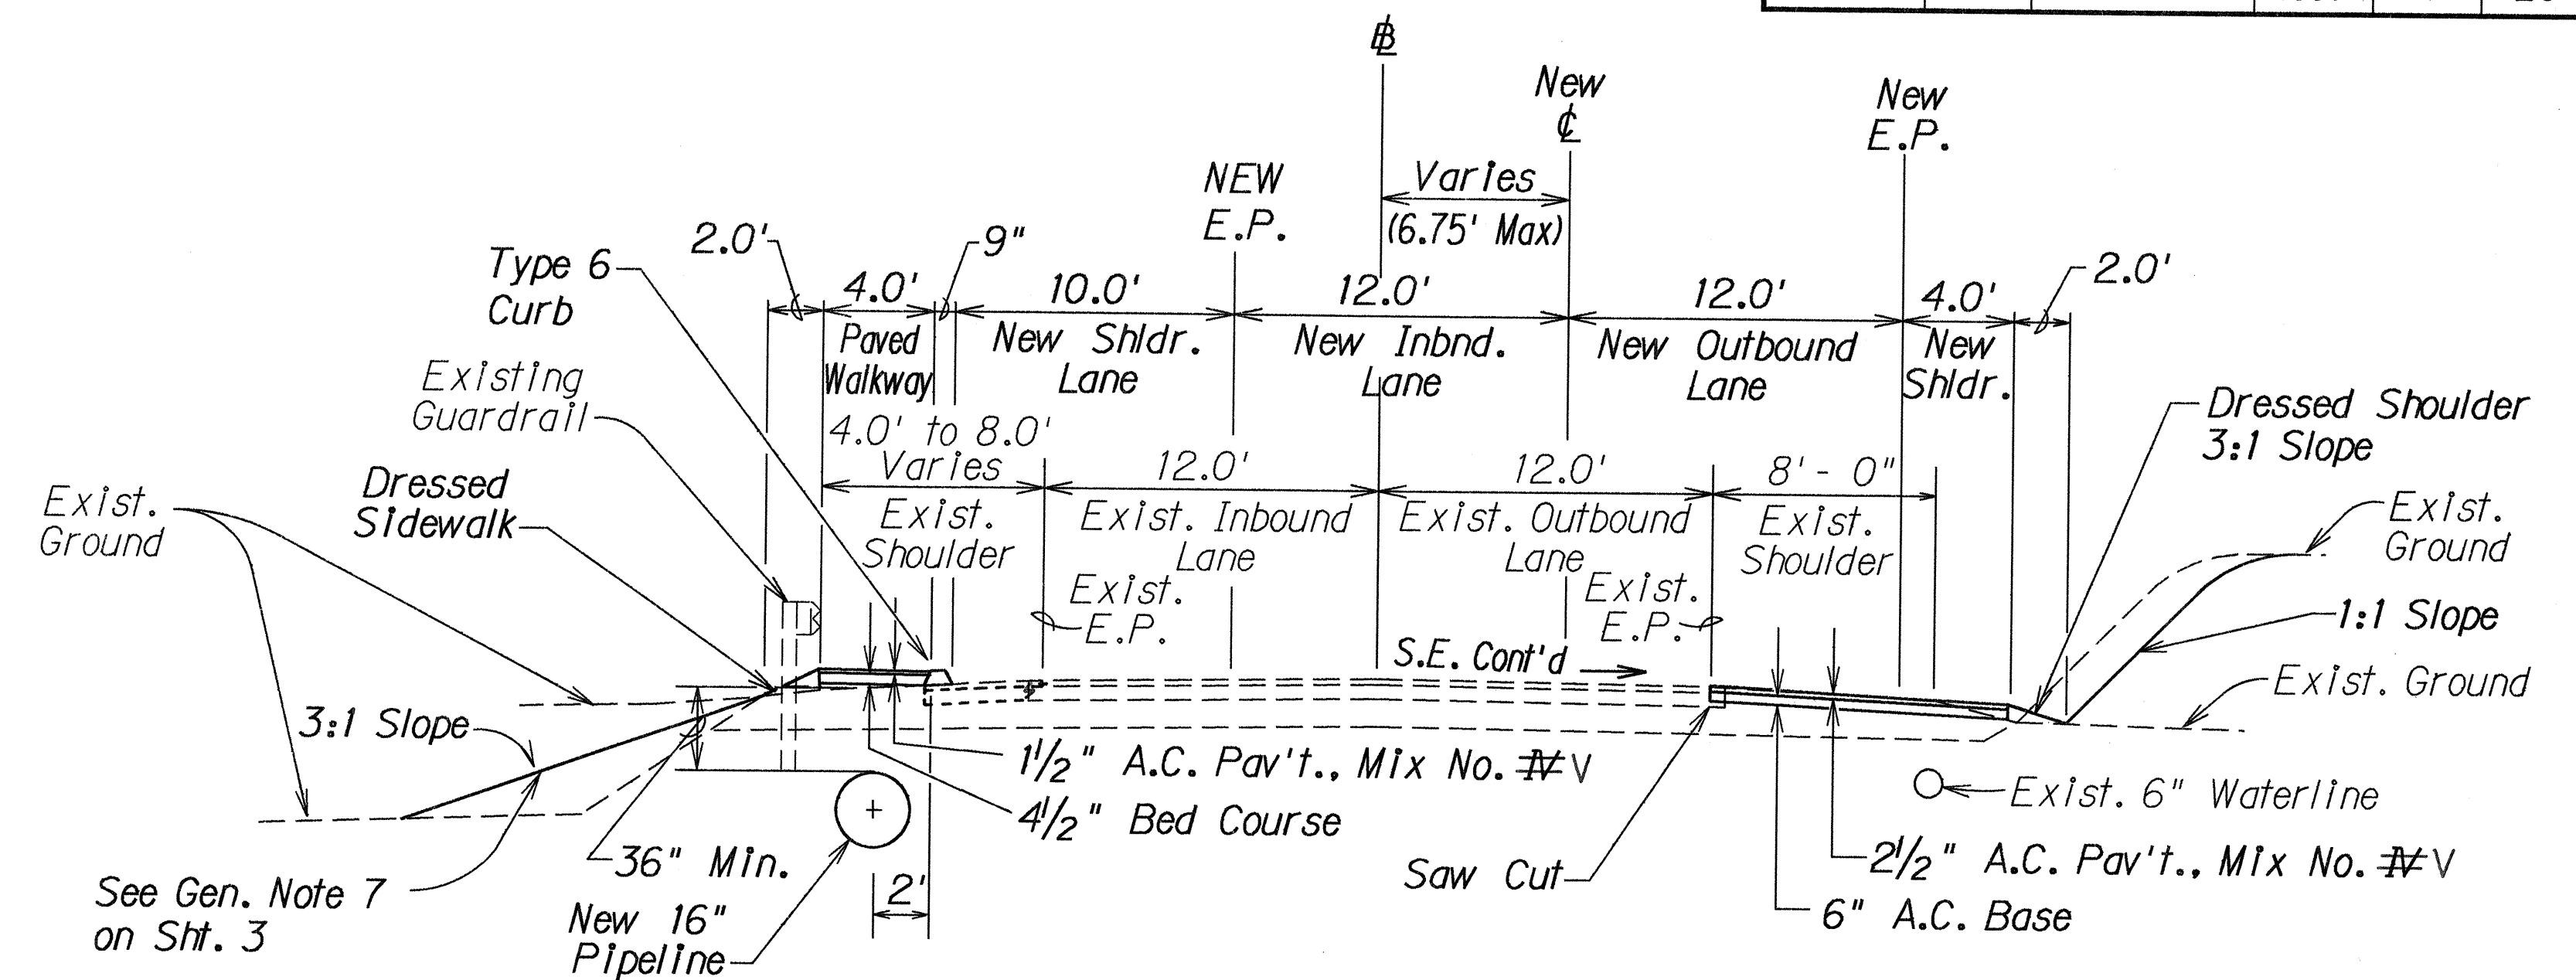


TYPICAL SECTION

Sta. 9+45± TO Sta. 28+00±

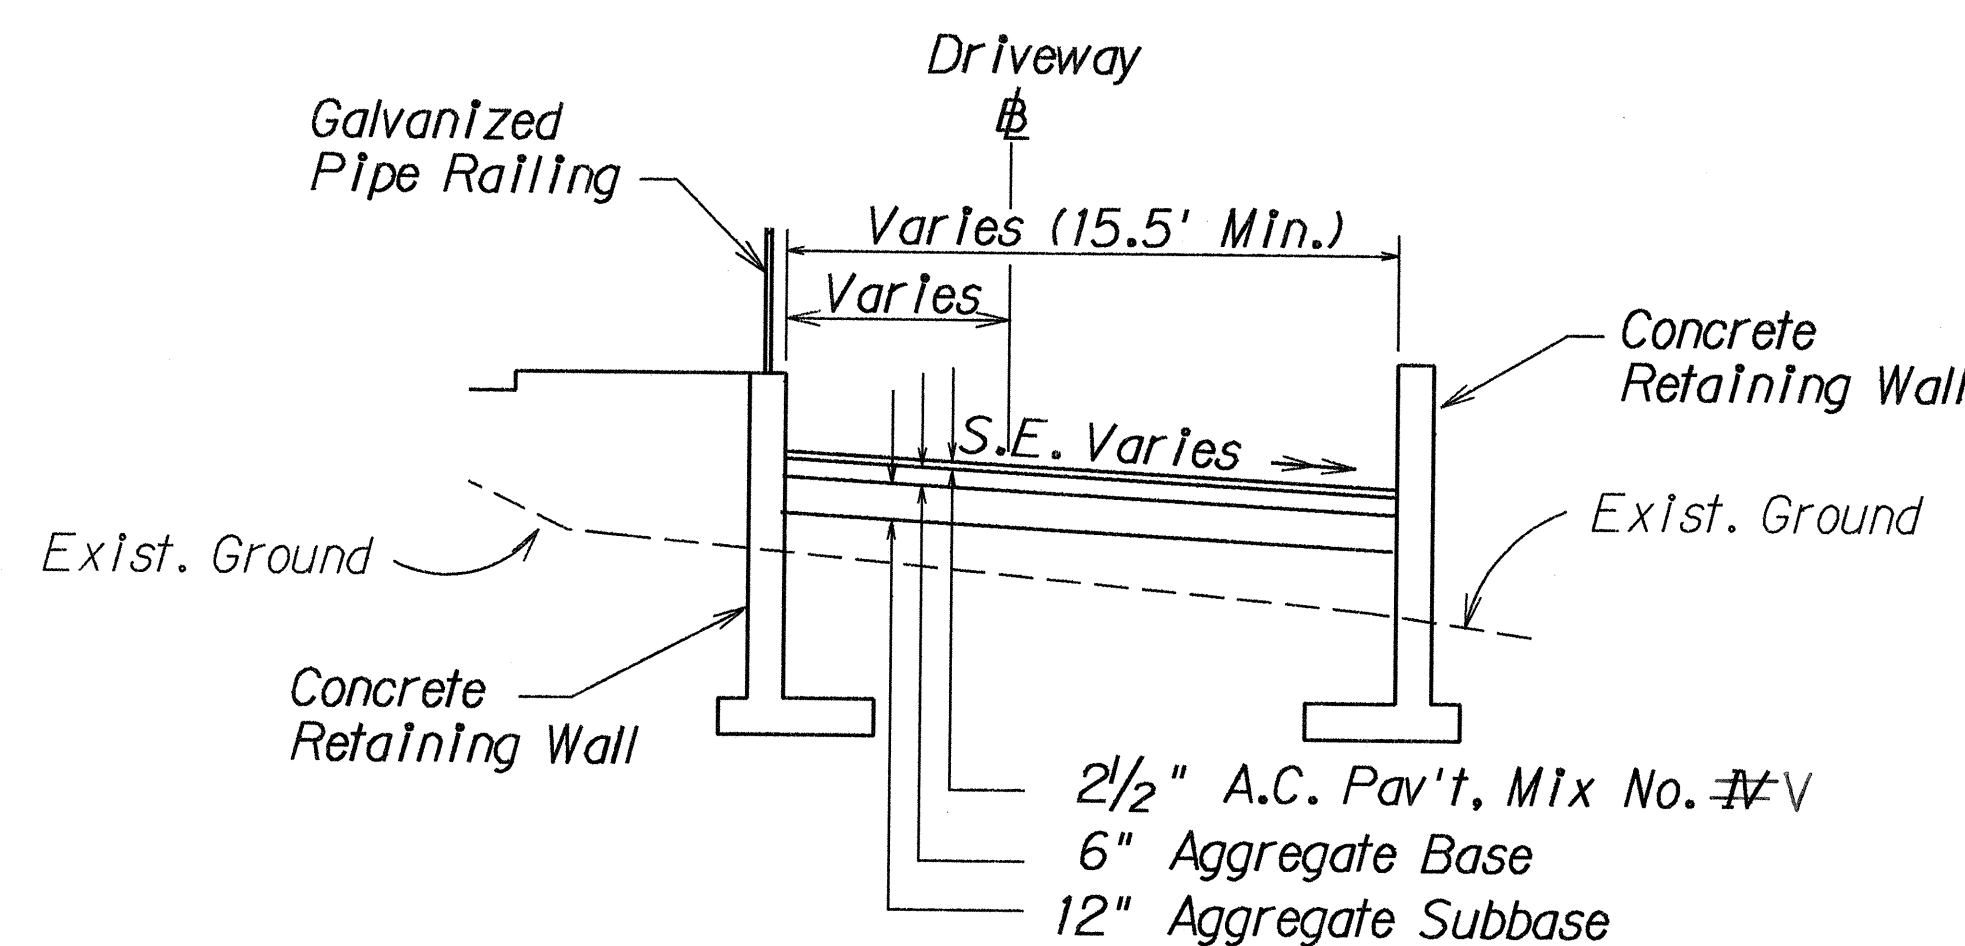


TYPICAL SECTION

ROAD "B", SIDEROAD

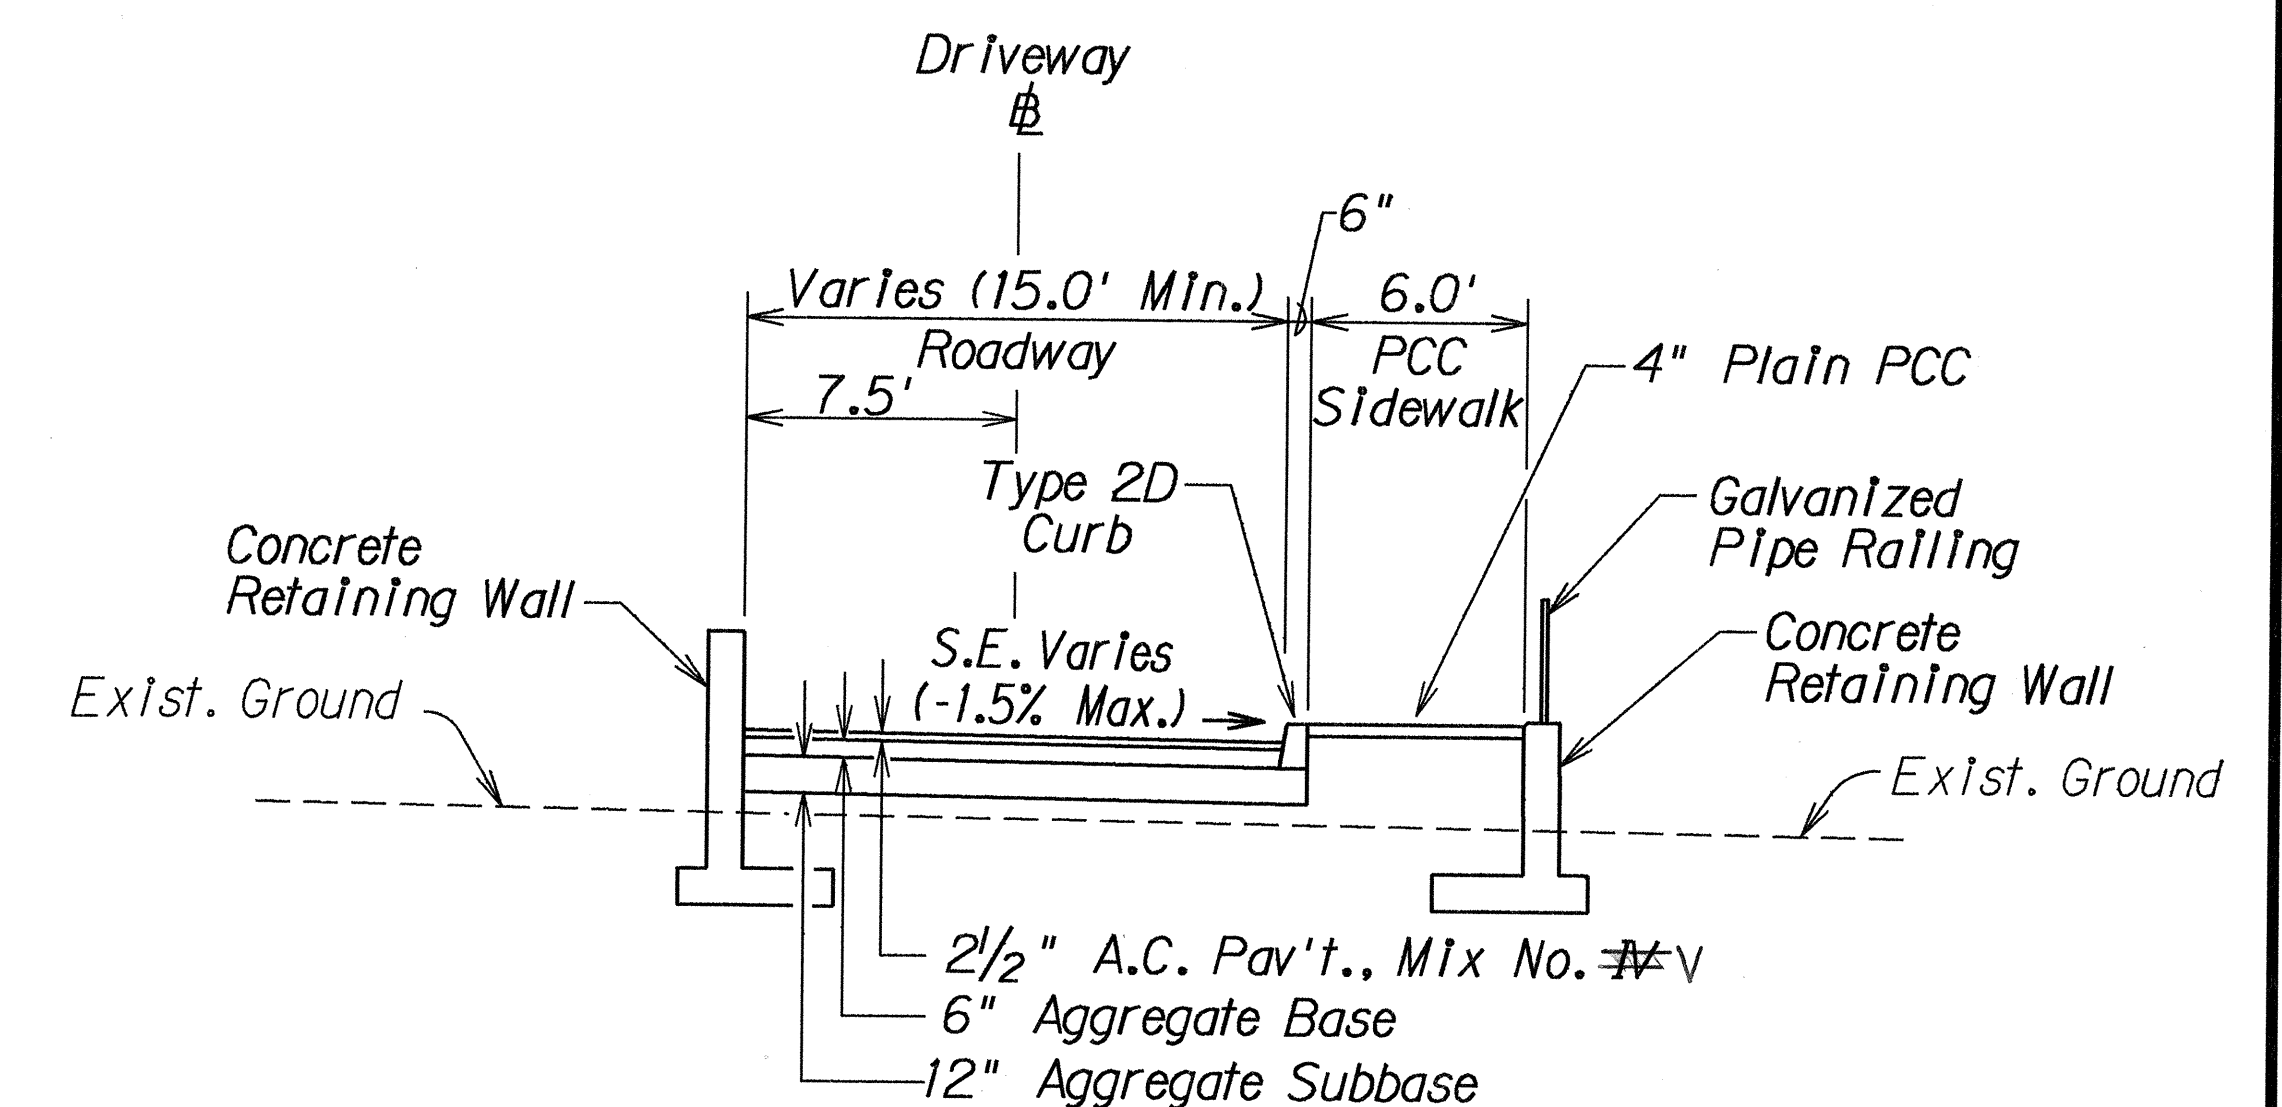

TYPICAL SECTION

ROAD "A", KEAAU SCHOOL DRIVEWAY

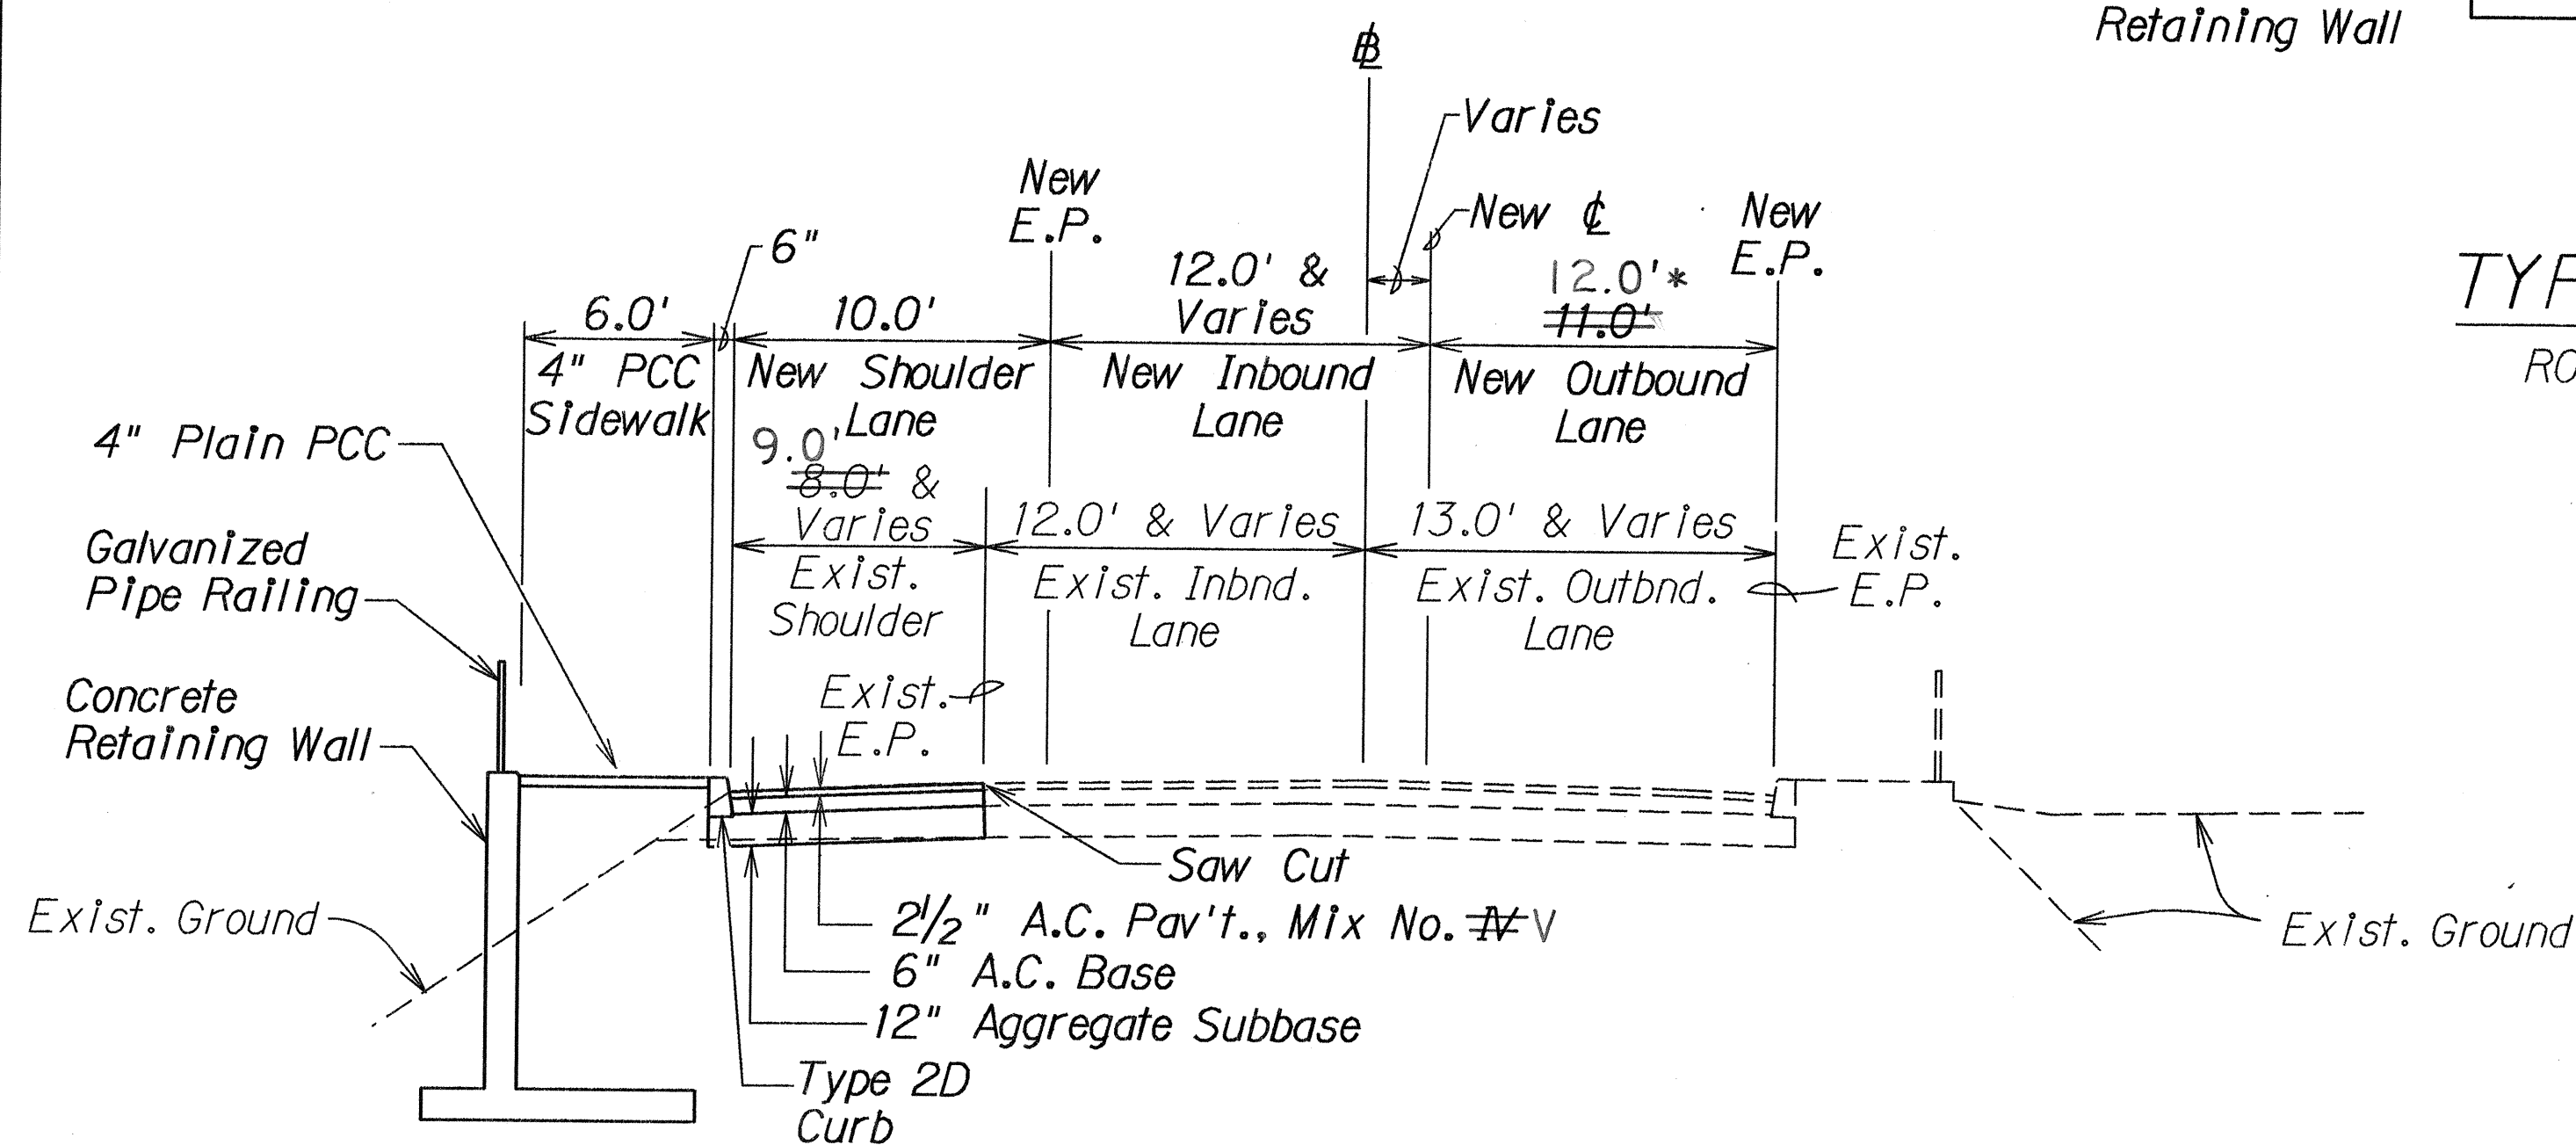

TYPICAL SECTION

Sta. 8+45± TO Sta. 9+45±

APPROVED FOR CONSTRUCTION WITHIN
KEAAU SCHOOL RIGHT-OF-WAY:

[Signature]
DISTRICT SUPERINTENDENT
HAWAII DISTRICT SCHOOLS

5-23-91
DATE

STATE OF HAWAII
DEPARTMENT OF TRANSPORTATION
HIGHWAYS DIVISION

TYPICAL SECTIONS

KEAAU-PAHOA ROAD IMPROVEMENTS
Vicinity of Keau School
PROJECT NO. 130B-01-91

Not To Scale

Date: May, 1991

SHEET No. 1 OF 1 SHEETS

"AS-BUILT"